



TRANSBAY JOINT POWERS AUTHORITY

Maria Ayerdi-Kaplan • Executive Director

January 14, 2010

Steven C. Hood
Millennium Partners
735 Market Street, 4th Floor
San Francisco, CA 94103

Subject: Transbay Transit Center Program
Buttress Construction Documents

Dear Mr. Hood,

In accordance with the Easement Agreement dated October 10, 2008, between the Transbay Joint Powers Authority (TJPA) and Mission Street Development LLC, we are attaching for your review three copies of the Buttress Construction Documents (drawings and specifications).

With this submittal we are soliciting feedback from your designers regarding the design of the Buttress to enable TJPA to complete the design and construct the Buttress. These documents should be reviewed in conjunction with the Report on the Preliminary Design of the Buttress for Limiting Excavation-Induced Deformations at 301 Mission Street previously provided to you with our letter of November 18, 2009.

Additionally, we are requesting responses from your designers to the questions outlined below to allow our designers to better understand your building's design and performance as they finalize the Buttress Construction Documents. Accompanying the correspondence you will find three plates referenced in the questions to assist.

General

- 1.0 For what magnitude of movement have the utility service connections been designed?
- 2.0 For the building systems which are adversely affected by building movement, e.g., below-grade waterproofing (including penetration seals), exterior drainage (exterior door thresholds, sidewalk cross-falls, driveway and service entrance drainage), exterior skin/ cladding, elevators, expansion joints, finishes, etc., how much total movement can be accommodated without affecting their performance?
- 3.0 What are the pile design criteria and installation criteria issued to the original contractor? What is the pile head displacement used in the design?

Tower Settlement

- 1.0 Treadwell and Rollo, in their letter referenced by DeSimone to the San Francisco Department of Building Inspection of February 25, 2009, reported that the settlement of the tower core was 8.3 inches and estimated that approximately 2 to 4 inches of additional settlement could occur in the future. Please see Plate 1-1 and 1-2 attached. On the basis of these current data, how much additional total and differential settlement is now expected under the tower?

- 2.0 What are the reasons for larger than anticipated settlements at the tower core? Does Treadwell and Rollo remain of the opinion that the additional settlement is due to longer dewatering and limited effectiveness of predrilling of piles?
- 3.0 What is the explanation for the differential settlements at the south end of the tower? Please see Plate 2 attached, which is based on surveyed settlement marker elevations.
- 4.0 Does the observed differential movement, shown in Plate 2, affect the structural performance of the 301 Mission building? How much movement can the structure accommodate?
- 5.0 What amount of total measured settlement is from undrained deformation and what settlement is from consolidation?
- 6.0 Is the Old Bay Clay stressed into the virgin compression zone, or is the settlement entirely due to recompression?
- 7.0 What is the estimated degree of consolidation of the Old Bay Clay at this time? How long will it take to reach 95% consolidation?
- 8.0 Is the slow rate of observed settlement within the last 9 months an indication of slow primary consolidation, or is the settlement secondary compression?

Foundation Design

- 1.0 In the foundation design, was the assumption made that the 10-foot mat and the piles would perform as a rigid block? At what depth was it assumed that the building load was applied?
- 2.0 Was the full dead load plus full live load used to calculate the building settlement, or was a reduced live load used?

Seismic Considerations

- 1.0 What are the periods of vibration, mass participation factors and mode shapes for the first 5 modes of the tower?
- 2.0 What is the shear corresponding to the maximum shear and bending moment capacity of the lateral system of the tower?
- 3.0 What is the maximum base shear and moment that the structure is able to deliver to the foundation?

In order to expedite the review process, we are requesting that we meet the week of January 25, 2010, to review the responses to the above questions and any comments generated from your review of the Buttress Construction Documents.


Yours truly,



Brian R. Dykes, P.E.
Principal Engineer
Transbay Joint Powers Authority

Enclosure: Buttress Construction Documents


cc: R. Volenec, N. Riordan, B. Gibbons, Document Control

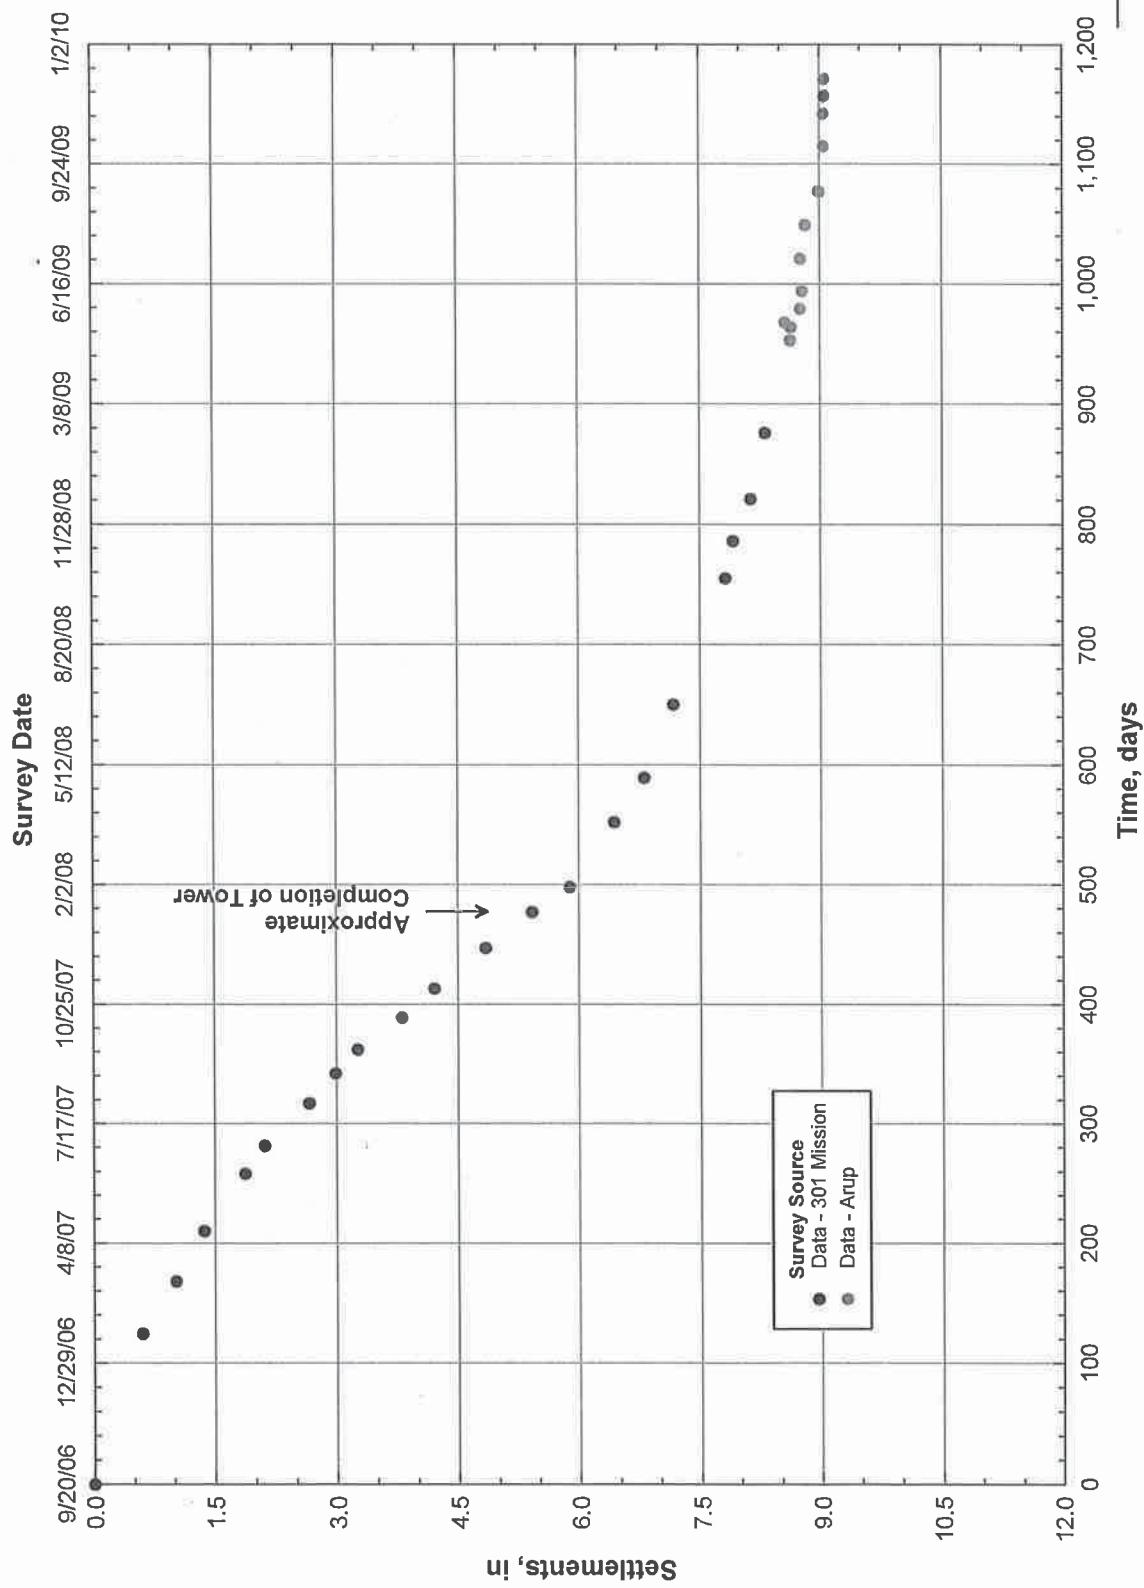


SURVEYED SETTLEMENT OF THE 301
MISSION TOWER: LOG TIME SCALE

Transbay Transit Center
301 Mission Performance
Transbay Joint Powers Authority
San Francisco, California

January 2010

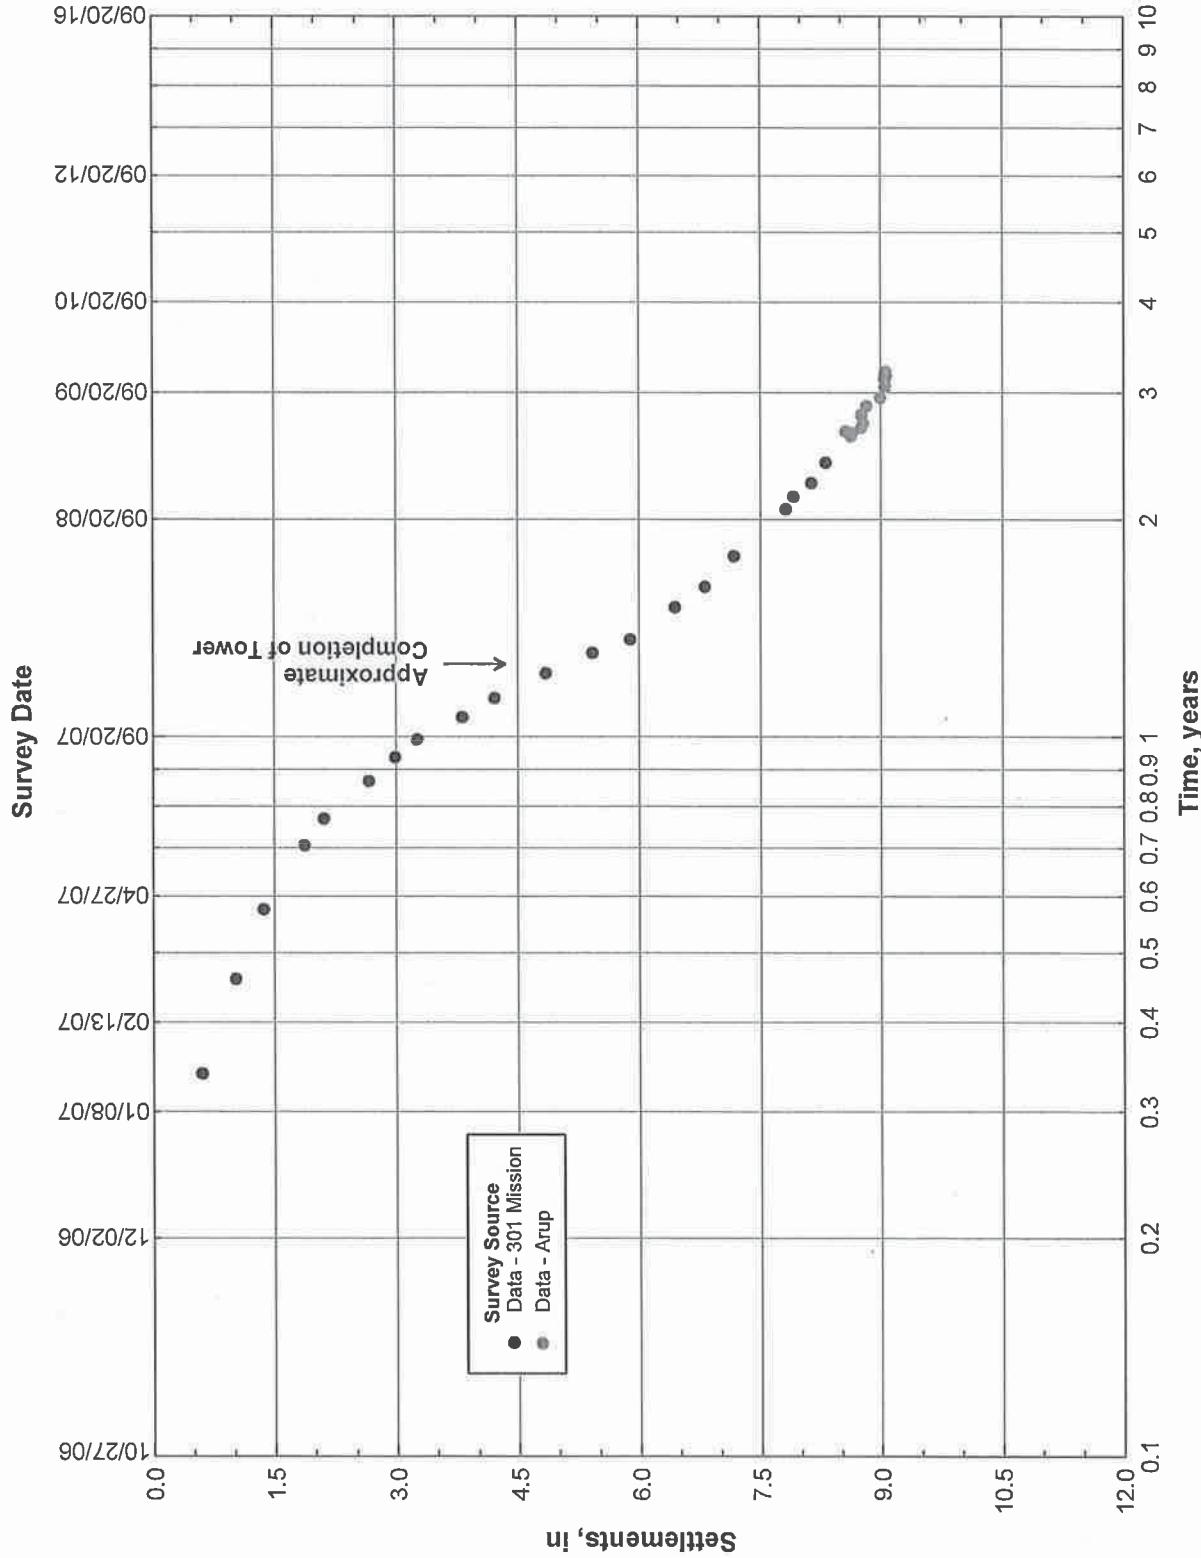

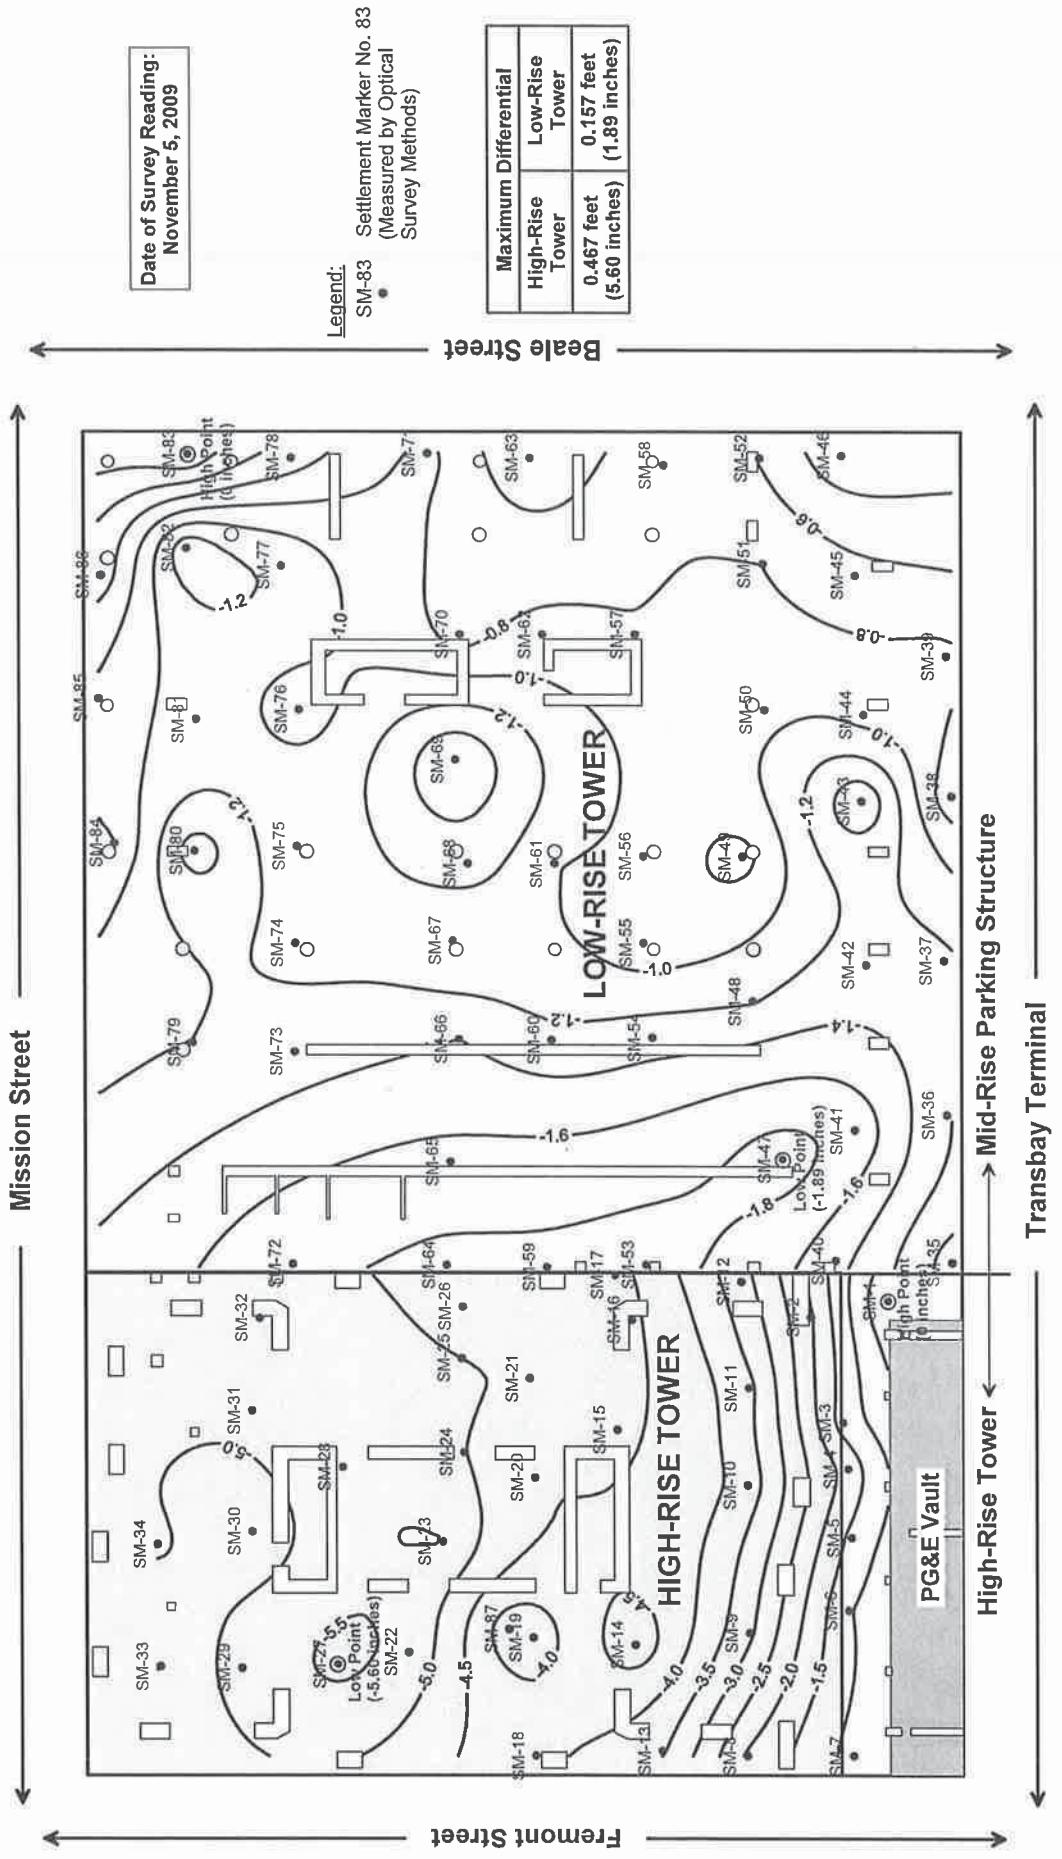

DIFFERENTIAL FLOOR ELEVATION (INCHES)
FROM SURVEYED SETTLEMENT MARKERS
FOR THE 301 MISSION BUILDINGS

Transbay Transit Center
301 Mission Performance
Transbay Joint Powers Authority
San Francisco, California

January 2010

PLATE 2

Q112224 Internal Project Data\4.11 Field Work\4.11 Existing Building Survey\Existing Buildings\301 Mission\Monitoring\Program\Settlement Markers\2009 Differential Elevation All (101303).dwg



Notes:

Contours represent differential elevation, in inches, between the highest point and all other points taken on November 5, 2009.
Level B-1 at Mid-Rise Parking portion of survey site is approximately 4 inches higher than Level B-1 at High-Rise Tower portion.
The PG&E vault is inaccessible for monitoring.

Contour intervals are different between the High-Rise Tower and the Low-Rise Tower.

MAXIMUM DIFFERENTIAL

High-Rise Tower	Low-Rise Tower
0.467 feet (5.60 inches)	0.157 feet (1.89 inches)

Legend:
 ● Settlement Marker No. 83
 ■ PG&E Vault

January 2010

ARUP

From: Brian Dykes <bdykes@transbaycenter.org>
Sent: Monday, March 15, 2010 10:59 AM
To: Sean Jeffries; Steven Hood; rgolesorkhi@treadwellrollo.com; derrick.roorda@de-simone.com
Cc: Robert Beck; Andrew W. Schwartz; Sheryl Bregman
Subject: Results of Settlement Surveys at 301 Mission Street
Attachments: 2010-03-12_Memo_301 Mission Settlement Results.pdf

CONFIDENTIAL INFORMATION

In accordance with the easement agreement between Millennium Partners and the TJPA, attached are the results of the settlement surveys at 301 Mission Street as recorded from April 2009 to March 1st 2010. This information is not for public release.

Brian Dykes
Principal Engineer
Transbay Joint Powers Authority
201 Mission Street, Suite 2100
San Francisco, CA 94105
415 597 4617 phone
415 597 4615 fax

Check out our progress at <http://temporaryterminal.org/webcam>

NOTE: This e-mail communication and any attachments hereto are covered by the Electronic Communications Privacy Act, 18 U.S.C. Sections 2510-2521, and are legally privileged. The information contained herein is confidential, and is intended only for the use of the individual or entity to whom it is addressed. If you are not the intended recipient of this e-mail communication (or an employee or agent responsible for delivering this communication to its intended recipient(s)), you are hereby notified that any retention, copying or further distribution of this e-mail communication and any attachments is strictly prohibited. If you are not the intended recipient, please notify the sender by telephoning 415-597-4620, or by forwarding an e-mail reply message addressed to TransAdmin@TransbayCenter.org confirming that you have already destroyed (deleted) the original e-mail communication and any and all copies thereof. Thank you.

To	Brian Dykes (TJPA)	Reference number
		132242/dk
cc	Robert Beck (TJPA) Gerry McClelland (PMPC), Randy Volenec (PCPA) George Metzger (AAI)	File reference
From	Deme Koutsoftas Nick O'Riordan	Date
		March 12, 2010
Subject	Transbay Transit Center: Results of Settlement Surveys at the 301 Mission Property	

Under Arup's Geotechnical Contract with the Transbay Joint Powers Authority (TJPA) through Pelli Clark Pelli Architects (PCPA), Arup is required to monitor the settlements of the buildings adjacent to the Transbay Transit Center (TTC) prior to and during construction. We began the monitoring program for the 301 Mission property in April of 2009 in anticipation of construction commencing in 2010 on the east end of the TTC.


Progress results of the monitoring program were presented in a memorandum dated October 15, 2009, which described the instrumentation, the scope of the monitoring program and results measured up to September 1, 2009. This memorandum updates the results of the monitoring program to include the measurements made between September 1, 2009 and March 1, 2010.


1. Plate 1 summarizes the results of the latest survey conducted on March 1, 2010 as floor elevations at the first basement level under the Tower and the Podium structures. Comparison of the high and low points under the high-rise Tower indicate a maximum differential settlement of 5.8 inches; and under the Podium of approximately 2 inches.
2. Plate 2 summarizes differential floor elevations based on the latest survey of March 1, 2010, and it is just another way of presenting the data shown on Plate 1.
3. Plate 3 shows contours of incremental settlements determined from the surveys, conducted on April 30, 2009 (baseline) and the latest survey of March 1, 2010. The results indicate an incremental settlement under the Tower of up to 0.76 inches, and under the Podium of 0.2 inches. The middle and east side of the Podium appear to be fairly level.
4. Plates 4 and 5 present plots of settlements versus time from selected monitoring points under the Tower and Podium, respectively. Over the approximately 300-day monitoring period the settlements under the Tower range from 0.25 to 0.76 inches. As reflected in Plate 3, there is an area of differential settlements along the southern portion of the Tower and the portion of the basement below the driveway where differential settlements are developing and appear to be increasing with time.
5. Under the Podium the incremental settlements are very small as reflected by the plot of settlements versus time on Plate 5. The differential settlements appear to be increasing with time between the Podium and the Tower. Near the north end of the interface between the two areas the incremental differential settlement measured over the duration of the monitoring program is approaching 0.5 inches, while at the southern end the incremental differential settlement is on the order of 0.2 inches.

-
6. The results of the current monitoring program have been combined with settlement data provided by Millennium partners, and are presented on a semi-logarithmic plot on Plate 6.
 7. Periodic surveys of settlements will continue on a monthly basis until construction of the Transbay Transit Center begins.

List of Plates

- | | |
|---------|---|
| Plate 1 | Floor Elevations at Level B-1 of 301 Mission Property: Periodic Survey – March 1, 2010 |
| Plate 2 | Differential Floor Elevation (Inches) – March 1, 2010 Survey |
| Plate 3 | Contours of Settlements Measured at the First Level Basement of the 301 Mission Street Structure Between April 30, 2009 and March 1, 2010 |
| Plate 4 | Settlement Over Time Floor Elevations at Level B-1 of 301 Mission Property – Tower: April 30, 2009 through March 1, 2010. |
| Plate 5 | Settlement Over Time Floor Elevations at Level B-1 of 301 Mission Property – Midrise: April 30, 2009 through March 1, 2010 |
| Plate 6 | Settlements of the 301 Mission Tower Including Monitoring During Construction |

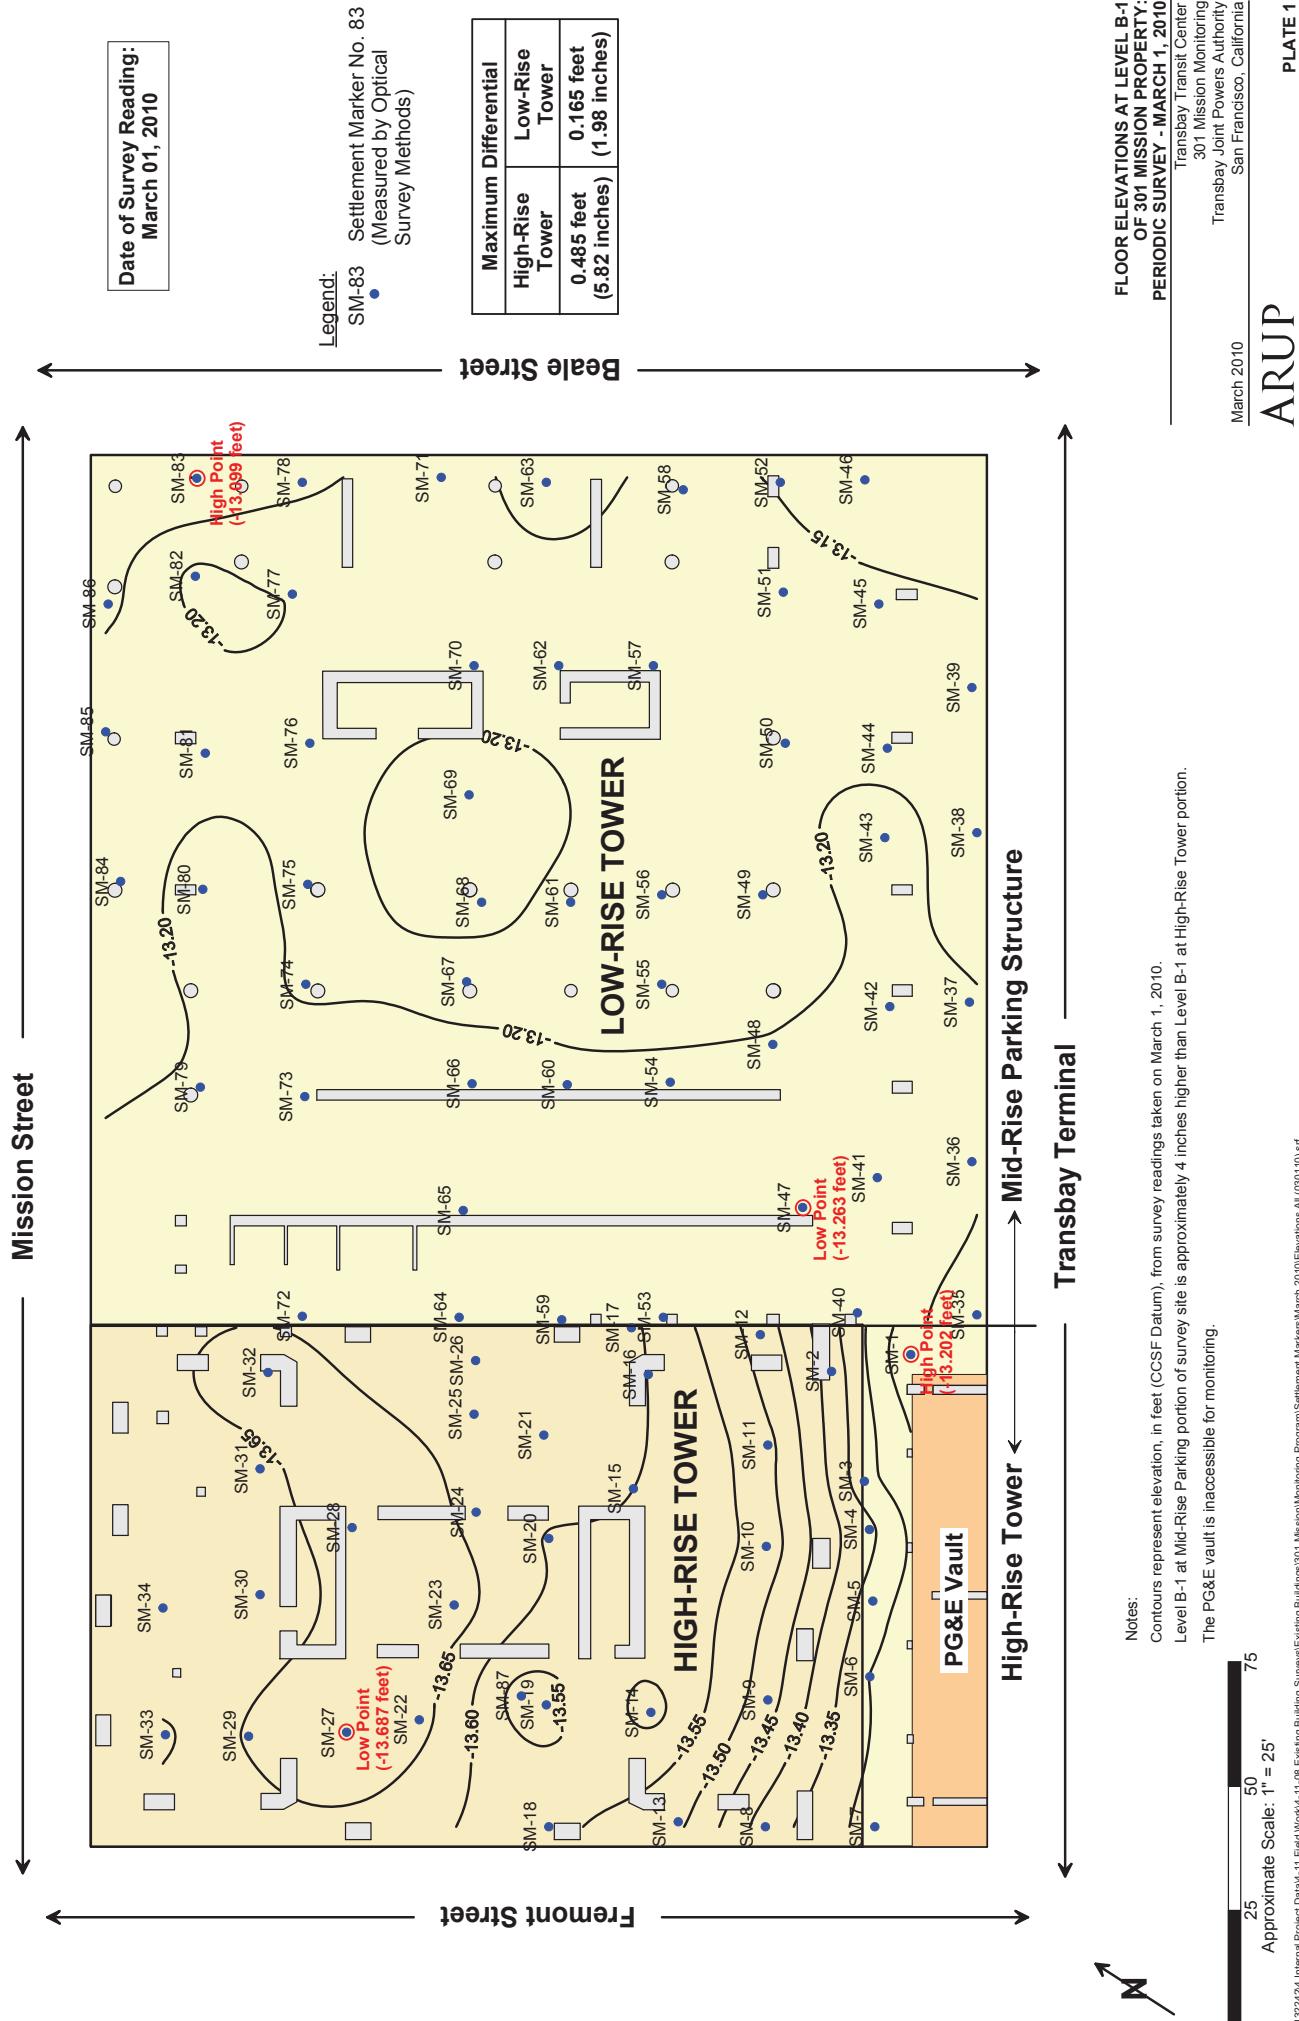

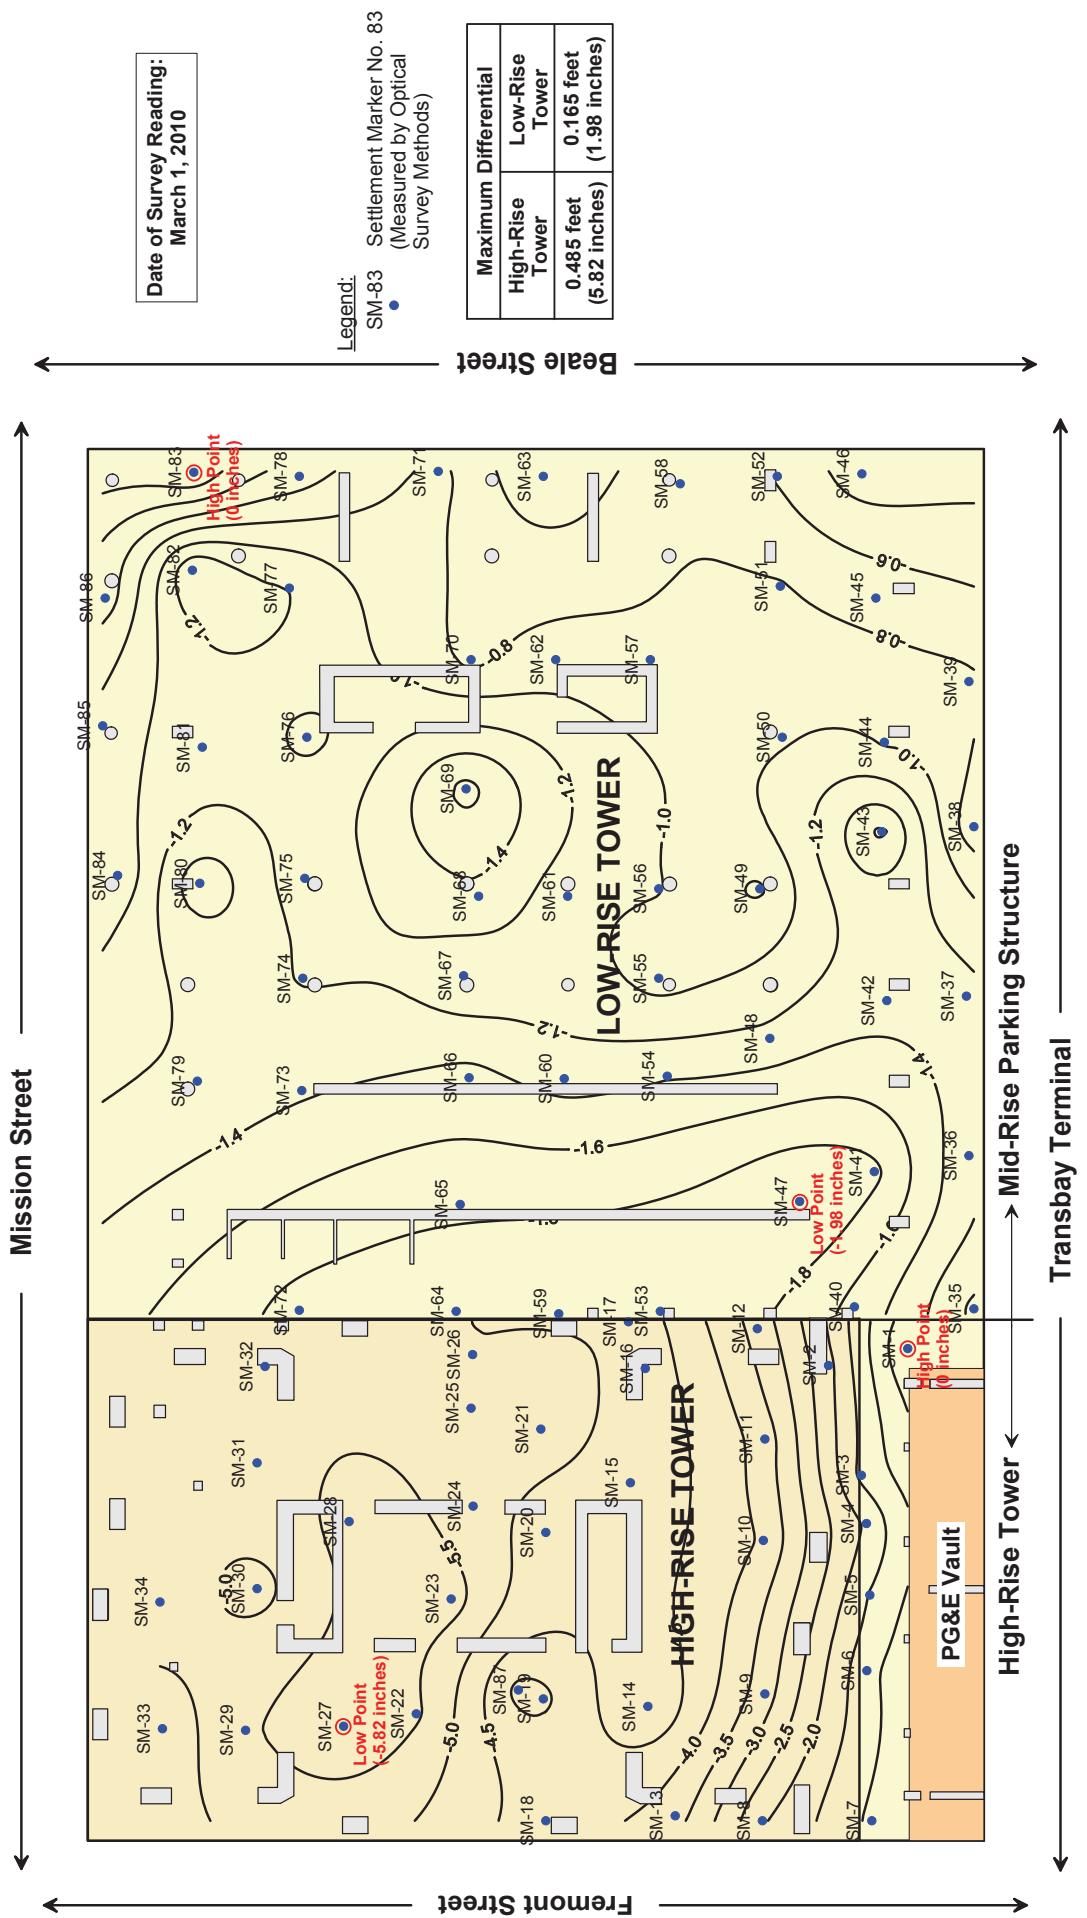

**DIFFERENTIAL FLOOR ELEVATION (INCHES)
MARCH 1, 2010 SURVEY**

Transbay Transit Center
301 Mission Monitoring
Transbay Joint Powers Authority
San Francisco, California

March 2010


ARUP

Notes:

Contours represent differential elevation, in inches, between the highest point and all other points taken on March 1, 2010.
Level B-1 at Mid-Rise Parking portion of survey site is approximately 4 inches higher than Level B-1 at High-Rise Tower portion.
The PG&E vault is inaccessible for monitoring.
Contour intervals are different between the High-Rise Tower and the Low-Rise Tower.

Approximate Scale: 1" = 25'
0 25 50 75

01122424 Internal Project Doc#4-11 Field Work#4-11-08 Existing Building Survey Existing Buildings/Mission Monitoring Program Settlement Marks/March 2010 Differential Elevation All (03910).srf

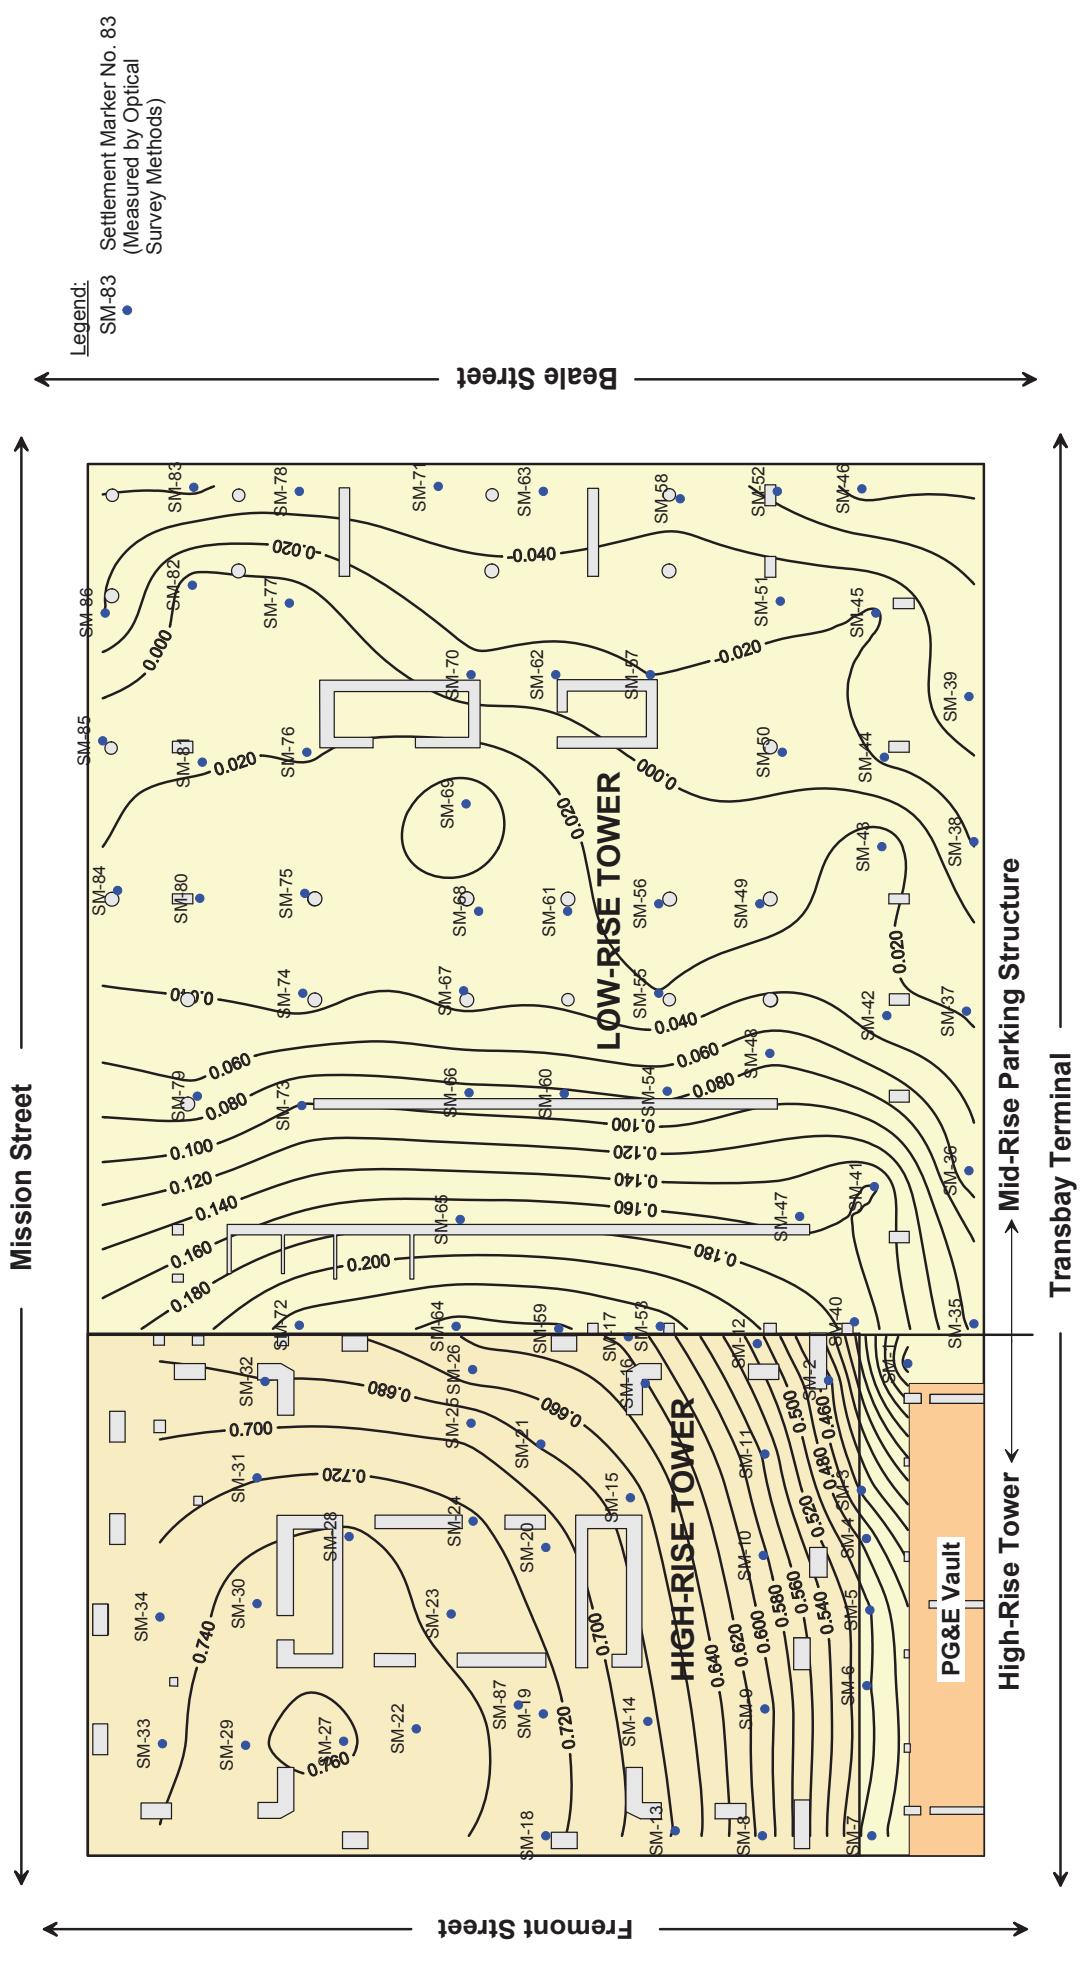



CONTOURS OF SETTLEMENTS MEASURED AT THE FIRST LEVEL BASEMENT OF THE 301 MISSION STREET STRUCTURE BETWEEN APRIL 30, 2009 AND MARCH 1, 2010

Transbay Transit Center
301 Mission Monitoring
Transbay Joint Powers Authority
San Francisco, California

March 2010



0 25 50 75
Approximate Scale: 1" = 25'
01122424 Internal Project Data\4-11 Field Work\4-11-08 Existing Building Survey\Existing Buildings\301 Mission Monitoring Program\Settlement Markers\March 2010\Elevation changes All (030110).srf

ARUP
PLATE 3

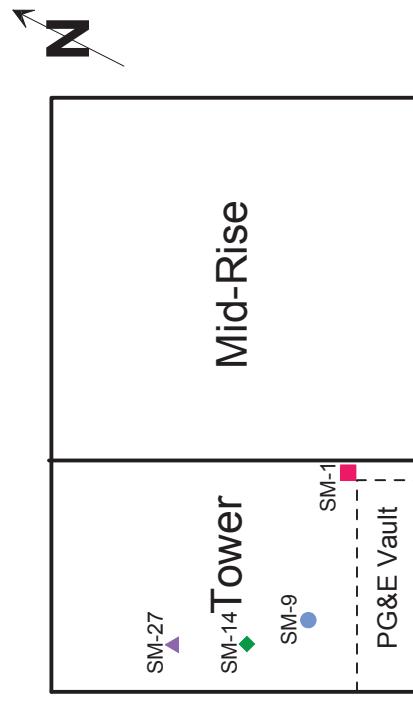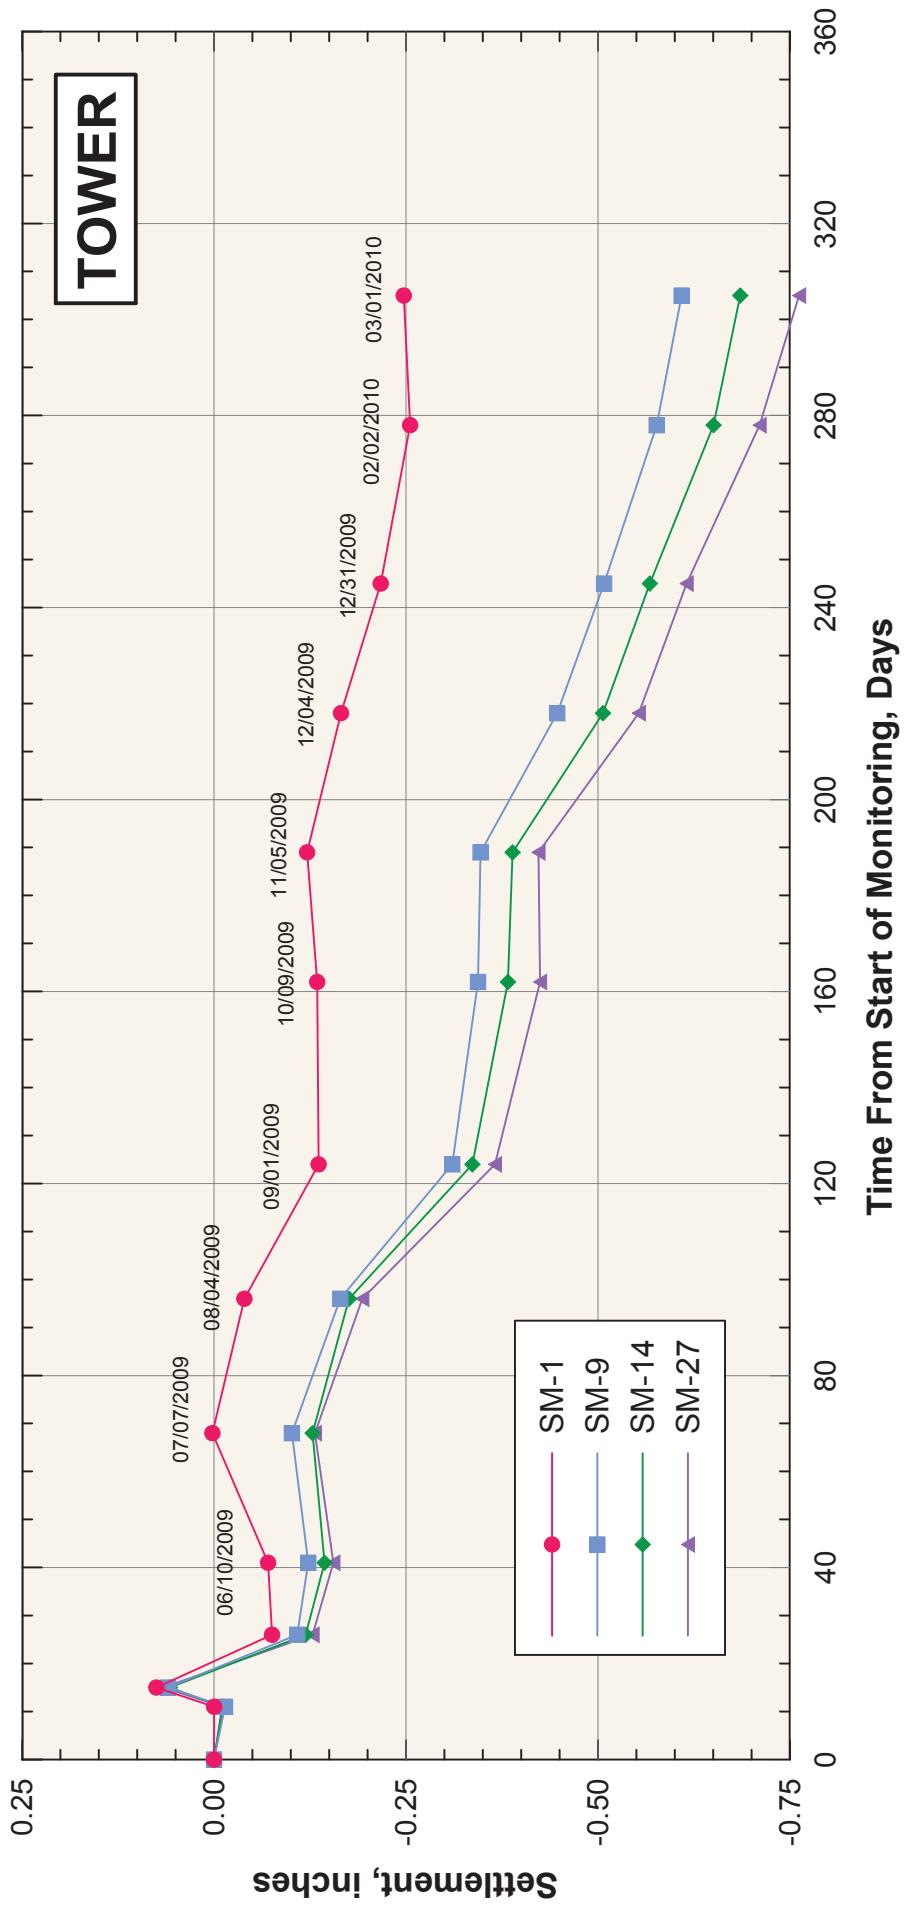

Note:
Initial (Baseline) reading
taken on 04/30/09

Q11322424 Internal Project Data-41 Field Work 41-08 Existing Building Surveys/Existing Buildings/301 Mission/Monitoring Program/Settlement Markers/March 2010/ Settlement Over Time

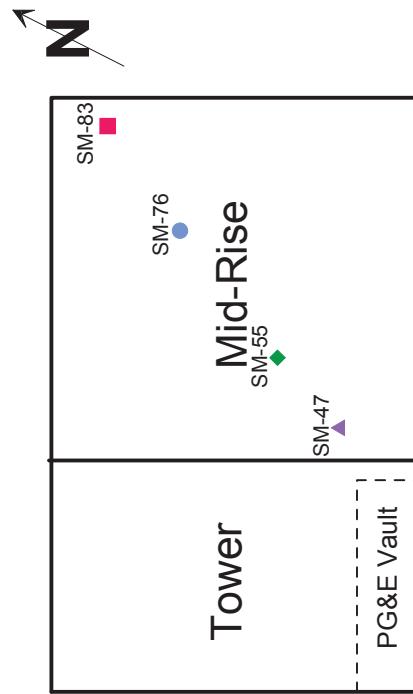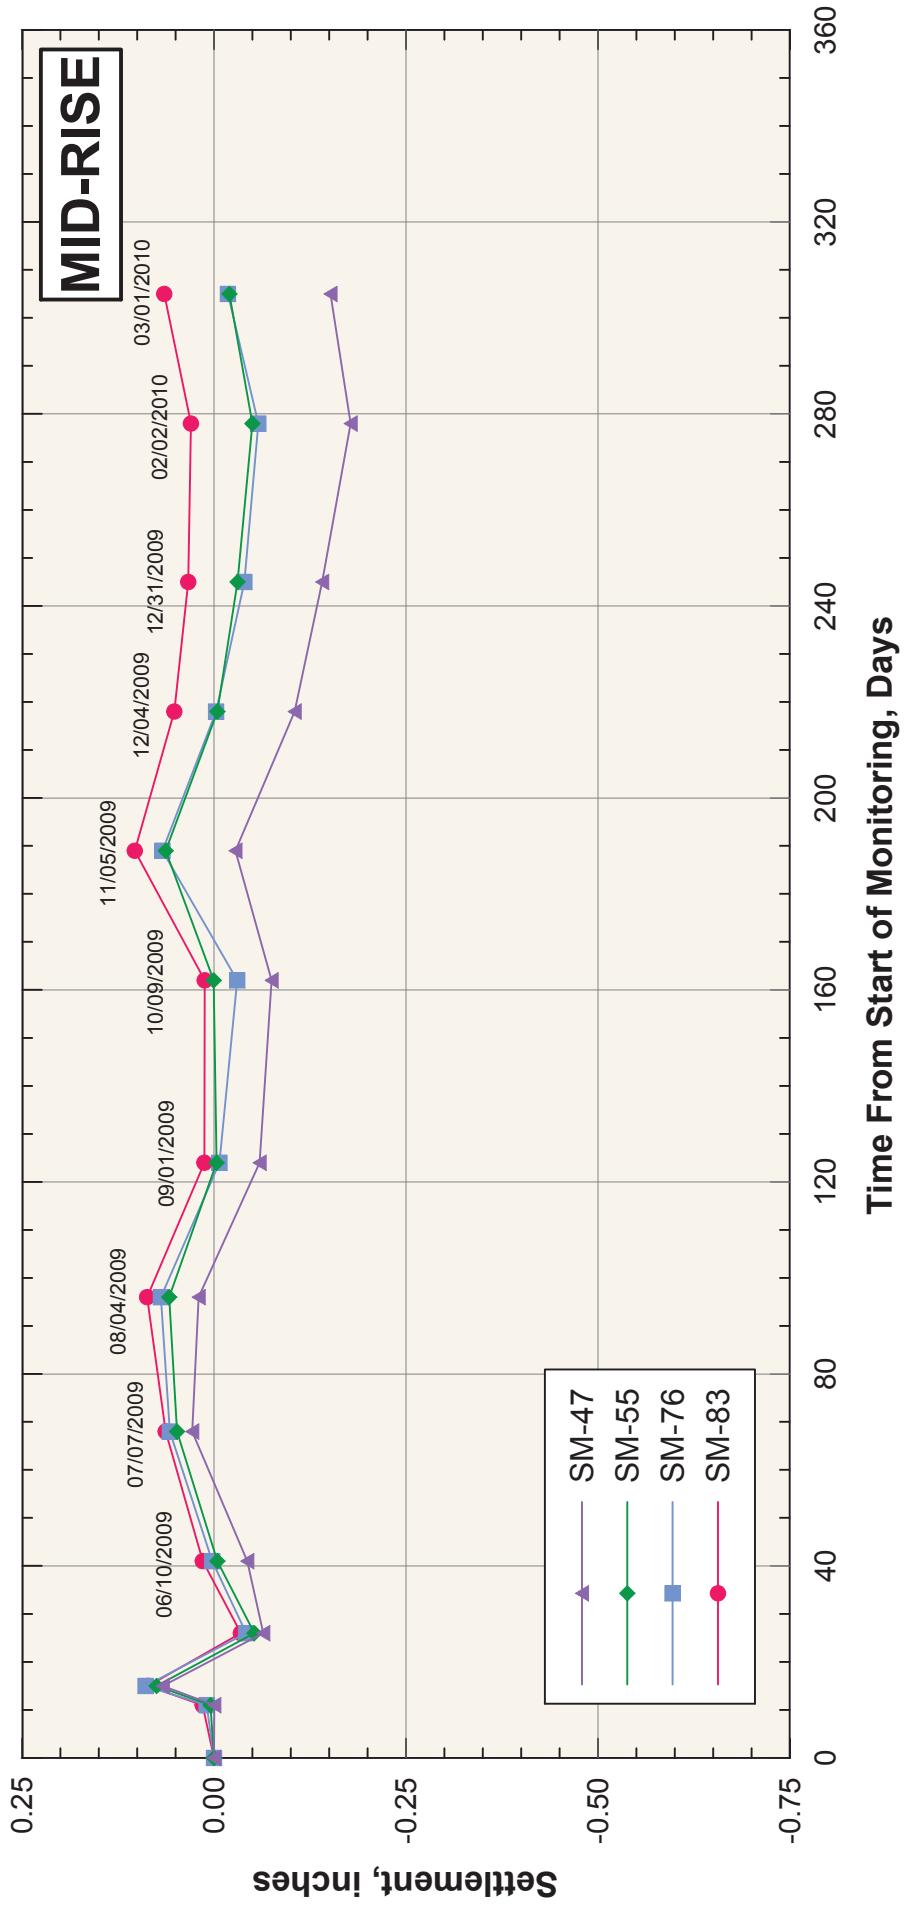

Note:
Initial (Baseline) reading
taken on 04/30/09

ARUP

PLATE 5

ARUP

**SETTLEMENT OVER TIME
FLOOR ELEVATIONS AT LEVEL B-1
OF 301 MISSION PROPERTY- MIDRISE:
APRIL 30, 2009 THROUGH MARCH 1, 2010**

Transbay Transit Center
301 Mission Monitoring
Transbay Joint Powers Authority
San Francisco, California


March 2010

ARUP

PLATE 5

ARUP

ARUP

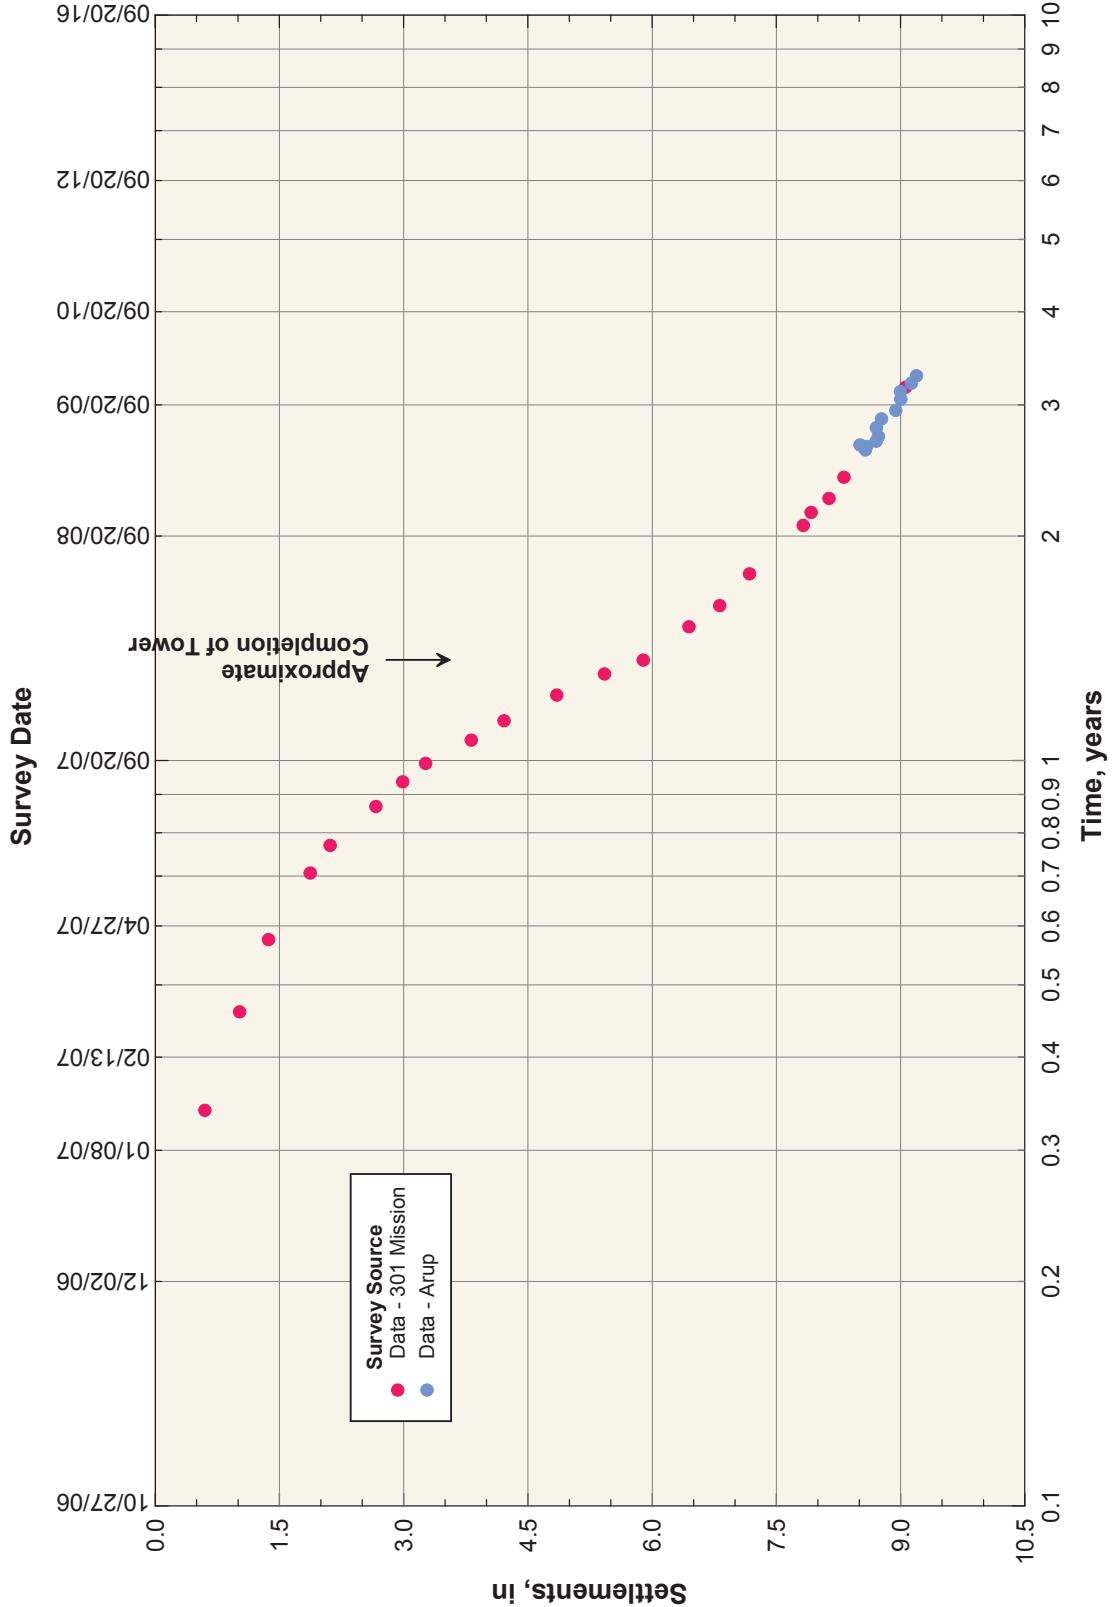

From: Brian Dykes
Sent: Friday, October 29, 2010 9:41 AM
To: Steven Hood; John Luciano
Subject: FW: Settlement of 301 Mission tower

Steve and John,
As per your request, I am sending you the latest settlement plot.
Brian.

From: Nick O'Riordan [<mailto:nick.oriordan@arup.com>]
Sent: Wednesday, October 20, 2010 9:04 AM
To: Brian Dykes
Cc: DeeDee Maggi; Kevin Clinch
Subject: Settlement of 301 Mission tower


Brian, As discussed yesterday, I attach the current settlement plot. The most recent survey date was 30 September. The trend continues, but with a slight reduction in creep rate over the past 6 months. Regards Nick


Nick O'Riordan
Principal | Leader Geotechnics

Arup
560 Mission Street, 7th Floor, San Francisco, CA 94105, USA
t +1 415 957 9445 d +1 415 963 3886
f +1 415 963 3886 m +1 415 774 6506
www.arup.com

Check out our progress at <http://transbaycenter.org/construction-updates/construction-cameras>

NOTE: This e-mail communication and any attachments hereto are covered by the Electronic Communications Privacy Act, 18 U.S.C. Sections 2510-2521, and are legally privileged. The information contained herein is confidential, and is intended only for the use of the individual or entity to whom it is addressed. If you are not the intended recipient of this e-mail communication (or an employee or agent responsible for delivering this communication to its intended recipient(s)), you are hereby notified that any retention, copying or further distribution of this e-mail communication and any attachments is strictly prohibited. If you are not the intended recipient, please notify the sender by telephoning 415-597-4620, or by forwarding an e-mail reply message addressed to TransAdmin@TransbayCenter.org confirming that you have already destroyed (deleted) the original e-mail communication and any and all copies thereof. Thank you.

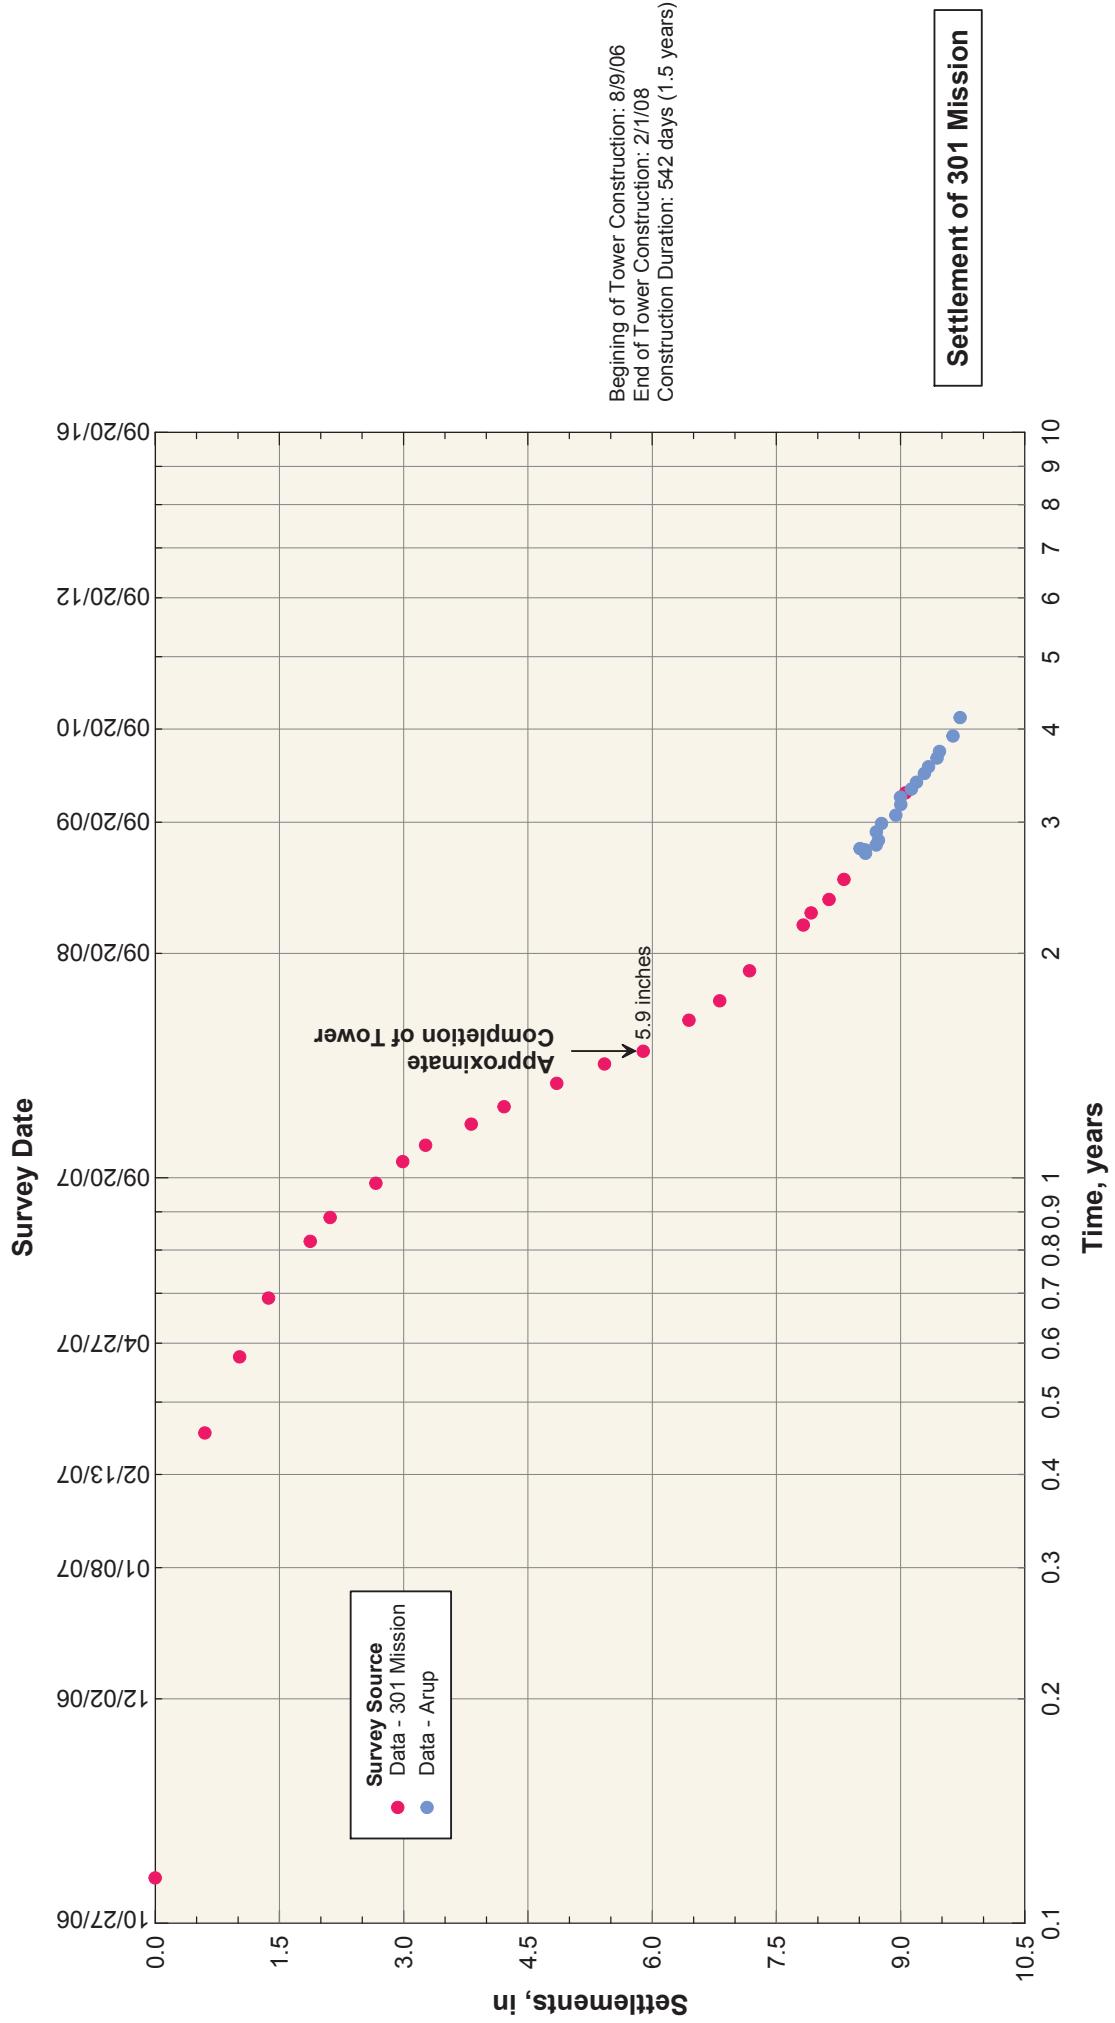

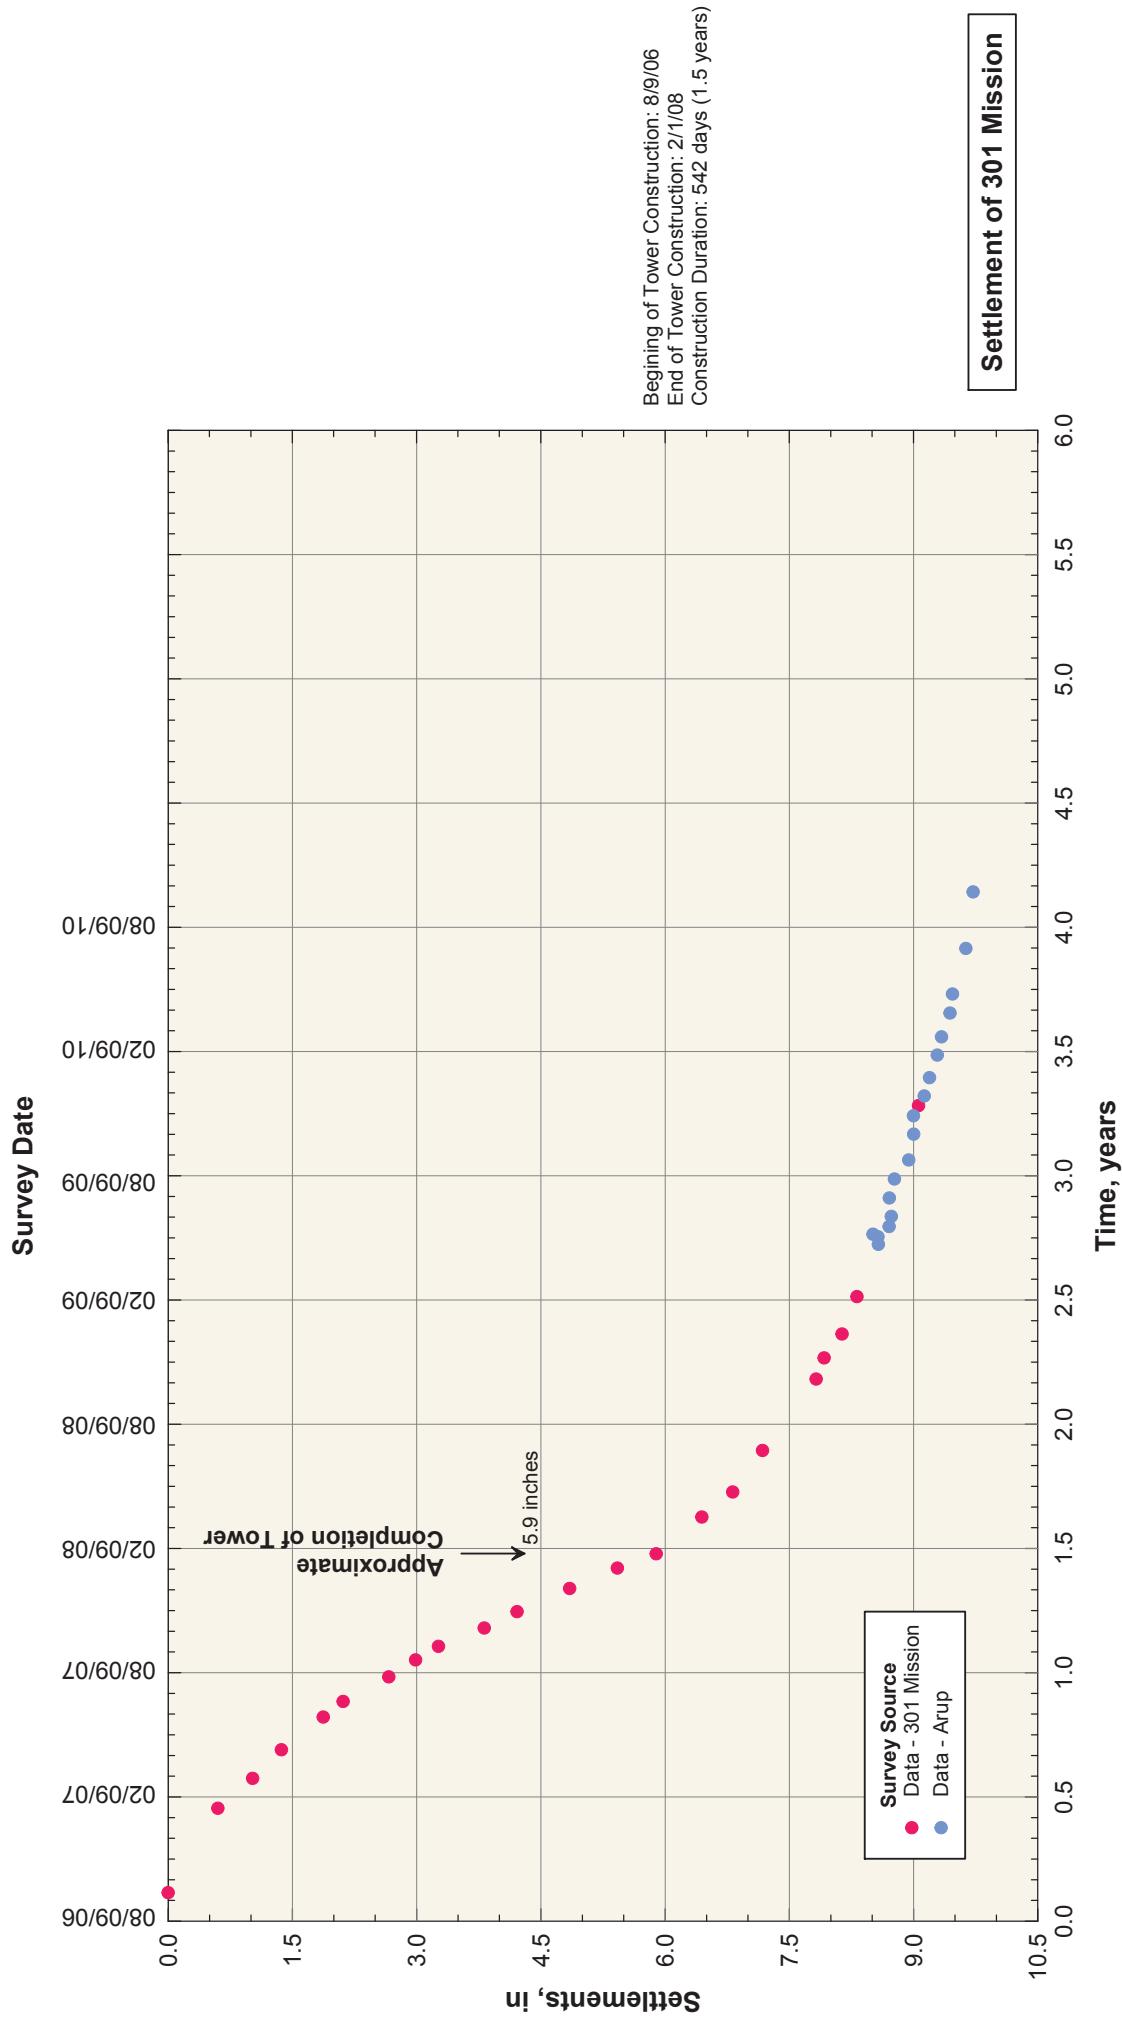

From: Brian Dykes
Sent: Friday, January 14, 2011 4:31 PM
To: Steven Hood; John Luciano; Sean Jeffries
Cc: Nick O'Riordan
Subject: December Settlement Monitoring at 301 Mission Street
Attachments: 2011-01-05 Memo_301 Mission Settlement - Dec 2010 Survey.pdf

Categories: Adjacent Properties

Steve,
In response to your request during last month's demolition of the old Transbay Terminal I requested that Arup provide the latest settlement monitoring readings as surveyed during December.
Attached is the Arup memo dated January 5, 2011 with the plots of the survey records taken on December 9, 2010.
These records show that the tower building has continued to settle at the same rate that has been observed for the past 19 months (04/30/09 – 12/09/10).
Brian.

Brian Dykes
Principal Engineer
Transbay Joint Powers Authority
201 Mission Street, Suite 2100
San Francisco, CA 94105
415 597 4617 phone
415 597 4615 fax

Check out our progress at <http://transbaycenter.org/construction-updates/construction-cameras>

NOTE: This e-mail communication and any attachments hereto are covered by the Electronic Communications Privacy Act, 18 U.S.C. Sections 2510-2521, and are legally privileged. The information contained herein is confidential, and is intended only for the use of the individual or entity to whom it is addressed. If you are not the intended recipient of this e-mail communication (or an employee or agent responsible for delivering this communication to its intended recipient(s)), you are hereby notified that any retention, copying or further distribution of this e-mail communication and any attachments is strictly prohibited. If you are not the intended recipient, please notify the sender by telephoning 415-597-4620, or by forwarding an e-mail reply message addressed to TransAdmin@TransbayCenter.org confirming that you have already destroyed (deleted) the original e-mail communication and any and all copies thereof. Thank you.

Memorandum




To	Brian Dykes (TJPA)	Date
		January 5, 2011
Copies	Robert Beck (TJPA) Emilio Cruz (PMPC) Randy Volenec (PCPA) George Metzger (AAI)	Reference number 132242-60/SMM
From	Stephen McLandrich (Arup) Nick O'Riordan (Arup) Kevin Clinch (Arup)	File reference 4-05 112
Subject	Transbay Transit Center: Results of December 2010 Settlement Survey at 301 Mission Property	Page 1 of 1

Under Arup's Geotechnical Contract with the Transbay Joint Powers Authority through Pelli Clark Pelli Architects, Arup is required to monitor the settlements of the buildings adjacent to the Transbay Transit Center prior to and during construction. We began the monitoring program for the 301 Mission property in April of 2009. This memorandum and the attached plates present an update to our memorandum dated March 12, 2010 with measurements made through December 2010.

List of Plates


- Plate 1 Floor Elevations at Level B-1 of 301 Mission Property: Periodic Survey – December 9, 2010
- Plate 2 Differential Floor Elevation (Inches) – December 9, 2010 Survey
- Plate 3 Contours of Settlements Measured at the First Level Basement of the 301 Mission Street Structure Between April 30, 2009 and December 9, 2010
- Plate 4 Settlement Over Time Floor Elevations at Level B-1 of 301 Mission Property – Tower: April 30, 2009 through December 9, 2010.
- Plate 5 Settlement Over Time Floor Elevations at Level B-1 of 301 Mission Property – Mid-Rise: April 30, 2009 through December 9, 2010
- Plate 6 Settlements of the 301 Mission Tower Including Monitoring During Construction

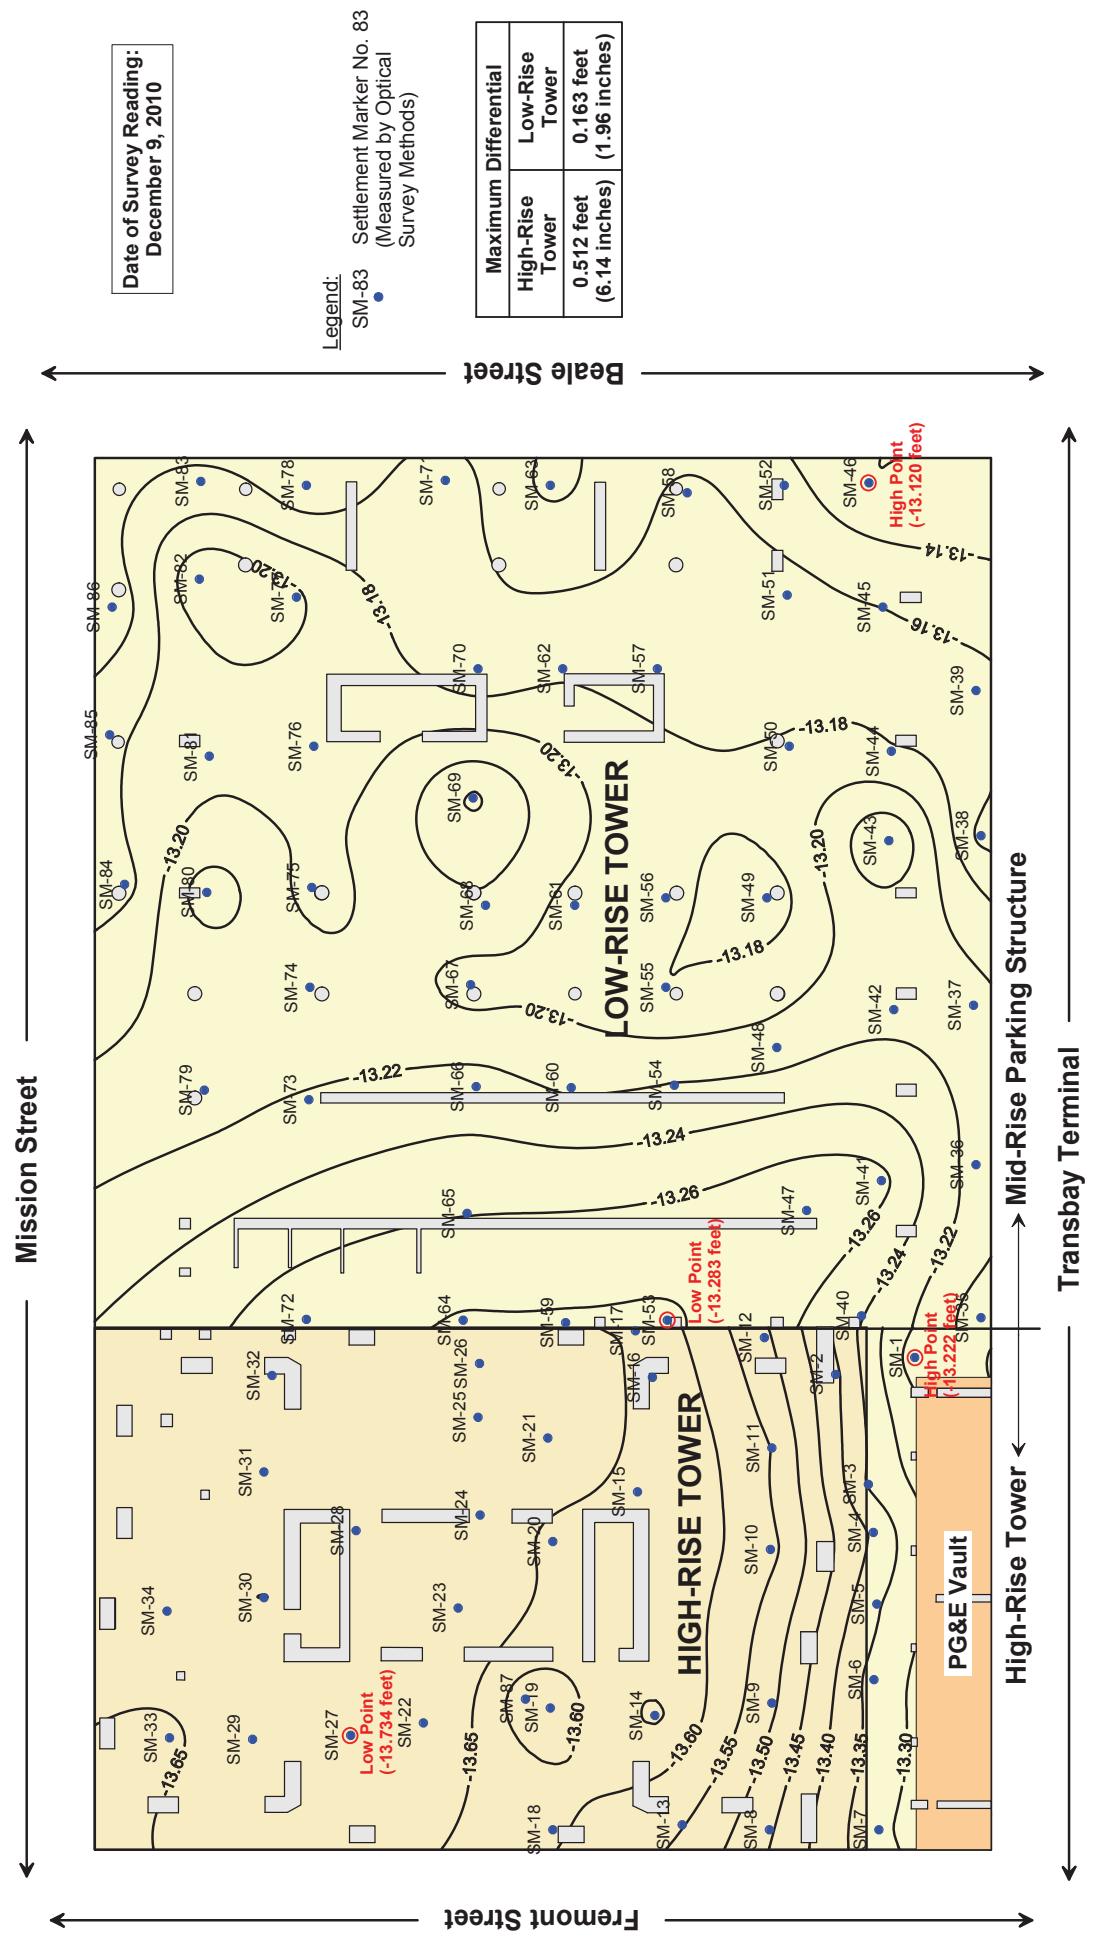


**FLOOR ELEVATIONS AT LEVEL B-1
OF 301 MISSION PROPERTY:
PERIODIC SURVEY - DECEMBER 9, 2010**


January 2011

Transbay Transit Center
301 Mission Monitoring
Transbay Joint Powers Authority
San Francisco, California

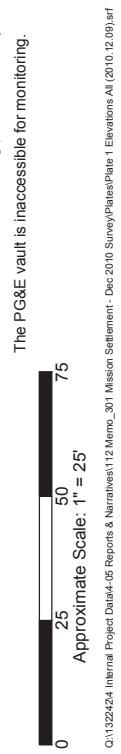

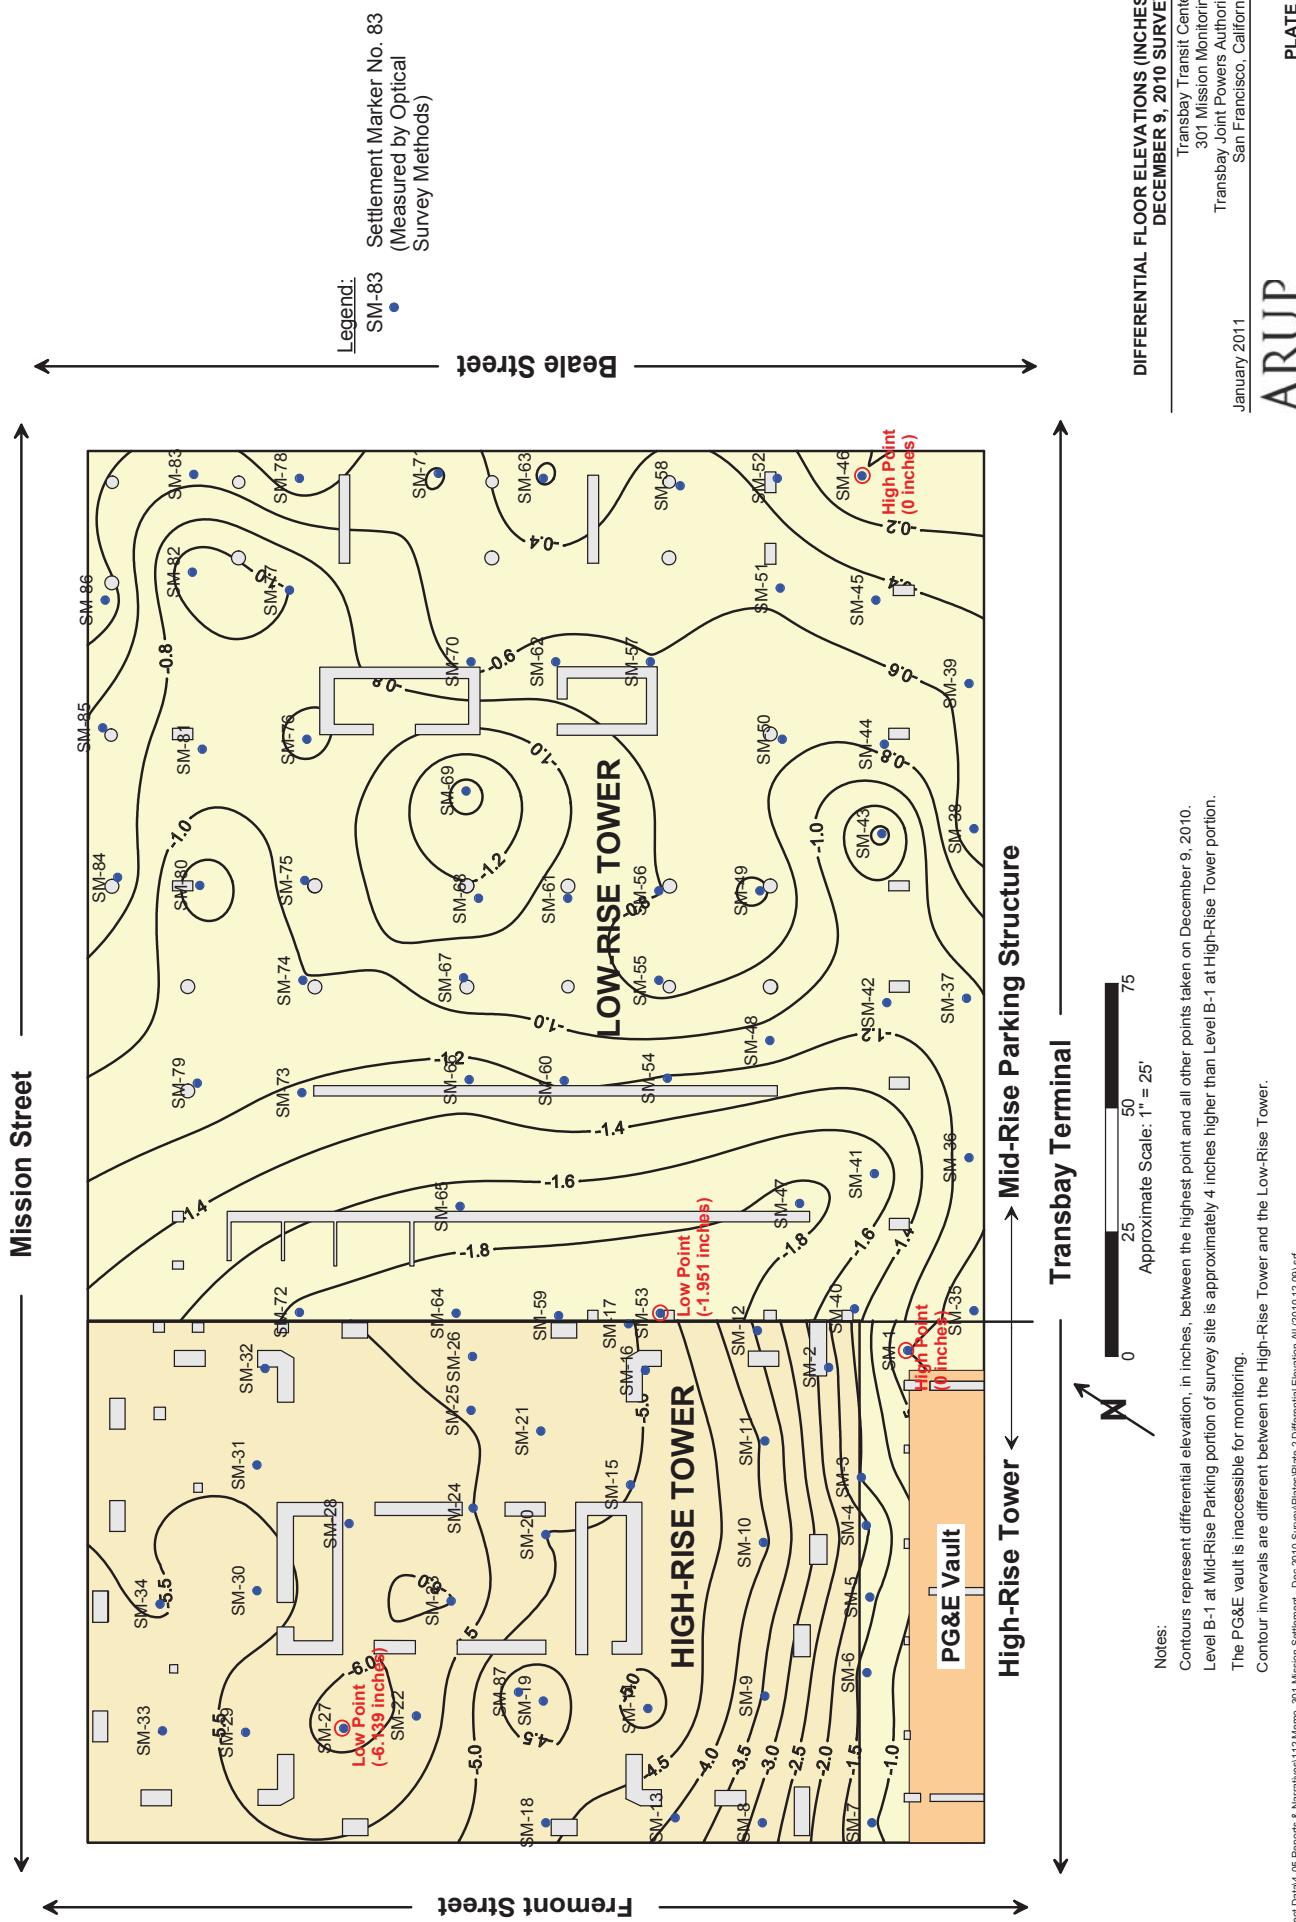

210

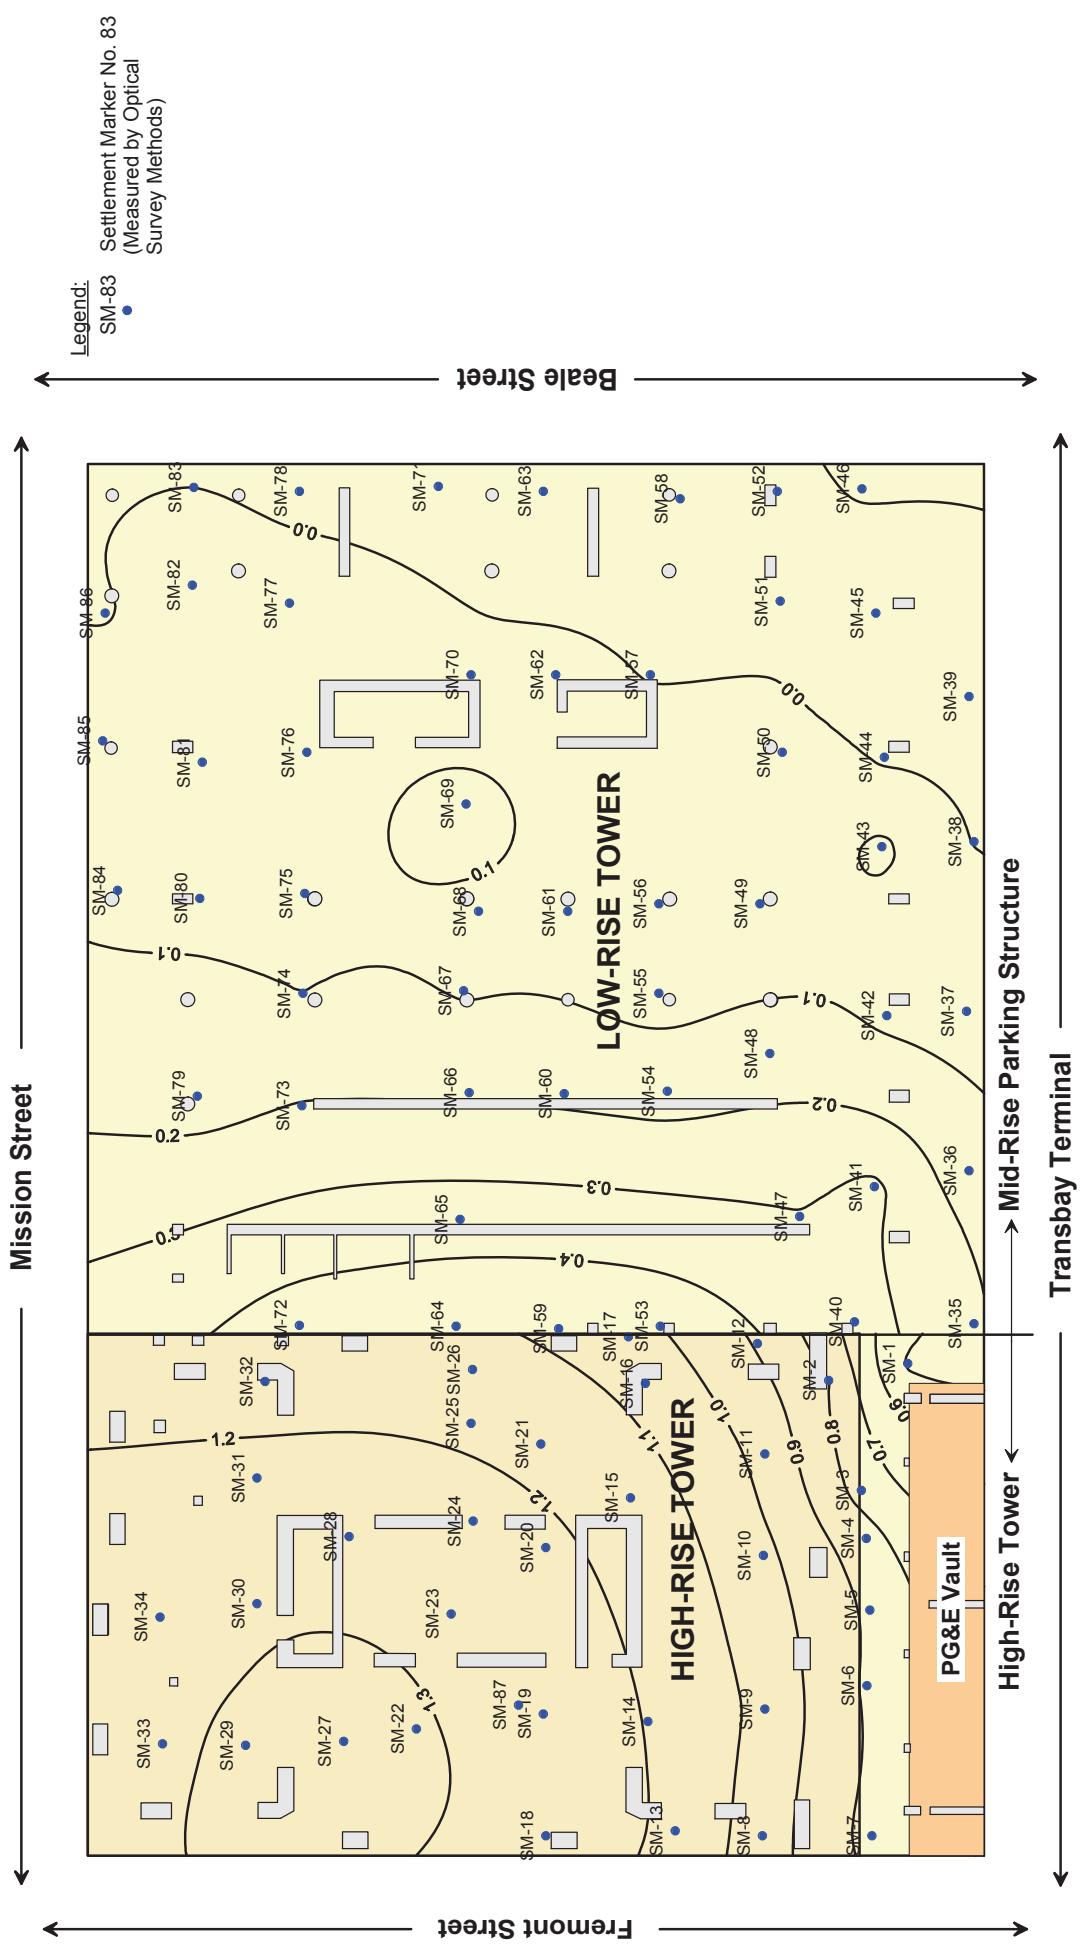

CONTENTS OF SETTLEMENTS MEASURED AT THE FIRST LEVEL BASEMENT OF THE 301 MISSION STREET STRUCTURE BETWEEN APRIL 30, 2009 AND DECEMBER 9, 2010

NOTES:



Contours represent elevation change, in inches, between Baseline survey (April 30, 2009) and readings taken on December 9, 2010. Level B-1 at Mid-Rise Parking portion of survey site is approximately 4 inches higher than Level B-1 at High-Rise Tower portion.

The PG&E vault is inaccessible for monitoring.

Negative values of settlement (within Low-rise Tower) indicate uplift.

January 2011

TOWER

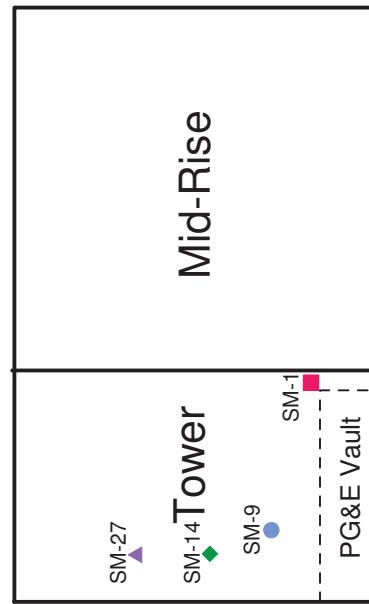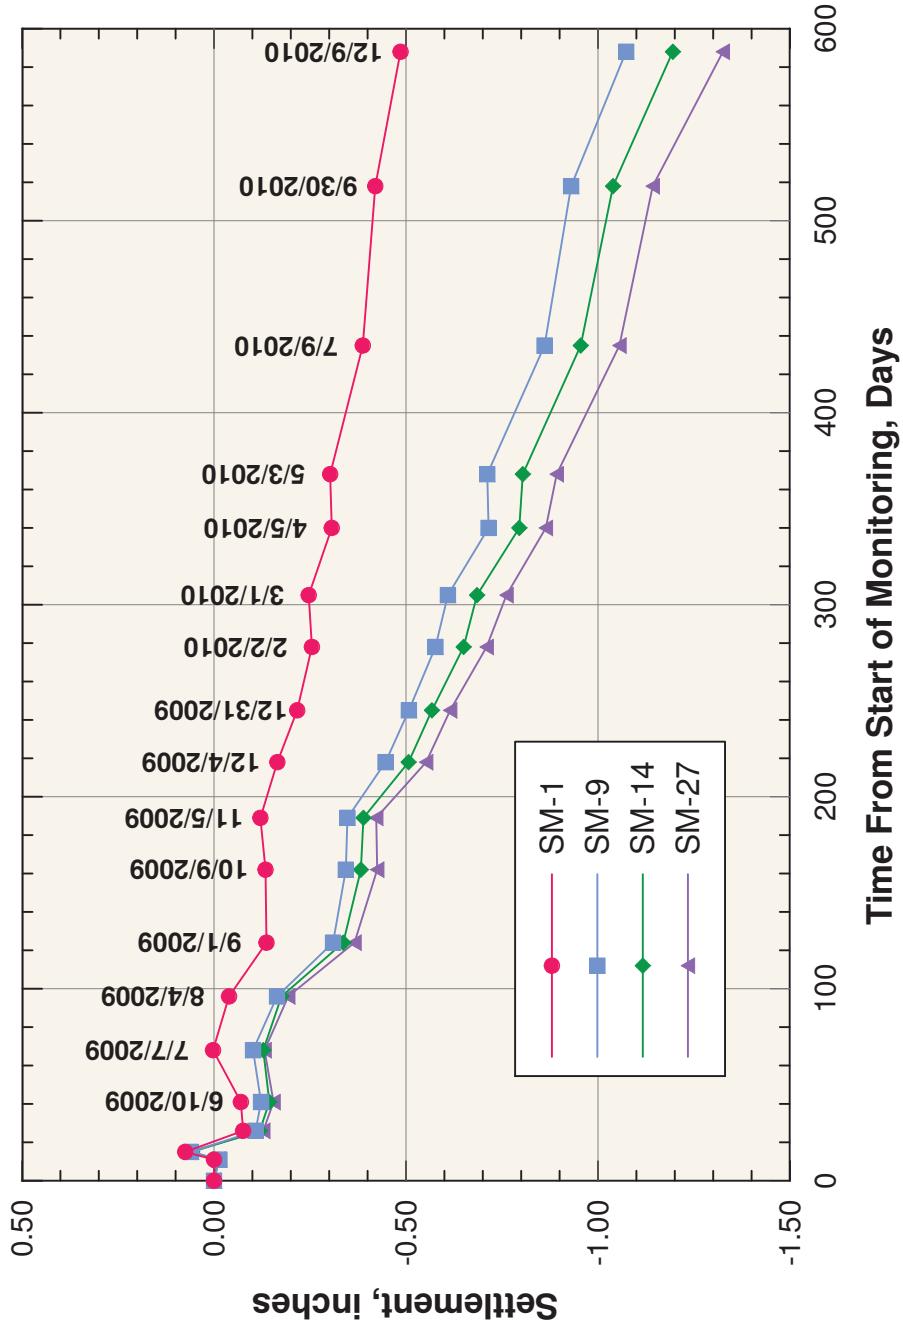

Note:
Initial (Baseline) reading
taken on 04/30/09



ARUP

SETTLEMENT OVER TIME
FLOOR ELEVATIONS AT LEVEL B-1
OF 301 MISSION PROPERTY- TOWER:
APRIL 30, 2009 THROUGH DECEMBER 9, 2010


Transbay Transit Center
301 Mission Monitoring
Transbay Joint Powers Authority
San Francisco, California

January 2011

MID-RISE

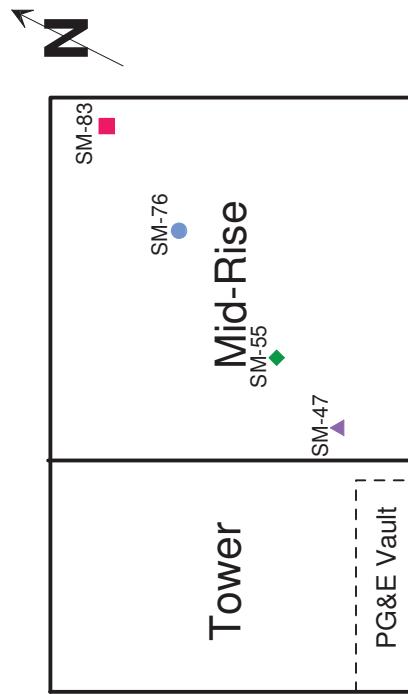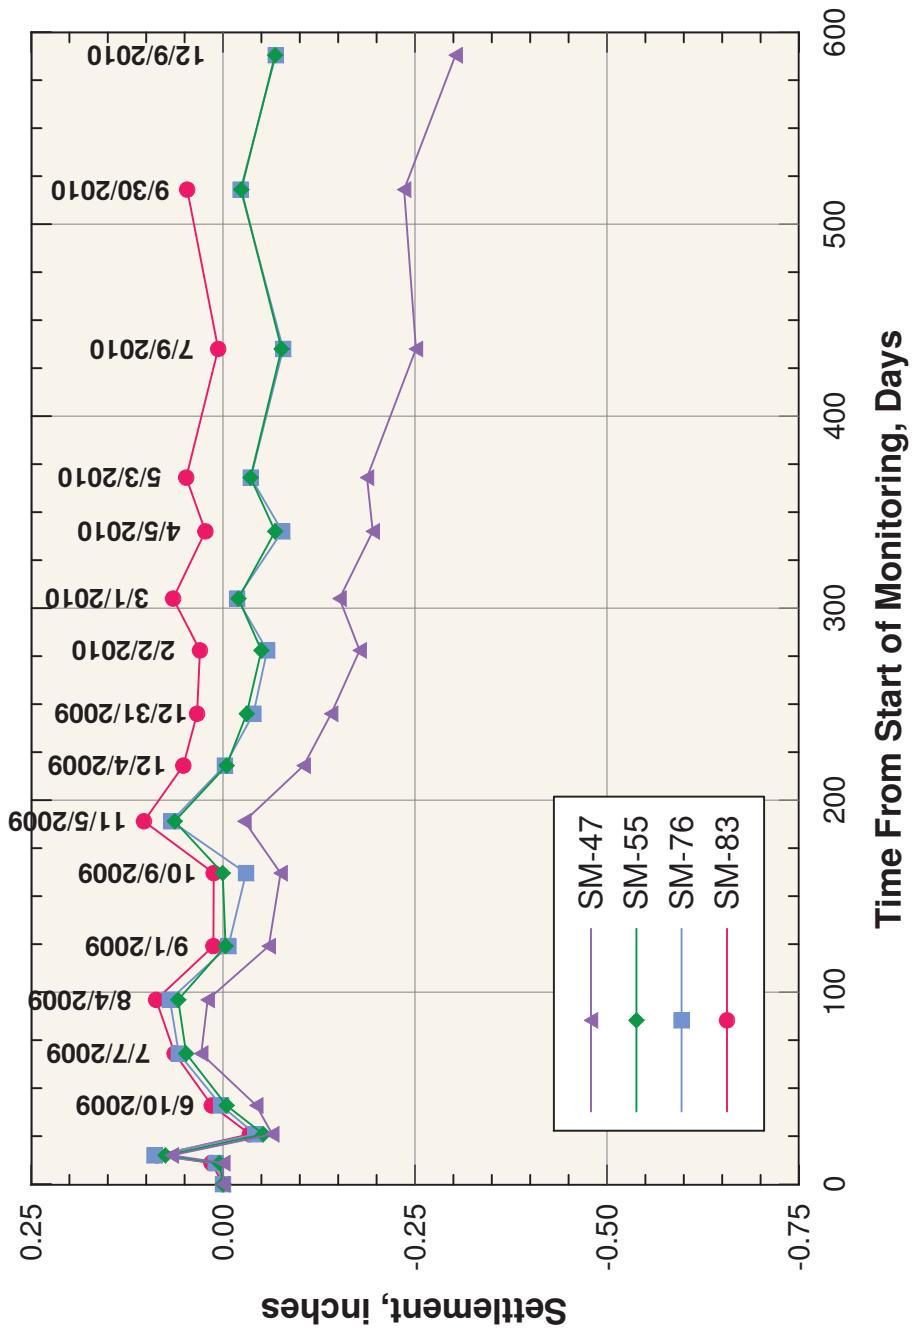

Note:
Initial (Baseline) reading
taken on 04/30/09

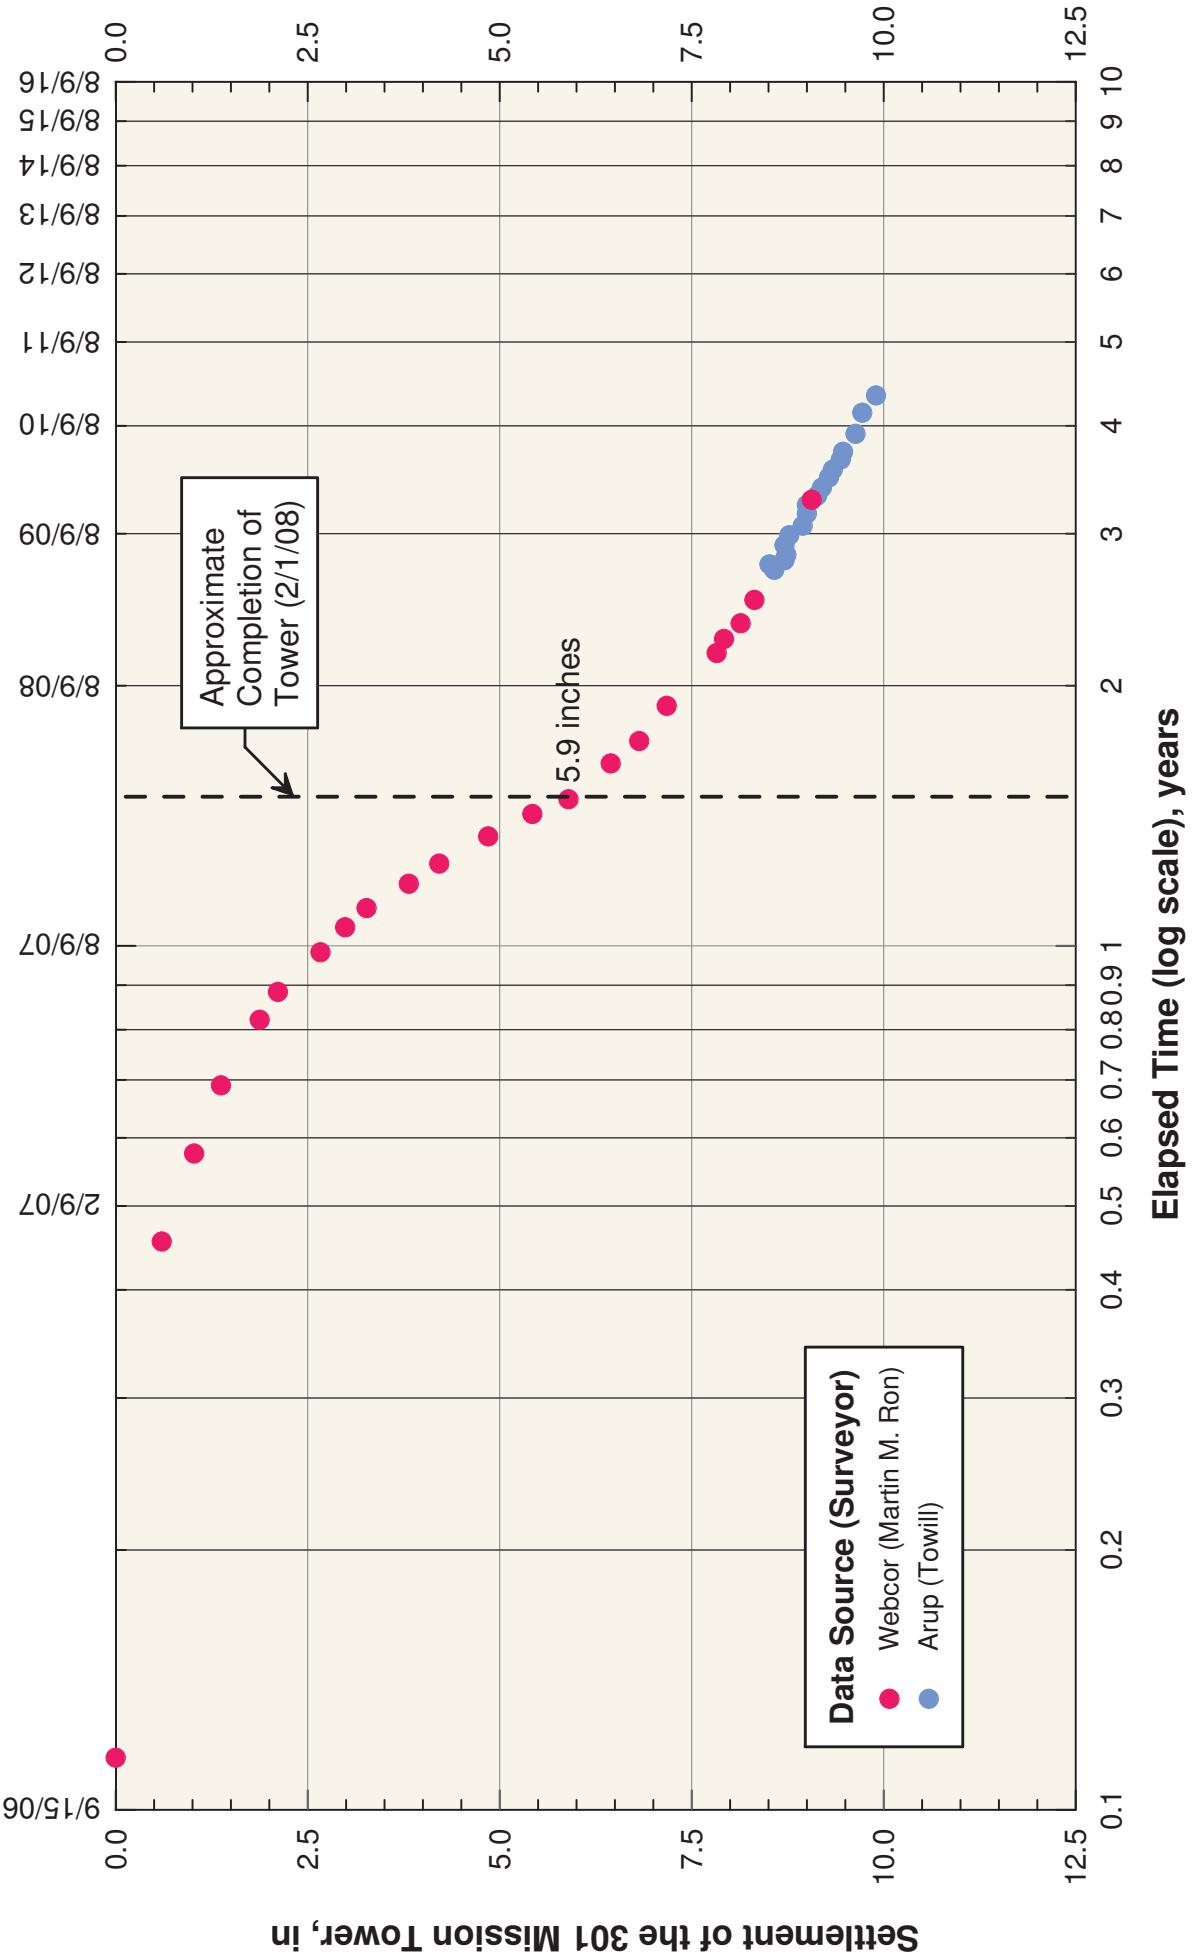

**SETTLEMENTS OF THE 301 MISSION TOWER
INCLUDING MONITORING DURING CONSTRUCTION**

Transbay Transit Center
301 Mission Monitoring
Transbay Joint Powers Authority
San Francisco, California

January 2011

Beginning of Tower Construction: 8/9/06
End of Tower Construction: 2/1/08
Construction Duration: 542 days (1.5 years)

From: Brian Dykes
Sent: Monday, February 28, 2011 2:57 PM
To: Steven Hood; John Luciano
Cc: Rebecca Armenta
Subject: 301 Mission Street Settlement Readings February 2011
Attachments: 2011-02-24 Memo_301 Mission Settlement - Feb 2011 Survey.pdf

Follow Up Flag: Follow up
Flag Status: Completed

Categories: Adjacent Properties

Steven,
Here are the latest plots of the settlement readings as recorded on February 4, 2011.
Brian.

Brian Dykes
Principal Engineer
Transbay Joint Powers Authority
201 Mission Street, Suite 2100
San Francisco, CA 94105
415 597 4617 phone
415 597 4615 fax

Check out our progress at <http://transbaycenter.org/construction-updates/construction-cameras>

NOTE: This e-mail communication and any attachments hereto are covered by the Electronic Communications Privacy Act, 18 U.S.C. Sections 2510-2521, and are legally privileged. The information contained herein is confidential, and is intended only for the use of the individual or entity to whom it is addressed. If you are not the intended recipient of this e-mail communication (or an employee or agent responsible for delivering this communication to its intended recipient(s)), you are hereby notified that any retention, copying or further distribution of this e-mail communication and any attachments is strictly prohibited. If you are not the intended recipient, please notify the sender by telephoning 415-597-4620, or by forwarding an e-mail reply message addressed to TransAdmin@TransbayCenter.org confirming that you have already destroyed (deleted) the original e-mail communication and any and all copies thereof. Thank you.

Memorandum

ARUP


To	Brian Dykes (TJPA)	Date
		February 24, 2011
Copies	Robert Beck (TJPA) Emilio Cruz (PMPC) Randy Volenec (PCPA) George Metzger (AAI)	Reference number 132242-60/SMM
From	Stephen McLandrich (Arup) Nick O'Riordan (Arup) Kevin Clinch (Arup)	File reference 4-05 117
Subject	Transbay Transit Center: Results of February 2011 Settlement Survey at 301 Mission Property	Page 1 of 1

Under Arup's Geotechnical Contract with the Transbay Joint Powers Authority through Pelli Clark Pelli Architects, Arup is required to monitor the settlements of the buildings adjacent to the Transbay Transit Center prior to and during construction. We began the monitoring program for the 301 Mission property in April of 2009. This memorandum and the attached plates present an update to our memorandum dated January 5, 2011 with measurements made through February 2010.

List of Plates

- Plate 1 Floor Elevations at Level B-1 of 301 Mission Property: Periodic Survey – February 4, 2010
- Plate 2 Differential Floor Elevation (Inches) – February 4, 2010 Survey
- Plate 3 Contours of Settlements Measured at the First Level Basement of the 301 Mission Street Structure Between April 30, 2009 and February 4, 2010
- Plate 4 Settlement Over Time Floor Elevations at Level B-1 of 301 Mission Property – Tower: April 30, 2009 through February 4, 2010.
- Plate 5 Settlement Over Time Floor Elevations at Level B-1 of 301 Mission Property – Mid-Rise: April 30, 2009 through February 4, 2010
- Plate 6 Settlements of the 301 Mission Tower Including Monitoring During Construction


Note Typo: references to "2010" on this page should read "2011"

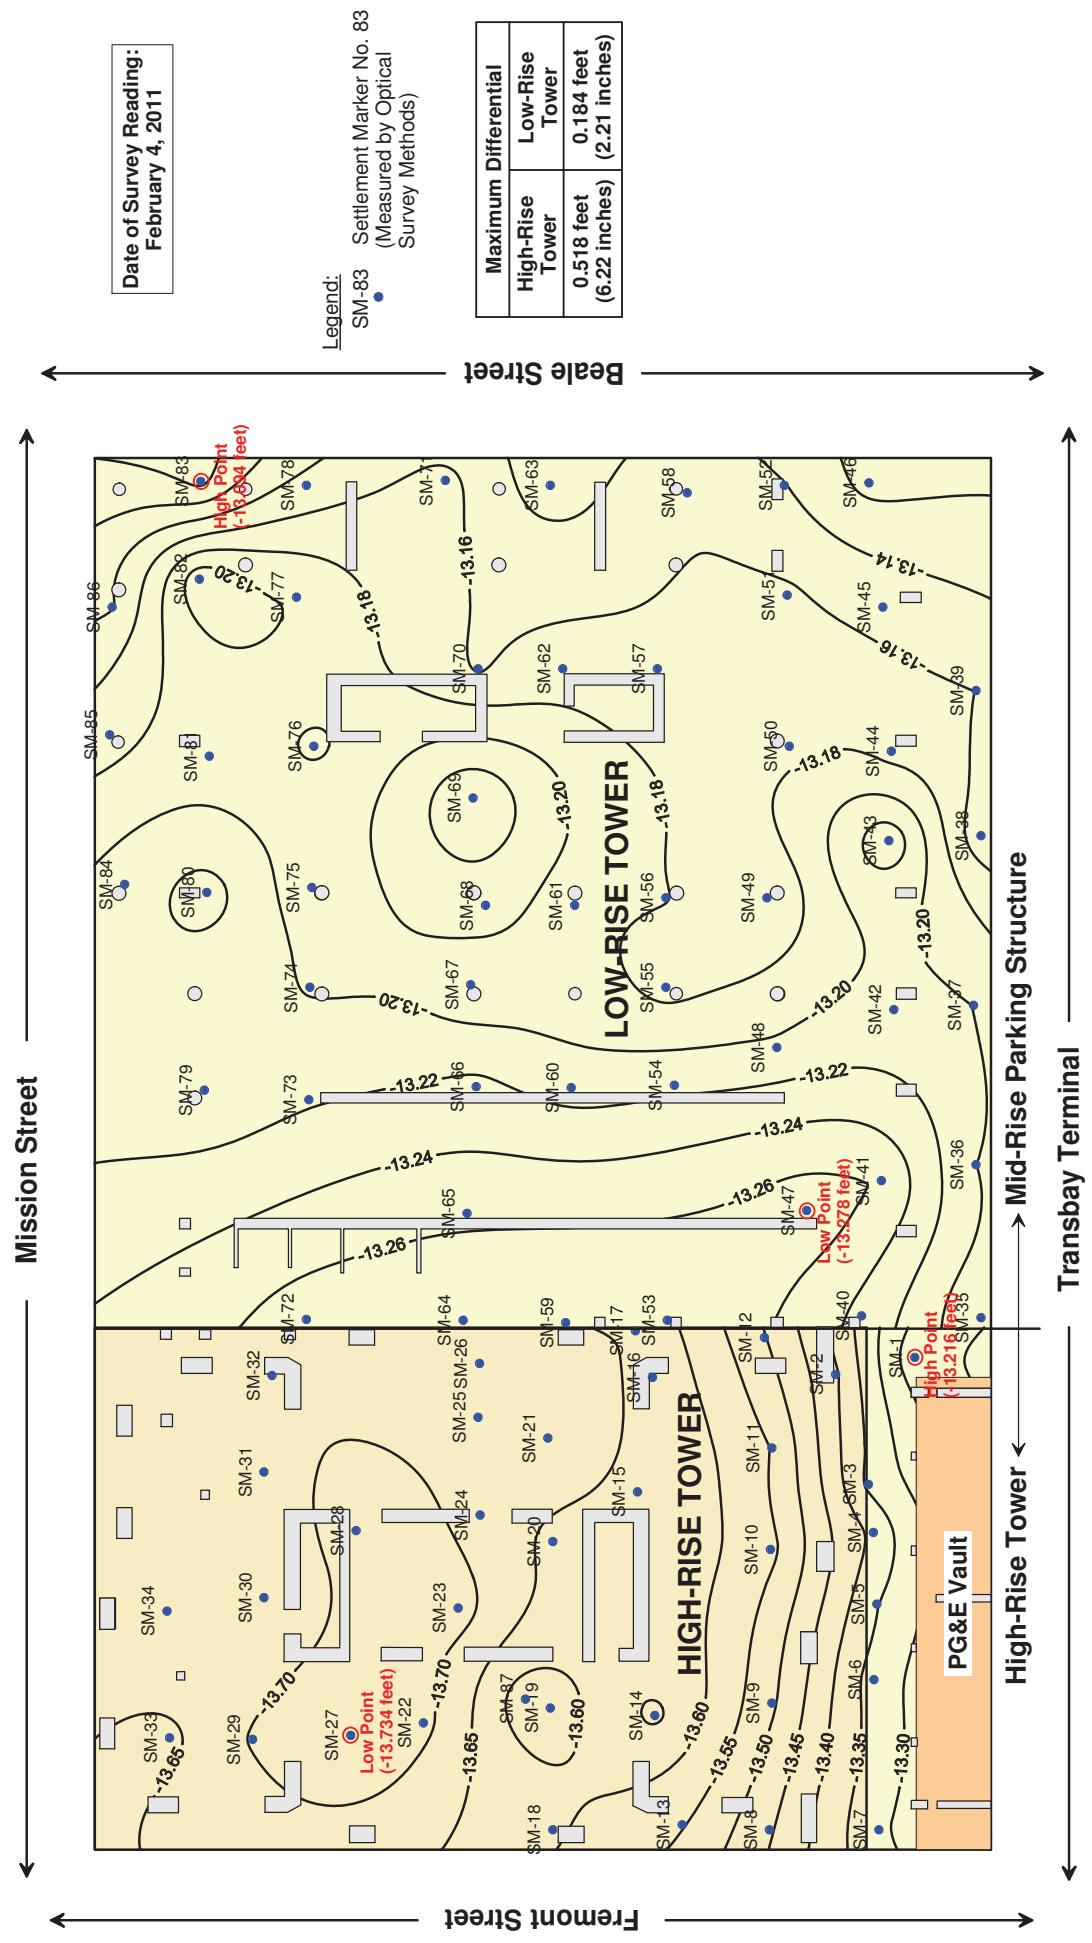


**FLOOR ELEVATIONS AT LEVEL B-1
OF 301 MISSION PROPERTY:
PERIODIC SURVEY - FEBRUARY 2011**

Transbay Transit Center
301 Mission Monitoring
Transbay Joint Powers Authority
San Francisco, California

February 2011

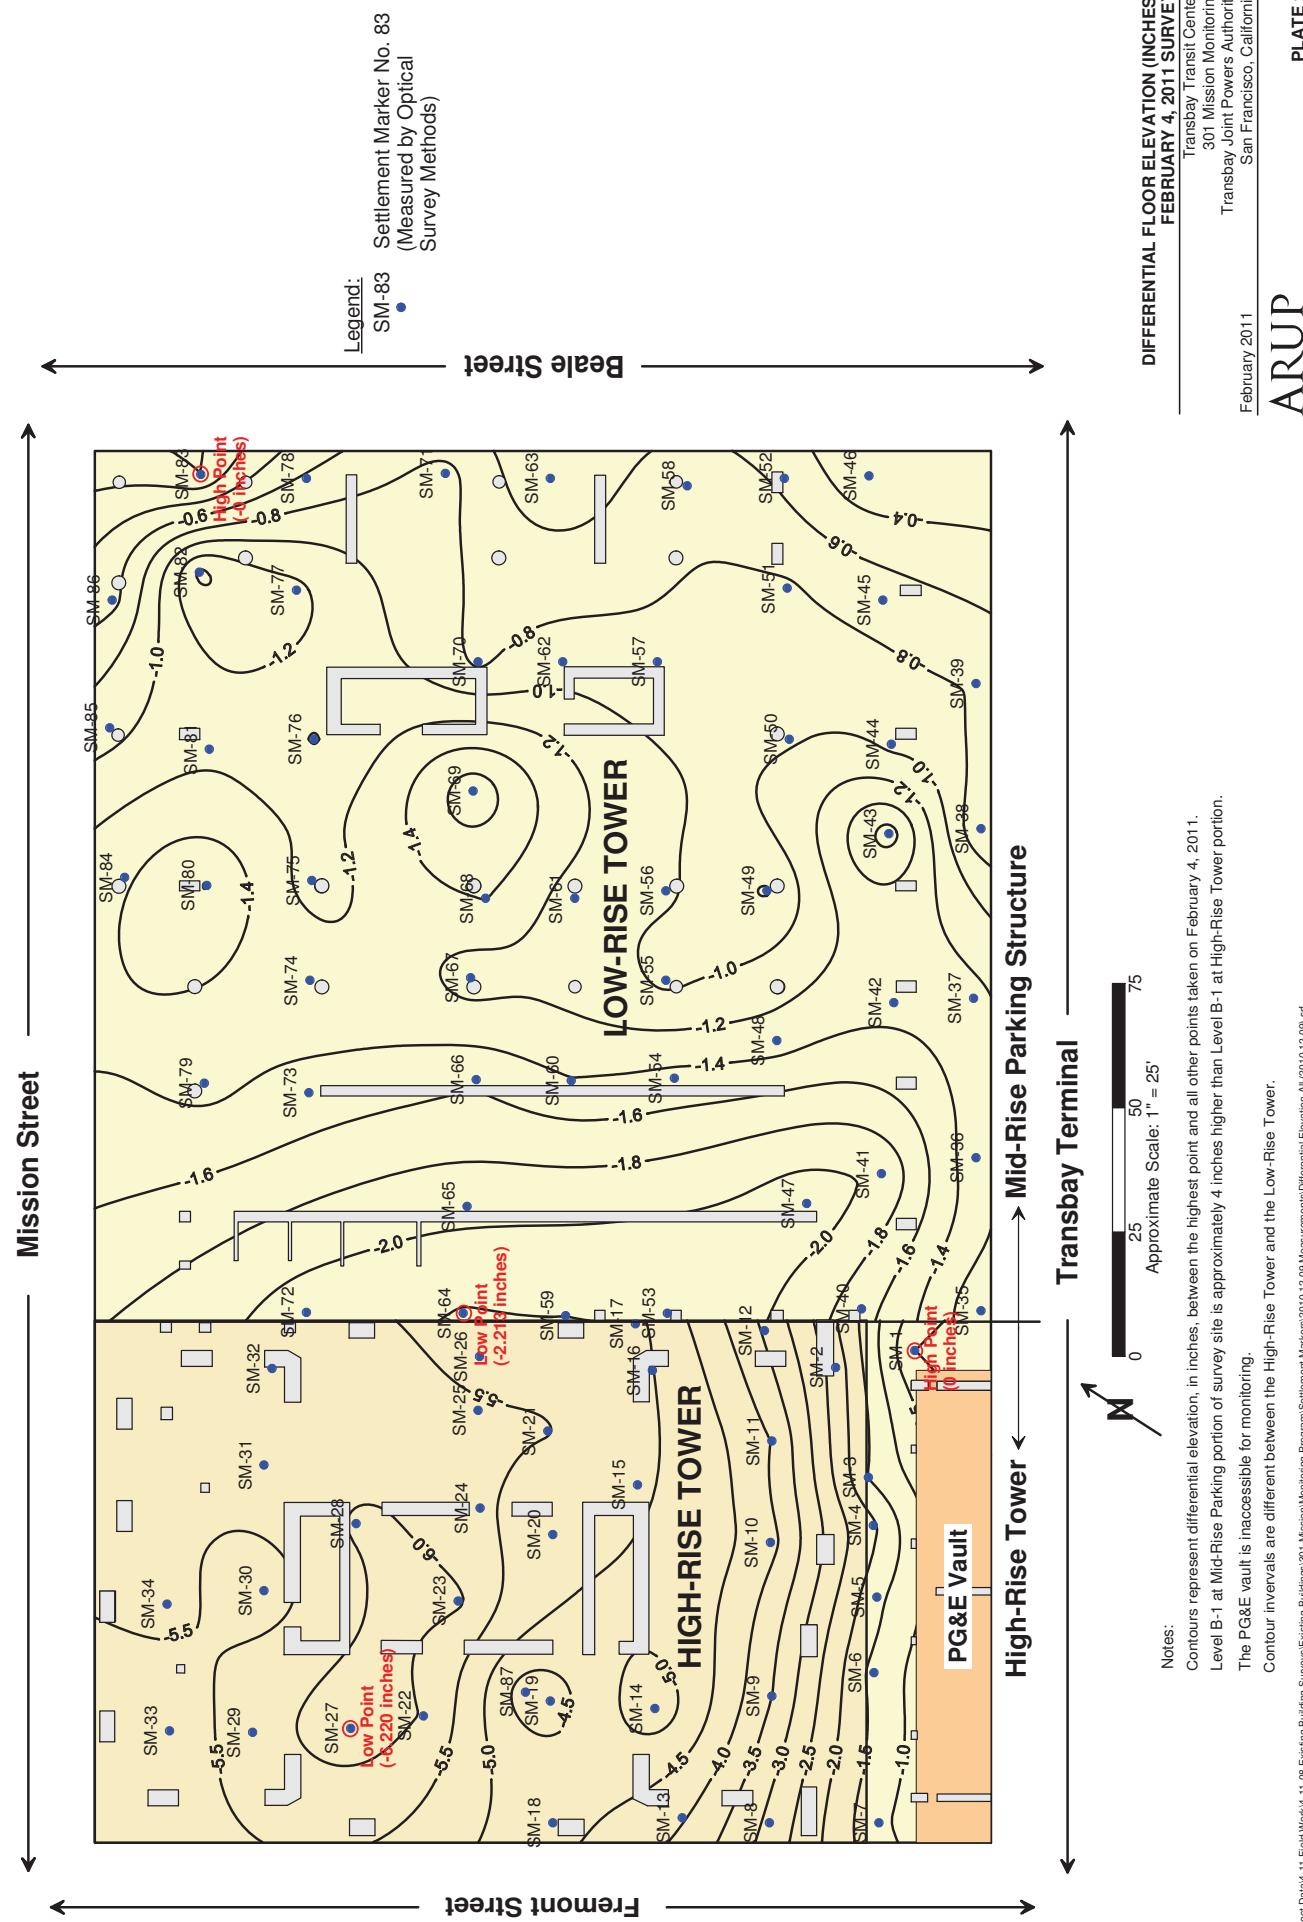

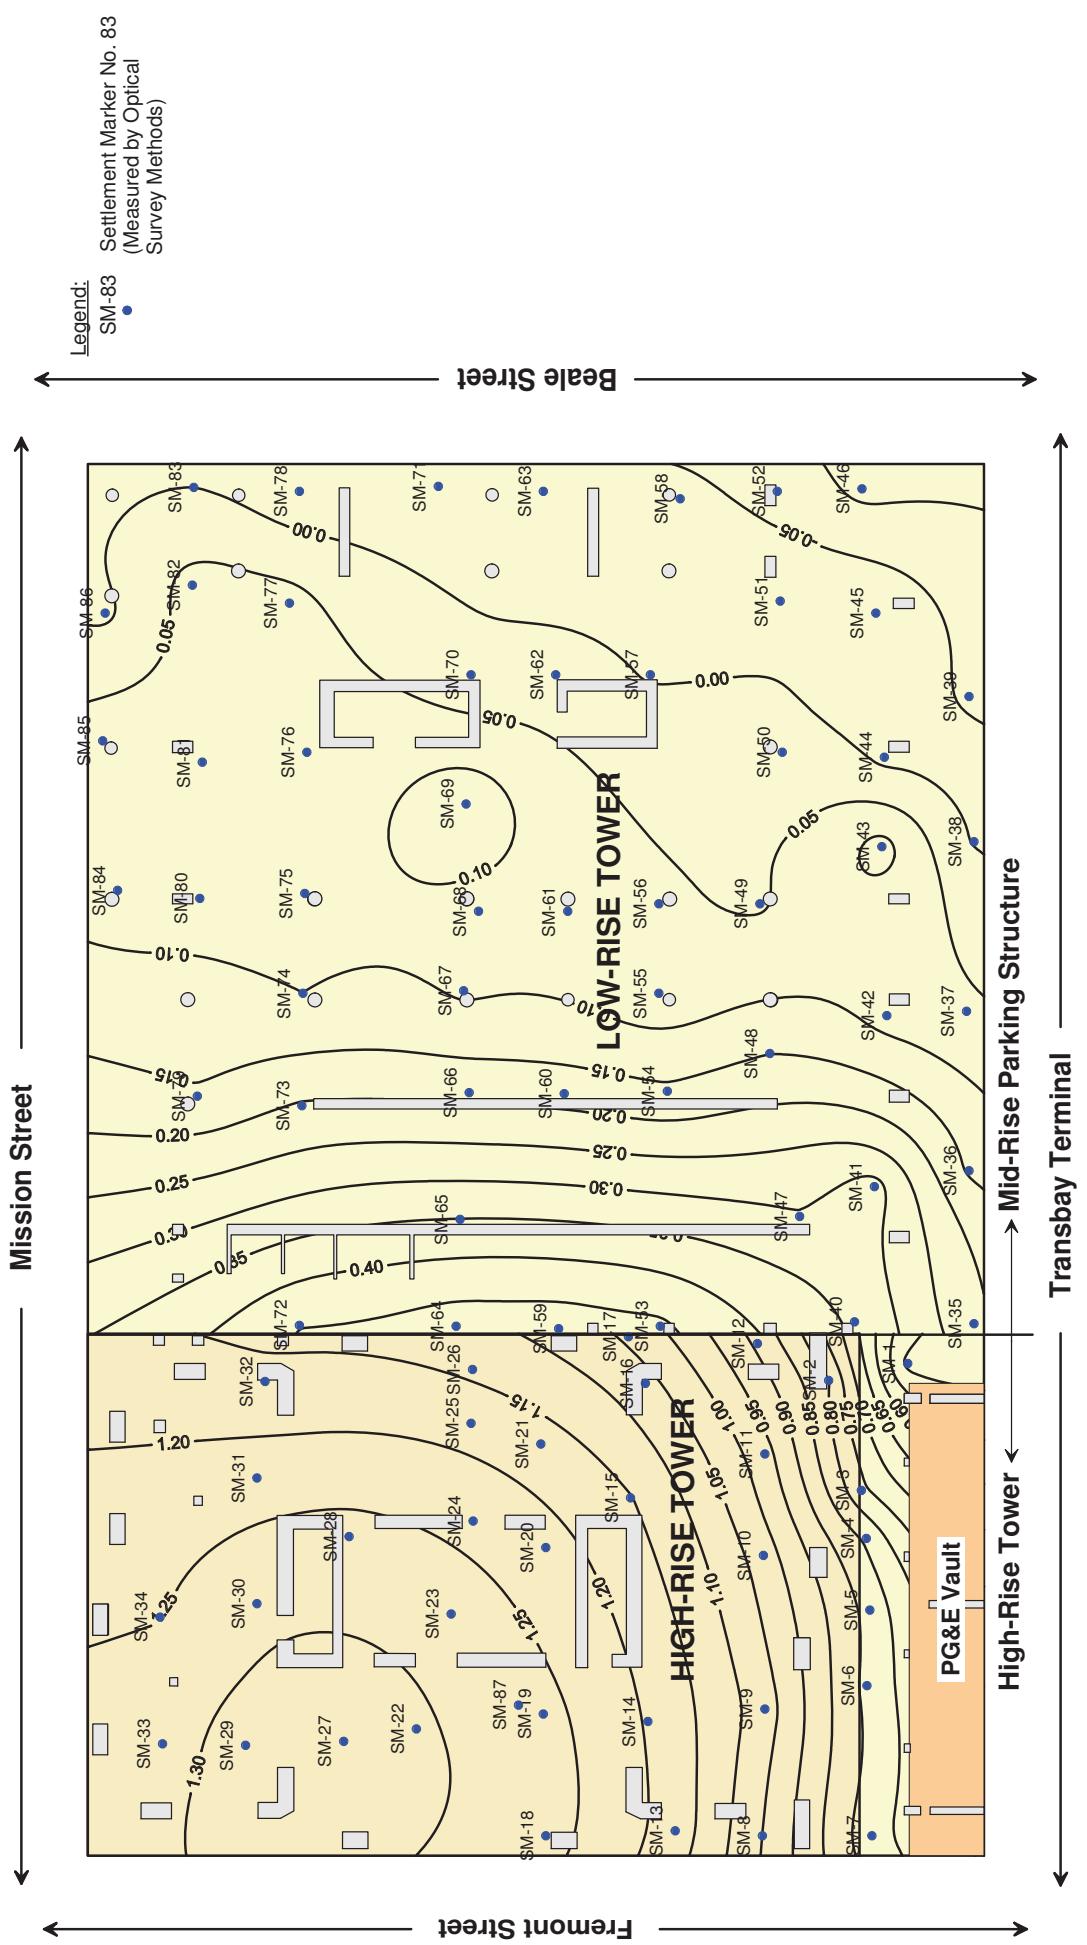



CONTOURS OF SETTLEMENTS MEASURED AT THE FIRST LEVEL BASEMENT OF THE 301 MISSION STREET STRUCTURE BETWEEN APRIL 30, 2009 AND FEBRUARY 4, 2011

Transbay Transit Center
301 Mission Monitoring
Transbay Joint Powers Authority
San Francisco, California

February 2011



TOWER

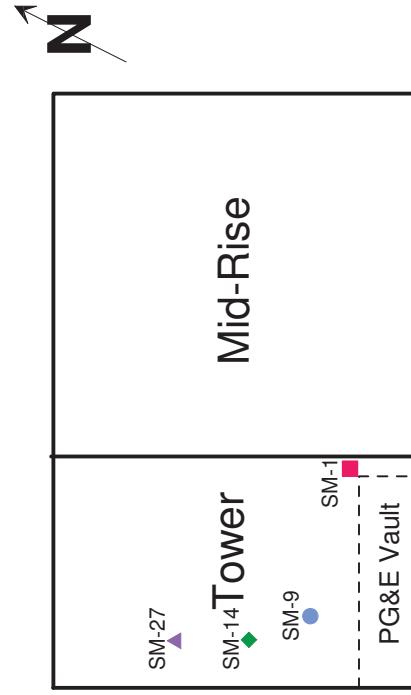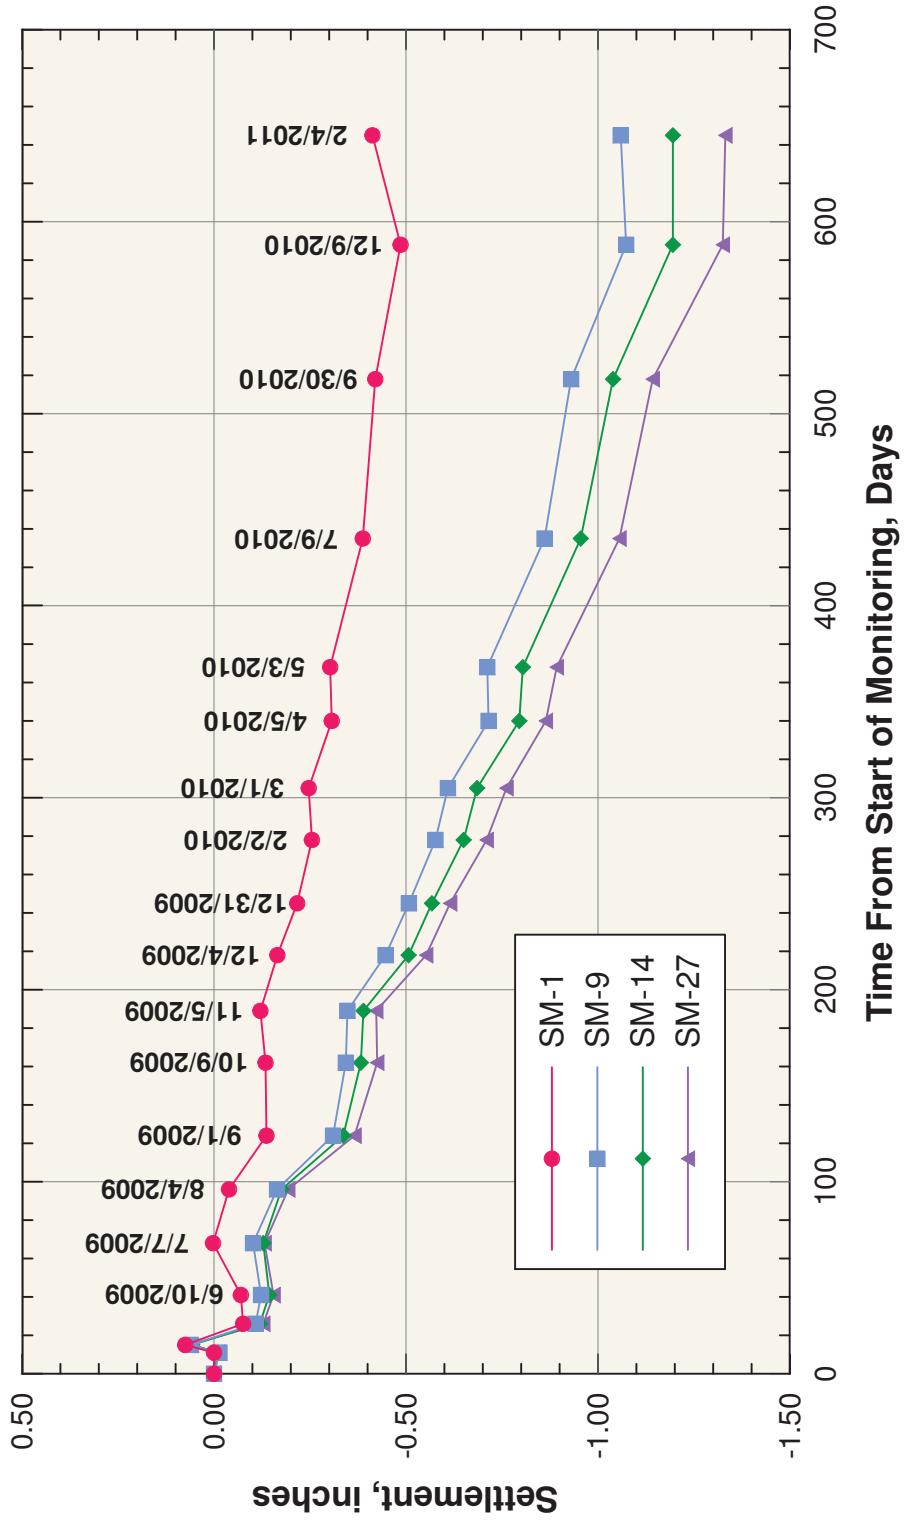

Note:
Initial (Baseline) reading
taken on 04/30/09

ARUP

February 2011

Note:
Initial (Baseline) reading taken on 04/30/09

PLATE 5

February 2011



Note:
Initial (Baseline) reading taken on 04/30/09


PLATE 5

February 2011

**SETTLEMENT OVER TIME
 FLOOR ELEVATIONS AT LEVEL B-1
 OF 301 MISSION PROPERTY- MID-RISE:
 APRIL 30, 2009 THROUGH FEBRUARY 4, 2011**

Transbay Transit Center
 301 Mission Monitoring
 Transbay Joint Powers Authority
 San Francisco, California

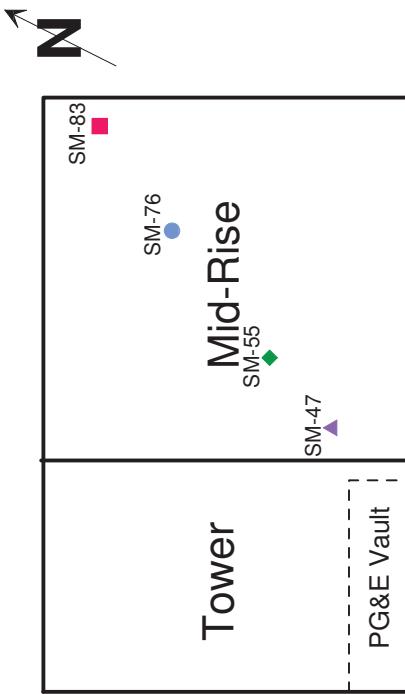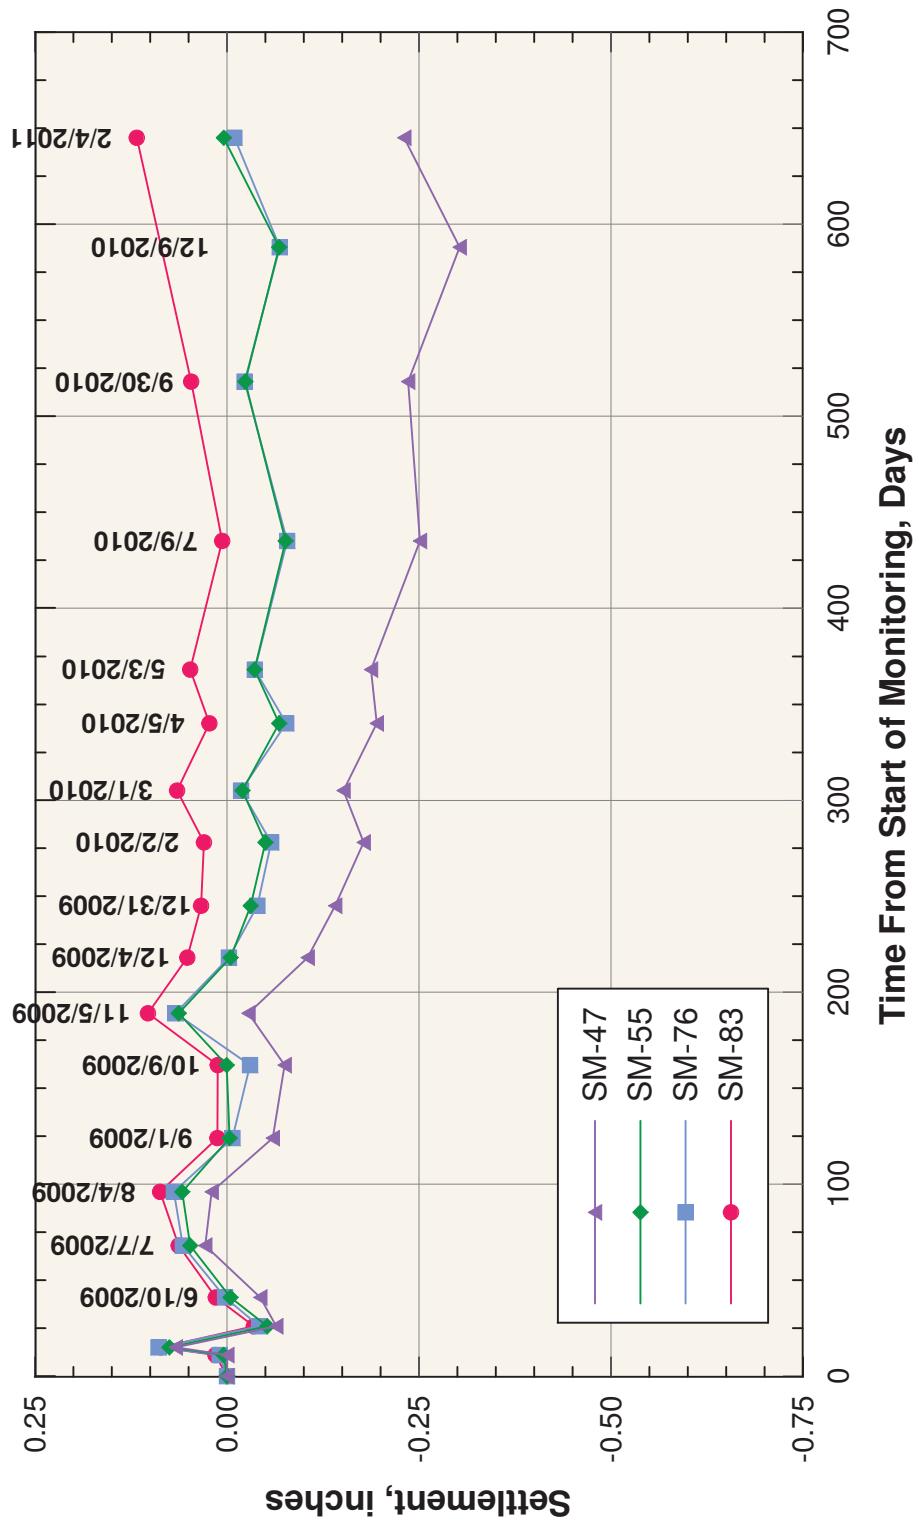

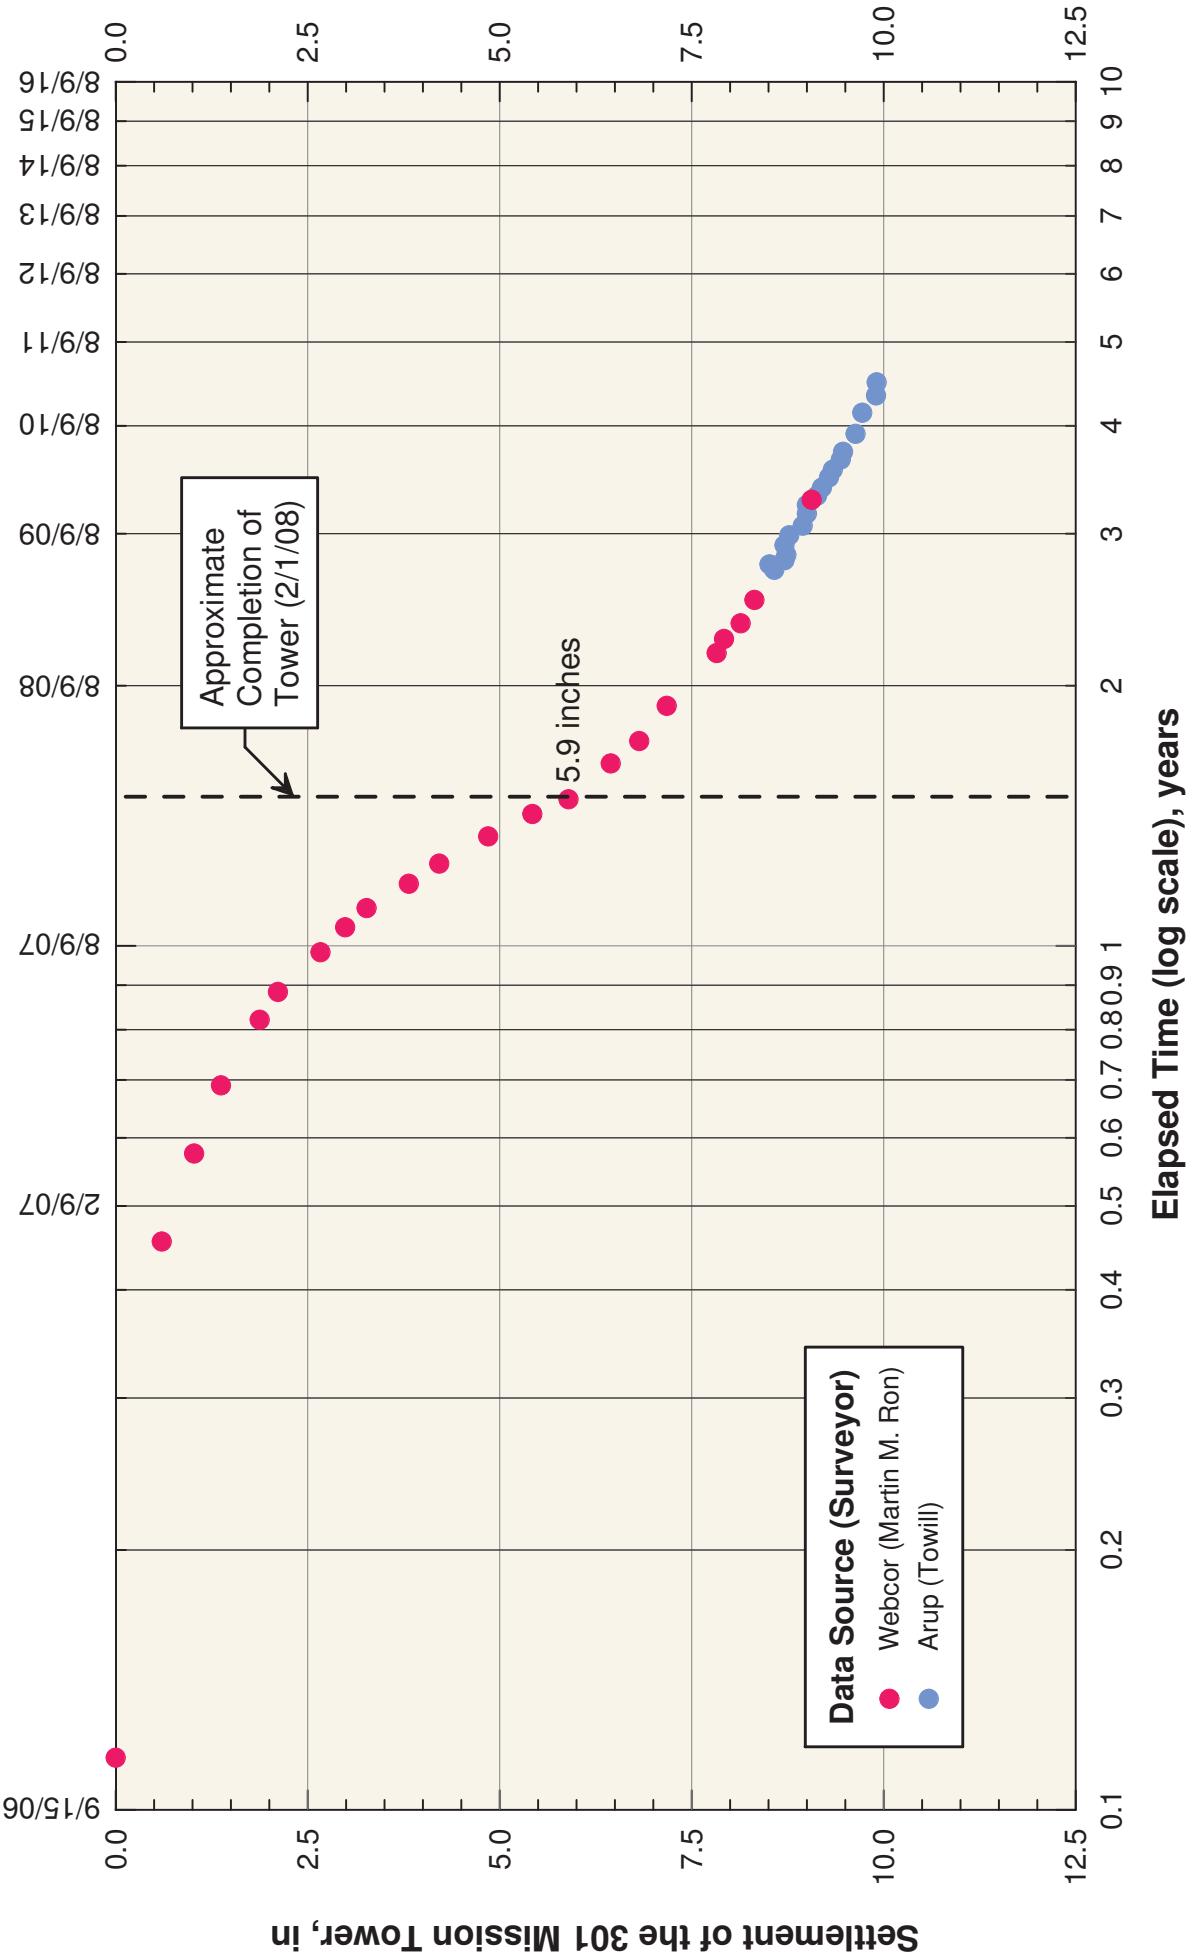

**SETTLEMENTS OF THE 301 MISSION TOWER
INCLUDING MONITORING DURING CONSTRUCTION**

Transbay Transit Center
301 Mission Monitoring
Transbay Joint Powers Authority
San Francisco, California

February 2011

Beginning of Tower Construction: 8/9/06
End of Tower Construction: 2/1/08
Construction Duration: 542 days (1.5 years)

From: Brian Dykes
Sent: Tuesday, May 03, 2011 7:51 AM
To: Steven Hood
Cc: Rebecca Armenta
Subject: FW: TTC - 301 Mission Settlement - March 2011 Survey
Attachments: 2011-04-12 Memo_301 Mission Settlement - March 2011 Survey.pdf

Follow Up Flag: Follow up
Flag Status: Completed

Categories: Adjacent Properties

Steve,
Here are the settlement marker readings taken at the end of March.
Sorry for the delay in sending them to you.
Brian.

From: Stephen McLandrich [<mailto:stephen.mclandrich@arup.com>]
Sent: Tuesday, April 12, 2011 5:25 PM
To: Brian Dykes
Cc: Robert Beck; Emilio Cruz; 'rvolenec@pcparch.com'; George Metzger; Nick O'Riordan; Kevin Clinch; DeeDee Maggi
Subject: TTC - 301 Mission Settlement - March 2011 Survey

Brian,

Please find the attached pdf which is a revised version of the 301 Mission settlement memo based on our late March settlement marker readings. This survey was originally scheduled for early April but was moved forward so we would have this reading a few days before the pile extraction began.

Let me know if you have any questions.

Cheers,
Stephen

Stephen McLandrich PE
Senior Engineer | Geotechnics Group

Arup
560 Mission Street Suite 700 San Francisco CA 94105 USA
t +1 415 957 9445 d +1 415 946 0245
f +1 415 957 9096
www.arup.com

Check out our progress at <http://transbaycenter.org/construction-updates/construction-cameras>

NOTE: This e-mail communication and any attachments hereto are covered by the Electronic Communications Privacy Act, 18 U.S.C. Sections 2510-2521, and are legally privileged. The information contained herein is confidential, and is intended only for the use of the individual or entity to whom it is addressed. If you are

not the intended recipient of this e-mail communication (or an employee or agent responsible for delivering this communication to its intended recipient(s)), you are hereby notified that any retention, copying or further distribution of this e-mail communication and any attachments is strictly prohibited. If you are not the intended recipient, please notify the sender by telephoning 415-597-4620, or by forwarding an e-mail reply message addressed to TransAdmin@TransbayCenter.org confirming that you have already destroyed (deleted) the original e-mail communication and any and all copies thereof. Thank you.

Memorandum

ARUP


To	Brian Dykes (TJPA)	Date
		April 12, 2011
Copies	Robert Beck (TJPA) Emilio Cruz (PMPC) Randy Volenec (PCPA) George Metzger (AAI)	Reference number 132242-60/SMM
From	Stephen McLandrich (Arup) Nick O'Riordan (Arup) Kevin Clinch (Arup)	File reference 4-05 124
Subject	Transbay Transit Center: Results of March 2011 Settlement Survey at 301 Mission Property	Page 1 of 1

Under Arup's Geotechnical Contract with the Transbay Joint Powers Authority through Pelli Clark Pelli Architects, Arup is required to monitor the settlements of the buildings adjacent to the Transbay Transit Center prior to and during construction. We began the monitoring program for the 301 Mission property in April of 2009. This memorandum and the attached plates present an update to our memorandum dated January 5, 2011 with measurements made through March 2010.

List of Plates

- Plate 1 Floor Elevations at Level B-1 of 301 Mission Property: Periodic Survey – March 24, 2010
- Plate 2 Differential Floor Elevation (Inches) – March 24, 2010 Survey
- Plate 3 Contours of Settlements Measured at the First Level Basement of the 301 Mission Street Structure Between April 30, 2009 and March 24, 2010
- Plate 4 Settlement Over Time Floor Elevations at Level B-1 of 301 Mission Property – Tower: April 30, 2009 through March 24, 2010.
- Plate 5 Settlement Over Time Floor Elevations at Level B-1 of 301 Mission Property – Mid-Rise: April 30, 2009 through March 24, 2010
- Plate 6 Settlements of the 301 Mission Tower Including Monitoring During Construction

Note Typo: References to "2010"
on this page should read "2011"

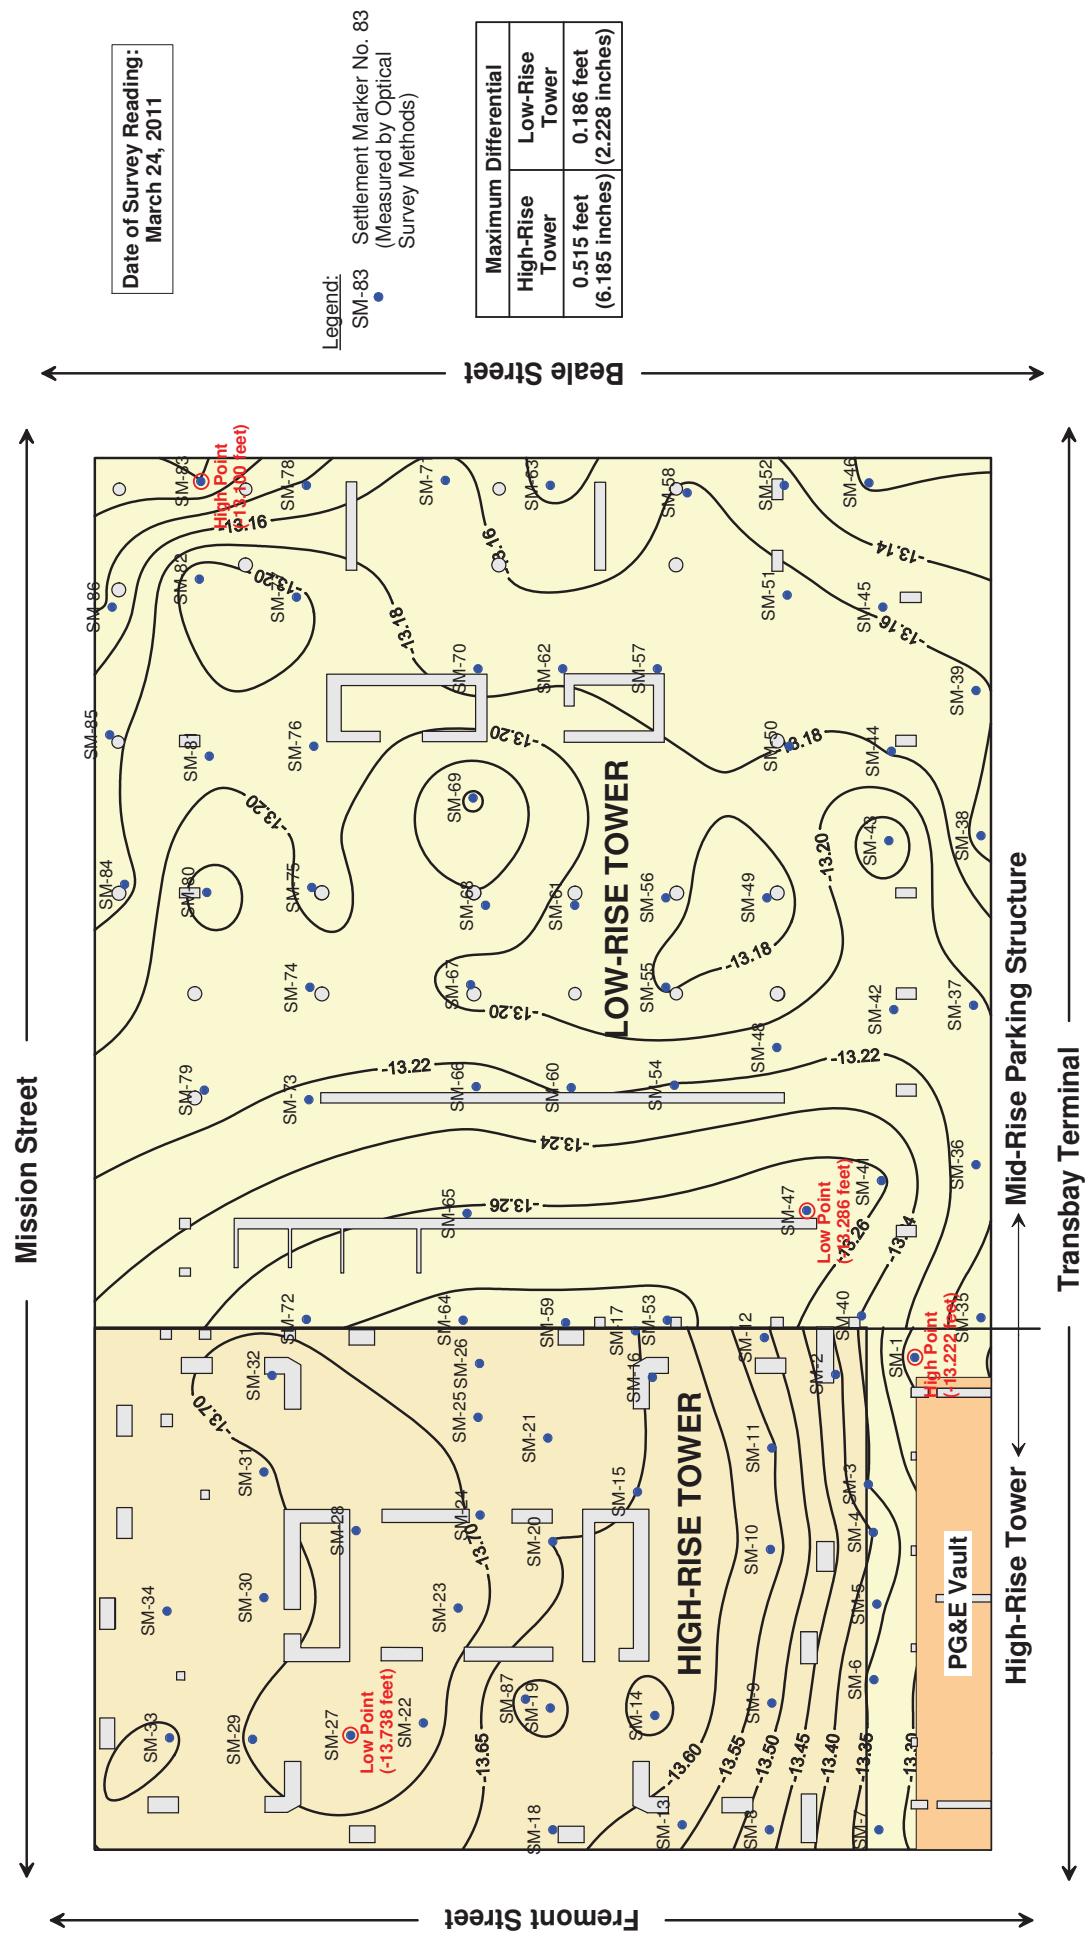


**FLOOR ELEVATIONS AT LEVEL B-1
OF 301 MISSION PROPERTY:
PERIODIC SURVEY - MARCH 24, 2011**


Transbay Transit Center
 301 Mission Monitoring
 Transbay Joint Powers Authority
 San Francisco, California

April 2011

ARUP

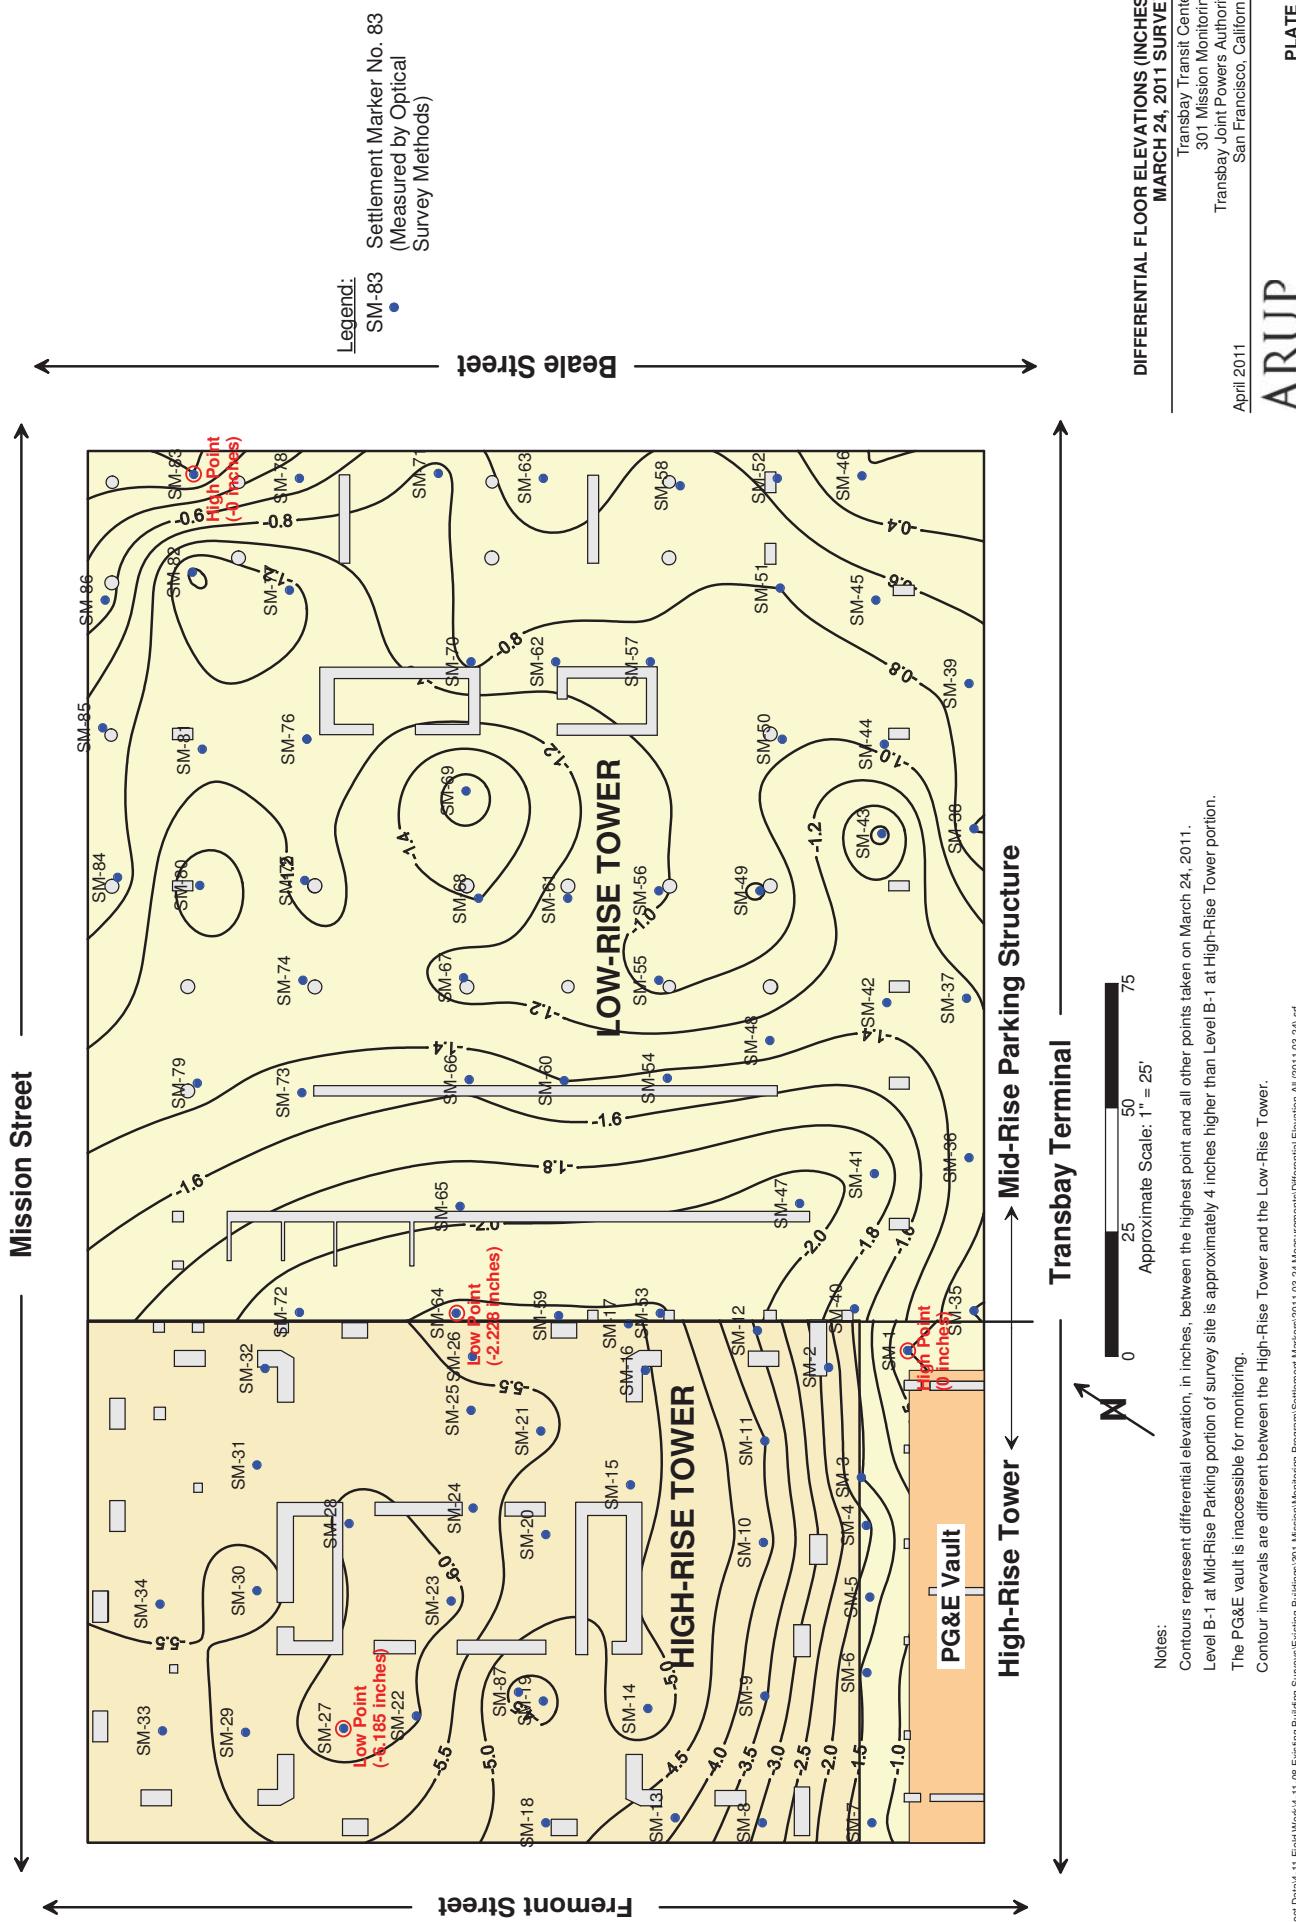

Q11322424 Internal Project Data\4_11 Field Work\4_11-08 Existing Building Survey\Existing Buildings\301 Mission Monitoring Program Settlement Markers\2011.03.24 Measurements\ Differential Elevation All (2011.03.24).srf

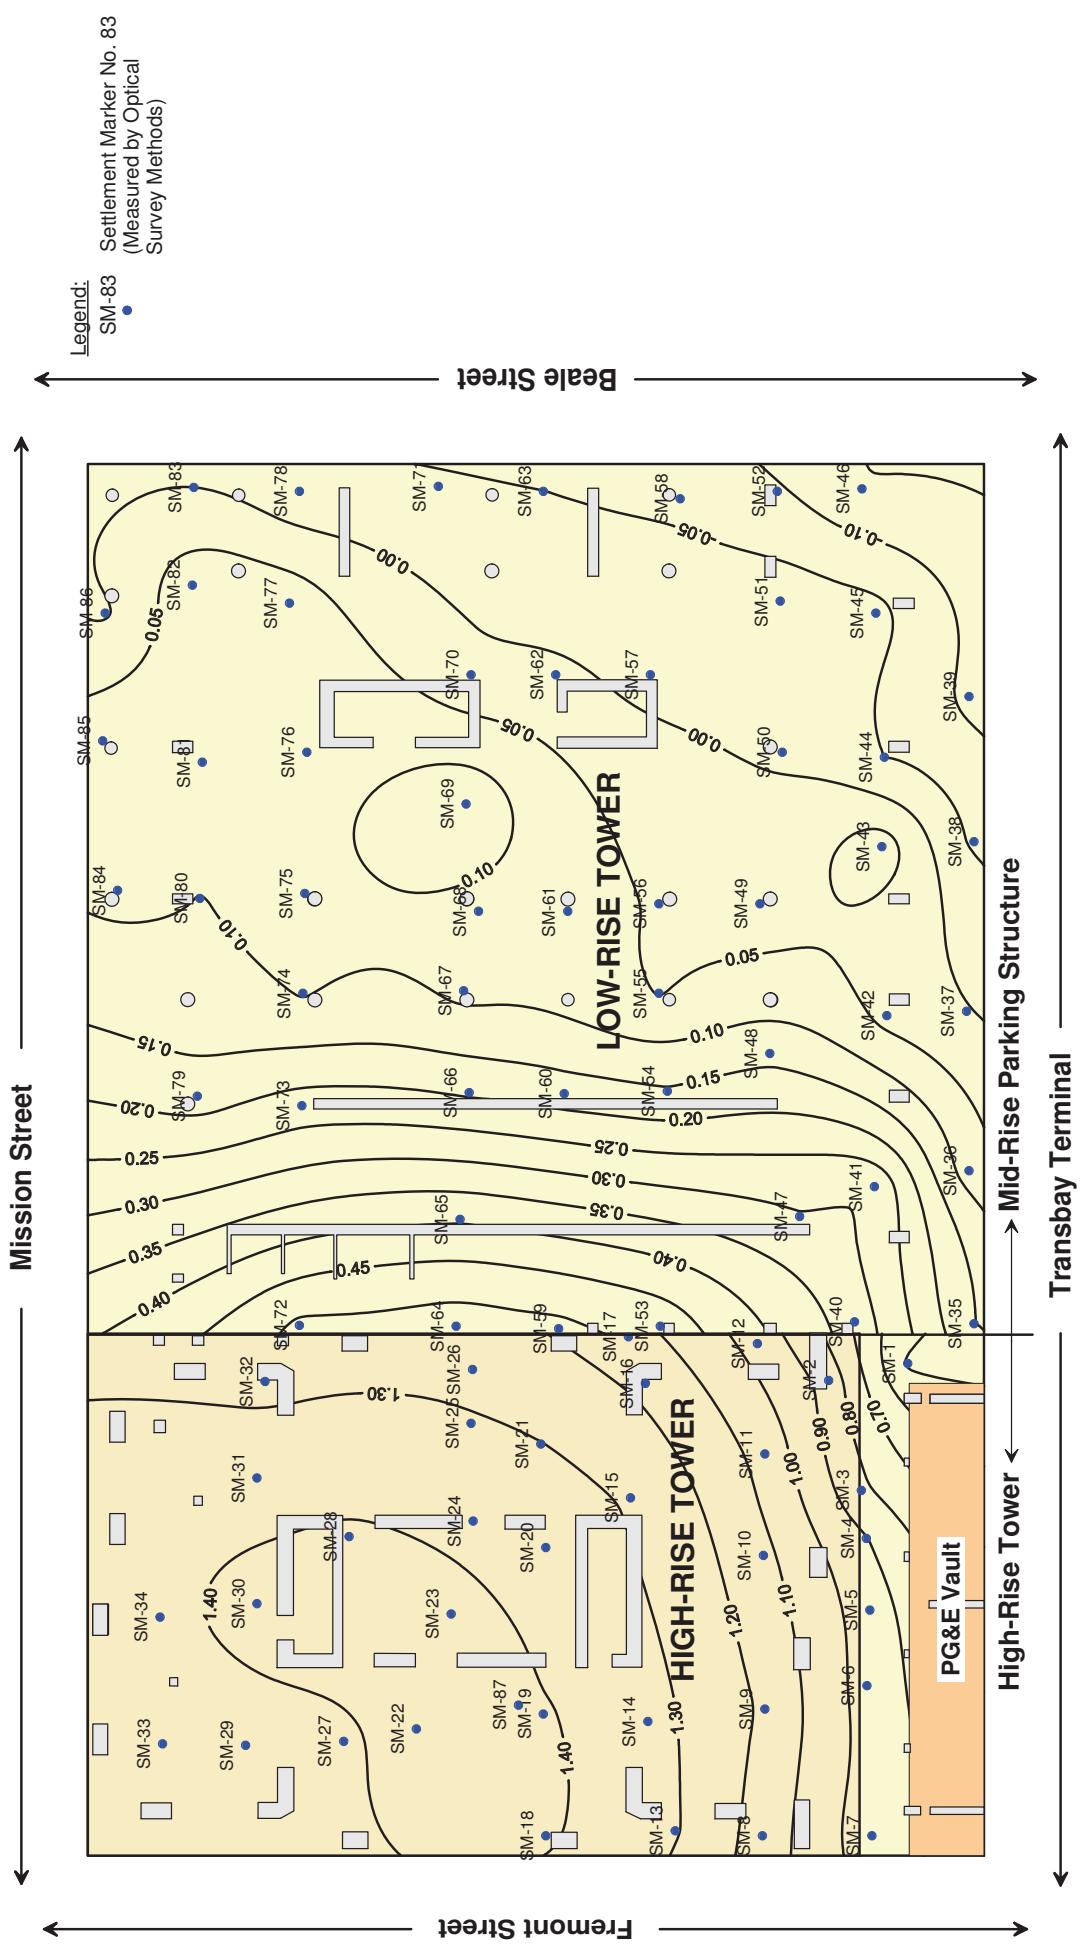

CONTOURS OF SETTLEMENTS MEASURED AT THE
FIRST LEVEL BASEMENT OF THE 301 MISSION STREET
STRUCTURE BETWEEN APRIL 30, 2009 AND MARCH 24, 2011

Transbay Transit Center
301 Mission Monitoring
Transbay Joint Powers Authority
San Francisco, California

ARUP

April 2011

Q1322424 Internal Project Data\11\Field Work\4-11-08-Elevating Building Survey\Existing Buildings\301 Mission Monitoring Program\Settlement Markers\2011-03-24 Measurements\Elevation changes All (2011-03-24).sdf

Approximate Scale: 1" = 25'


ARUP

Note:
Initial (Baseline) reading
taken on 04/30/09

April 2011

Transbay Transit Center
301 Mission Monitoring
Transbay Joint Powers Authority
San Francisco, California

SETTLEMENT OVER TIME
FLOOR ELEVATIONS AT LEVEL B-1
OF 301 MISSION PROPERTY- TOWER:
APRIL 30, 2009 THROUGH MARCH 24, 2011

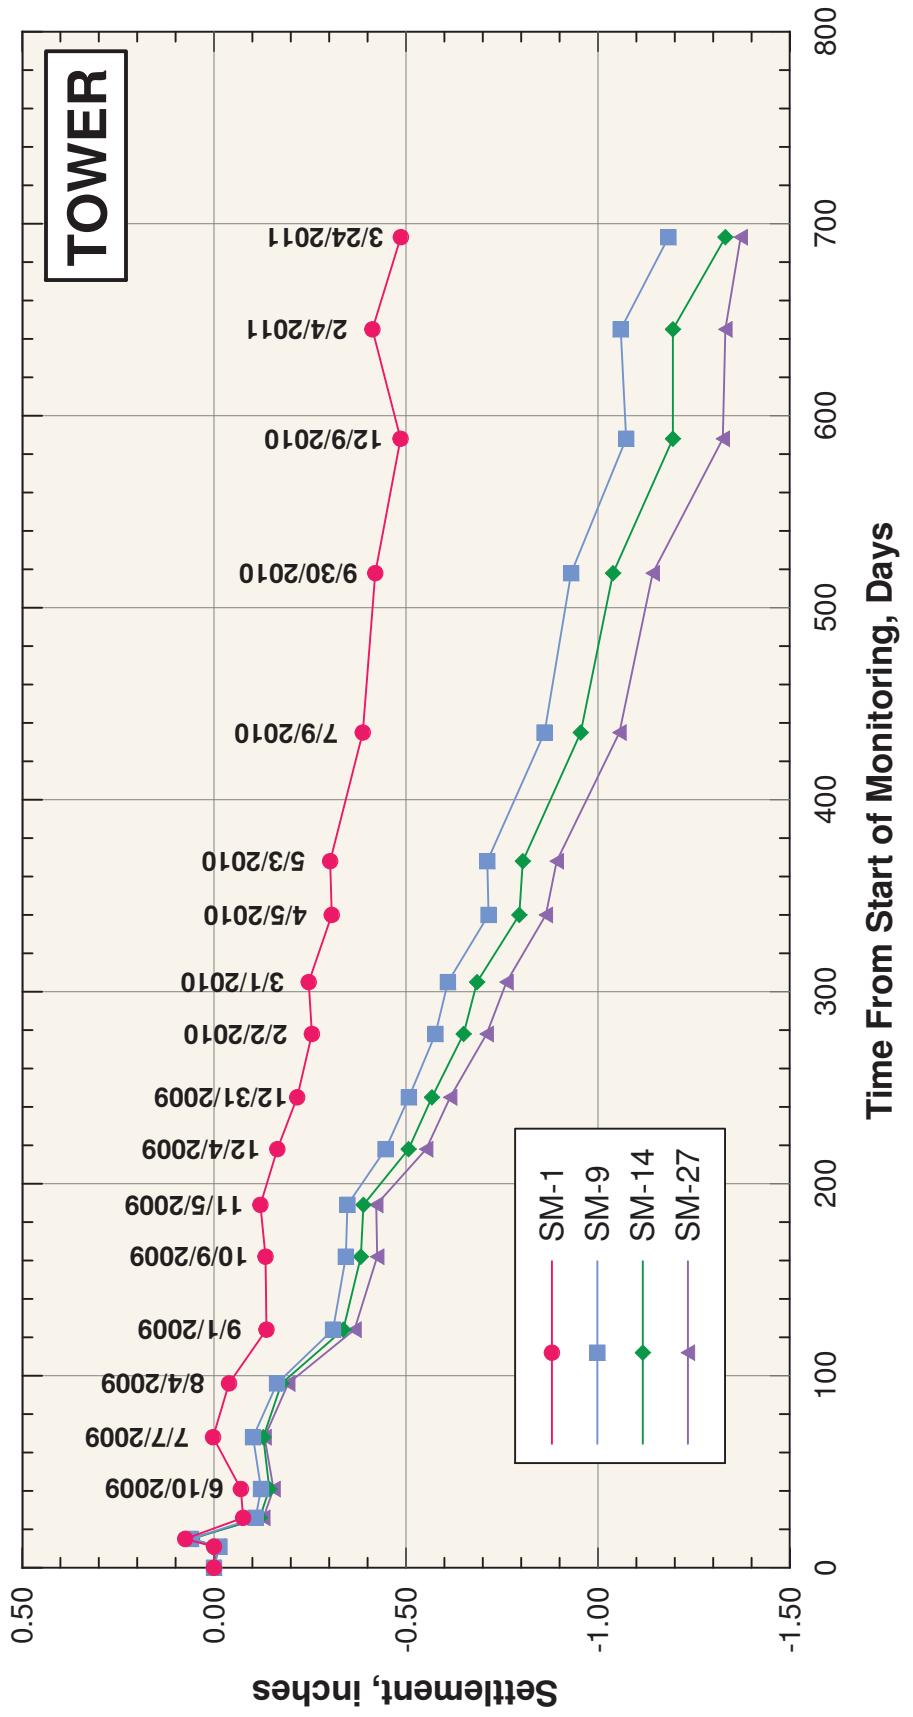

ARUP



Note:
Initial (Baseline) reading
taken on 04/30/09


April 2011

Q:\132224\24 Internal Project Data\4-05 Reports & Narratives\124 301 Mission - March Survey\Plates\Plate 5 Settlement Over Time - Midrise.gpt

SETTLEMENT OVER TIME
FLOOR ELEVATIONS AT LEVEL B-1
OF 301 MISSION PROPERTY- MID-RISE:
APRIL 30, 2009 THROUGH MARCH 24, 2011

Transbay Transit Center
301 Mission Monitoring
Transbay Joint Powers Authority
San Francisco, California

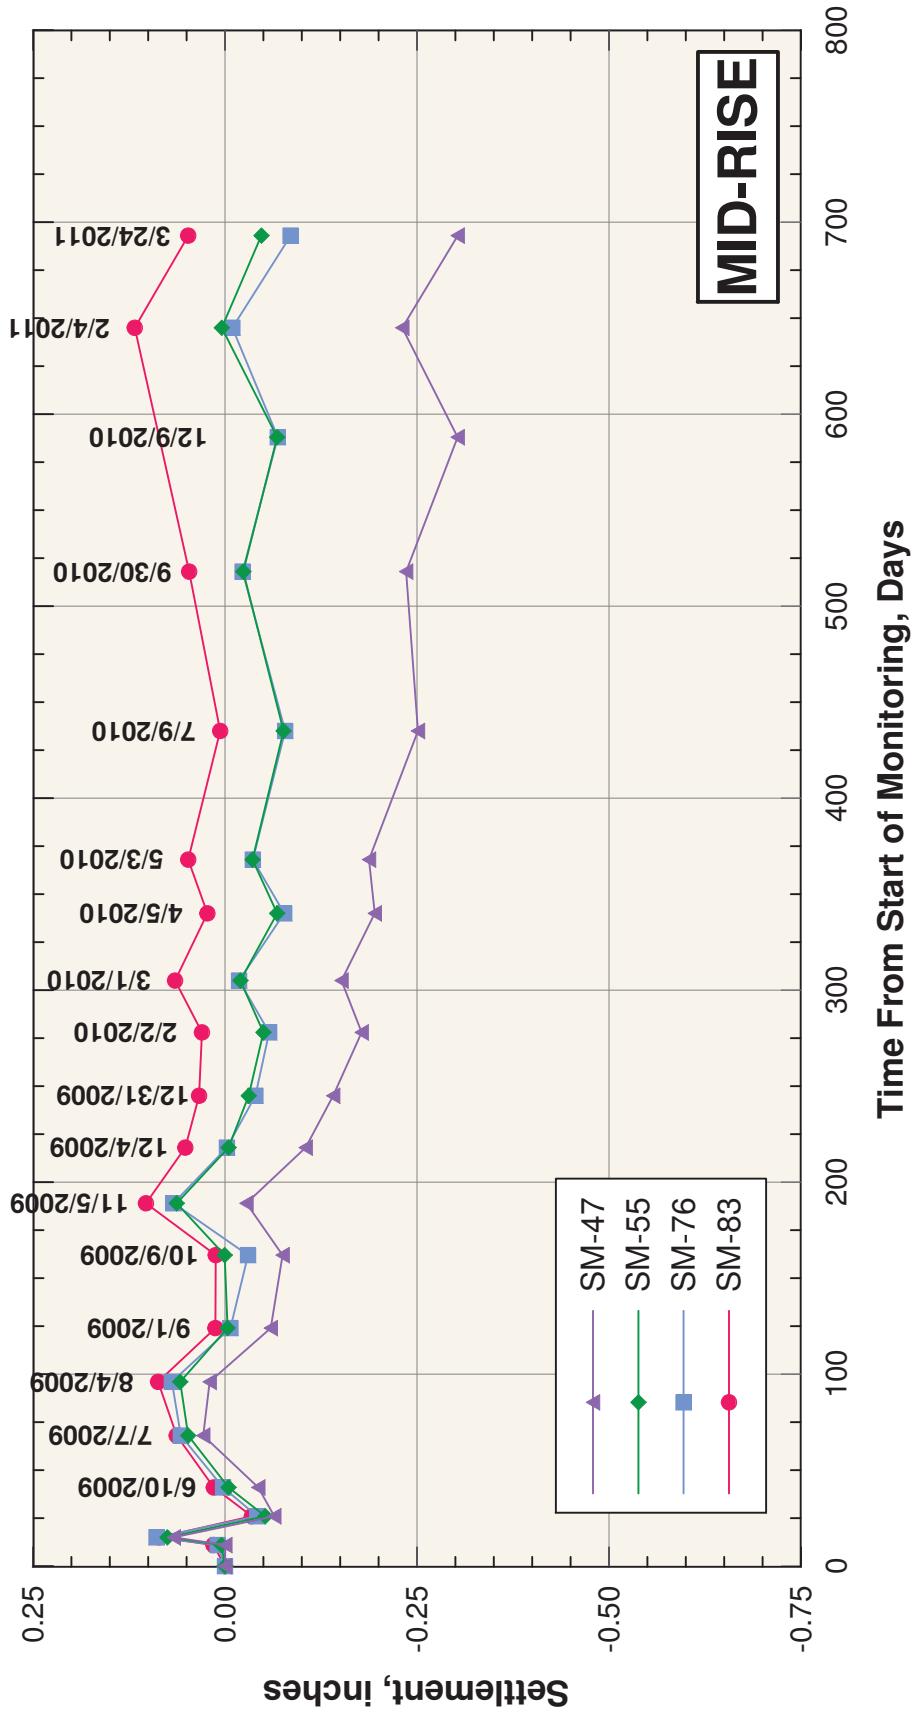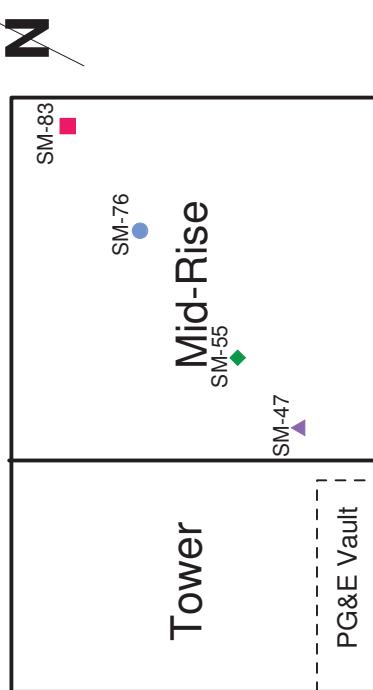

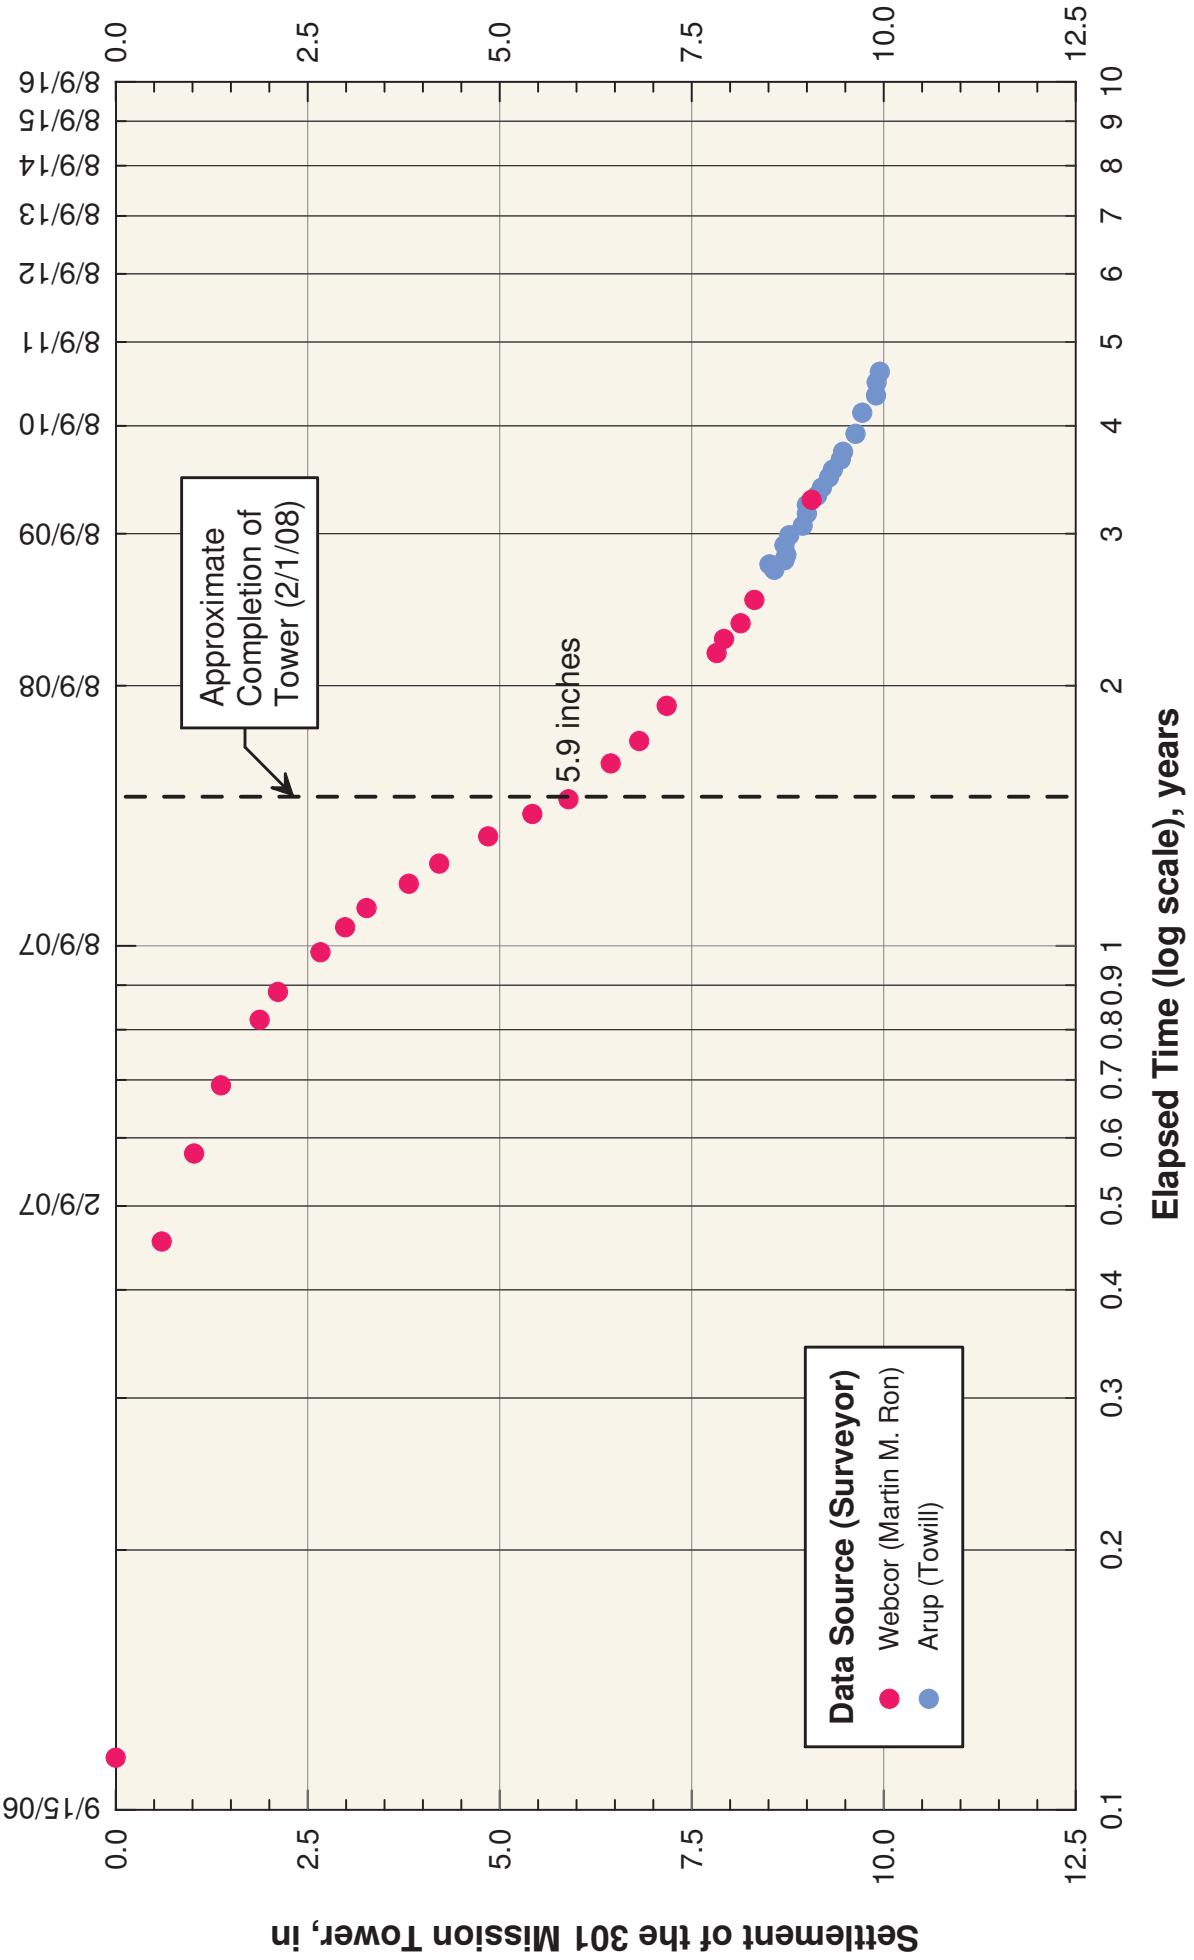

**SETTLEMENTS OF THE 301 MISSION TOWER
INCLUDING MONITORING DURING CONSTRUCTION**

Transbay Transit Center
301 Mission Monitoring
Transbay Joint Powers Authority
San Francisco, California

April 2011

ARUP

From: Brian Dykes
Sent: Friday, June 24, 2011 3:37 PM
To: Steven Hood; John Luciano
Cc: Rebecca Armenta
Subject: Settlement Records at 301 Mission Street
Attachments: 2011-06-24 Memo_301 Mission Settlement - May 2011 Survey.pdf

Follow Up Flag: Follow up
Flag Status: Completed

Categories: Adjacent Properties

Steve,
Here is the report of the settlement readings taken on May 31, 2011.
The next readings will be taken during the work week starting July 5th.
Brian.

Brian Dykes
Principal Engineer
Transbay Joint Powers Authority
201 Mission Street, Suite 2100
San Francisco, CA 94105
415 597 4617 phone
415 597 4615 fax

Check out our progress at <http://transbaycenter.org/construction-updates/construction-cameras>

NOTE: This e-mail communication and any attachments hereto are covered by the Electronic Communications Privacy Act, 18 U.S.C. Sections 2510-2521, and are legally privileged. The information contained herein is confidential, and is intended only for the use of the individual or entity to whom it is addressed. If you are not the intended recipient of this e-mail communication (or an employee or agent responsible for delivering this communication to its intended recipient(s)), you are hereby notified that any retention, copying or further distribution of this e-mail communication and any attachments is strictly prohibited. If you are not the intended recipient, please notify the sender by telephoning 415-597-4620, or by forwarding an e-mail reply message addressed to TransAdmin@TransbayCenter.org confirming that you have already destroyed (deleted) the original e-mail communication and any and all copies thereof. Thank you.

Memorandum

ARUP


To	Brian Dykes (TJPA)	Date
		June 24, 2011
Copies	Robert Beck (TJPA) Emilio Cruz (PMPC) Randy Volenec (PCPA) George Metzger (AAI)	Reference number 132242-60/SMM
From	Stephen McLandrich (Arup) Nick O'Riordan (Arup) Kevin Clinch (Arup)	File reference 4-05 136
Subject	Transbay Transit Center: Results of May 2011 Settlement Survey at 301 Mission Property	Page 1 of 1

Under Arup's Geotechnical Contract with the Transbay Joint Powers Authority through Pelli Clark Pelli Architects, Arup is required to monitor the settlements of the buildings adjacent to the Transbay Transit Center prior to and during construction. We began the monitoring program for the 301 Mission property in April of 2009. This memorandum and the attached plates present an update to our memorandum dated April 12, 2011 with measurements made through May 2010.

List of Plates

- Plate 1 Floor Elevations at Level B-1 of 301 Mission Property: Periodic Survey – May 31, 2010
- Plate 2 Differential Floor Elevation (Inches) – May 31, 2010 Survey
- Plate 3 Contours of Settlements Measured at the First Level Basement of the 301 Mission Street Structure Between April 30, 2009 and May 31, 2010
- Plate 4 Settlement Over Time Floor Elevations at Level B-1 of 301 Mission Property – Tower: April 30, 2009 through May 31, 2010.
- Plate 5 Settlement Over Time Floor Elevations at Level B-1 of 301 Mission Property – Mid-Rise: April 30, 2009 through May 31, 2010
- Plate 6 Settlements of the 301 Mission Tower Including Monitoring During Construction

Note Typo: references to "2010"
on this page should read "2011"

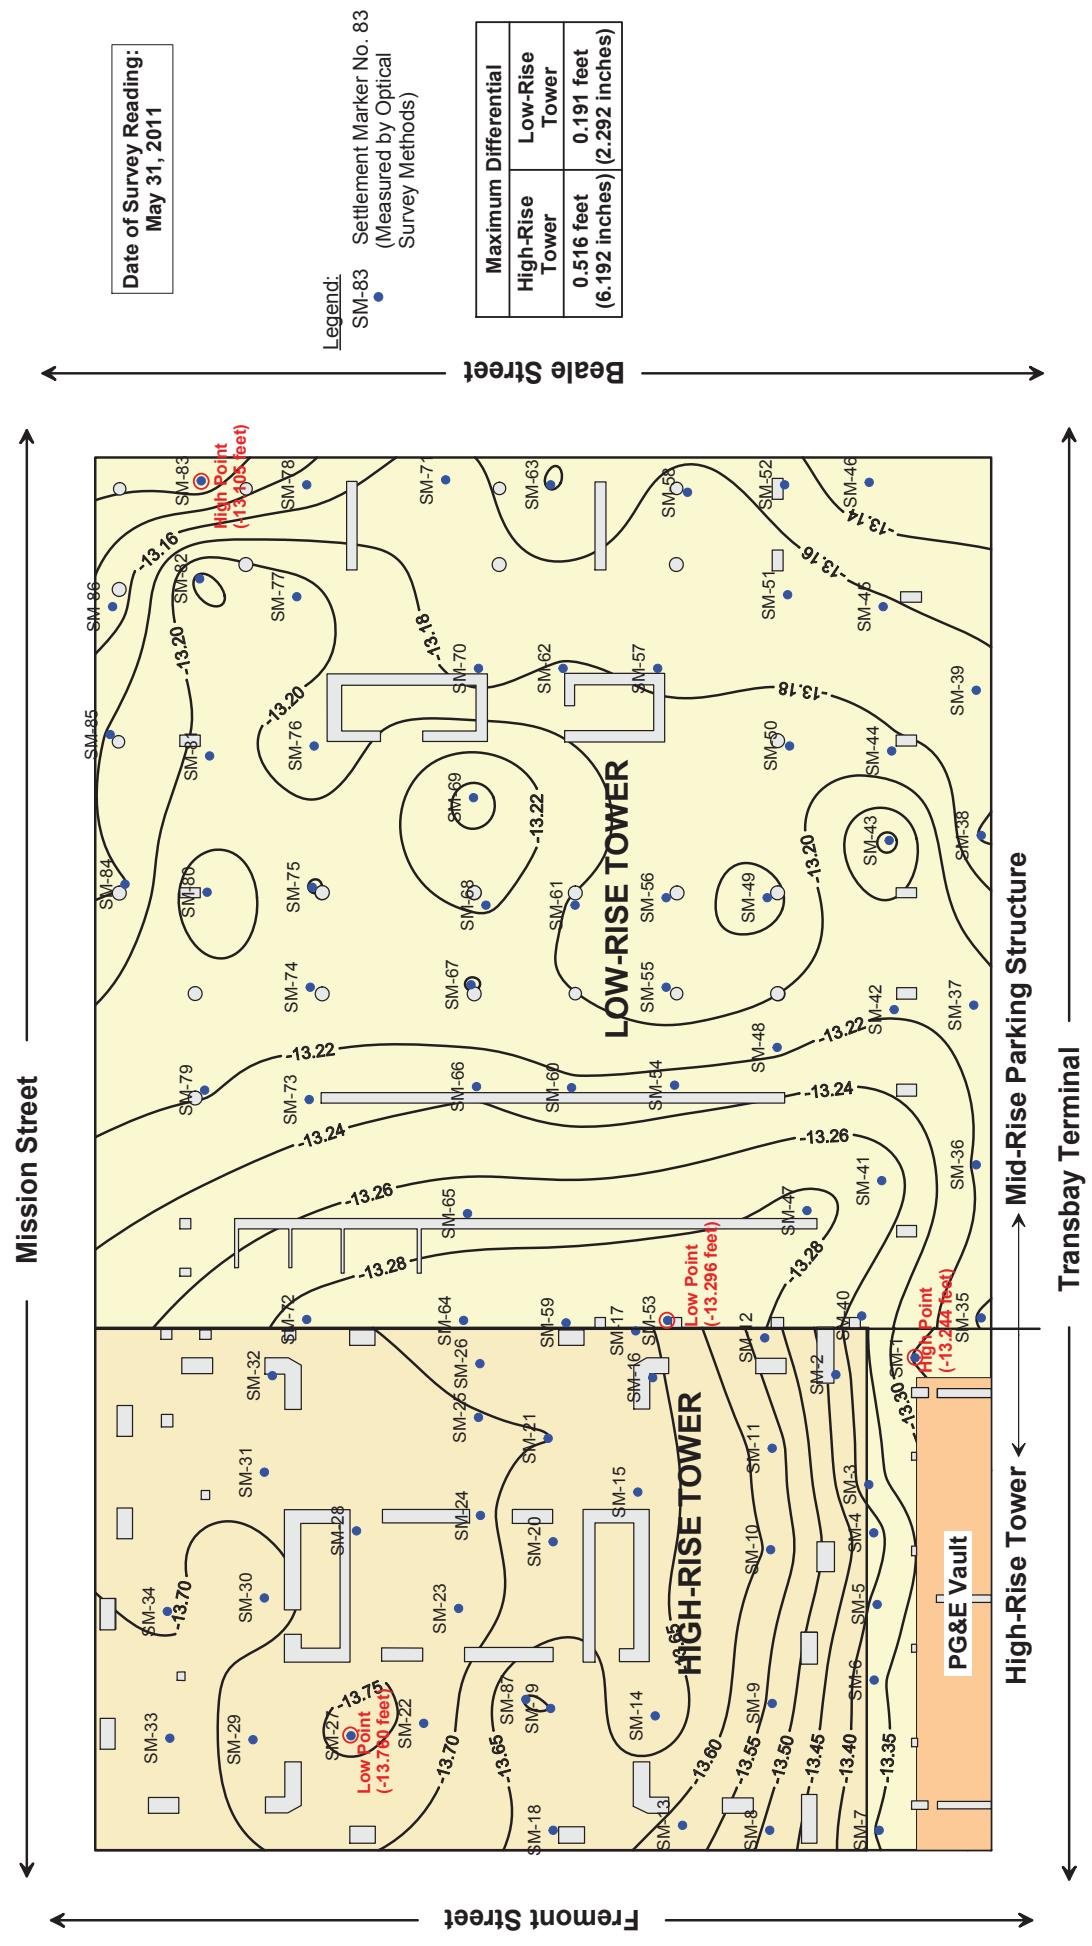


**FLOOR ELEVATIONS AT LEVEL B-1
OF 301 MISSION PROPERTY:
PERIODIC SURVEY - MAY 31, 2011**

Transbay Transit Center
 301 Mission Monitoring
 Transbay Joint Powers Authority
 San Francisco, California

June 2011

ARUP

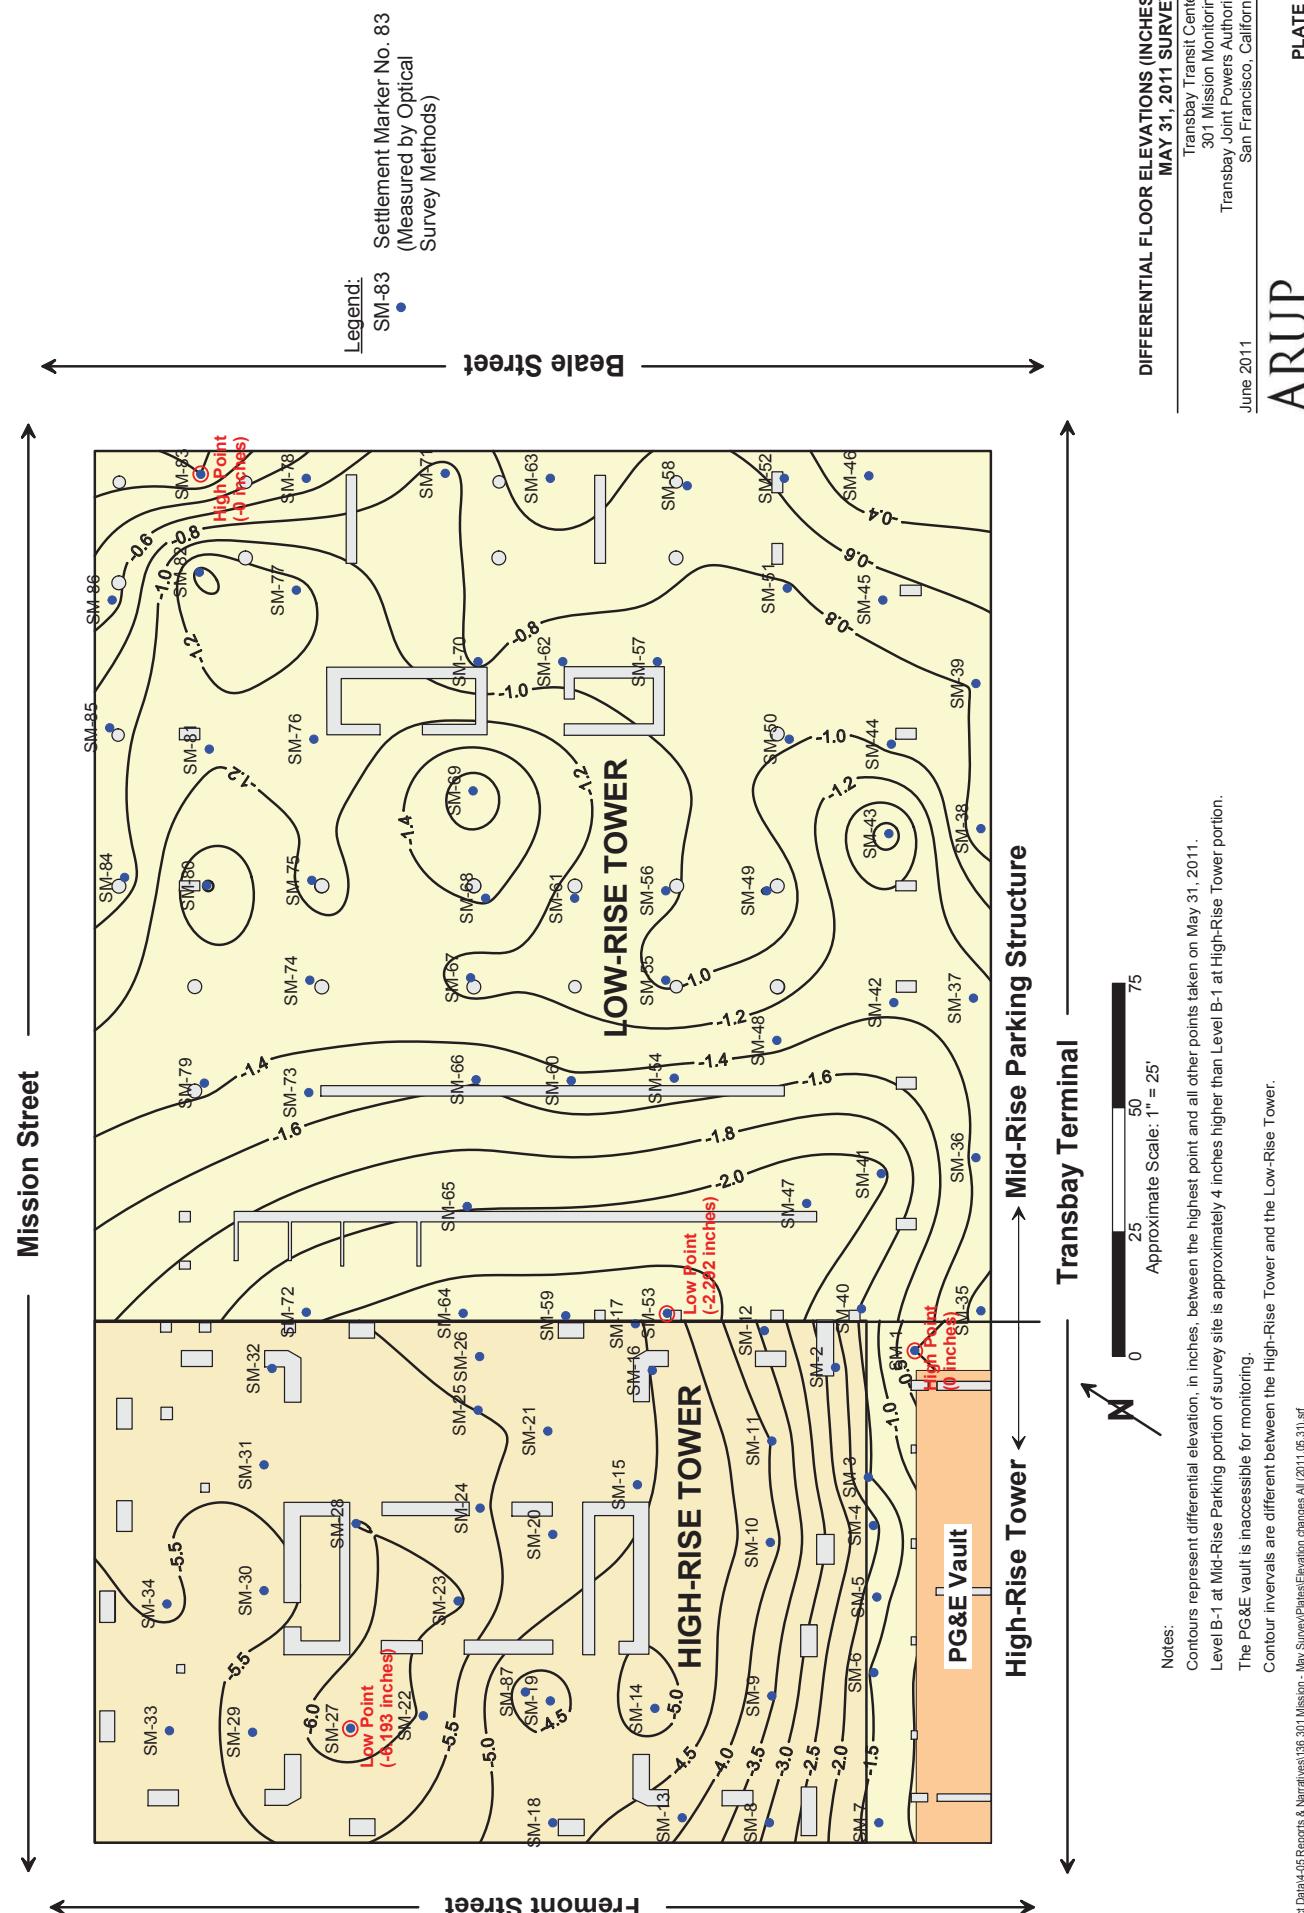


ARUP

Note:
Initial (Baseline) reading
taken on 04/30/09

June 2011

SETTLEMENT OVER TIME
FLOOR ELEVATIONS AT LEVEL B-1
OF 301 MISSION PROPERTY - TOWER:
APRIL 30, 2009 THROUGH MAY 31, 2011



Transbay Transit Center
301 Mission Monitoring
Transbay Joint Powers Authority
San Francisco, California

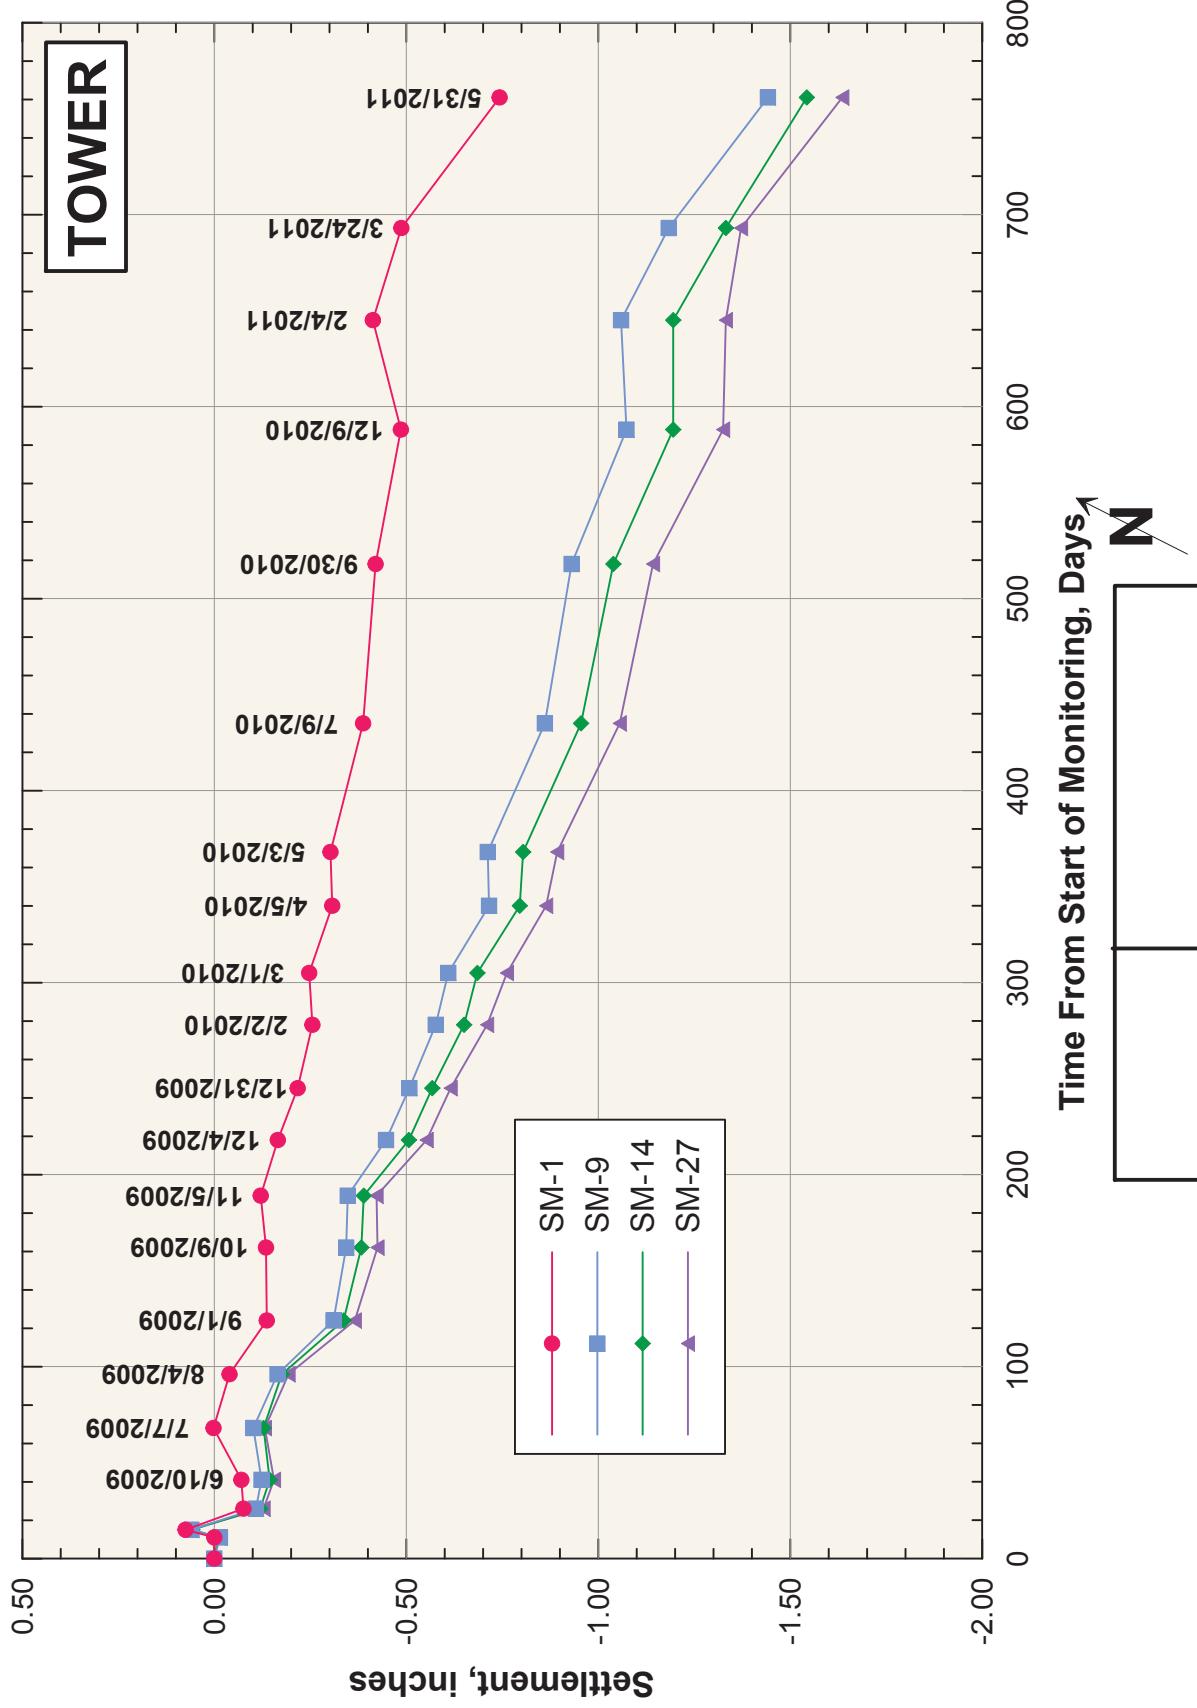

ARUP

Note:
Initial (Baseline) reading
taken on 04/30/09


Q:\13224\24 Internal Project Data\405 Reports & Narratives\136 301 Mission - May Survey\Plates\Plate 5 Settlement Over Time - Midrise.grf

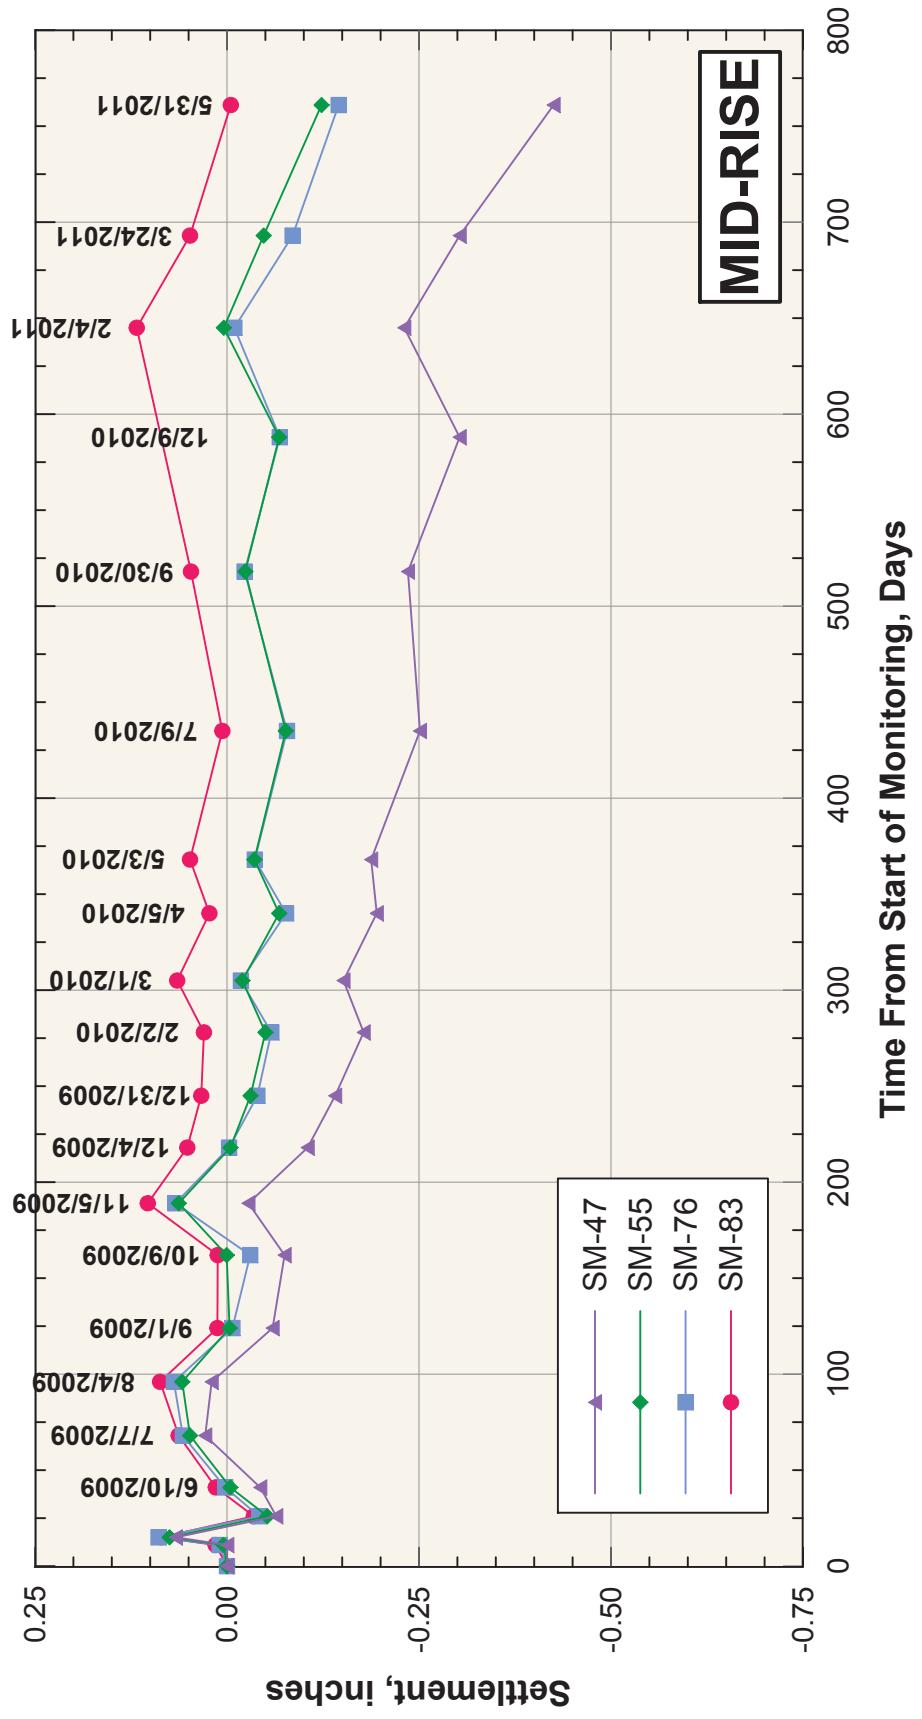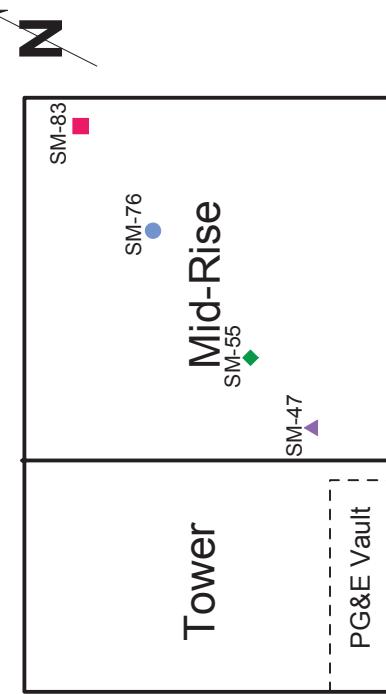

SETTLEMENT OVER TIME
FLOOR ELEVATIONS AT LEVEL B-1
OF 301 MISSION PROPERTY - MID-RISE:
APRIL 30, 2009 THROUGH MAY 31, 2011

Transbay Transit Center
301 Mission Monitoring
Transbay Joint Powers Authority
San Francisco, California

June 2011

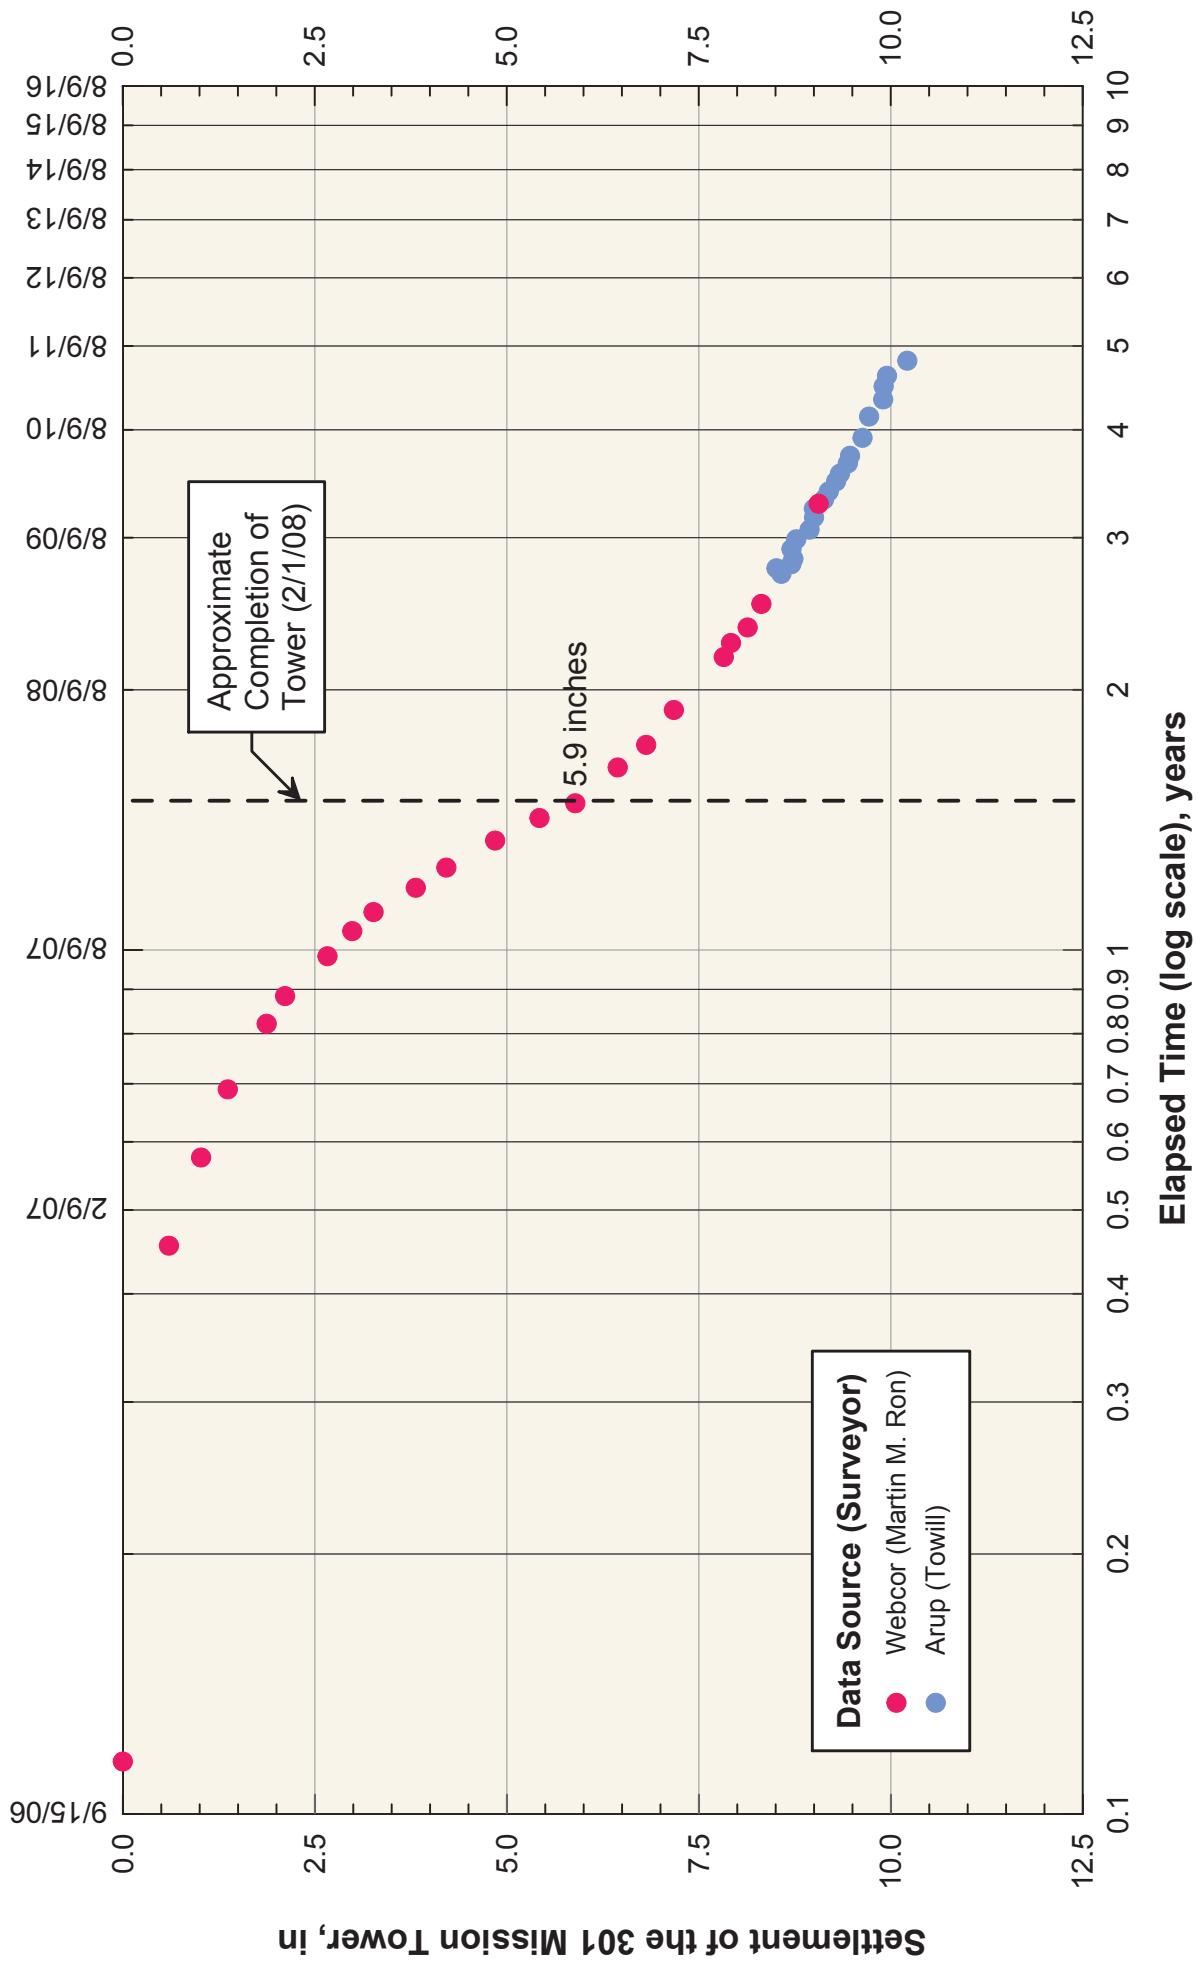

From: Brian Dykes
Sent: Thursday, October 06, 2011 11:10 AM
To: Steven Hood
Cc: John Luciano
Subject: RE: Building Survey
Attachments: 2011-08-26 Memo_301 Mission Settlement - July 2011 Survey.pdf

Categories: Adjacent Properties

Steven,
The surveyors were in the tower during the week ending September 9, which is on the two monthly schedule for these readings.
I do not have the results, but expect them shortly.
They will be passed on to you when I get them.
The previous readings were taken on July 7 and I did not receive them until August 26 just before my vacation in Europe.
I left verbal instructions for Arup to pass them to you.
In case they did not follow through, I have attached a copy for you above.
Brian.

From: Steven Hood [<mailto:shood@MillenniumPtrs.com>]
Sent: Thursday, October 06, 2011 10:32 AM
To: Brian Dykes
Cc: John Luciano
Subject: Building Survey

Brian I noticed the surveyors were in the tower a couple of weeks ago, do you the results of their work and are you planning on sharing it?

Steven C. Hood
Millennium Partners
301 Mission Street, Level B1
San Francisco, CA 94105
t 415.874.4707 f 415.874.4750

This email has been scanned by the MessageLabs Email Security System.
For more information please visit <http://www.messagelabs.com/email>

Check out our progress at <http://transbaycenter.org/construction-updates/construction-cameras>

NOTE: This e-mail communication and any attachments hereto are covered by the Electronic Communications Privacy Act, 18 U.S.C. Sections 2510-2521, and are legally privileged. The information contained herein is confidential, and is intended only for the use of the individual or entity to whom it is addressed. If you are not the intended recipient of this e-mail communication (or an employee or agent responsible for delivering this communication to its intended recipient(s)), you are hereby notified that any retention, copying or further distribution of this e-mail communication and any attachments is strictly prohibited. If you are not the intended recipient, please notify the sender by telephoning 415-597-4620, or by forwarding an e-mail reply message addressed to TransAdmin@TransbayCenter.org confirming that you have already destroyed (deleted) the original e-mail communication and any and all copies thereof. Thank you.

Memorandum

ARUP

To	Brian Dykes (TJPA)	Date
		August 26, 2011
Copies	Robert Beck (TJPA) Emilio Cruz (PMPC) Randy Volenec (PCPA) George Metzger (AAI)	Reference number 132242-60/SMM
From	Stephen McLandrich (Arup) Nick O'Riordan (Arup) Kevin Clinch (Arup)	File reference 4-05 142
Subject	Transbay Transit Center: Results of July 2011 Settlement Survey at 301 Mission Property	Page 1 of 1


Under Arup's Geotechnical Contract with the Transbay Joint Powers Authority through Pelli Clark Pelli Architects, Arup is required to monitor the settlements of the buildings adjacent to the Transbay Transit Center prior to and during construction. We began the monitoring program for the 301 Mission property in April of 2009. This memorandum and the attached plates present an update to our memorandum dated June 24, 2011 with measurements made through July 2011.

Arup has installed an additional nine settlement markers in the floor at basement level B-5. These settlement markers were surveyed three separate times in order to establish a baseline reading. The results of this monitoring are presented in Plates 7 and 8 of this memorandum.

List of Plates

- Plate 1 Floor Elevations at Level B-1 of 301 Mission Property: Periodic Survey – July 7, 2010
- Plate 2 Differential Floor Elevation (Inches) – July 7, 2010 Survey
- Plate 3 Contours of Settlements Measured at the First Level Basement of the 301 Mission Street Structure Between April 30, 2009 and July 7, 2010
- Plate 4 Settlement Over Time Floor Elevations at Level B-1 of 301 Mission Property – Tower: April 30, 2009 through July 7, 2010.
- Plate 5 Settlement Over Time Floor Elevations at Level B-1 of 301 Mission Property – Mid-Rise: April 30, 2009 through July 7, 2010
- Plate 6 Settlements of the 301 Mission Tower Including Monitoring During Construction
- Plate 7 Floor Elevation at Basement Level B-5 of 301 Mission Property: July 7, Survey
- Plate 8 Differential Floor Elevations (Inches) at Basement Level B-5: July 7, 2011 Survey

Note Typo: references to "2010"
on this page should readh "2011"

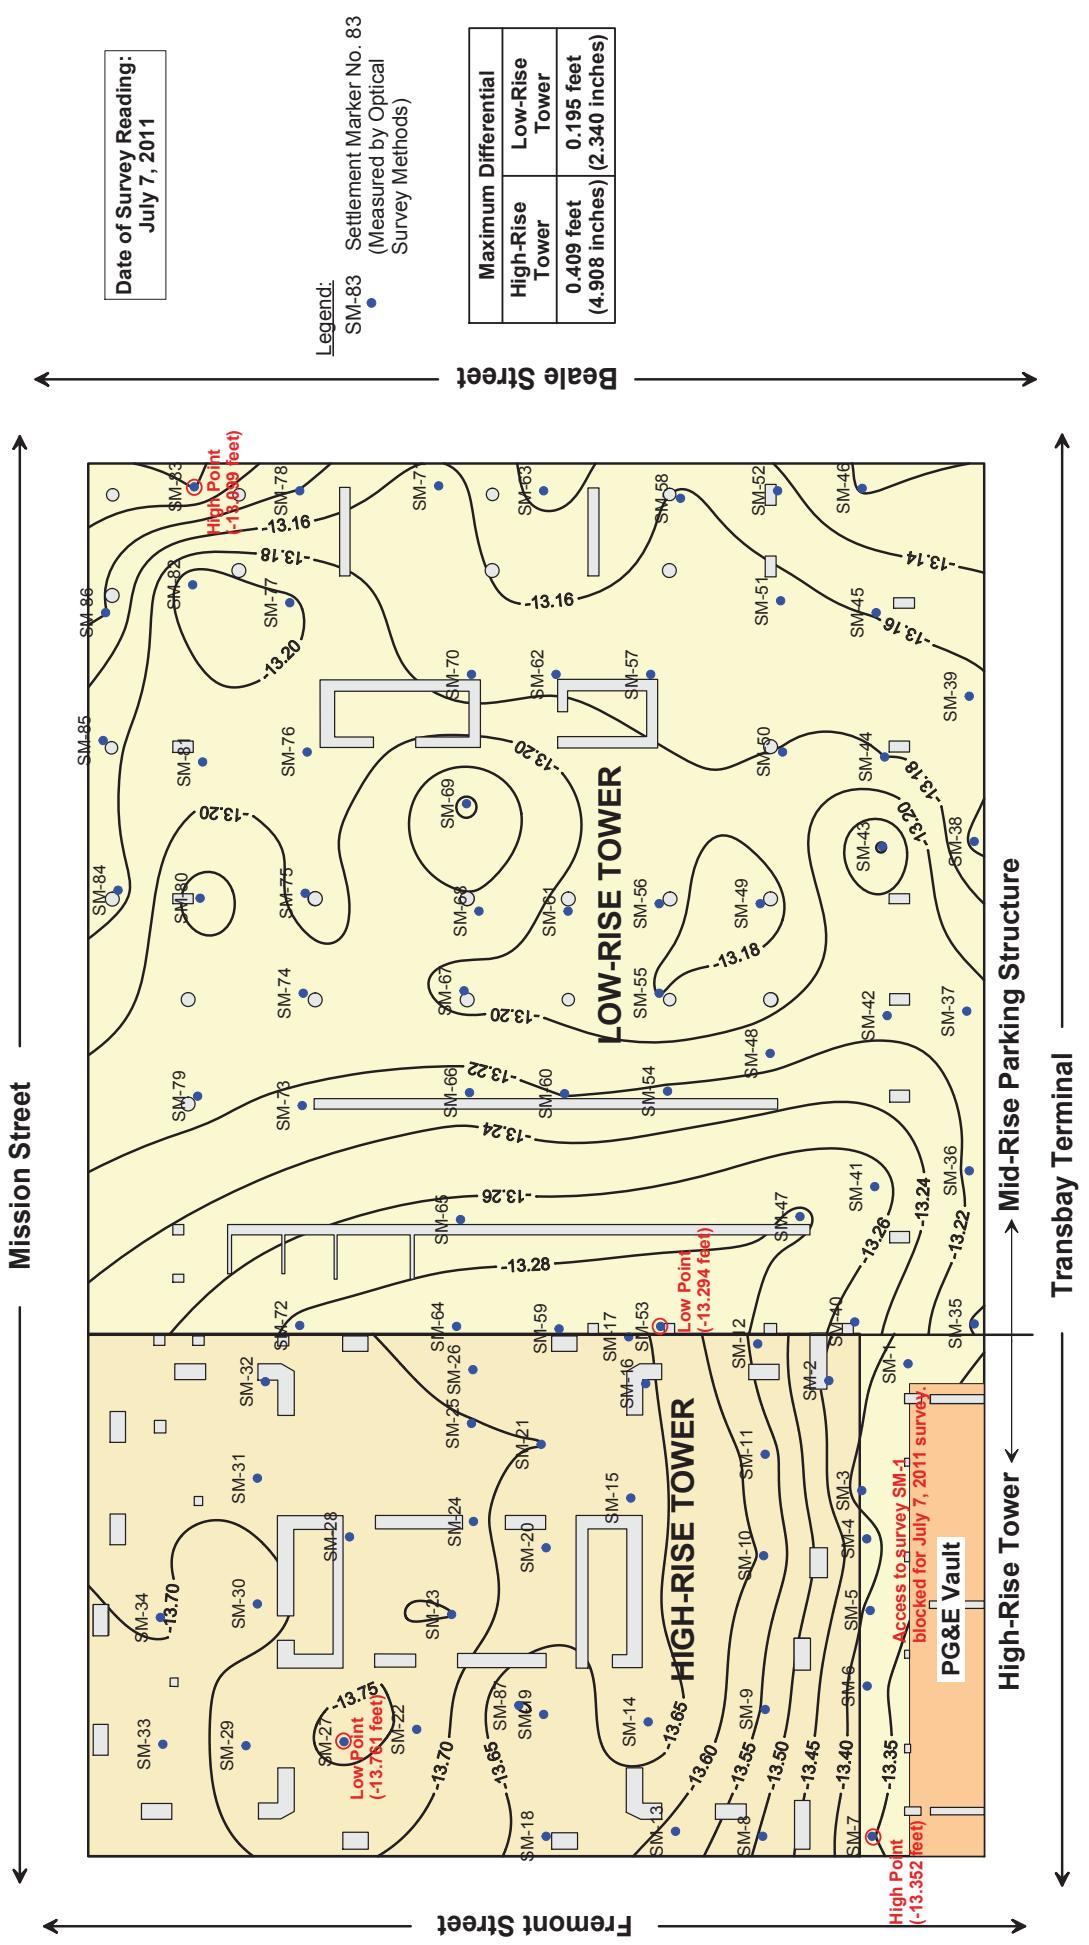



**FLOOR SURVEYS AT LEVEL B-1
OF 301 MISSION PROPERTY:
PERIODIC SURVEY - JULY 7, 2011**

PLATE 1

Notes:
Contours represent elevation, in feet (CCSF Datum), from survey readings taken on July 7, 2011.
Level B-1 at Mid-Rise Parking portion of survey site is approximately 4 inches higher than Level B-1 at High-Rise Tower portion.

The PG&E vault is inaccessible
 Q:\113224 Internal Project Data\4-05 Reports & Narratives\4-2301 Mission - July Survey\Tables\Elevations All (2011-07-07).sif

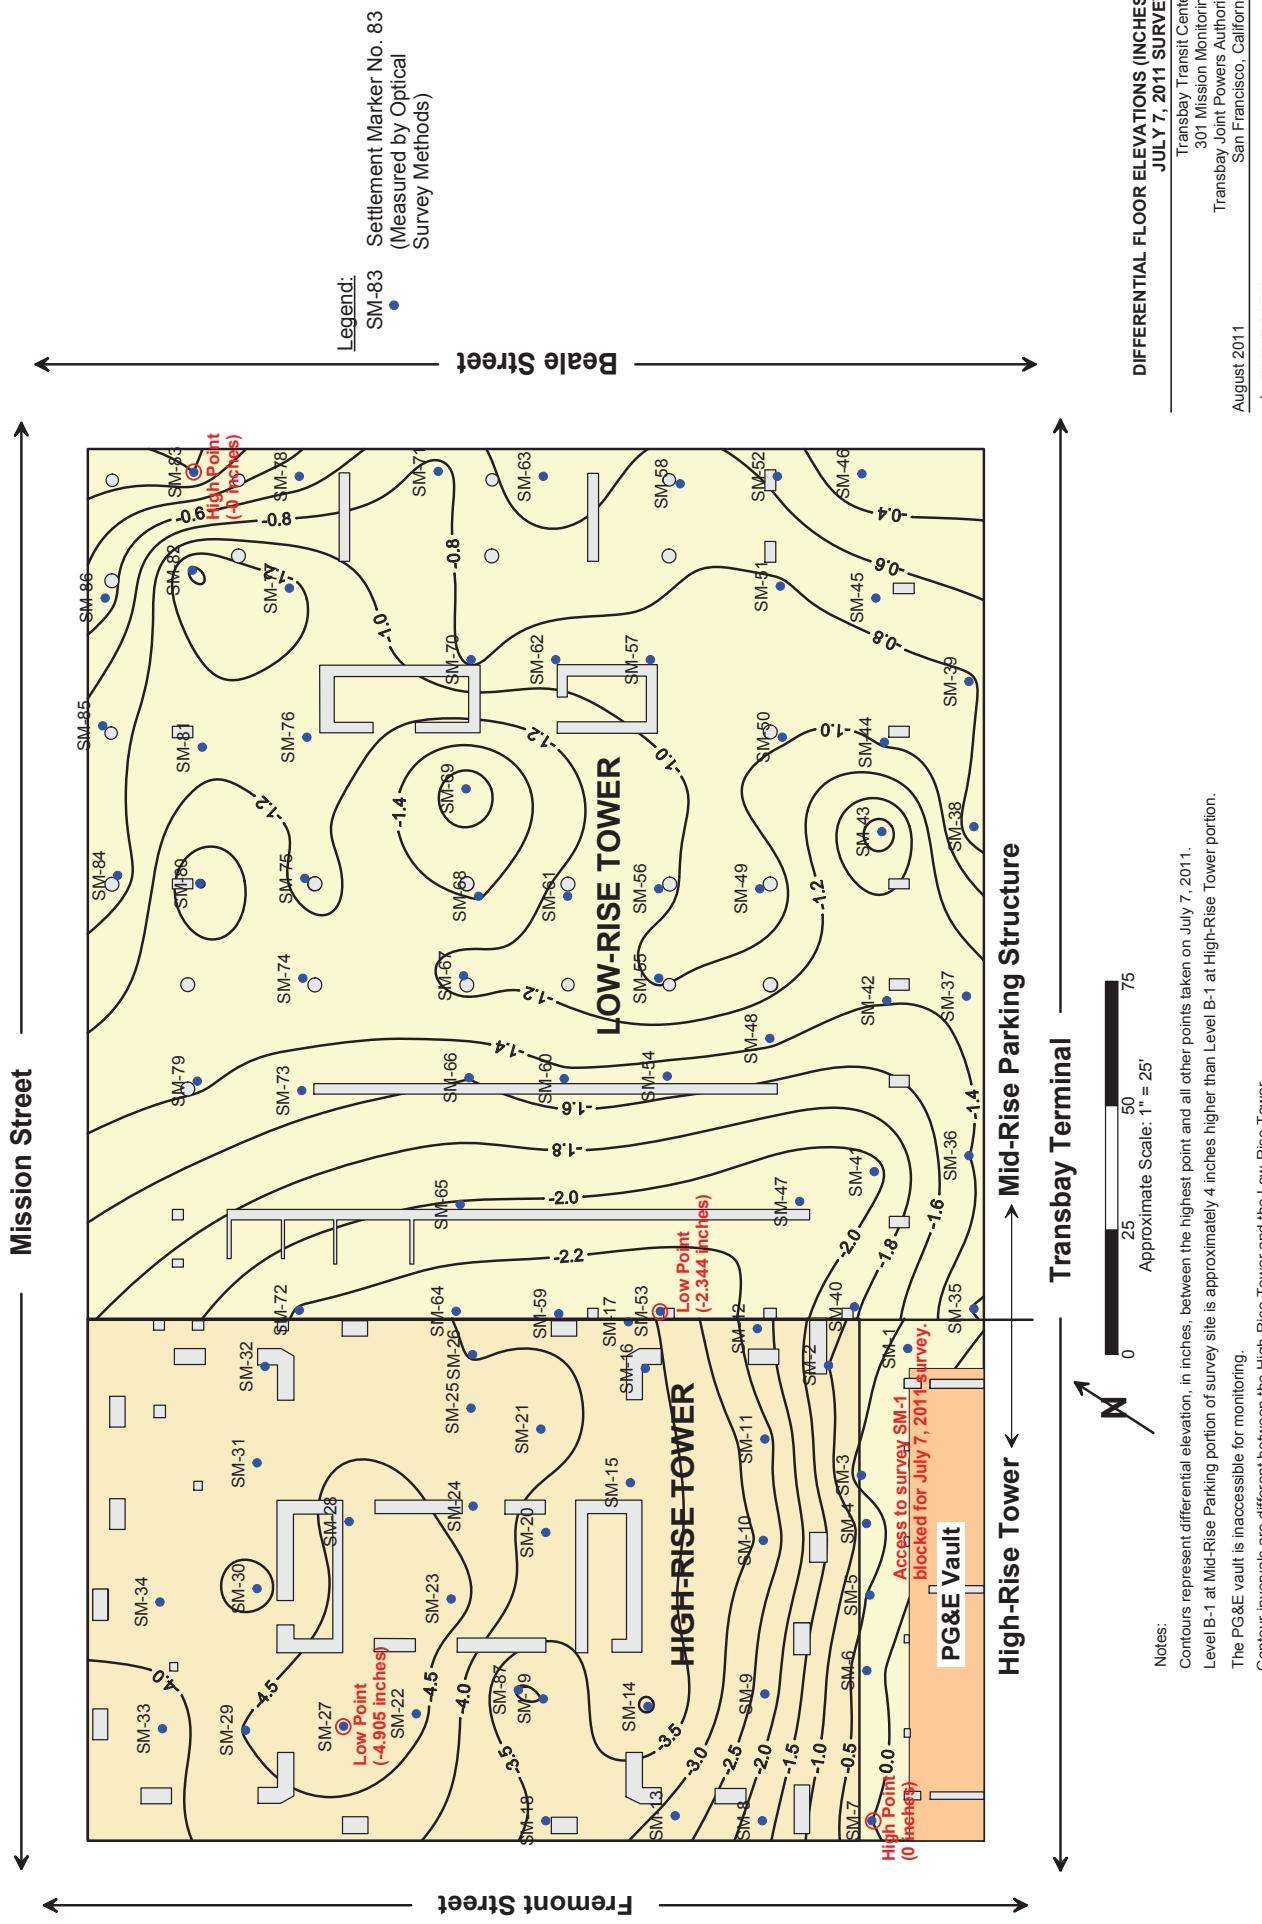

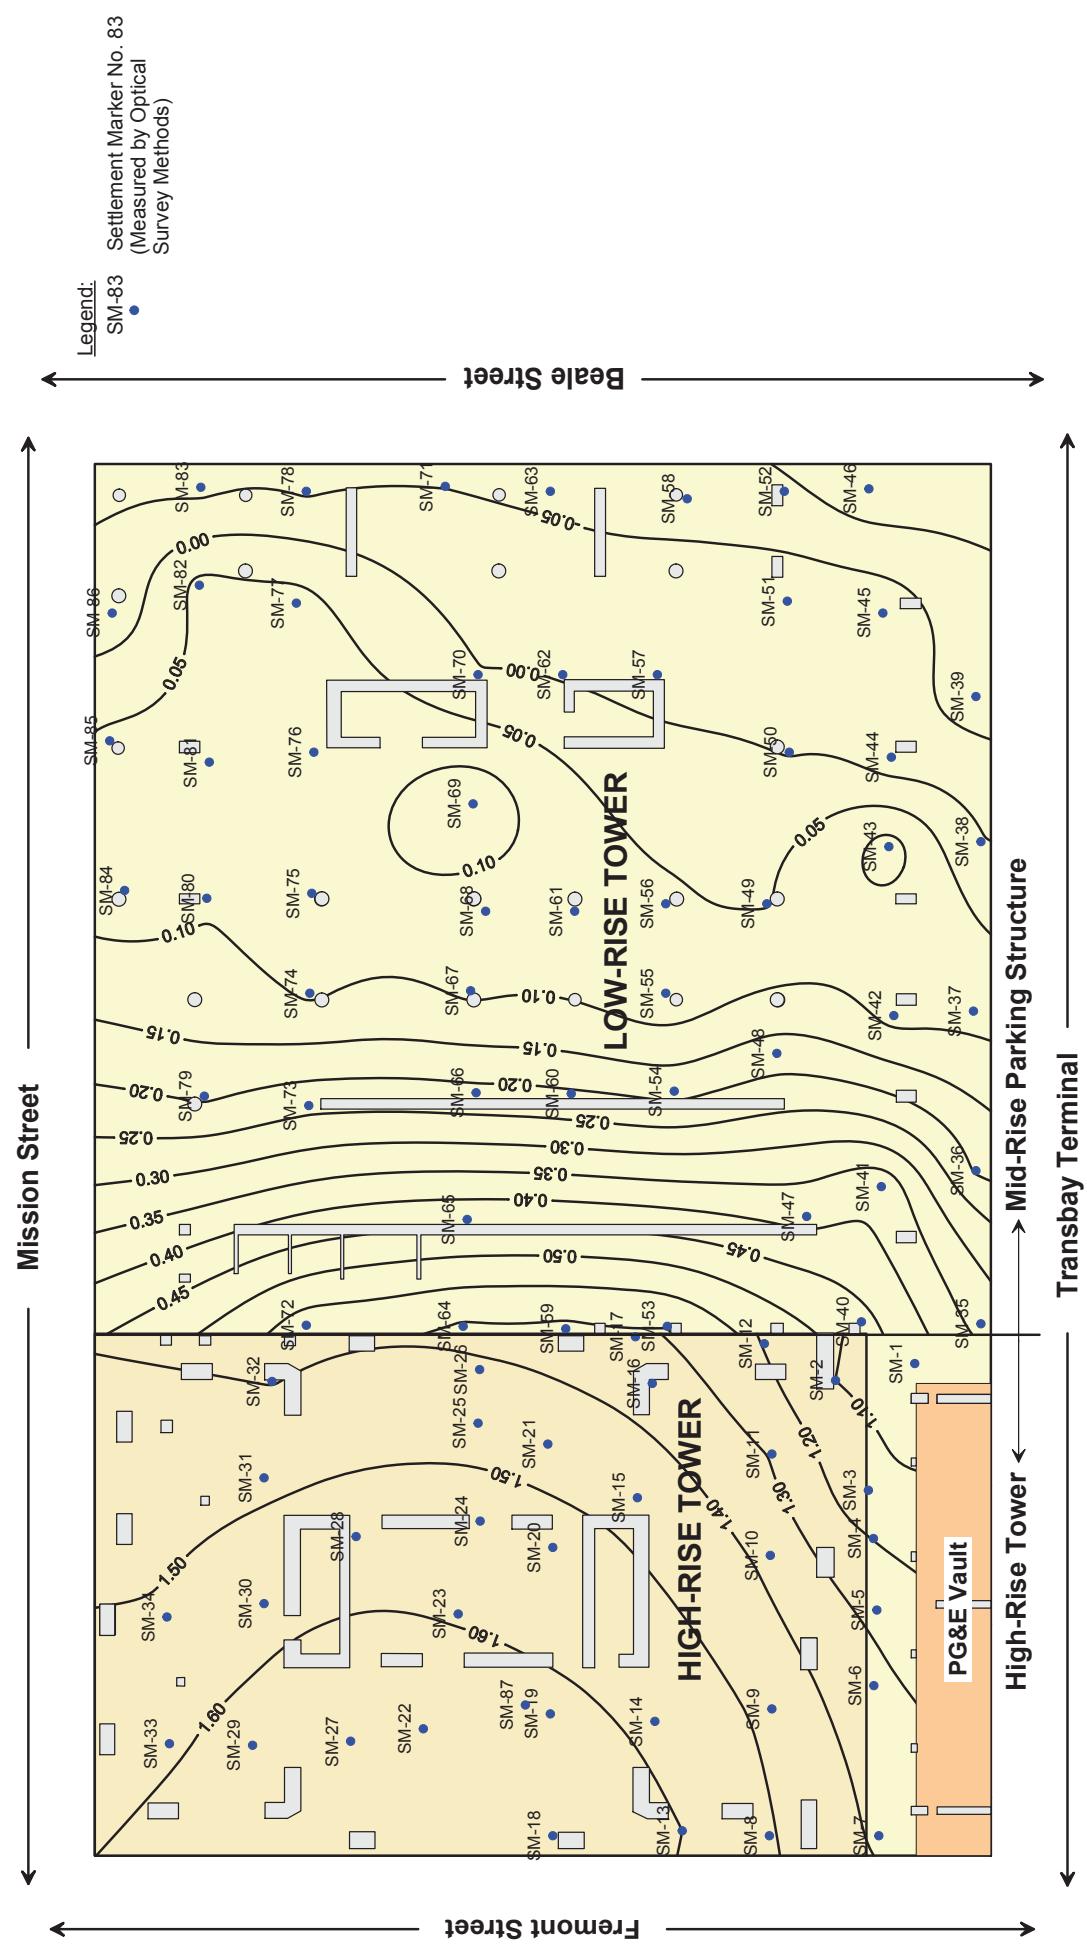

CONTOURS OF SETTLEMENTS MEASURED AT THE FIRST LEVEL BASEMENT OF THE 301 MISSION STREET STRUCTURE BETWEEN APRIL 30, 2009 AND JULY 7, 2011

Transbay Transit Center
301 Mission Monitoring
Transbay Joint Powers Authority
San Francisco, California

August 2011

PLATE 3

ARUP



01322414 Internal Project Data\4.05 Reports & Narratives\14.2 301 Mission - July Survey\Pdf\Settlement Changes All (2011.07.07).pdf

ARUP

August 2011


Note:
Initial (Baseline) reading
taken on 04/30/09

Q:\13224\24 Internal Project Data\405 Reports & Narratives\142 301 Mission - July Survey\Plates\Plate 5 Settlement Over Time - Midrise.grf

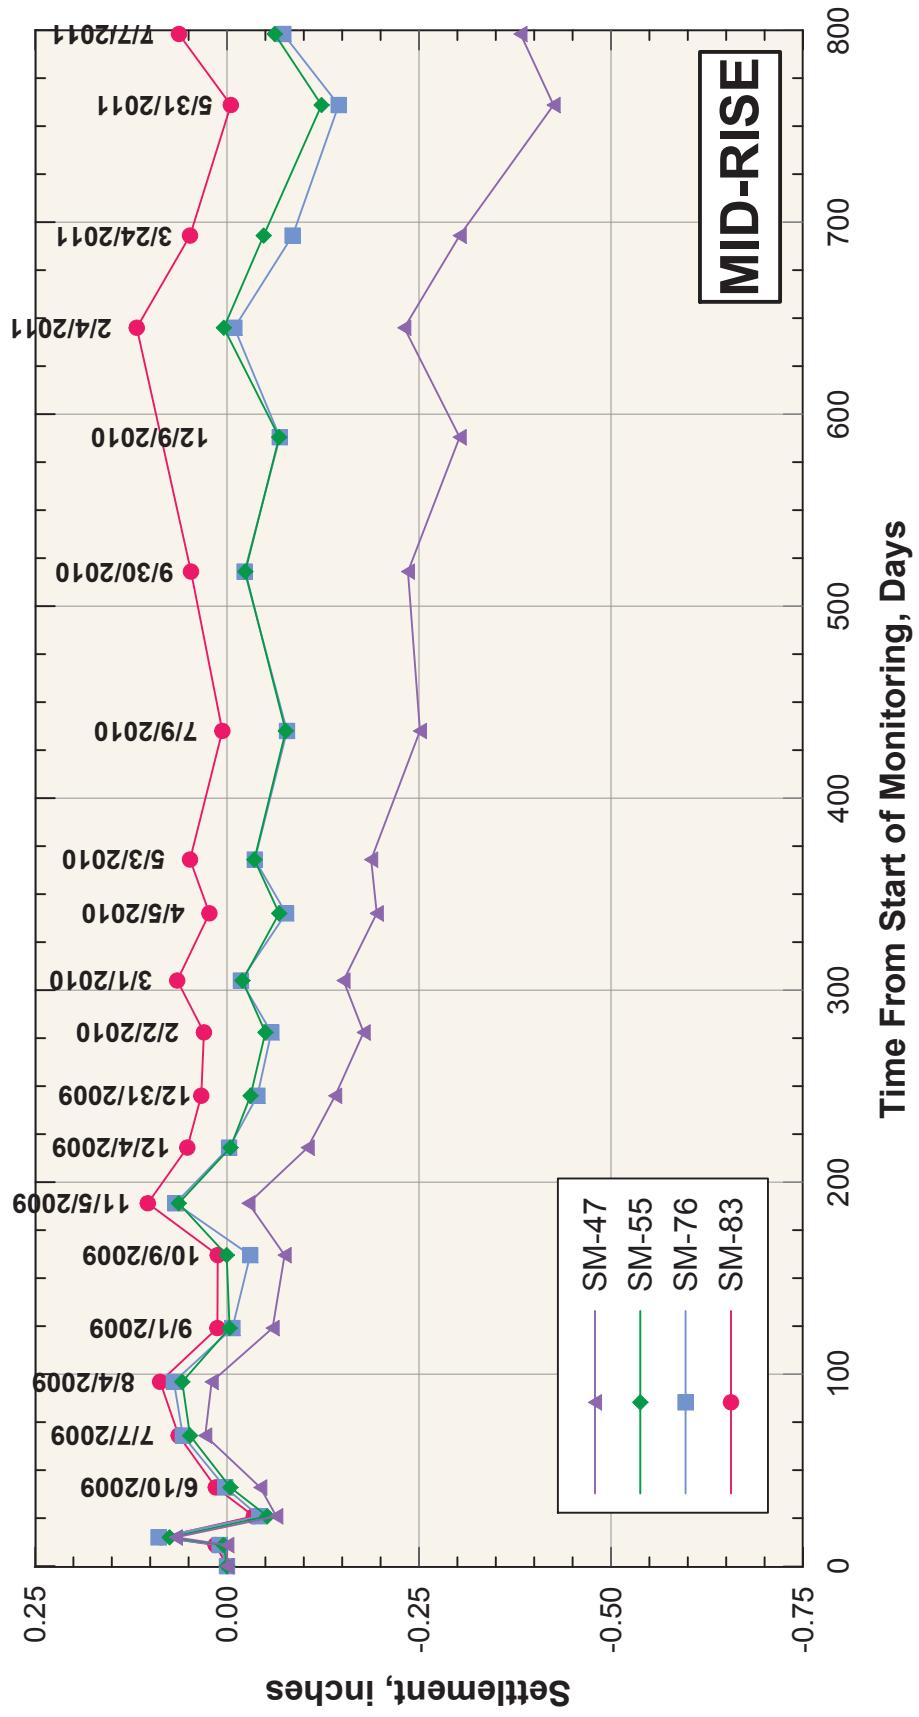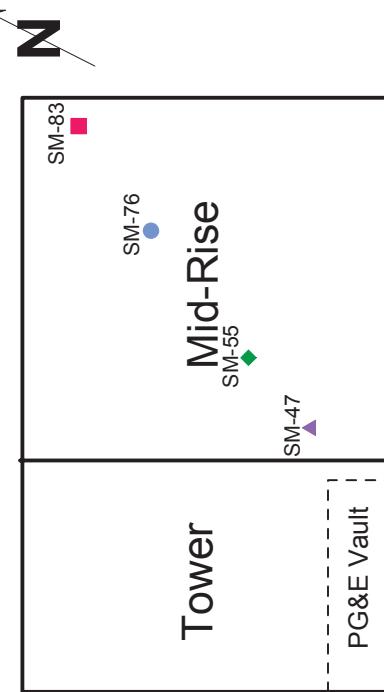

SETTLEMENT OVER TIME
FLOOR ELEVATIONS AT LEVEL B-1
OF 301 MISSION PROPERTY - MID-RISE:
APRIL 30, 2009 THROUGH JULY 7, 2011

Transbay Transit Center
301 Mission Monitoring
Transbay Joint Powers Authority
San Francisco, California

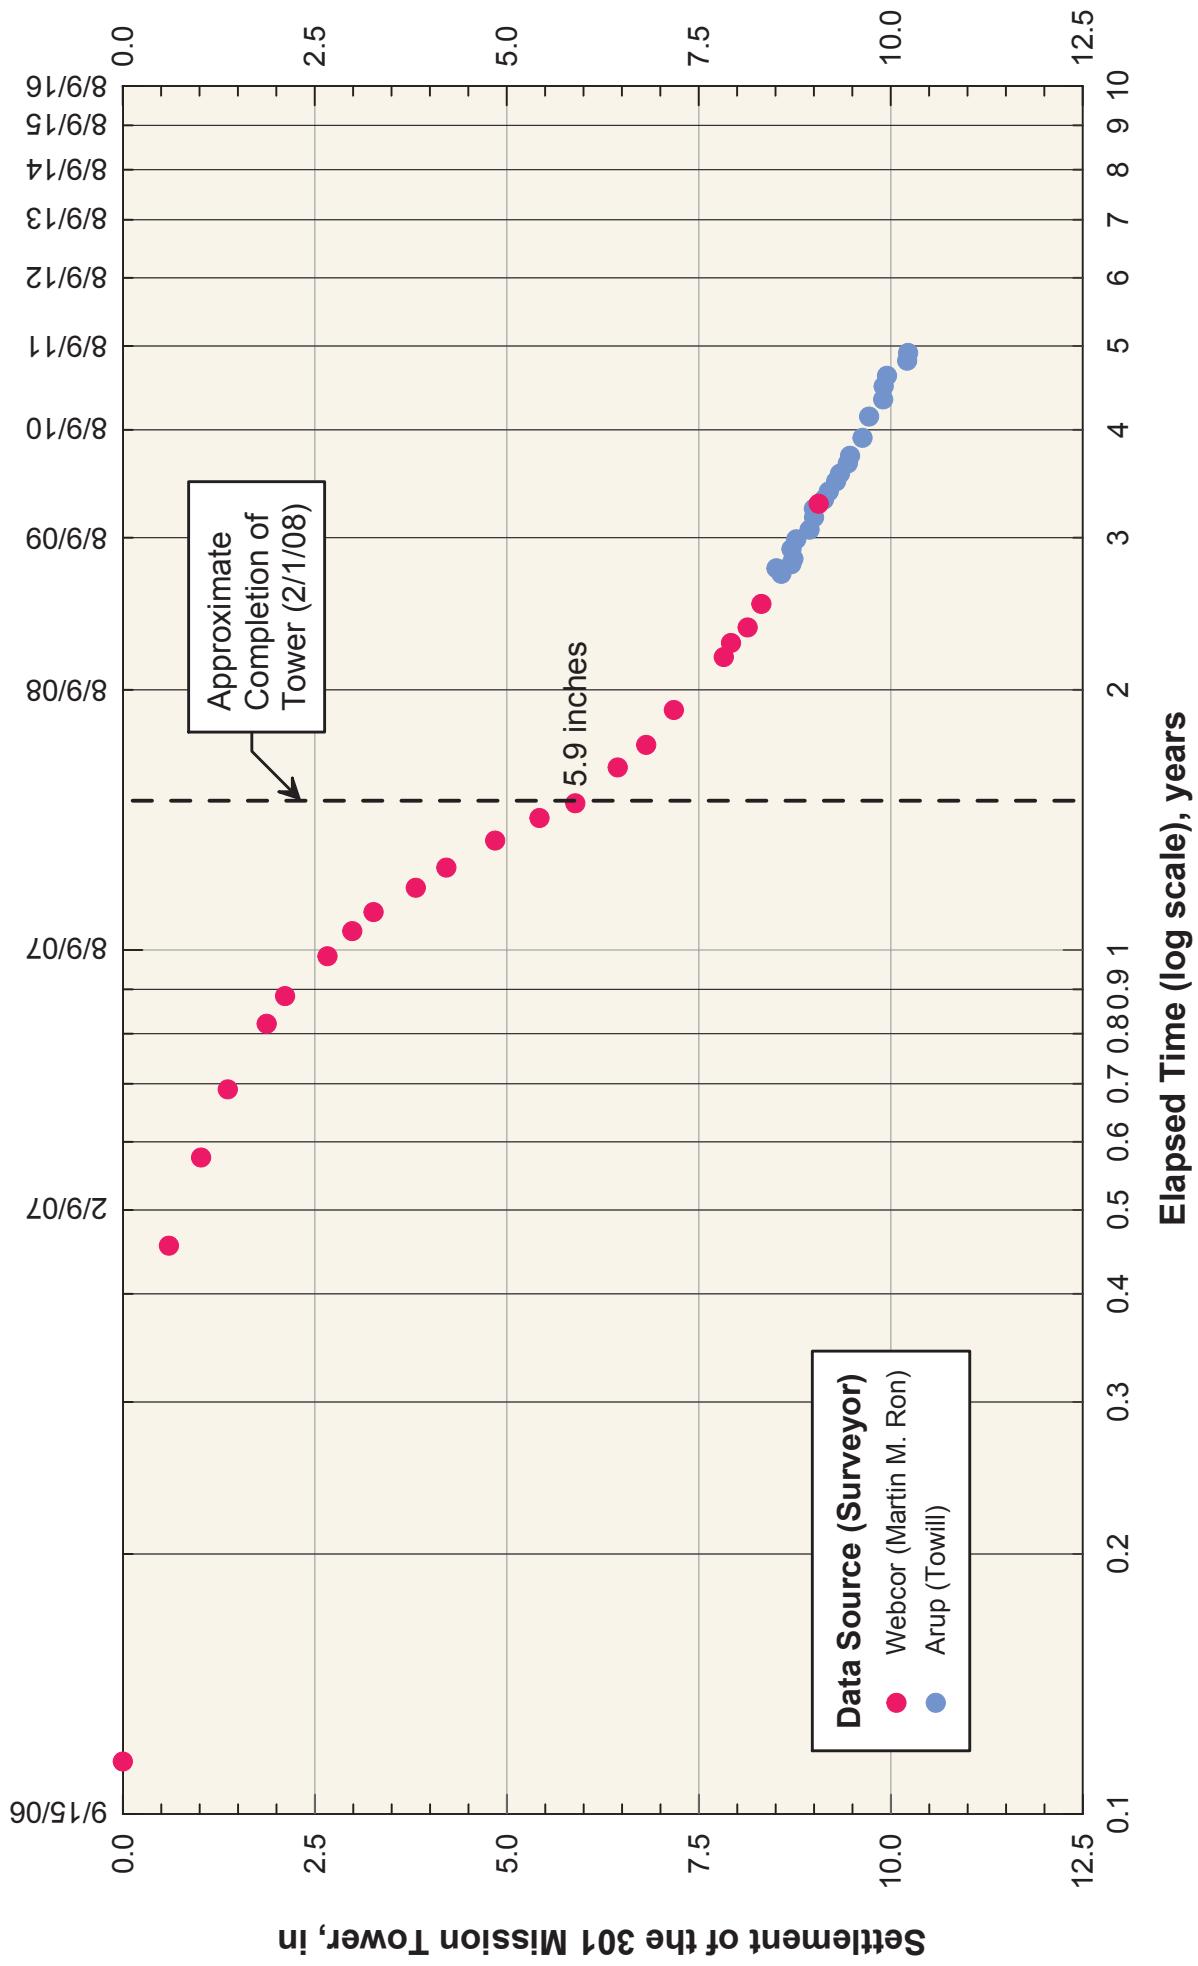



SETTLEMENTS OF THE 301 MISSION TOWER INCLUDING MONITORING DURING CONSTRUCTION

Transbay Transit Center
301 Mission Monitoring
Transbay Joint Powers Authority
San Francisco, California

August 2011

Beginning of Tower Construction: 8/9/06
End of Tower Construction: 2/1/08
Construction Duration: 542 days (1.5 years)

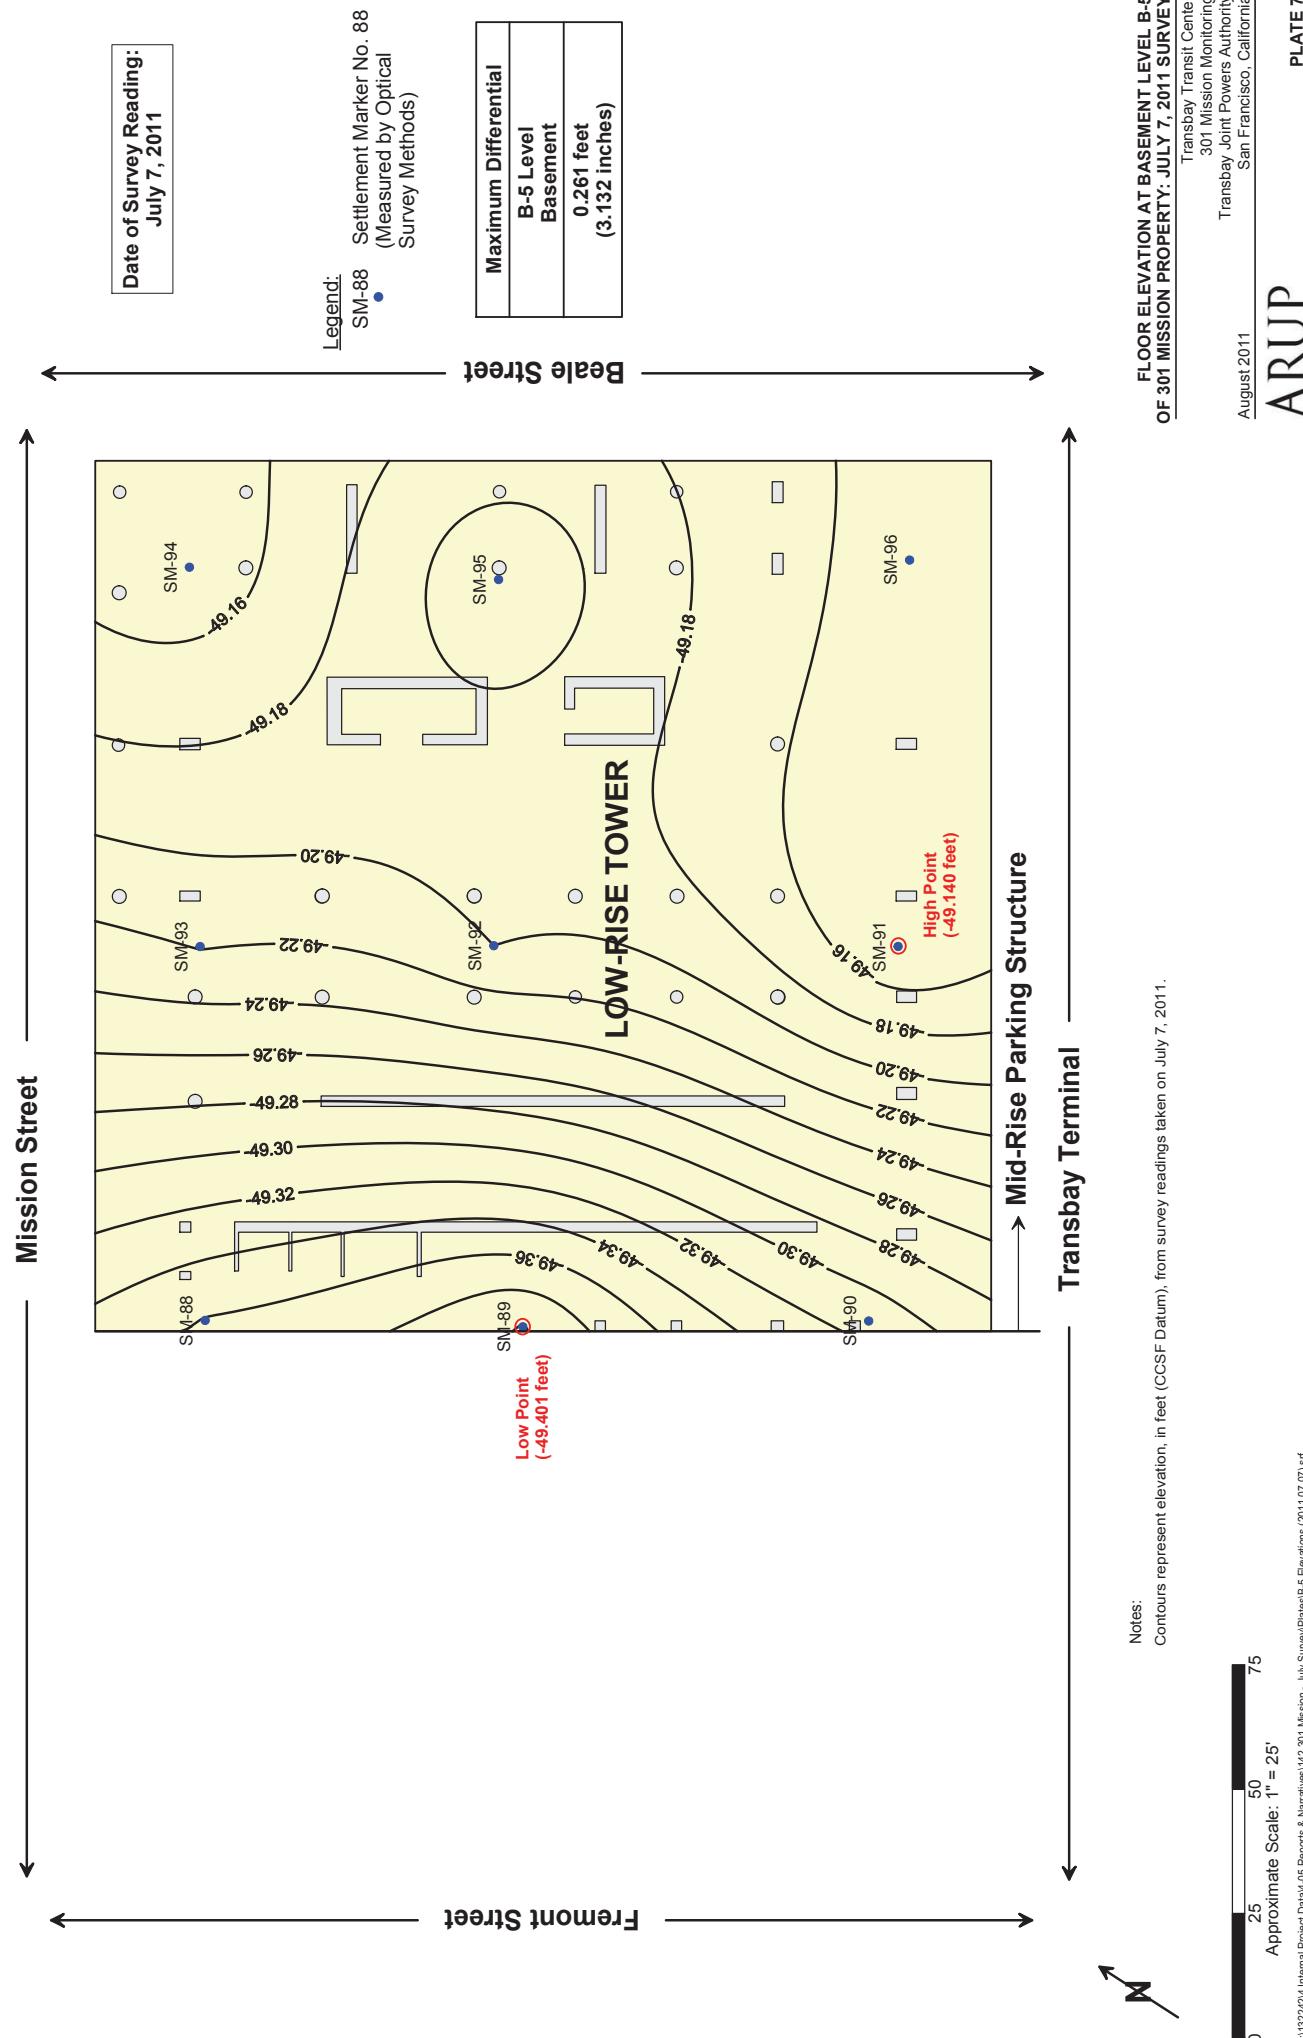

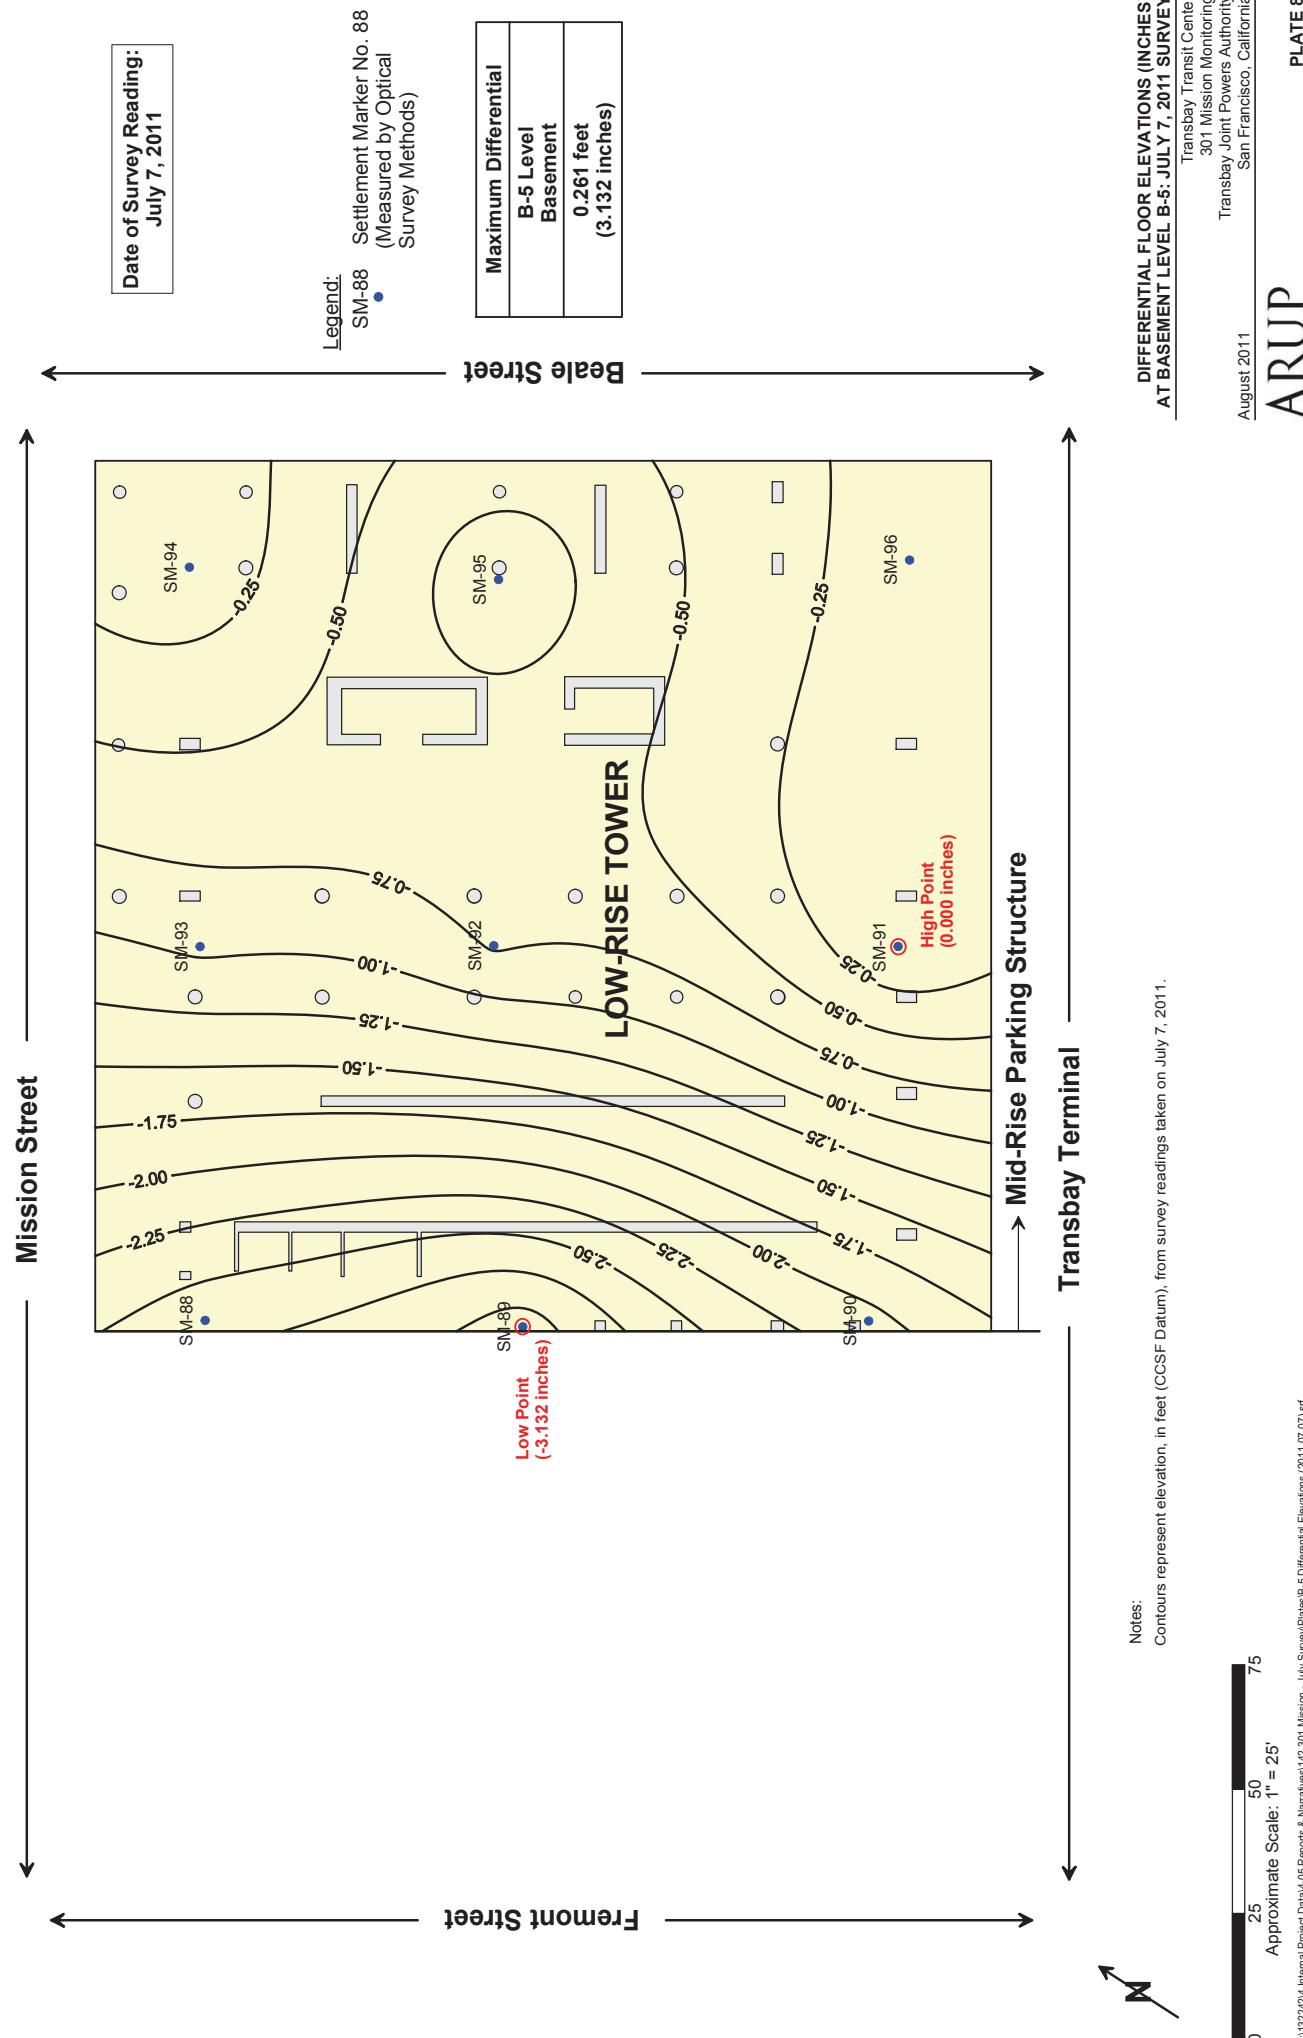

From: Brian Dykes <bdykes@transbaycenter.org>
Sent: Tuesday, October 11, 2011 8:25 AM
To: Steven Hood; John Luciano
Cc: Rebecca Armenta; Stephen McLandrich; Robert Beck
Subject: FW: 301 Mission - September Survey Results
Attachments: 2011-10-10 Memo_301 Mission Settlement - September 2011 Survey.pdf

Steven and John,
Please see the attached memo which contains the settlement records taken on September 8, 2011.
The total settlement curve on plate # 6 is still following the same rate as has been recorded since Arup started taking readings in April 2009.
The maximum total settlement under the tower is now 10.5 inches.
The settlement recorded between April 2009 and September 2011 as shown on plate # 4 is 1.8 inches at markers 9 & 14.
The next set of readings is scheduled to be taken early next month.
Regards, Brian.

From: Stephen McLandrich [<mailto:stephen.mclandrich@arup.com>]
Sent: Monday, October 10, 2011 5:39 PM
To: Brian Dykes; Robert Beck; Emilio Cruz; 'Randy Volenec'; George Metzger
Cc: Nick O'Riordan; Kevin Clinch; DeeDee Maggi
Subject: 301 Mission - September Survey Results

Brian,

Please find the attached memo which contains the latest results of the 301 Mission settlement marker survey.

Note, I am NOT sending these memos directly to Steve Hood and John Luciano but I can if you would like.

Let me know if you have any questions.

Cheers,
Stephen

Stephen McLandrich PE
Senior Engineer | Geotechnics Group

Arup
560 Mission Street Suite 700 San Francisco CA 94105 USA
t +1 415 957 9445 d +1 415 946 0245
f +1 415 957 9096 c +1 415 310 1095
www.arup.com

Check out our progress at <http://transbaycenter.org/construction-updates/construction-cameras>

NOTE: This e-mail communication and any attachments hereto are covered by the Electronic Communications Privacy Act, 18 U.S.C. Sections 2510-2521, and are legally privileged. The information contained herein is confidential, and is intended only for the use of the individual or entity to whom it is addressed. If you are not the intended recipient of this e-mail communication (or an employee or agent responsible for delivering this communication to its intended recipient(s)), you are hereby notified that any retention, copying or further distribution of this e-mail communication and any attachments is strictly prohibited. If you are not the intended

recipient, please notify the sender by telephoning 415-597-4620, or by forwarding an e-mail reply message addressed to TransAdmin@TransbayCenter.org confirming that you have already destroyed (deleted) the original e-mail communication and any and all copies thereof. Thank you.

Memorandum

ARUP


To	Brian Dykes (TJPA)	Date
		10 October 2011
Copies	Robert Beck (TJPA) Emilio Cruz (PMPC) Randy Volenec (PCPA) George Metzger (AAI)	Reference number 132242-60/SMM
From	Stephen McLandrich (Arup) Nick O'Riordan (Arup) Kevin Clinch (Arup)	File reference 4-05 145
Subject	Transbay Transit Center: Results of September 2011 Settlement Survey at 301 Mission Property	Page 1 of 1

Under Arup's Geotechnical Contract with the Transbay Joint Powers Authority through Pelli Clark Pelli Architects, Arup is required to monitor the settlements of the buildings adjacent to the Transbay Transit Center prior to and during construction. We began the monitoring program for the 301 Mission property in April of 2009. This memorandum and the attached plates present an update to our memorandum dated August 26, 2011 with measurements made through September 2011.

List of Plates

- Plate 1 Floor Elevations at Level B-1 of 301 Mission Property: Periodic Survey – September 8, 2010
- Plate 2 Differential Floor Elevation (Inches) – September 8, 2010 Survey
- Plate 3 Contours of Settlements Measured at the First Level Basement of the 301 Mission Street Structure Between April 30, 2009 and September 8, 2010
- Plate 4 Settlement Over Time Floor Elevations at Level B-1 of 301 Mission Property – Tower: April 30, 2009 through September 8, 2010.
- Plate 5 Settlement Over Time Floor Elevations at Level B-1 of 301 Mission Property – Mid-Rise: April 30, 2009 through September 8, 2010
- Plate 6 Settlements of the 301 Mission Tower Including Monitoring During Construction
- Plate 7 Floor Elevation at Basement Level B-5 of 301 Mission Property: September 8, 2011 Survey
- Plate 8 Differential Floor Elevations (Inches) at Basement Level B-5: September 8, 2011 Survey

Note Typo: references to "2010" on this page should read "2011"

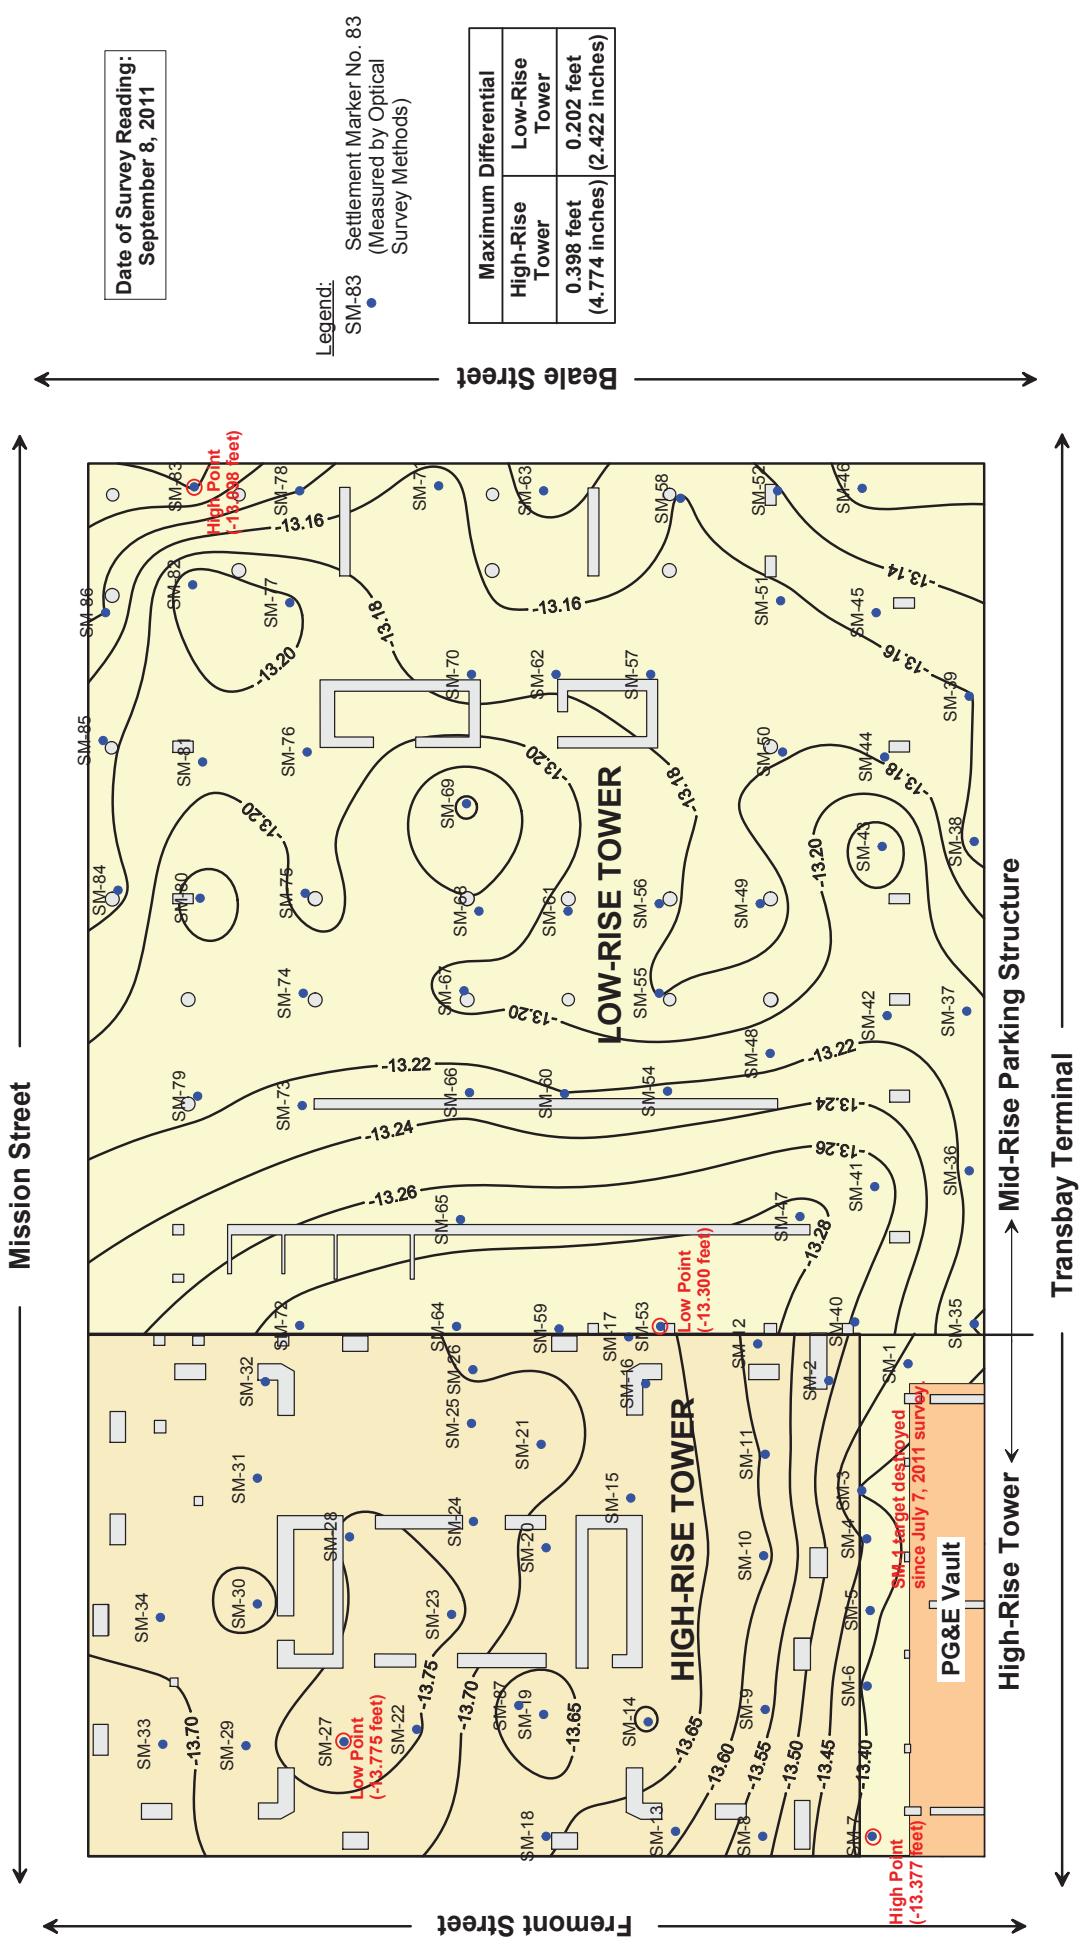

FLOOR ELEVATIONS AT LEVEL OF
OF 301 MISSION PROPERTY:
PERIODIC SURVEY - SEPTEMBER 8, 2011

Transbay Transit Center
301 Mission Monitoring
Transbay Joint Powers Authority
San Francisco, California

2011
JF

PLATE 1


J:\\SF\\132001\\13224\\Internal Project Data\\4-05 Reports & Narratives\\145 301 Mission - September Survey\\Plates\\Elevations All (2011.09.08).tif


ARUP

**DIFFERENTIAL FLOOR ELEVATIONS (INCHES)
SEPTEMBER 8, 2011 SURVEY**

Transbay Transit Center
301 Mission Monitoring
Transbay Joint Powers Authority
San Francisco, California

October 2011

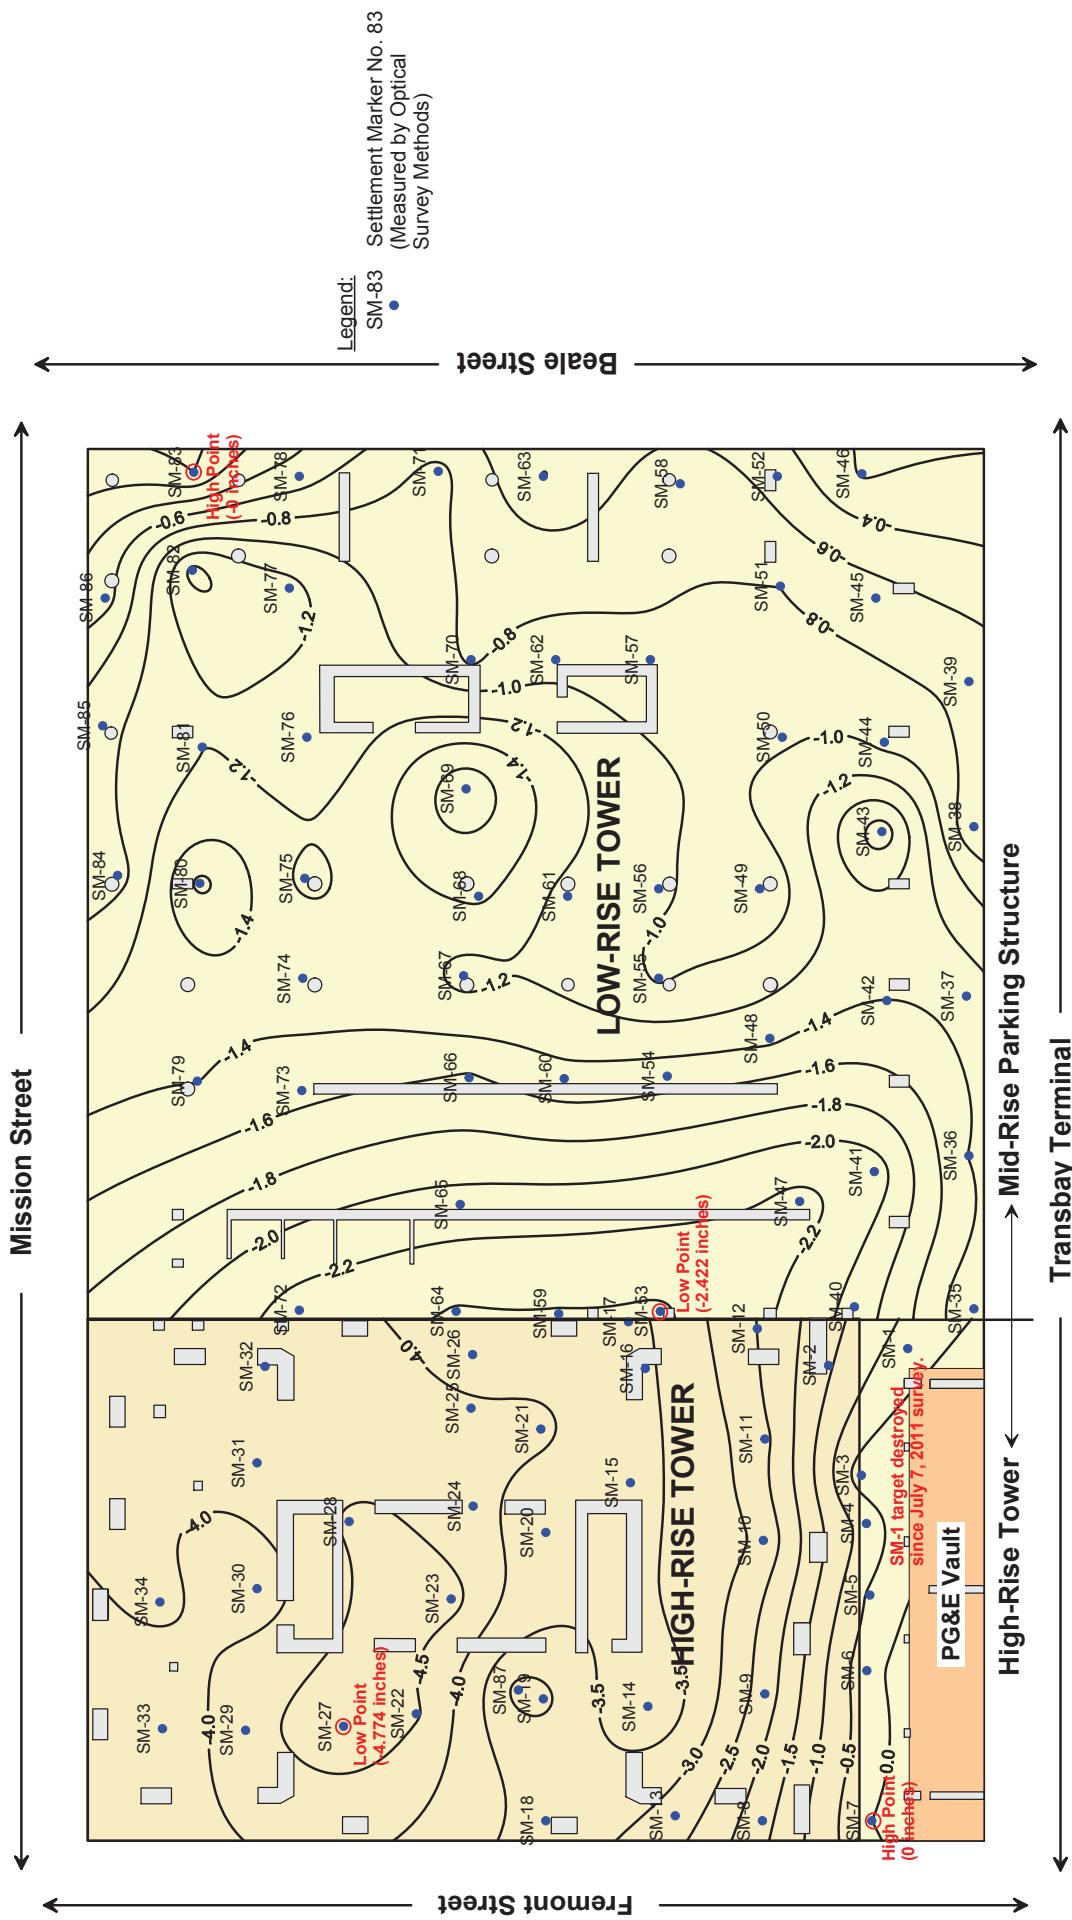

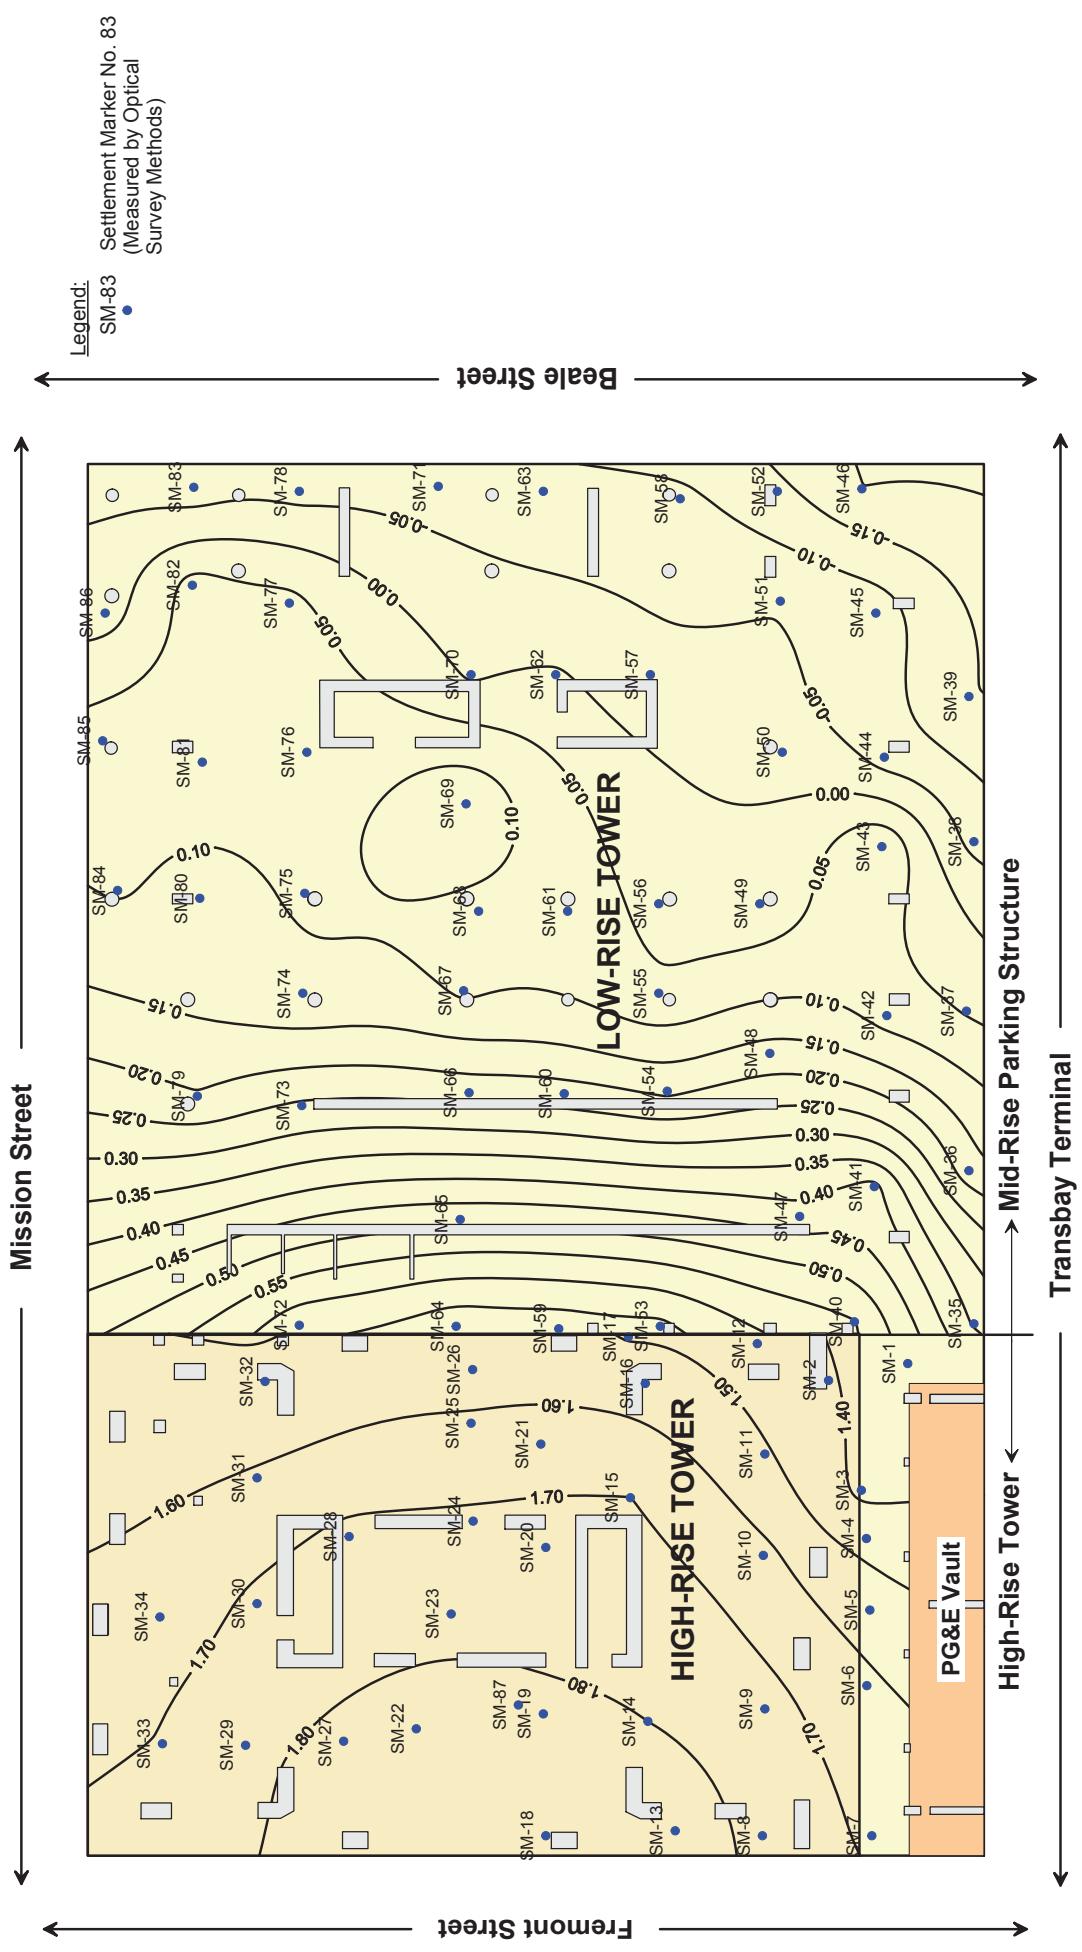

**CONTOURS OF SETTLEMENTS MEASURED AT THE
FIRST LEVEL BASEMENT OF THE 301 MISSION STREET
STRUCTURE BETWEEN APRIL 20, 2000 AND SEPTEMBER 9, 2004**

STRUCTURE BETWEEN APRIL 30, 2009 AND SEPTEMBER 8, 2011 Transbay Transit Center

Handbook of Human Services
301 Mission Monitoring

October 2011 Transbay Joint Powers Authority
San Francisco, California

San Francisco, California
October 2011


Contours represent elevation change, in inches, between Baseline survey (April 30, 2009) and readings taken on September 8, 2011. Level B-1 at Mid-Rise Parking portion of survey site is approximately 4 inches higher than Level B-1 at High-Rise Tower portion.

The PG&E vault is inaccessible for monitoring. Negative values of settlement (within Low-rise Tower) indicate uplift.

J:\\S-F\\120000\\132424\\Internal Project Data\\45 - Reports & Narratives\\145 301 Mission - September Survey\\Plots\\Elevation changes All\\2011.09.08.srf

ARUP

Note:
Initial (Baseline) reading
taken on 04/30/09

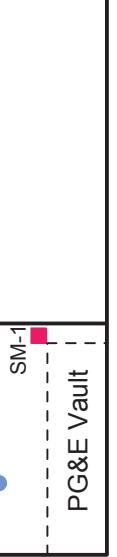


October 2011
APRIL 30, 2009 THROUGH SEPTEMBER 8, 2011

Transbay Transit Center
301 Mission Monitoring
Transbay Joint Powers Authority
San Francisco, California



SETTLEMENT OVER TIME
FLOOR ELEVATIONS AT LEVEL B-1
OF 301 MISSION PROPERTY - TOWER:

APRIL 30, 2009 THROUGH SEPTEMBER 8, 2011

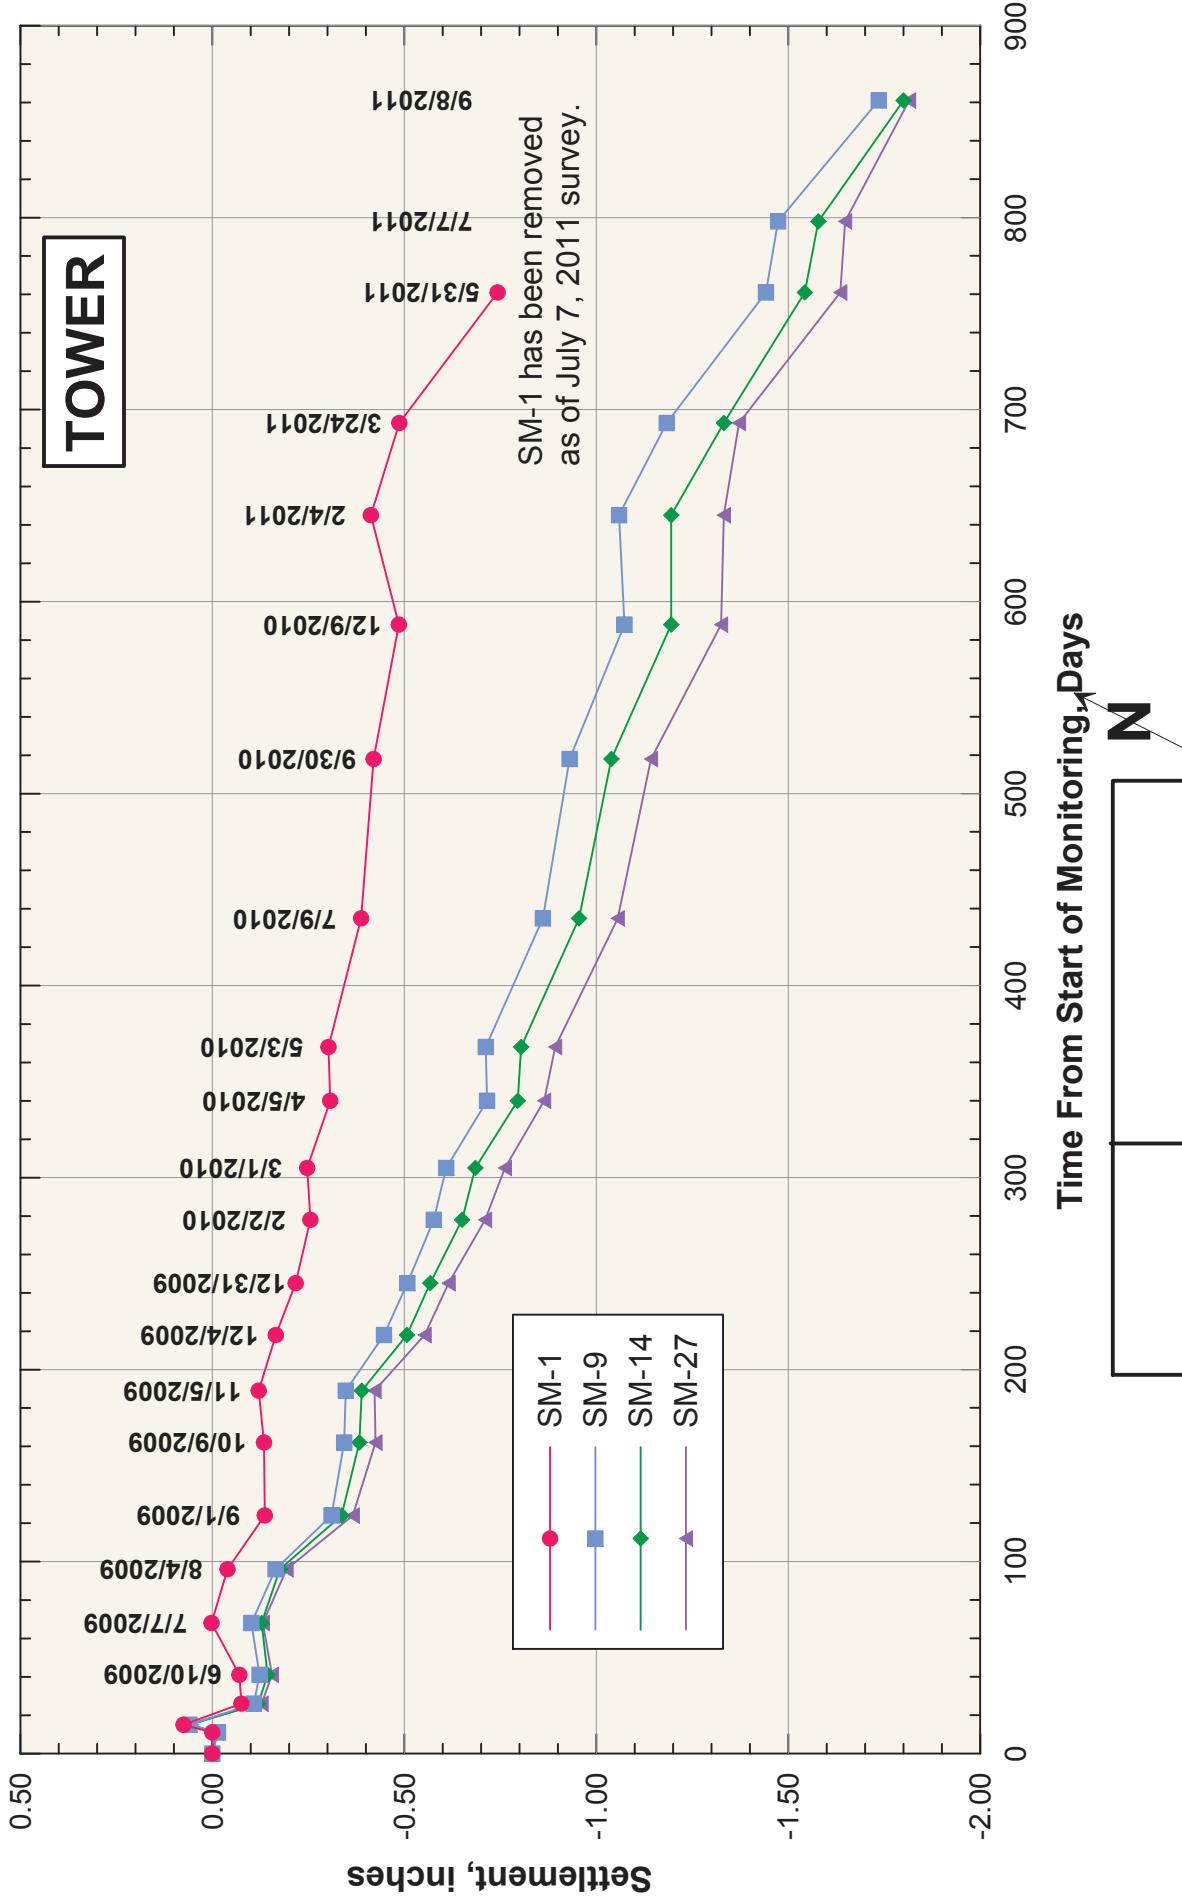

ARUP


Note:
Initial (Baseline) reading
taken on 04/30/09

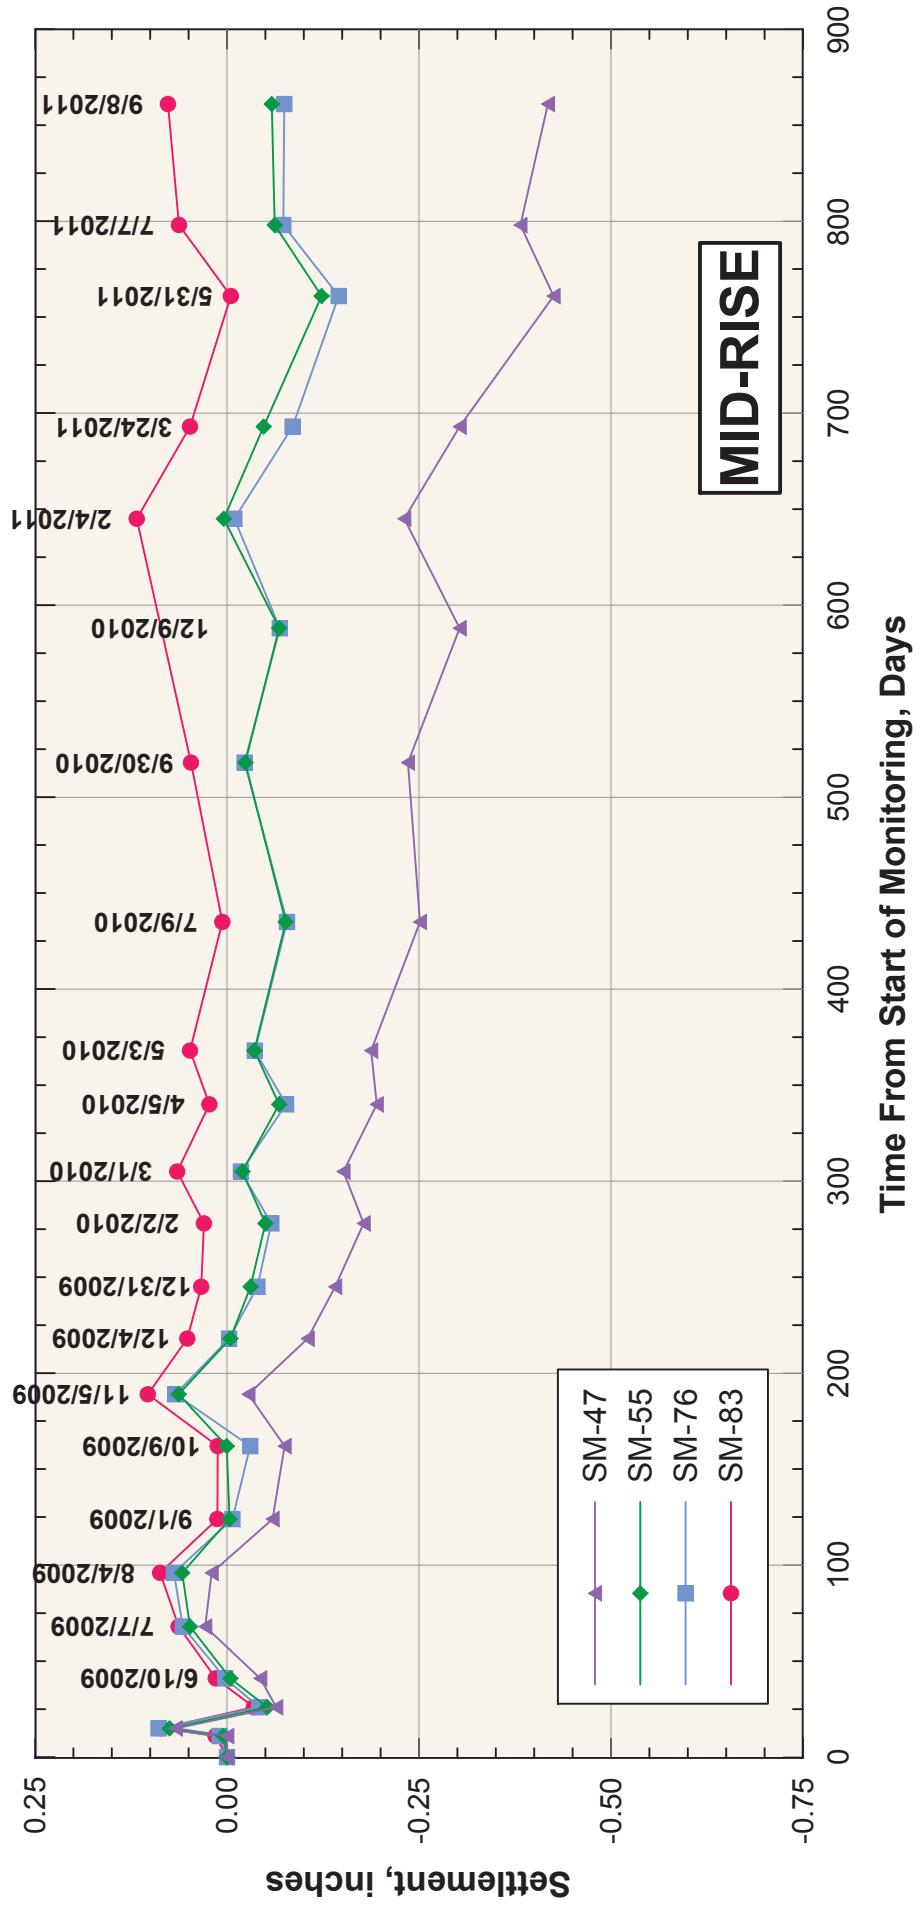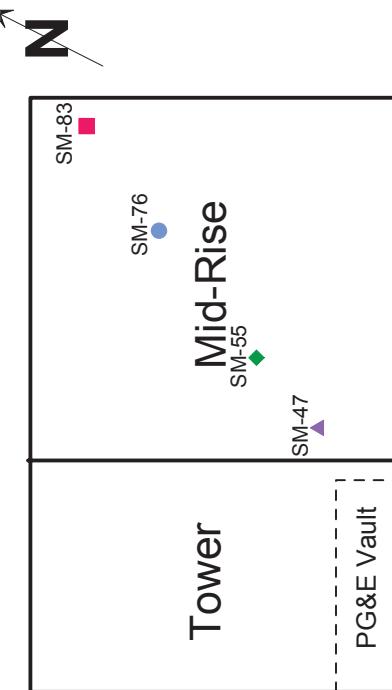

SETTLEMENT OVER TIME
FLOOR ELEVATIONS AT LEVEL B-1
OF 301 MISSION PROPERTY- MID-RISE:
APRIL 30, 2009 THROUGH SEPTEMBER 8, 2011

Transbay Transit Center
301 Mission Monitoring
Transbay Joint Powers Authority
San Francisco, California

October 2011

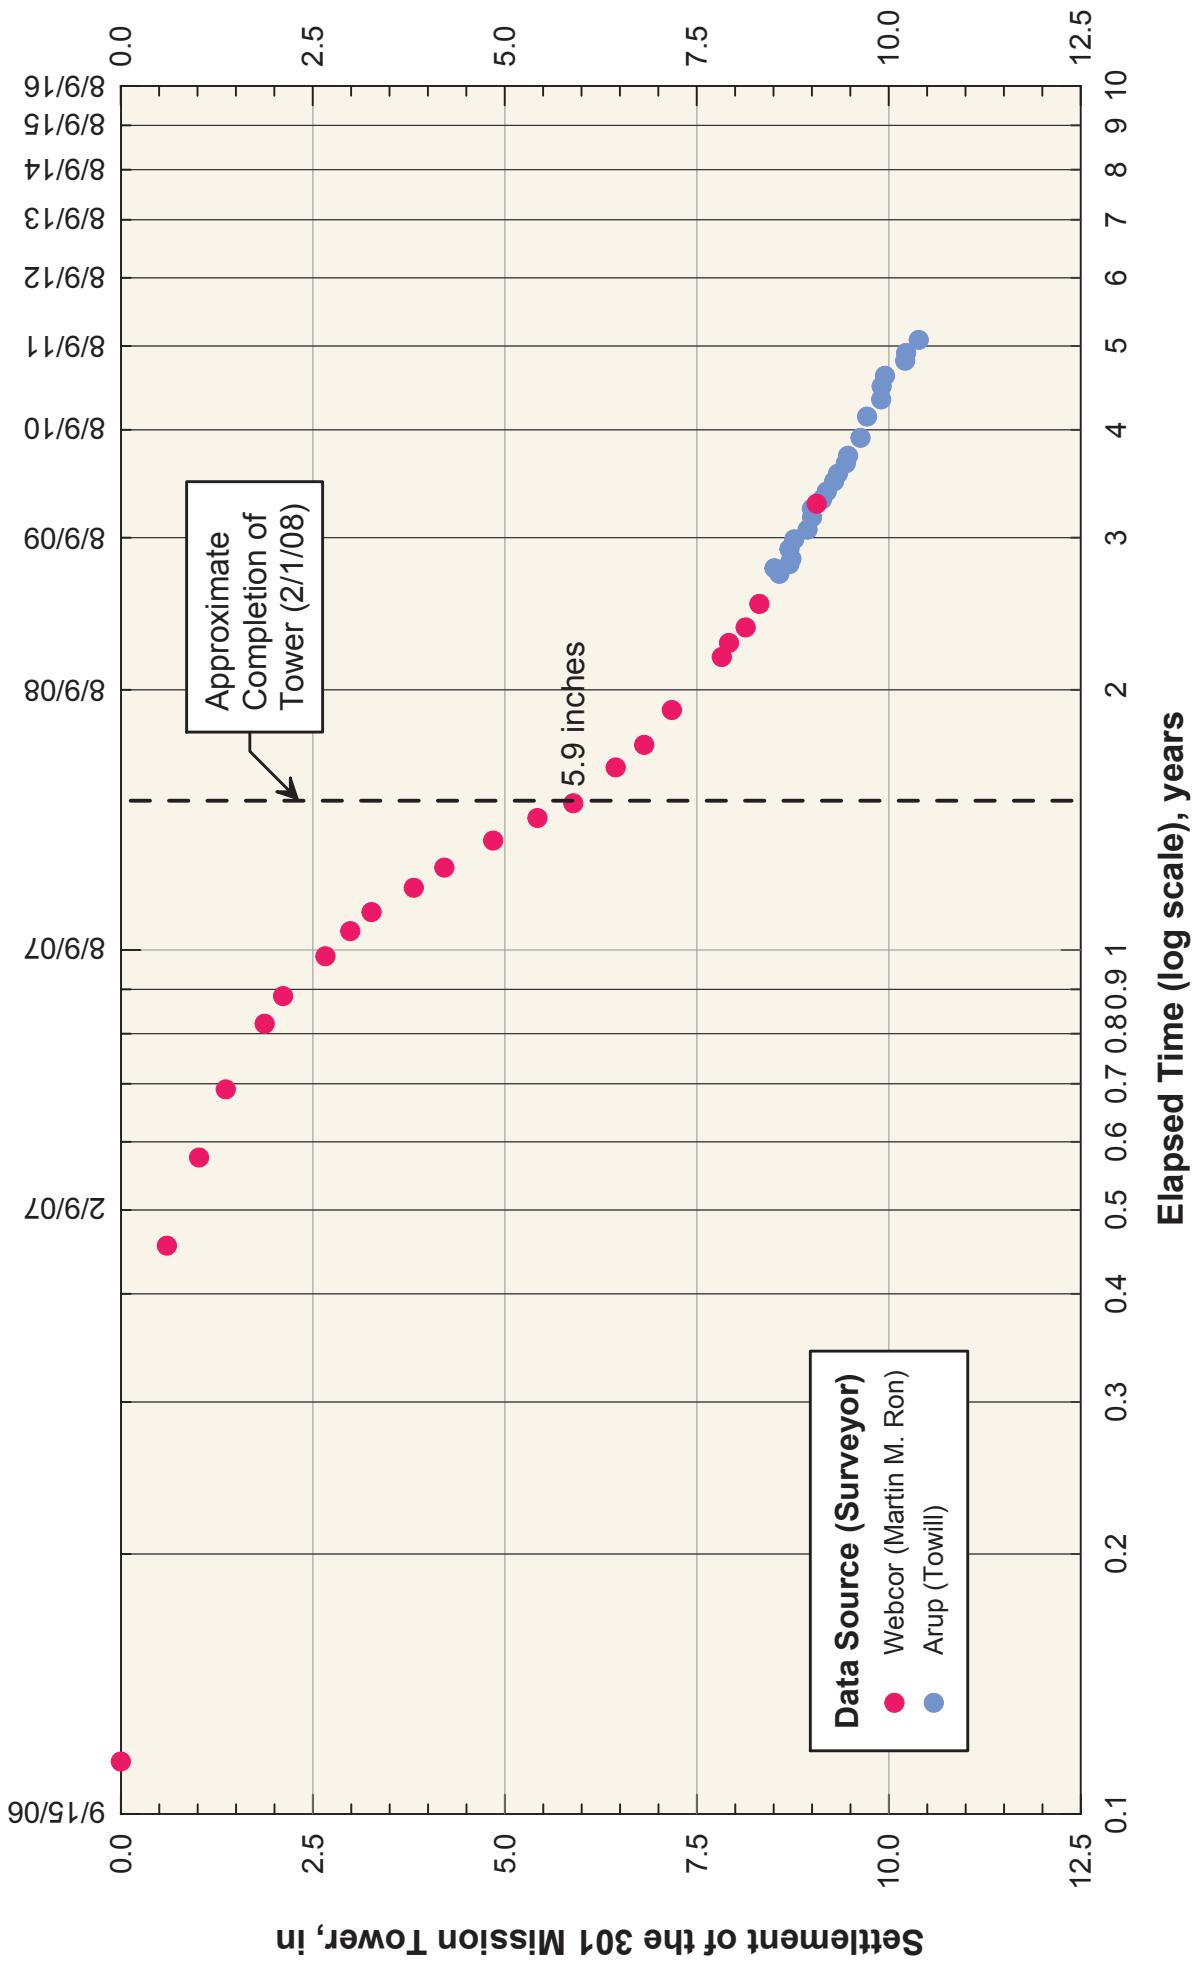



SETTLEMENTS OF THE 301 MISSION TOWER INCLUDING MONITORING DURING CONSTRUCTION

Transbay Transit Center
301 Mission Monitoring
Transbay Joint Powers Authority
San Francisco, California

October 2011

Beginning of Tower Construction: 8/9/06
End of Tower Construction: 2/1/08
Construction Duration: 542 days (1.5 years)

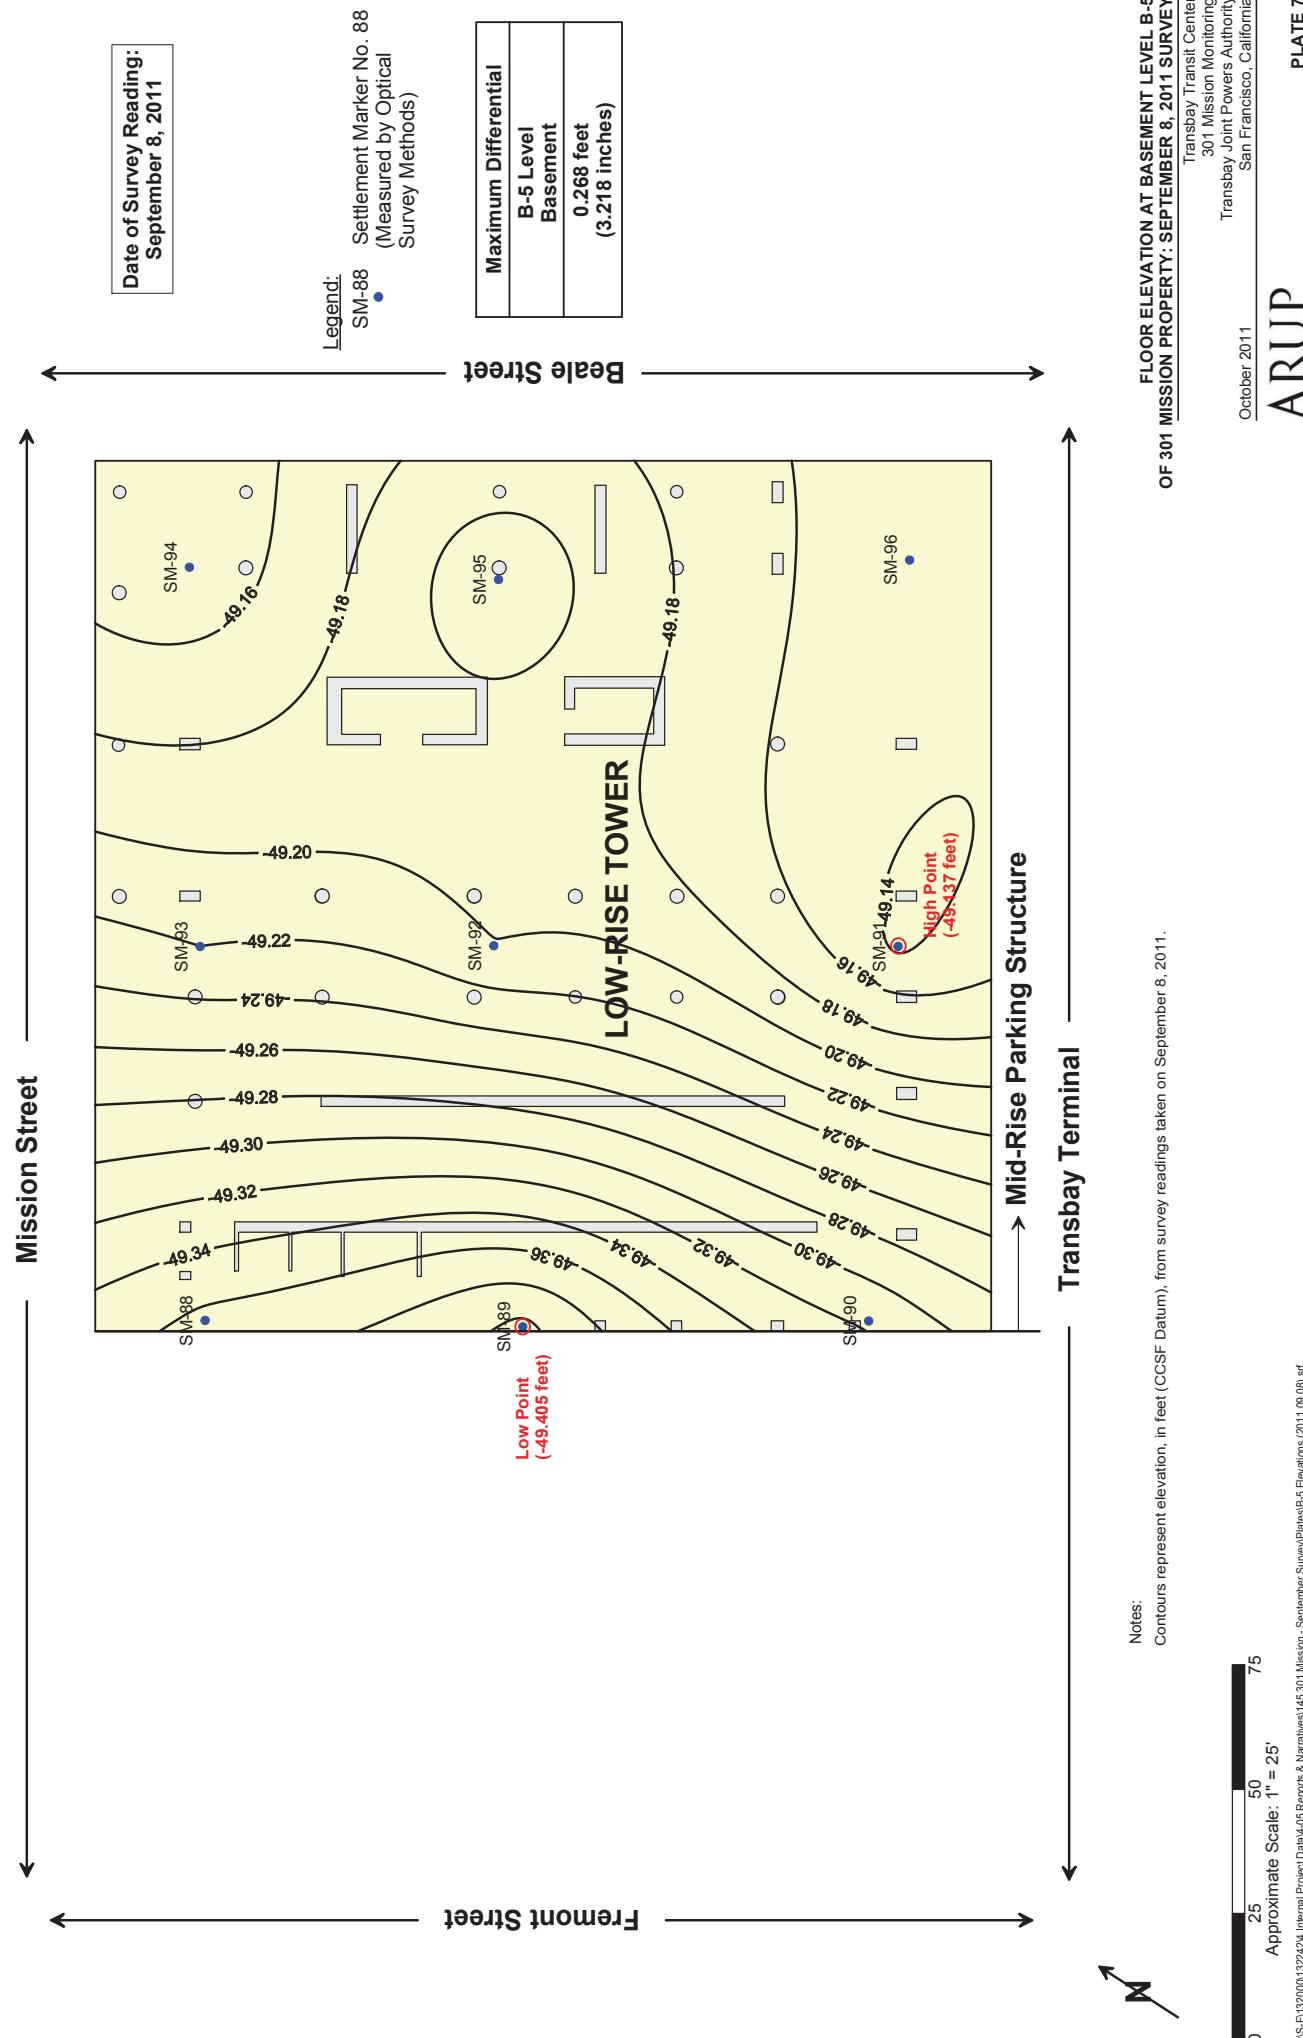

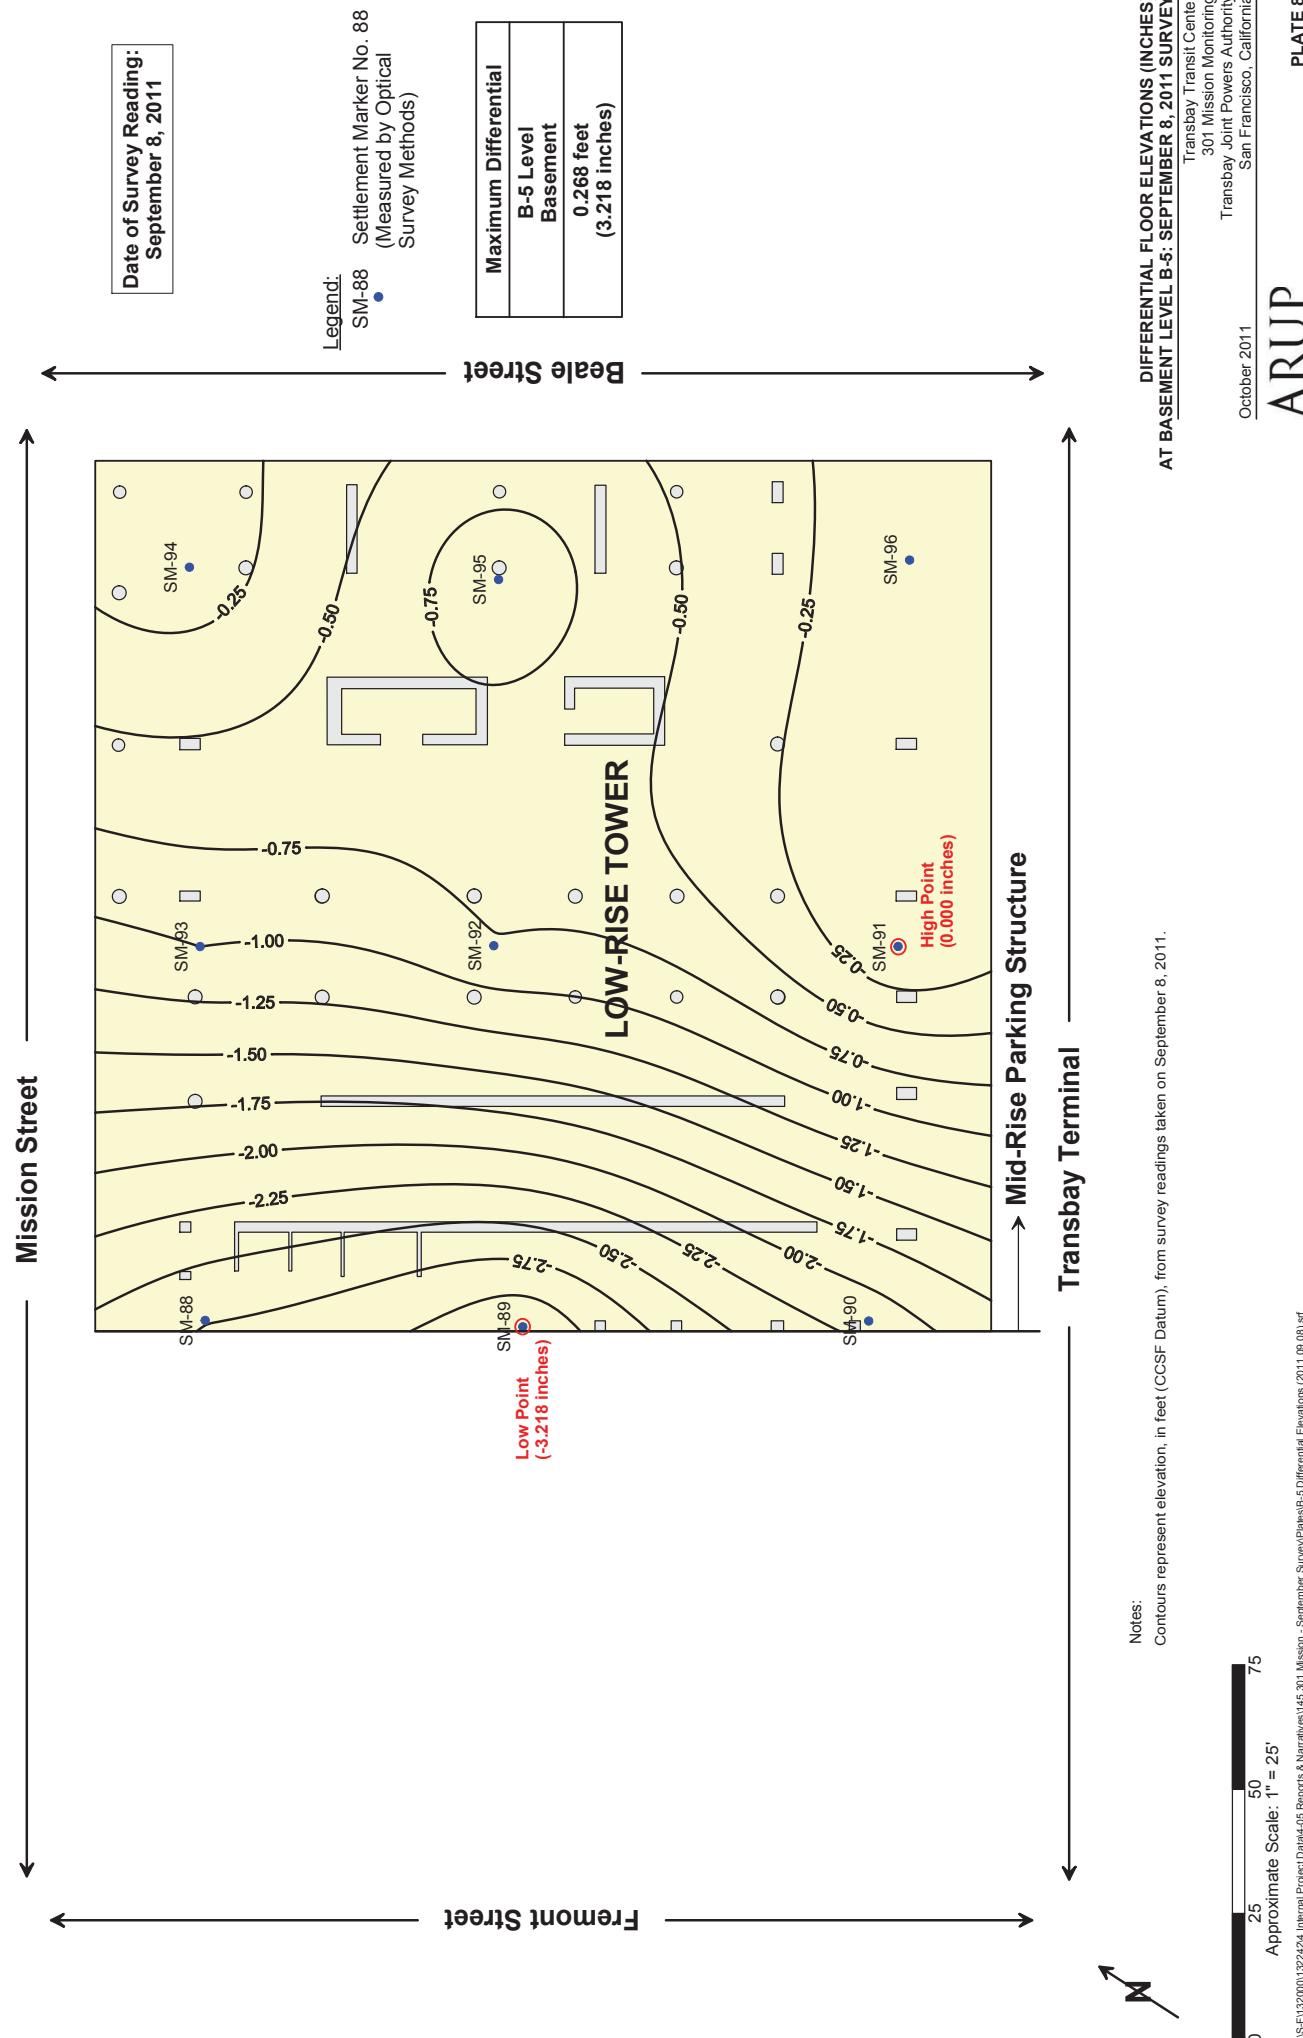

From: Brian Dykes <bdykes@transbaycenter.org>
Sent: Friday, October 28, 2011 8:27 AM
To: Steven Hood; John Luciano
Cc: Robert Beck; Rebecca Armenta
Subject: FW: 301 Mission - October Survey
Attachments: 2011-10-25 Memo_301 Mission Settlement - October 2011 Survey.pdf

Steven and John,
Attached above are the settlement readings taken on October 20, 2011.
This set of readings was taken on the same day that we poured the concrete for the 12th buttress pile.
I agree with the statement below that we have not found any increased settlements.
Brian.

From: Stephen McLandrich [<mailto:stephen.mclandrich@arup.com>]
Sent: Tuesday, October 25, 2011 3:31 PM
To: Brian Dykes; Robert Beck; Emilio Cruz; 'Randy Volenec'; George Metzger
Cc: Nick O'Riordan; Kevin Clinch; DeeDee Maggi
Subject: 301 Mission - October Survey

Brian,

Please find the attached memo which summarizes the results of the October 20th survey of the settlement points in 301 Mission. We accelerated the survey date about 2 to 3 weeks in order to catch any negative consequences from the buttress installation. The results do not suggest an impact from the buttress construction activities.

The next survey is scheduled for the week of December 19th.

Let me know if you have any questions.

Cheers,
Stephen

Stephen McLandrich PE
Senior Engineer | Geotechnics Group

Arup
560 Mission Street Suite 700 San Francisco CA 94105 USA
t +1 415 957 9445 d +1 415 946 0245
f +1 415 957 9096 e +1 415 310 1095
www.arup.com

Check out our progress at <http://transbaycenter.org/construction-updates/construction-cameras>

NOTE: This e-mail communication and any attachments hereto are covered by the Electronic Communications Privacy Act, 18 U.S.C. Sections 2510-2521, and are legally privileged. The information contained herein is confidential, and is intended only for the use of the individual or entity to whom it is addressed. If you are not the intended recipient of this e-mail communication (or an employee or agent responsible for delivering this communication to its intended recipient(s)), you are hereby notified that any retention, copying or further distribution of this e-mail communication and any attachments is strictly prohibited. If you are not the intended recipient, please notify the sender by telephoning 415-597-4620, or by forwarding an e-mail reply message addressed to TransAdmin@TransbayCenter.org confirming that you have already destroyed (deleted) the original e-mail communication and any and all copies thereof. Thank you.

Memorandum

ARUP

To	Brian Dykes (TJPA)	Date
		25 October 2011
Copies	Robert Beck (TJPA) Emilio Cruz (PMPC) Randy Volenec (PCPA) George Metzger (AAI)	Reference number 132242-60/SMM
From	Stephen McLandrich (Arup) Nick O'Riordan (Arup) Kevin Clinch (Arup)	File reference 4-05 146
Subject	Transbay Transit Center: Results of October 2011 Settlement Survey at 301 Mission Property	Page 1 of 1


Under Arup's Geotechnical Contract with the Transbay Joint Powers Authority through Pelli Clark Pelli Architects, Arup is required to monitor the settlements of the buildings adjacent to the Transbay Transit Center prior to and during construction. We began the monitoring program for the 301 Mission property in April of 2009. This memorandum and the attached plates present an update to our memorandum dated October 25, 2011 with measurements made through October 2011.

List of Plates

Note Typo: should refer to "October 10, 2011" report

- Plate 1 Floor Elevations at Level B-1 of 301 Mission Property: Periodic Survey – October 20, 2010
- Plate 2 Differential Floor Elevation (Inches) – October 20, 2010 Survey
- Plate 3 Contours of Settlements Measured at the First Level Basement of the 301 Mission Street Structure Between April 30, 2009 and October 20, 2010
- Plate 4 Settlement Over Time Floor Elevations at Level B-1 of 301 Mission Property – Tower: April 30, 2009 through October 20, 2010.
- Plate 5 Settlement Over Time Floor Elevations at Level B-1 of 301 Mission Property – Mid-Rise: April 30, 2009 through October 20, 2010
- Plate 6 Settlements of the 301 Mission Tower Including Monitoring During Construction
- Plate 7 Floor Elevation at Basement Level B-5 of 301 Mission Property: October 20, 2011 Survey
- Plate 8 Differential Floor Elevations (Inches) at Basement Level B-5: October 20, 2011 Survey

Note Typo: references to "2010" on this page should read "2011"

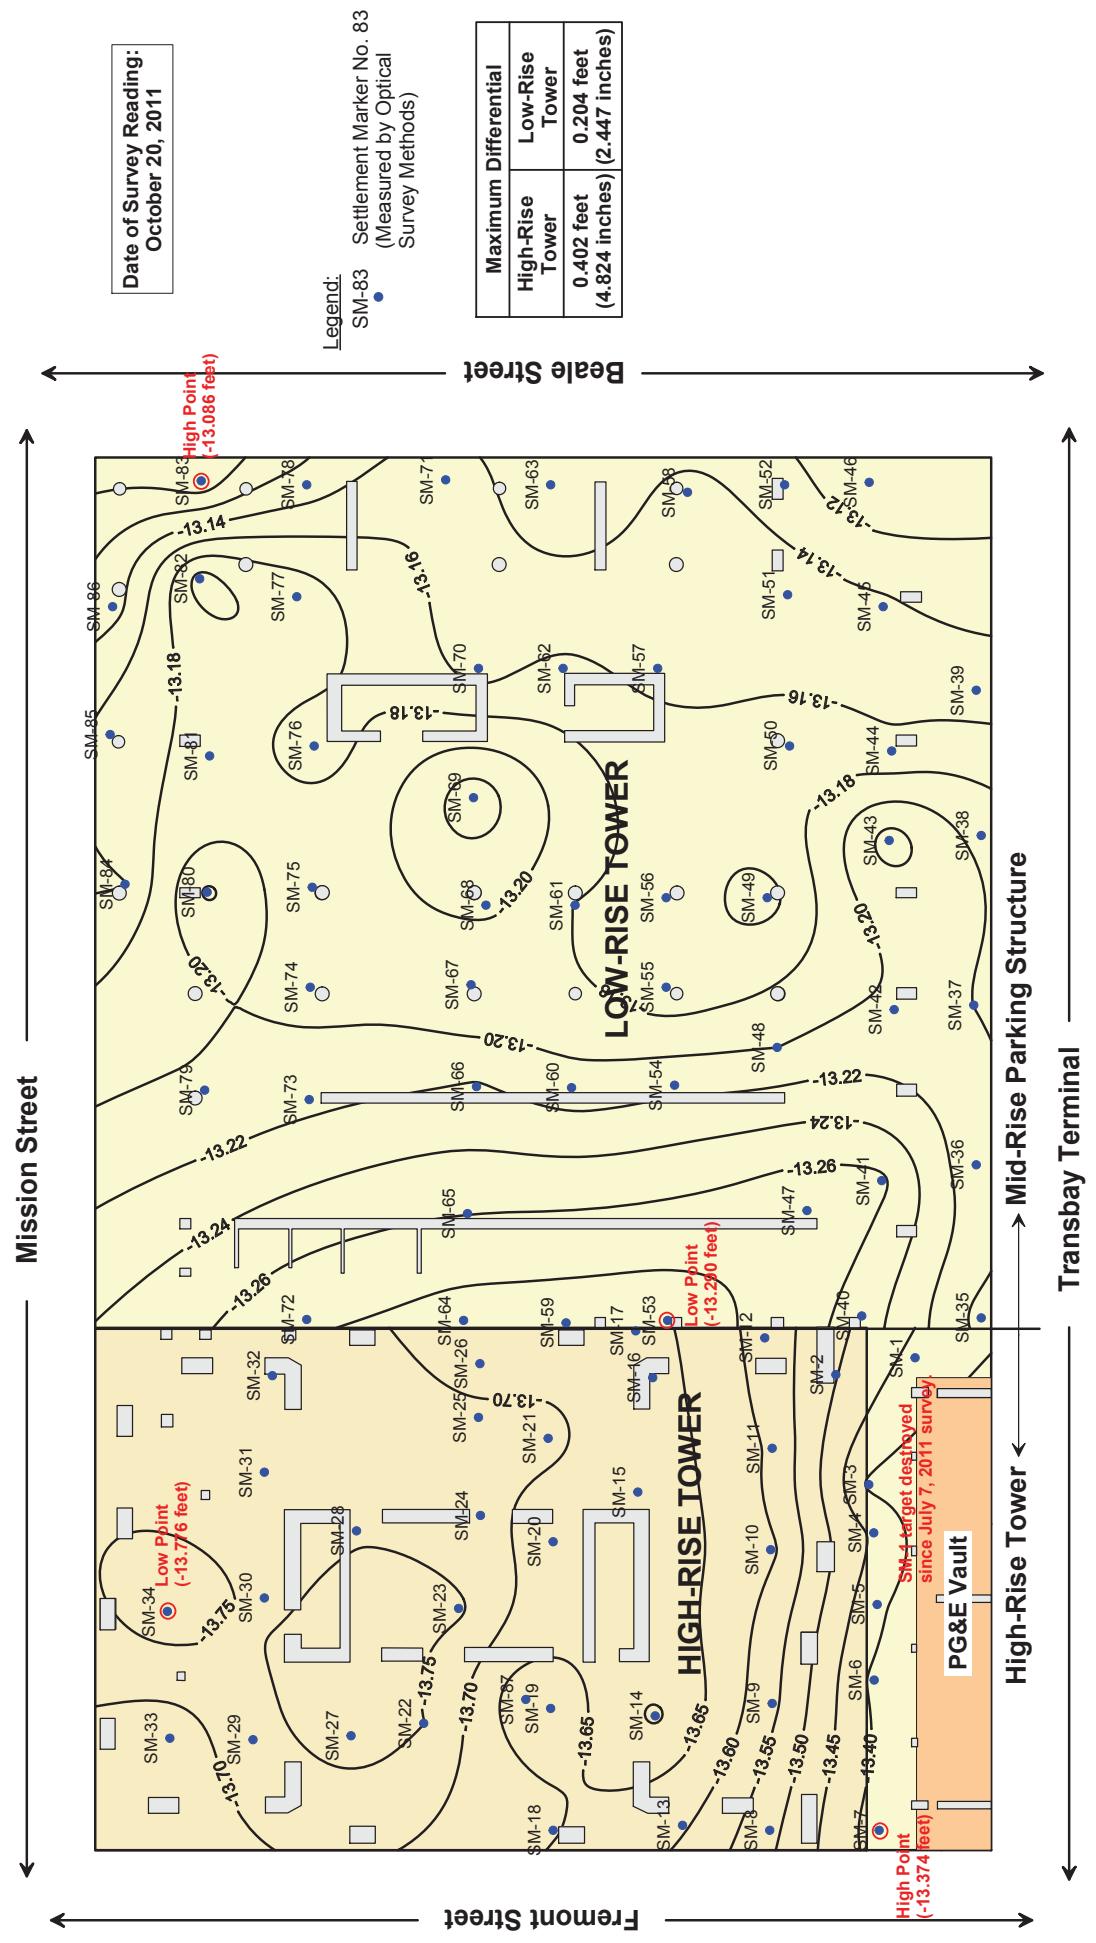



**FLOOR ELEVATIONS AT LEVEL B-1
OF 301 MISSION PROPERTY:
PERIODIC SURVEY - OCTOBER 20, 2011**

Transbay Transit Center
301 Mission Monitoring
Transbay Joint Powers Authority
San Francisco, California

October 2011

ARUP

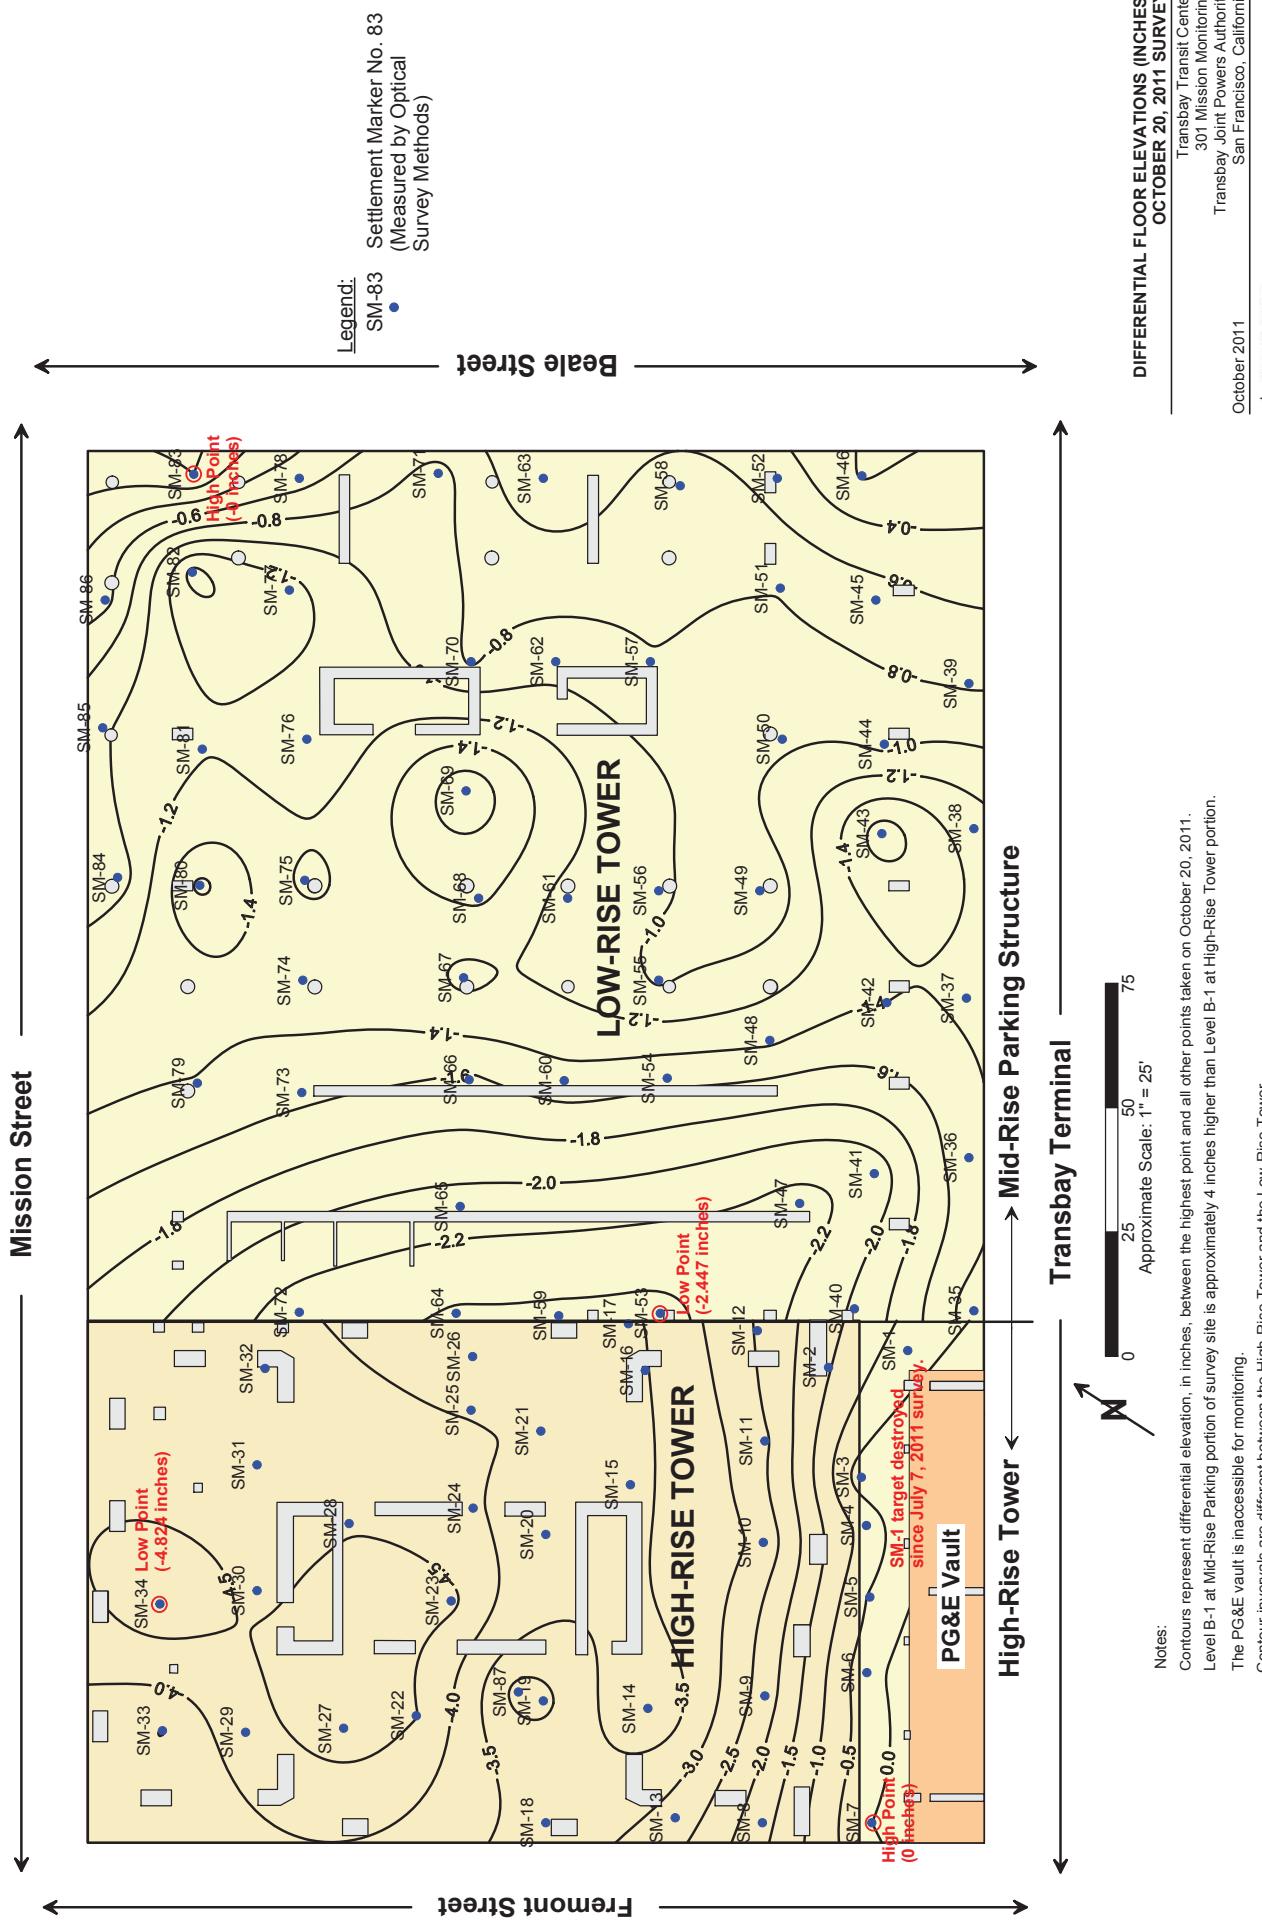

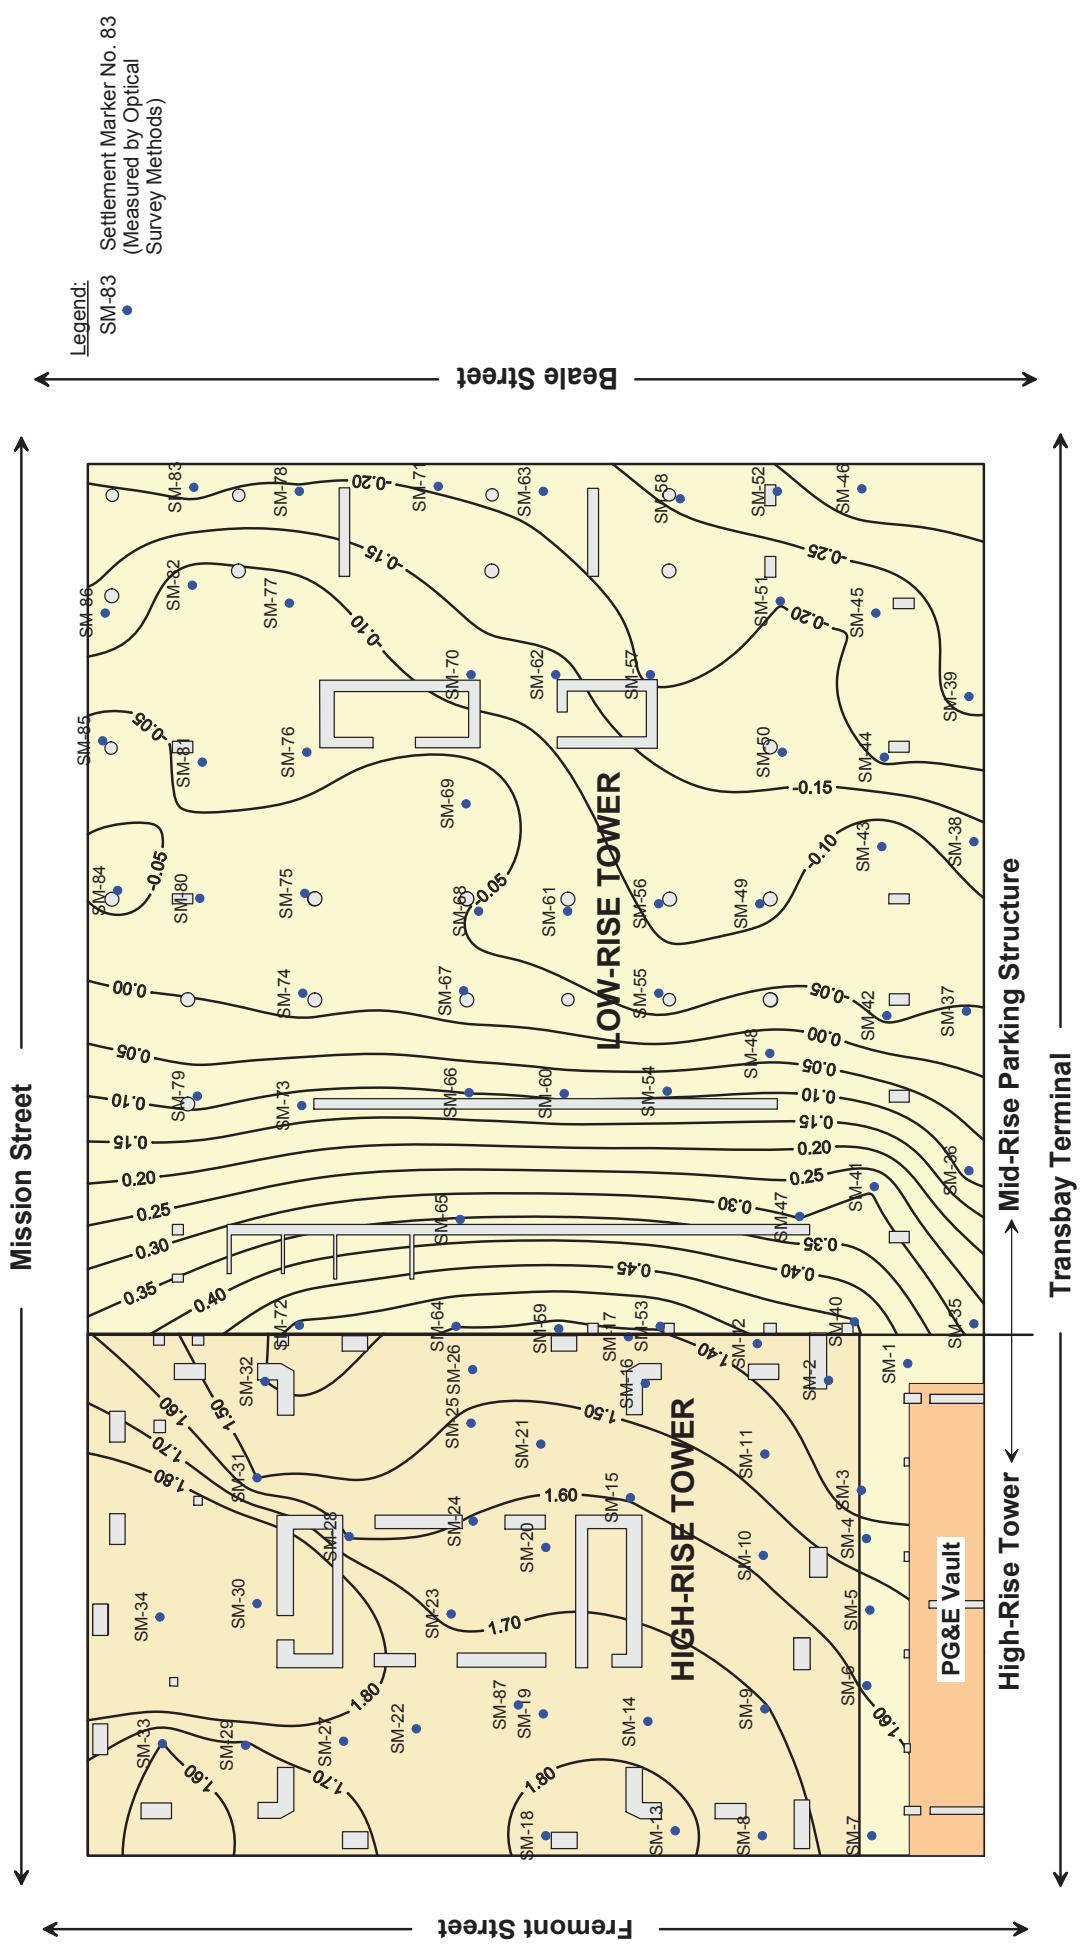

CONTOURS OF SETTLEMENTS MEASURED AT THE FIRST LEVEL BASEMENT OF THE 301 MISSION STREET STRUCTURE BETWEEN APRIL 30, 2009 AND OCTOBER 20, 2011

Transbay Transit Center
301 Mission Monitoring
Transbay Joint Powers Authority
San Francisco, California

October 2011

ARUP


Note:
Initial (Baseline) reading
taken on 04/30/09





October 2011


**SETTLEMENT OVER TIME
FLOOR ELEVATIONS AT LEVEL B-1
OF 301 MISSION PROPERTY - TOWER:
APRIL 30, 2009 THROUGH OCTOBER 20, 2011**

Transbay Transit Center
301 Mission Monitoring
Transbay Joint Powers Authority
San Francisco, California

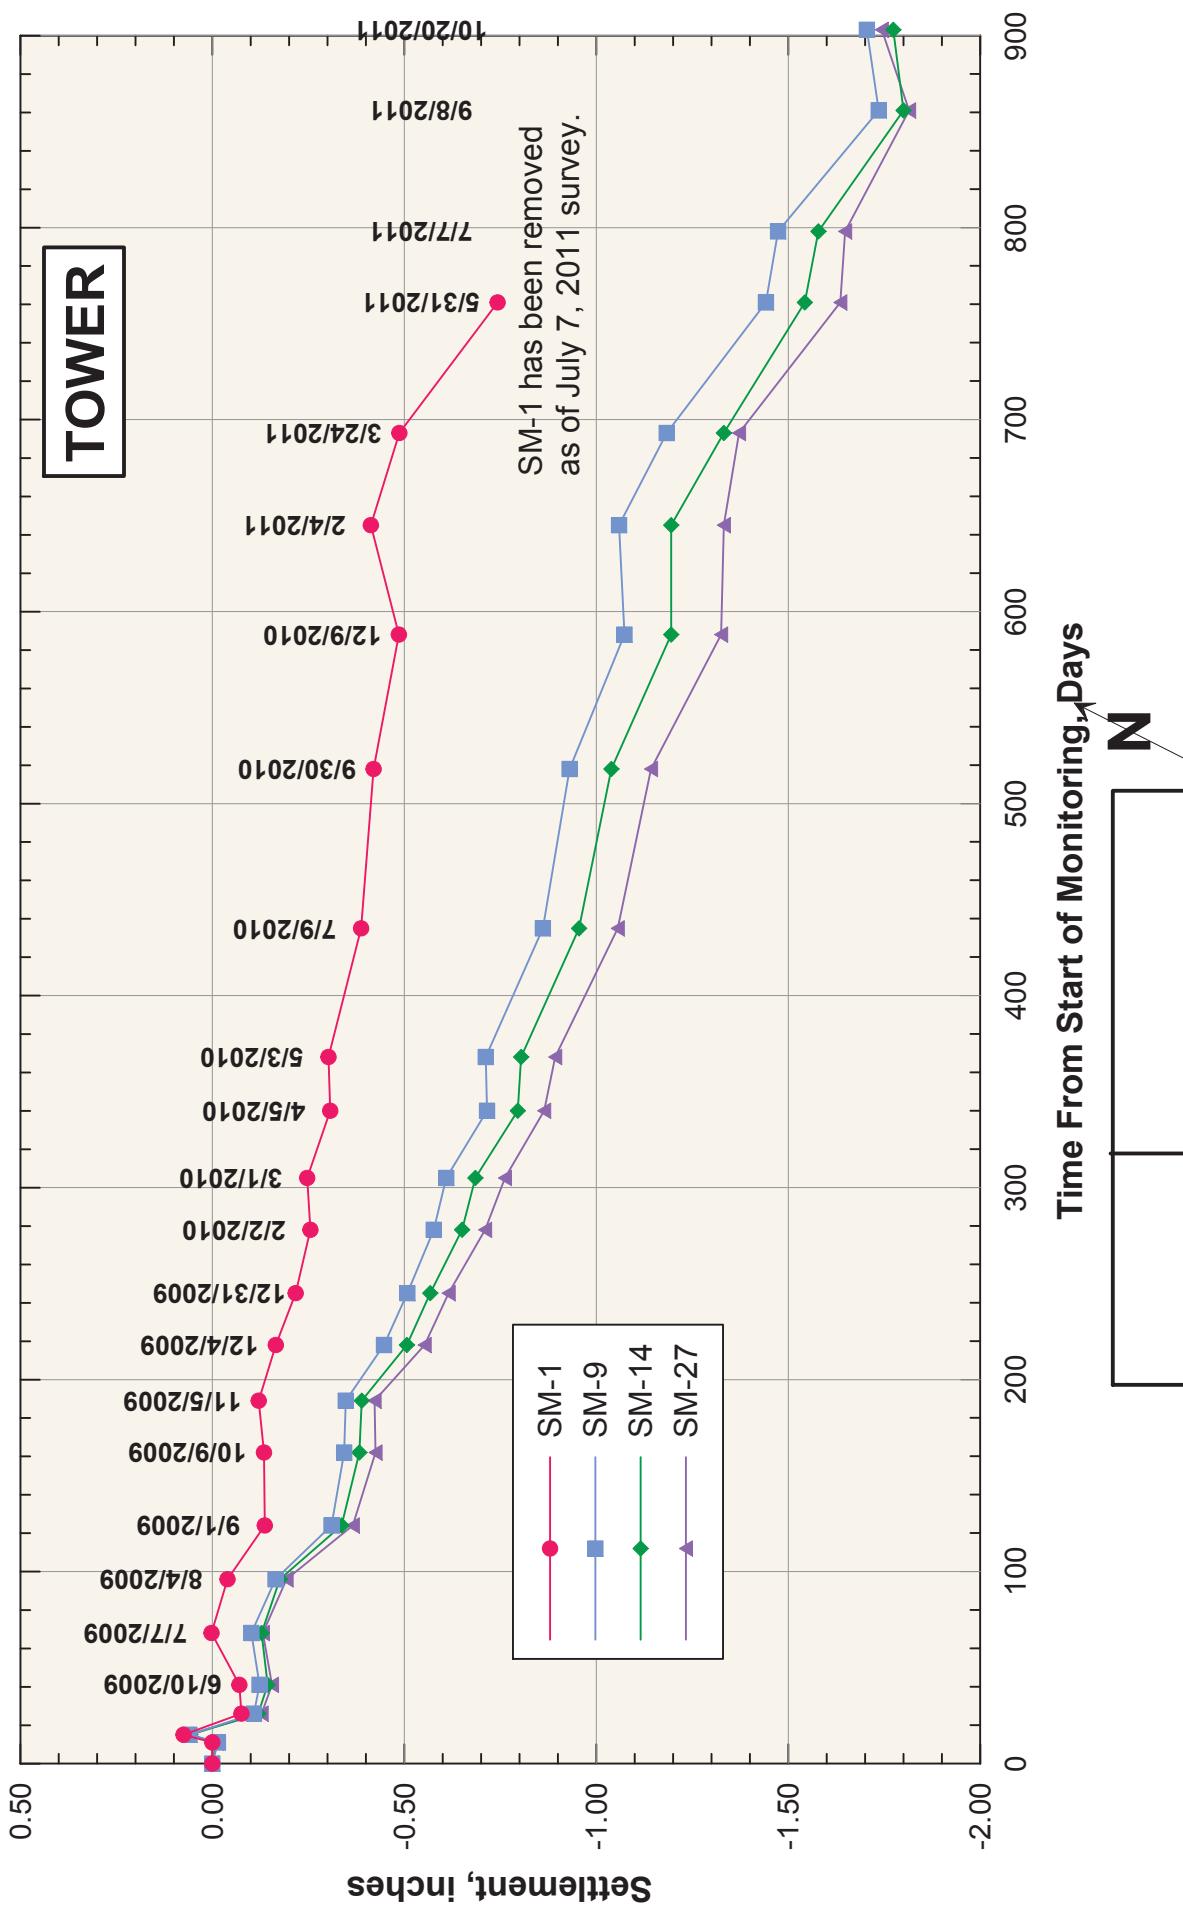

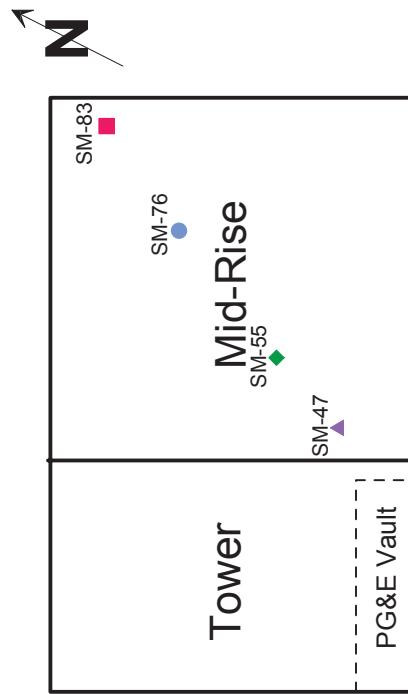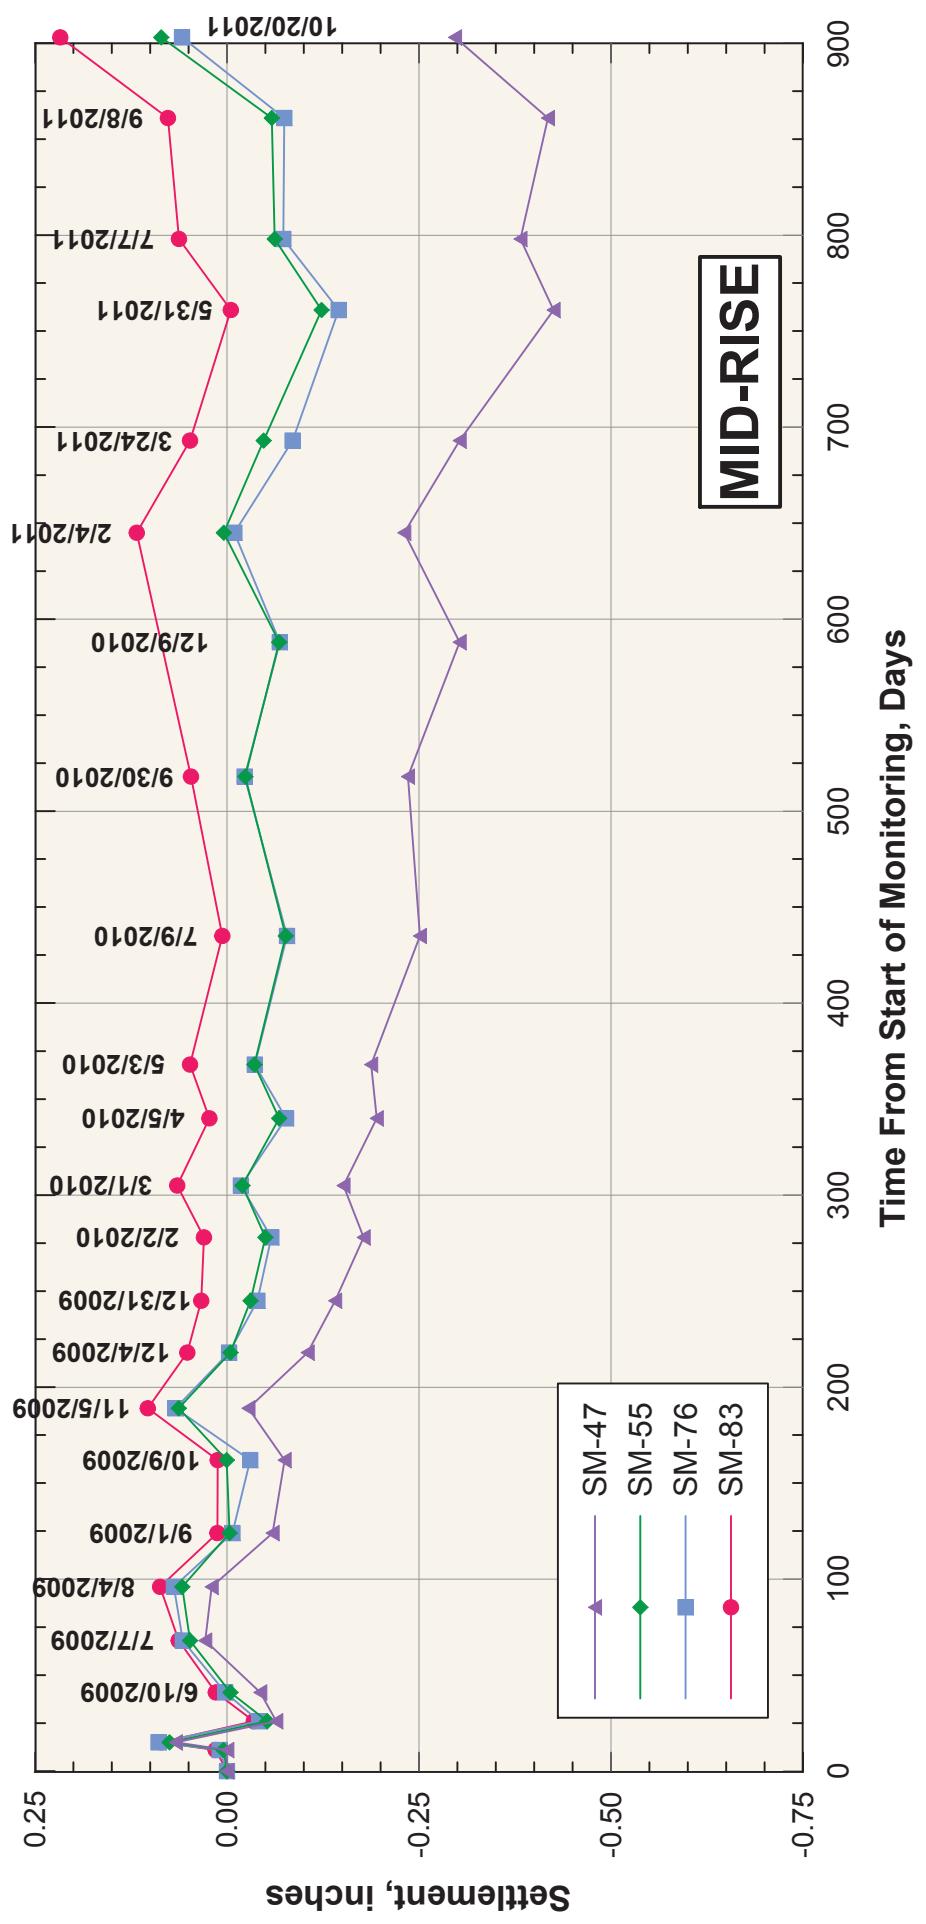

Note:
Initial (Baseline) reading
taken on 04/30/09

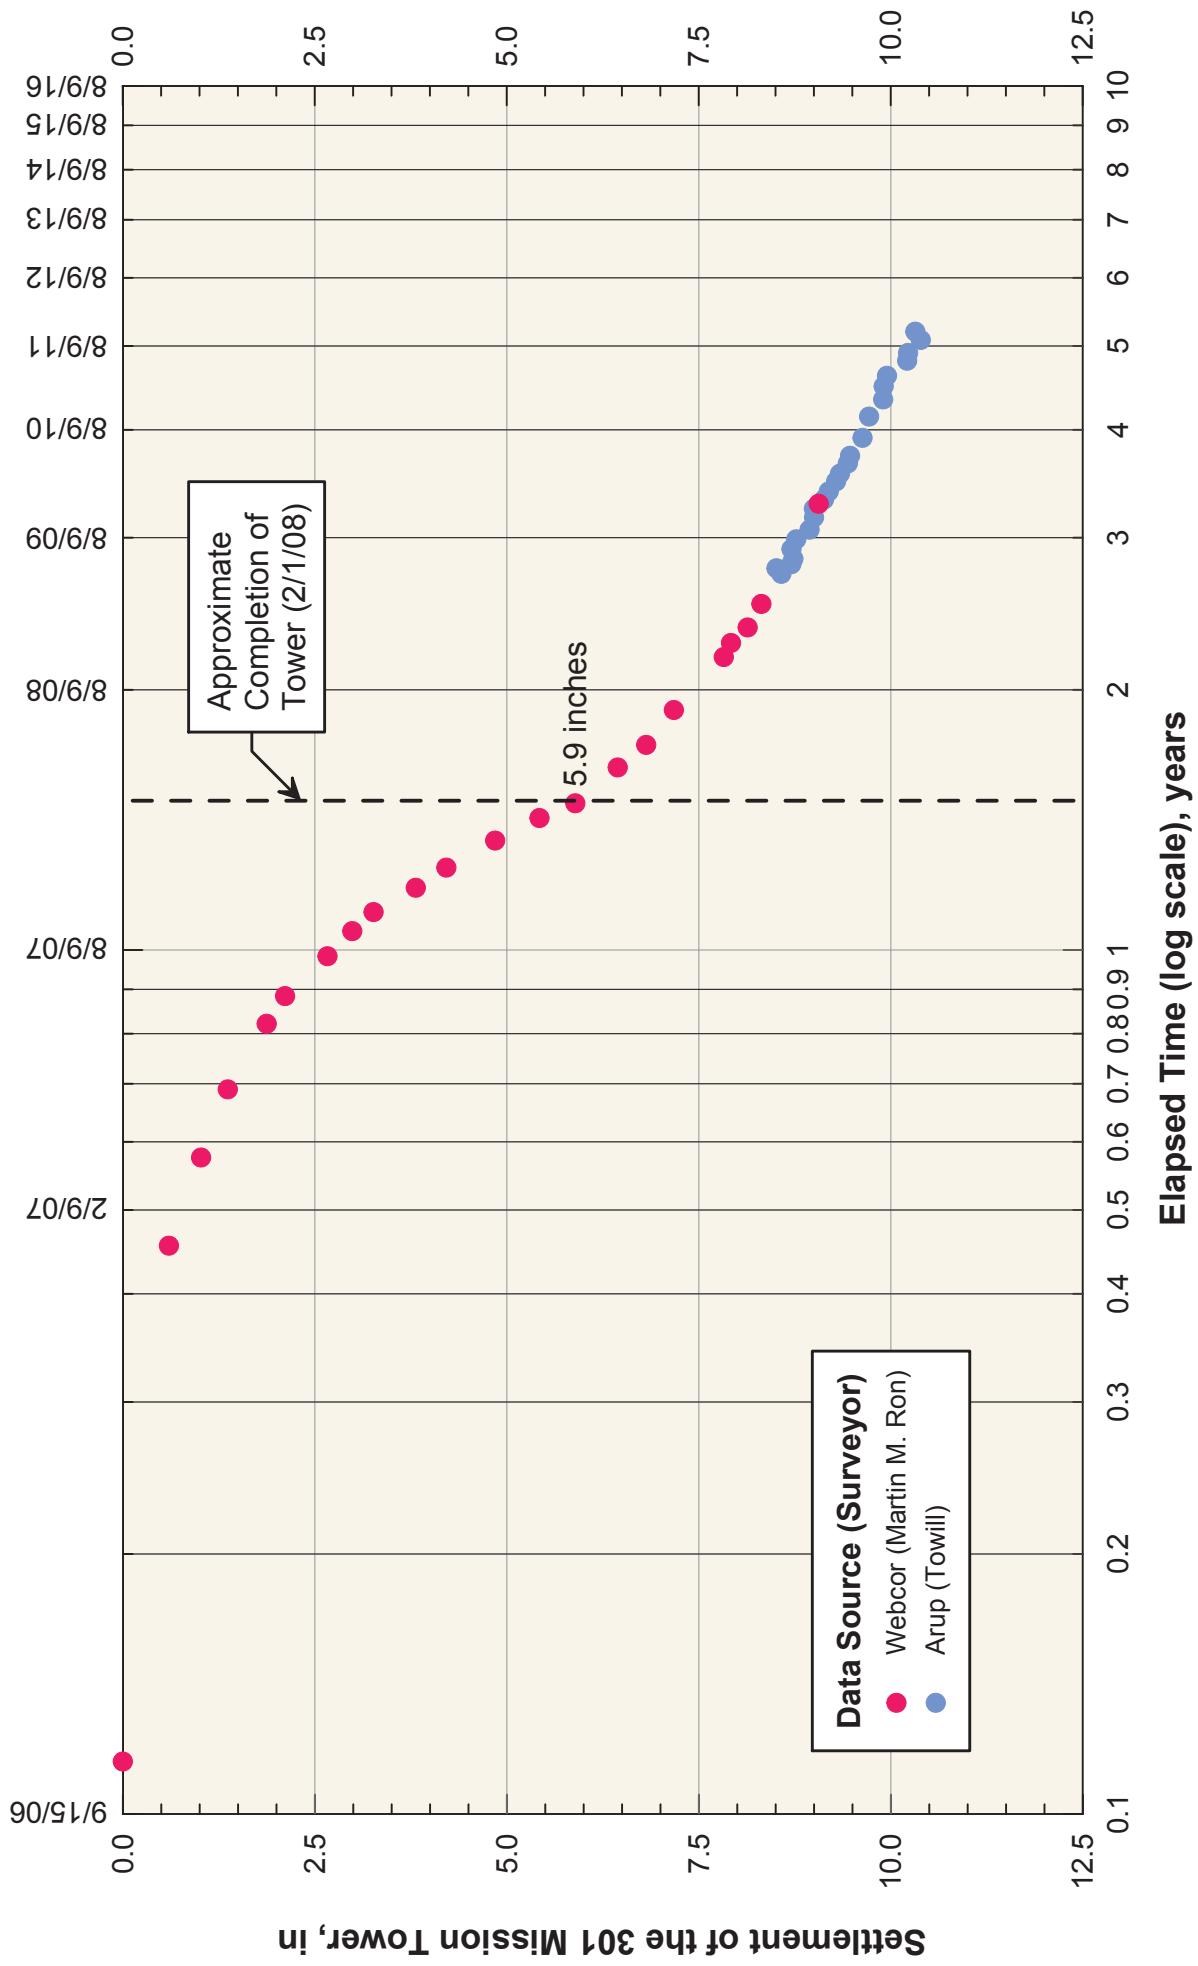



SETTLEMENTS OF THE 301 MISSION TOWER INCLUDING MONITORING DURING CONSTRUCTION

Transbay Transit Center
301 Mission Monitoring
Transbay Joint Powers Authority
San Francisco, California

October 2011

Beginning of Tower Construction: 8/9/06
End of Tower Construction: 2/1/08
Construction Duration: 542 days (1.5 years)

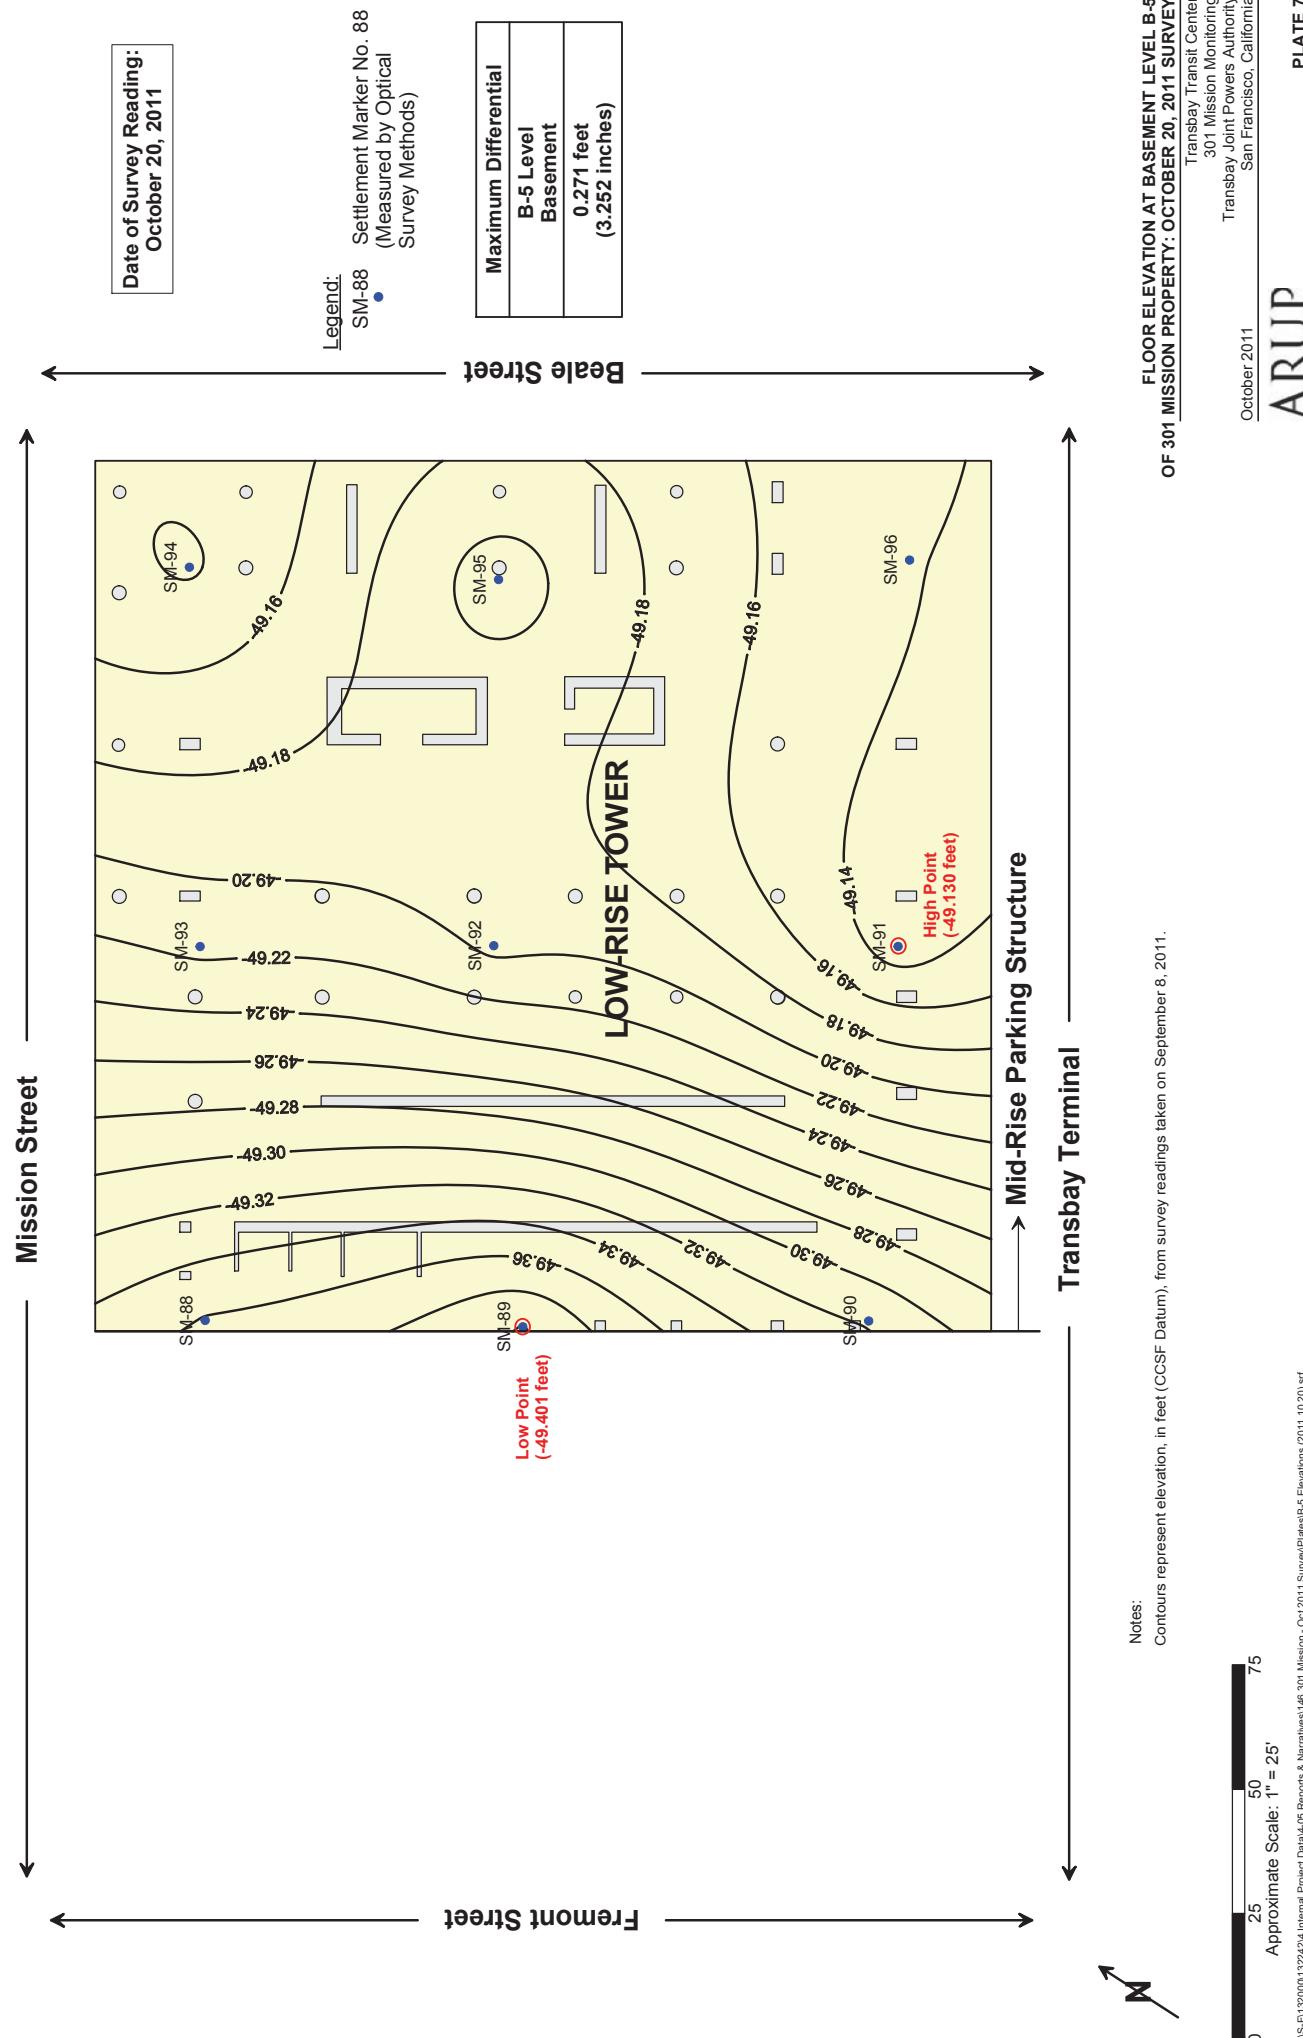

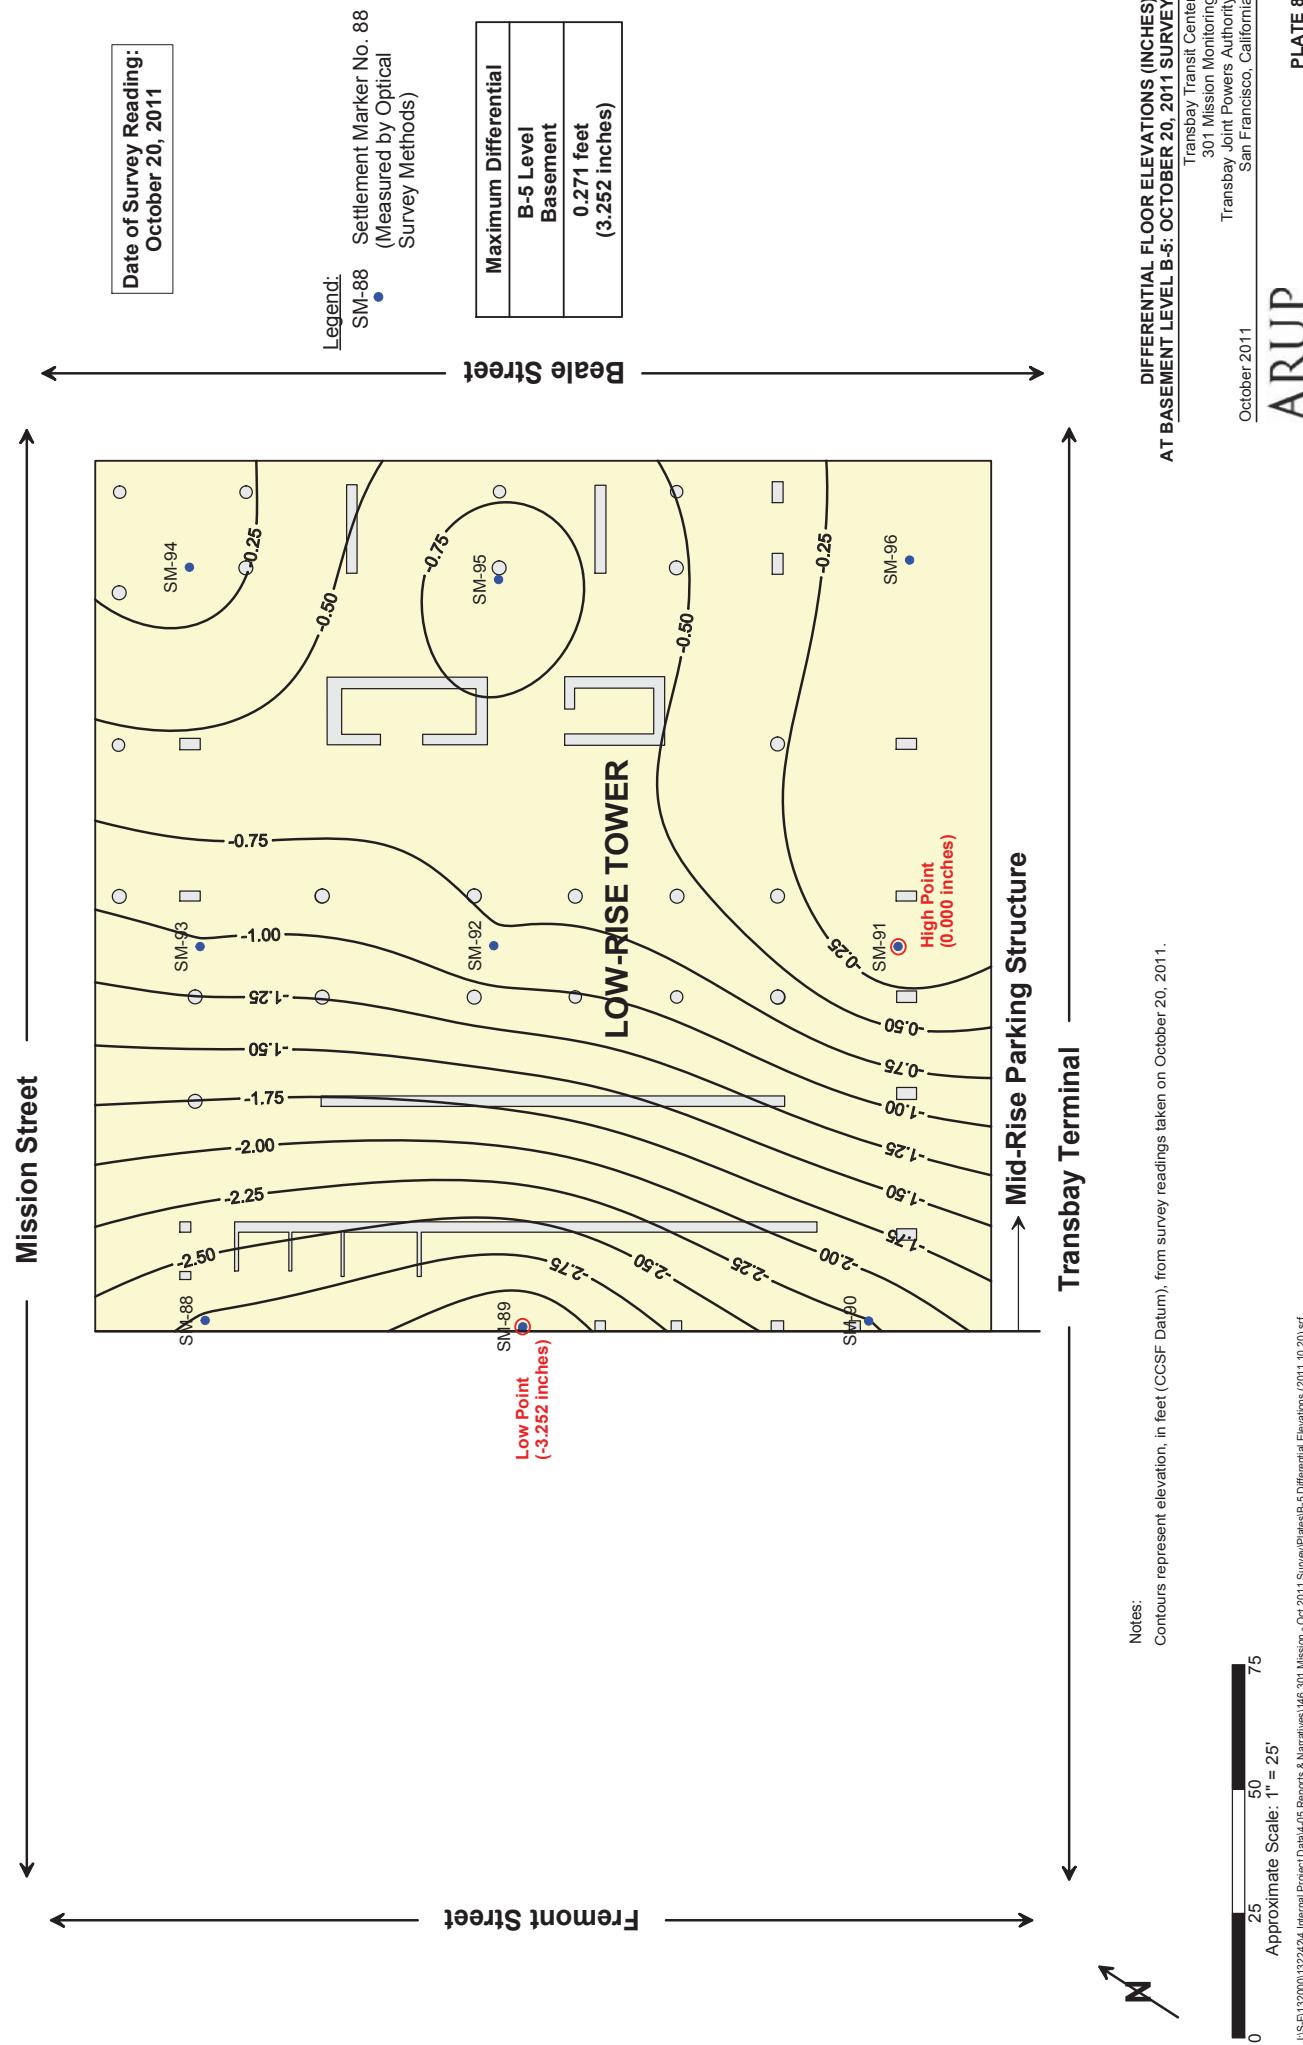

From: Brian Dykes <bdykes@transbaycenter.org>
Sent: Monday, January 23, 2012 3:52 PM
To: Steven Hood; John Luciano
Cc: Robert Beck; Nick O'Riordan; Stephen McLandrich; Rebecca Armenta
Subject: Monitoring Records at 301 Mission Street
Attachments: 2011-12-23 Memo_301 Mission Settlement - December 2011 Survey.pdf; 2012-01-20 Memo_Crack Gauge Survey.pdf

Steve and John,

Attached above are the following two memoranda from Arup:

1. December 23rd memo on settlement marker readings which on plate 6 (page 7 of 9) show the same rate of settlement as recorded over the last 3 years.
2. January 20th memo on crack gauge readings recorded in late December and early January which record the movements over the last 6 to 18 months since the gauges were installed. No significant movements were observed except at those markers highlighted in deep red on plates 1-4 (pages 14-18). Most of these highlighted crack widths increased by 0.5 mm in the zones towards the two southern corners of the tower basement. However, the maximum observed increase is 1.1 mm at Mission Street on the north side of the basement.

Presently, Arup is preparing another series of memoranda which I expect to forward to you in early February. These will cover the following areas of measurements:

1. Tape extensometers between building columns.
2. Tilt meters inside the building.
3. Utility crossings between the tower and the atrium.
4. Utility penetrations from the sidewalks into the building.
5. Inclinometer readings on the south outside the building.
6. Piezometers reading ground water levels around the outside of the building.

Regards, Brian.

Brian Dykes
Principal Engineer
Transbay Joint Powers Authority
201 Mission Street, Suite 2100
San Francisco, CA 94105
415 597 4617 phone
415 597 4615 fax

Check out our progress at <http://transbaycenter.org/construction-updates/construction-cameras>

NOTE: This e-mail communication and any attachments hereto are covered by the Electronic Communications Privacy Act, 18 U.S.C. Sections 2510-2521, and are legally privileged. The information contained herein is confidential, and is intended only for the use of the individual or entity to whom it is addressed. If you are not the intended recipient of this e-mail communication (or an employee or agent responsible for delivering this communication to its intended recipient(s)), you are hereby notified that any retention, copying or further distribution of this e-mail communication and any attachments is strictly prohibited. If you are not the intended recipient, please notify the sender by telephoning 415-597-4620, or by forwarding an e-mail reply message addressed to TransAdmin@TransbayCenter.org confirming that you have already destroyed (deleted) the original e-mail communication and any and all copies thereof. Thank you.

Memorandum

ARUP

To	Brian Dykes (TJPA)	Date
		23 December 2011
Copies	Robert Beck (TJPA) Emilio Cruz (PMPC) Randy Volenec (PCPA) George Metzger (AAI)	Reference number 132242-60/SMM
From	Stephen McLandrich (Arup) Nick O'Riordan (Arup) Kevin Clinch (Arup)	File reference 4-05 150
Subject	Transbay Transit Center: Results of December 2011 Settlement Survey at 301 Mission Property	Page 1 of 1


Under Arup's Geotechnical Contract with the Transbay Joint Powers Authority through Pelli Clark Pelli Architects, Arup is required to monitor the settlements of the buildings adjacent to the Transbay Transit Center prior to and during construction. We began the monitoring program for the 301 Mission property in April of 2009. This memorandum and the attached plates present an update to our memorandum dated October 25, 2011 with measurements made through December 2011.

Settlement Markers SM-01 and SM-02 were destroyed during patching of the floor in their locations. These two points will be replaced by four additional settlement markers, SM-97 through SM-100. Currently, only SM-97 and SM-98 have been installed due to additional floor patching work. Their locations can be seen in the floor plan in Plate 1.

List of Plates

- Plate 1 Floor Elevations at Level B-1 of 301 Mission Property: Periodic Survey – December 14, 2010
- Plate 2 Differential Floor Elevation (Inches) – December 14, 2010 Survey
- Plate 3 Contours of Settlements Measured at the First Level Basement of the 301 Mission Street Structure Between April 30, 2009 and December 14, 2010
- Plate 4 Settlement Over Time Floor Elevations at Level B-1 of 301 Mission Property – Tower: April 30, 2009 through December 14, 2010.
- Plate 5 Settlement Over Time Floor Elevations at Level B-1 of 301 Mission Property – Mid-Rise: April 30, 2009 through December 14, 2010
- Plate 6 Settlements of the 301 Mission Tower Including Monitoring During Construction
- Plate 7 Floor Elevation at Basement Level B-5 of 301 Mission Property: December 14, 2011 Survey
- Plate 8 Differential Floor Elevations (Inches) at Basement Level B-5: December 14, 2011 Survey

Note Typo: references to "2010"
on this page should read "2011"

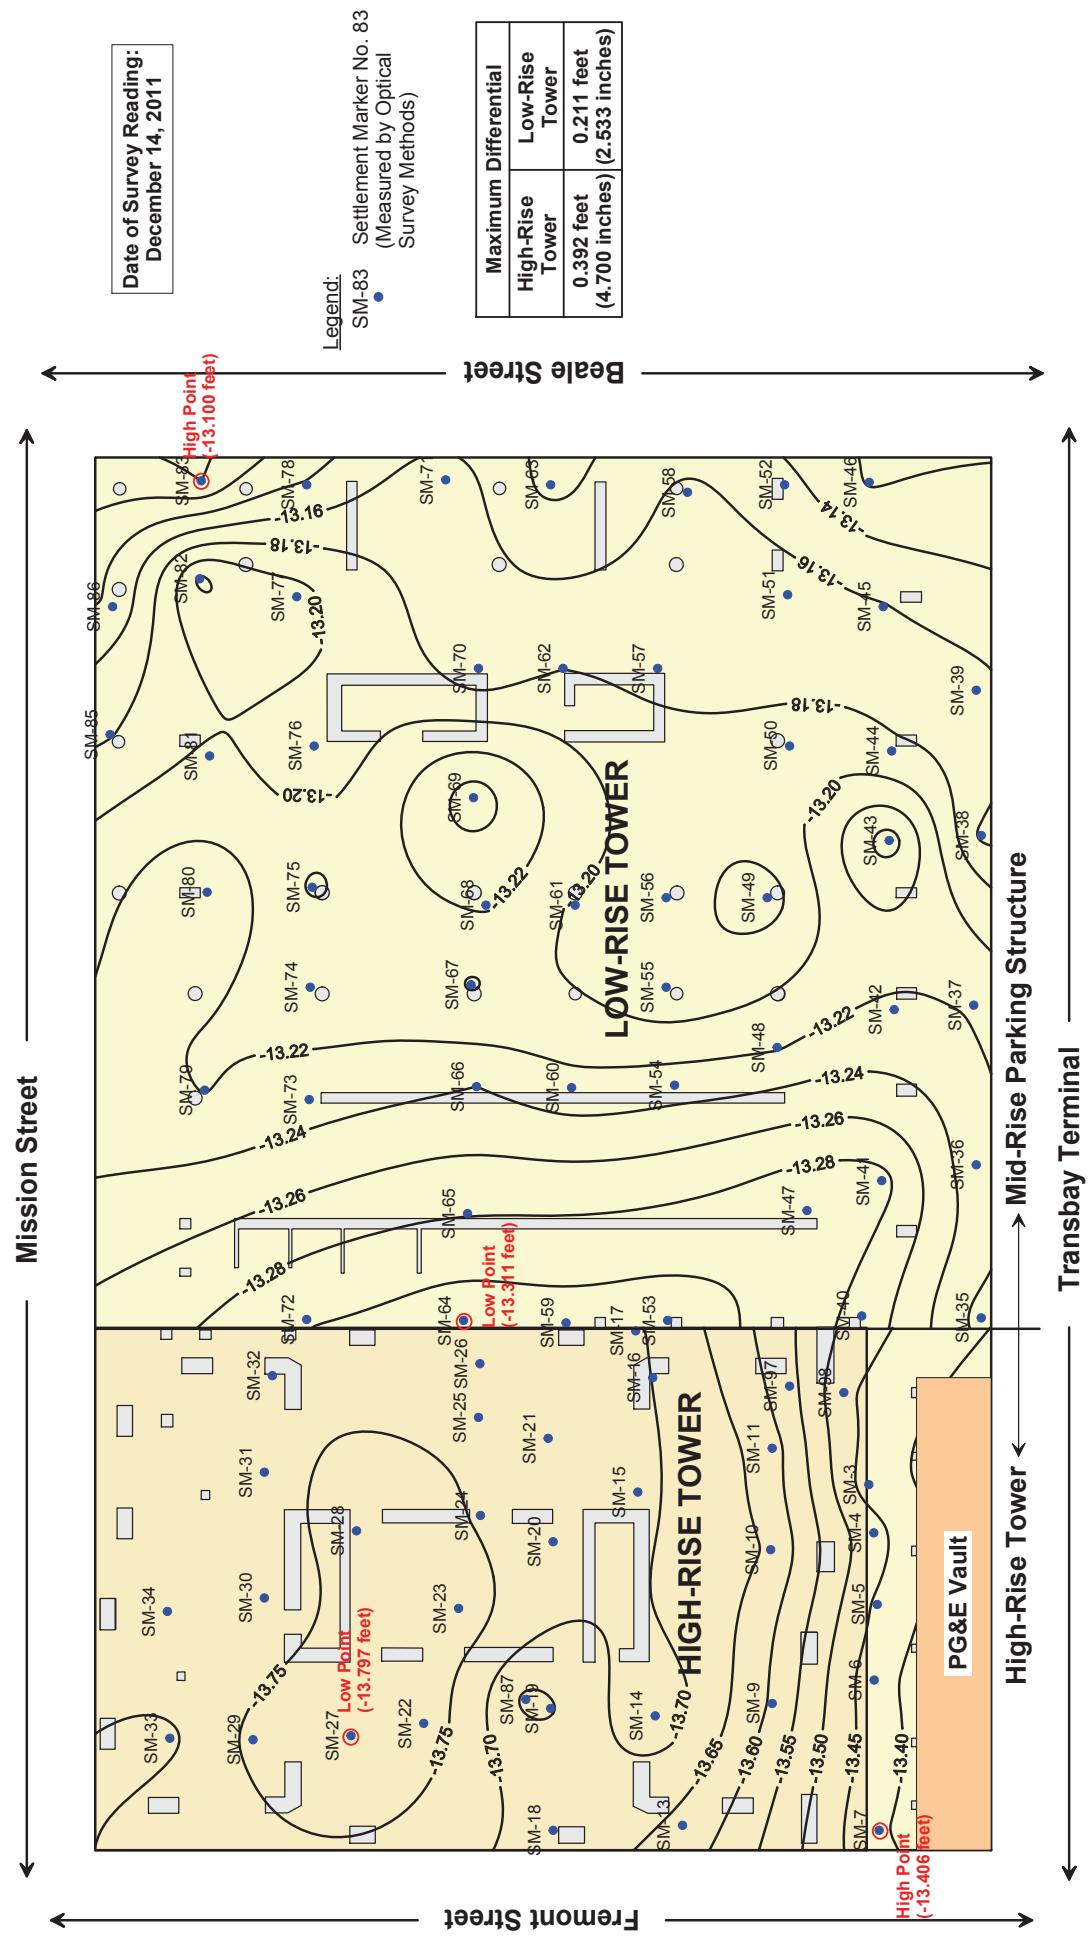

**FLOOR ELEVATIONS AT LEVEL B-1
OF 301 MISSION PROPERTY:
PERIODIC SURVEY - DECEMBER 14, 2011**

Transbay Transit Center
 301 Mission Monitoring
 Transbay Joint Powers Authority
 San Francisco, California


December 2011

J:\\SF\\132000\\132424\\Internal Project Data\\405 Reports & Narratives\\150_301 Mission - Dec 2011 Survey\\Plates\\Elevations All (2011.12.14).srf

Approximate Scale: 1" = 25'

PLATE 1



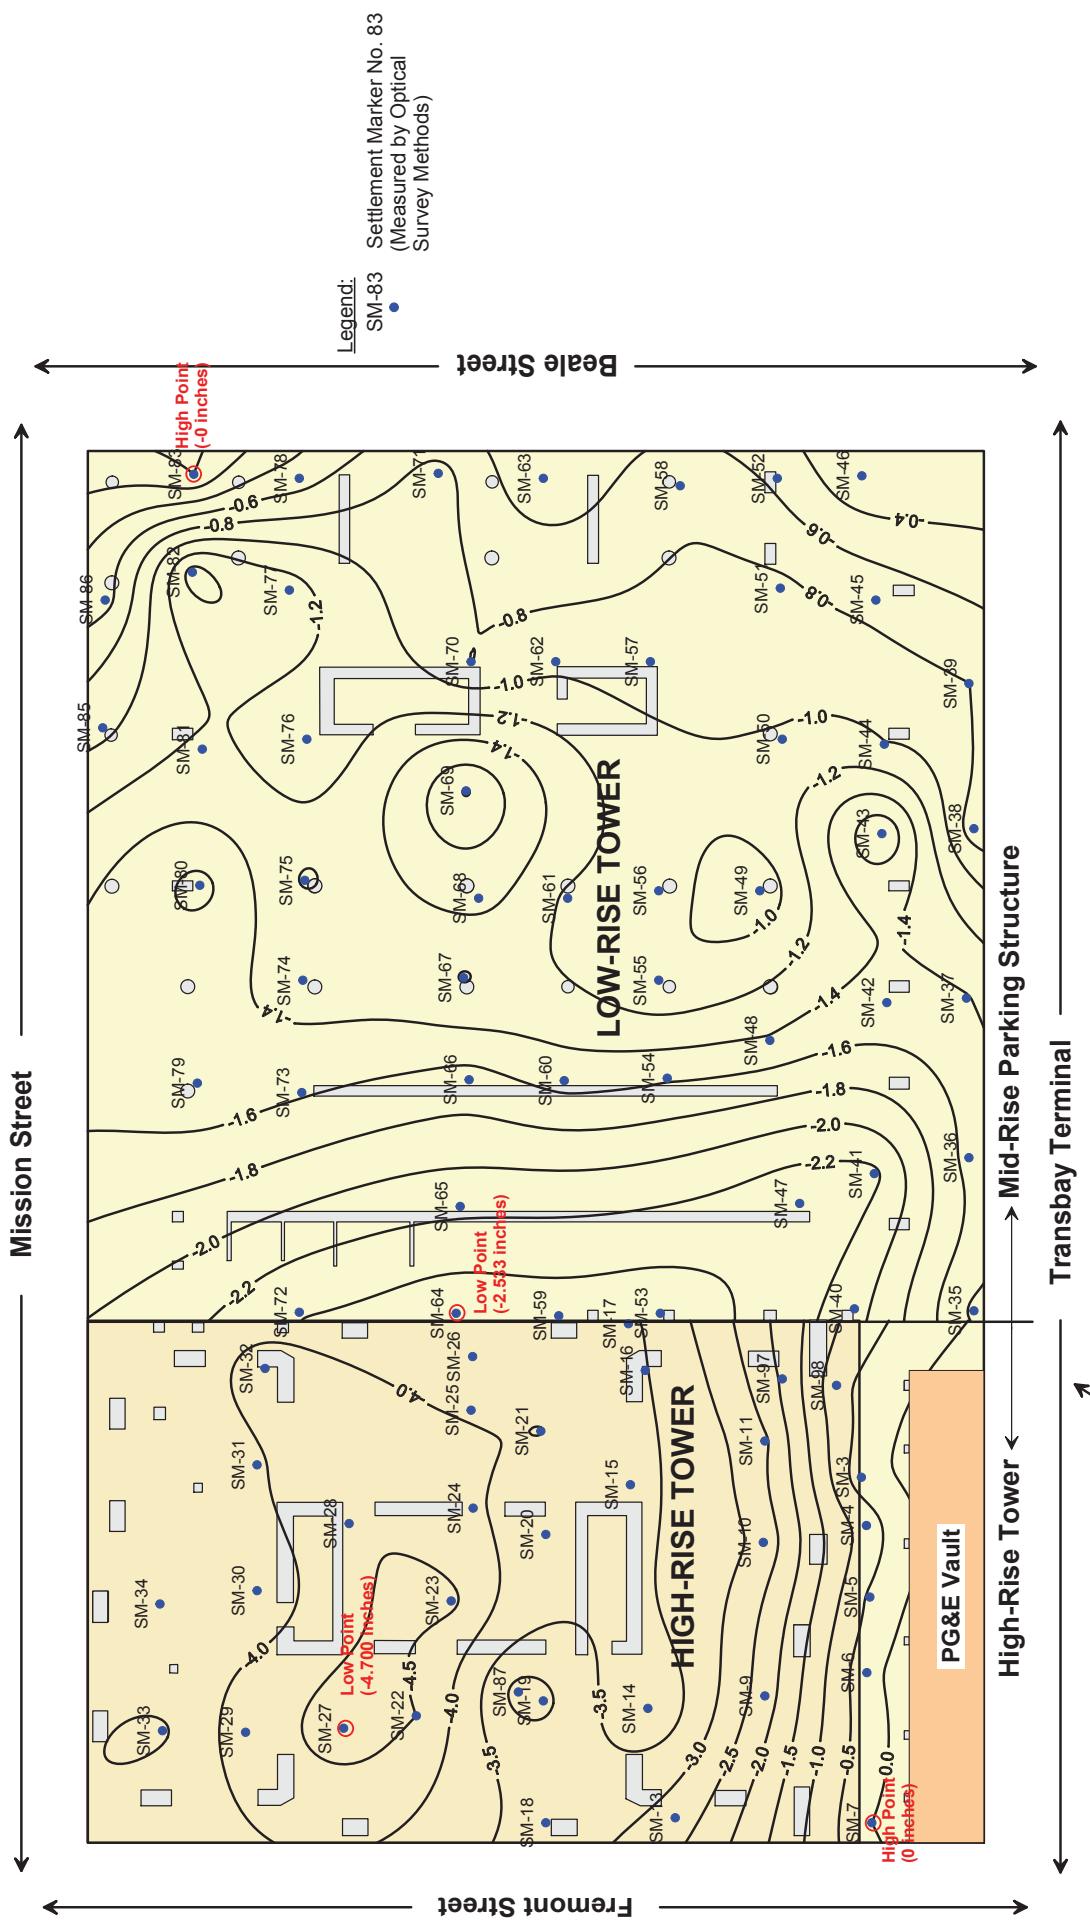

**DIFFERENTIAL FLOOR ELEVATIONS (INCHES)
DECEMBER 14, 2011 SURVEY**

Transbay Transit Center
301 Mission Monitoring
Transbay Joint Powers Authority
San Francisco, California


December 2011

J:\\SF\\132000\\1322424\\Internal Project Data\\4-05 Reports & Narratives\\150 301 Mission - Dec 2011 Survey\\Plates\\Differential Elevation\\12112141.stf



Notes:

Contours represent differential elevation, in inches, between the highest point and all other points taken on December 14, 2011.
Level B-1 at Mid-Rise Parking portion of survey site is approximately 4 inches higher than Level B-1 at High-Rise Tower portion.
The PG&E Vault is inaccessible for monitoring.
Contour intervals are different between the High-Rise Tower and the Low-Rise Tower.

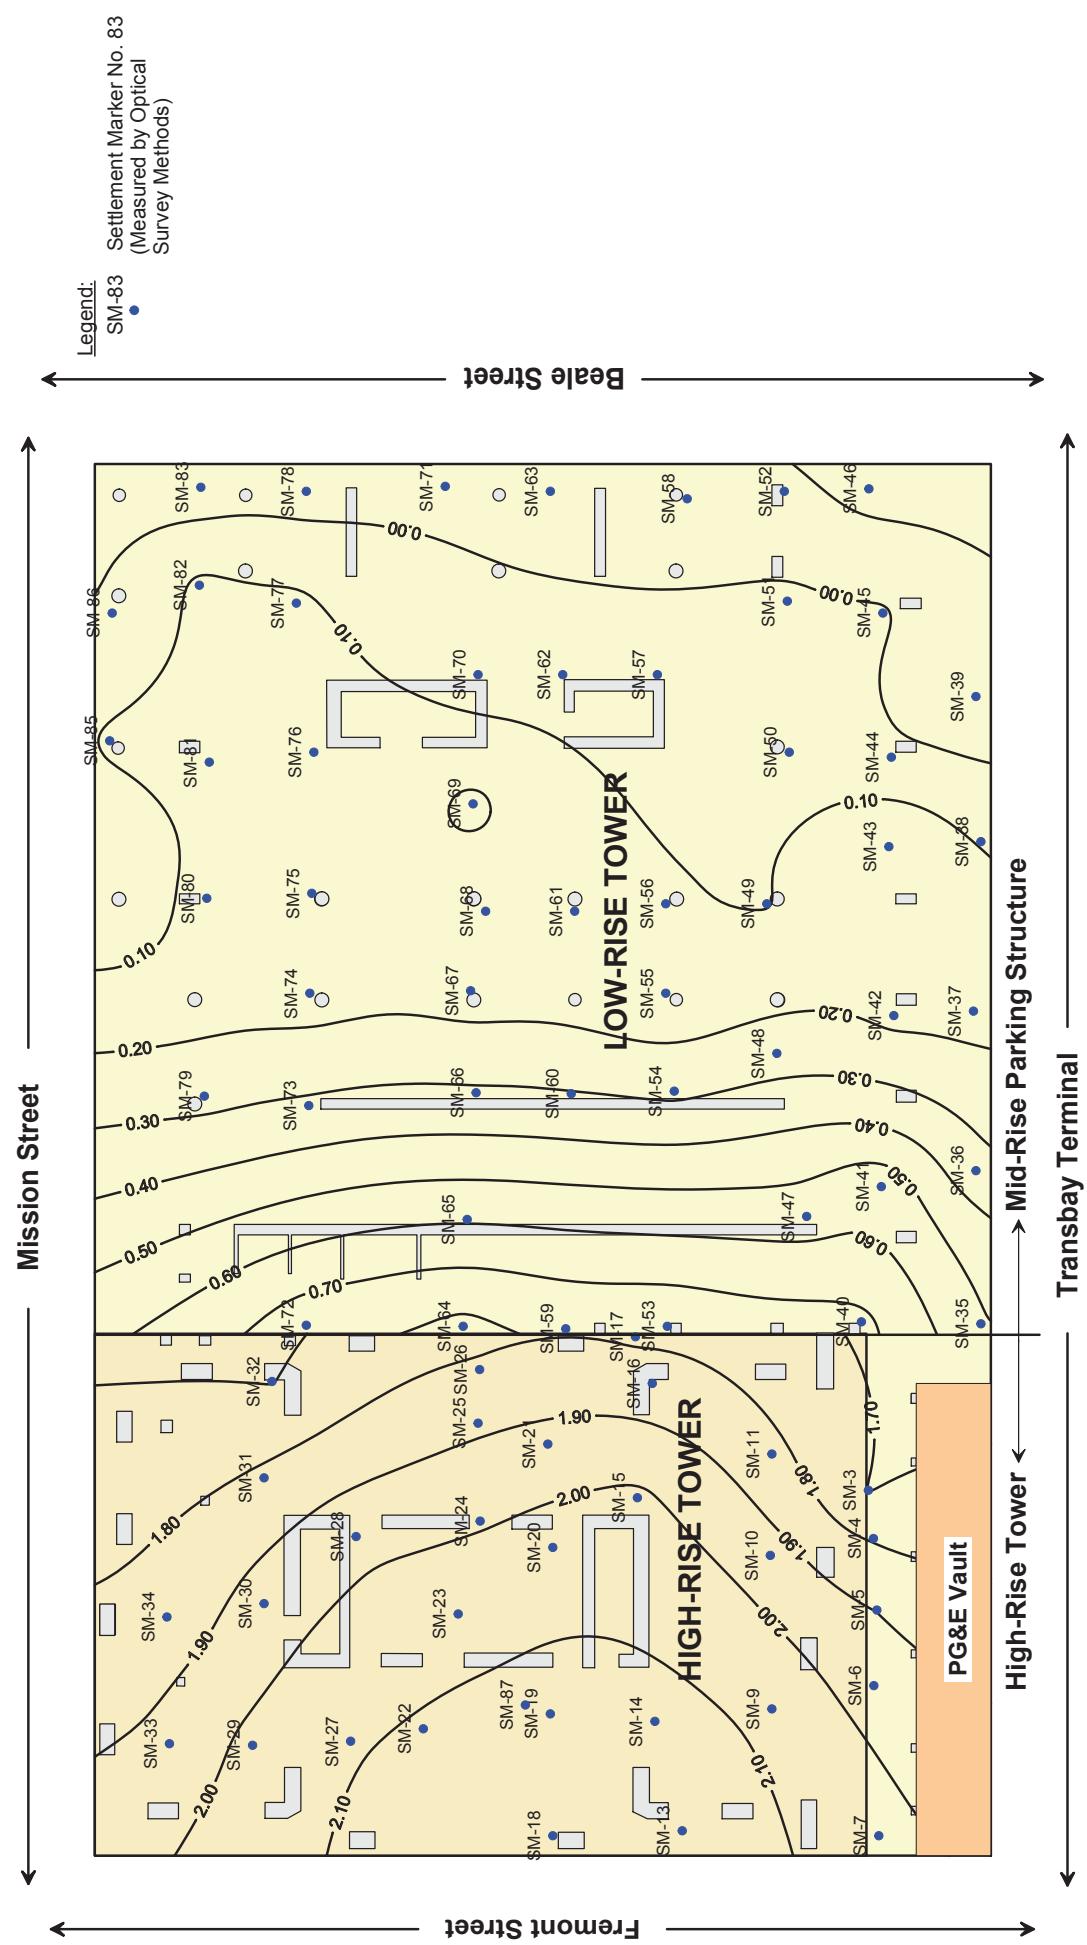

CONTOURS OF SETTLEMENTS MEASURED AT THE FIRST LEVEL BASEMENT OF THE 301 MISSION STREET STRUCTURE BETWEEN APRIL 30, 2009 AND DECEMBER 14, 2011.

The PG&E vault is inaccessible for monitoring.
Negative values of settlement (within Low-rise Tower) indicate uplift.

Notes:
Contours represent elevation change, in inches, between Baseline survey (April 30, 2009) and readings taken on December 14, 2011.
Level B-1 at Mid-Rise Parking portion of survey site is approximately 4 inches higher than Level B-1 at High-Rise Tower portion.

The PG&E vault is inaccessible for monitoring.

Negative values of settlement (within Low-rise Tower) indicate uplift.

December 2011

Transbay Joint Powers Authority

San Francisco, California

PLATE 3

ARUP

JIS-F13200013224 Internal Project Data445 Reports & Narratives\150301 Mission - Dec 2011 Survey\Plots\Elevation changes All (20111214).scr

ARUP


Note:
Initial (Baseline) reading
taken on 04/30/09



**SETTLEMENT OVER TIME
FLOOR ELEVATIONS AT LEVEL B-1
OF 301 MISSION PROPERTY - TOWER:
APRIL 30, 2009 THROUGH DECEMBER 14, 2011**

Transbay Transit Center
301 Mission Monitoring
Transbay Joint Powers Authority
San Francisco, California



December 2011

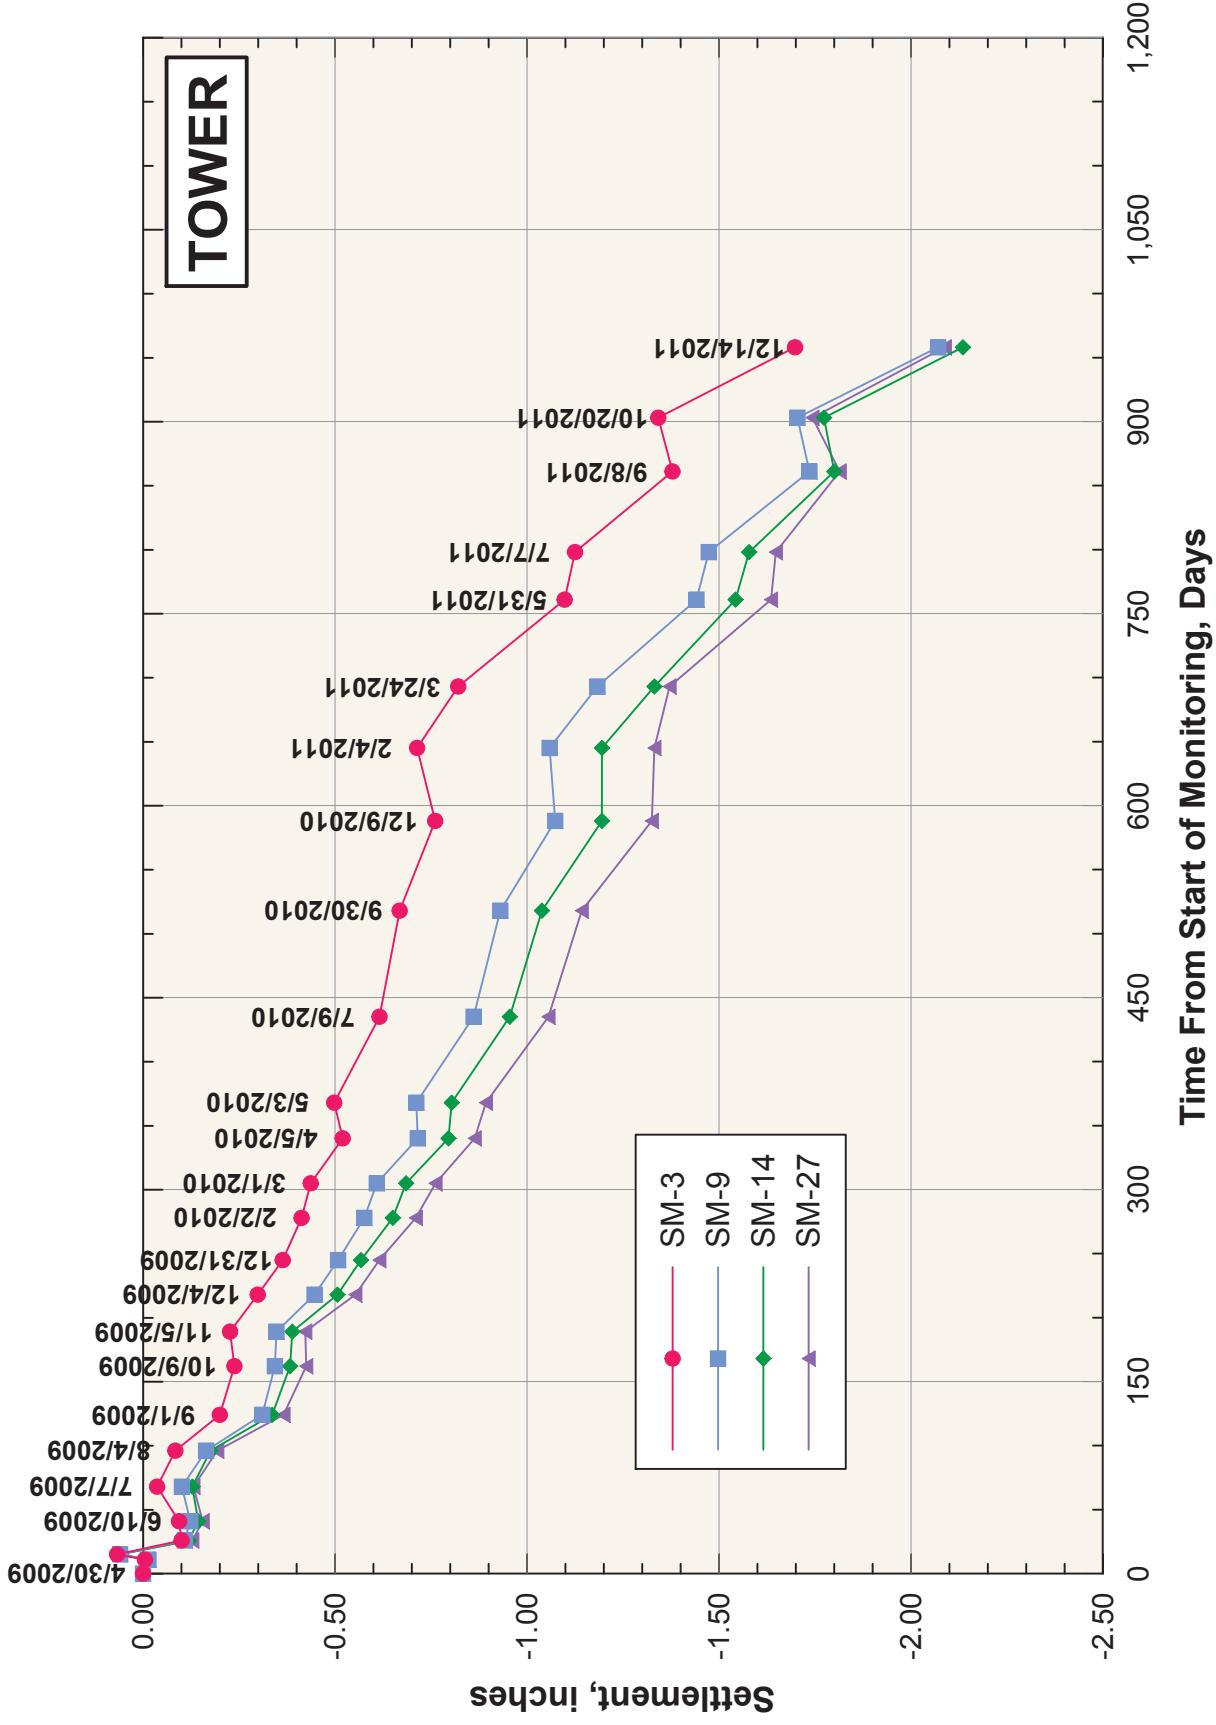


ARUP

Note:
Initial (Baseline) reading
taken on 04/30/09

J:\\SF\\1322424 Internal Project Data\\4.05 Reports & Narratives\\150 301 Mission - Dec 2011 Survey\\Plate 5 Settlement Over Time - Midrise.grf

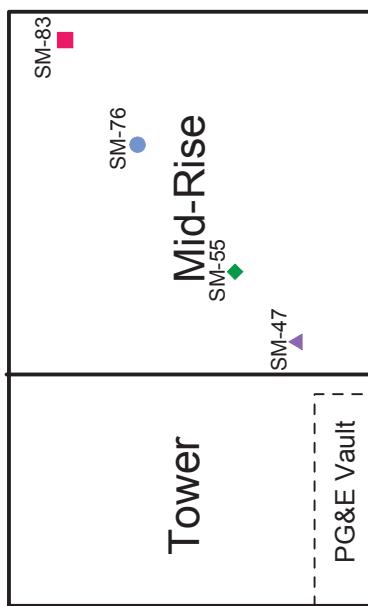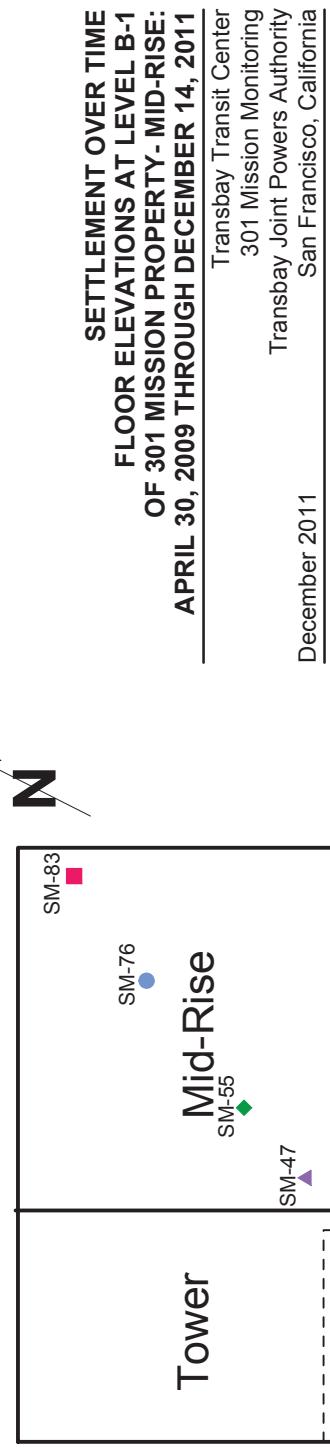

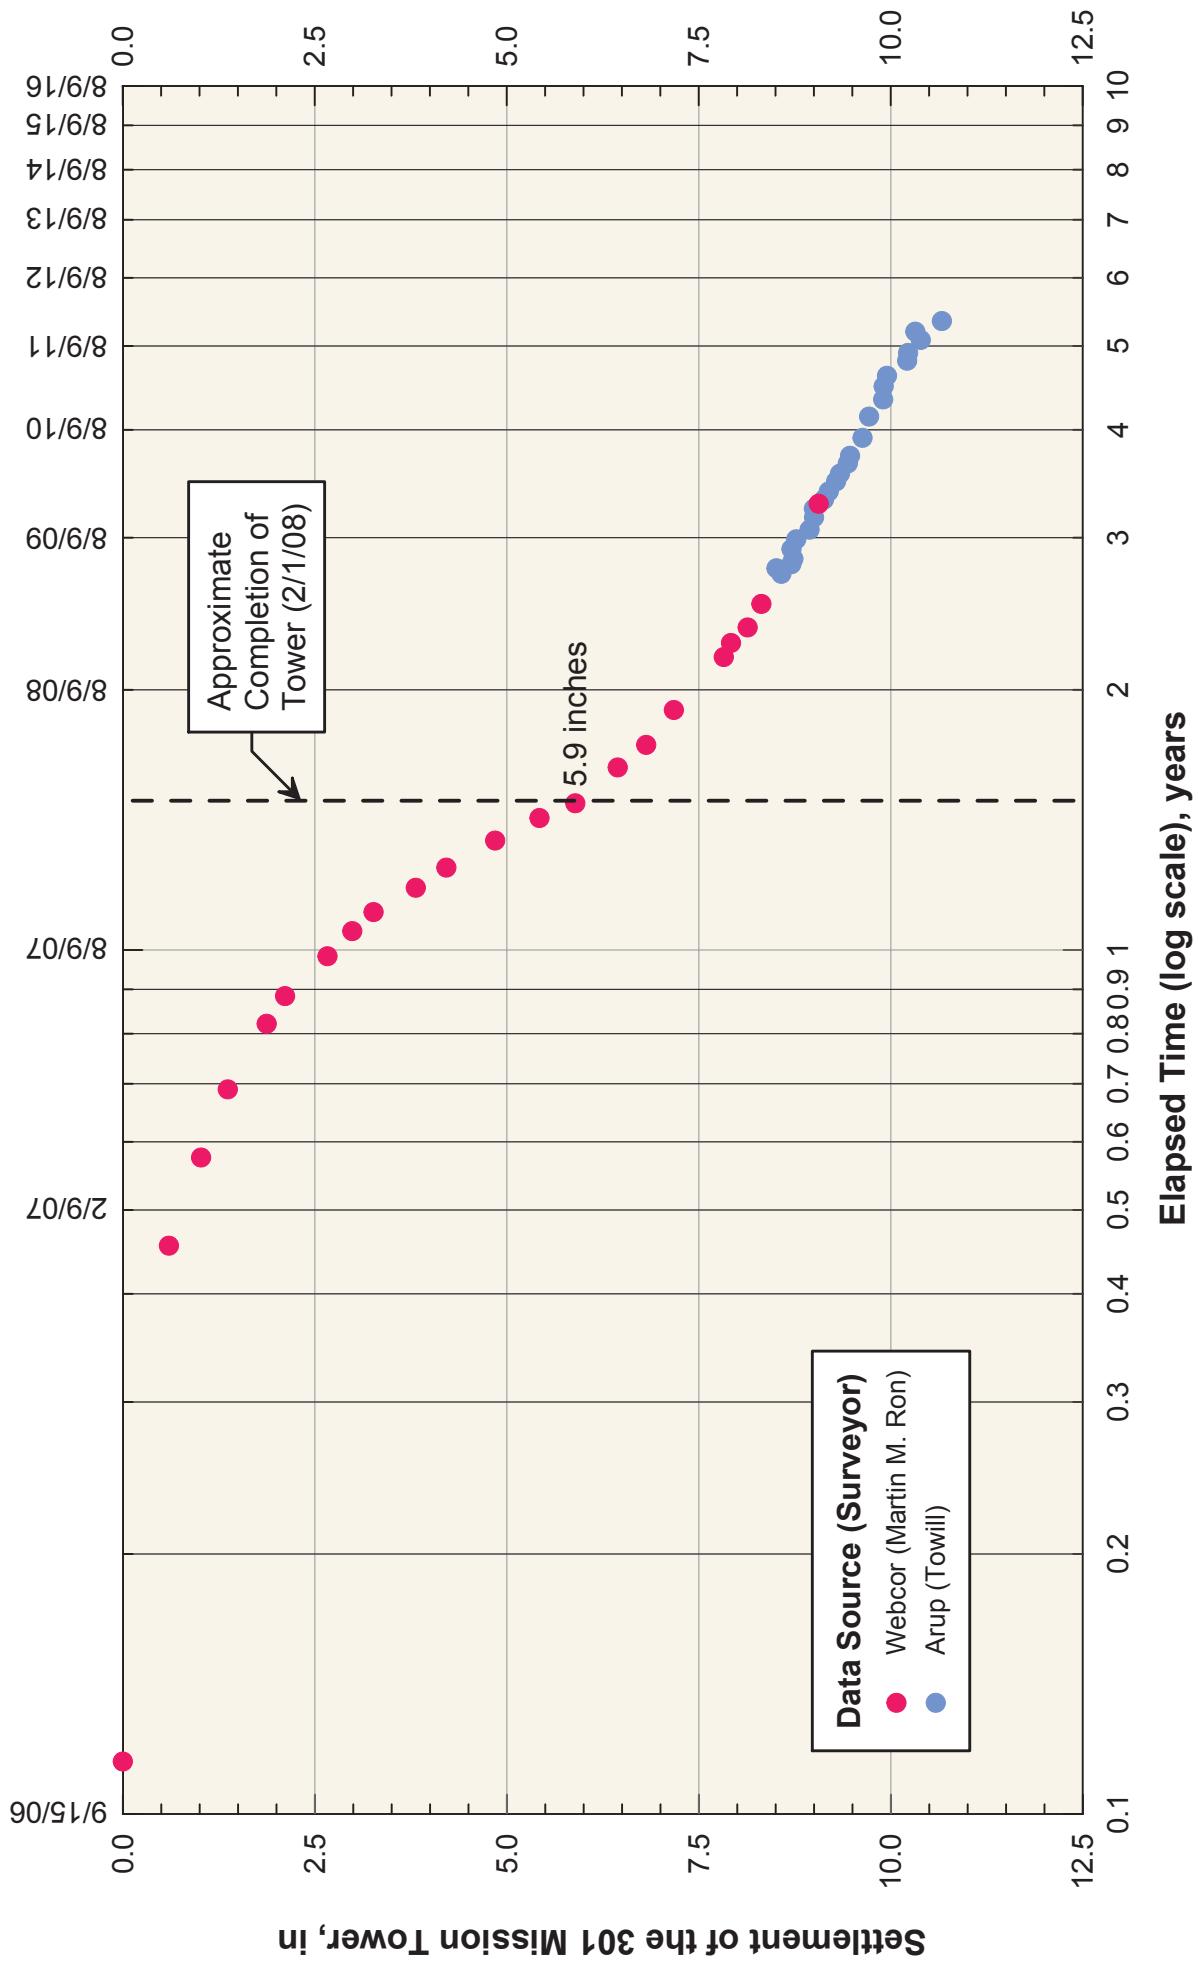



SETTLEMENTS OF THE 301 MISSION TOWER INCLUDING MONITORING DURING CONSTRUCTION

Transbay Transit Center
301 Mission Monitoring
Transbay Joint Powers Authority
San Francisco, California

December 2011

Beginning of Tower Construction: 8/9/06
End of Tower Construction: 2/1/08
Construction Duration: 542 days (1.5 years)

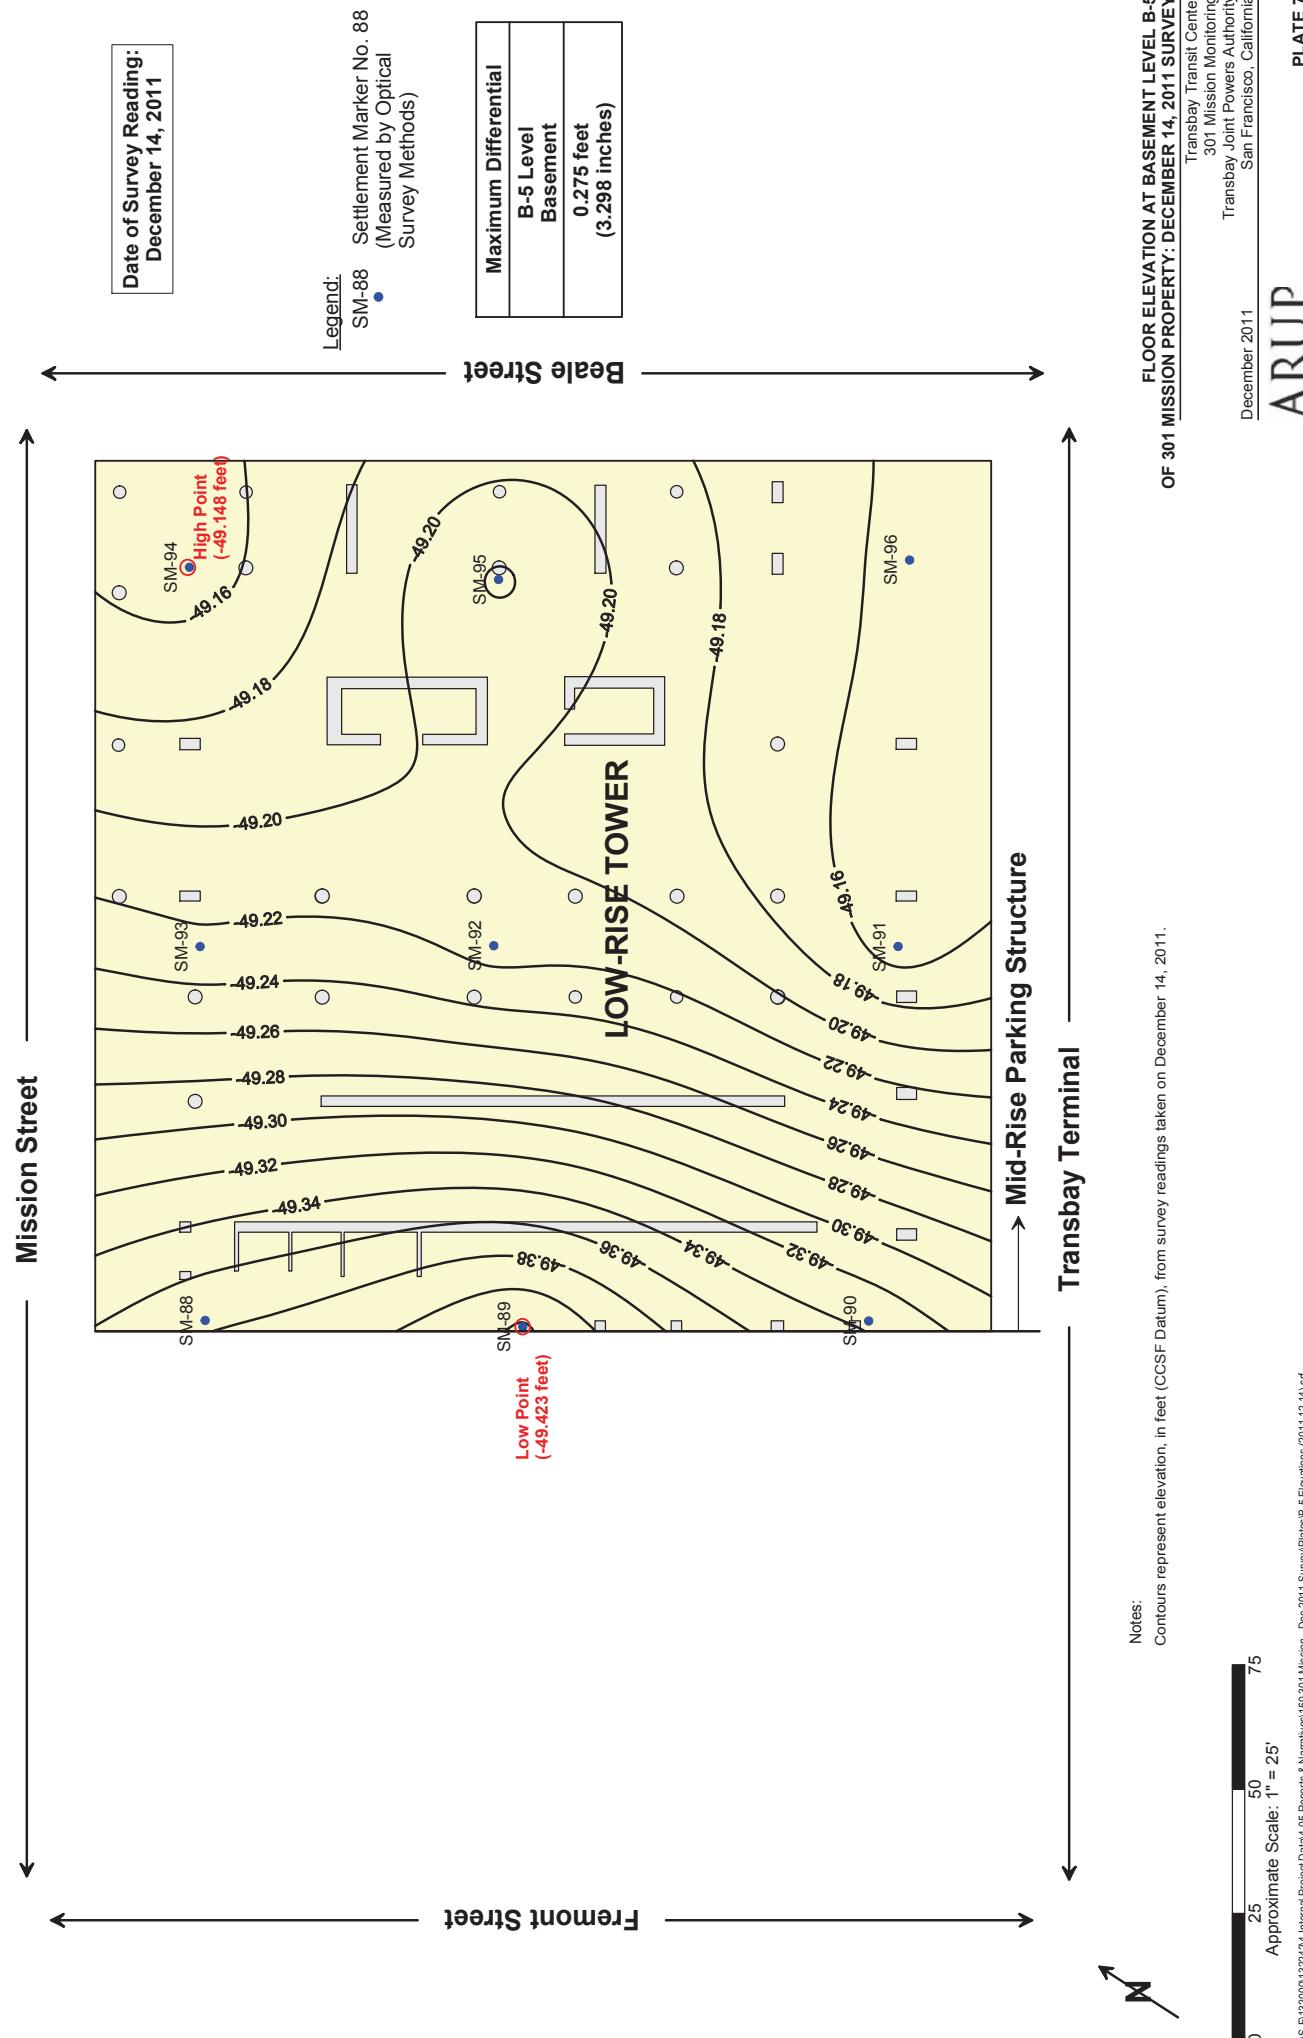

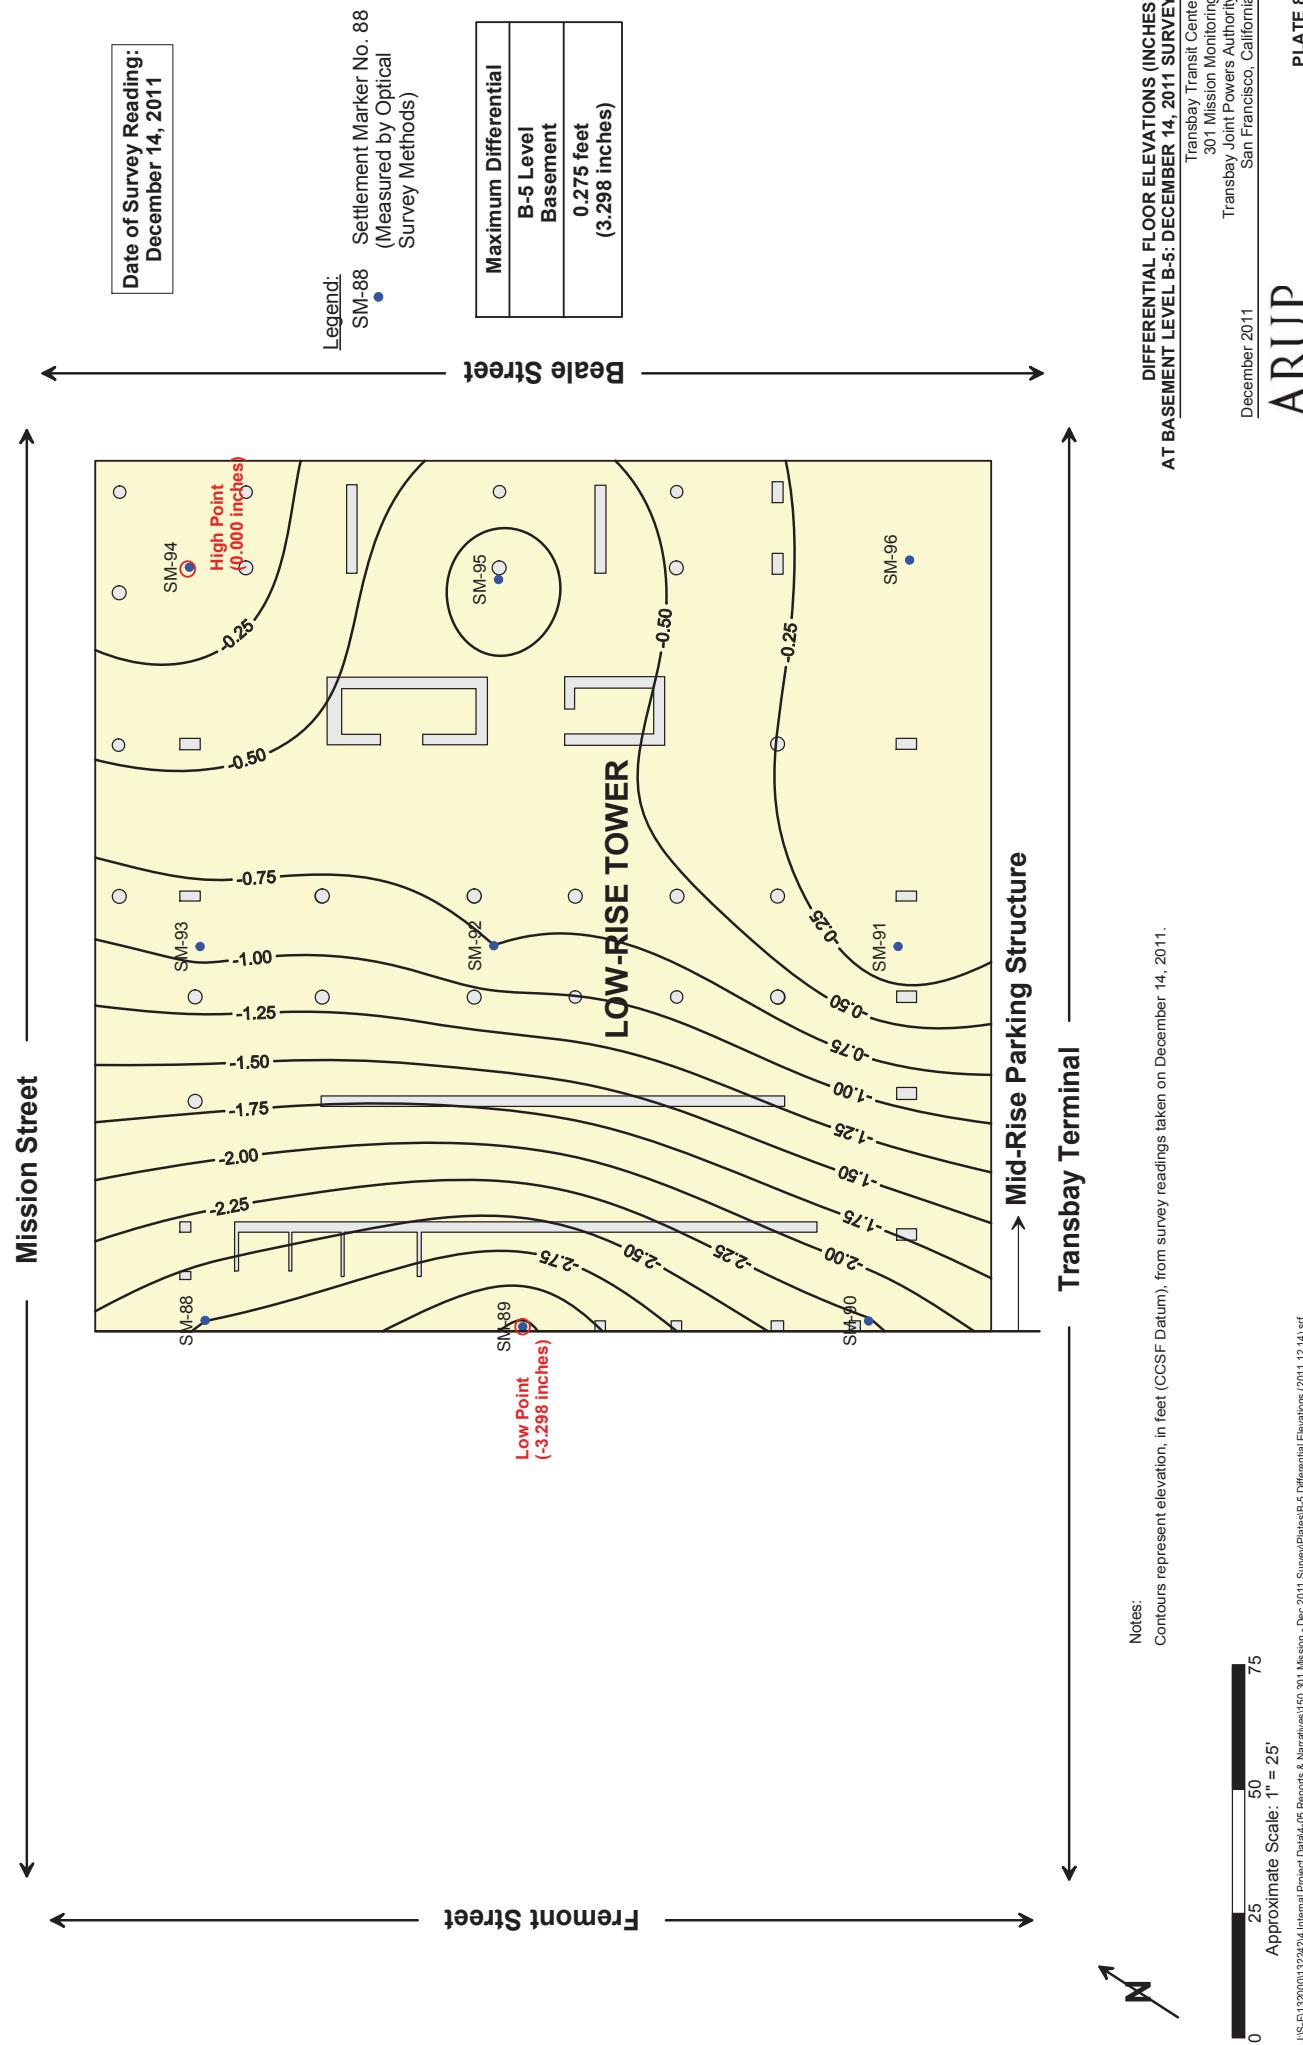

From: Brian Dykes <bdykes@transbaycenter.org>
Sent: Tuesday, March 20, 2012 10:19 AM
To: Steven Hood; John Luciano
Cc: Robert Beck; Ed Sum; Nick O'Riordan
Subject: FW: 301 Mission Monitoring - March Survey
Attachments: 2012-03-07 Memo_301 Mission Settlement - March 2012 Survey.pdf

Steve,

Here are the latest settlement readings taken on March 7, 2011.

As shown on plate 6, the total maximum settlement recorded to date is now almost 11 inches and the average rate has not changed over the last four years.

Brian.

From: Stephen McLandrich [<mailto:stephen.mclandrich@arup.com>]

Sent: Monday, March 19, 2012 6:32 PM

To: Brian Dykes

Cc: Robert Beck; rvolenec@pcparch.com; George Metzger; Emilio Cruz; Nick O'Riordan; Kevin Clinch; DeeDee Maggi

Subject: 301 Mission Monitoring - March Survey

Brian,

Here are the results of the latest monitoring survey of the settlement markers in the 301 Mission basement.

Let me know if you have any questions.

Regards,
Stephen

Stephen McLandrich PE GE

Senior Geotechnical Engineer

Arup

560 Mission Street Suite 700 San Francisco CA 94105 USA

t +1 415 957 9445 d +1 415 946 0245

f +1 415 957 9096 c +1 415 310 1095

www.arup.com

Check out our progress at <http://transbaycenter.org/construction-updates/construction-cameras>

NOTE: This e-mail communication and any attachments hereto are covered by the Electronic Communications Privacy Act, 18 U.S.C. Sections 2510-2521, and are legally privileged. The information contained herein is confidential, and is intended only for the use of the individual or entity to whom it is addressed. If you are not the intended recipient of this e-mail communication (or an employee or agent responsible for delivering this communication to its intended recipient(s)), you are hereby notified that any retention, copying or further distribution of this e-mail communication and any attachments is strictly prohibited. If you are not the intended recipient, please notify the sender by telephoning 415-597-4620, or by forwarding an e-mail reply message addressed to TransAdmin@TransbayCenter.org confirming that you have already destroyed (deleted) the original e-mail communication and any and all copies thereof. Thank you.

Memorandum


ARUP

To	Brian Dykes (TJPA)	Date
		19 March 2012
Copies	Robert Beck (TJPA) Emilio Cruz (PMPC) Randy Volenec (PCPA) George Metzger (AAI)	Reference number 132242-60/SMM
From	Stephen McLandrich (Arup) Nick O'Riordan (Arup) Kevin Clinch (Arup)	File reference 4-05 160
Subject	Transbay Transit Center: Results of March 2012 Settlement Survey at 301 Mission Property	Page 1 of 1

Under Arup's Geotechnical Contract with the Transbay Joint Powers Authority through Pelli Clark Pelli Architects, Arup is required to monitor the settlements of the buildings adjacent to the Transbay Transit Center prior to and during construction. We began the monitoring program for the 301 Mission property in April of 2009. This memorandum and the attached plates present an update to our memorandum dated December 23, 2011 with measurements made through March 2012.

List of Plates

- Plate 1 Floor Elevations at Level B-1 of 301 Mission Property: Periodic Survey – March 7, 2012
- Plate 2 Differential Floor Elevation (Inches) – March 7, 2012 Survey
- Plate 3 Contours of Settlements Measured at the First Level Basement of the 301 Mission Street Structure Between April 30, 2009 and March 7, 2012
- Plate 4 Settlement Over Time Floor Elevations at Level B-1 of 301 Mission Property – Tower: April 30, 2009 through March 7, 2012.
- Plate 5 Settlement Over Time Floor Elevations at Level B-1 of 301 Mission Property – Mid-Rise: April 30, 2009 through March 7, 2012
- Plate 6 Settlements of the 301 Mission Tower Including Monitoring During Construction
- Plate 7 Floor Elevation at Basement Level B-5 of 301 Mission Property: March 7, 2012 Survey
- Plate 8 Differential Floor Elevations (Inches) at Basement Level B-5: March 7, 2012 Survey

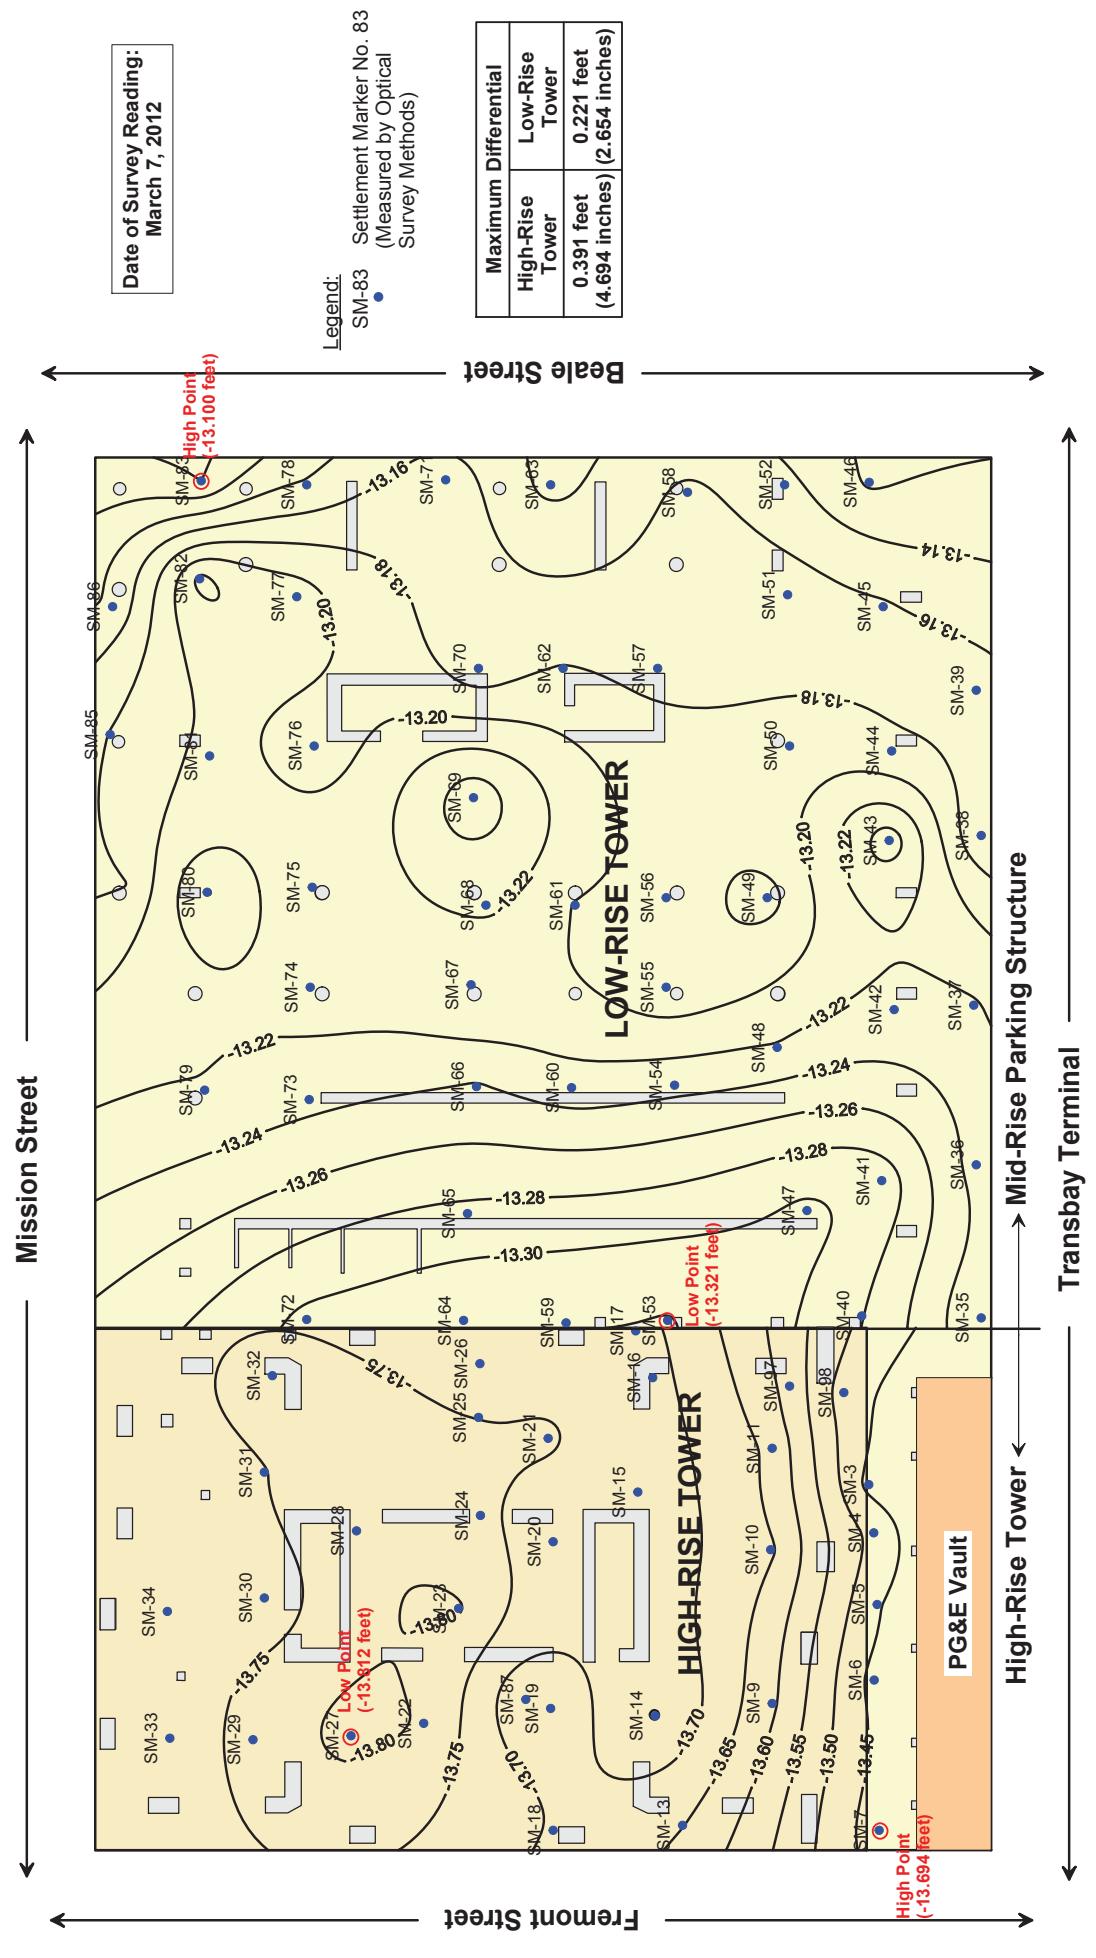

**FLOOR ELEVATIONS AT LEVEL B-1
OF 301 MISSION PROPERTY:
PERIODIC SURVEY - MARCH 7, 2012**


Transbay Transit Center
301 Mission Monitoring
Transbay Joint Powers Authority
San Francisco, California

PLATE 1

ARUP

Notes:
Contours represent elevation, in feet (CCSF Datum), from survey readings taken on March 7, 2012.
Level B-1 at Mid-Rise Parking portion of survey site is approximately 4 inches higher than Level B-1 at High-Rise Tower portion.
The PG&E vault is inaccessible for monitoring.

Approximate Scale: 1" = 25'
0 25 50 75
USFS-13200013224 Internal Project Data445 Reports & Narratives\160_301 Mission - Mar 2011 Survey\Plates\Elevations All (2012 03 07).tif

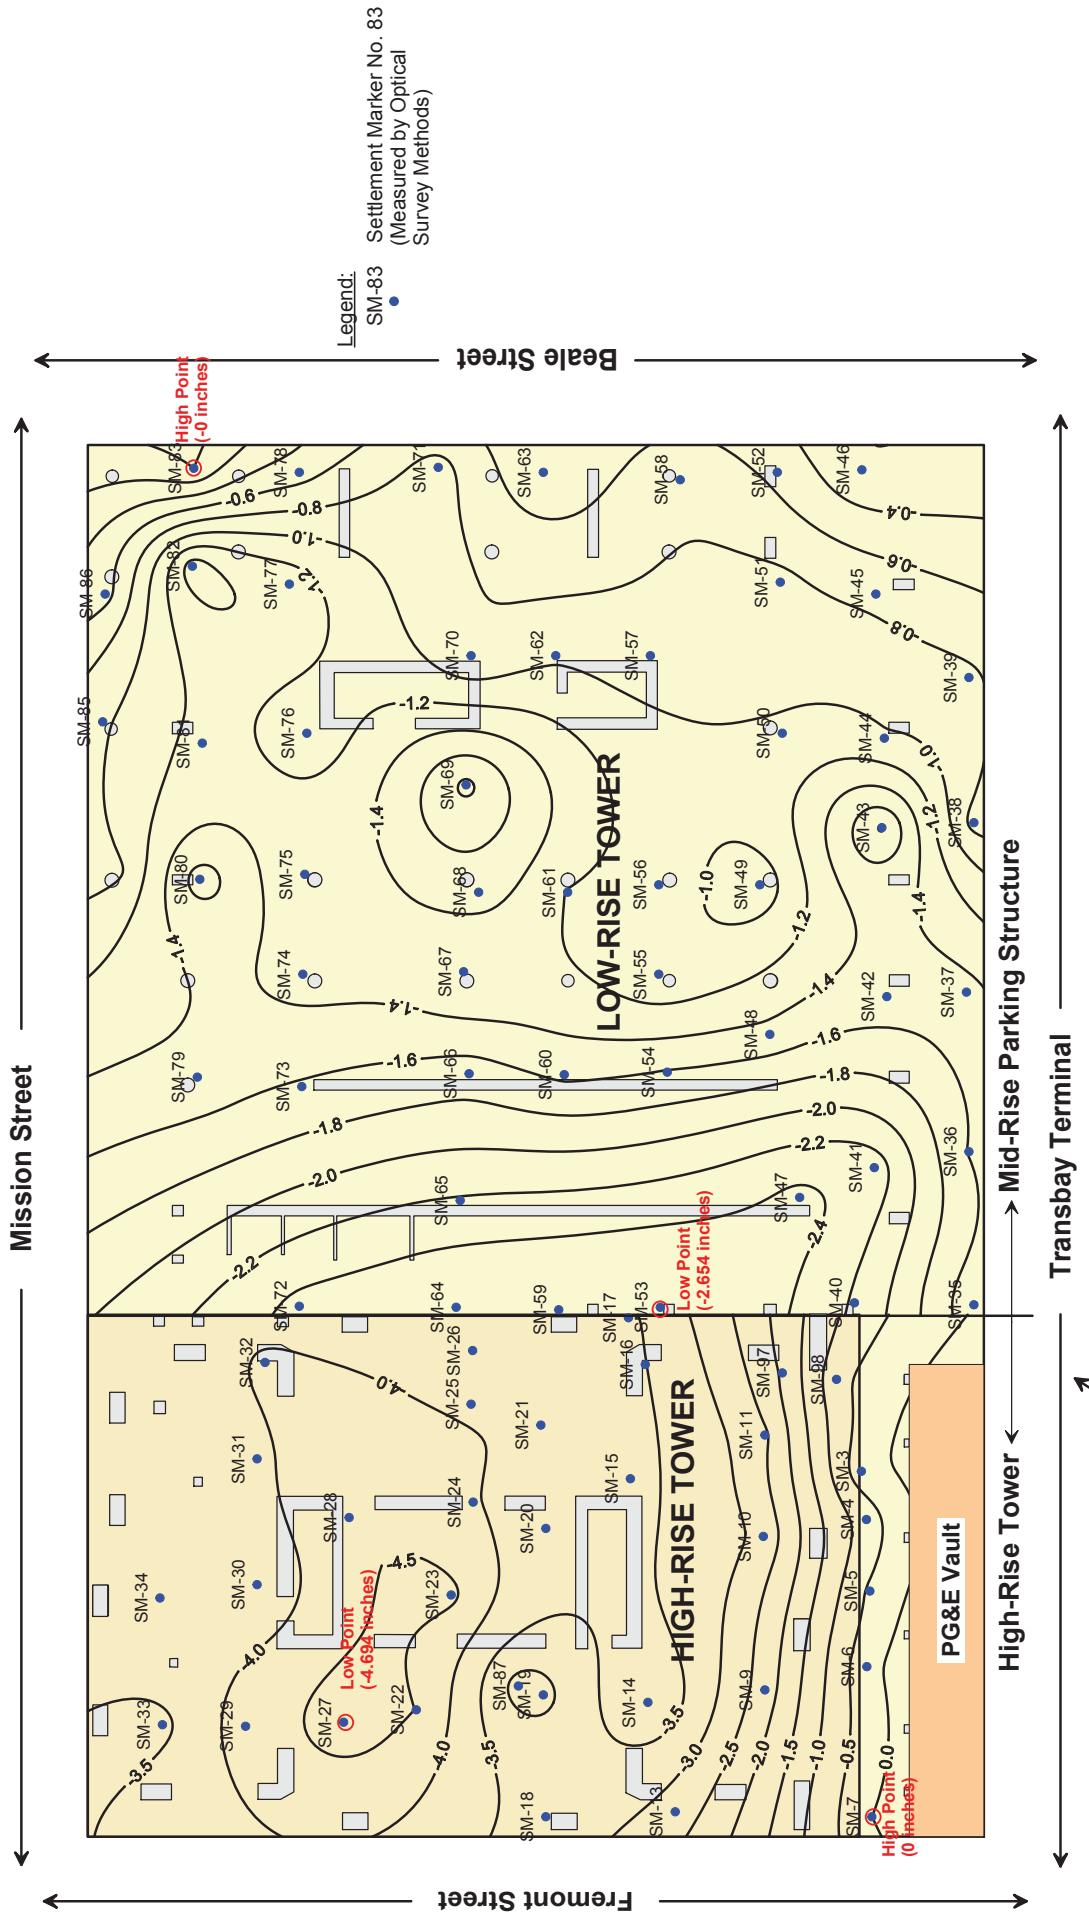


MARCH 7, 2012 SURVEY

Transbay Transit Center
301 Mission Monitoring
Transbay Joint Powers Authority
San Francisco, California

PLATE 2

Notes: / Approximate Scale: 1 - 20
Contours represent differential elevation, in inches, between the highest point and all other points taken on March 7, 2012.
Level B-1 at Mid-Rise Parking portion of survey site is approximately 4 inches higher than Level B-1 at High-Rise Tower portion.

The PG&E vault is inaccessible for monitoring.
Contour intervals are different between the High-Rise Tower and the Low-Rise Tower.

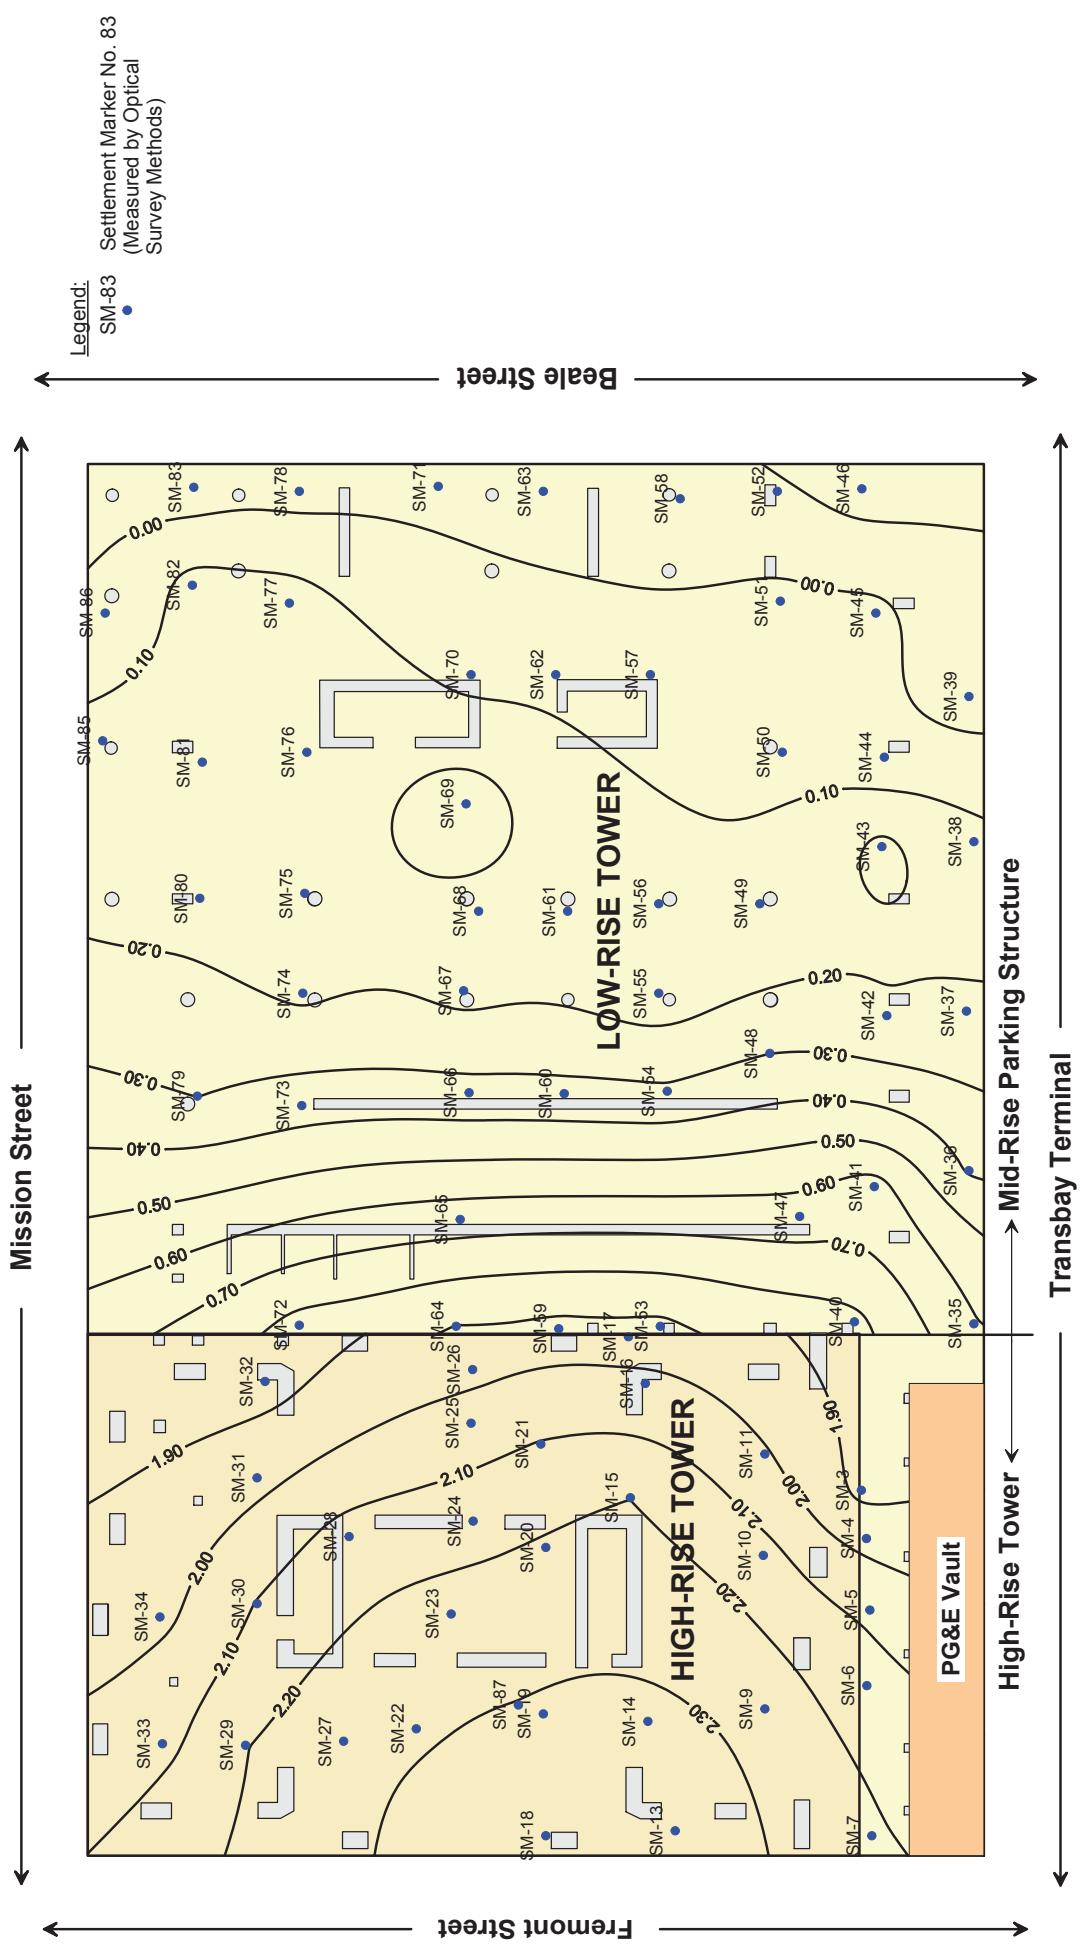

CONTOURS OF SETTLEMENTS MEASURED AT THE FIRST LEVEL BASEMENT OF THE 301 MISSION STREET STRUCTURE BETWEEN APRIL 30, 2009 AND MARCH 7, 2012.

Transbay Transit Center
301 Mission Monitoring
Transbay Joint Powers Authority
San Francisco, California

March 2012

Notes:
Contours represent elevation change, in inches, between Baseline survey (April 30, 2009) and readings taken on March 7, 2012.
Level B-1 at Mid-Rise Parking portion of survey site is approximately 4 inches higher than Level B-1 at High-Rise Tower portion.
The PG&E vault is inaccessible for monitoring.
Negative values of settlement (within Low-rise Tower) indicate uplift.

J.S.F-132000132424 Internal Project Data v4-05 Reports v4-Narratives160_391 Mission 0 - Mar_2011 Survey\Piles\Plots\Elevation changes AI (2012.03.07).srf

Approximate Scale: 1" = 25'

0

25

50

ARUP


Note:
Initial (Baseline) reading
taken on 04/30/09



**SETTLEMENT OVER TIME
FLOOR ELEVATIONS AT LEVEL B-1
OF 301 MISSION PROPERTY - TOWER:
APRIL 30, 2009 THROUGH MARCH 7, 2012**

Transbay Transit Center
301 Mission Monitoring
Transbay Joint Powers Authority
San Francisco, California



March 2012

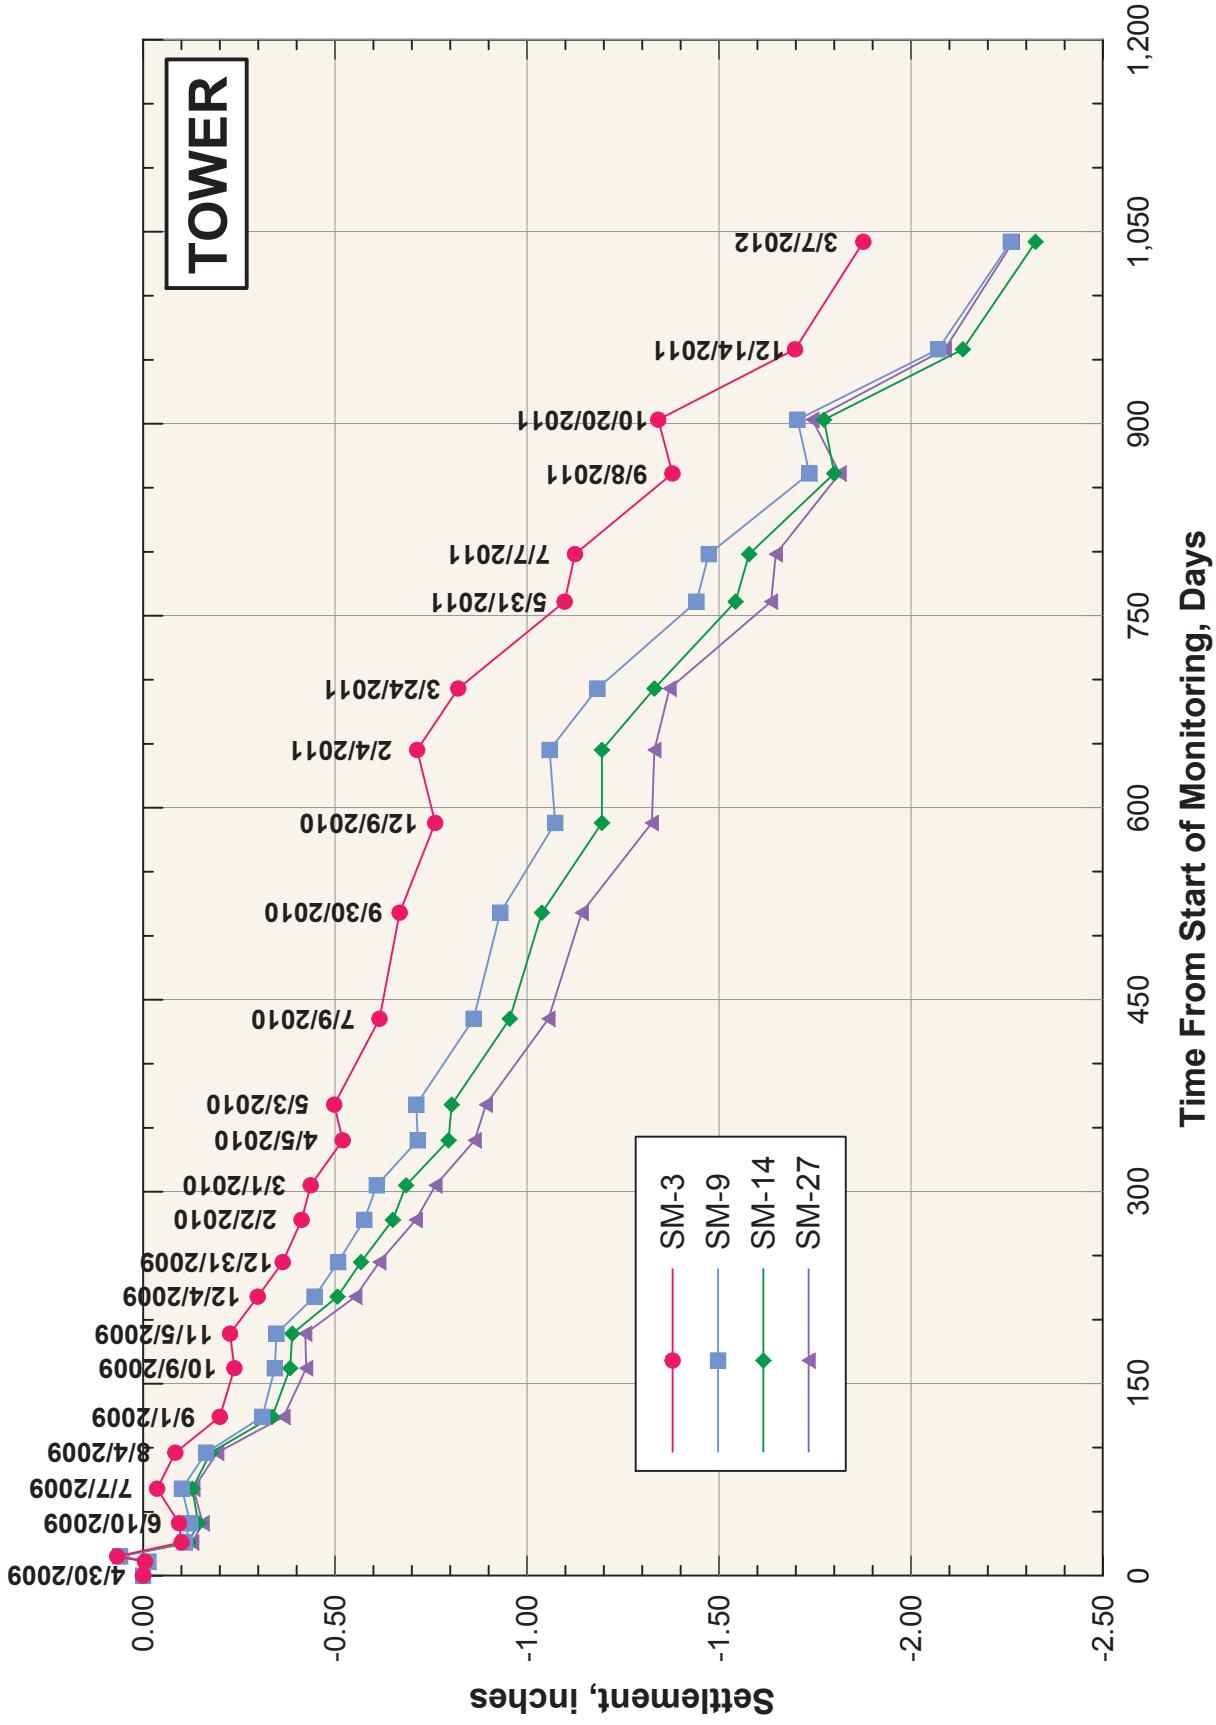


ARUP

Note:
Initial (Baseline) reading
taken on 04/30/09

J:\\S\\FV\\1322424 Internal Project Data\\4.05 Reports & Narratives\\160 301 Mission - Mar 2011 Survey\\Plates\\Plate 5 Settlement Over Time - Midrise.grf

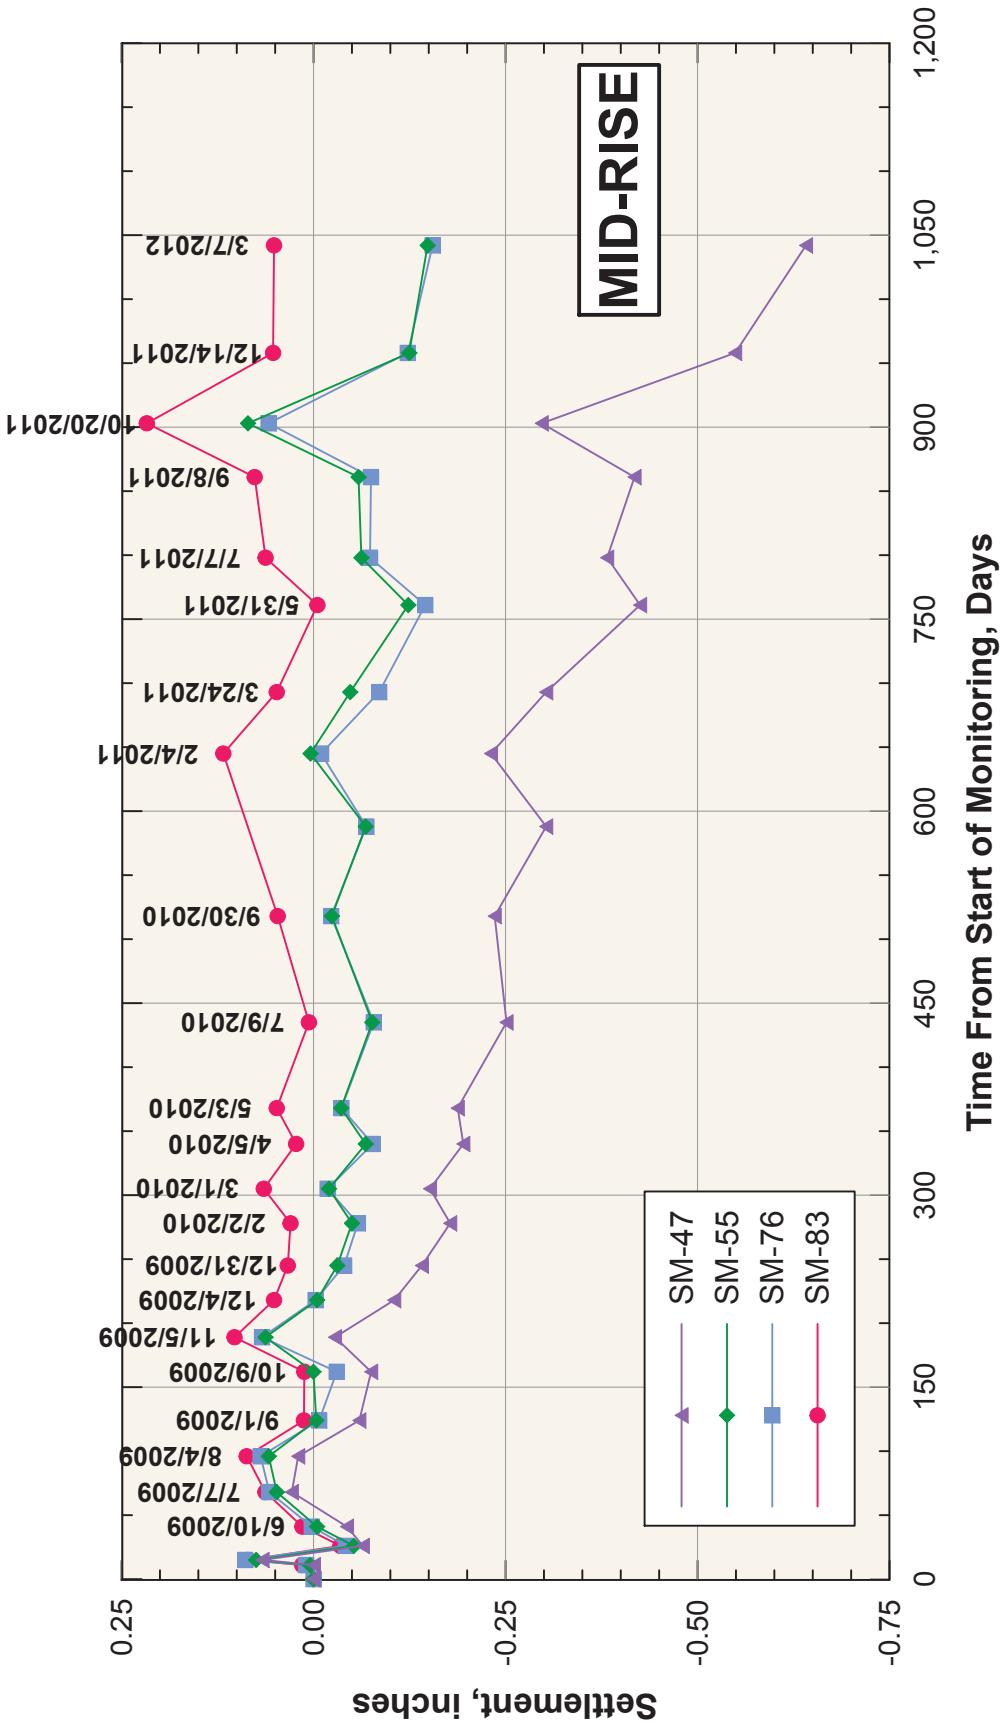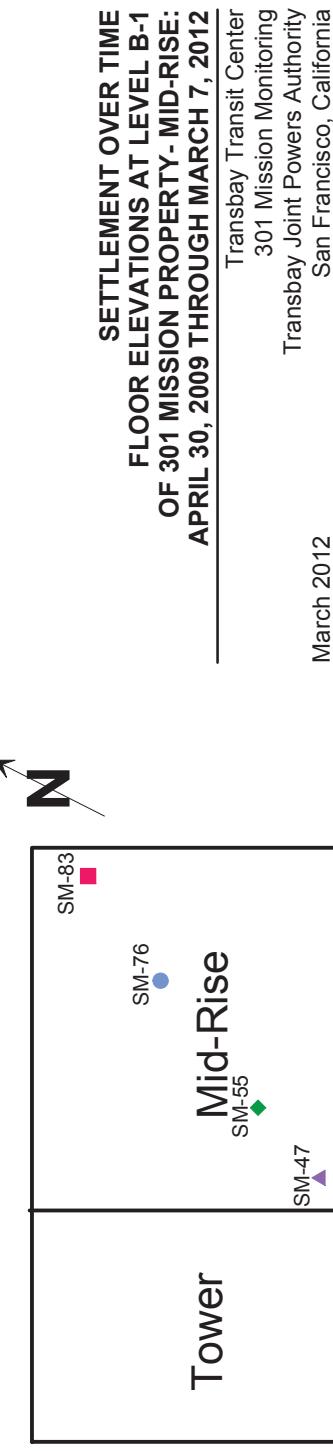

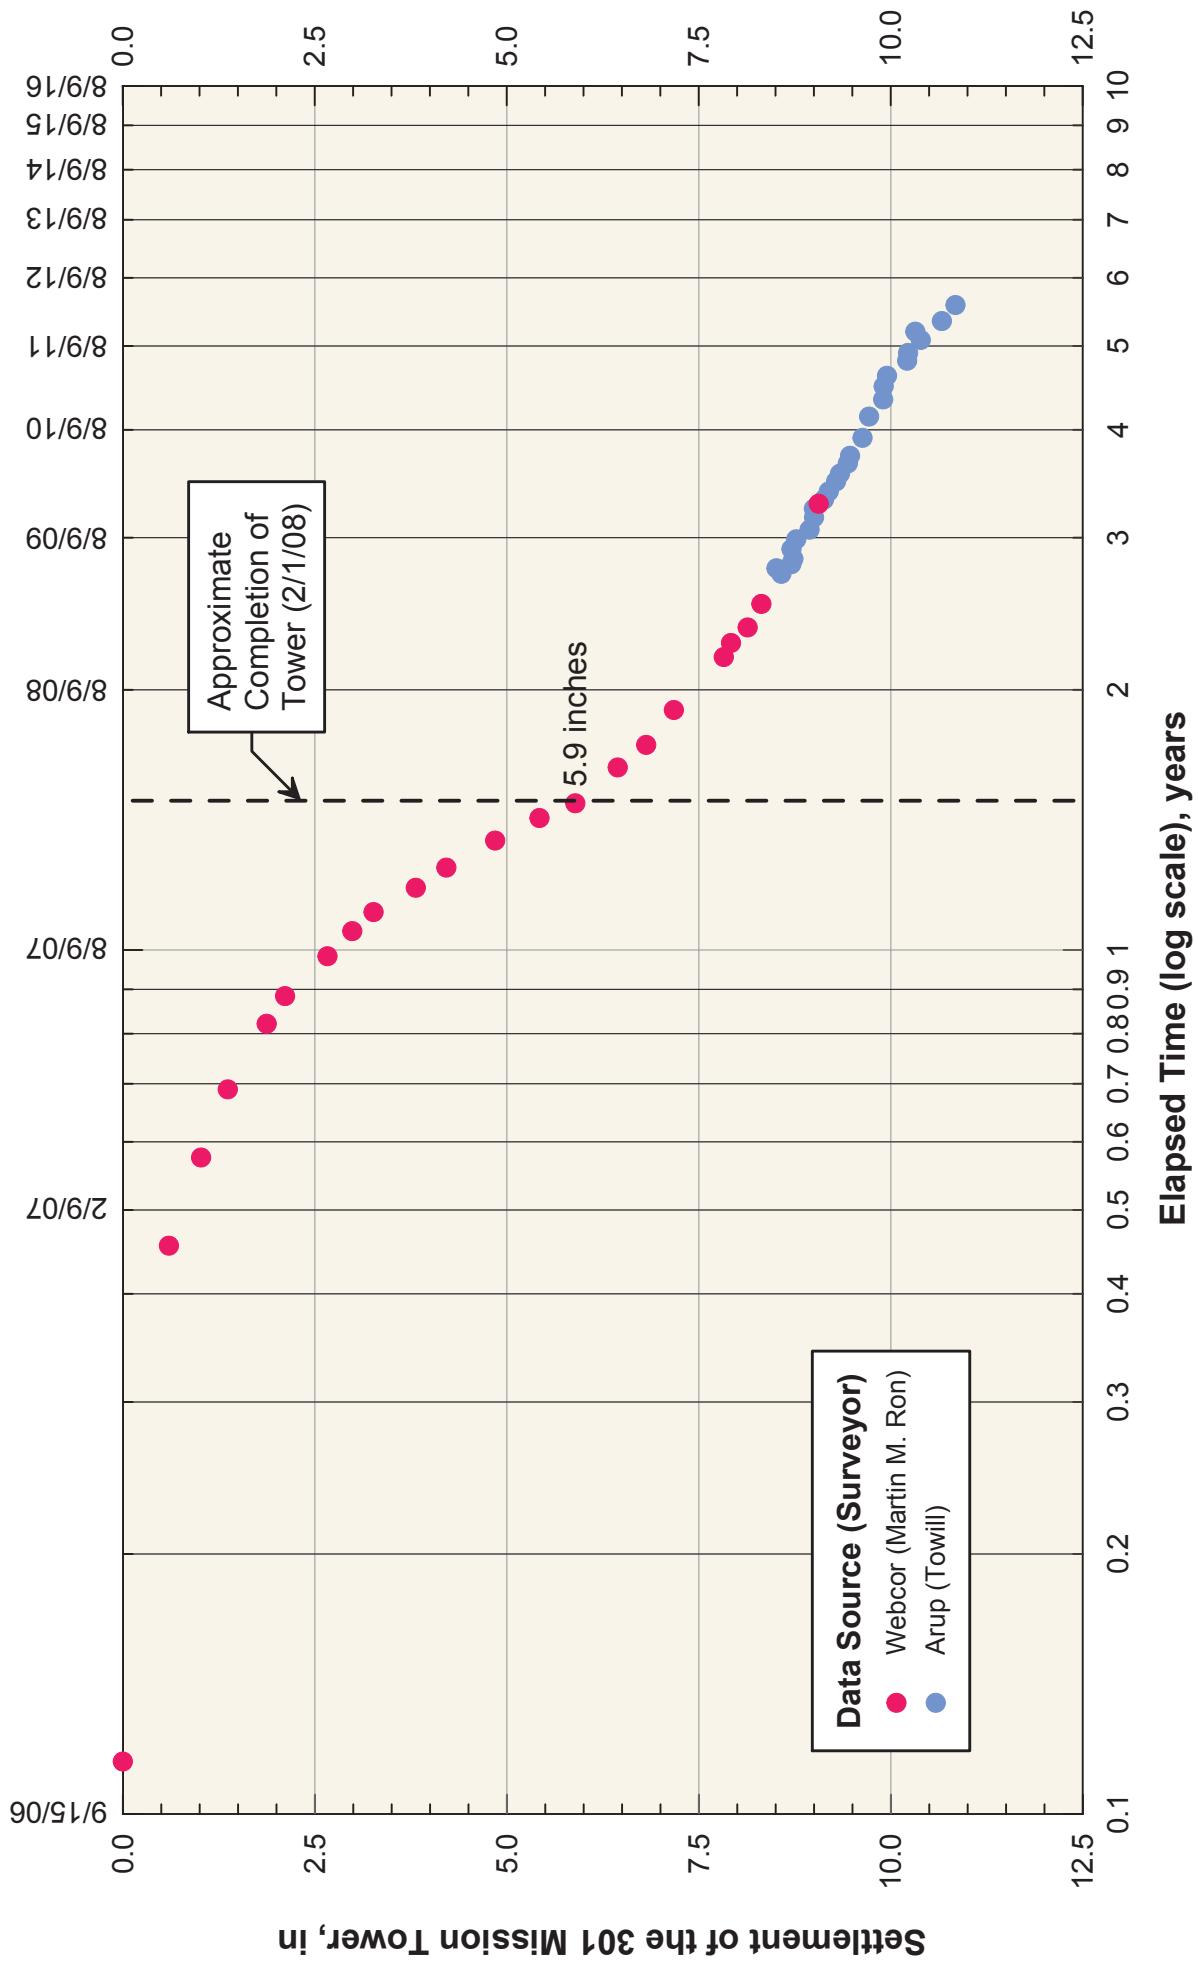

**SETTLEMENTS OF THE 301 MISSION TOWER
INCLUDING MONITORING DURING CONSTRUCTION**


Transbay Transit Center
301 Mission Monitoring
Transbay Joint Powers Authority
San Francisco, California


March 2012

Beginning of Tower Construction: 8/9/06
End of Tower Construction: 2/1/08
Construction Duration: 542 days (1.5 years)

March 2012

ARUP

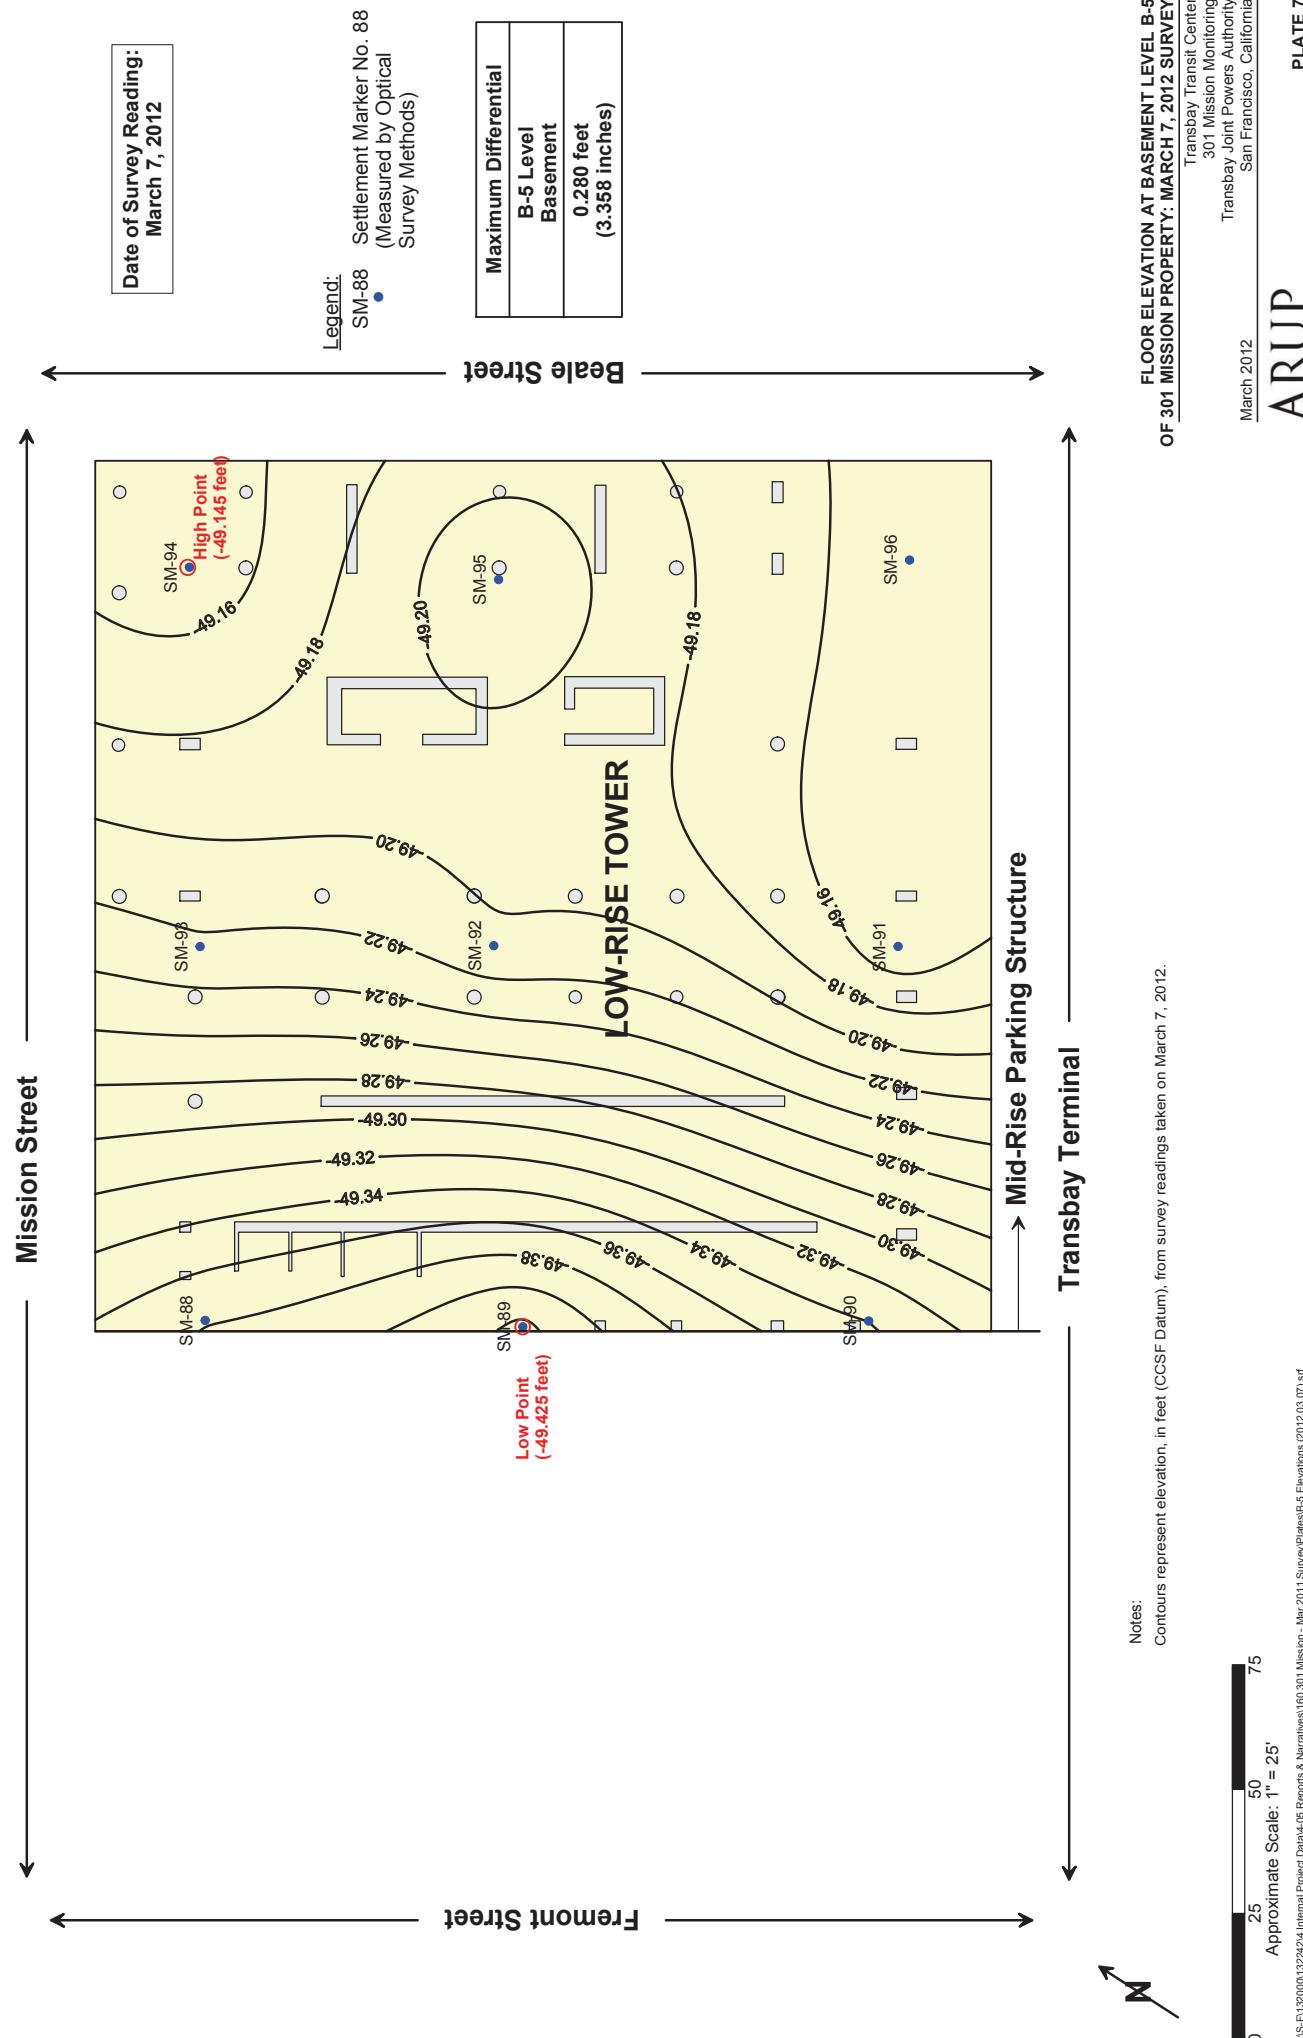

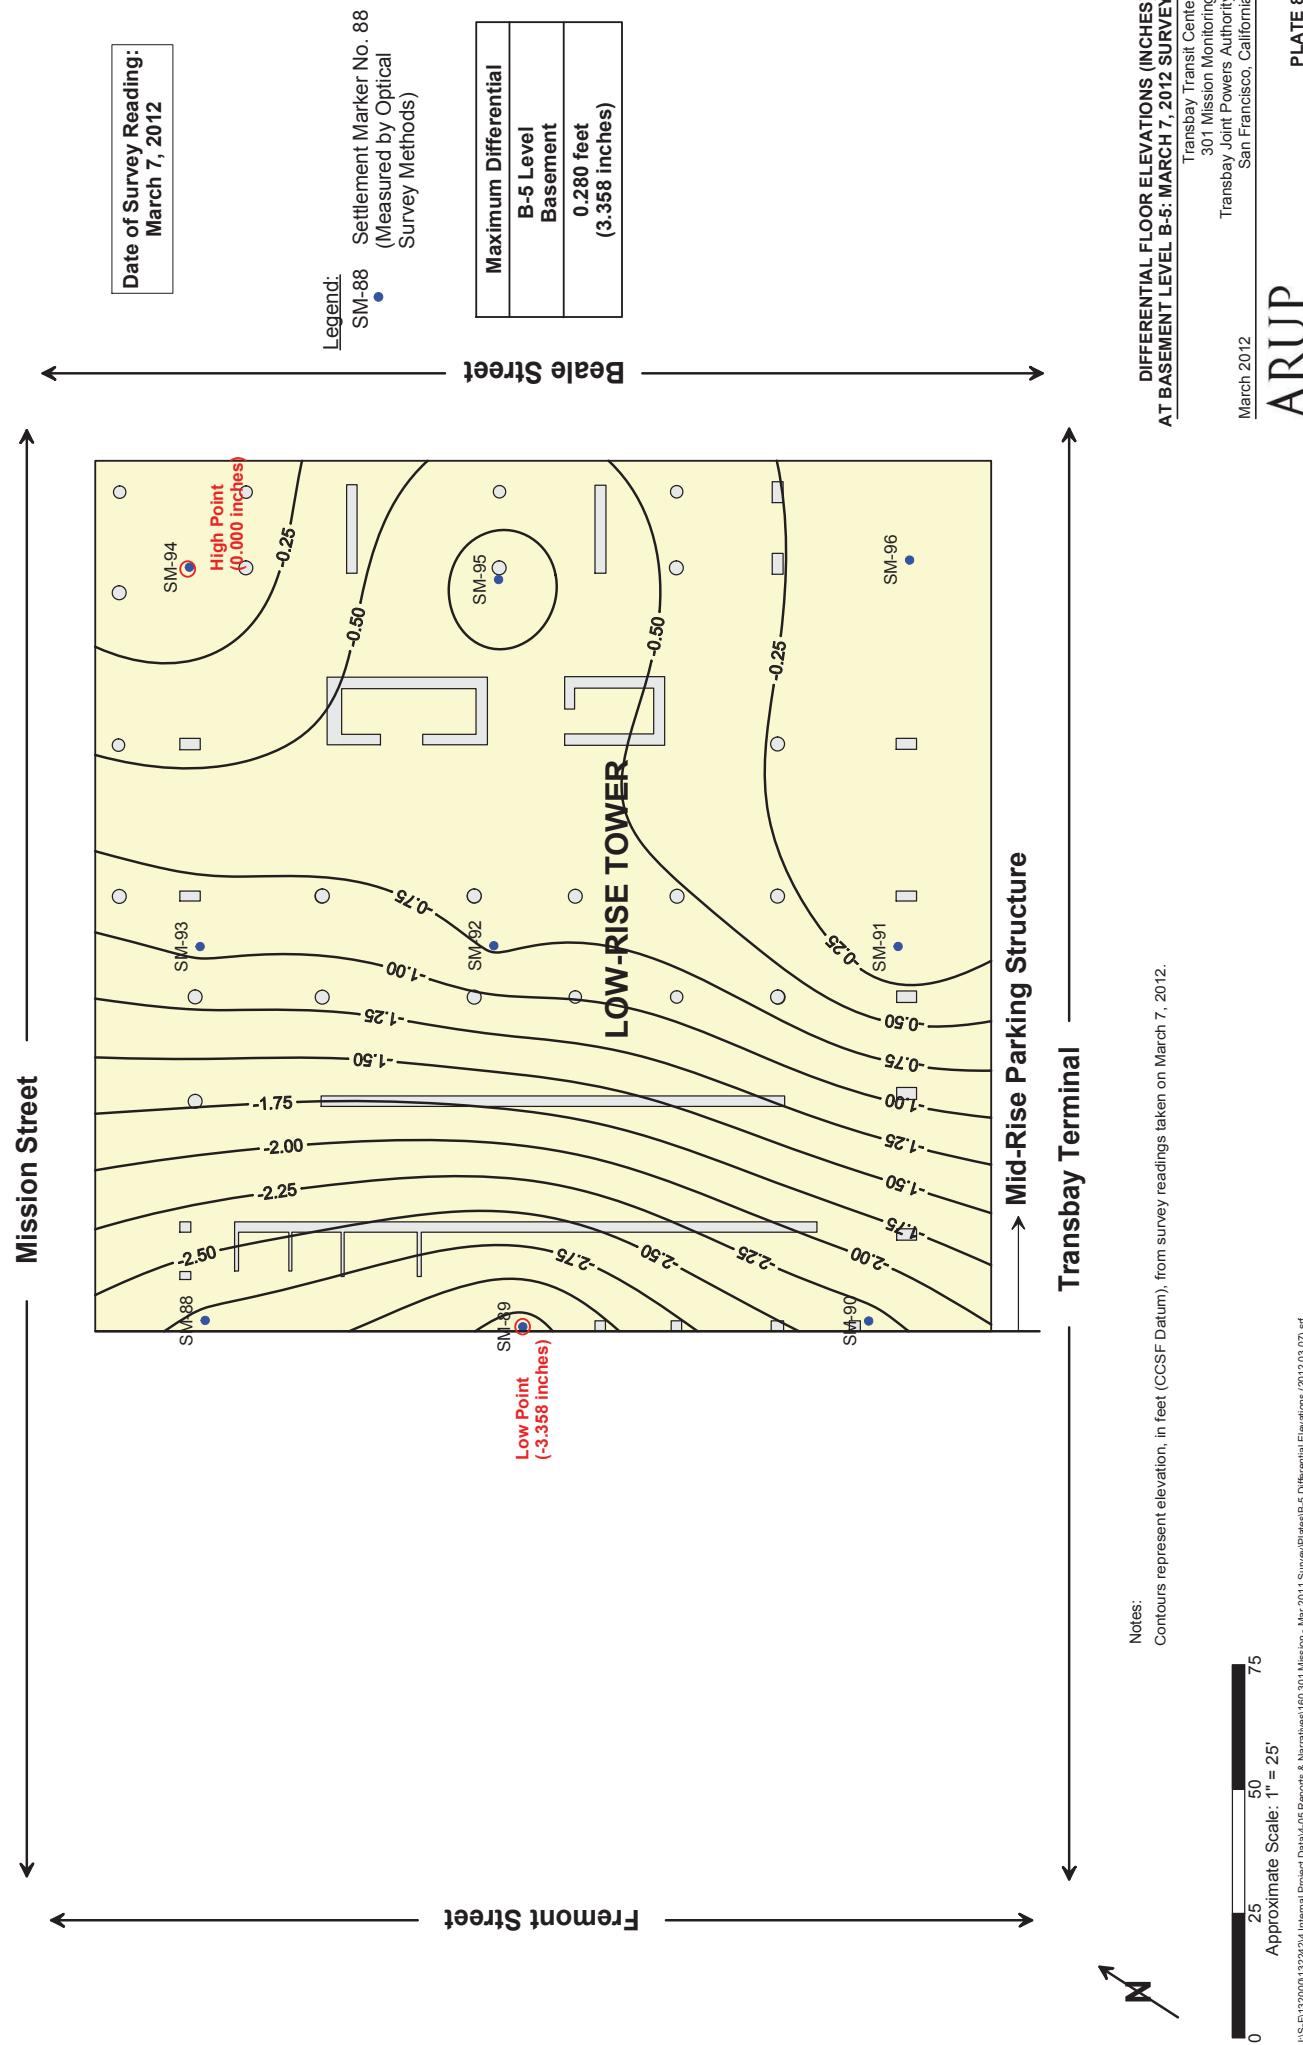

Memorandum


ARUP

To	Brian Dykes (TJPA)	Date
		27 April 2012
Copies	Robert Beck (TJPA) Emilio Cruz (PMPC) Randy Volenec (PCPA) George Metzger (AAI)	Reference number 132242-60/SMM
From	Stephen McLandrich (Arup) Nick O'Riordan (Arup) Kevin Clinch (Arup)	File reference 4-05 165
Subject	Transbay Transit Center: Results of April 2012 Settlement Survey at 301 Mission Property	Page 1 of 1

Under Arup's Geotechnical Contract with the Transbay Joint Powers Authority through Pelli Clark Pelli Architects, Arup is required to monitor the settlements of the buildings adjacent to the Transbay Transit Center prior to and during construction. We began the monitoring program for the 301 Mission property in April of 2009. This memorandum and the attached plates present an update to our memorandum dated March 7, 2011 with measurements made through April 2012.

List of Plates

- Plate 1 Floor Elevations at Level B-1 of 301 Mission Property: Periodic Survey – April 18, 2012
- Plate 2 Differential Floor Elevation (Inches) – April 18, 2012 Survey
- Plate 3 Contours of Settlements Measured at the First Level Basement of the 301 Mission Street Structure Between April 30, 2009 and April 18, 2012
- Plate 4 Settlement Over Time Floor Elevations at Level B-1 of 301 Mission Property – Tower: April 30, 2009 through April 18, 2012.
- Plate 5 Settlement Over Time Floor Elevations at Level B-1 of 301 Mission Property – Mid-Rise: April 30, 2009 through April 18, 2012
- Plate 6 Settlements of the 301 Mission Tower Including Monitoring During Construction
- Plate 7 Floor Elevation at Basement Level B-5 of 301 Mission Property: April 18, 2012 Survey
- Plate 8 Differential Floor Elevations (Inches) at Basement Level B-5: April 18, 2012 Survey

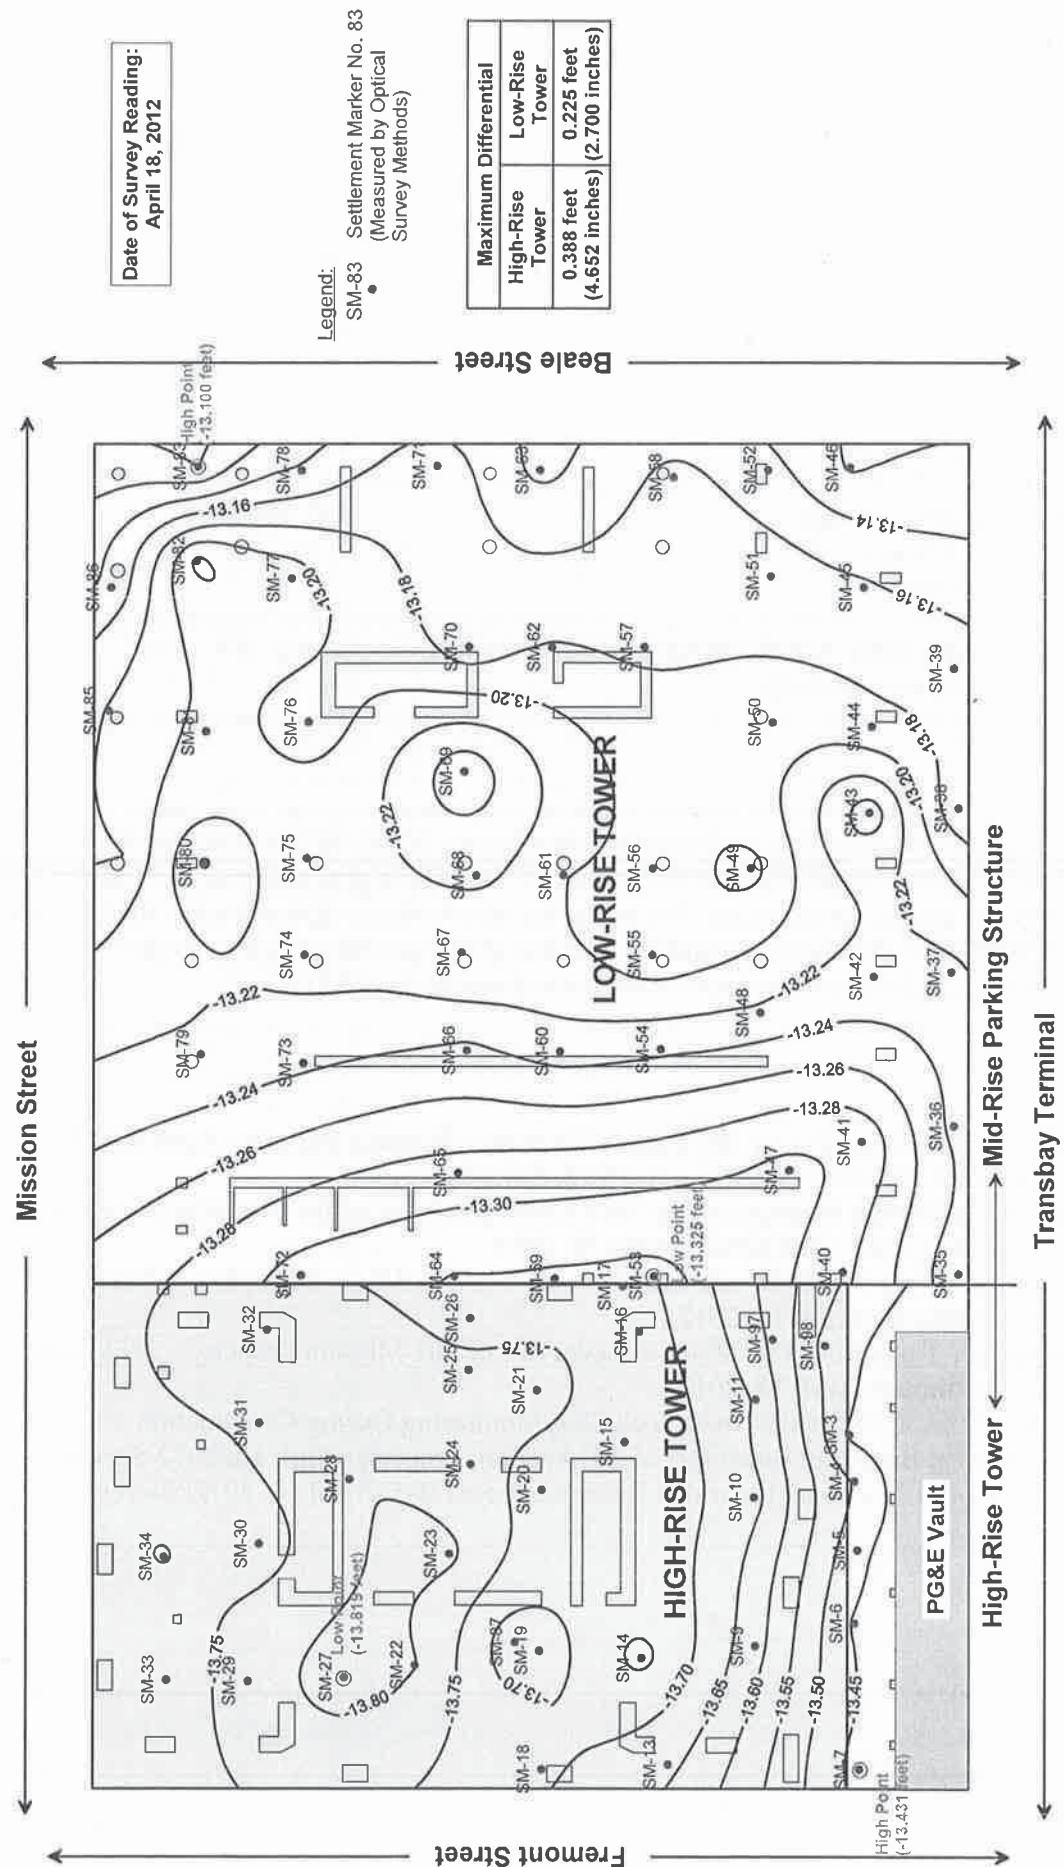


**FLOOR ELEVATIONS AT LEVEL B-1
OF 301 MISSION PROPERTY
PERIODIC SURVEY - APRIL 18, 2011**


Transbay Transit Centre
301 Mission Monitor
Transbay Joint Powers Authority
San Francisco, California

ARUP

Notes:
 Contours represent elevation, in feet (CCSF Datum), from survey readings taken on April 18, 2012.
 Level B-1 at Mid-Rise Parking portion of survey site is approximately 4 inches higher than Level B-1 at High-Rise Tower portion.
 The PG&E Vault is inaccessible for monitoring.

Approximate Scale: 1" = 25'
 0 25 50 75
 Internal Project Data Reports & Narratives 301 Mission Apr 2012 Survey Dates/Elevations All (2012-04-18).ser

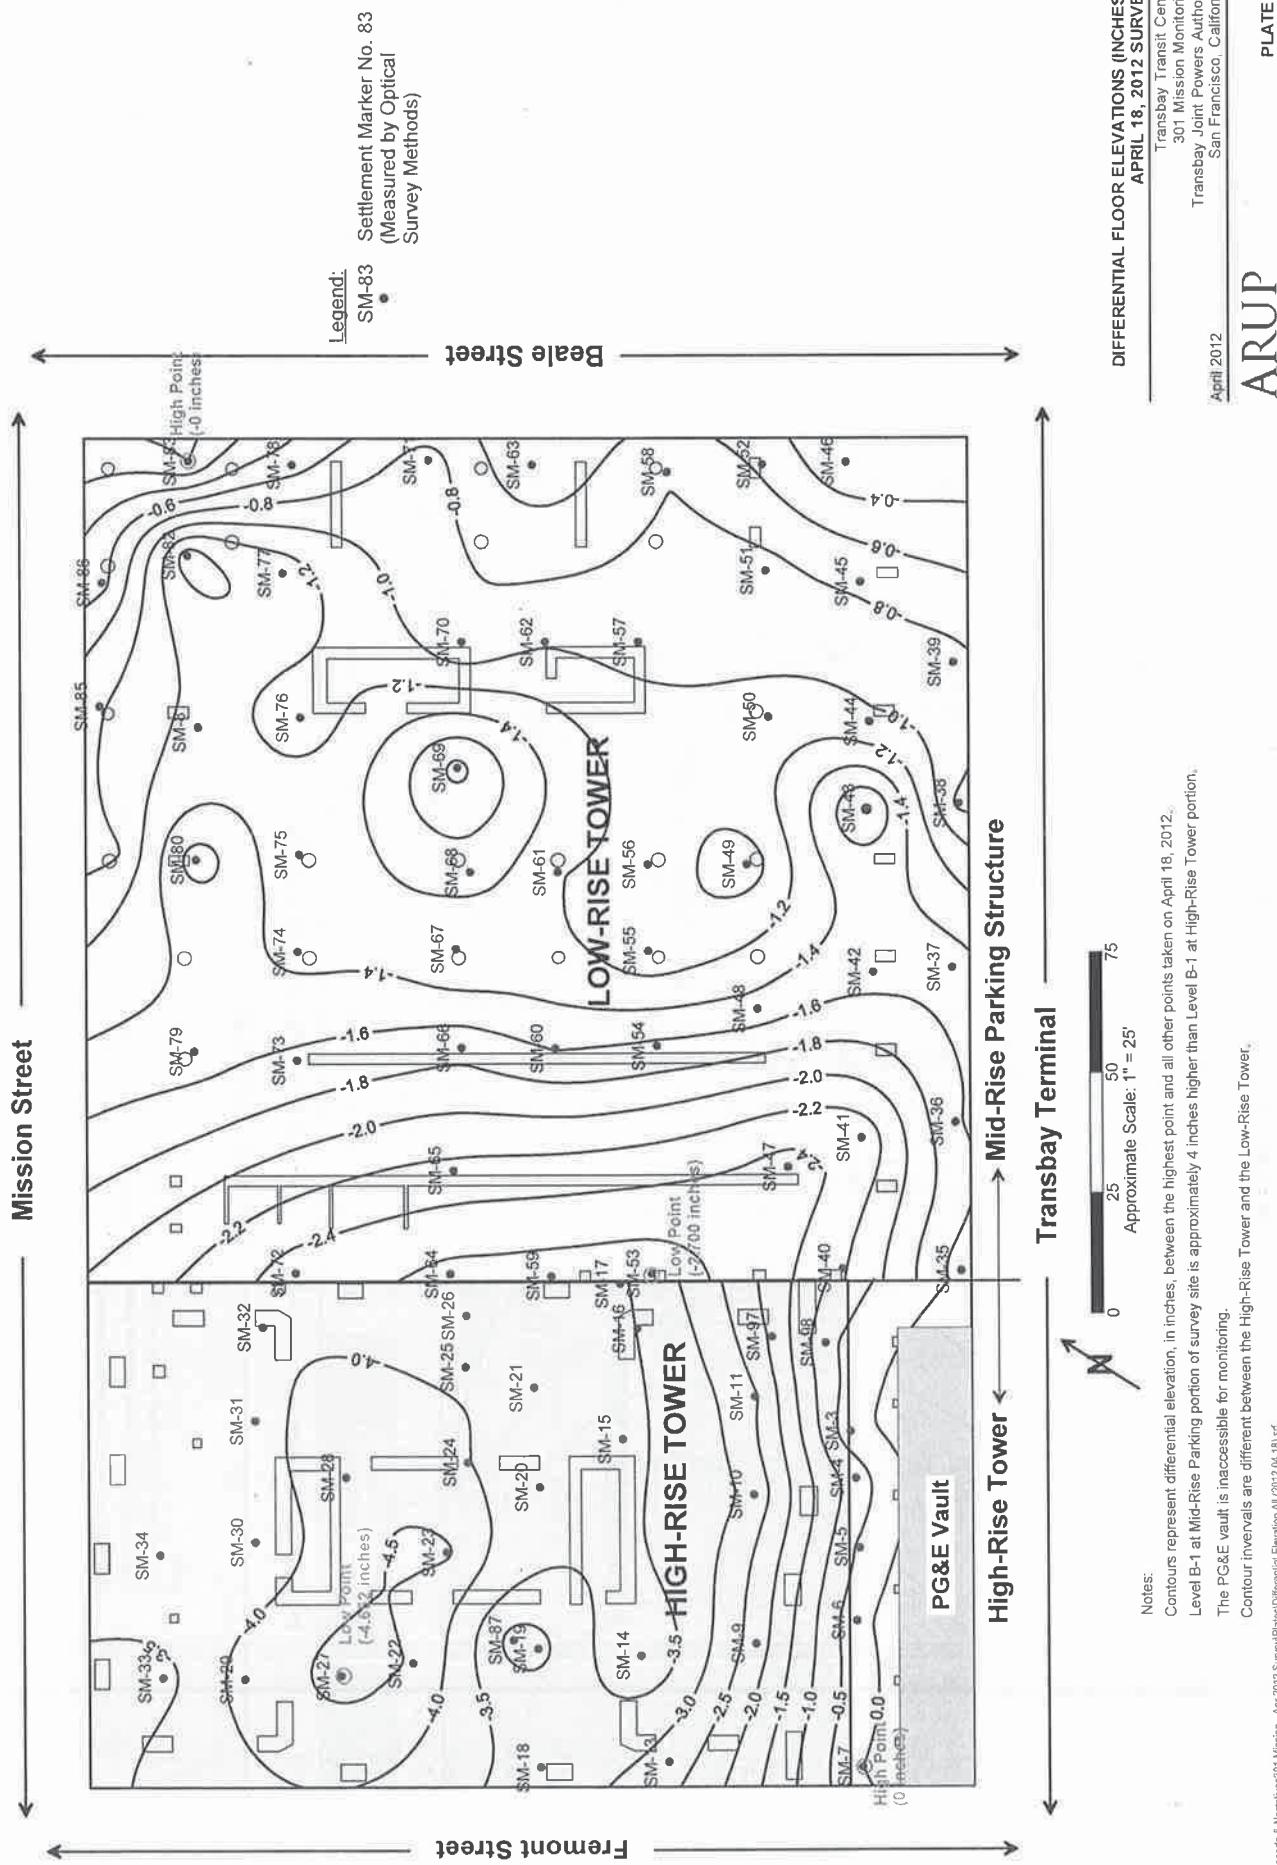

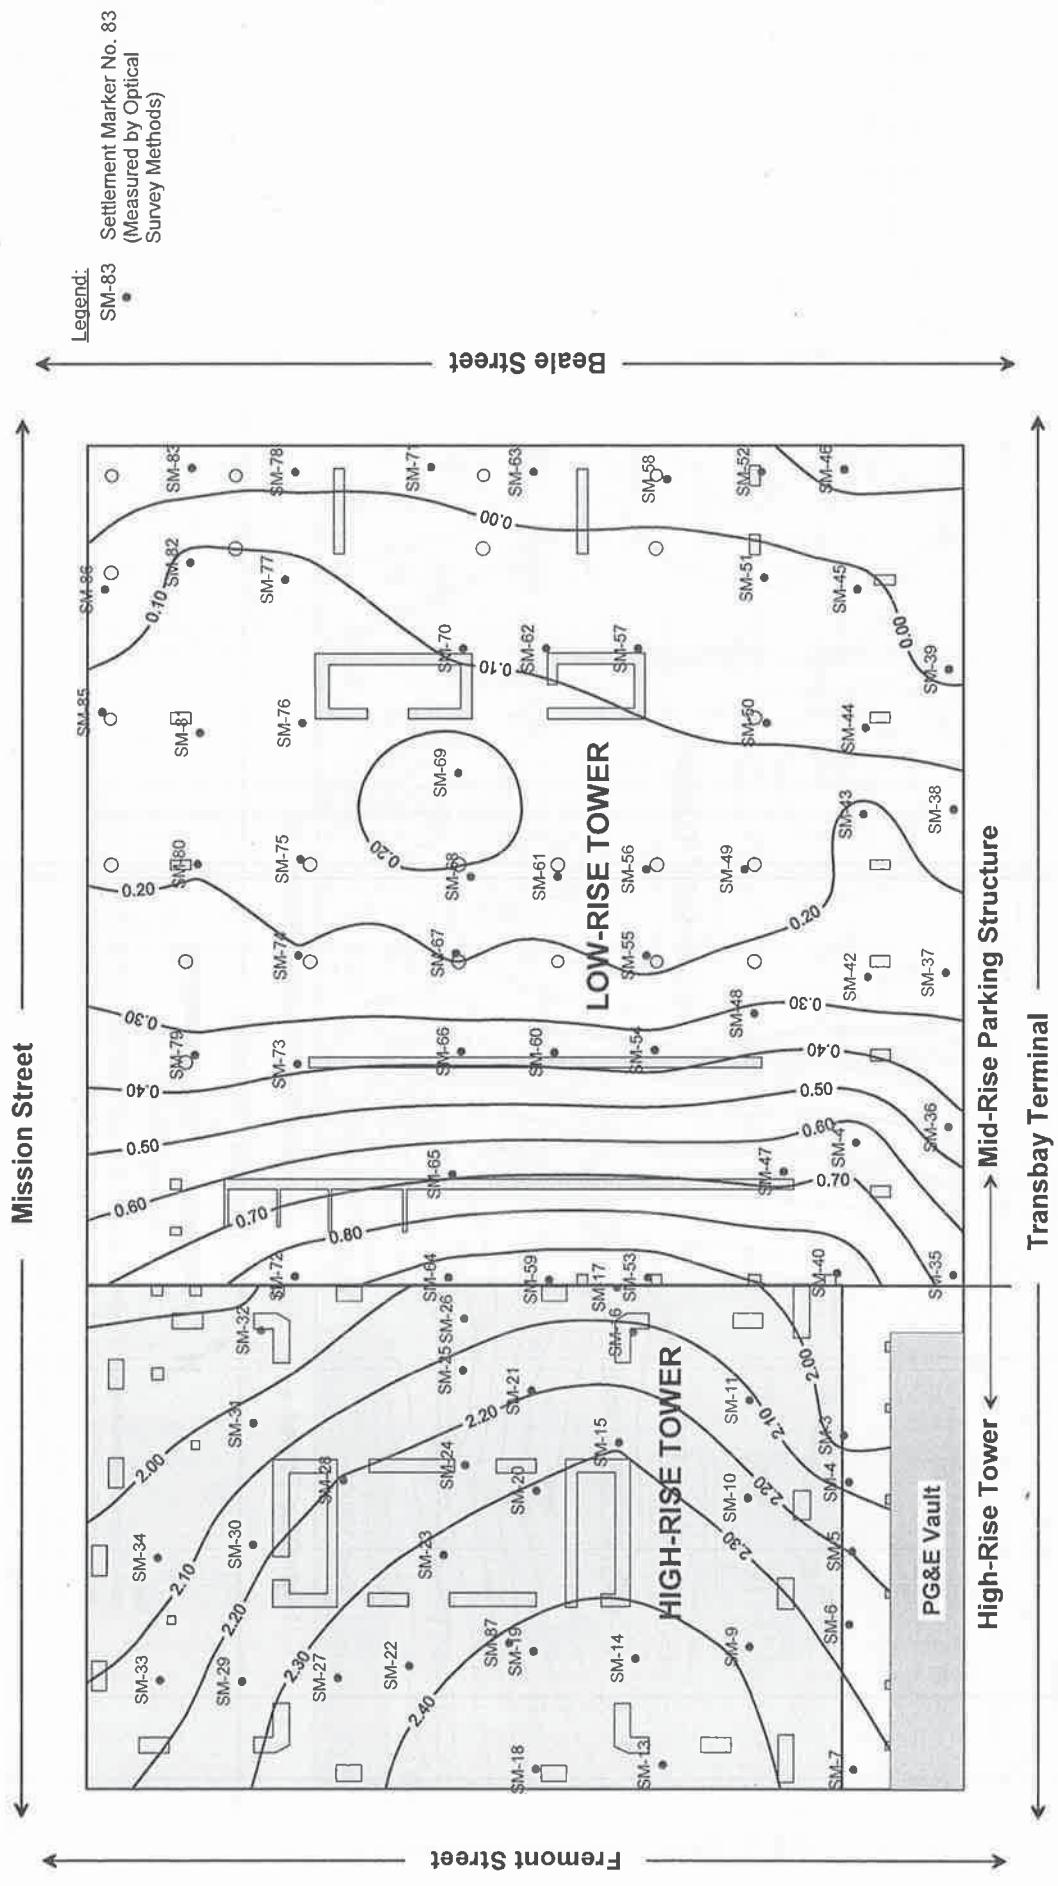

**CONTOURS OF SETTLEMENTS MEASURED AT THE
FIRST LEVEL BASEMENT OF THE 301 MISSION STREET
STRUCTURE BETWEEN APRIL 30, 2009 AND APRIL 30, 2012**

Transbay Transit Center
301 Mission Monitoring
Transbay Joint Powers Authority
San Francisco, California

ARUP

Sant'Antonino, Gramona:

Zona 2012

PLATE 3

Notes:
Contours represent elevation change, in inches, between Baseline survey (April 30, 2009) and readings taken on April 18, 2012.
Level B-1 at Mid-Rise Parking portion of survey site is approximately 4 inches higher than Level B-1 at High-Rise Tower portion.

Notes:
Contour
Level B

The PG&E vault is inaccessible for monitoring.
Negative values of settlement (within Low-rise Tc)

Approximate Scale: 1" = 25'
J:\Internal Project Data\Reports & Narratives\301 Mission - Apr 2012 Survey\Plates\Elevation changes All [2012.04.18].sld

ARUP

April 2012

Transbay Transit Center
301 Mission Monitoring
Transbay Joint Powers Authority
San Francisco, California



SETTLEMENT OVER TIME
FLOOR ELEVATIONS AT LEVEL B-1
OF 301 MISSION PROPERTY - TOWER:
APRIL 30, 2009 THROUGH APRIL 18, 2012

Transbay Transit Center

301 Mission Monitoring

Transbay Joint Powers Authority

San Francisco, California

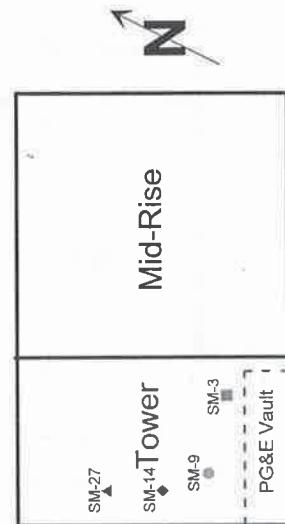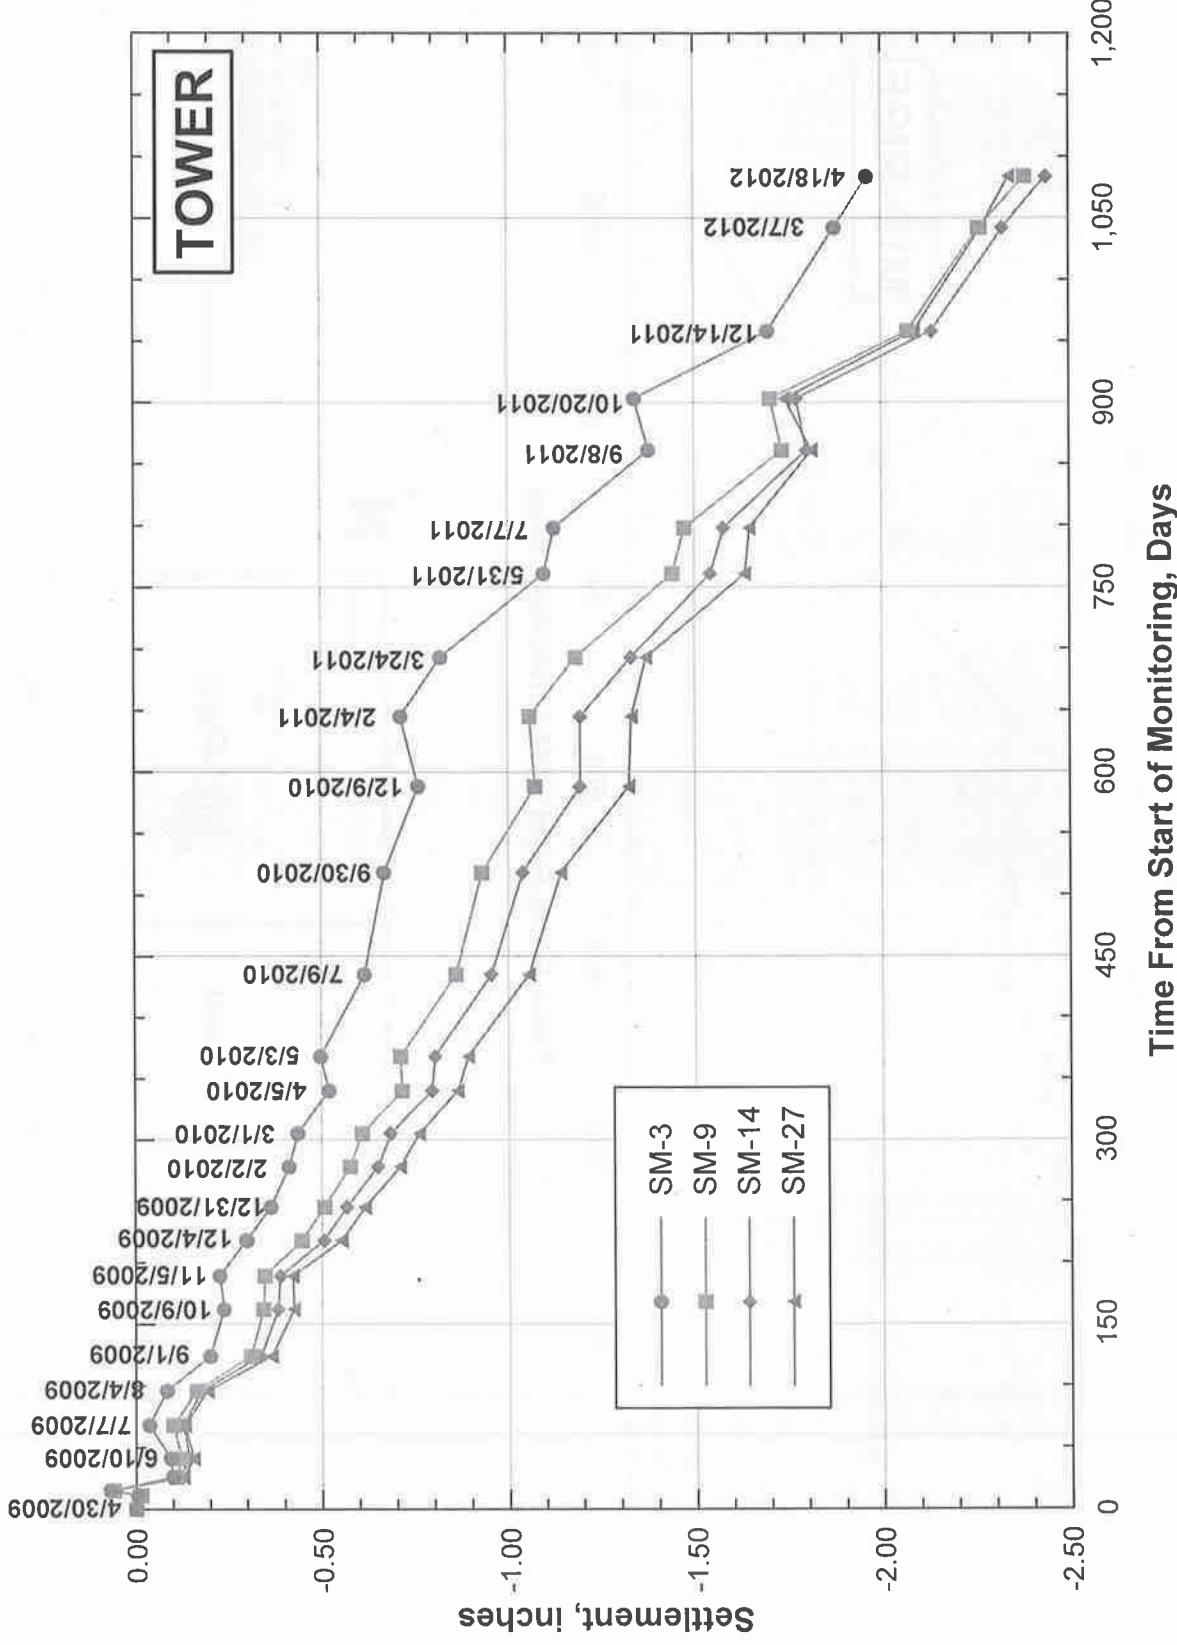

ARUP

SETTLEMENT OVER TIME
FLOOR ELEVATIONS AT LEVEL B-1
OF 301 MISSION PROPERTY - MID-RISE:
APRIL 30, 2009 THROUGH APRIL 18, 2012

Transbay Transit Center

301 Mission Monitoring

Transbay Joint Powers Authority



San Francisco, California


April 2012

Note:
Initial (Baseline) reading
taken on 04/30/09

JSS-FY1320090113224204 Internal Project Data\4-5 Reports & Narratives\165301 Mission - Apr 2012 Survey\Plates\Plate 5 Settlement Over Time - Midrise.grf

Time From Start of Monitoring, Days

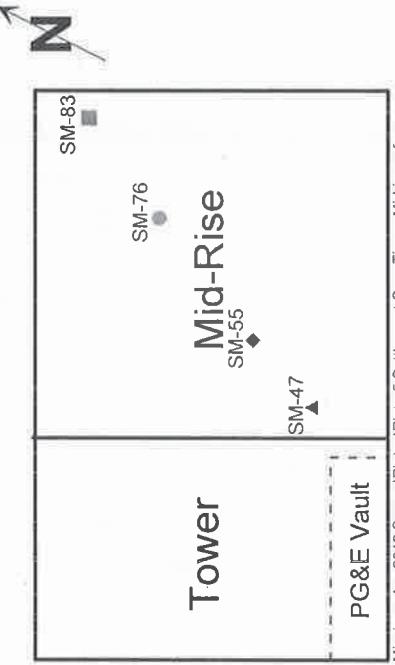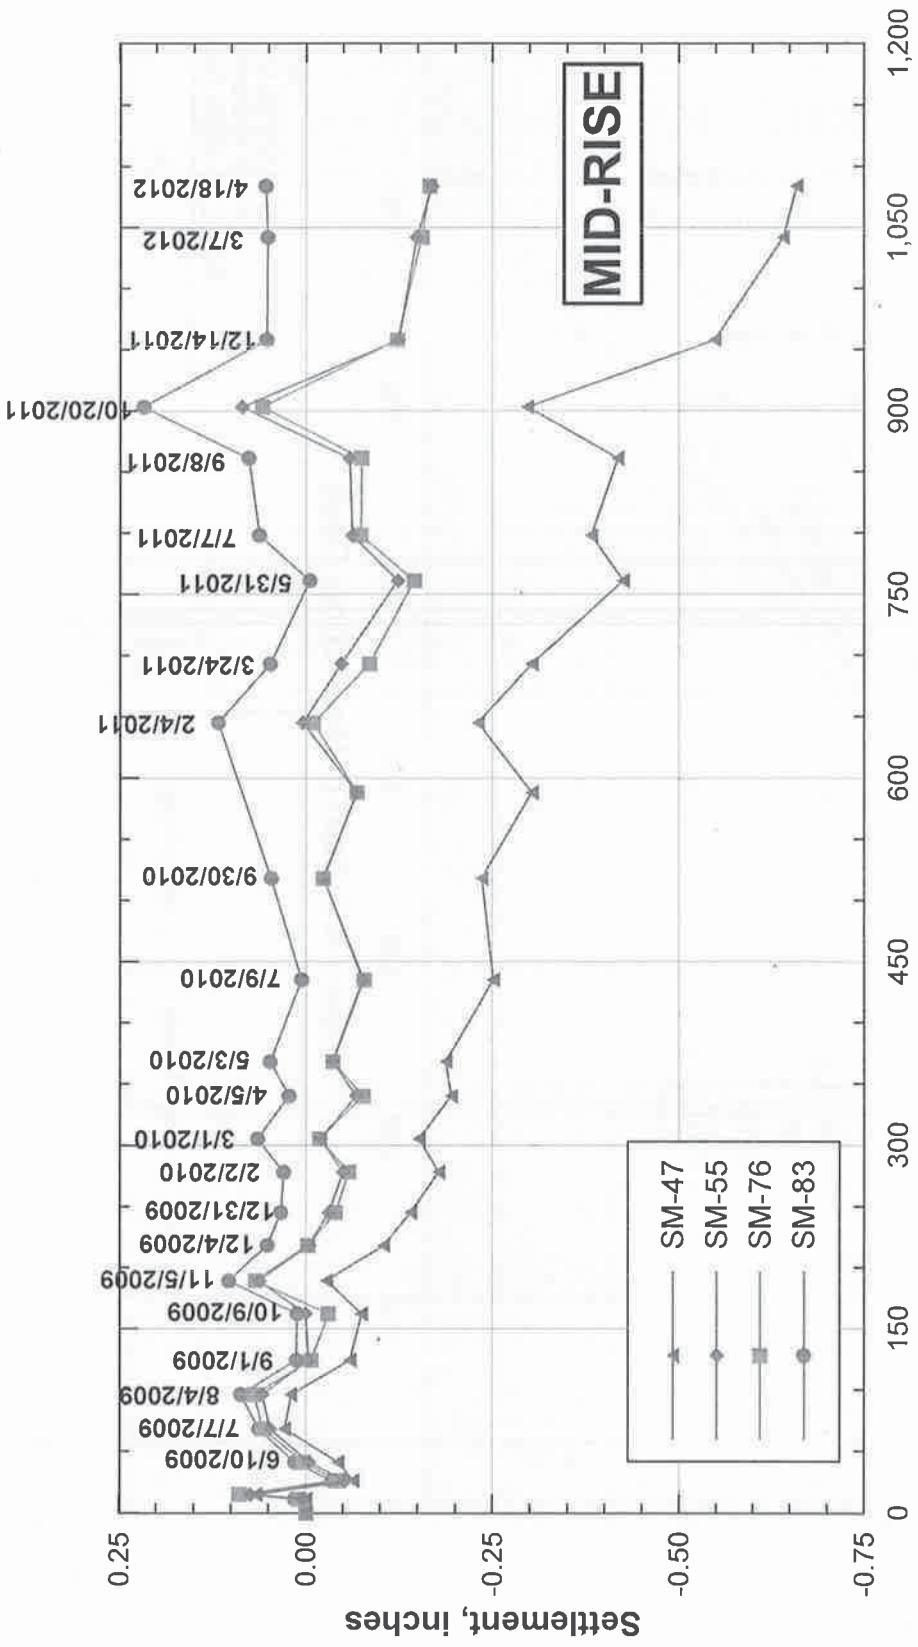

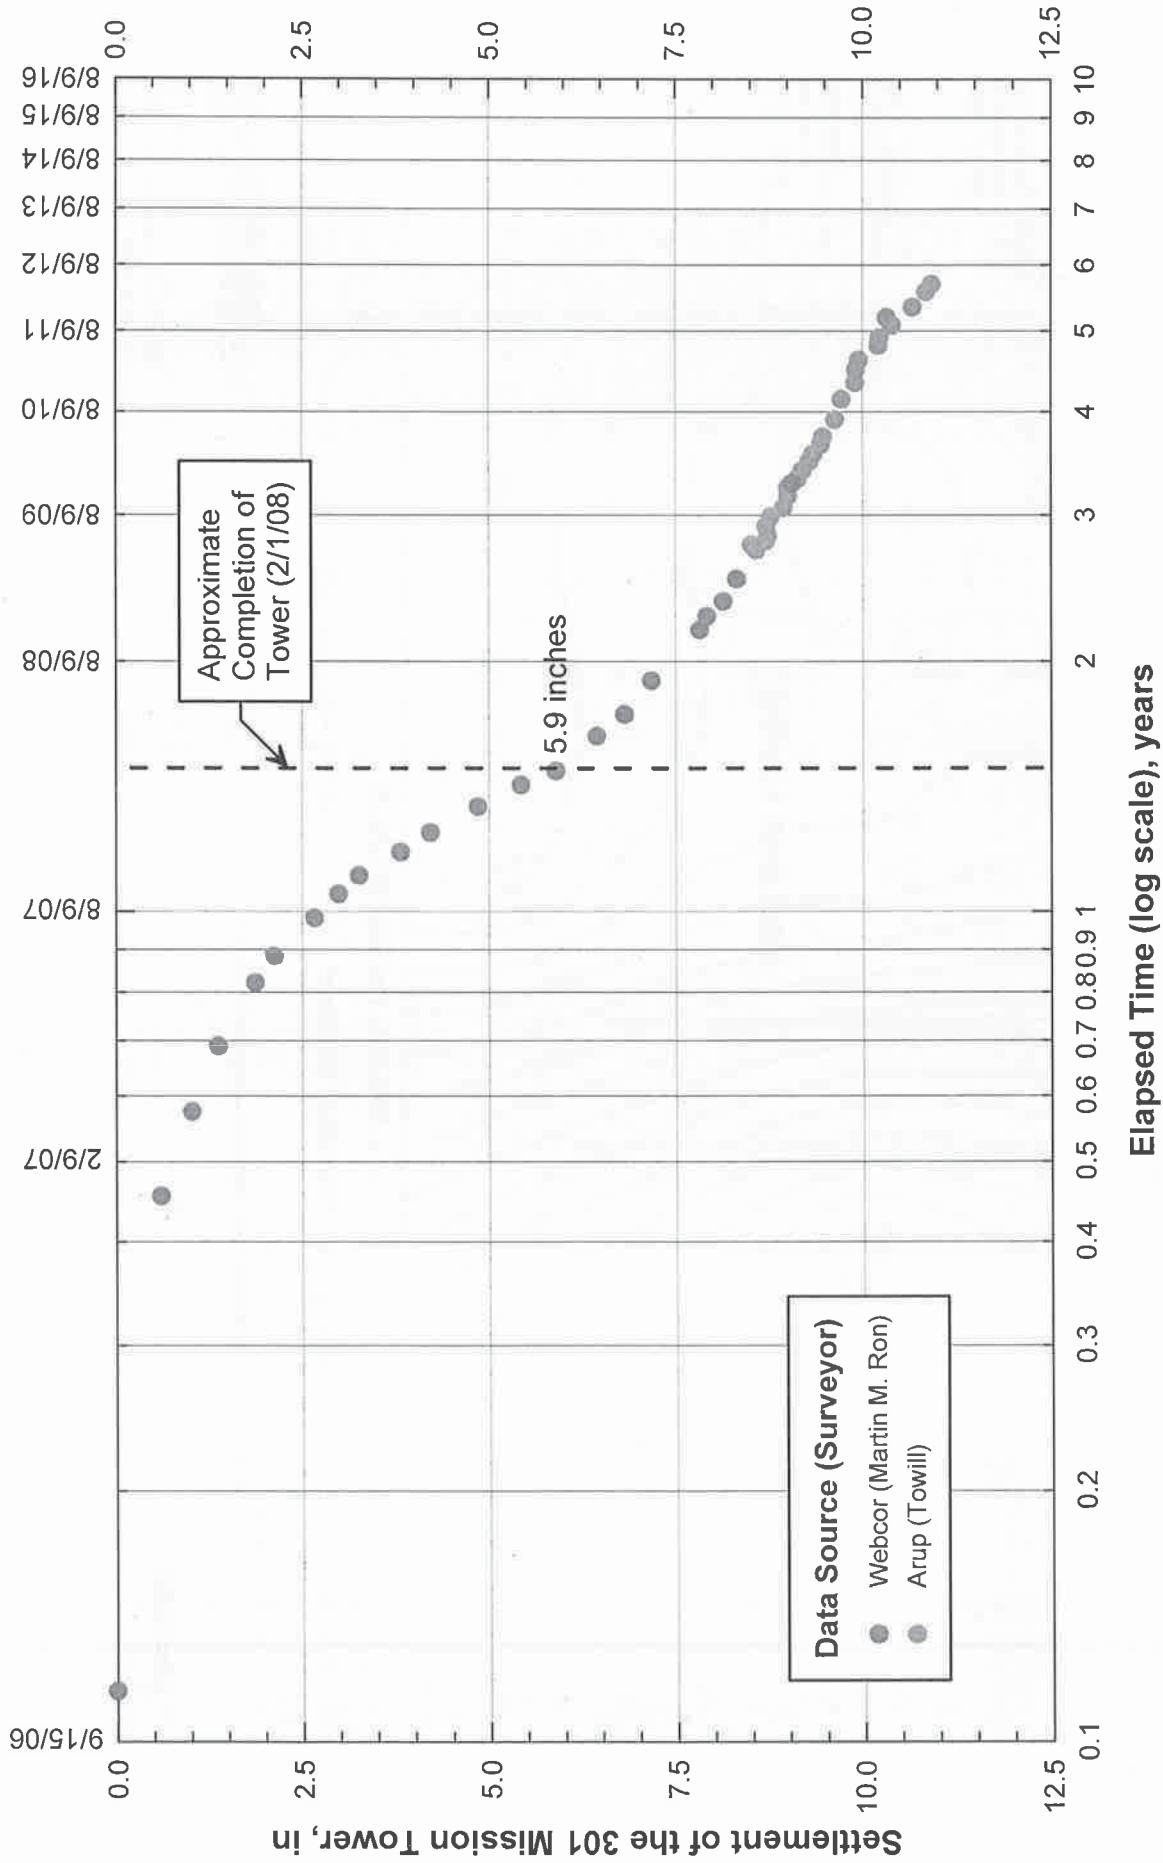


**SETTLEMENTS OF THE 301 MISSION TOWER
INCLUDING MONITORING DURING CONSTRUCTION**

Transbay Transit Center
301 Mission Monitoring
Transbay Joint Powers Authority
San Francisco, California

April 2012

Beginning of Tower Construction: 8/9/06
End of Tower Construction: 2/1/08
Construction Duration: 542 days (1.5 years)

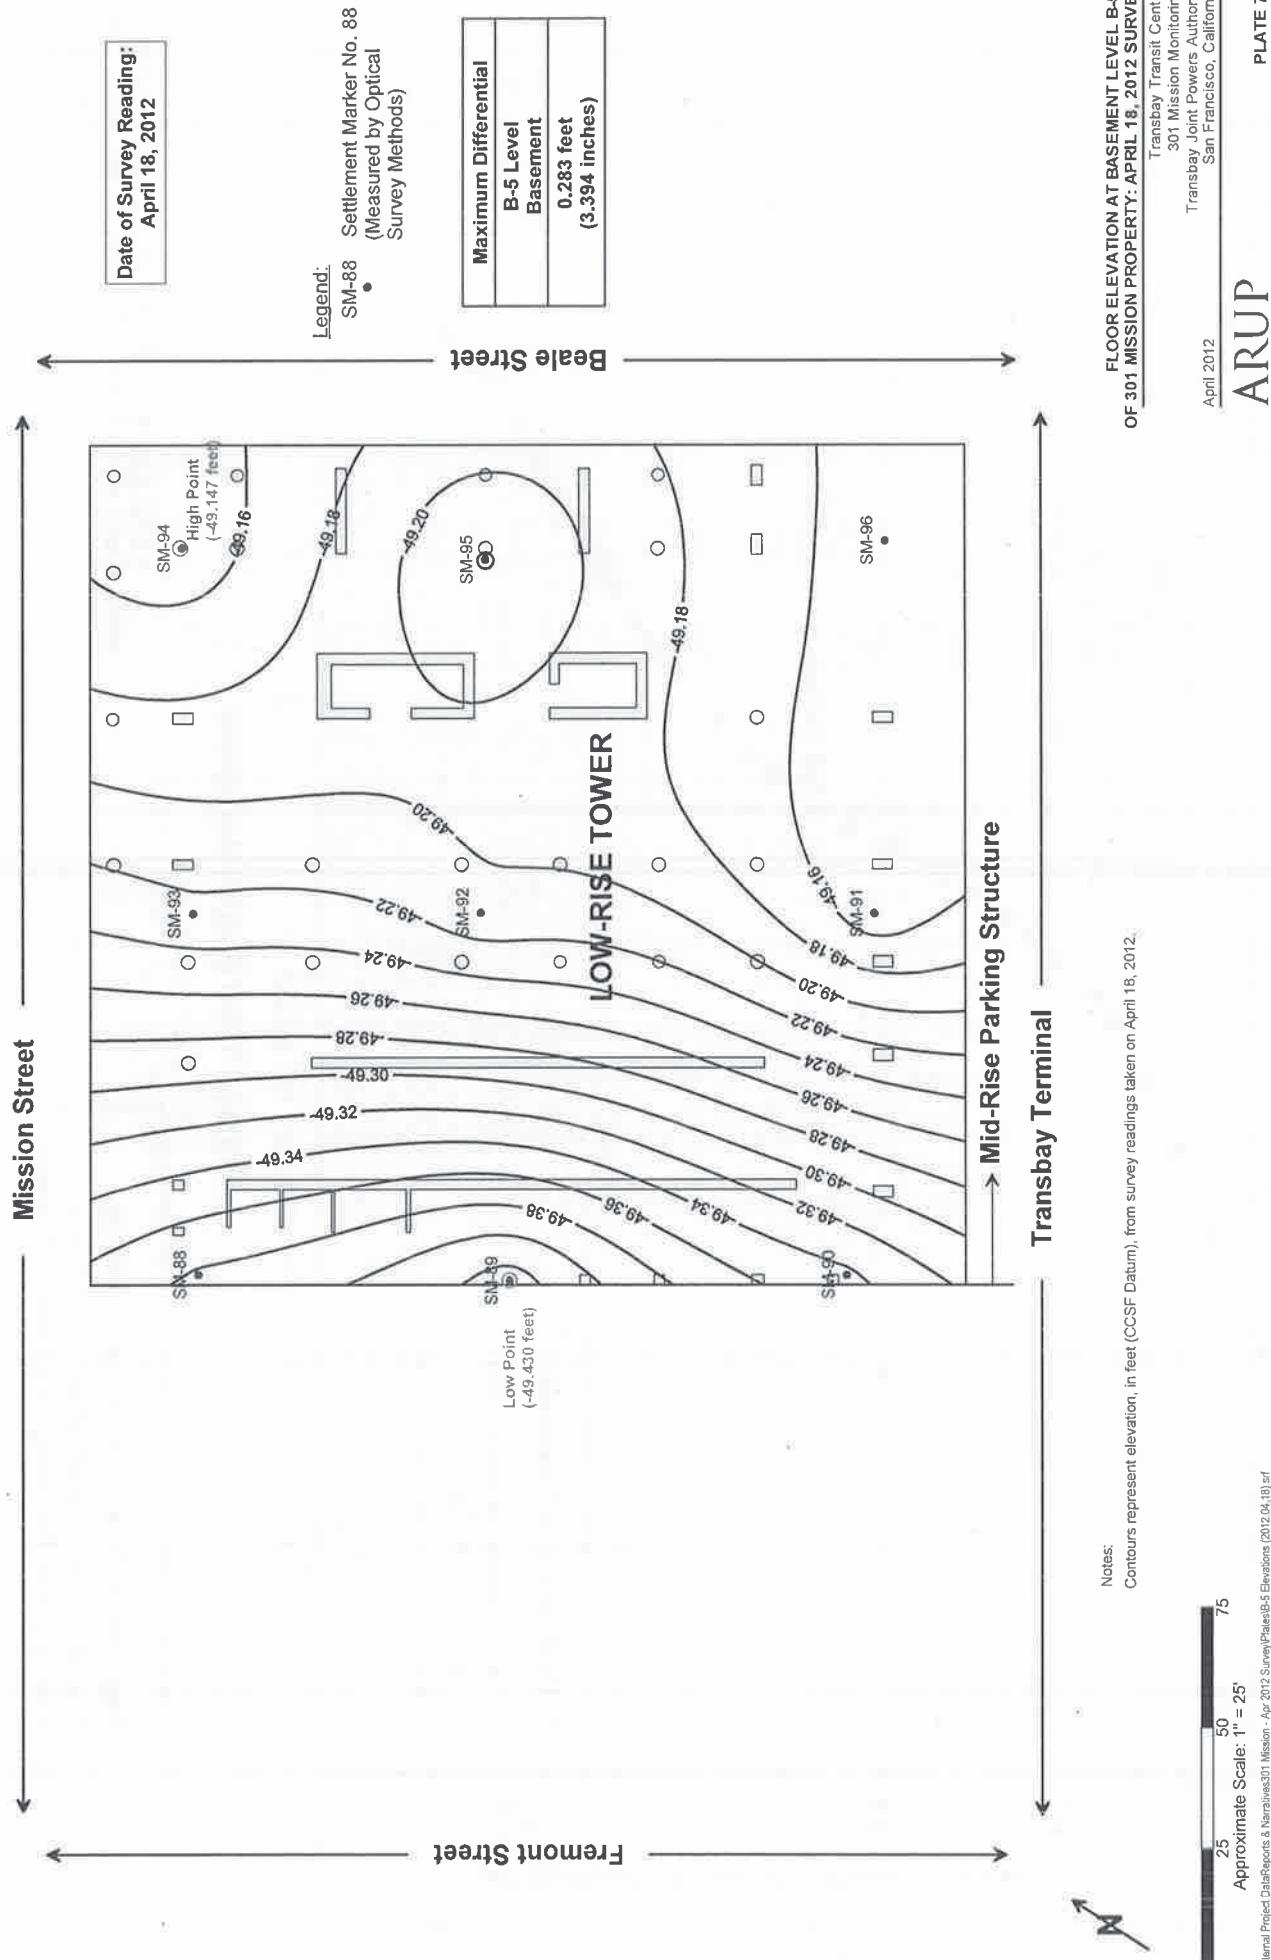

Mission Street

Beale Street

Mission Street

Transbay Terminal

Fremont Street

LOW-RISE TOWER

Mid-Rise Parking Structure

High Point (0.000 inches)

Low Point (-3.394 inches)

SM-94

SM-95

SM-96

SM-93

SM-92

SM-91

SM-90

SM-89

-0.25

-0.50

-0.75

-1.00

-1.25

-1.50

-1.75


-2.00

-2.25

-2.50

-2.75

-3.00

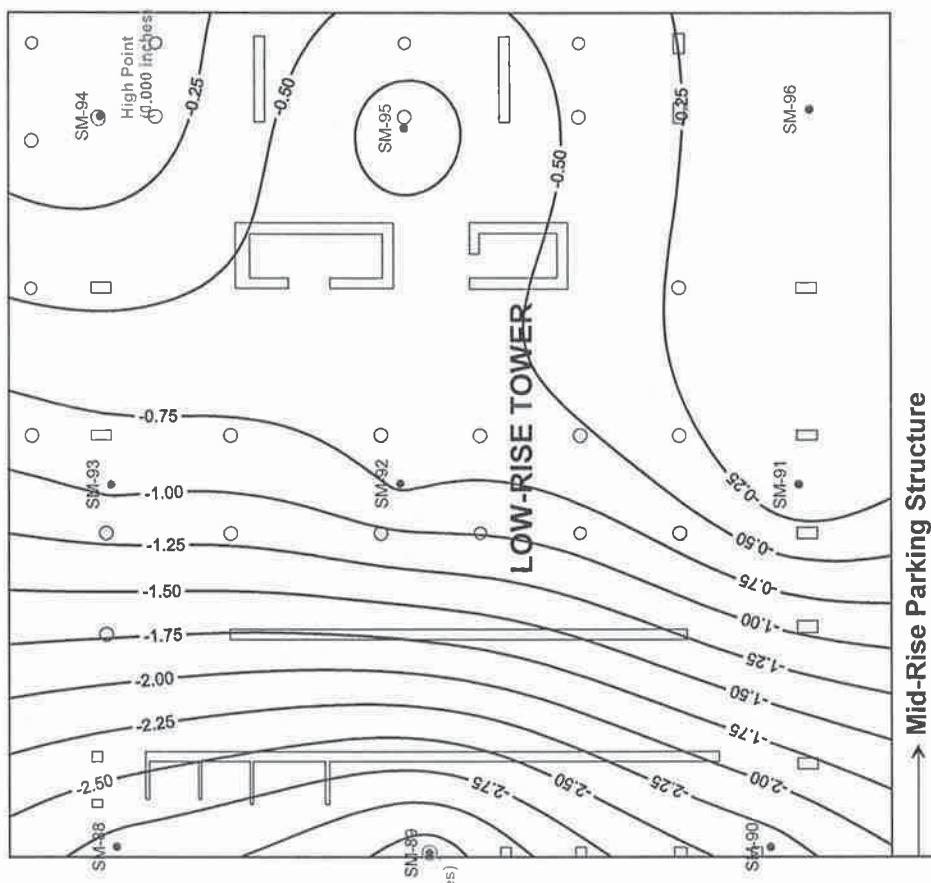

Notes:
Contours represent elevation, in feet (CCSF Datum), from survey readings taken on April 18, 2012.

**DIFFERENTIAL FLOOR ELEVATIONS (INCHES)
AT BASEMENT LEVEL B-5: APRIL 15, 2012 SURVEY**

Transbay Transit Center
301 Mission Monitors
Transbay Joint Powers Authority
San Francisco, California.

April 2012

1 Internal Project Data Resource - Narrative-2013 Mission - Ann 2012 Survey Plate #B-5 Differential Elevations (2012-04-16) sf

PLATE 8

From: Brian Dykes <bdykes@transbaycenter.org>
Sent: Wednesday, July 11, 2012 5:26 PM
To: Steven Hood
Cc: Stephen McLandrich; Robert Beck; Ed Sum; Nila Gonzales
Attachments: 2012-07-06 Memo_301 Mission Settlement - Jun 2012 Survey.pdf

Steve,

I have attached a July 6th memo from Arup which provides the latest set of settlement marker readings recorded in the basements at 301 Mission Street.

The settlement under the tower as shown on plate 4 which has been measured by our surveyors over the last 3 years has added 2.5 inches.

The total settlement as shown on plate 6 is now 11 inches, which includes 8.5 inches measured by your surveyor before we started recording in April 2009.

Brian.

Brian Dykes
Principal Engineer
Transbay Joint Powers Authority
201 Mission Street, Suite 2100
San Francisco, CA 94105
415 597 4617 phone
415 597 4615 fax

Check out our progress at <http://transbaycenter.org/construction-updates/construction-cameras>

NOTE: This e-mail communication and any attachments hereto are covered by the Electronic Communications Privacy Act, 18 U.S.C. Sections 2510-2521, and are legally privileged. The information contained herein is confidential, and is intended only for the use of the individual or entity to whom it is addressed. If you are not the intended recipient of this e-mail communication (or an employee or agent responsible for delivering this communication to its intended recipient(s)), you are hereby notified that any retention, copying or further distribution of this e-mail communication and any attachments is strictly prohibited. If you are not the intended recipient, please notify the sender by telephoning 415-597-4620, or by forwarding an e-mail reply message addressed to TransAdmin@TransbayCenter.org confirming that you have already destroyed (deleted) the original e-mail communication and any and all copies thereof. Thank you.

Memorandum

ARUP


To	Brian Dykes (TJPA)	Date
		6 July 2012
Copies	Robert Beck (TJPA) Emilio Cruz (PMPC) Randy Volenec (PCPA) George Metzger (AAI)	Reference number 132242-60/SMM
From	Stephen McLandrich (Arup) Nick O'Riordan (Arup) Kevin Clinch (Arup)	File reference 4-05 174
Subject	Transbay Transit Center: Results of June 2012 Settlement Survey at 301 Mission Property	Page 1 of 1

Under Arup's Geotechnical Contract with the Transbay Joint Powers Authority through Pelli Clark Pelli Architects, Arup is required to monitor the settlements of the buildings adjacent to the Transbay Transit Center prior to and during construction. We began the monitoring program for the 301 Mission property in April of 2009. This memorandum and the attached plates present an update to our memorandum dated April 27, 2011 with measurements made through June 2012.

Note Typo: should refer to "April 27, 2012" report

List of Plates

- Plate 1 Floor Elevations at Level B-1 of 301 Mission Property: Periodic Survey – June 13, 2012
- Plate 2 Differential Floor Elevation (Inches) – June 13, 2012 Survey
- Plate 3 Contours of Settlements Measured at the First Level Basement of the 301 Mission Street Structure Between April 30, 2009 and June 13, 2012
- Plate 4 Settlement Over Time Floor Elevations at Level B-1 of 301 Mission Property – Tower: April 30, 2009 through June 13, 2012.
- Plate 5 Settlement Over Time Floor Elevations at Level B-1 of 301 Mission Property – Mid-Rise: April 30, 2009 through June 13, 2012
- Plate 6 Settlements of the 301 Mission Tower Including Monitoring During Construction
- Plate 7 Floor Elevation at Basement Level B-5 of 301 Mission Property: June 13, 2012 Survey
- Plate 8 Differential Floor Elevations (Inches) at Basement Level B-5: June 13, 2012 Survey

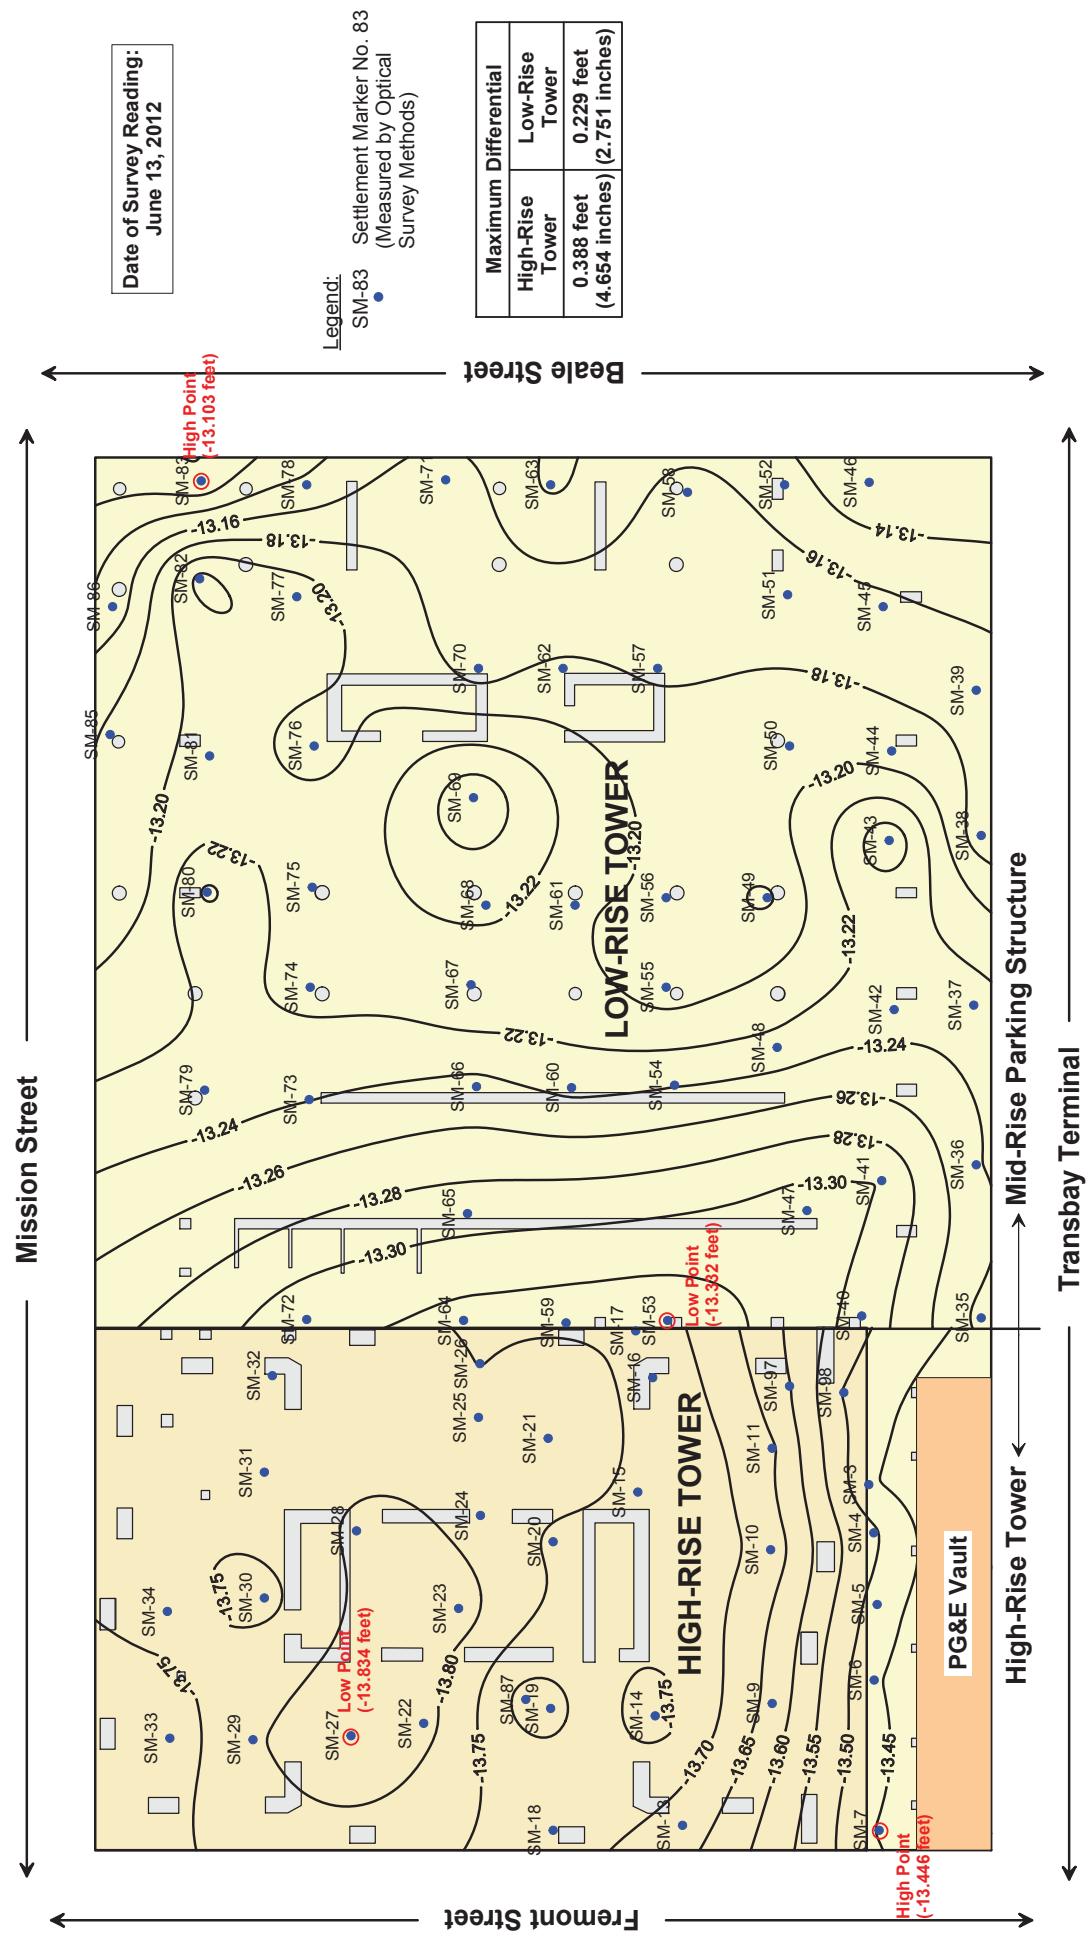

**FLOOR ELEVATIONS AT LEVEL B-1
OF 301 MISSION PROPERTY
PERIODIC SURVEY - JUNE 13, 2012**


Transbay Transit Center
301 Mission Monitoring
Transbay Joint Powers Authority
San Francisco, California


July 2012

ARUP

PLATE 1

Internal Project Data/Reports & Narratives\301 Mission\ - July 2012 Survey\SurveyElevations\All\20120613.srf

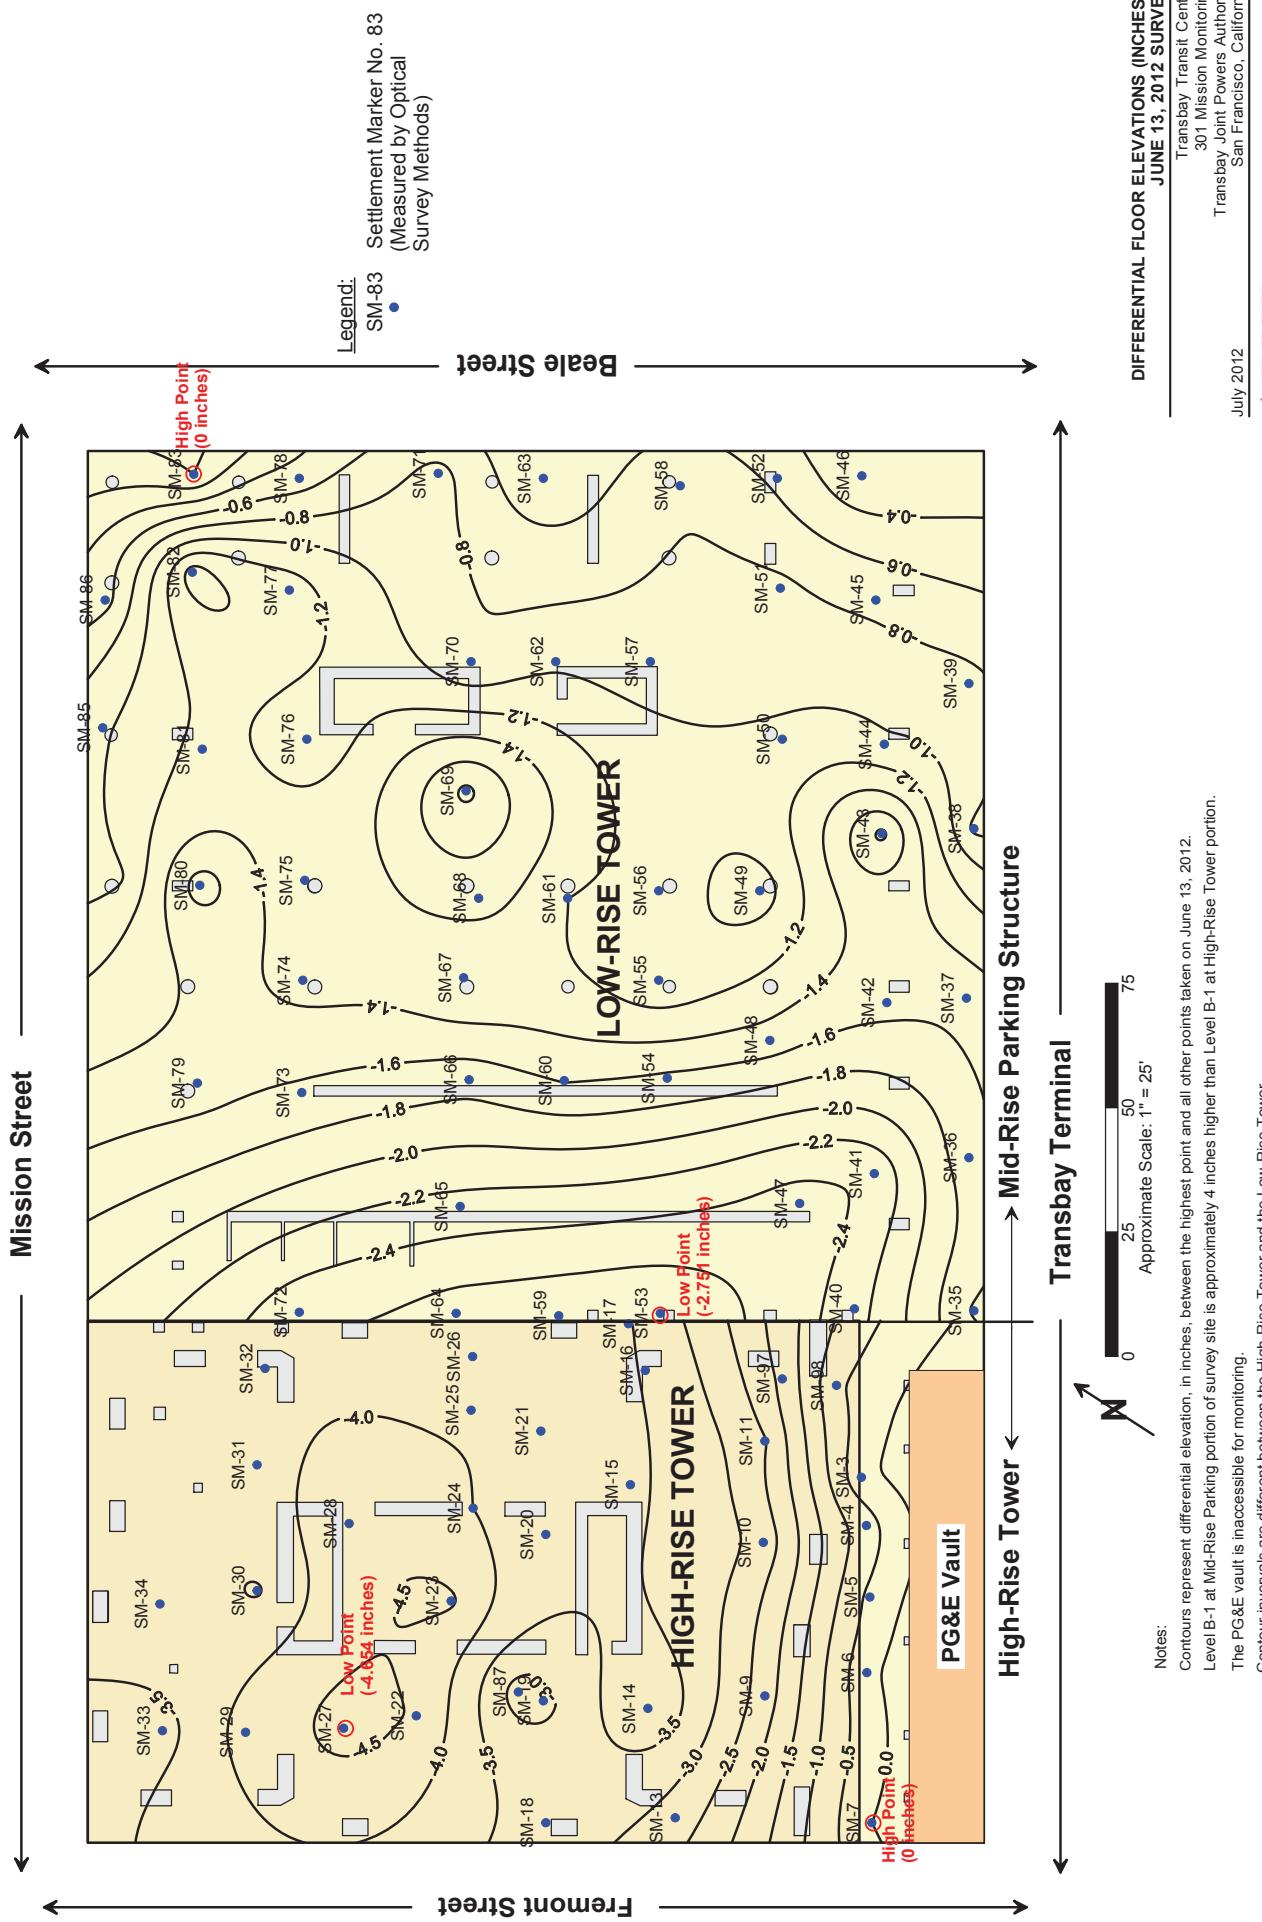

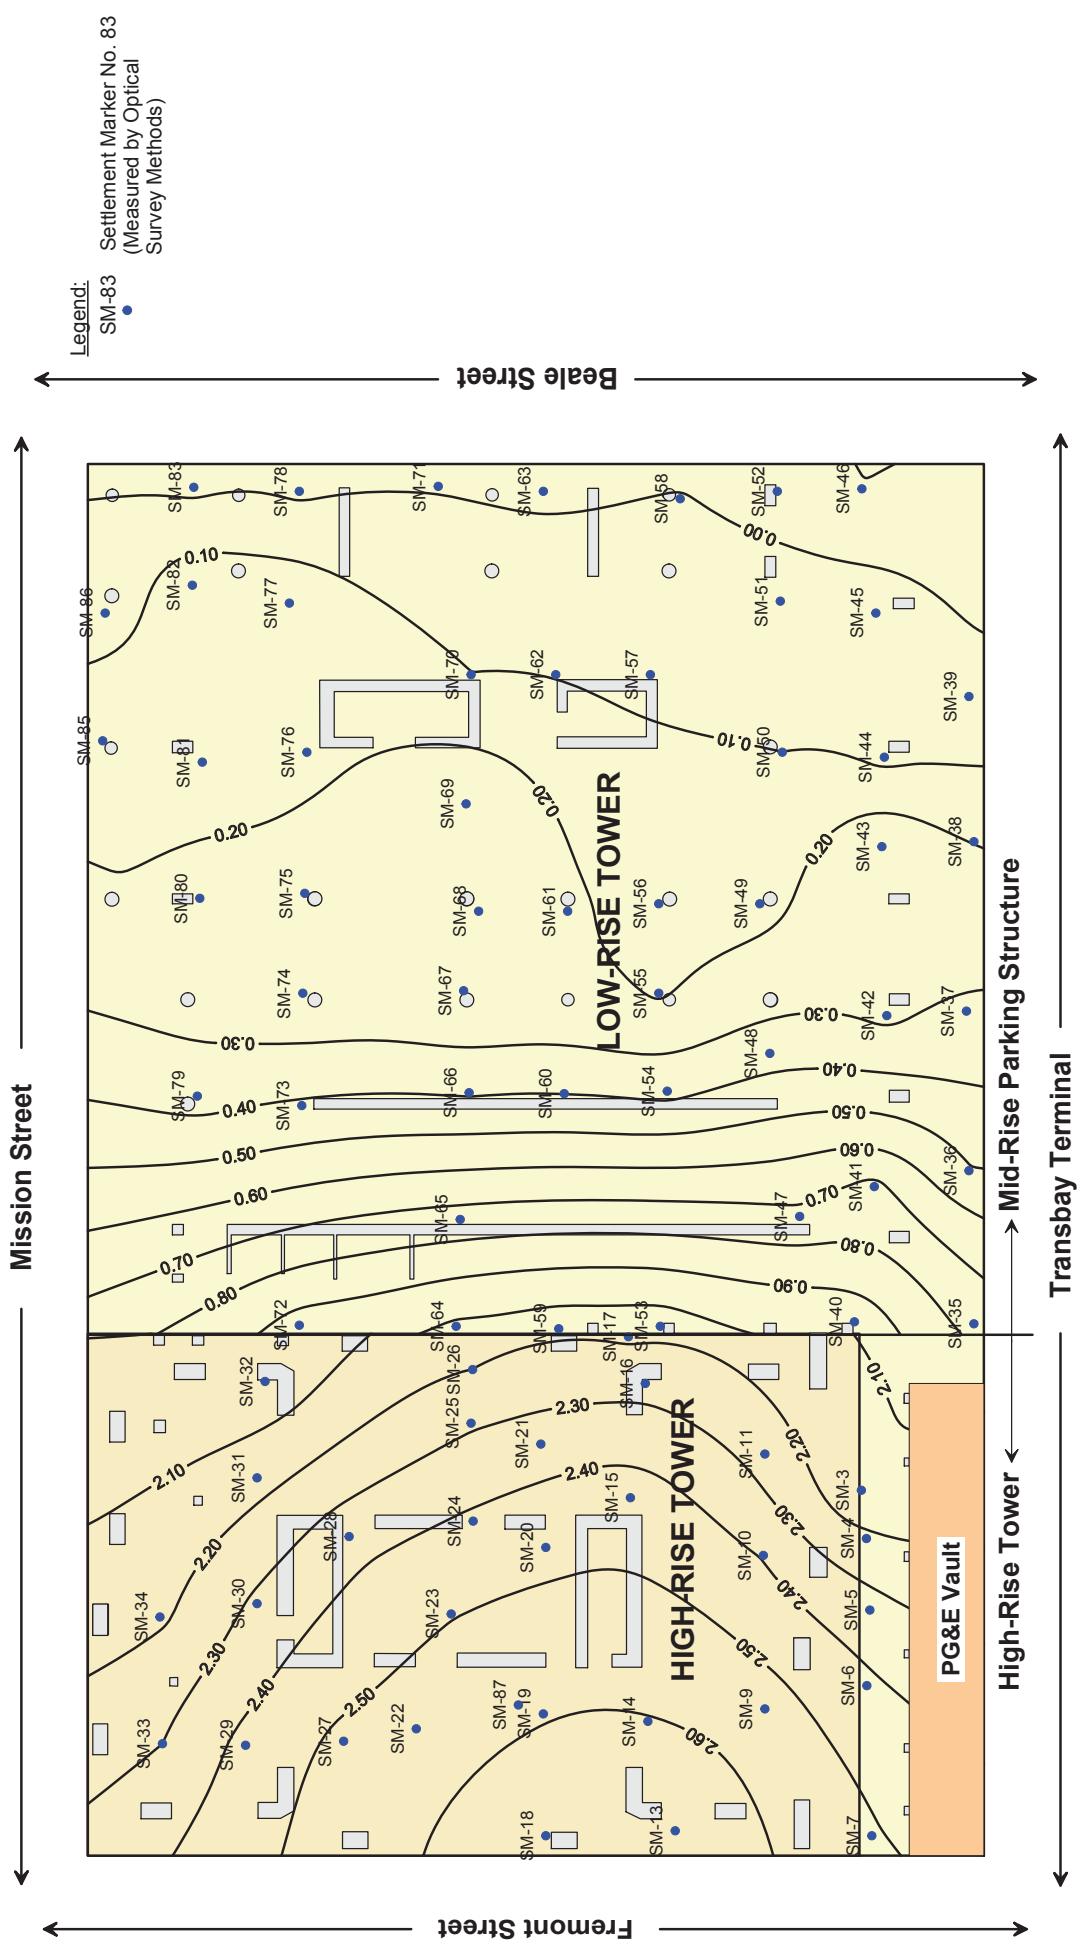

CONTENTS OF SETTLEMENTS MEASURED AT THE FIRST LEVEL BASEMENT OF THE 301 MISSION STREET STRUCTURE BETWEEN APRIL 30, 2009 AND JUN

Transbay Transit Concourse
301 Mission Monitoring
Transbay Joint Powers Authority
San Francisco, California

PLATE 3

Notes:
Contours represent elevation change, in inches, between Baseline survey (April 30, 2009) and readings taken on June 13, 2012.
Level B-1 at Mid-Rise Parking portion of survey site is approximately 4 inches higher than Level B-1 at High-Rise Tower portion.

The PG&E vault is inaccessible for monitoring.
Negative values of settlement (within Low-rise Tower) indicate uplift.

Internal Project Data Reports & Narratives 301 Mission • Jun 2012 Survey/Elevation changes All (2012.06.13).sf

Approximate Scale: 1" = 25'

25

50

75

0

ARUP


Note:
Initial (Baseline) reading
taken on 04/30/09



J.S.F.1322424 Internal Project Data\4-05 Reports & Narratives\174 301 Mission - Jun 2012 Survey\Plates\Plate 4 Settlement Over Time - Tower.gft

**SETTLEMENT OVER TIME
FLOOR ELEVATIONS AT LEVEL B-1
OF 301 MISSION PROPERTY- TOWER:
APRIL 30, 2009 THROUGH JUNE 13, 2012**



Transbay Transit Center
301 Mission Monitoring
Transbay Joint Powers Authority
San Francisco, California

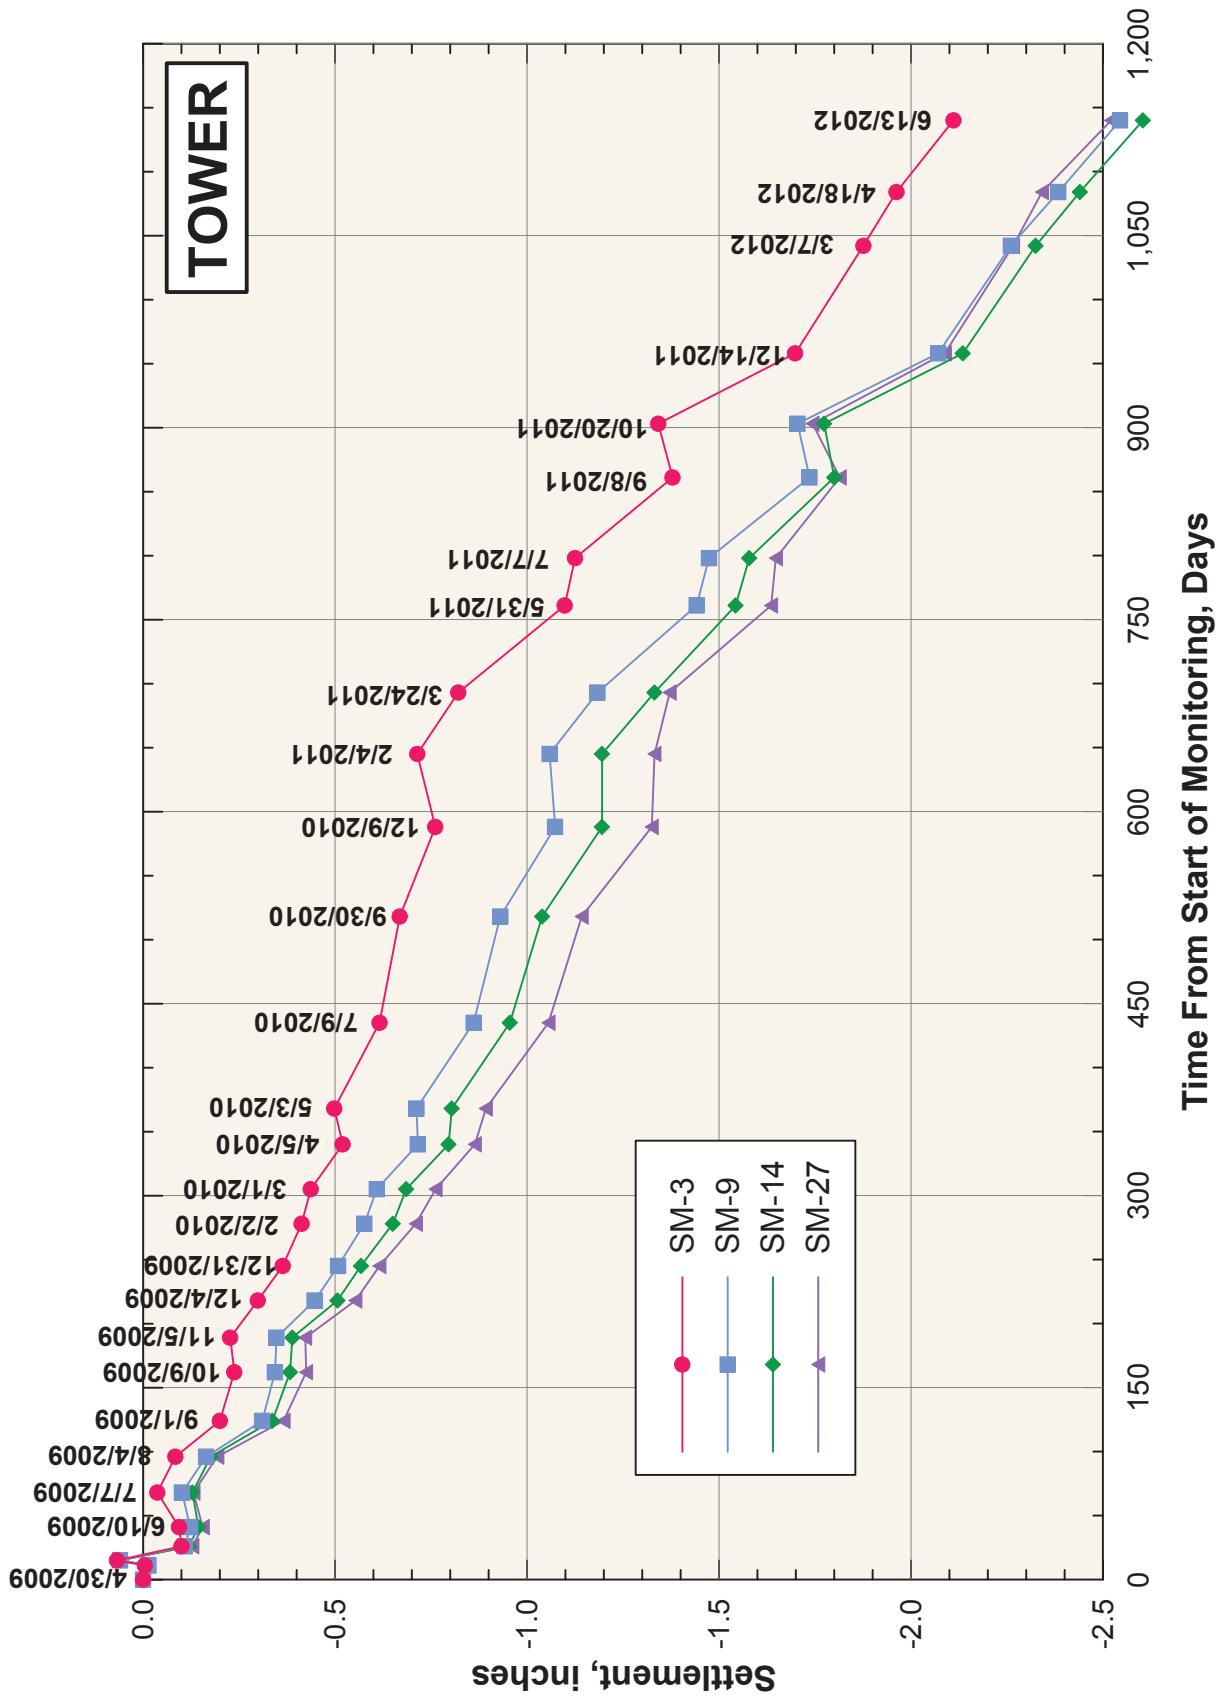

ARUP

Note:
Initial (Baseline) reading
taken on 04/30/09


J:\S\F\1322000\1322424 Internal Project Data\4-05 Reports & Narratives\174 301 Mission - Jun 2012 Survey\Plates\Plate 5 Settlement Over Time - Midrise.grf

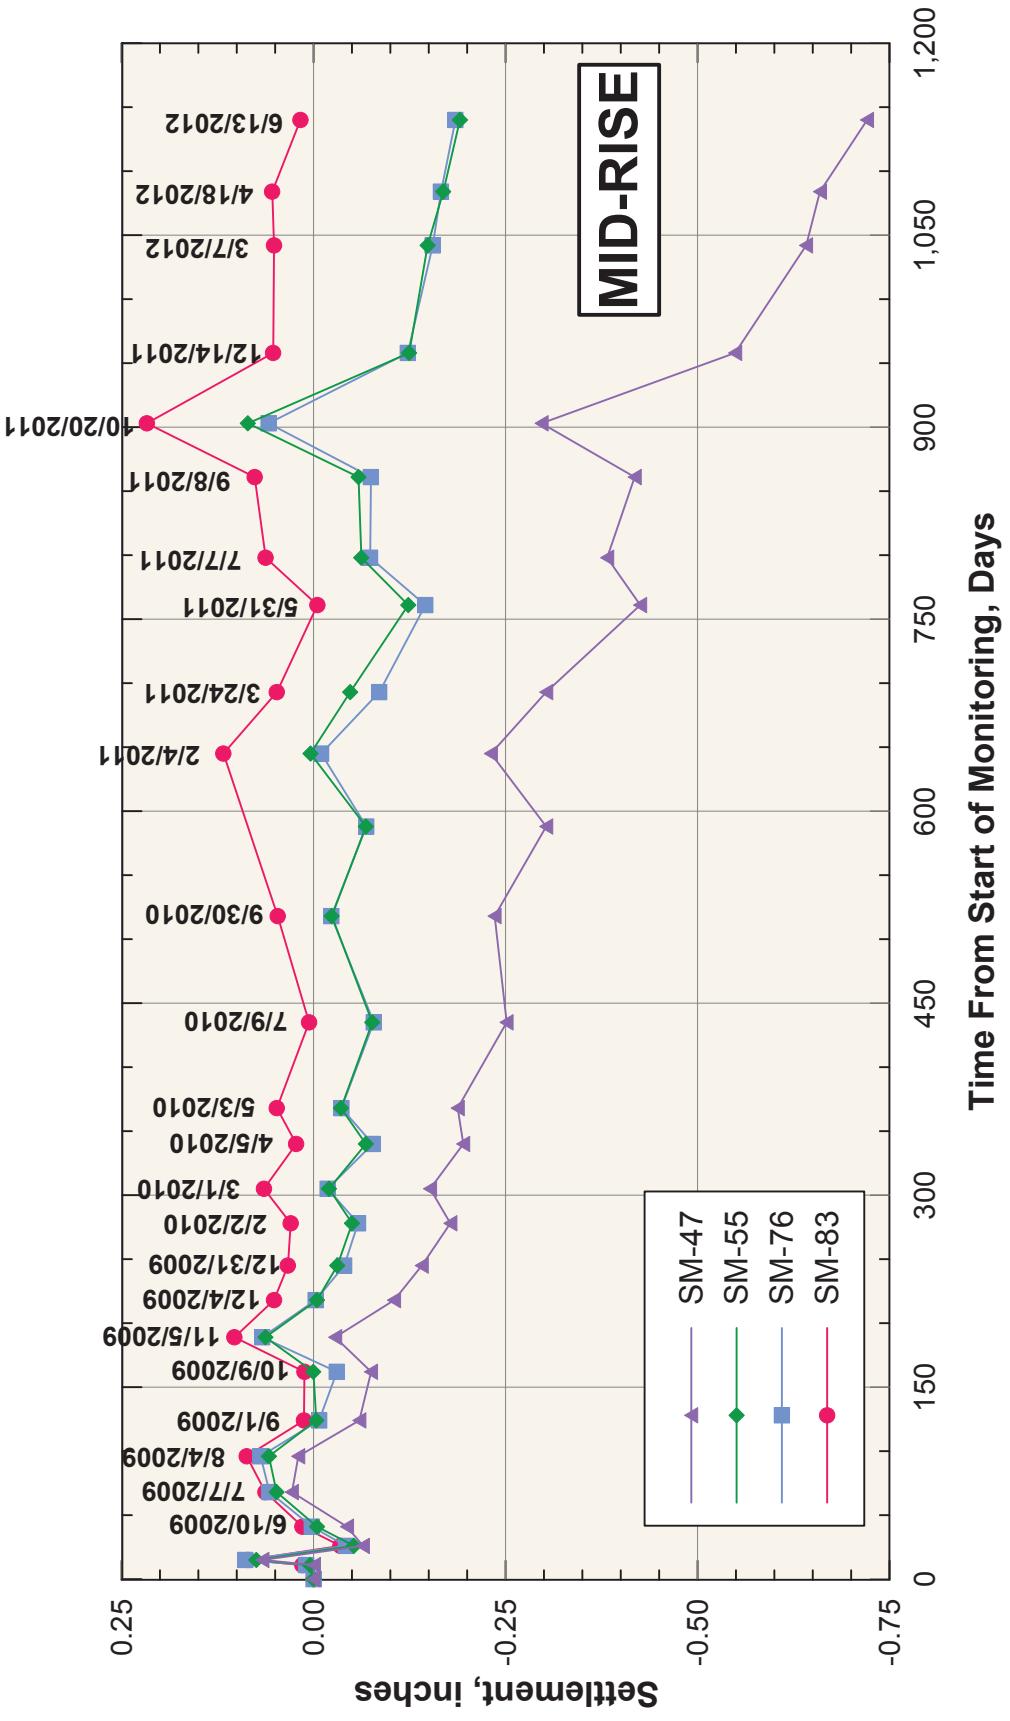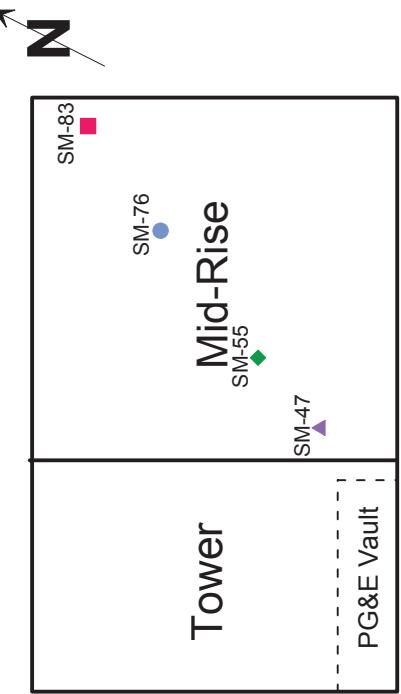

SETTLEMENT OVER TIME
FLOOR ELEVATIONS AT LEVEL B-1
OF 301 MISSION PROPERTY - MID-RISE:
APRIL 30, 2009 THROUGH JUNE 13, 2012

Transbay Transit Center
301 Mission Monitoring
Transbay Joint Powers Authority
San Francisco, California

July 2012

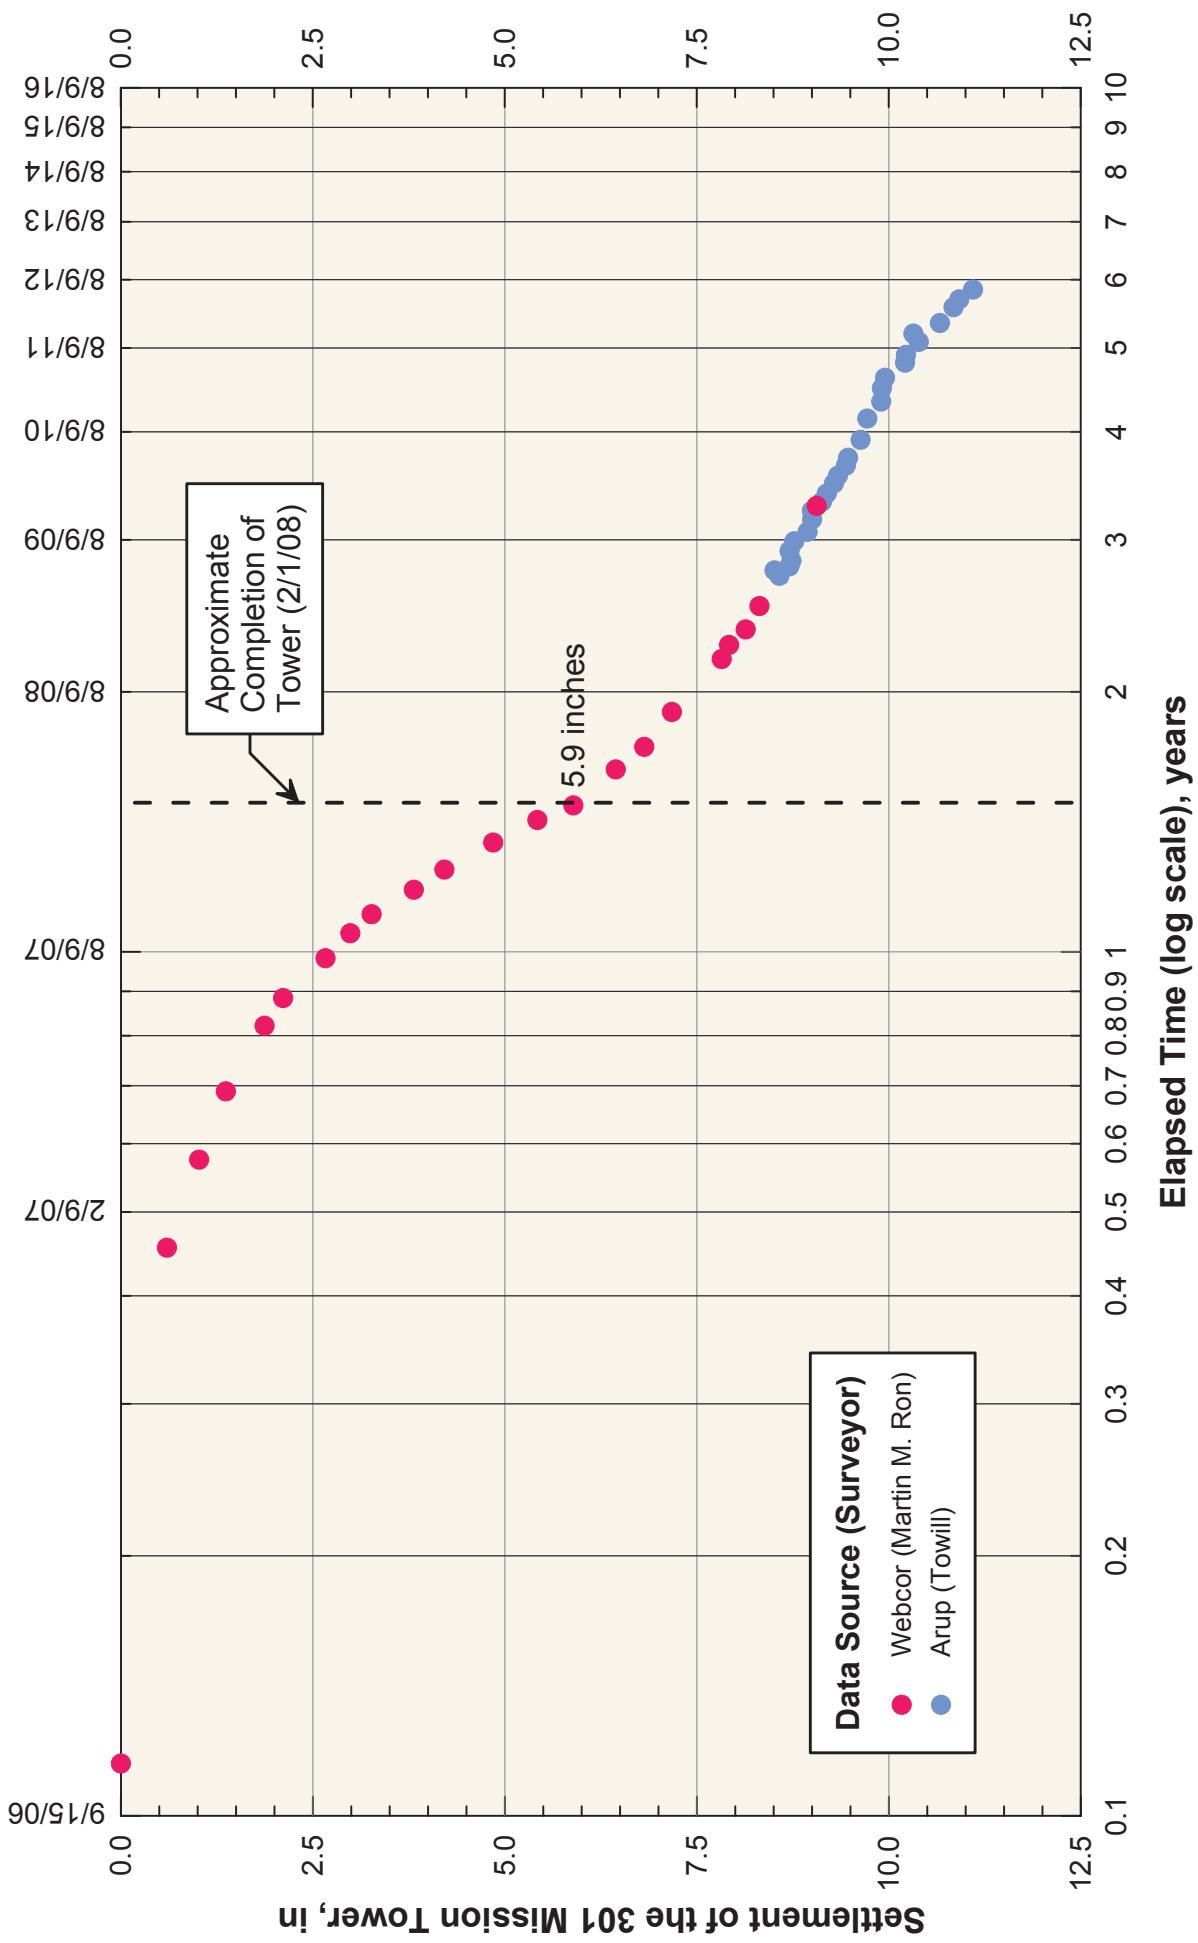


SETTLEMENTS OF THE 301 MISSION TOWER INCLUDING MONITORING DURING CONSTRUCTION

Transbay Transit Center
301 Mission Monitoring
Transbay Joint Powers Authority
San Francisco, California

July 2012

Beginning of Tower Construction: 8/9/06
End of Tower Construction: 2/1/08
Construction Duration: 542 days (1.5 years)

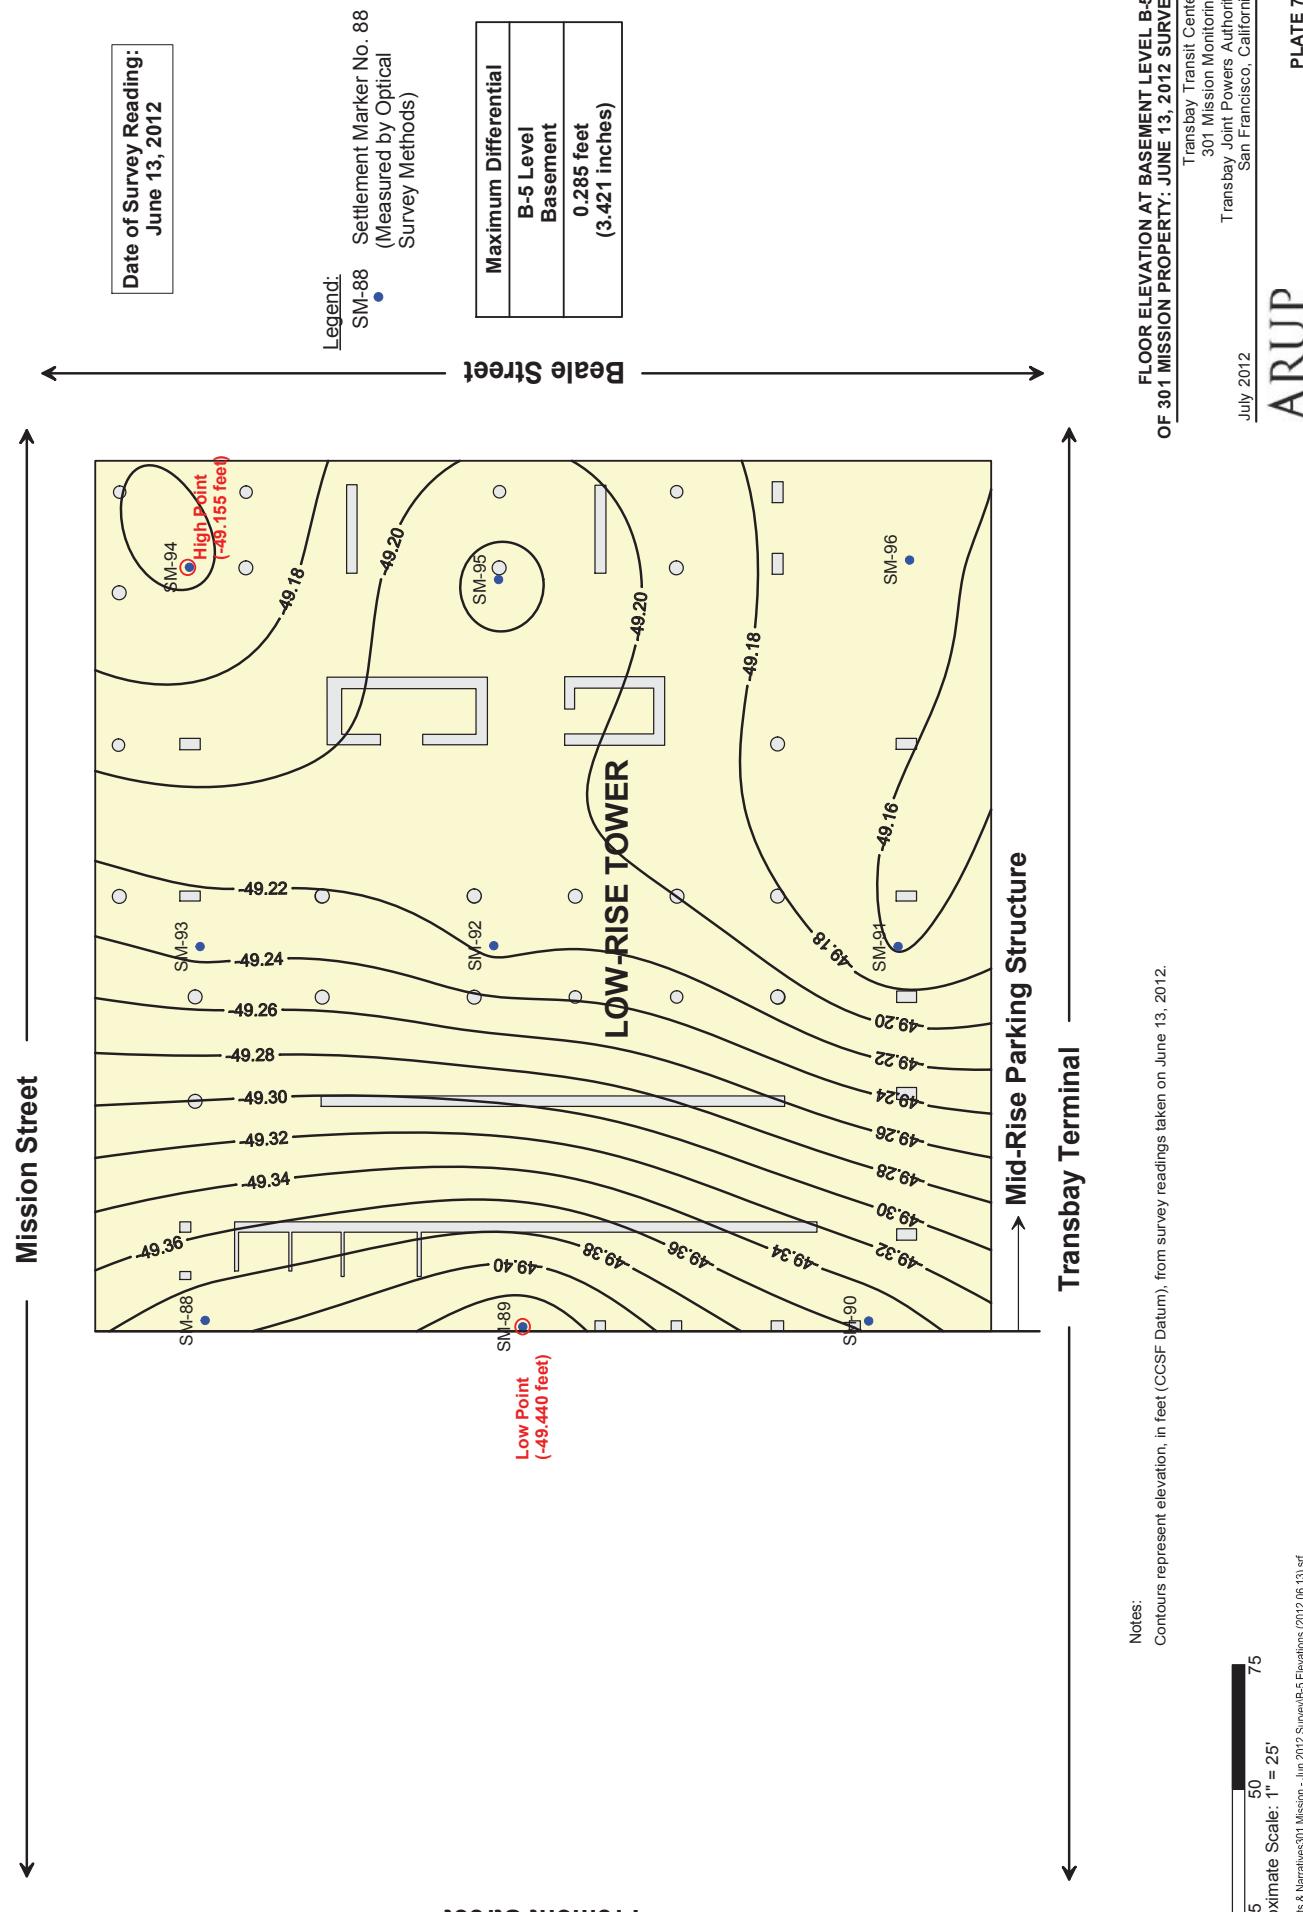


**FLOOR ELEVATION AT BASEMENT LEVEL B-5
OF 301 MISSION PROPERTY: JUNE 13, 2012 SURVEY**

Transbay Transit Concourse
301 Mission Monitoring
Transbay Joint Powers Authority
San Francisco, California
July 2012

ARUP

Notes:
 Contours represent elevation, in feet (CCSF Datum), from survey readings taken on June 13, 2012.

Approximate Scale: 1" = 25'
 Internal Project Data Report & Narratives 301 Mission - Jun 2012 Survey/B5 Elevations (2012.06.13).srf

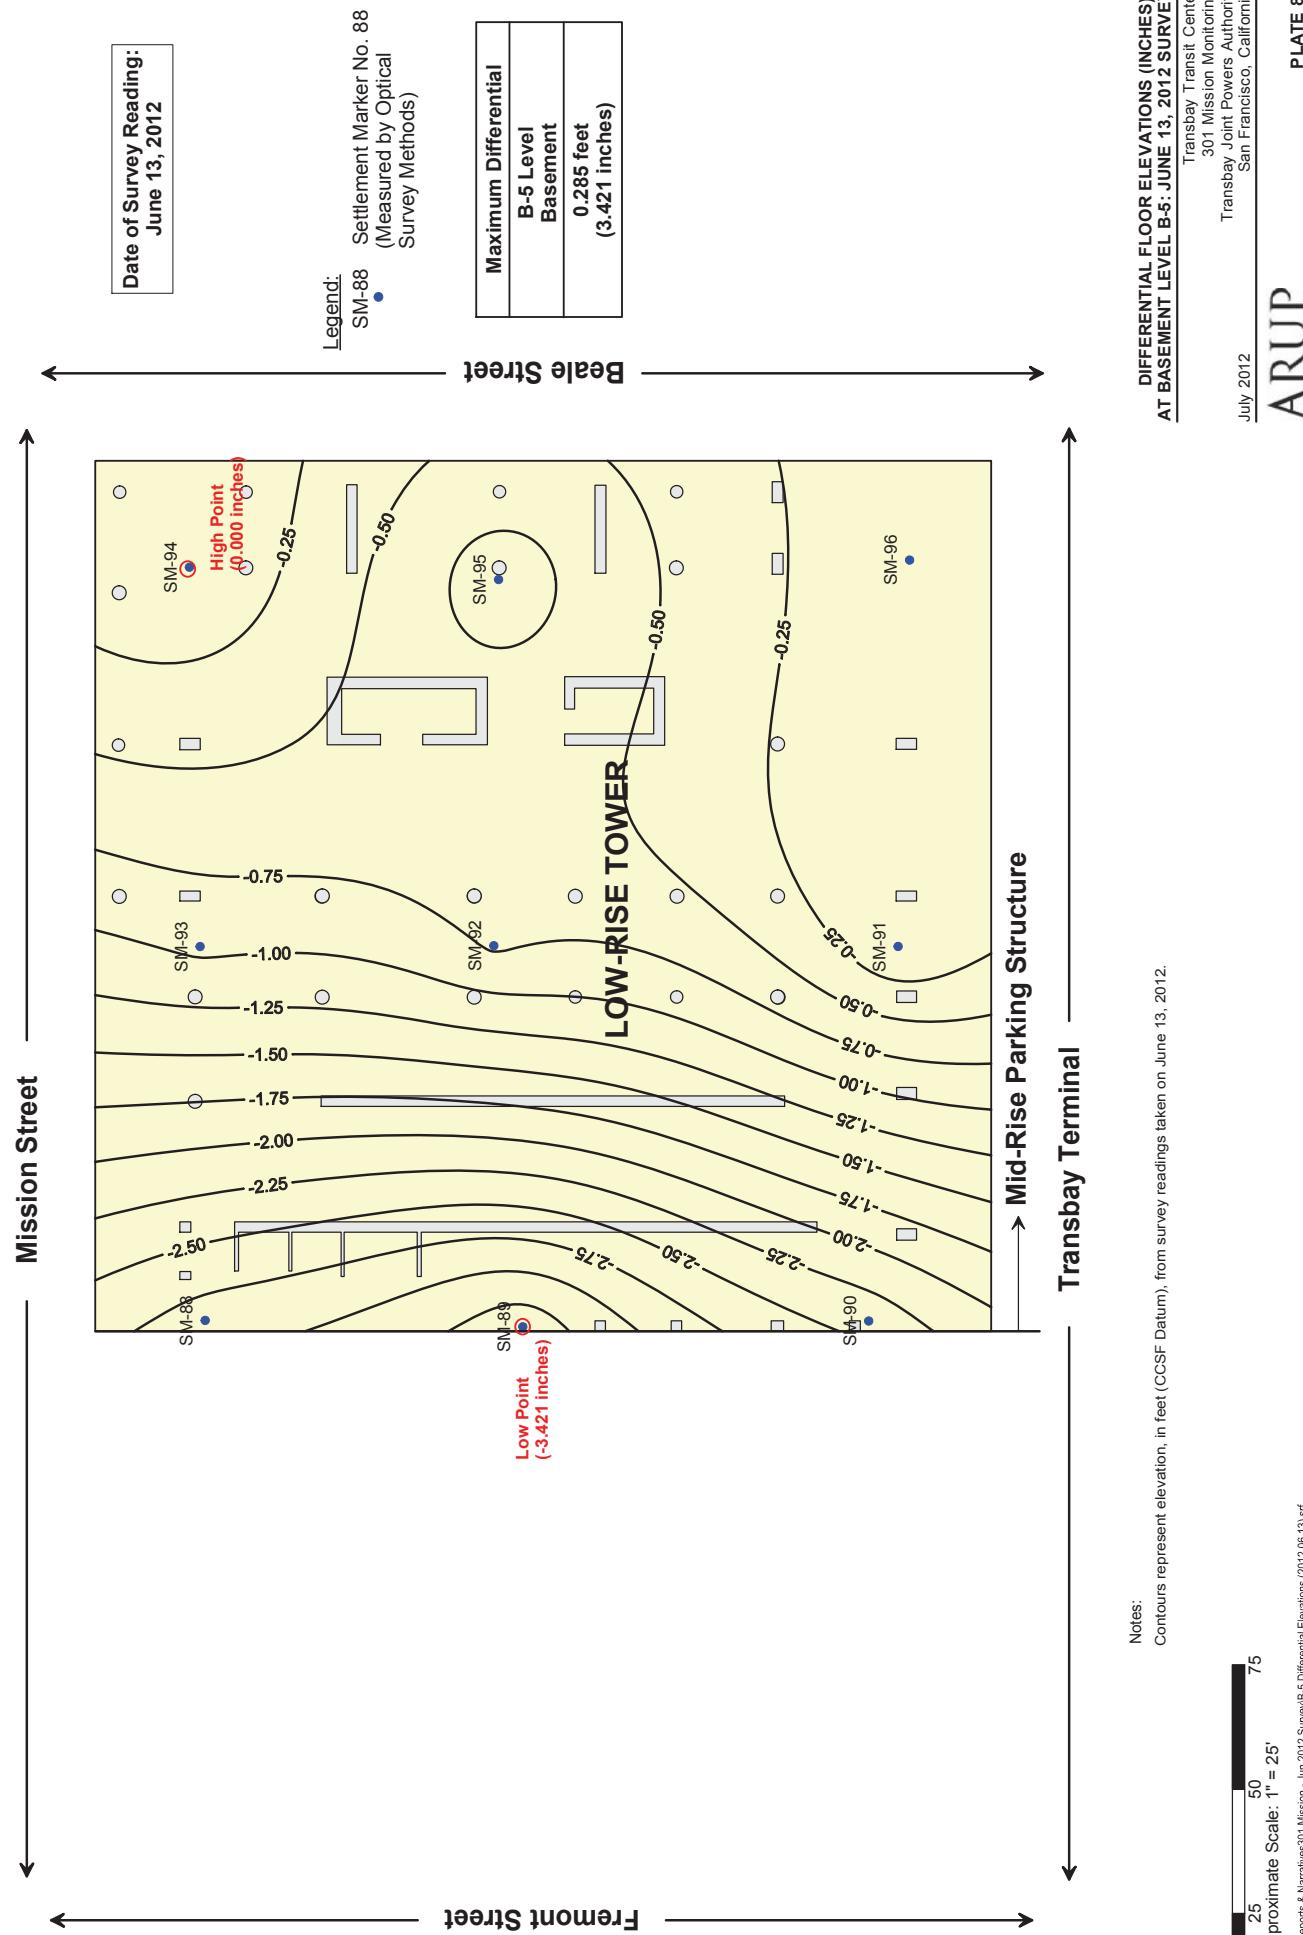

**DIFFERENTIAL FLOOR ELEVATIONS (INCHES)
AT BASEMENT LEVEL B-5: JUNE 13, 2012 SURVEY**

Transbay Transit Center
 301 Mission Monitoring
 Transbay Joint Powers Authority
 San Francisco, California

July 2012

From: Brian Dykes <bdykes@transbaycenter.org>
Sent: Wednesday, August 22, 2012 2:52 PM
To: Steven Hood
Cc: Nick O'Riordan; Stephen McLandrich; Robert Beck; Ed Sum; Nila Gonzales
Subject: Inclinometer & Settlement Readings
Attachments: 2012-08-22 Memo_301 Mission Inclinometer Update Aug 2012.pdf; 2012-08-22 Memo_301 Mission Settlement - Aug 2012 Survey.pdf

Steven,
Further to our meeting on Thursday, August 16th I am sending you the attached memos regarding the inclinometer and settlement survey readings as of August 2012.

Please forward them to other members of your team as you decide are appropriate.

Regards, Brian.

Brian Dykes
Principal Engineer
Transbay Joint Powers Authority
201 Mission Street, Suite 2100
San Francisco, CA 94105
415 597 4617 phone
415 597 4615 fax

Check out our progress at <http://transbaycenter.org/construction-updates/construction-cameras>

NOTE: This e-mail communication and any attachments hereto are covered by the Electronic Communications Privacy Act, 18 U.S.C. Sections 2510-2521, and are legally privileged. The information contained herein is confidential, and is intended only for the use of the individual or entity to whom it is addressed. If you are not the intended recipient of this e-mail communication (or an employee or agent responsible for delivering this communication to its intended recipient(s)), you are hereby notified that any retention, copying or further distribution of this e-mail communication and any attachments is strictly prohibited. If you are not the intended recipient, please notify the sender by telephoning 415-597-4620, or by forwarding an e-mail reply message addressed to TransAdmin@TransbayCenter.org confirming that you have already destroyed (deleted) the original e-mail communication and any and all copies thereof. Thank you.

Memorandum


ARUP

To	Brian Dykes (TJPA)	Date
		22 August 2012
Copies	Robert Beck (TJPA) Emilio Cruz (PMPC) Randy Volenec (PCPA) George Metzger (AAI)	Reference number 132242-60/SMM
From	Stephen McLandrich (Arup) Nick O'Riordan (Arup) Kevin Clinch (Arup)	File reference 4-05 181
Subject	Transbay Transit Center: Results of August 2012 Settlement Survey at 301 Mission Property	Page 1 of 1

Under Arup's Geotechnical Contract with the Transbay Joint Powers Authority through Pelli Clark Pelli Architects, Arup is required to monitor the settlements of the buildings adjacent to the Transbay Transit Center prior to and during construction. We began the monitoring program for the 301 Mission property in April of 2009. This memorandum and the attached plates present an update to our memorandum dated July 6, 2012 with measurements made through August 2012.

List of Plates

- Plate 1 Floor Elevations at Level B-1 of 301 Mission Property: Periodic Survey – August 13, 2012
- Plate 2 Differential Floor Elevation (Inches) – August 13, 2012 Survey
- Plate 3 Contours of Settlements Measured at the First Level Basement of the 301 Mission Street Structure Between April 30, 2009 and August 13, 2012
- Plate 4 Settlement Over Time Floor Elevations at Level B-1 of 301 Mission Property – Tower: April 30, 2009 through August 13, 2012.
- Plate 5 Settlement Over Time Floor Elevations at Level B-1 of 301 Mission Property – Mid-Rise: April 30, 2009 through August 13, 2012
- Plate 6 Settlements of the 301 Mission Tower Including Monitoring During Construction
- Plate 7 Floor Elevation at Basement Level B-5 of 301 Mission Property: August 13, 2012 Survey
- Plate 8 Differential Floor Elevations (Inches) at Basement Level B-5: August 13, 2012 Survey

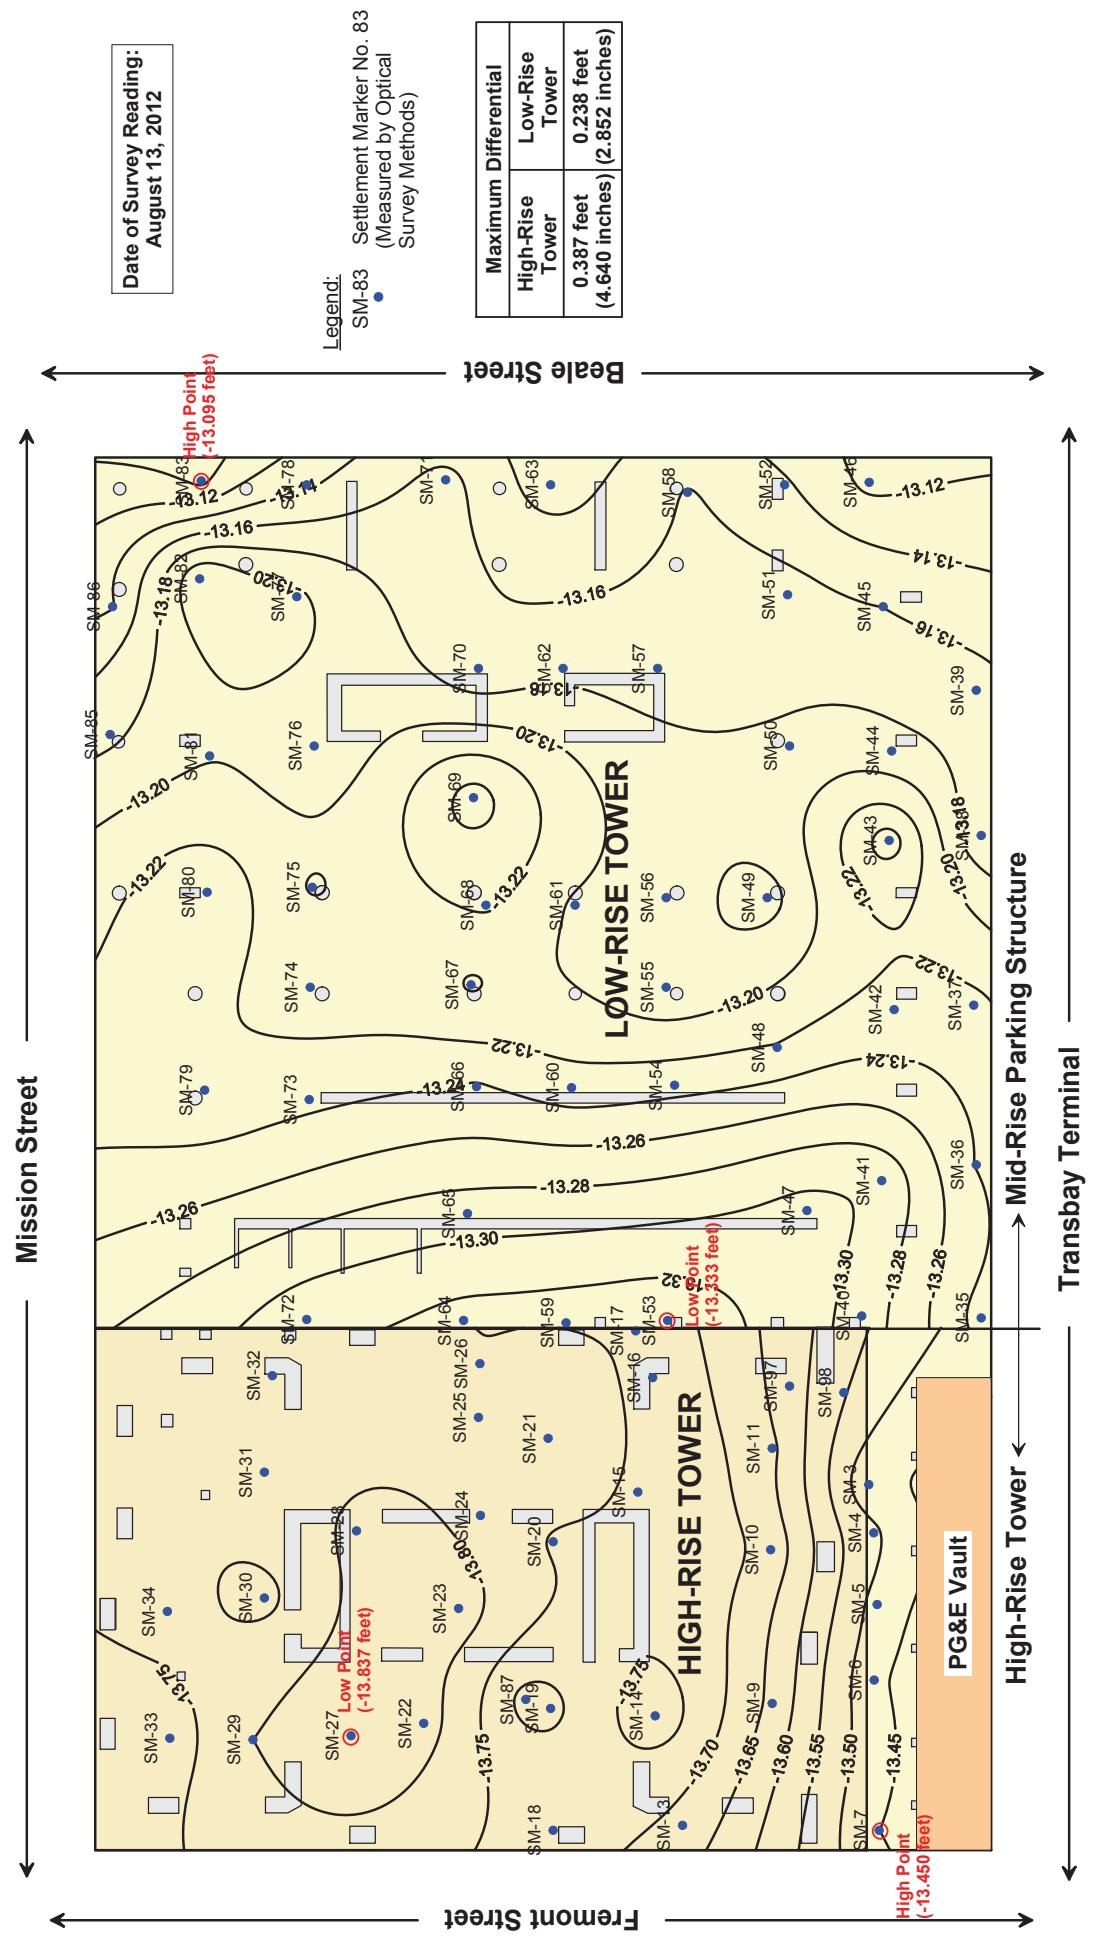


**FLOOR ELEVATIONS AT LEVEL B-1
OF 301 MISSION PROPERTY
PERIODIC SURVEY - AUGUST 13, 2012;**

Transbay Transit Center
301 Mission Monitoring
Transbay Joint Powers Authority
San Francisco, California

August 2012

PLATE 1

Approximate Scale: 1" = 25'
JIS-F1200013224 Internal Project Data445 Reports & Narratives\181301 Mission - Aug 2012 Survey\Plates\Elevations All (2012.08.13).srf

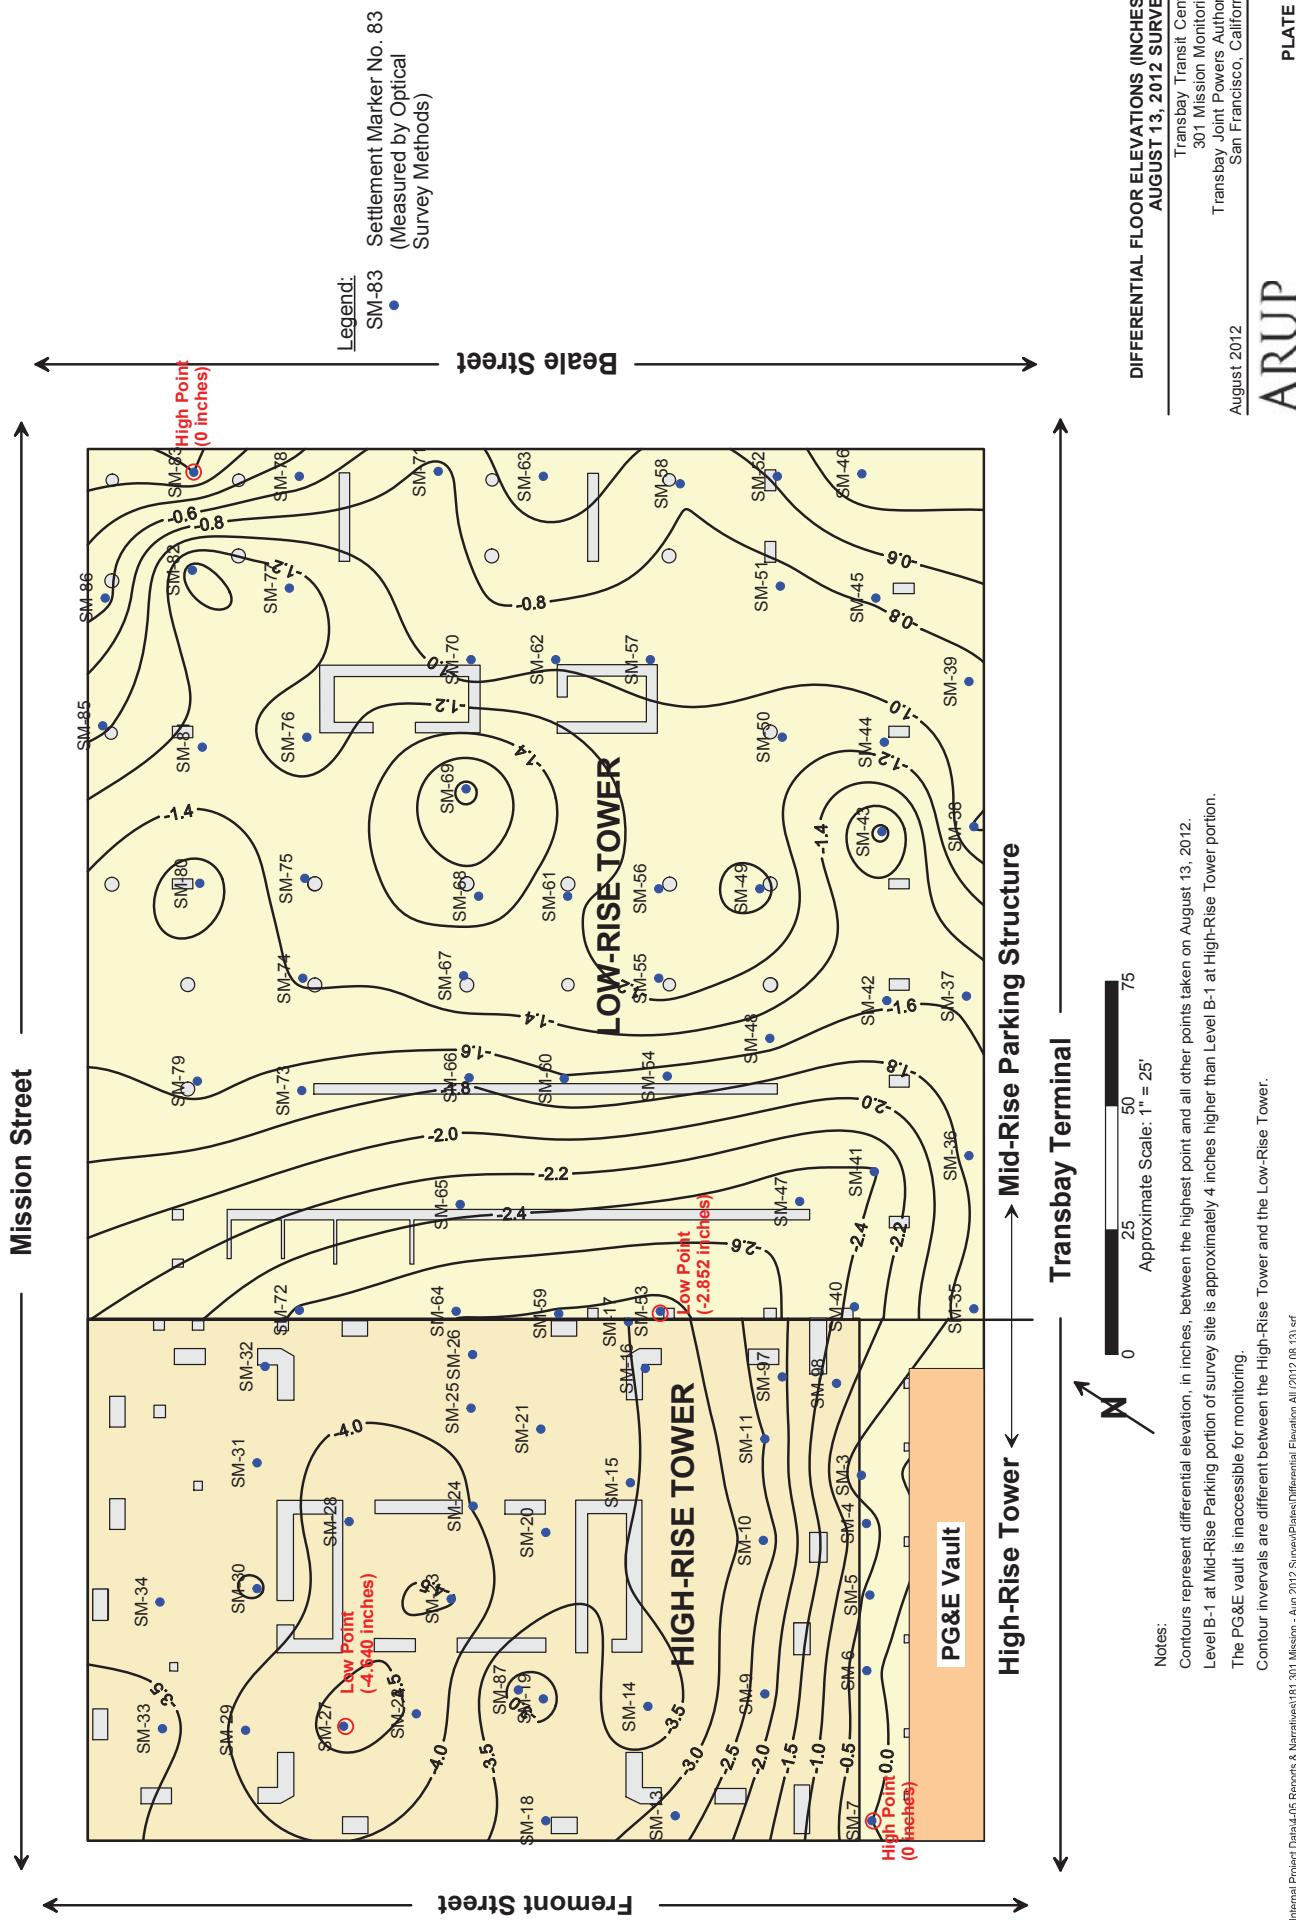


DIFFERENTIAL FLOOR ELEVATIONS (INCHES)
AUGUST 13, 2012 SURVEY

Transbay Transit Center
301 Mission Monitoring
Transbay Joint Powers Authority
San Francisco, California

August 2012

PLATE 2

ARUP

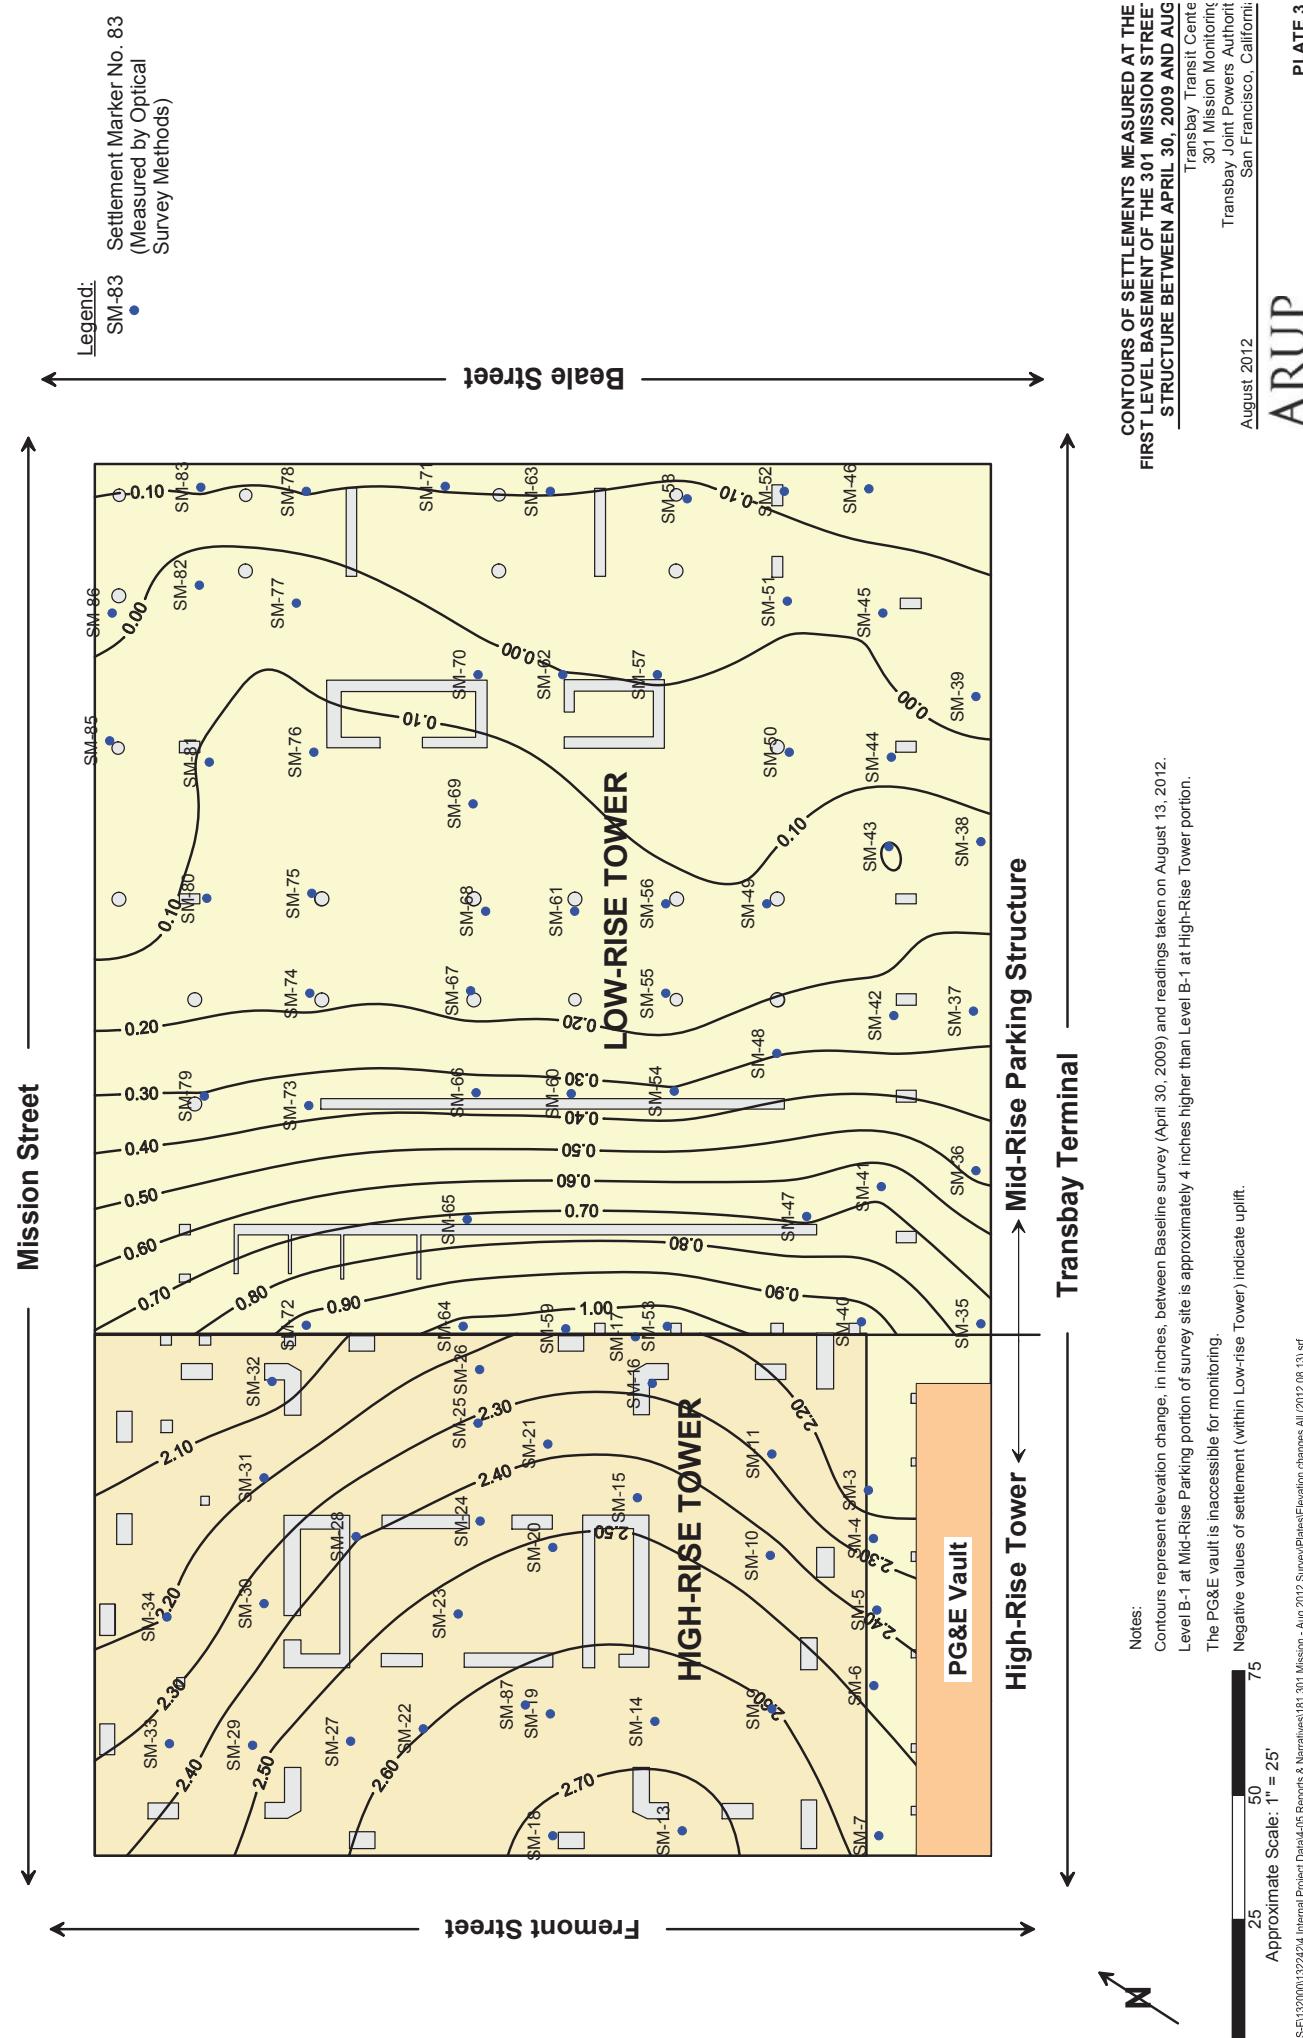

ARUP

Note:
Initial (Baseline) reading
taken on 04/30/09



J:\\S:\\F\\132000\\13224\\4 Internal Project Data\\4-05 Reports & Narratives\\181 301 Mission - Aug 2012 Survey\\Plates\\Plate 4 Settlement Over Time - Tower.grf

Transbay Transit Center
301 Mission Monitoring
Transbay Joint Powers Authority
San Francisco, California

August 2012

Time From Start of Monitoring, Days
APRIL 30, 2009 THROUGH AUGUST 13, 2012



Settlement, inches
-3.0
-2.5
-2.0
-1.5
-1.0
-0.5
0.0

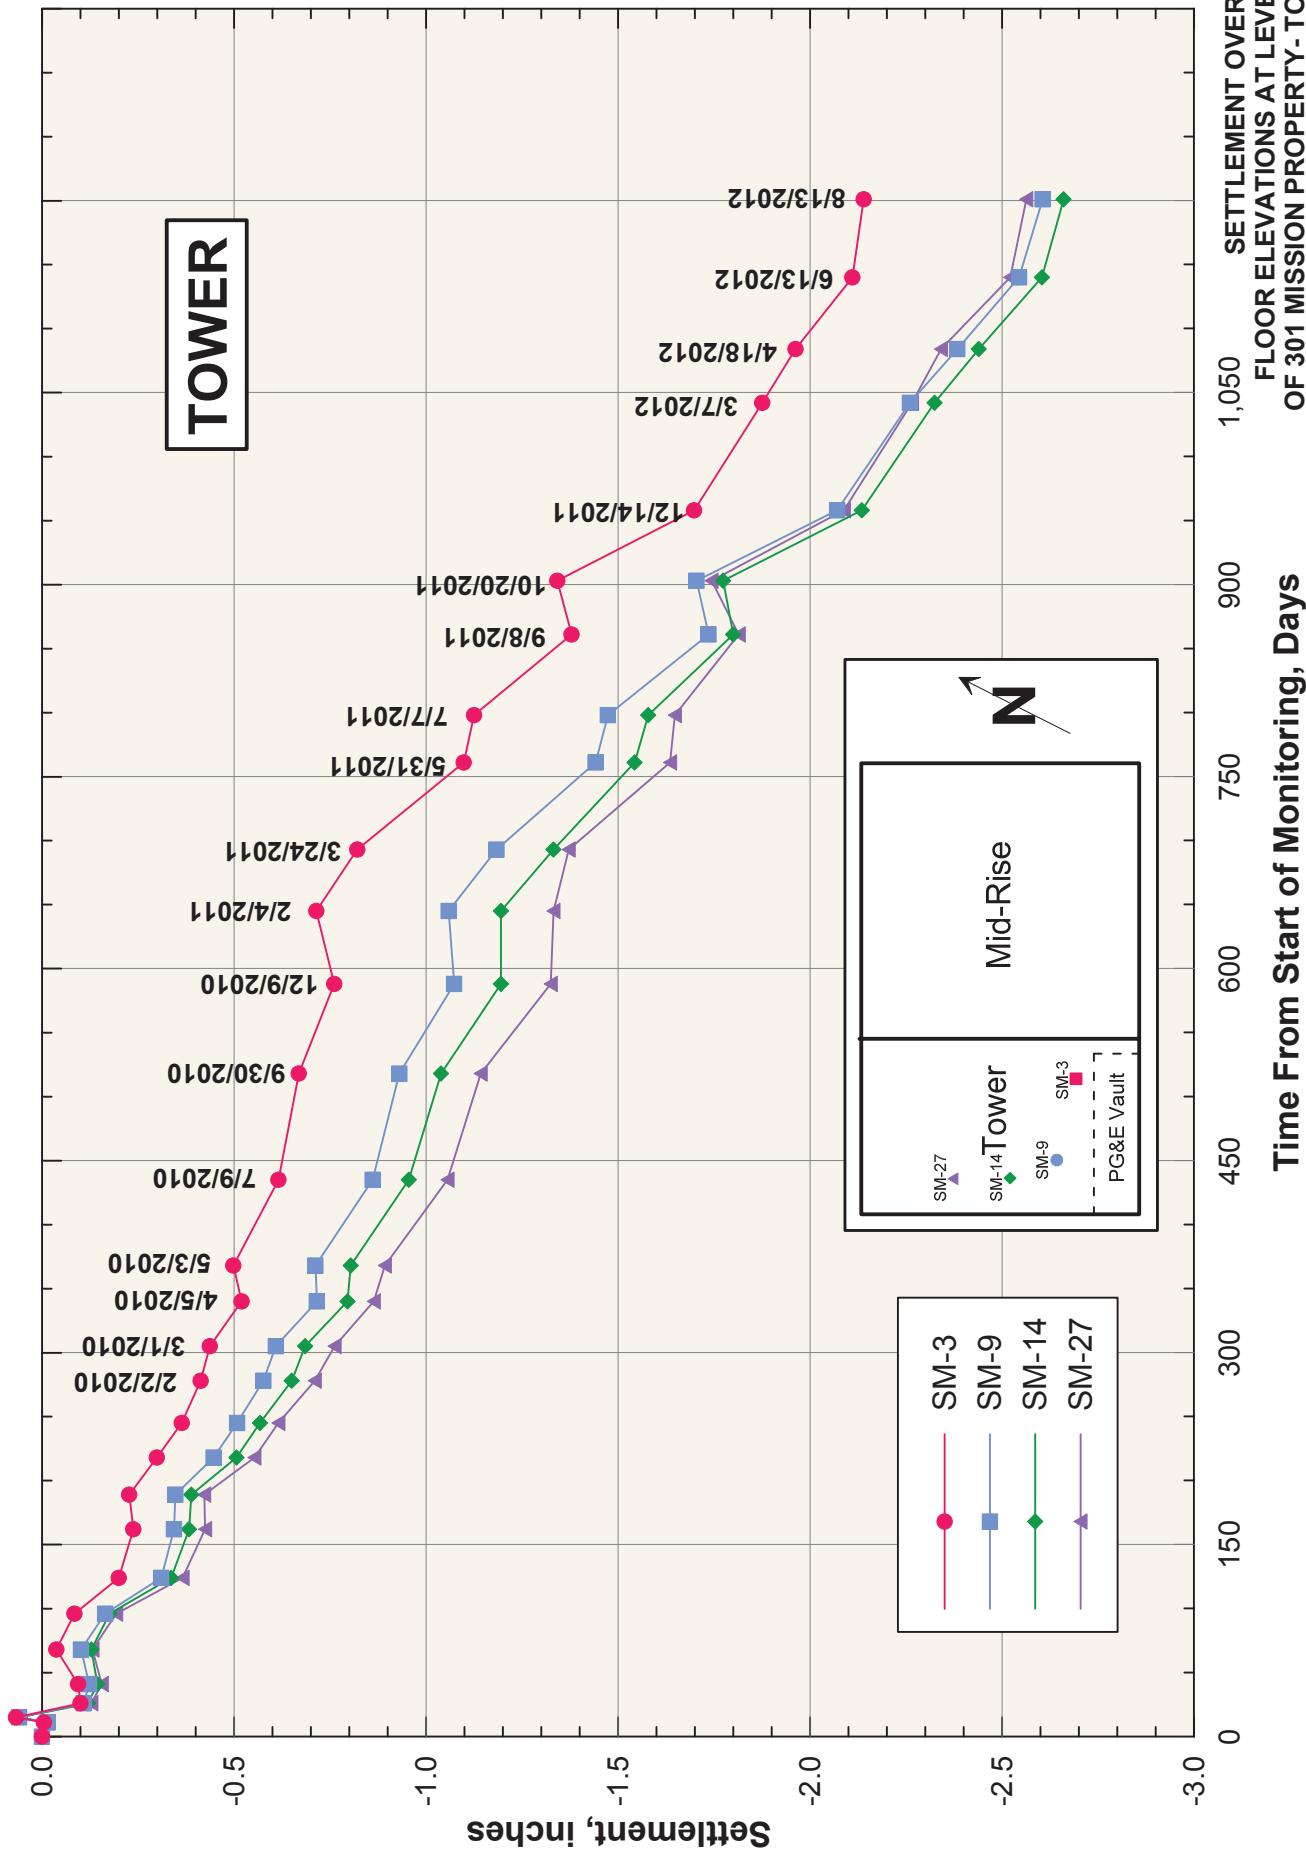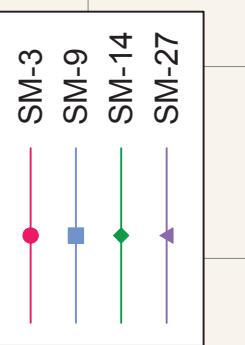

ARUP

Note:
Initial (Baseline) reading
taken on 04/30/09


J:\\S:\\FV\\13224214 Internal Project Data\\4-05 Reports & Narratives\\181 301 Mission - Aug 2012 Survey\\Plates\\Plate 5 Settlement Over Time - Midrise.grf

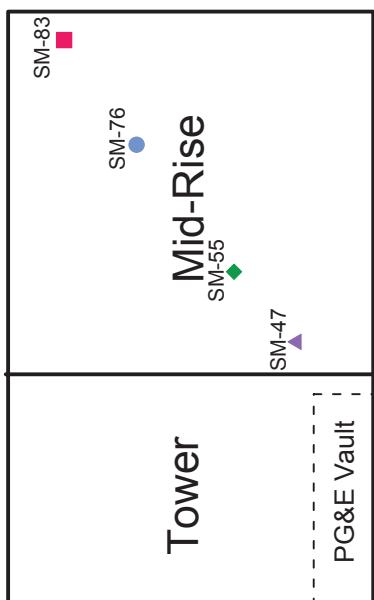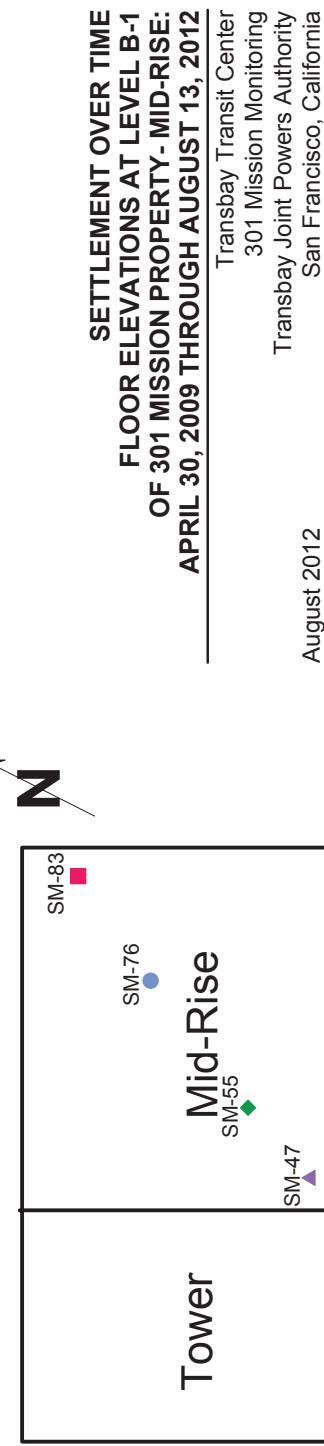

SETTLEMENT OVER TIME
FLOOR ELEVATIONS AT LEVEL B-1
OF 301 MISSION PROPERTY - MID-RISE:
APRIL 30, 2009 THROUGH AUGUST 13, 2012

Transbay Transit Center
301 Mission Monitoring
Transbay Joint Powers Authority
San Francisco, California

August 2012

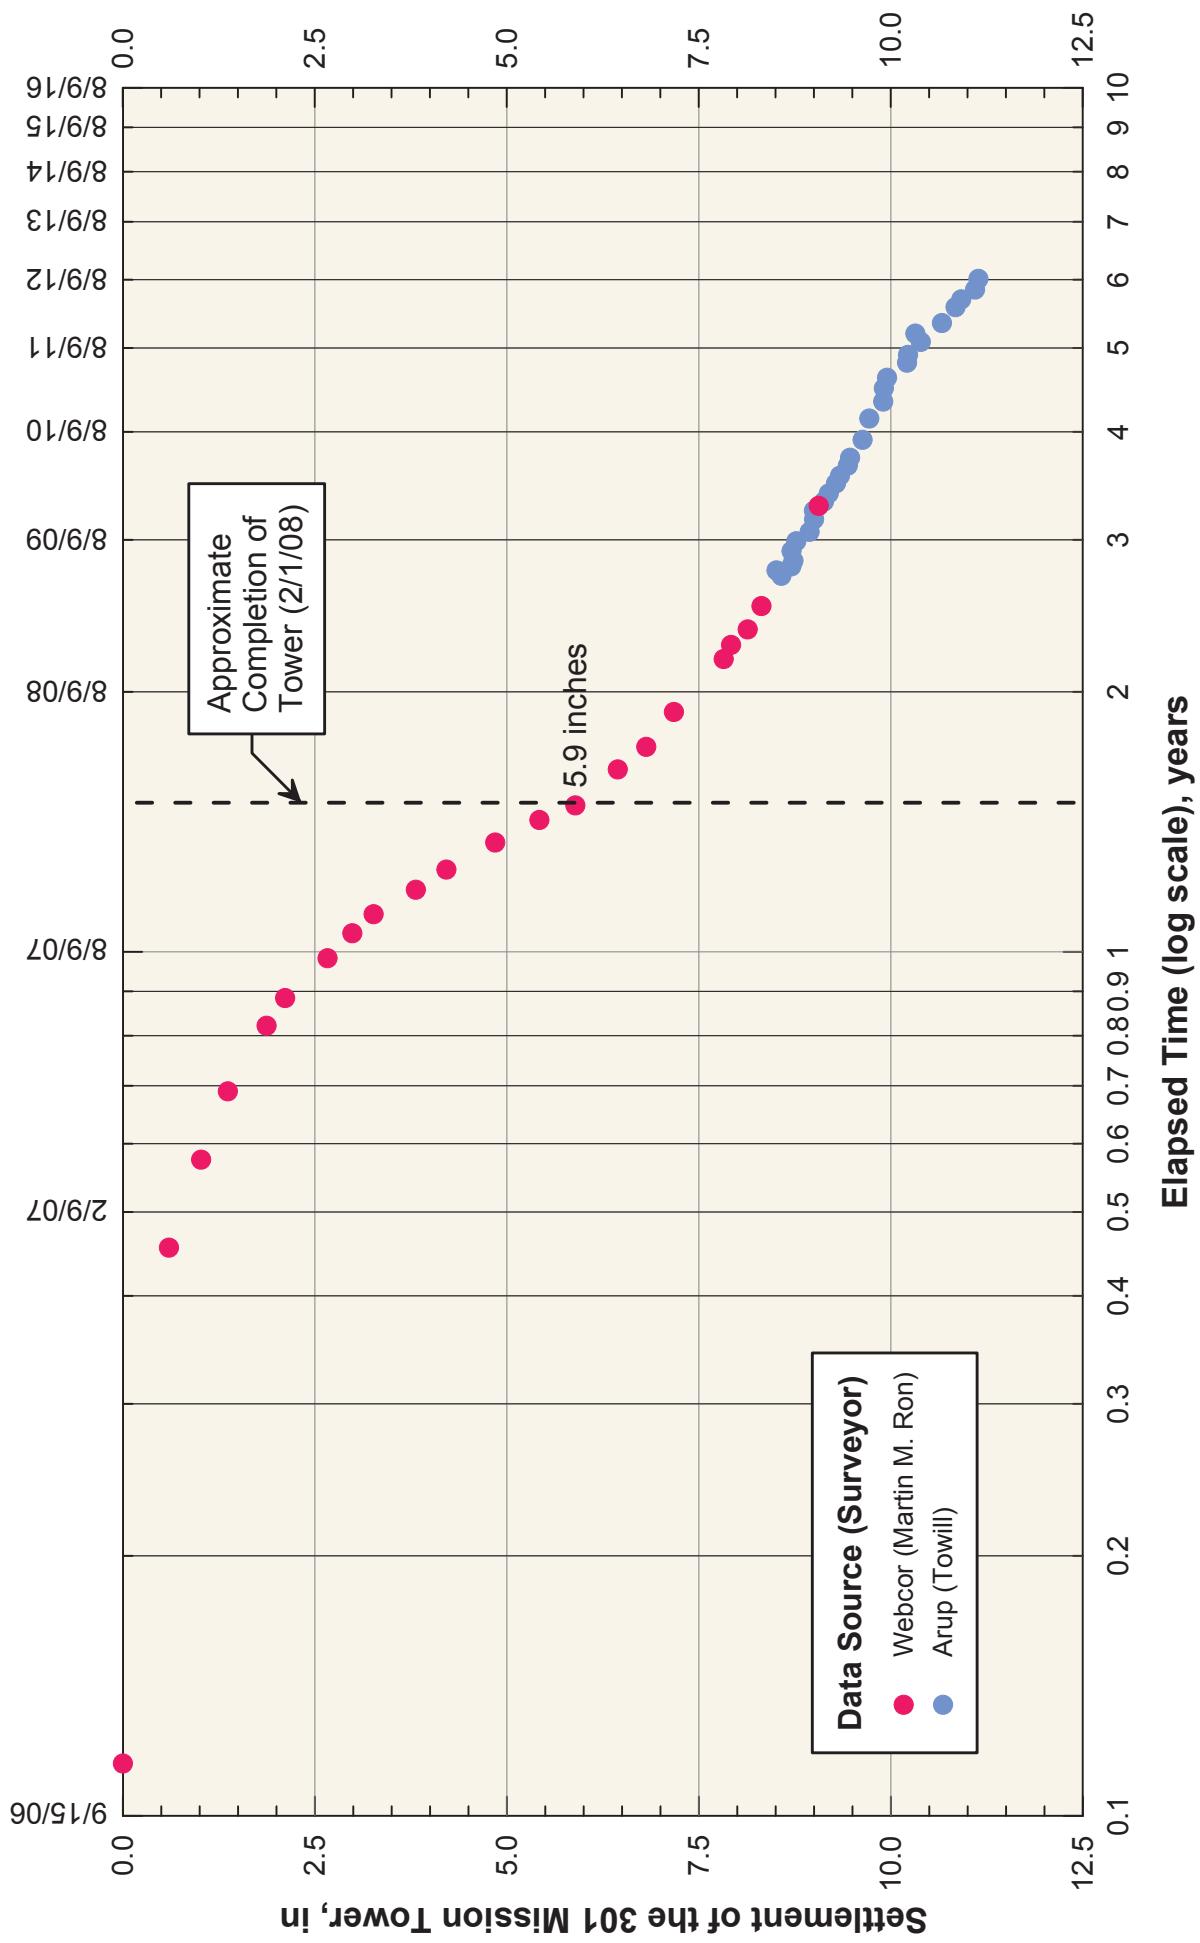



**SETTLEMENTS OF THE 301 MISSION TOWER
INCLUDING MONITORING DURING CONSTRUCTION**

Transbay Transit Center
301 Mission Monitoring
Transbay Joint Powers Authority
San Francisco, California

August 2012

Beginning of Tower Construction: 8/9/06
End of Tower Construction: 2/1/08
Construction Duration: 542 days (1.5 years)

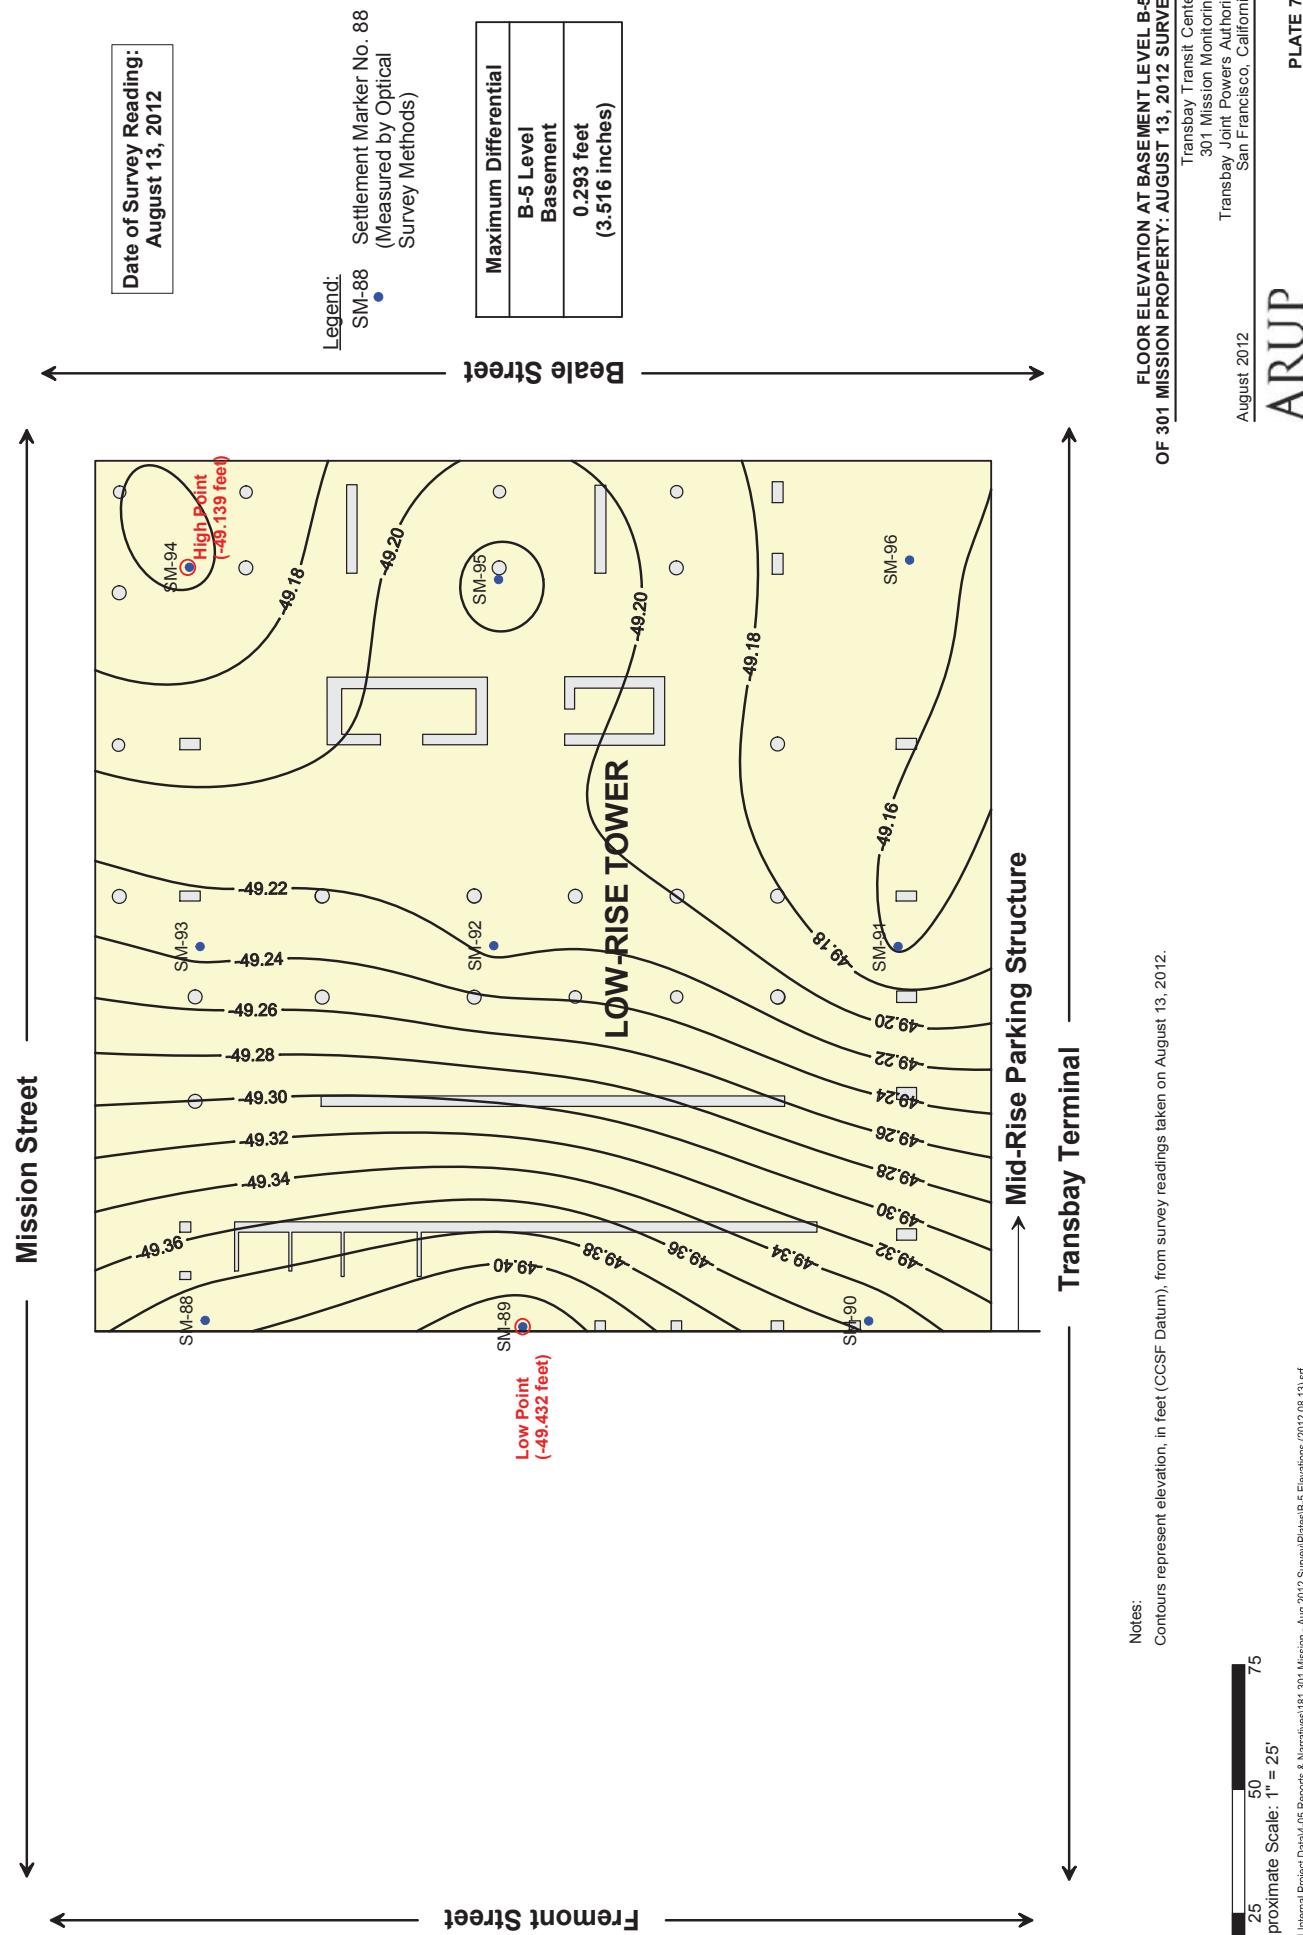

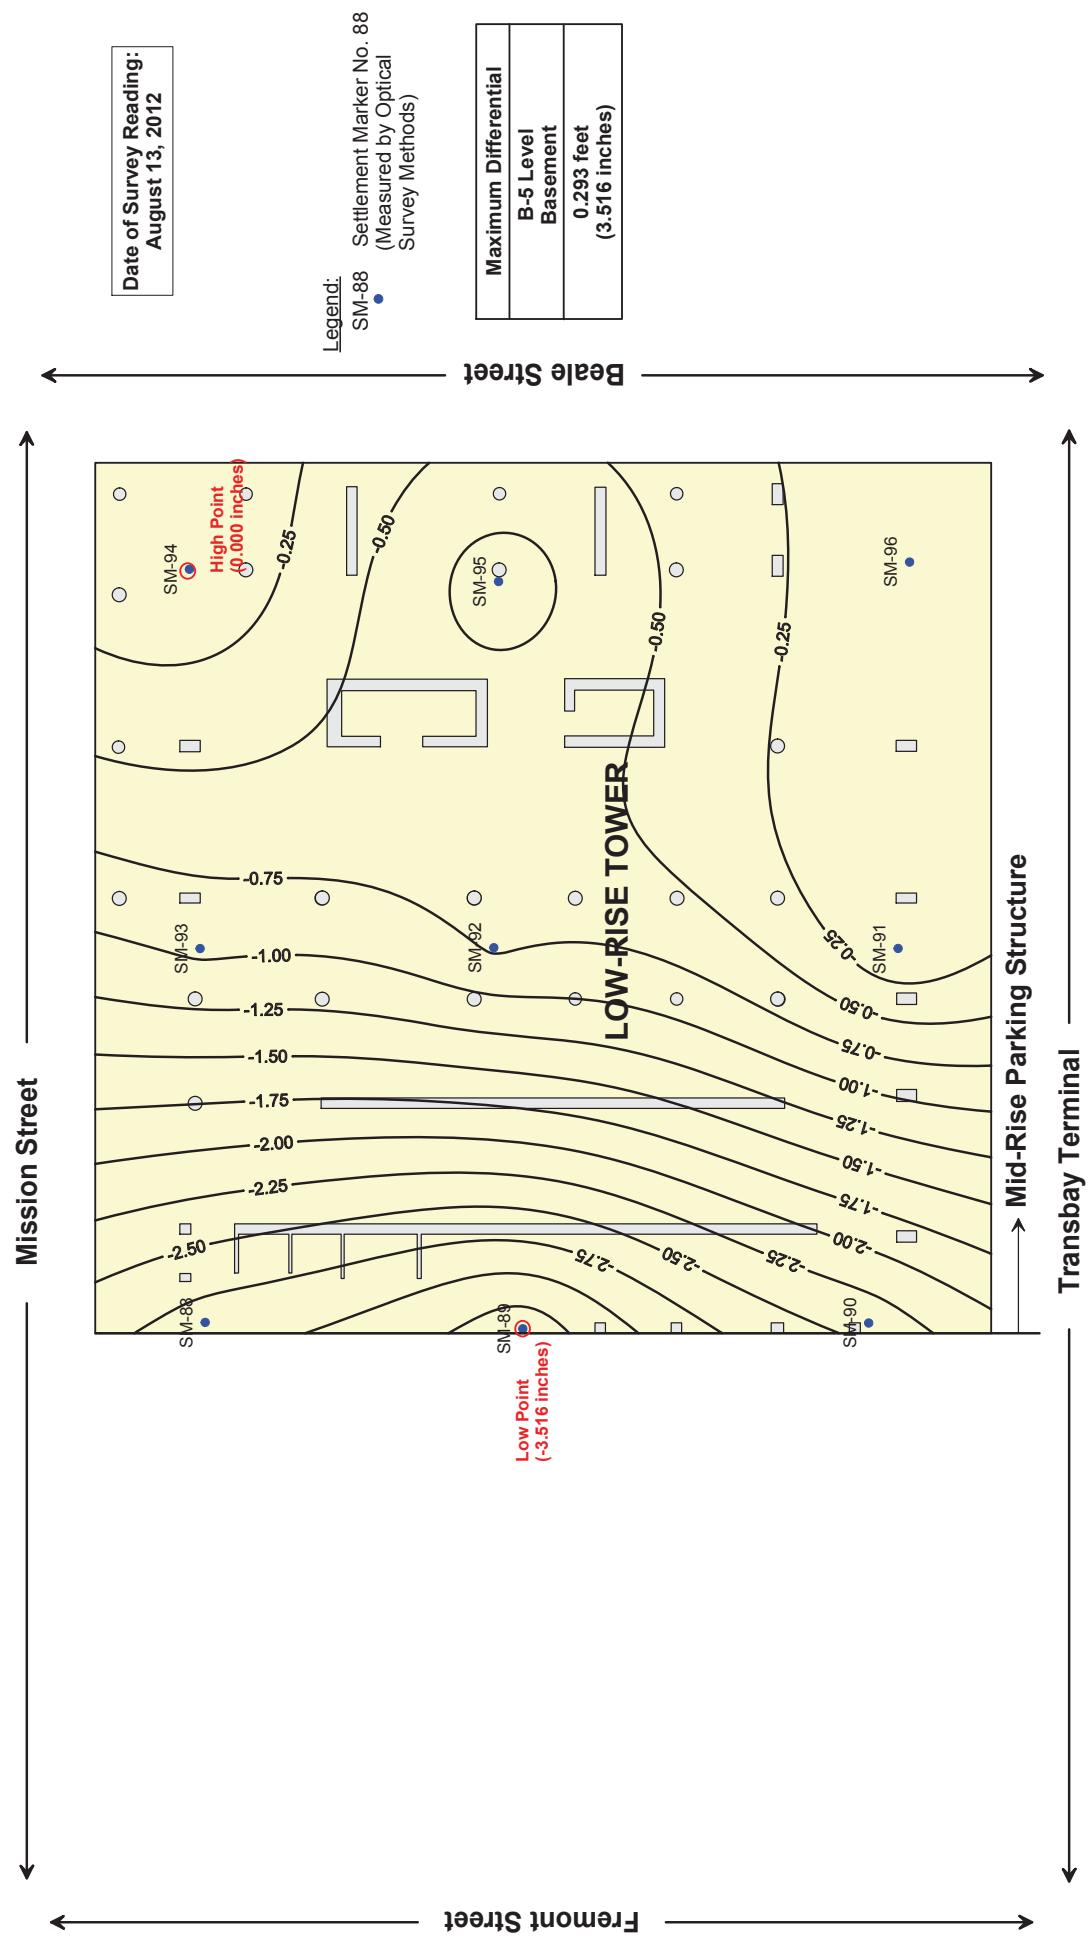

**DIFFERENTIAL FLOOR ELEVATIONS (INCHES)
AT BASEMENT LEVEL B-5: AUGUST 13, 2012 SURVEY**

Transbay Transit Centre
301 Mission Monitoring
Transbay Joint Powers Authority
San Francisco, California

August 2012

JIS-F132000132424 Internal Project Data445 Reports & Narratives\181_301 Mission - Aug 2012 Survey\PlatesB-5 Differential Elevations (2012.08.13).smf

Approximate Scale: 1" = 25'
0 25 50 75



ARUP

PLATE 8

From: Brian Dykes
Sent: Friday, November 16, 2012 1:46 PM
To: Steven Hood
Subject: Latest Settlement Readings at 301 Mission Street

Steven,
Attached is the latest set of settlement readings taken by Arup.
Regards, Brian.

Brian Dykes
Principal Engineer
Transbay Joint Powers Authority
201 Mission Street, Suite 2100
San Francisco, CA 94105
415 597 4617 phone
415 597 4615 fax

Check out our progress at <http://transbaycenter.org/construction-updates/construction-cameras>

NOTE: This e-mail communication and any attachments hereto are covered by the Electronic Communications Privacy Act, 18 U.S.C. Sections 2510-2521, and are legally privileged. The information contained herein is confidential, and is intended only for the use of the individual or entity to whom it is addressed. If you are not the intended recipient of this e-mail communication (or an employee or agent responsible for delivering this communication to its intended recipient(s)), you are hereby notified that any retention, copying or further distribution of this e-mail communication and any attachments is strictly prohibited. If you are not the intended recipient, please notify the sender by telephoning 415-597-4620, or by forwarding an e-mail reply message addressed to TransAdmin@TransbayCenter.org confirming that you have already destroyed (deleted) the original e-mail communication and any and all copies thereof. Thank you.

Memorandum


ARUP

To	Brian Dykes (TJPA)	Date
		06 November 2012
Copies	Robert Beck (TJPA) Emilio Cruz (PMPC) Randy Volenec (PCPA) George Metzger (AAI)	Reference number 132242-60/SMM
From	Michael Gardner (Arup) Stephen McLandrich (Arup)	File reference 4-05 187
Subject	Transbay Transit Center: Results of October 2012 Settlement Survey at 301 Mission Property	Page 1 of 1

Under Arup's Geotechnical Contract with the Transbay Joint Powers Authority through Pelli Clark Pelli Architects, Arup is required to monitor the settlements of the buildings adjacent to the Transbay Transit Center prior to and during construction. We began the monitoring program for the 301 Mission property in April of 2009. This memorandum and the attached plates present an update to our memorandum dated August 22, 2012 with measurements made through October 2012.

List of Plates

- Plate 1 Floor Elevations at Level B-1 of 301 Mission Property: Periodic Survey – October 12, 2012
- Plate 2 Differential Floor Elevation (Inches) – October 12, 2012 Survey
- Plate 3 Contours of Settlements Measured at the First Level Basement of the 301 Mission Street Structure Between April 30, 2009 and October 12, 2012
- Plate 4 Settlement Over Time Floor Elevations at Level B-1 of 301 Mission Property – Tower: April 30, 2009 through October 12, 2012.
- Plate 5 Settlement Over Time Floor Elevations at Level B-1 of 301 Mission Property – Mid-Rise: April 30, 2009 through October 12, 2012
- Plate 6 Settlements of the 301 Mission Tower Including Monitoring During Construction
- Plate 7 Floor Elevation at Basement Level B-5 of 301 Mission Property: October 12, 2012 Survey
- Plate 8 Differential Floor Elevations (Inches) at Basement Level B-5: October 12, 2012 Survey

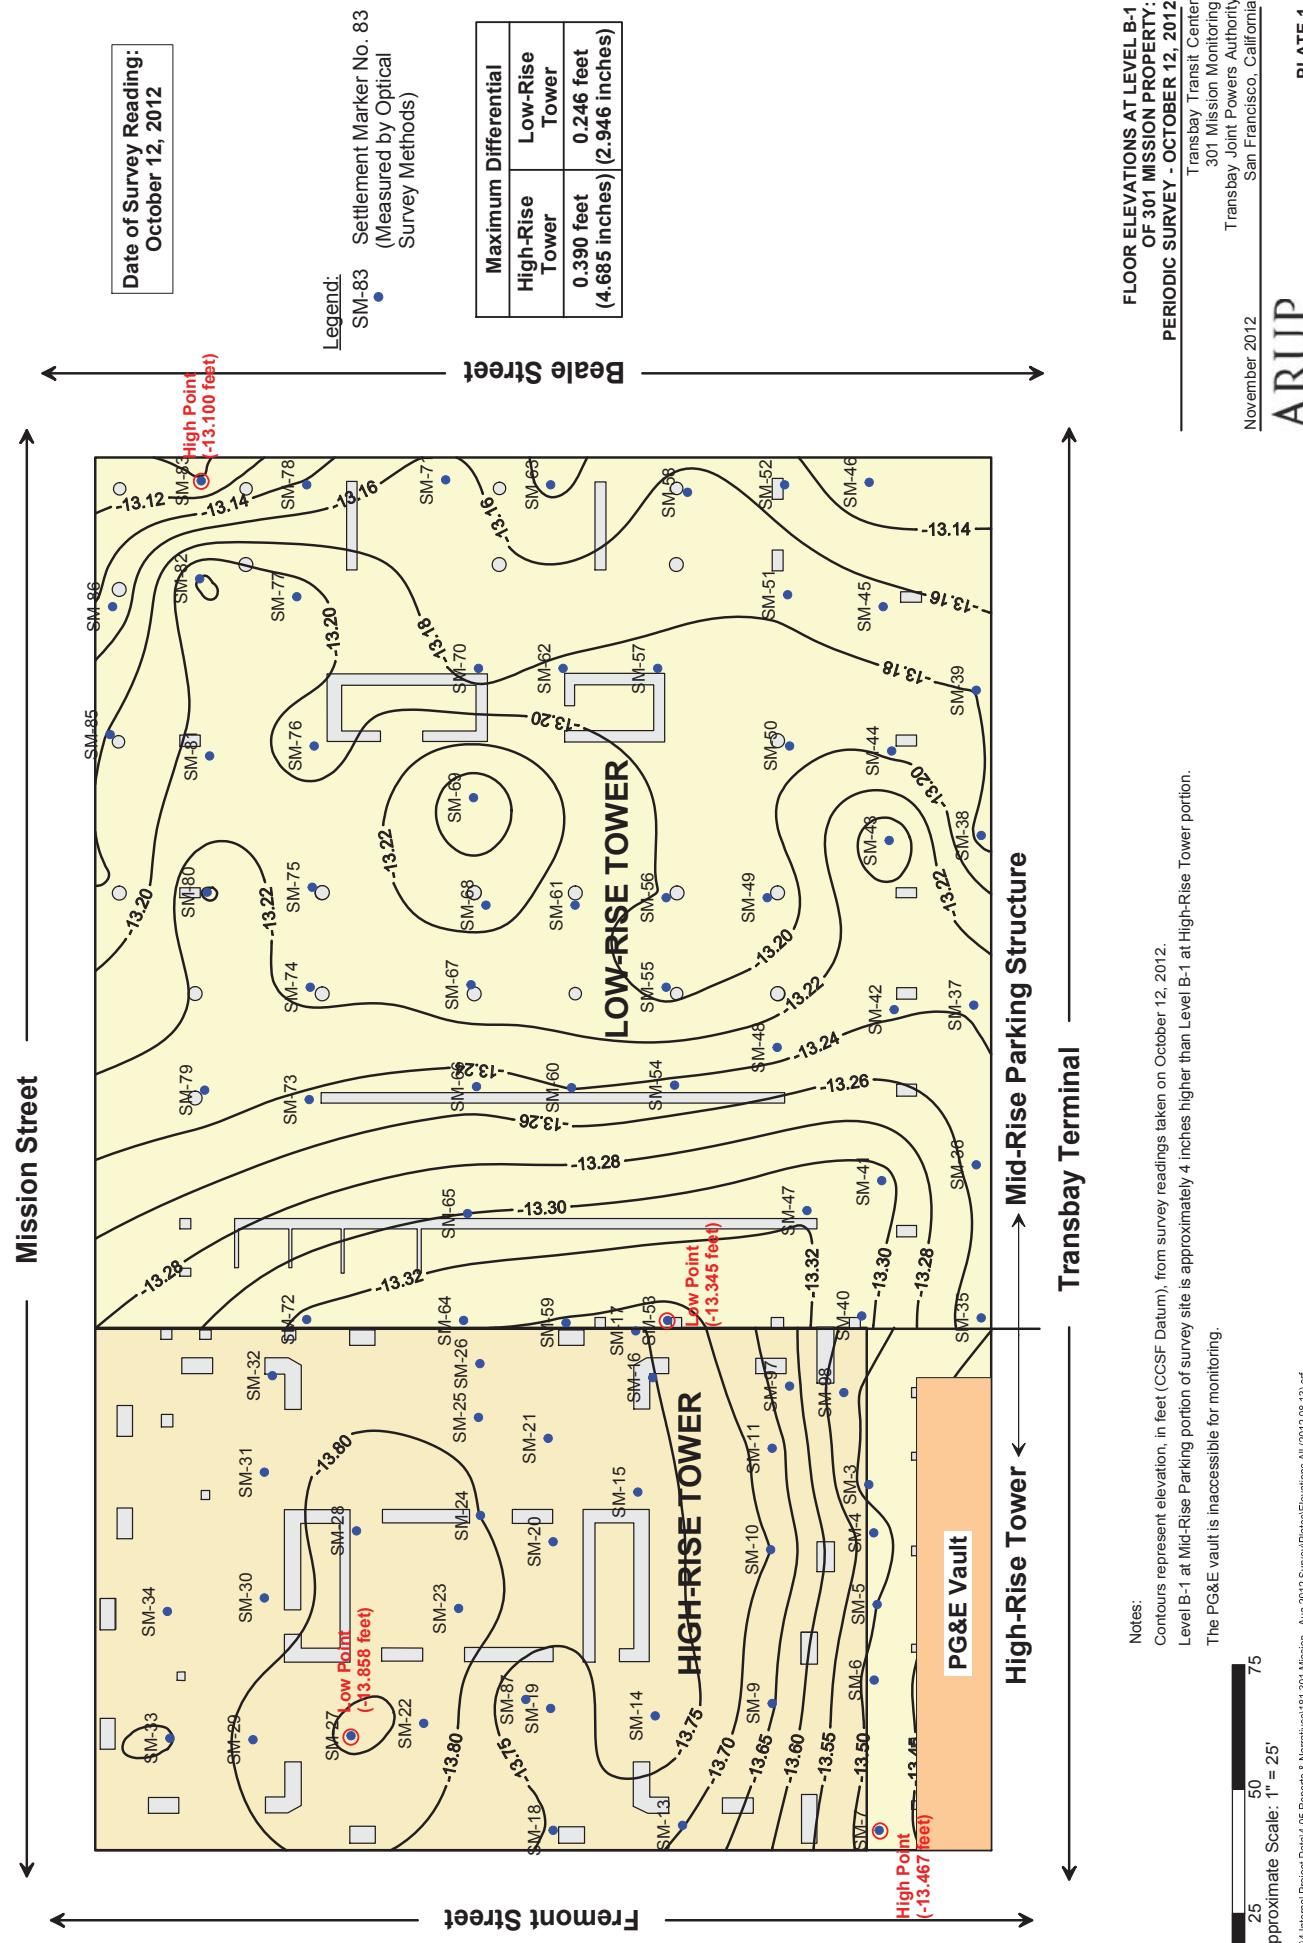

**FLOOR ELEVATIONS AT LEVEL B-1
OF 301 MISSION PROPERTY:
PERIODIC SURVEY - OCTOBER 12, 2012**

Transbay Transit Center
301 Mission Monitoring
Transbay Joint Powers Authority
San Francisco, California


November 2012


DIFFERENTIAL FLOOR ELEVATIONS (INCHES)
OCTOBER 12, 2012 SURVEY
 Transbay Transit Center
 301 Mission Monitoring
 Transbay Joint Powers Authority
 San Francisco, California

November 2012

J:\\S\\E\\132000\\132224 Internal Project Data\\405 Reports & Narratives\\181_301 Mission - Aug 2012 Survey\\Bases\\Differential Elevation All\\2012.08.13.srf

Notes:
 Contours represent differential elevation, in inches, between the highest point and all other points taken on October 12, 2012.
 Level B-1 at Mid-Rise Parking portion of survey site is approximately 4 inches higher than Level B-1 at High-Rise Tower portion.
 The PG&E Vault is inaccessible for monitoring.
 Contour intervals are different between the High-Rise Tower and the Low-Rise Tower.

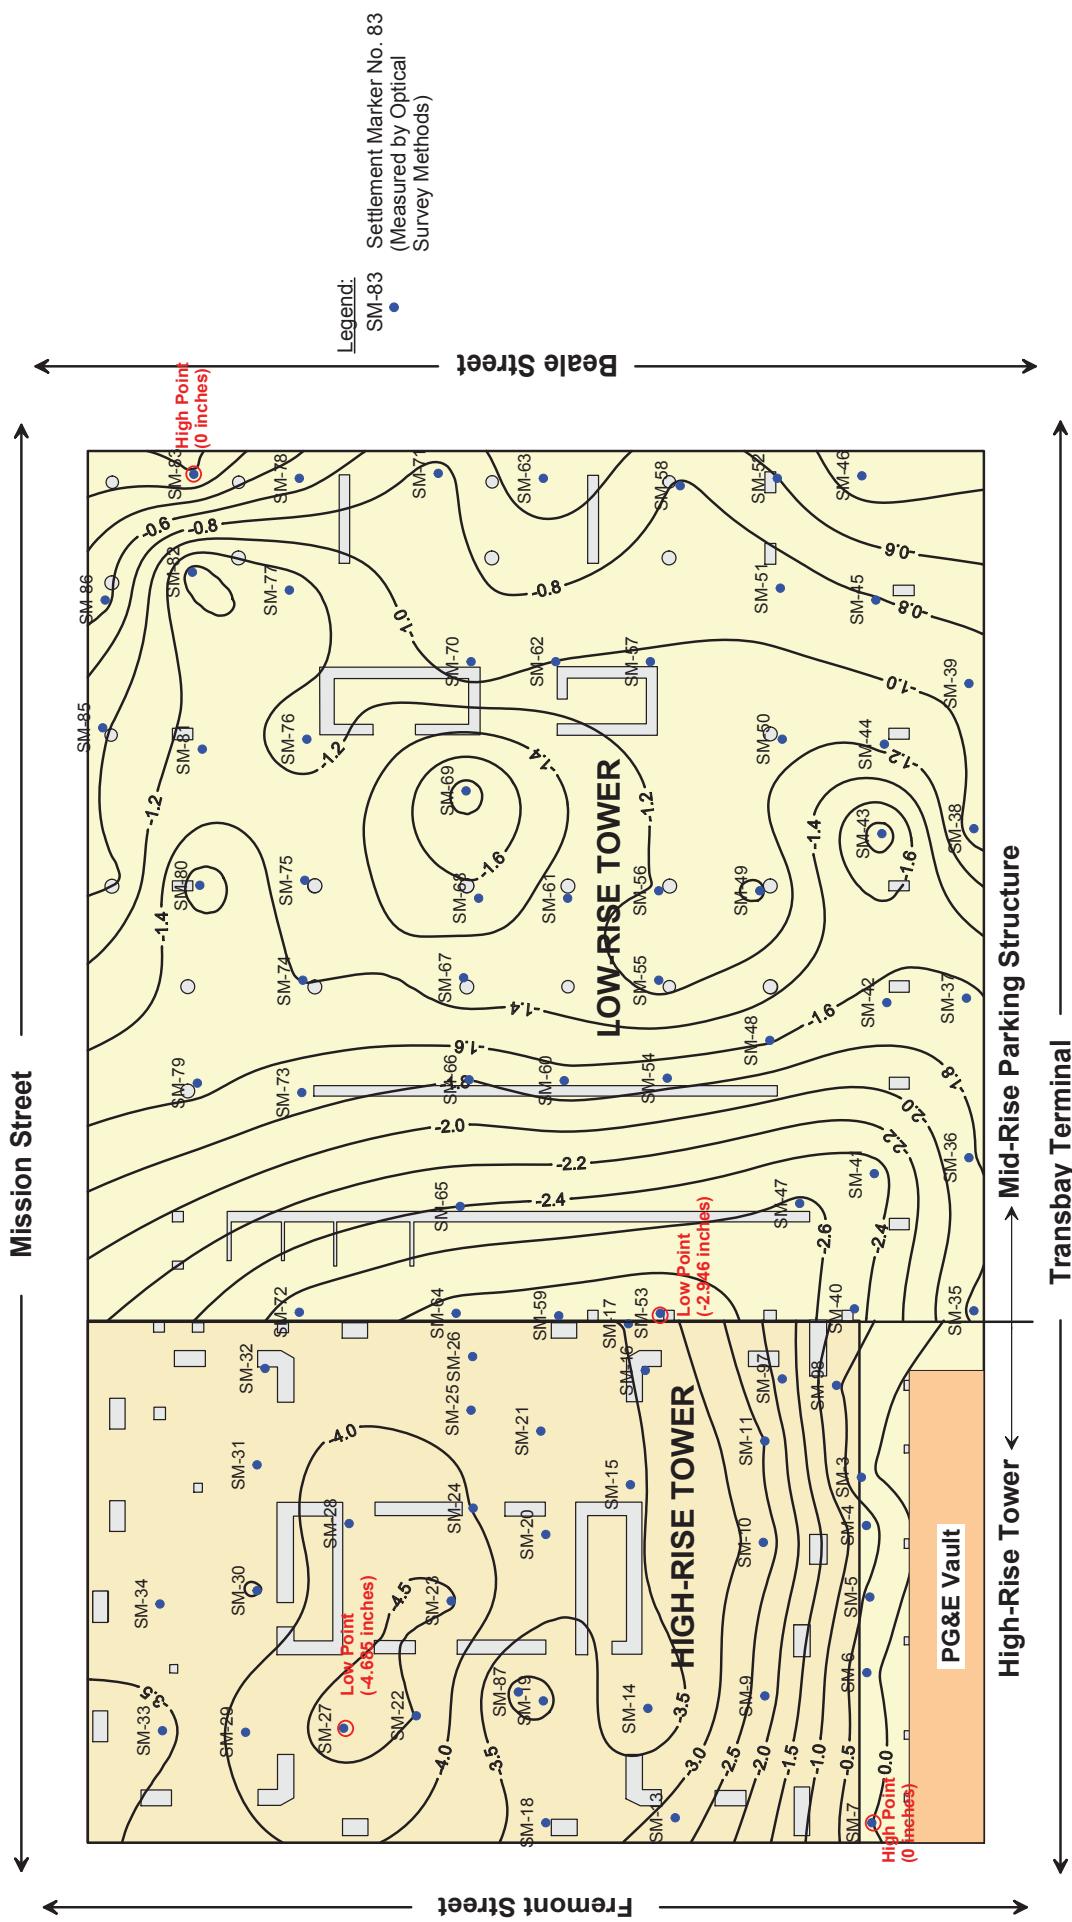

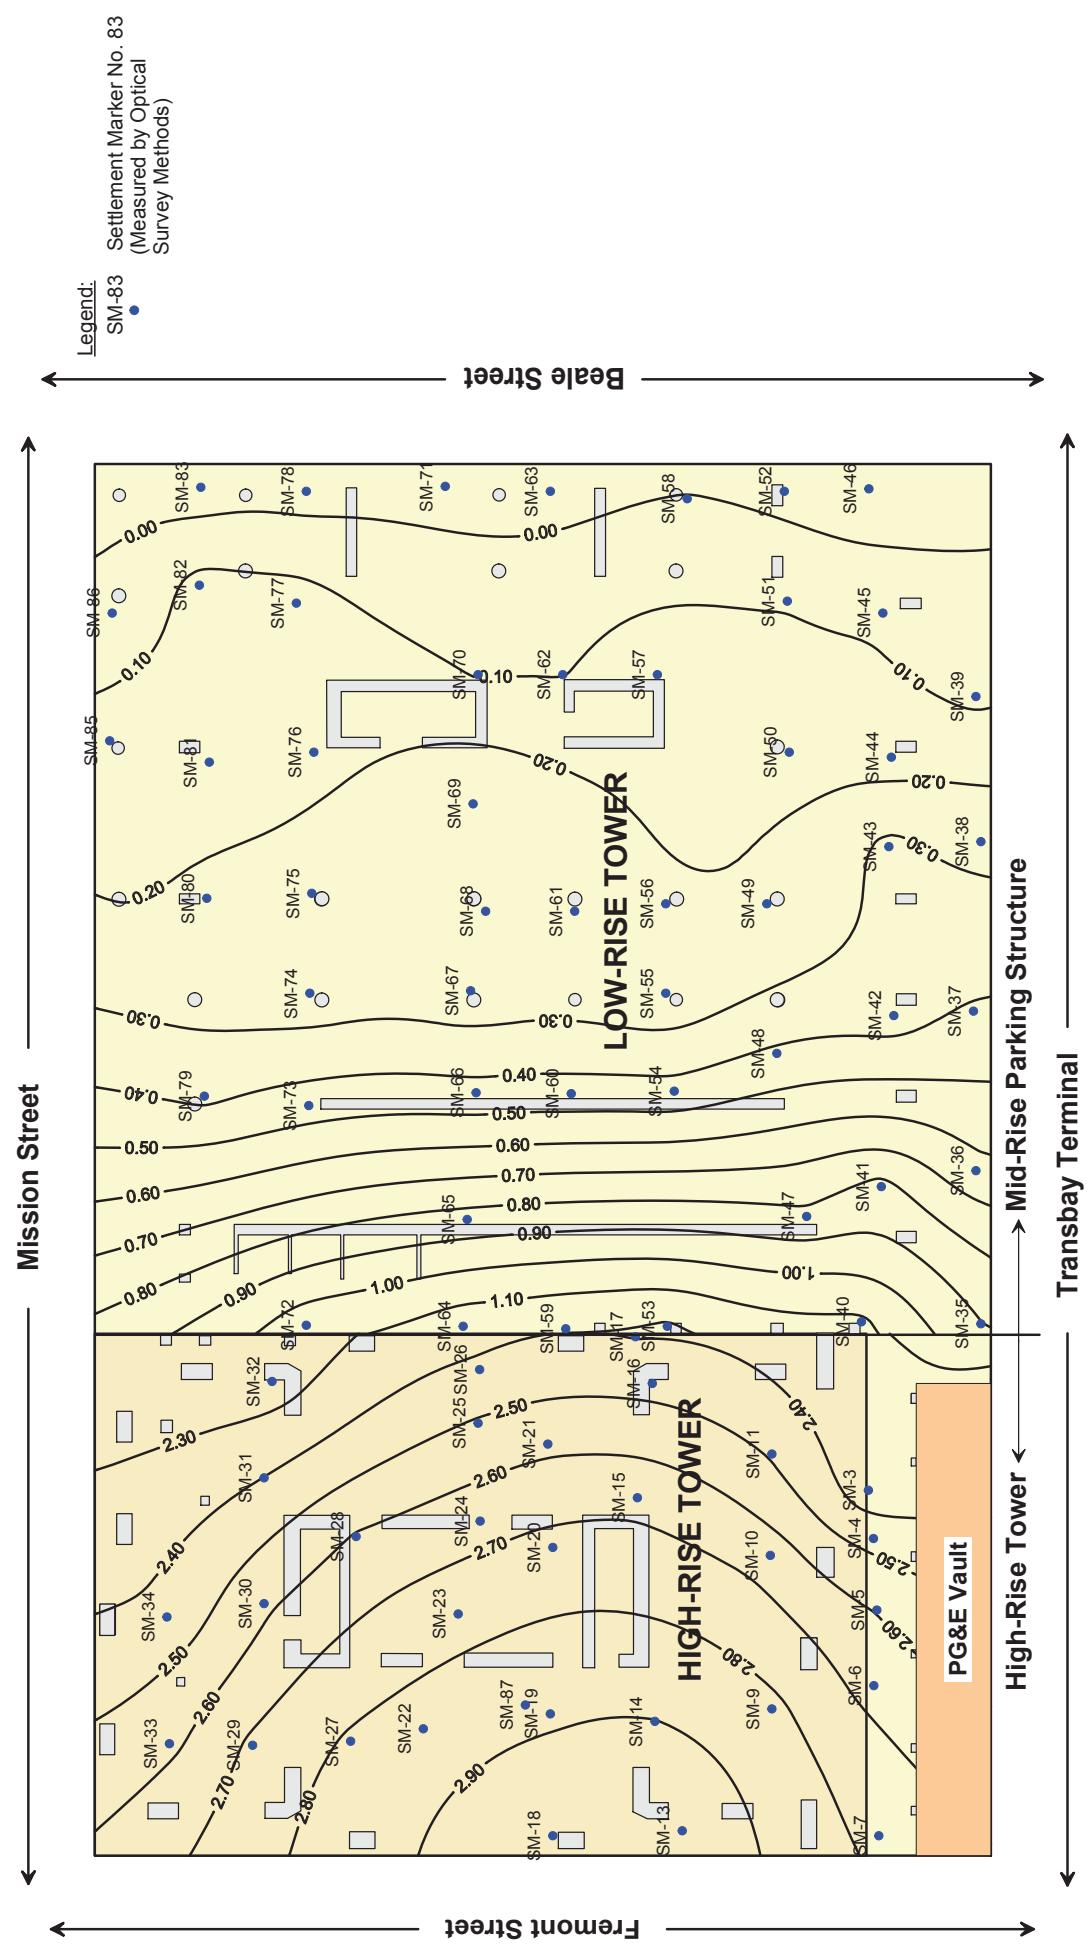

CONTOURS OF SETTLEMENTS MEASURED AT THE FIRST LEVEL BASEMENT OF THE 301 MISSION STREET STRUCTURE BETWEEN APRIL 30, 2009 AND OCTOBER 12, 2012

Transbay Joint Powers Authority
301 Mission Monitoring
San Francisco, California

November 2012



ARUP

Note:
Initial (Baseline) reading
taken on 04/30/09

Transbay Transit Center
301 Mission Monitoring
Transbay Joint Powers Authority
San Francisco, California

**SETTLEMENT OVER TIME
FLOOR ELEVATIONS AT LEVEL B-1
OF 301 MISSION PROPERTY- TOWER:**

APRIL 30, 2009 THROUGH OCTOBER 12, 2012

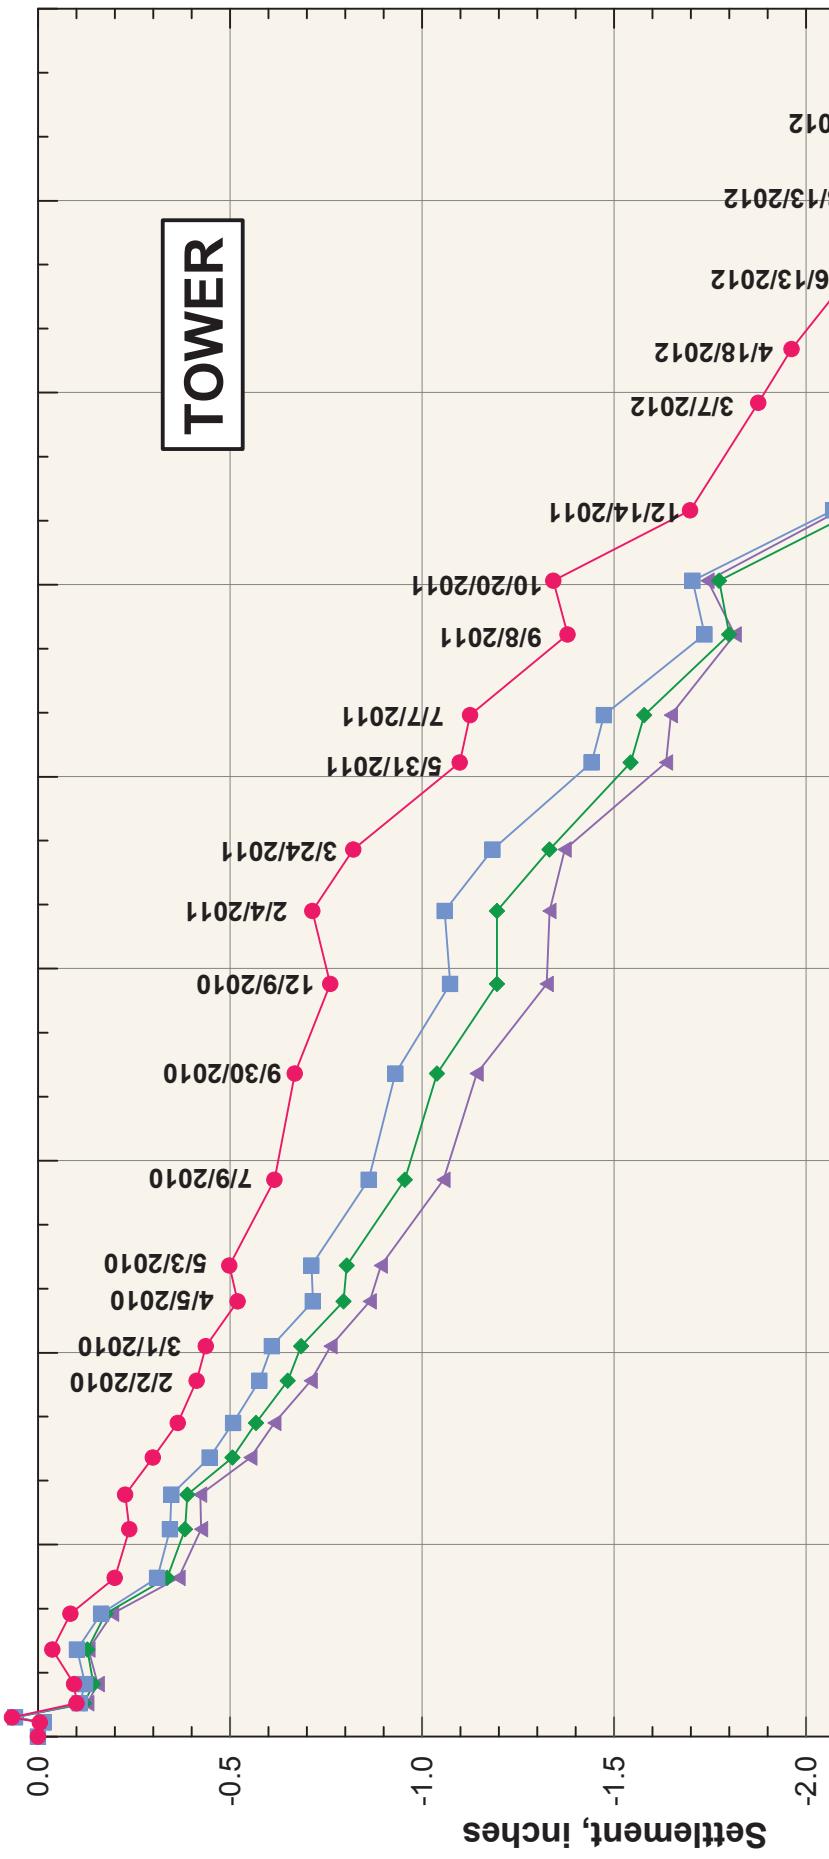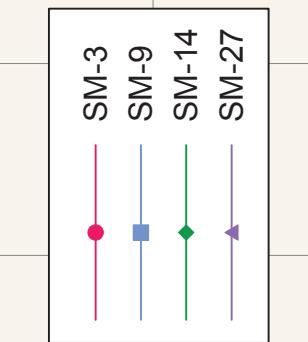

ARUP



Note:
Initial (Baseline) reading
taken on 04/30/09

November 2012

Transbay Joint Powers Authority
San Francisco, California

SETTLEMENT OVER TIME
FLOOR ELEVATIONS AT LEVEL B-1
OF 301 MISSION PROPERTY - MID-RISE:
APRIL 30, 2009 THROUGH OCTOBER 12, 2012

Transbay Transit Center
301 Mission Monitoring

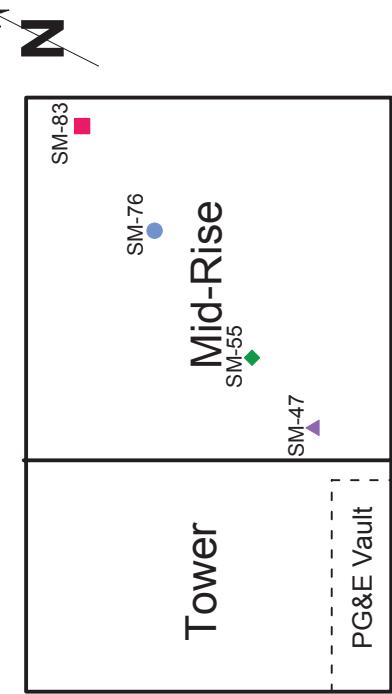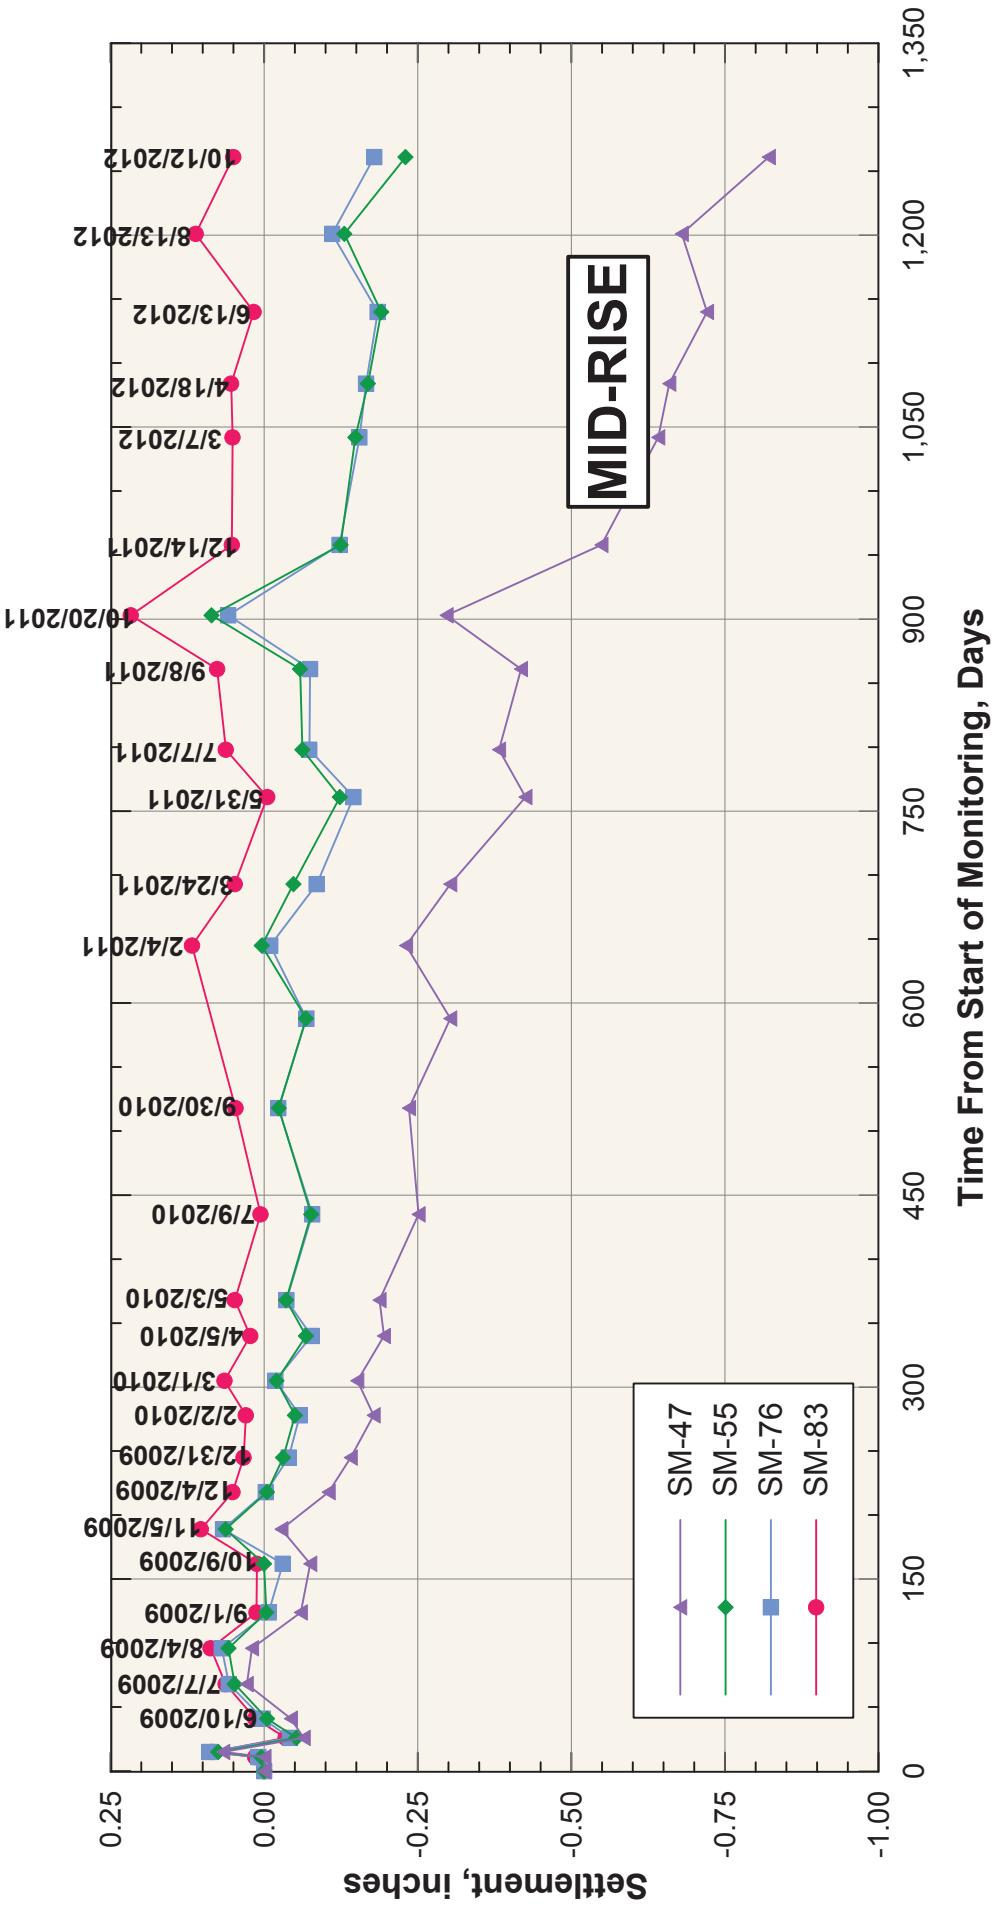



ARUP


**SETTLEMENTS OF THE 301 MISSION TOWER
INCLUDING MONITORING DURING CONSTRUCTION**

Transbay Transit Center
301 Mission Monitoring
Transbay Joint Powers Authority
San Francisco, California

August 2012

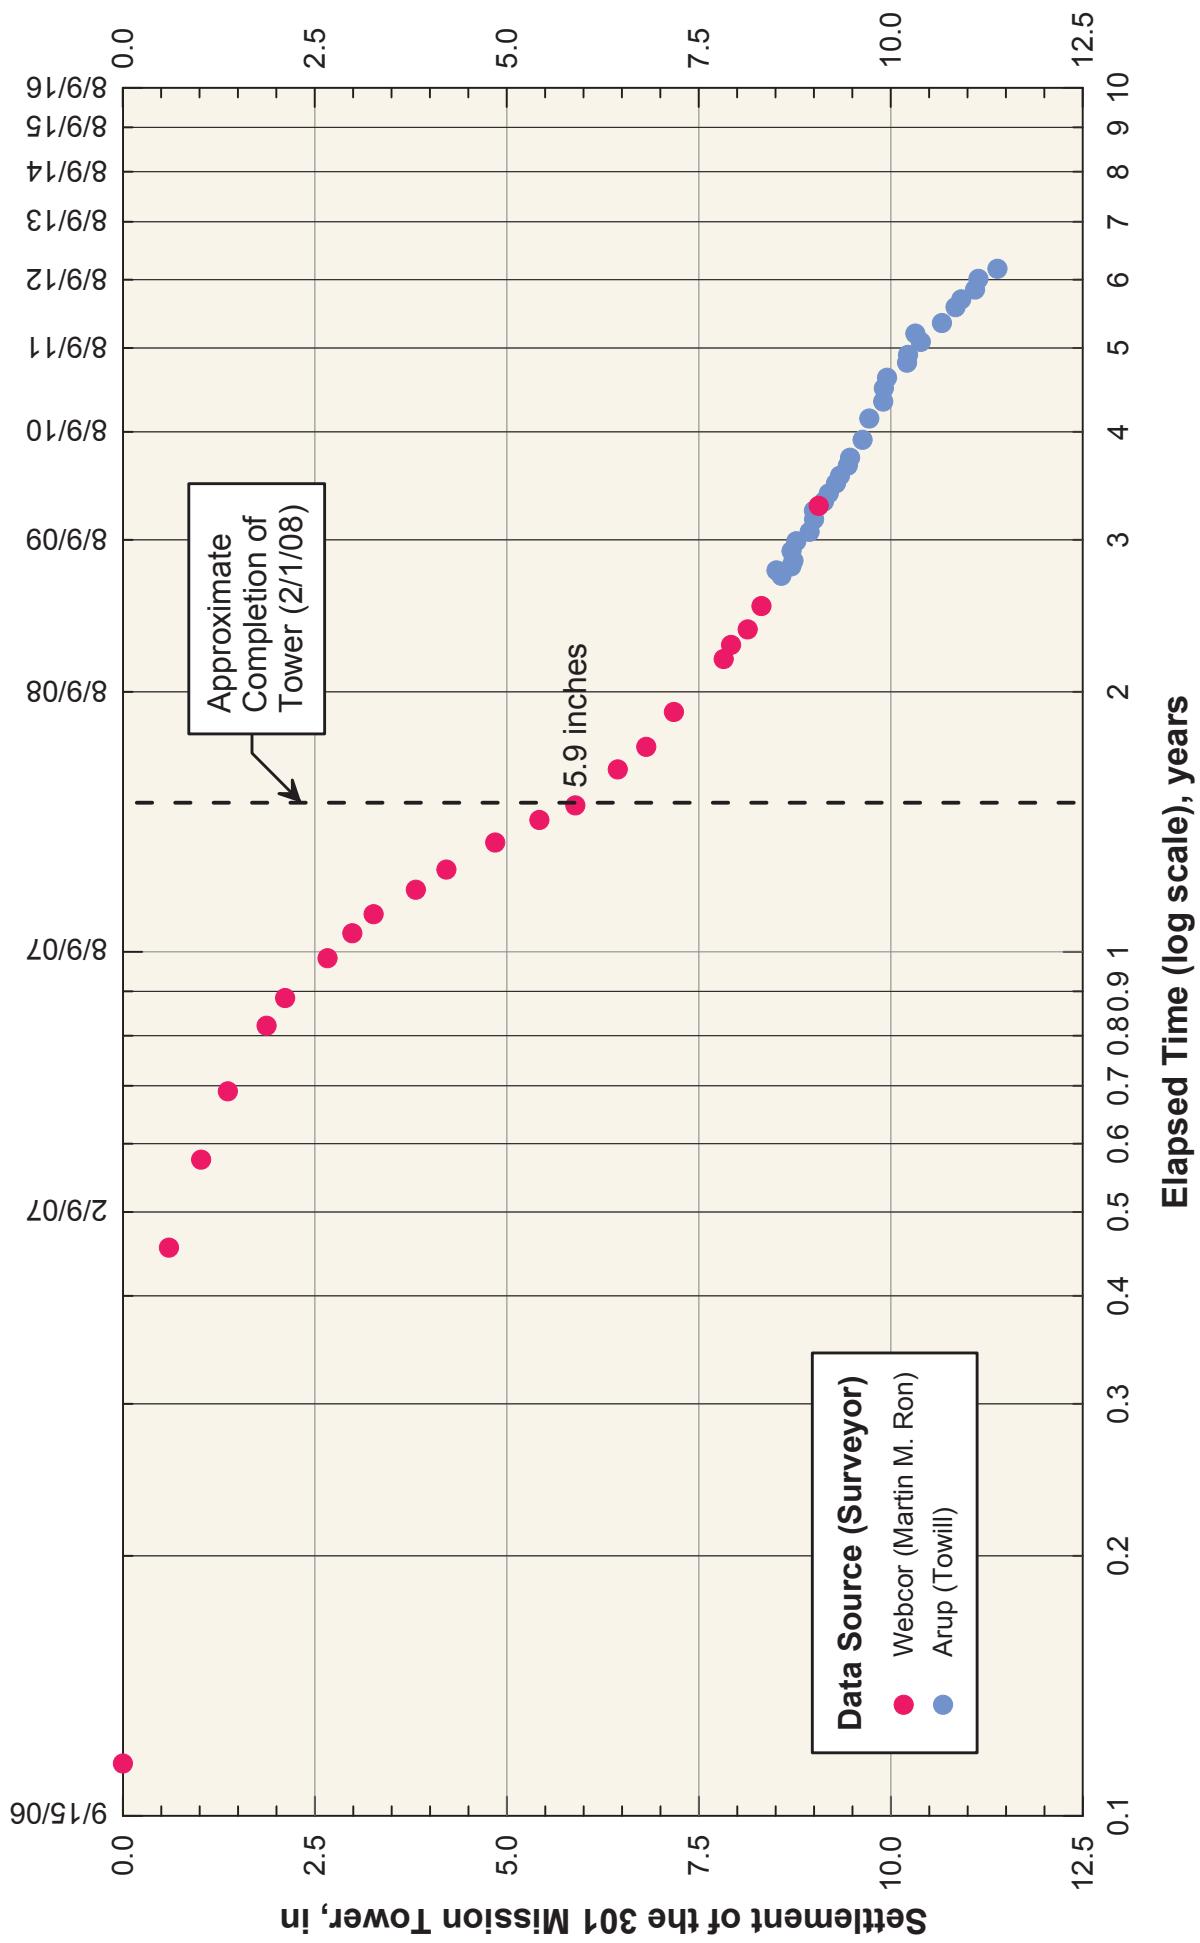

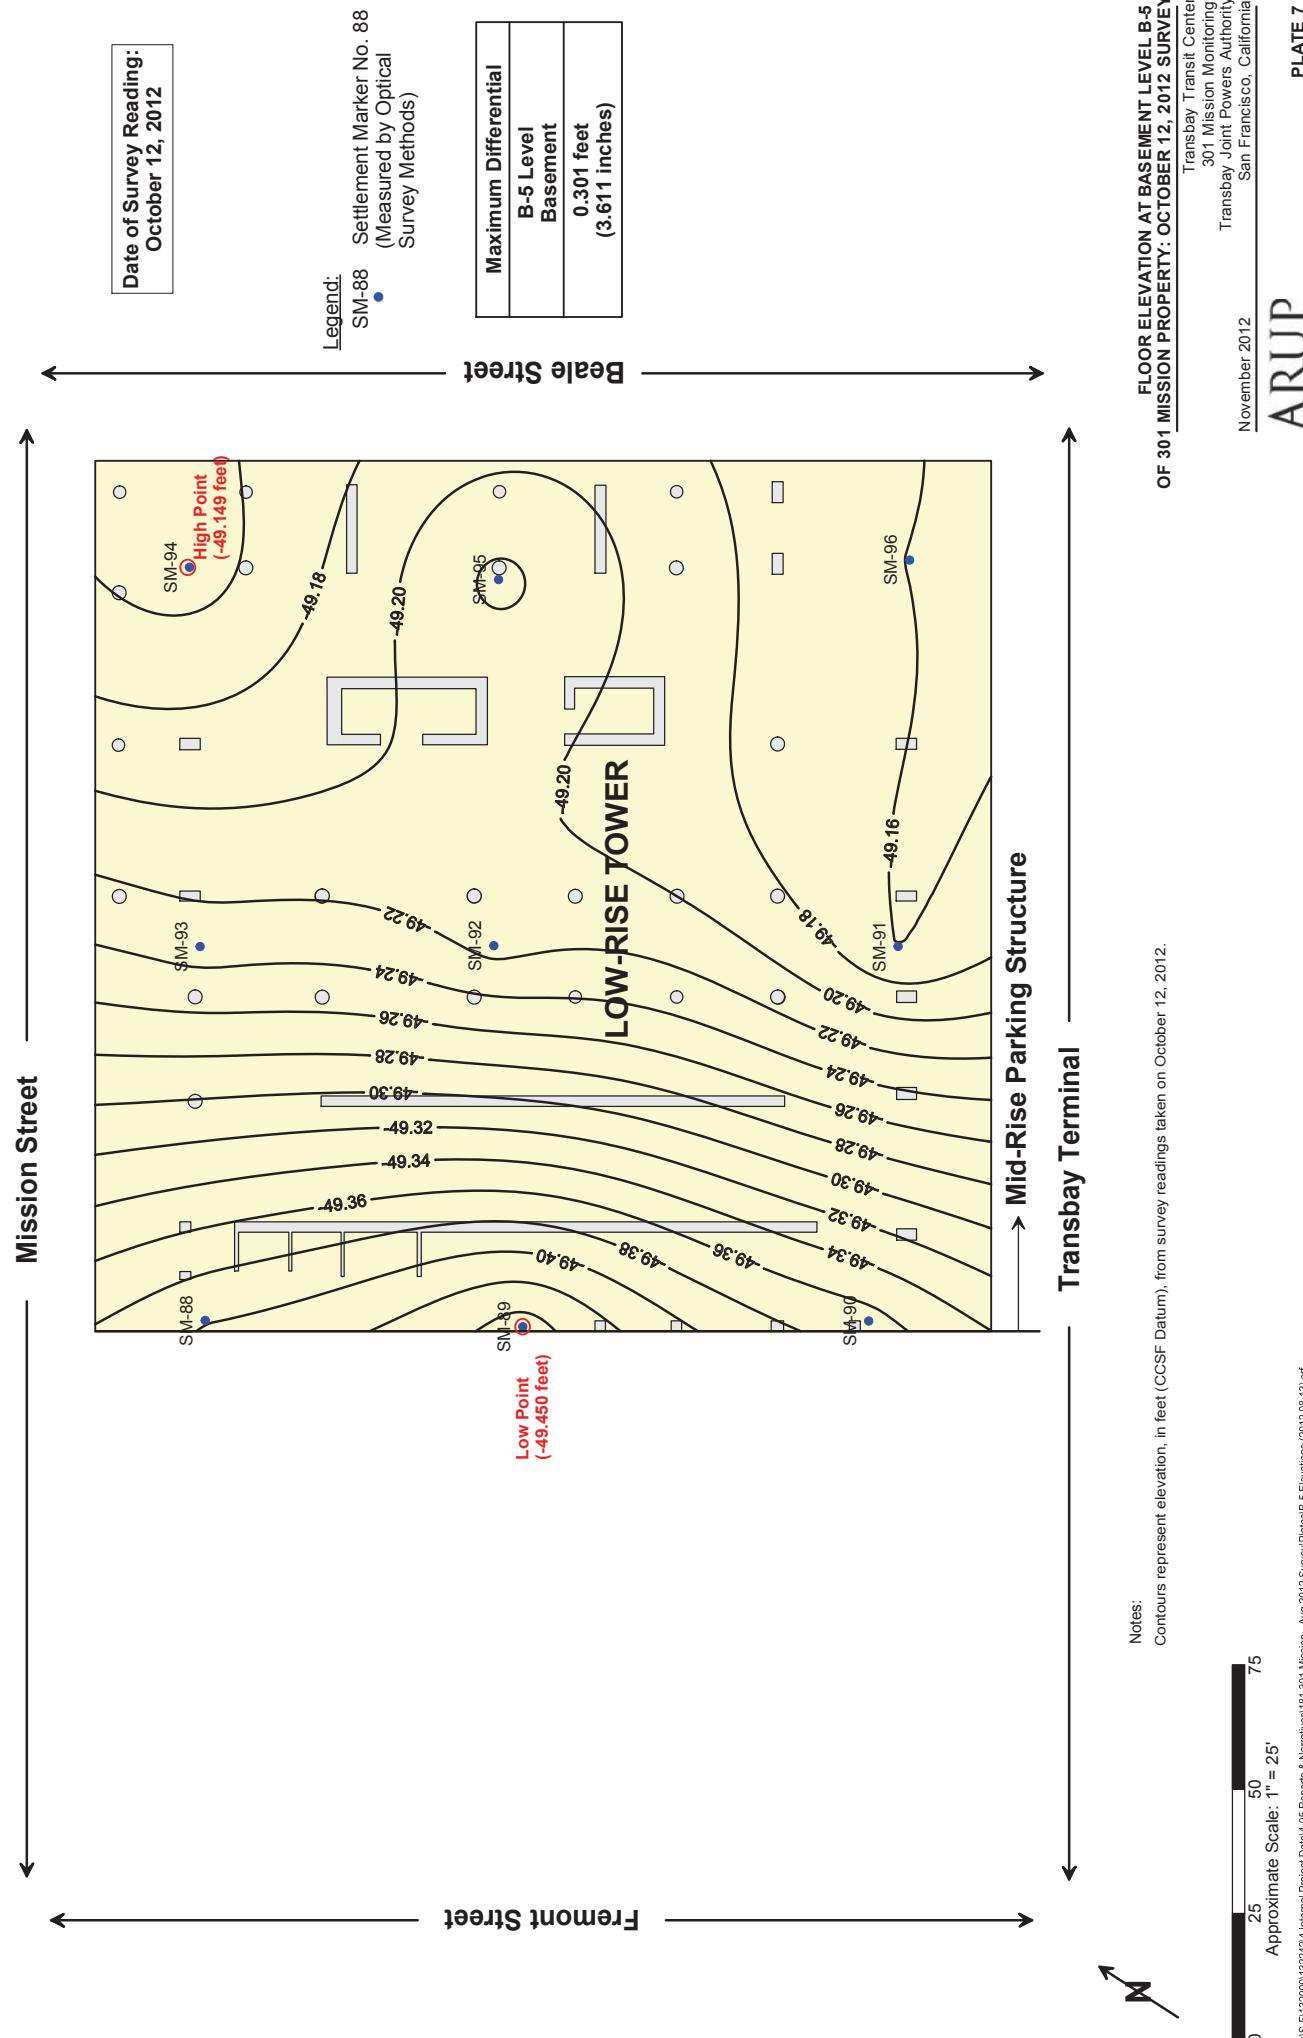

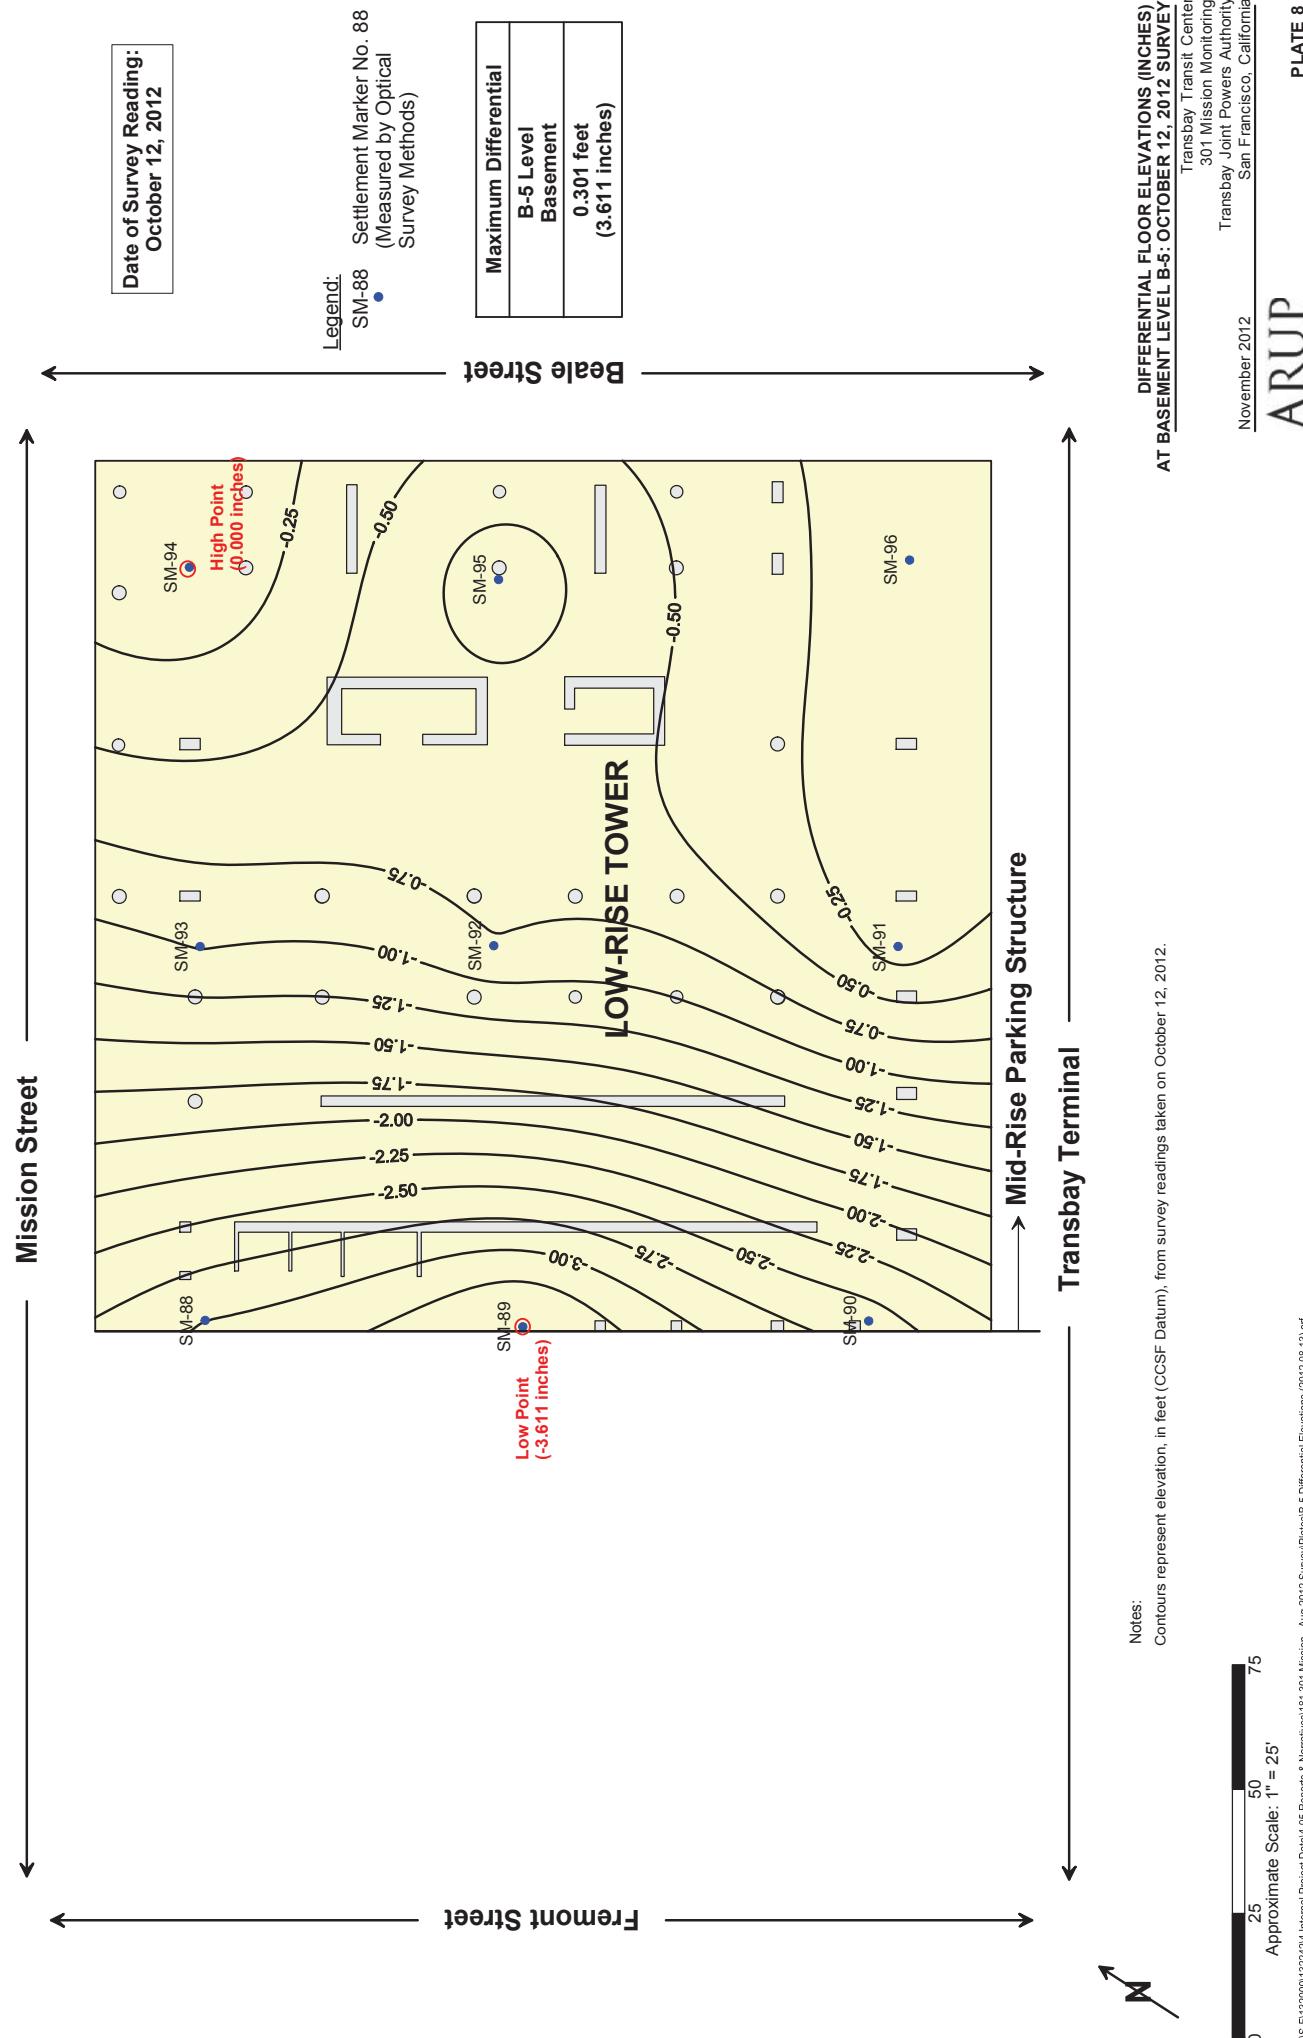

From: Brian Dykes <bdykes@transbaycenter.org>
Sent: Monday, January 28, 2013 3:12 PM
To: Steven Hood
Cc: Robert Beck; Nila Gonzales
Subject: December Settlement Readings at 301 Mission Street
Attachments: 2013-01-17 Memo_301 Mission Settlement - Dec 2012 Survey.pdf

Steve,
Attached is the report of the settlement readings up to the latest survey taken on December 26, 2012.
The next readings are scheduled to be taken in February 2013.
Brian.

Brian Dykes
Principal Engineer
Transbay Joint Powers Authority
201 Mission Street, Suite 2100
San Francisco, CA 94105
415 597 4617 phone
415 597 4615 fax

Check out our progress at <http://transbaycenter.org/construction-updates/construction-cameras>

NOTE: This e-mail communication and any attachments hereto are covered by the Electronic Communications Privacy Act, 18 U.S.C. Sections 2510-2521, and are legally privileged. The information contained herein is confidential, and is intended only for the use of the individual or entity to whom it is addressed. If you are not the intended recipient of this e-mail communication (or an employee or agent responsible for delivering this communication to its intended recipient(s)), you are hereby notified that any retention, copying or further distribution of this e-mail communication and any attachments is strictly prohibited. If you are not the intended recipient, please notify the sender by telephoning 415-597-4620, or by forwarding an e-mail reply message addressed to TransAdmin@TransbayCenter.org confirming that you have already destroyed (deleted) the original e-mail communication and any and all copies thereof. Thank you.

Memorandum


ARUP

To	Brian Dykes (TJPA)	Date
		17 January 2013
Copies	Robert Beck (TJPA) Emilio Cruz (PMPC) Randy Volenec (PCPA) George Metzger (AAI)	Reference number 132242-60/SMM
From	Stephen McLandrich (Arup)	File reference 4-05 195
Subject	Transbay Transit Center: Results of December 2012 Settlement Survey at 301 Mission Property	Page 1 of 1

Under Arup's Geotechnical Contract with the Transbay Joint Powers Authority through Pelli Clark Pelli Architects, Arup is required to monitor the settlements of the buildings adjacent to the Transbay Transit Center prior to and during construction. We began the monitoring program for the 301 Mission property in April of 2009. This memorandum and the attached plates present an update to our memorandum dated November 6, 2012 with measurements made through December 2012.

List of Plates


- Plate 1 Floor Elevations at Level B-1 of 301 Mission Property: Periodic Survey – December 26, 2012
- Plate 2 Differential Floor Elevation (Inches) – December 26, 2012 Survey
- Plate 3 Contours of Settlements Measured at the First Level Basement of the 301 Mission Street Structure Between April 30, 2009 and December 26, 2012
- Plate 4 Settlement Over Time Floor Elevations at Level B-1 of 301 Mission Property – Tower: April 30, 2009 through December 26, 2012.
- Plate 5 Settlement Over Time Floor Elevations at Level B-1 of 301 Mission Property – Mid-Rise: April 30, 2009 through December 26, 2012
- Plate 6 Settlements of the 301 Mission Tower Including Monitoring During Construction
- Plate 7 Floor Elevation at Basement Level B-5 of 301 Mission Property: December 26, 2012 Survey
- Plate 8 Differential Floor Elevations (Inches) at Basement Level B-5: December 26, 2012 Survey

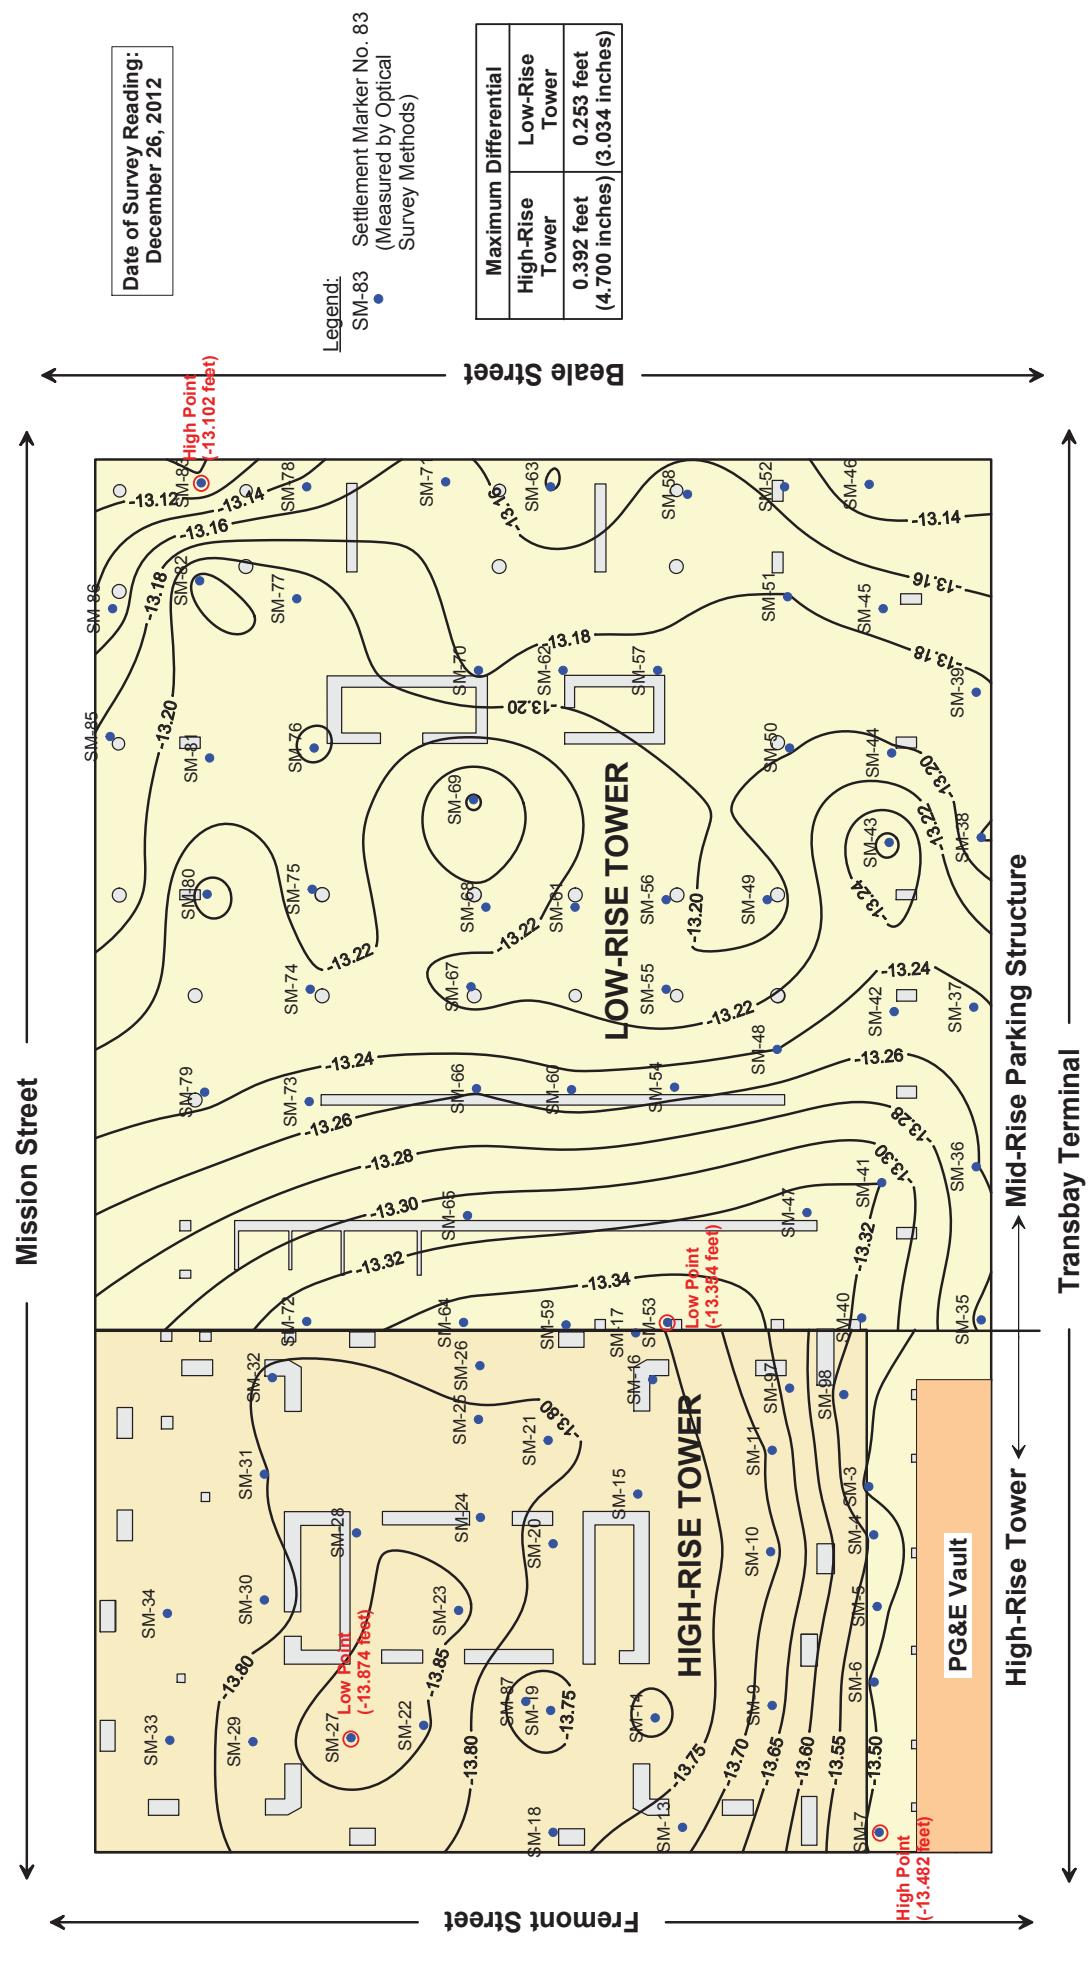


**FLOOR ELEVATIONS AT LEVEL B-1
OF 301 MISSION PROPERTY:
PERIODIC SURVEY - DECEMBER 26, 2012**

Transbay Transit Center
301 Mission Monitoring
Transbay Joint Powers Authority
San Francisco, California

January 2013

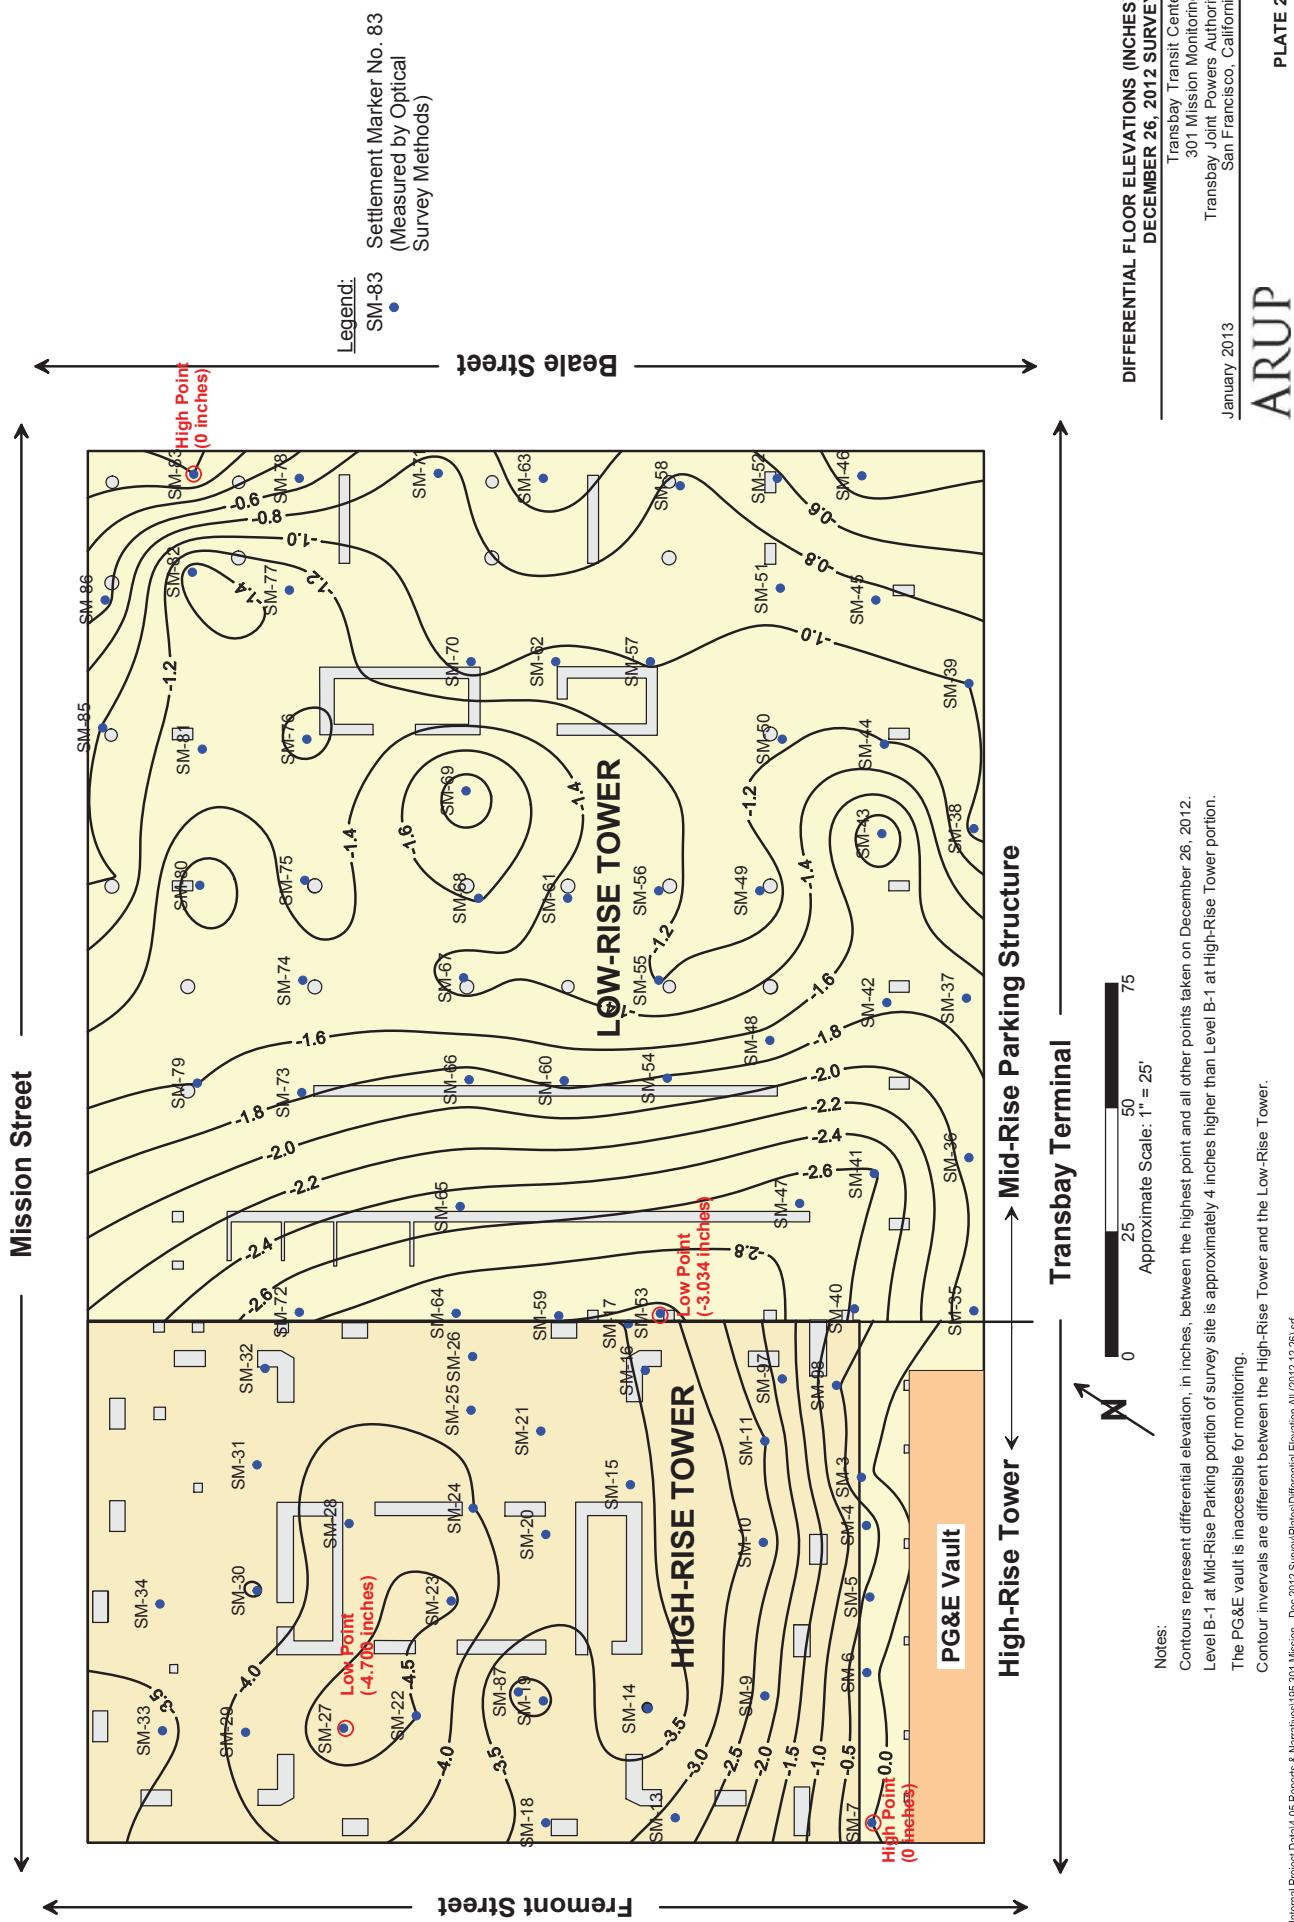

J-IVS-F-1132000/13224/2 Internal Project Data\4-05 Reports & Narratives\115_301 Mission - Dec 2012 SurveyPlates\DiffElevation All (2012-12-26).scr

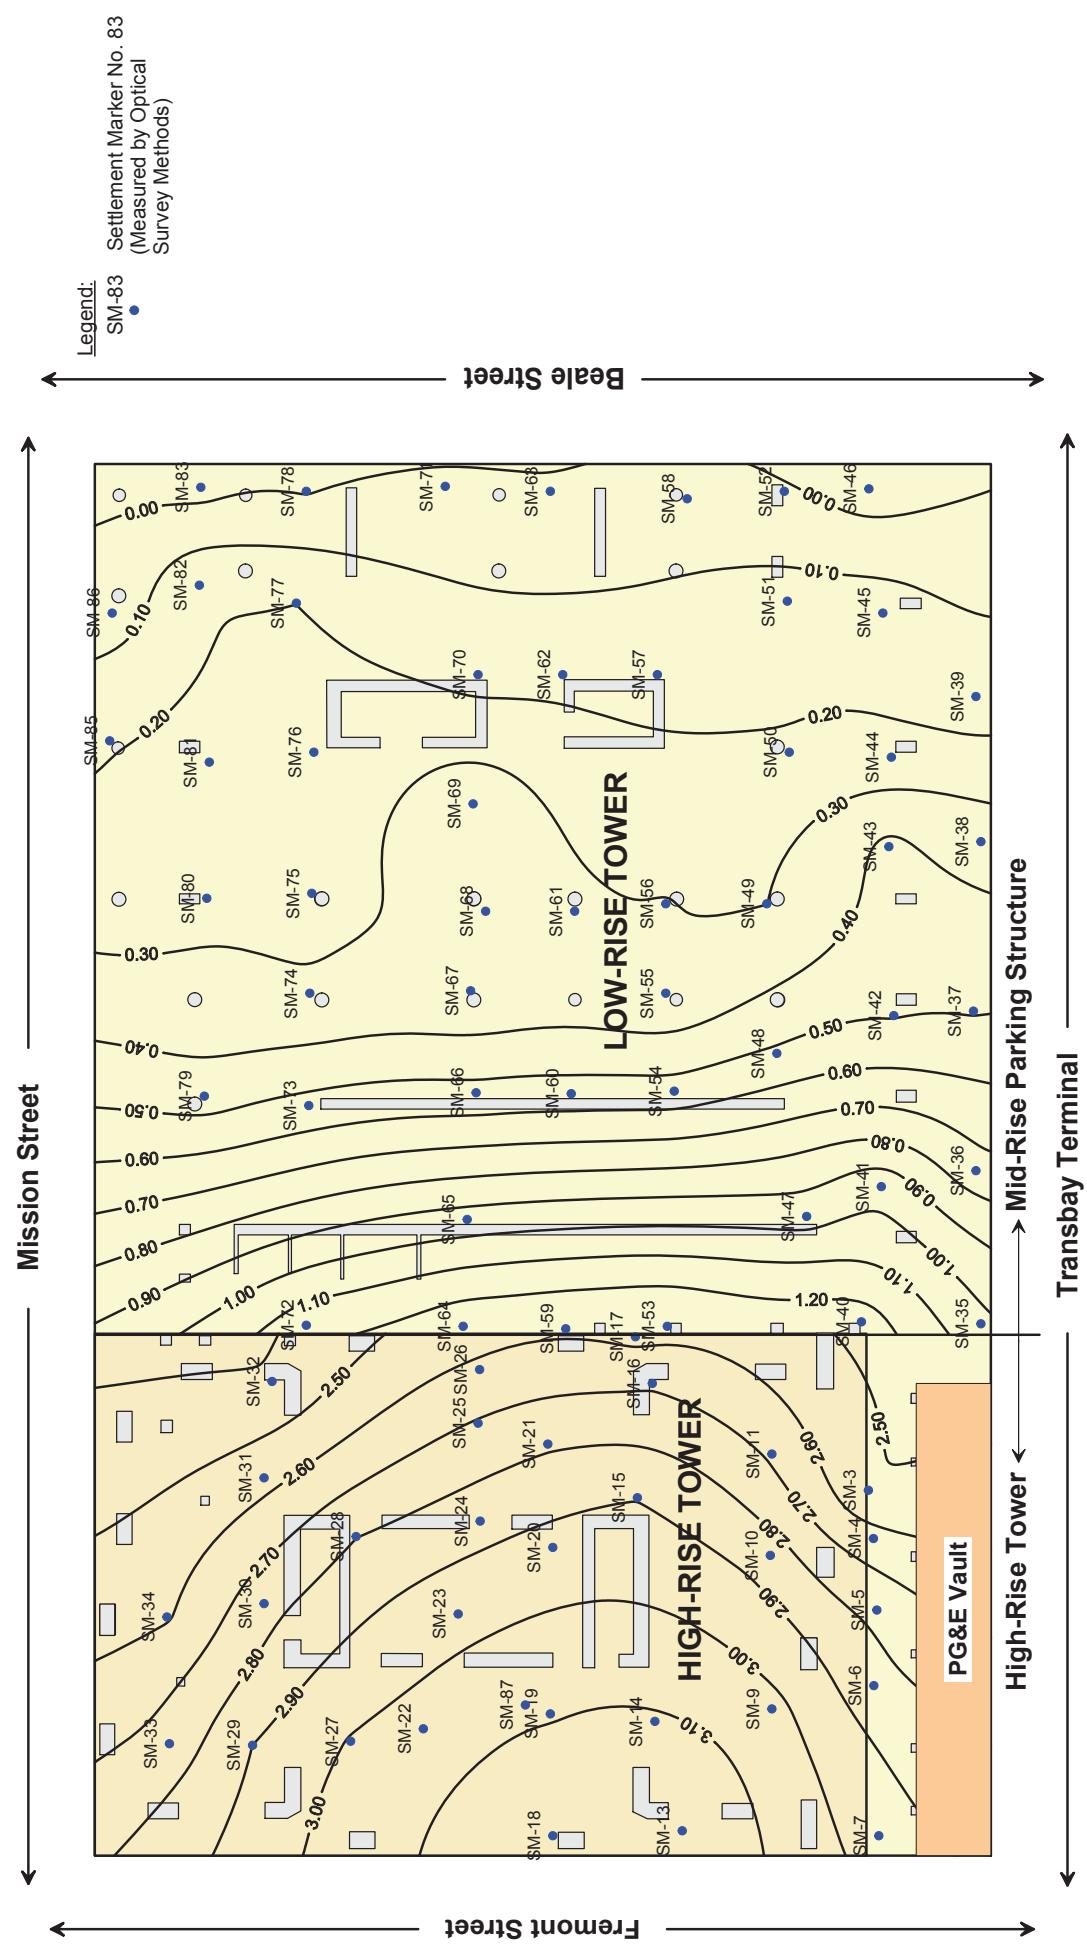

CONTOURS OF SETTLEMENTS MEASURED AT THE FIRST LEVEL BASEMENT OF THE 301 MISSION STREET STRUCTURE BETWEEN APRIL 30, 2009 AND DEC 26, 2012

Transbay Transit Center
301 Mission Monitoring
Transbay Joint Powers Authority
San Francisco, California

PLATE 3



ARUP

USF112000132424 Internal Project Data405 Reports & Narratives\195 301 Mission - Dec 2012 Survey\2012 Settlem...

Approximate Scale: 1" = 25'

Notes:
Contours represent elevation change, in inches, between Baseline survey (April 30, 2009) and readings taken on December 26, 2012.
Level B-1 at Mid-Rise Parking portion of survey site is approximately 4 inches higher than Level B-1 at High-Rise Tower portion.
The PG&E vault is inaccessible for monitoring.
Negative values of settlement (within Low-rise Tower) indicate uplift.

January 2013

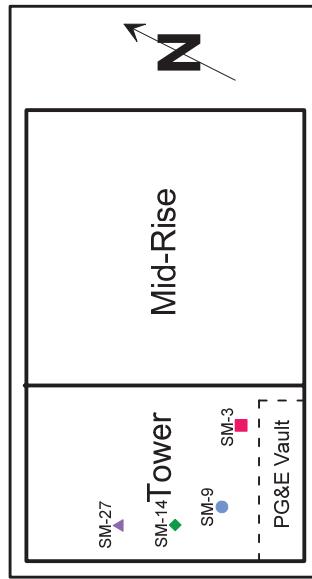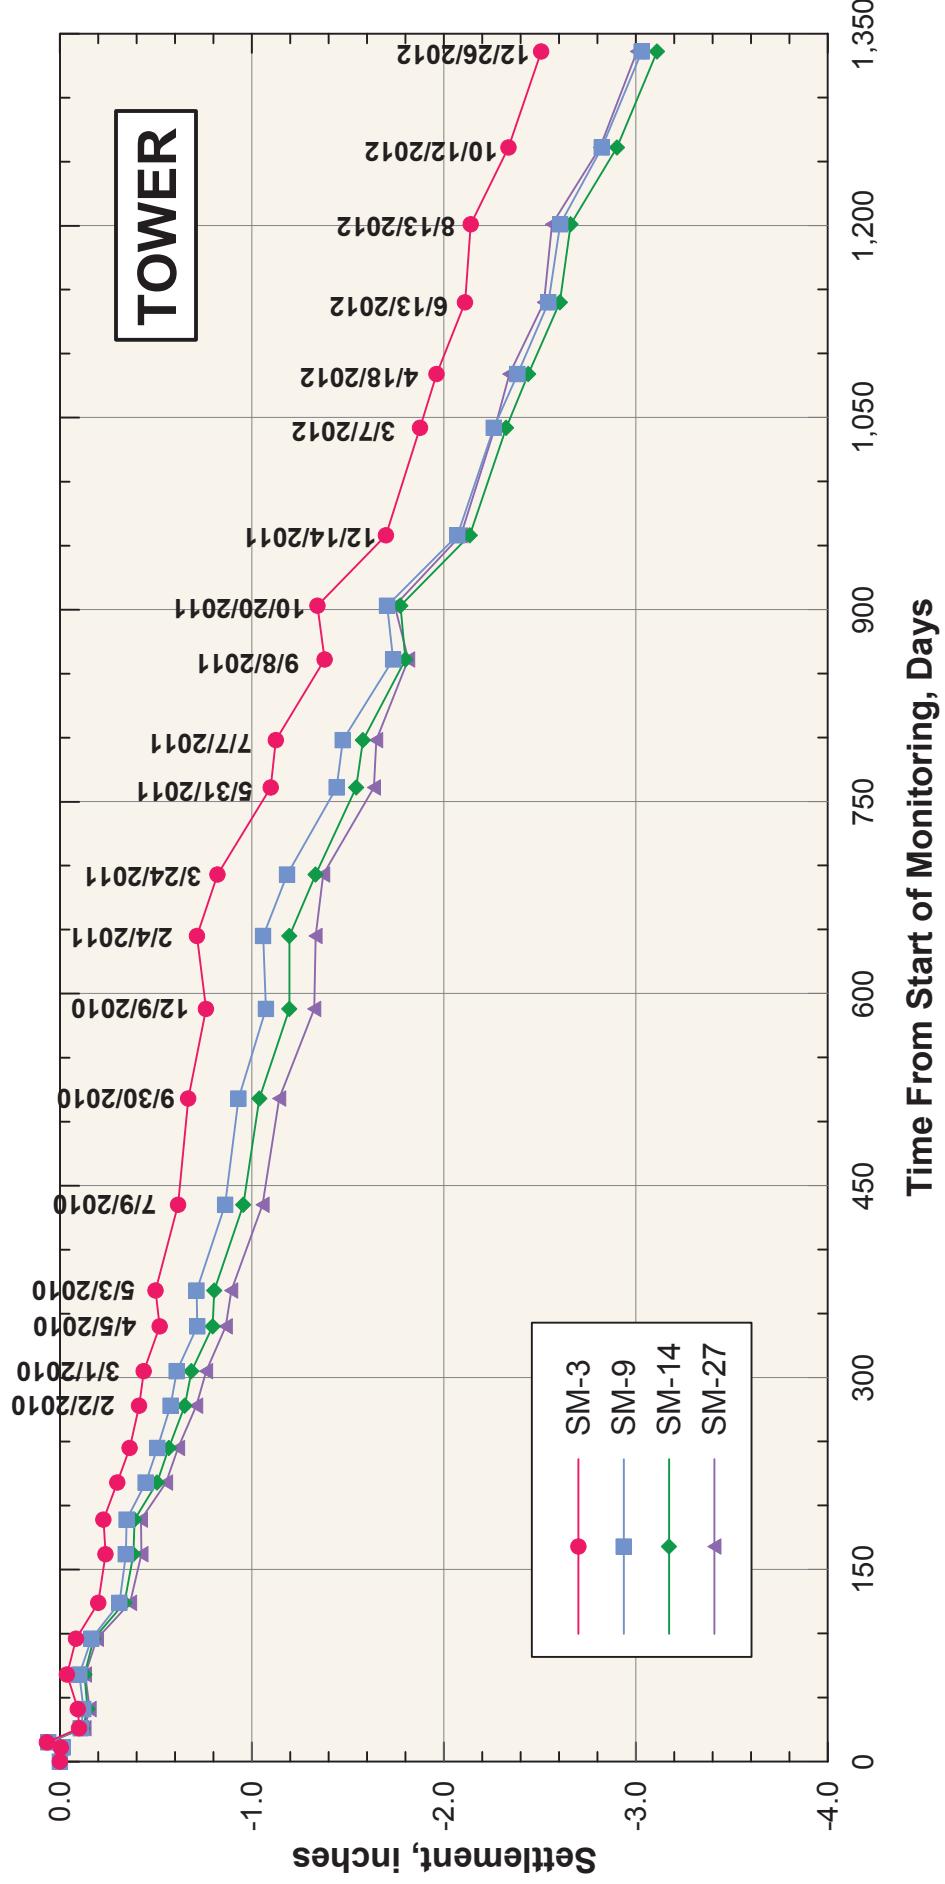

SETTLEMENT OVER TIME
FLOOR ELEVATIONS AT LEVEL B-1
OF 301 MISSION PROPERTY - TOWER:
APRIL 30, 2009 THROUGH DECEMBER 26, 2012

Transbay Transit Center
301 Mission Monitoring
Transbay Joint Powers Authority
San Francisco, California

January 2013

ARUP



ARUP

Note:
Initial (Baseline) reading
taken on 04/30/09


J:\\S:\\FV\\13224214 Internal Project Data\\4-05 Reports & Narratives\\195 301 Mission - Dec 2012 Survey\\Plates\\Plate 5 Settlement Over Time - Midrise.grf

**SETTLEMENT OVER TIME
FLOOR ELEVATIONS AT LEVEL B-1
OF 301 MISSION PROPERTY - MID-RISE:
APRIL 30, 2009 THROUGH DECEMBER 26, 2012**

Transbay Transit Center
301 Mission Monitoring
Transbay Joint Powers Authority
San Francisco, California

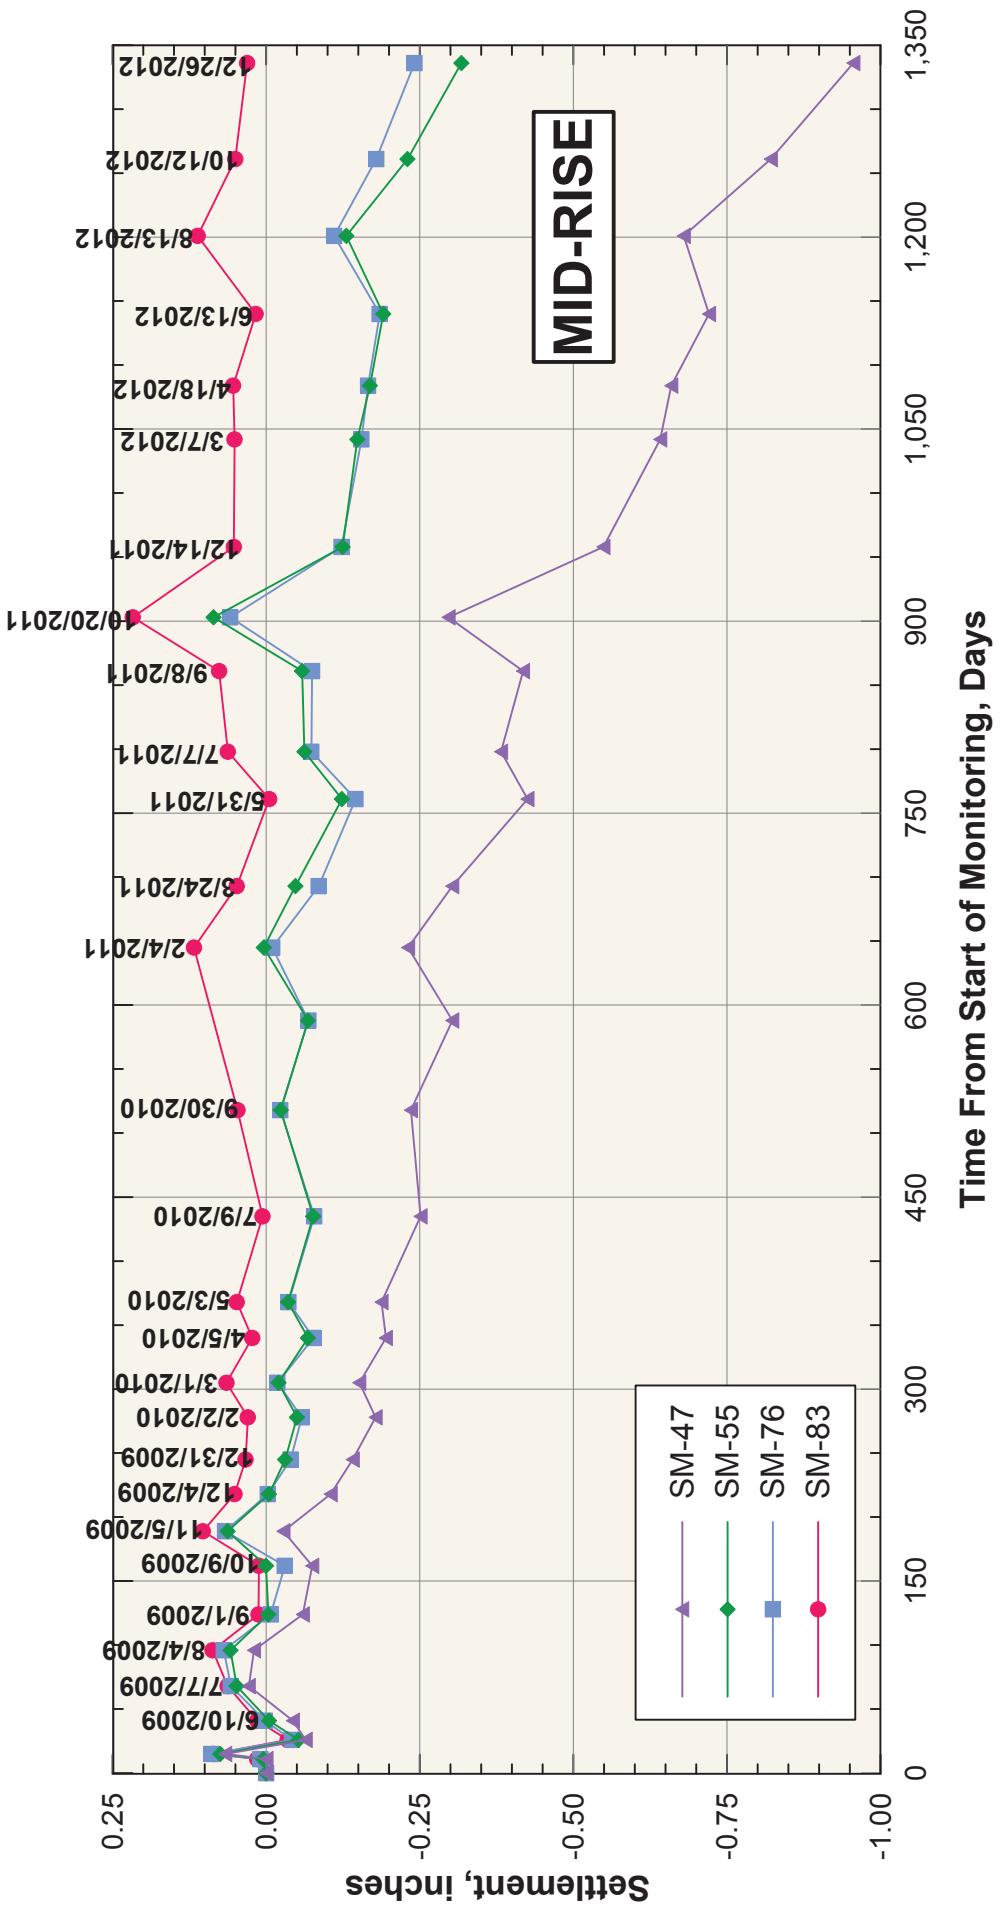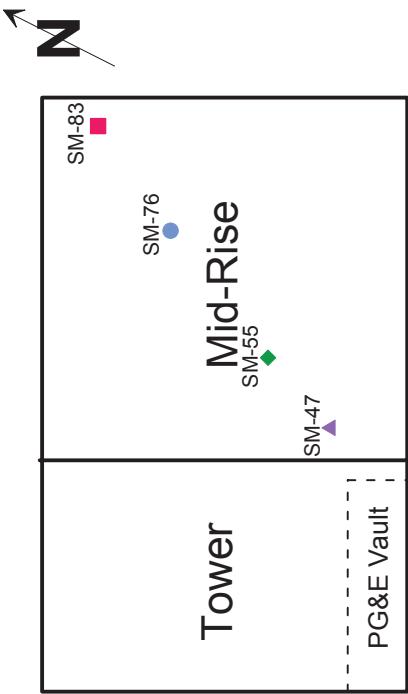

January 2013

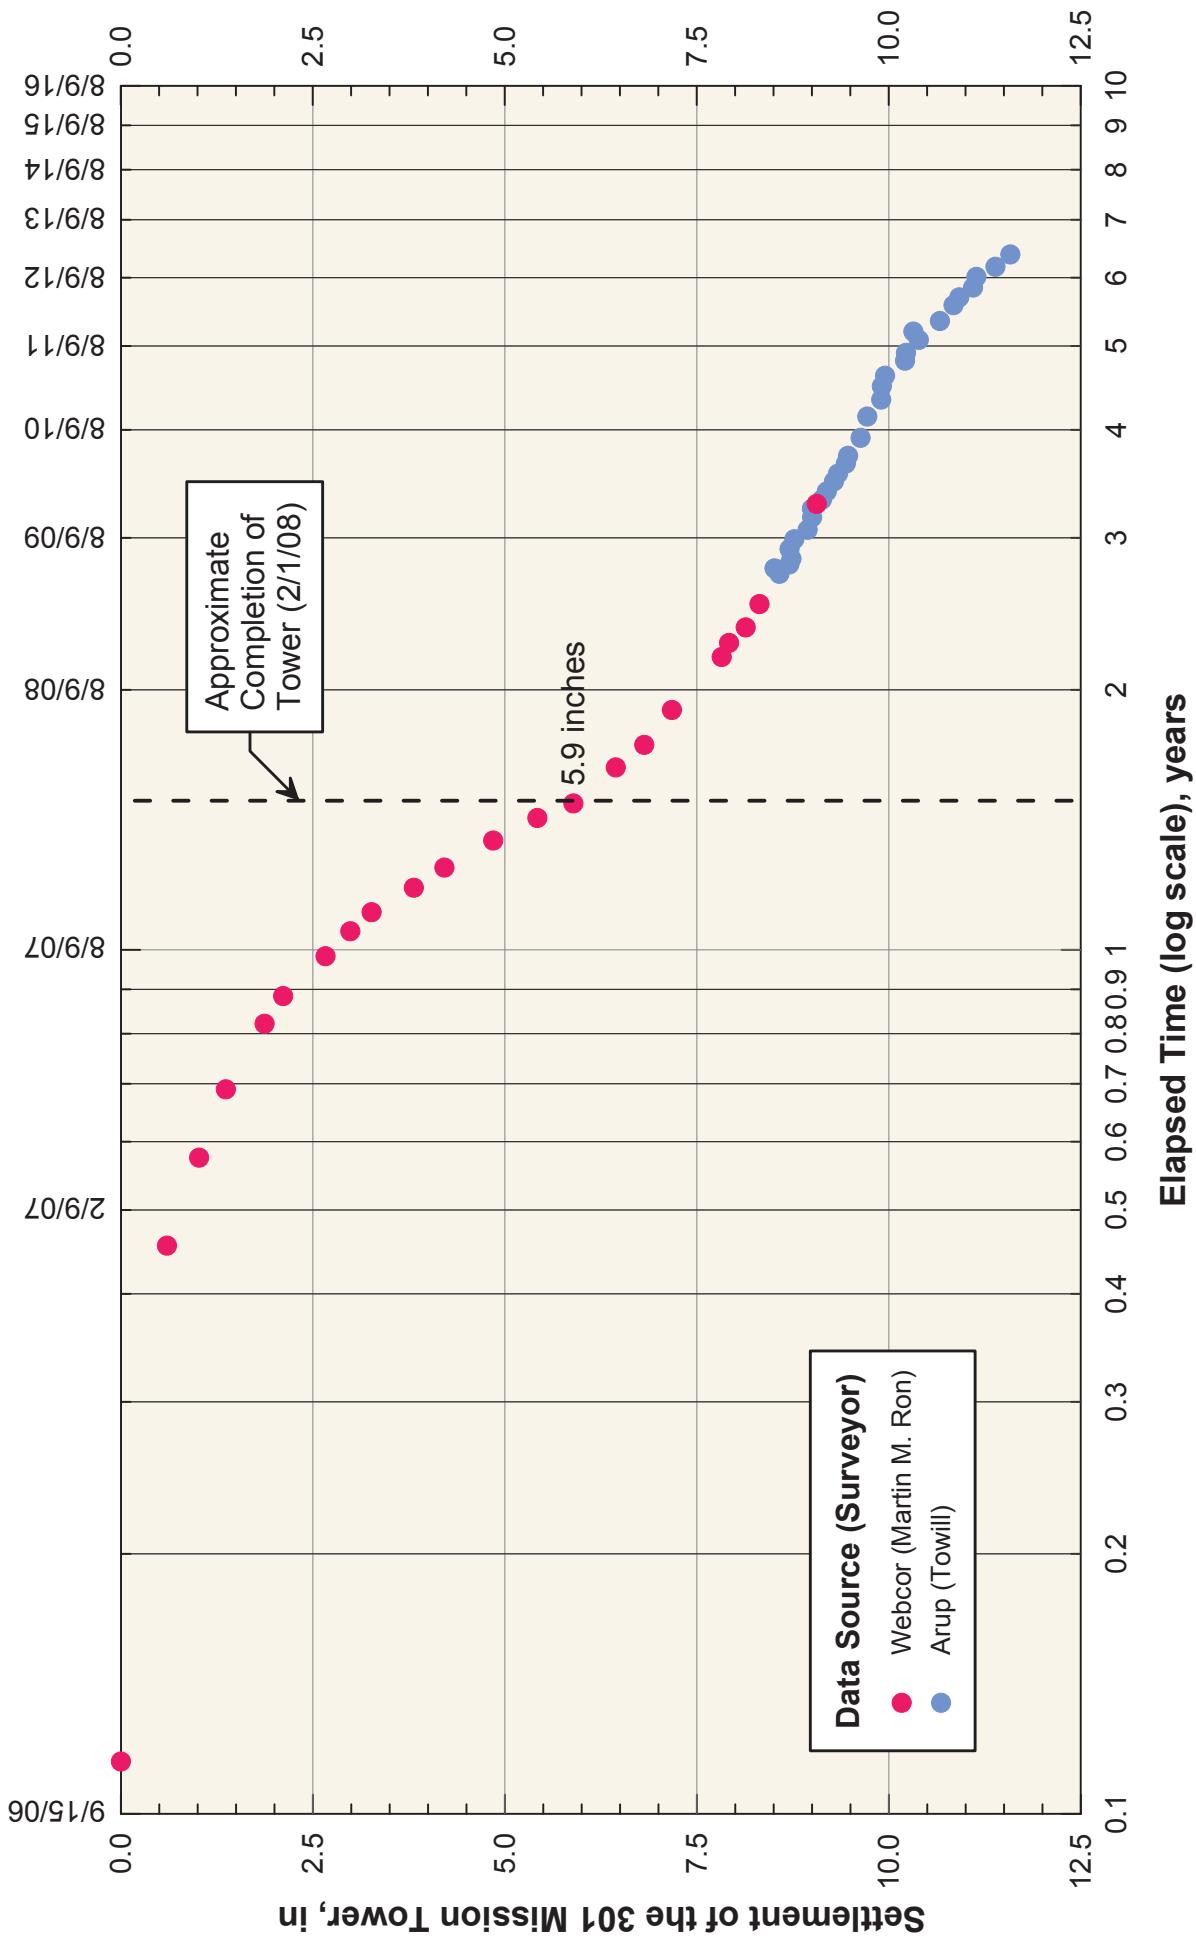



**SETTLEMENTS OF THE 301 MISSION TOWER
INCLUDING MONITORING DURING CONSTRUCTION**

Transbay Transit Center
301 Mission Monitoring
Transbay Joint Powers Authority
San Francisco, California

January 2013

Beginning of Tower Construction: 8/9/06
End of Tower Construction: 2/1/08
Construction Duration: 542 days (1.5 years)

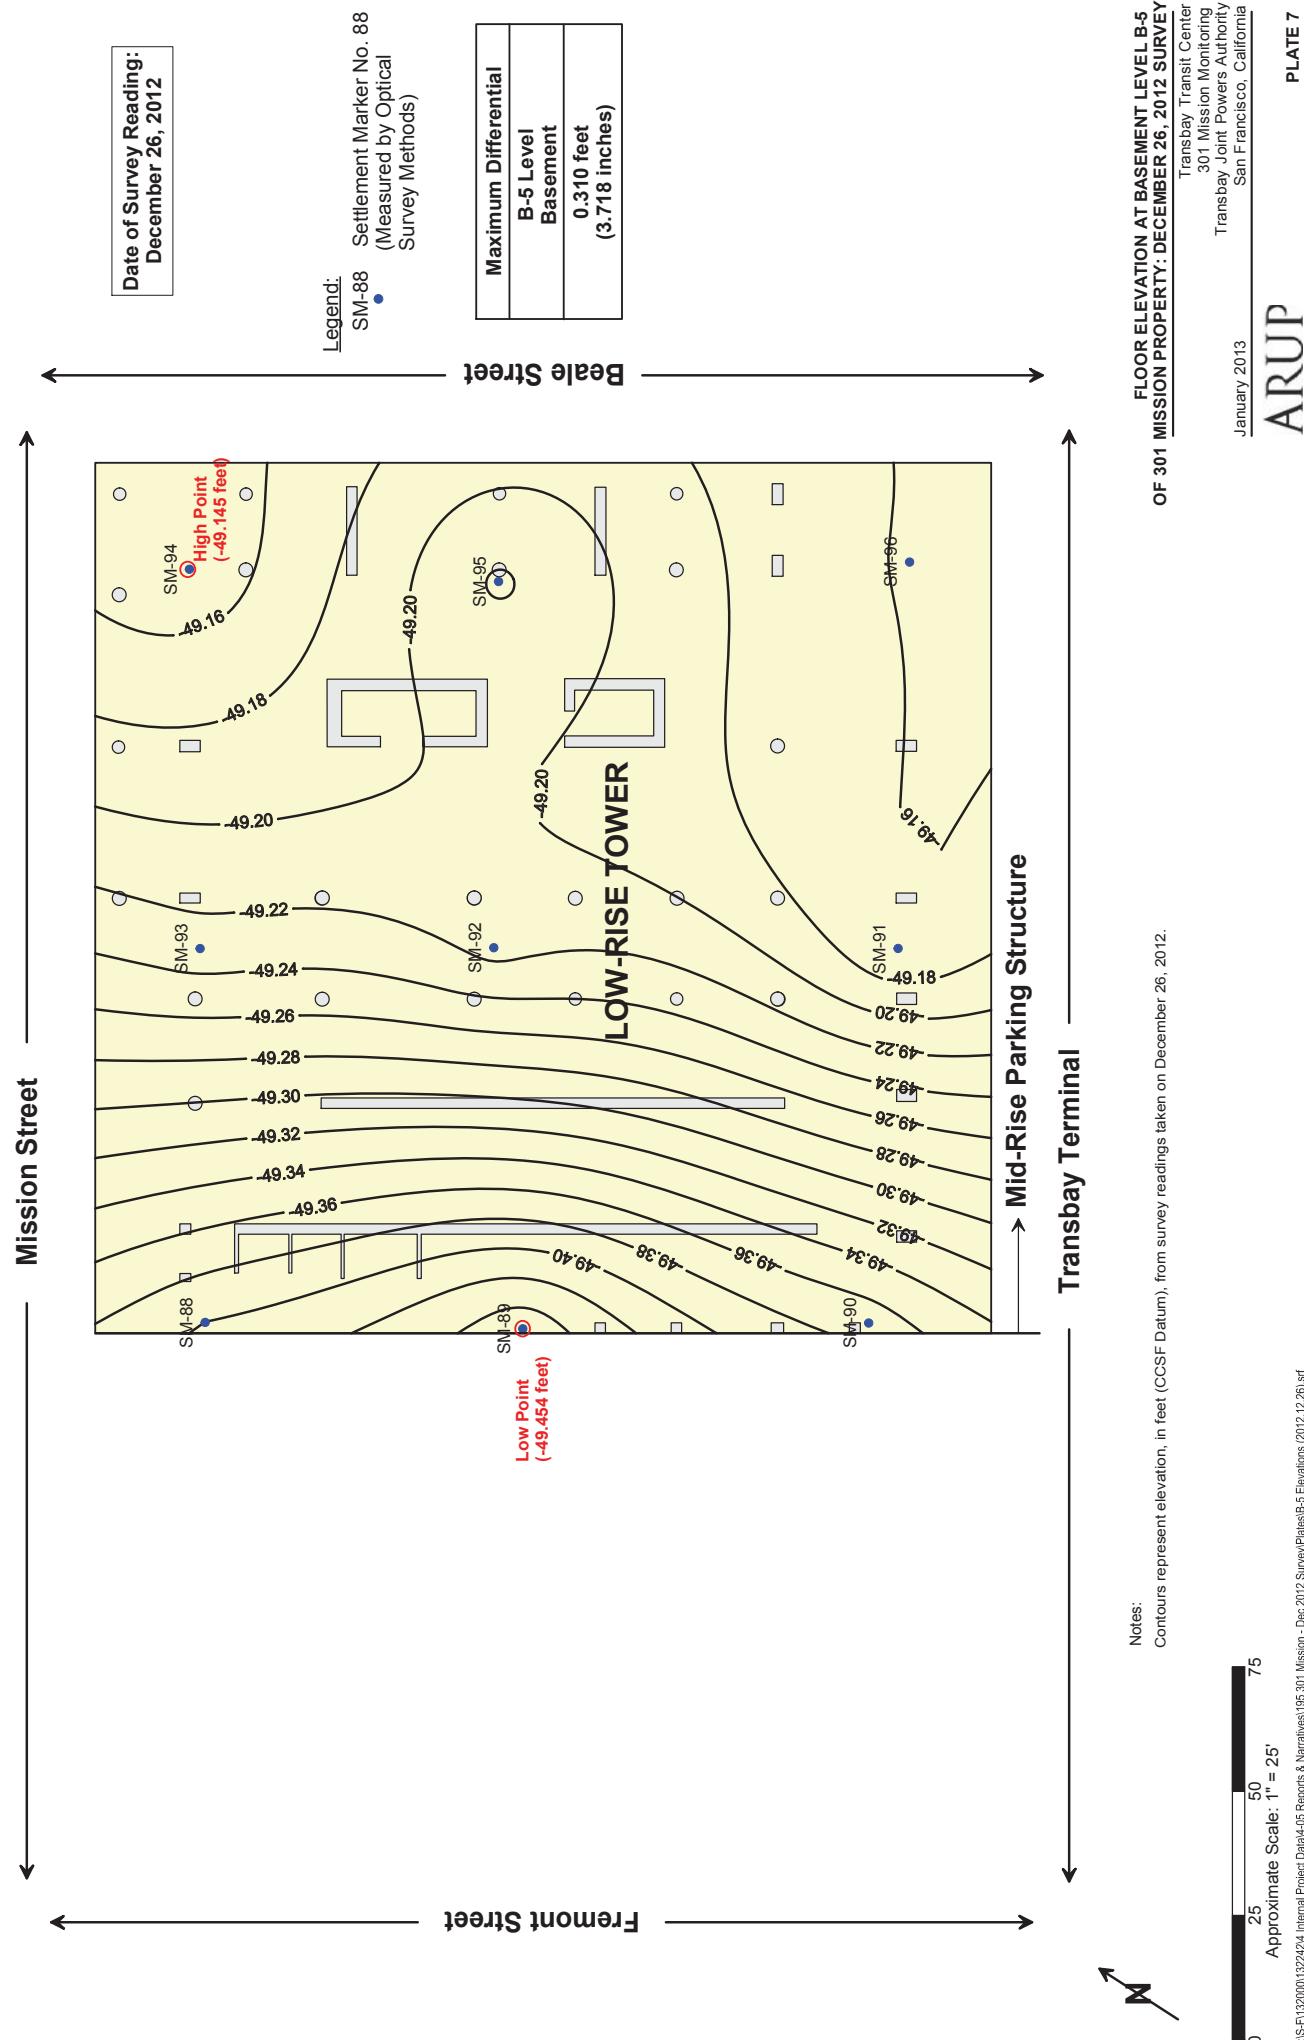

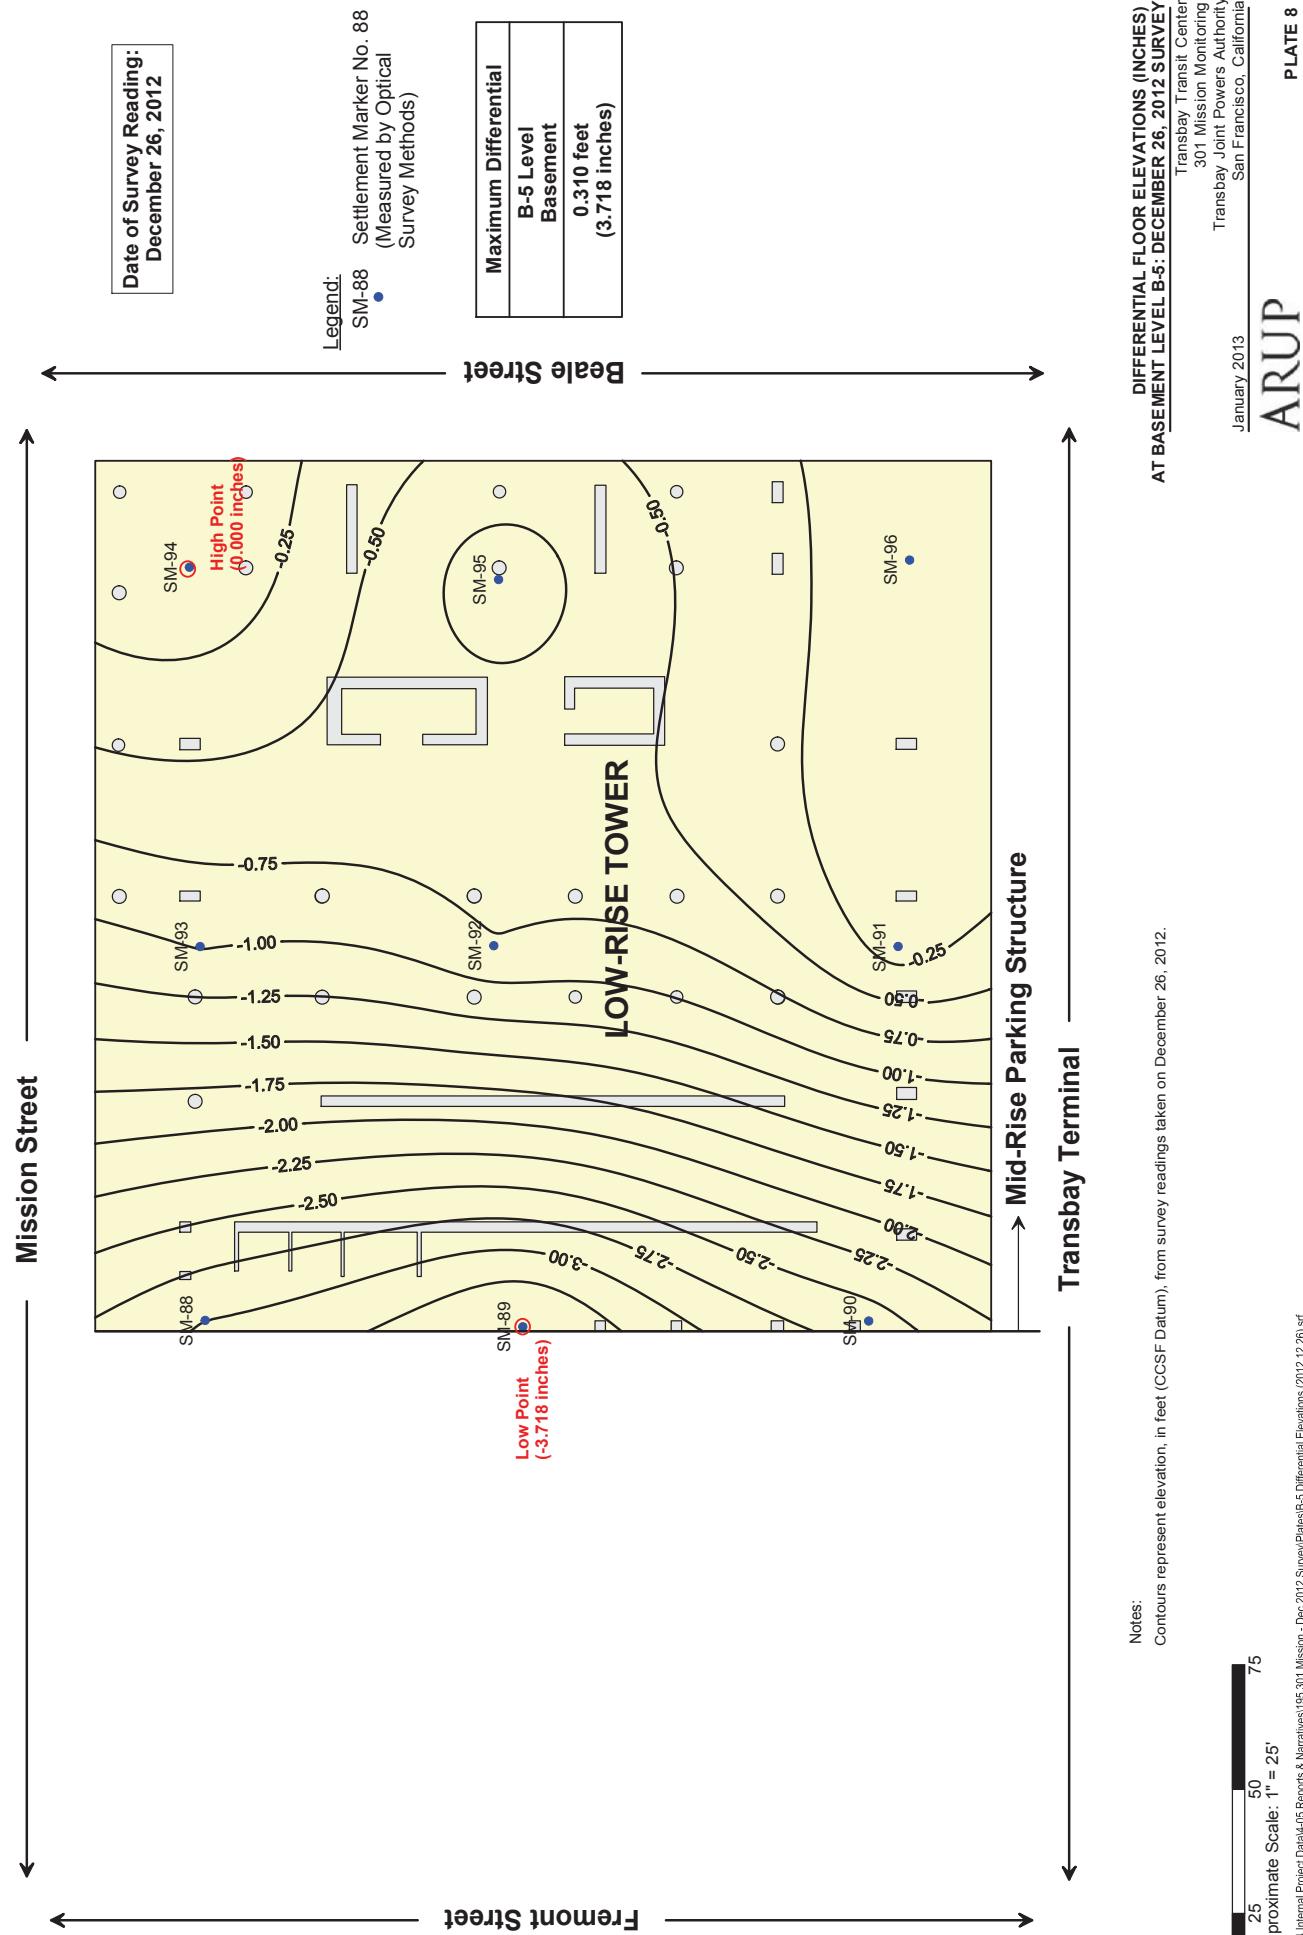

JIS-F132000132424, Internal Project Plan 405 Reports & Narratives 195.301 Mission - Dec 2012 Survey/Pilot B-5 Differential Elevation (2012.12.26).smf
 0 25 50 75
 Approximate Scale: 1" = 25'

From: Brian Dykes <bdykes@transbaycenter.org>
Sent: Monday, June 17, 2013 1:46 PM
To: Steven Hood
Cc: Dennis Turchon; Robert Beck
Subject: 301 Mission Street Settlement Monitoring Feb/Mar 2013
Attachments: 2013-03-27 Memo_301 Mission Settlement - Feb 2013 Survey.pdf; 301 Mission Monitoring Survey 021313.xls

Steve,
Here are the survey monitoring readings of the raw data recorded on 2/13/13 and the memo from Arup dated 3/27/13.
Regards, Brian.

Brian Dykes
Principal Engineer
Transbay Joint Powers Authority
201 Mission Street, Suite 2100
San Francisco, CA 94105
415 597 4617 phone
415 597 4615 fax

Check out our progress at <http://transbaycenter.org/construction-updates/construction-cameras>

NOTE: This e-mail communication and any attachments hereto are covered by the Electronic Communications Privacy Act, 18 U.S.C. Sections 2510-2521, and are legally privileged. The information contained herein is confidential, and is intended only for the use of the individual or entity to whom it is addressed. If you are not the intended recipient of this e-mail communication (or an employee or agent responsible for delivering this communication to its intended recipient(s)), you are hereby notified that any retention, copying or further distribution of this e-mail communication and any attachments is strictly prohibited. If you are not the intended recipient, please notify the sender by telephoning 415-597-4620, or by forwarding an e-mail reply message addressed to TransAdmin@TransbayCenter.org confirming that you have already destroyed (deleted) the original e-mail communication and any and all copies thereof. Thank you.

Memorandum


ARUP

To	Brian Dykes (TJPA)	Date
		27 March 2013
Copies	Robert Beck (TJPA) Randy Volenec (PCPA) George Metzger (AAI)	Reference number 132242-60/SMM
From	Stephen McLandrich (Arup)	File reference 4-05 204
Subject	Transbay Transit Center: Results of February 2013 Settlement Survey at 301 Mission Property	Page 1 of 1

Under Arup's Geotechnical Contract with the Transbay Joint Powers Authority through Pelli Clark Pelli Architects, Arup is required to monitor the settlements of the buildings adjacent to the Transbay Transit Center prior to and during construction. We began the monitoring program for the 301 Mission property in April of 2009. This memorandum and the attached plates present an update to our memorandum dated January 17, 2013 with measurements made through February 2013.

List of Plates

- Plate 1 Floor Elevations at Level B-1 of 301 Mission Property: Periodic Survey – February 13, 2013
- Plate 2 Differential Floor Elevation (Inches) – February 13, 2013 Survey
- Plate 3 Contours of Settlements Measured at the First Level Basement of the 301 Mission Street Structure Between April 30, 2009 and February 13, 2013
- Plate 4 Settlement Over Time Floor Elevations at Level B-1 of 301 Mission Property – Tower: April 30, 2009 through February 13, 2013
- Plate 5 Settlement Over Time Floor Elevations at Level B-1 of 301 Mission Property – Mid-Rise: April 30, 2009 through February 13, 2013
- Plate 6 Settlements of the 301 Mission Tower Including Monitoring During Construction
- Plate 7 Floor Elevation at Basement Level B-5 of 301 Mission Property: February 13, 2013 Survey
- Plate 8 Differential Floor Elevations (Inches) at Basement Level B-5: February 13, 2013 Survey

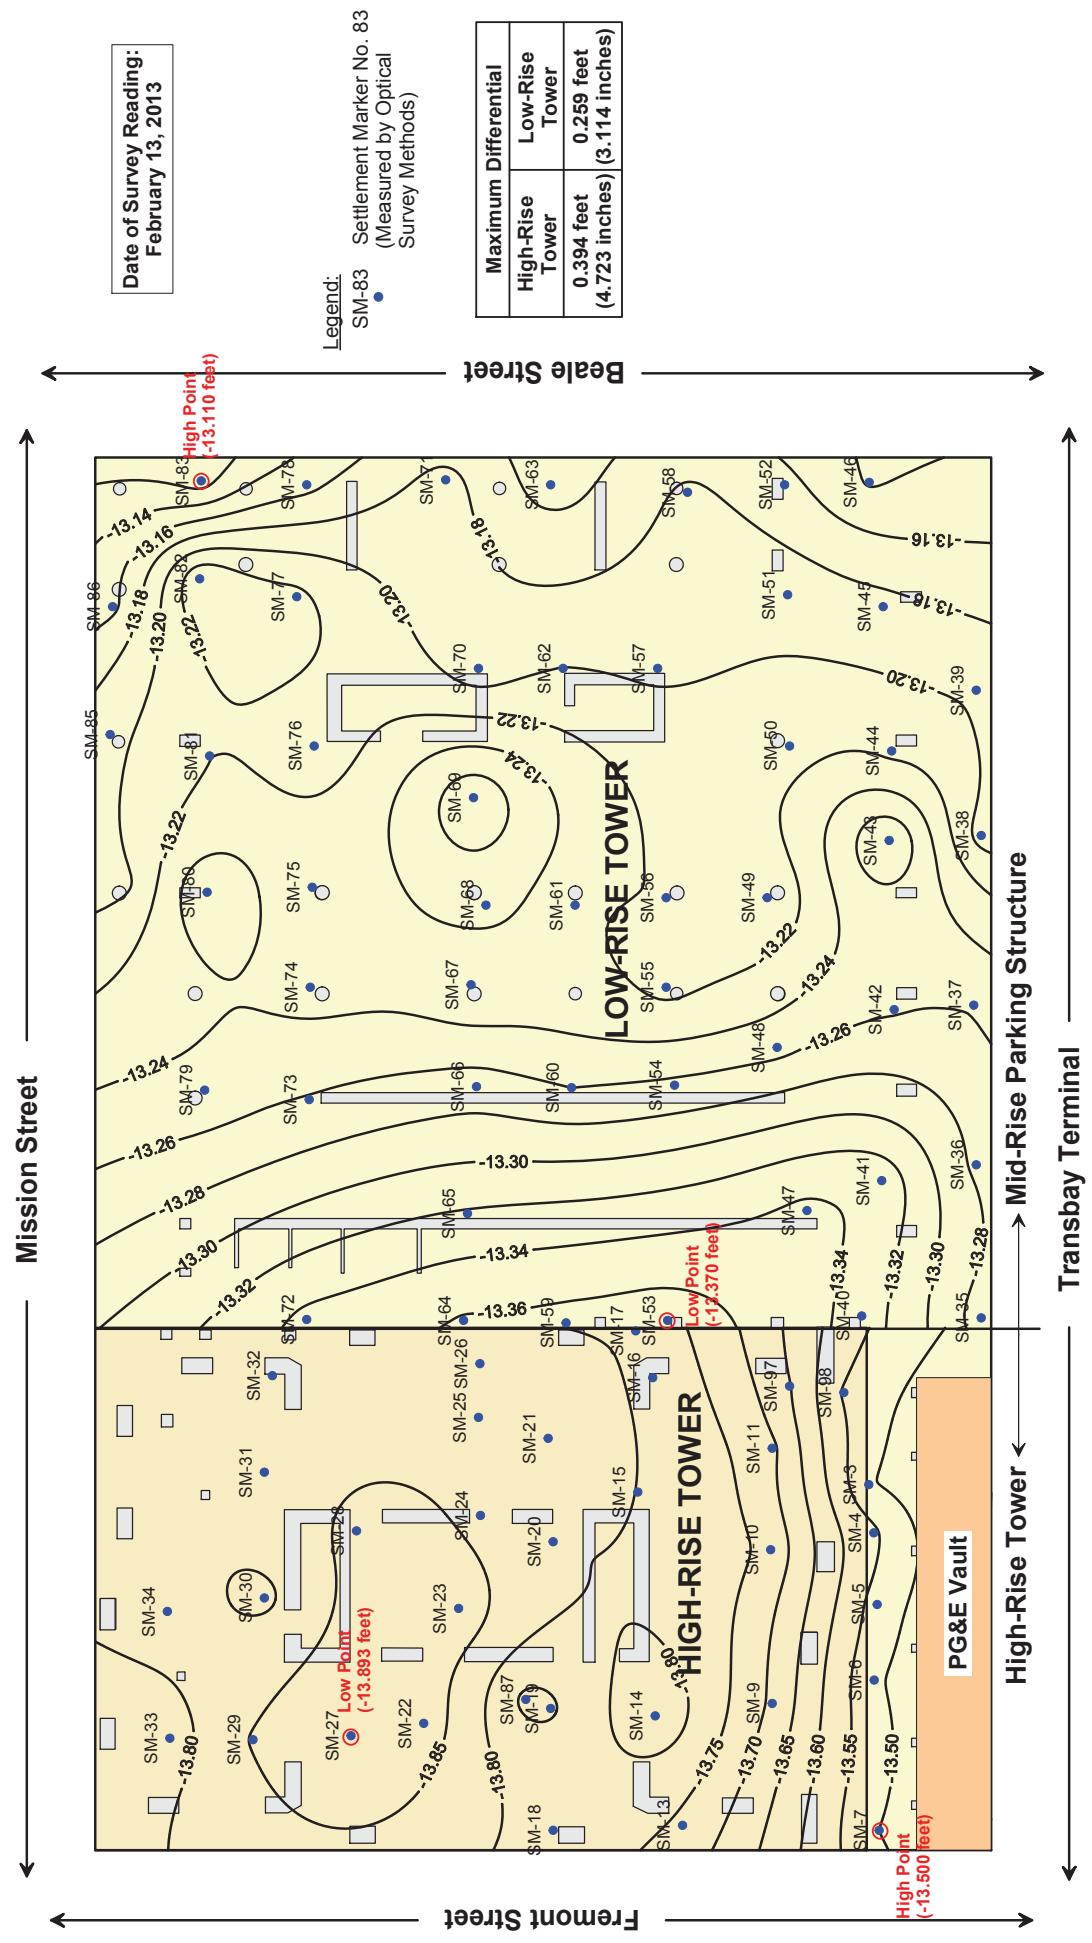


**FLOOR ELEVATIONS AT LEVEL B-1
OF 301 MISSION PROPERTY:
PERIODIC SURVEY - FEBRUARY 13, 2013**

Transbay Transit Center
301 Mission Monitoring
Transbay Joint Powers Authority
San Francisco, California

March 2013

ARUP


PLATE 1

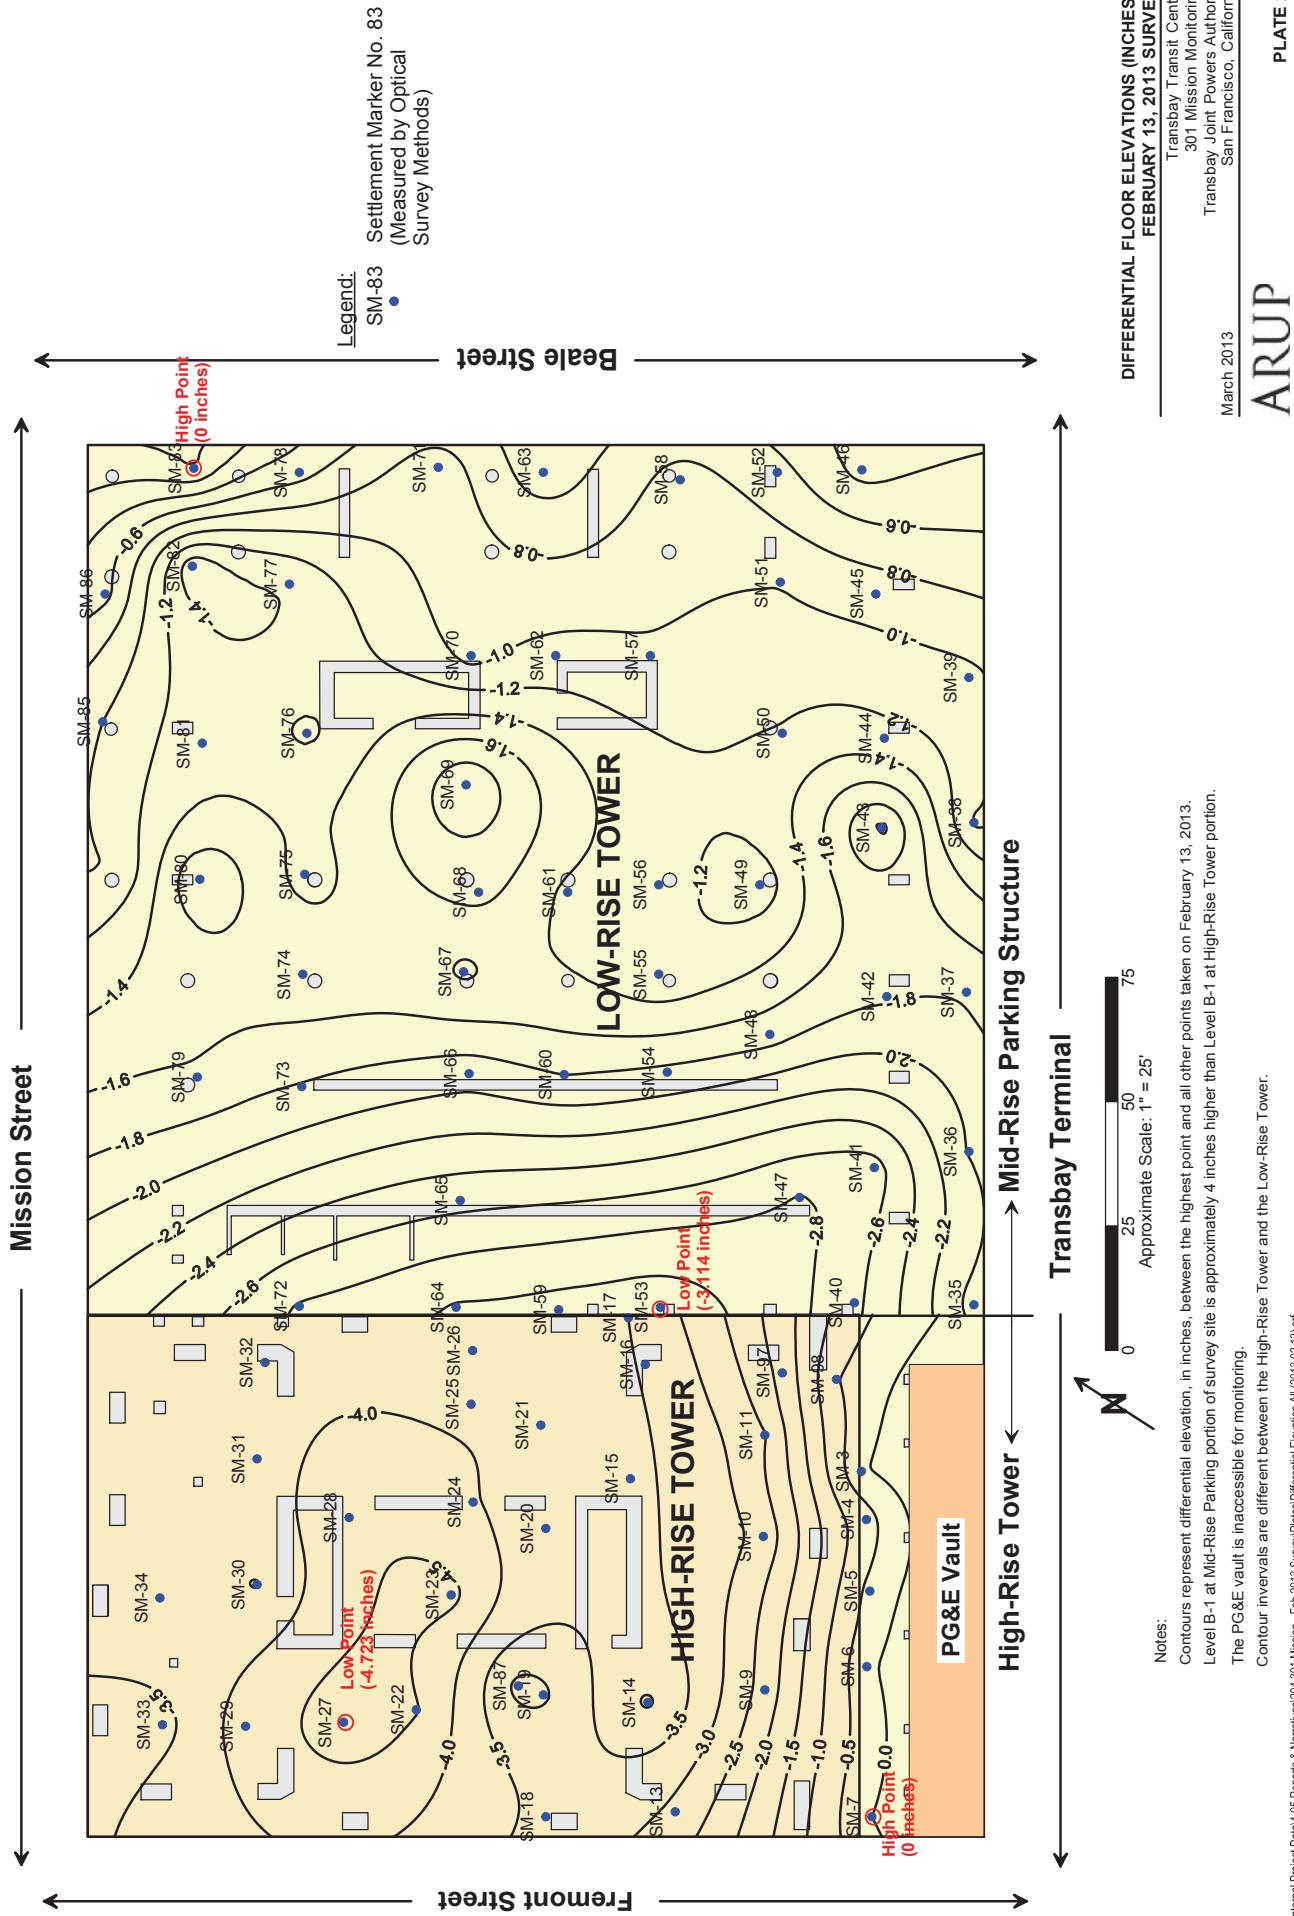


Control intervals are different between the right and left panels.

CONTOURS OF SETTLEMENTS MEASURED AT THE FIRST LEVEL BASEMENT OF THE 301 MISSION STREET STRUCTURE BETWEEN APRIL 30, 2009 AND FEB 2013
 Transbay Transit Center
 301 Mission Monitoring
 Transbay Joint Powers Authority
 San Francisco, California

March 2013

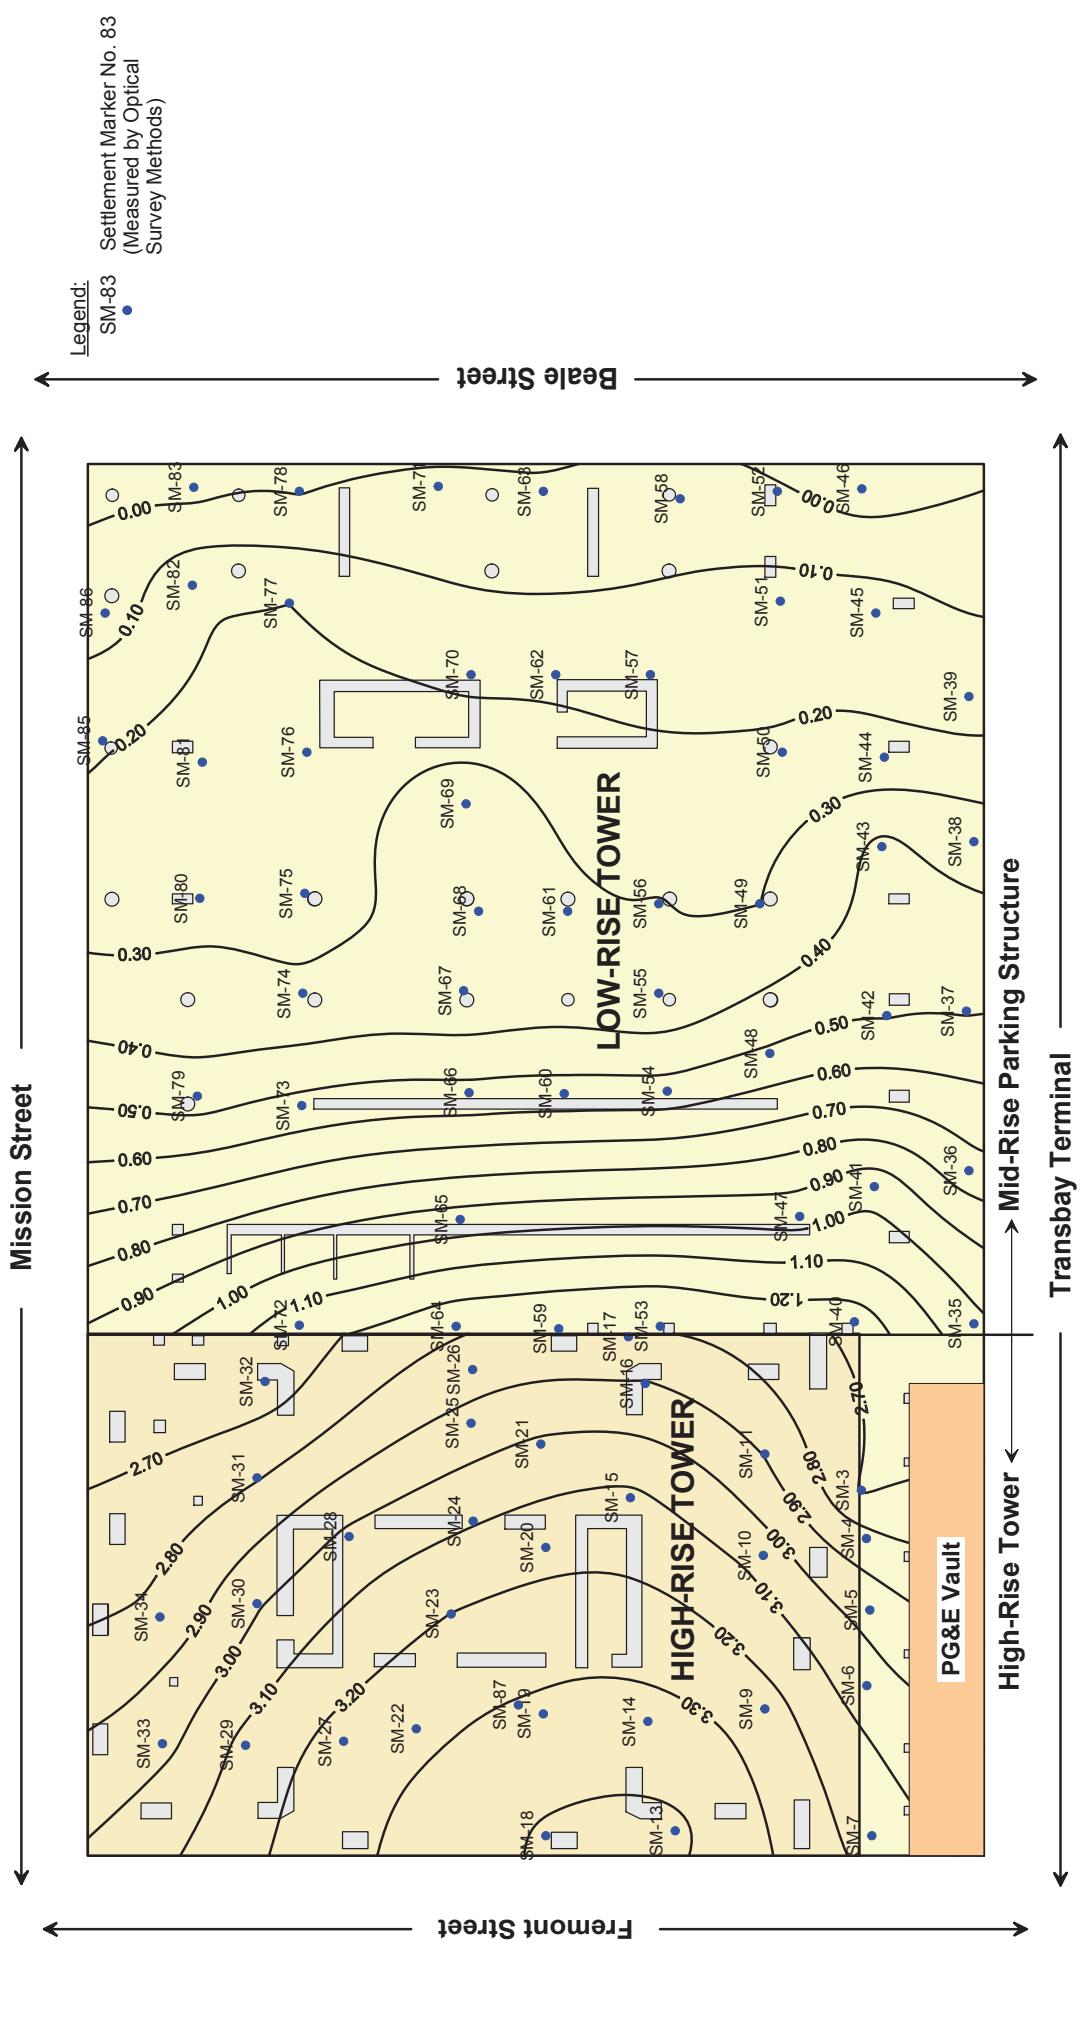


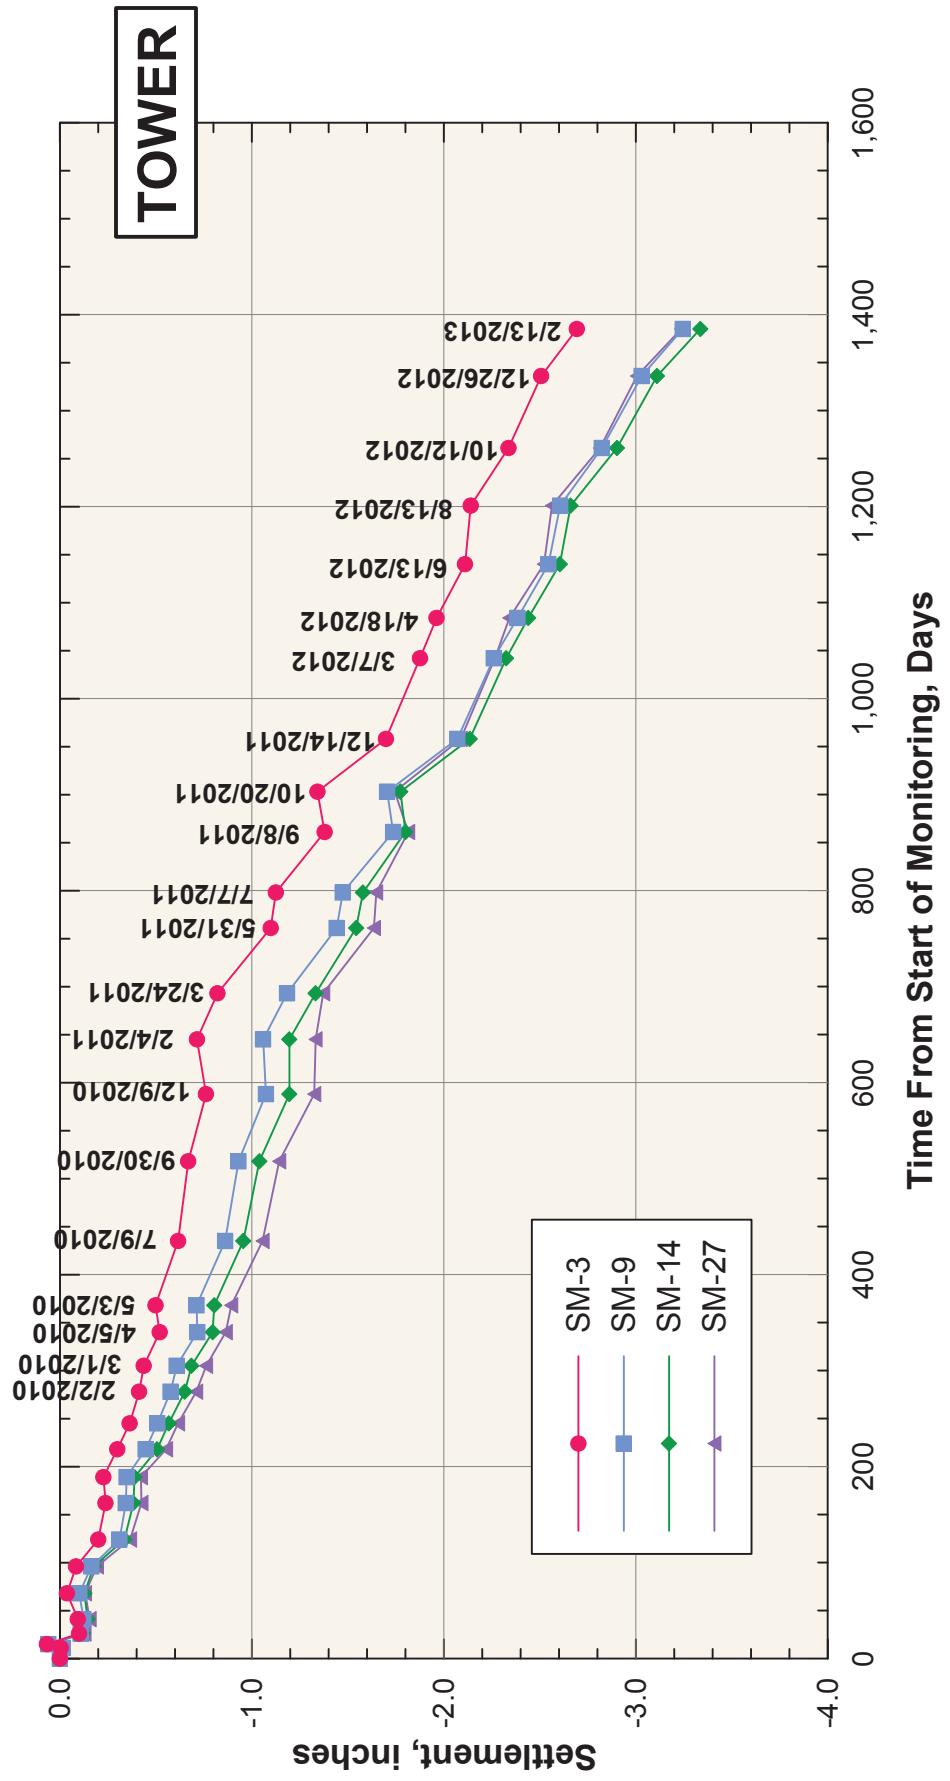


ARUP

**SETTLEMENT OVER TIME
FLOOR ELEVATIONS AT LEVEL B-1
OF 301 MISSION PROPERTY - MID-RISE:
APRIL 30, 2009 THROUGH FEBRUARY 13, 2013**

Transbay Transit Center
301 Mission Monitoring
Transbay Joint Powers Authority
San Francisco, California

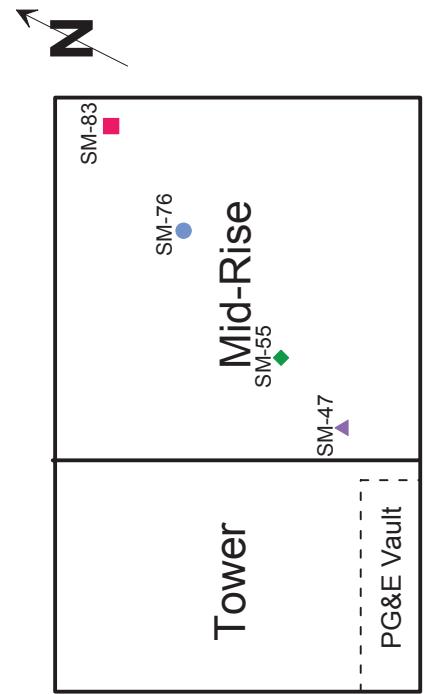

Time From Start of Monitoring, Days

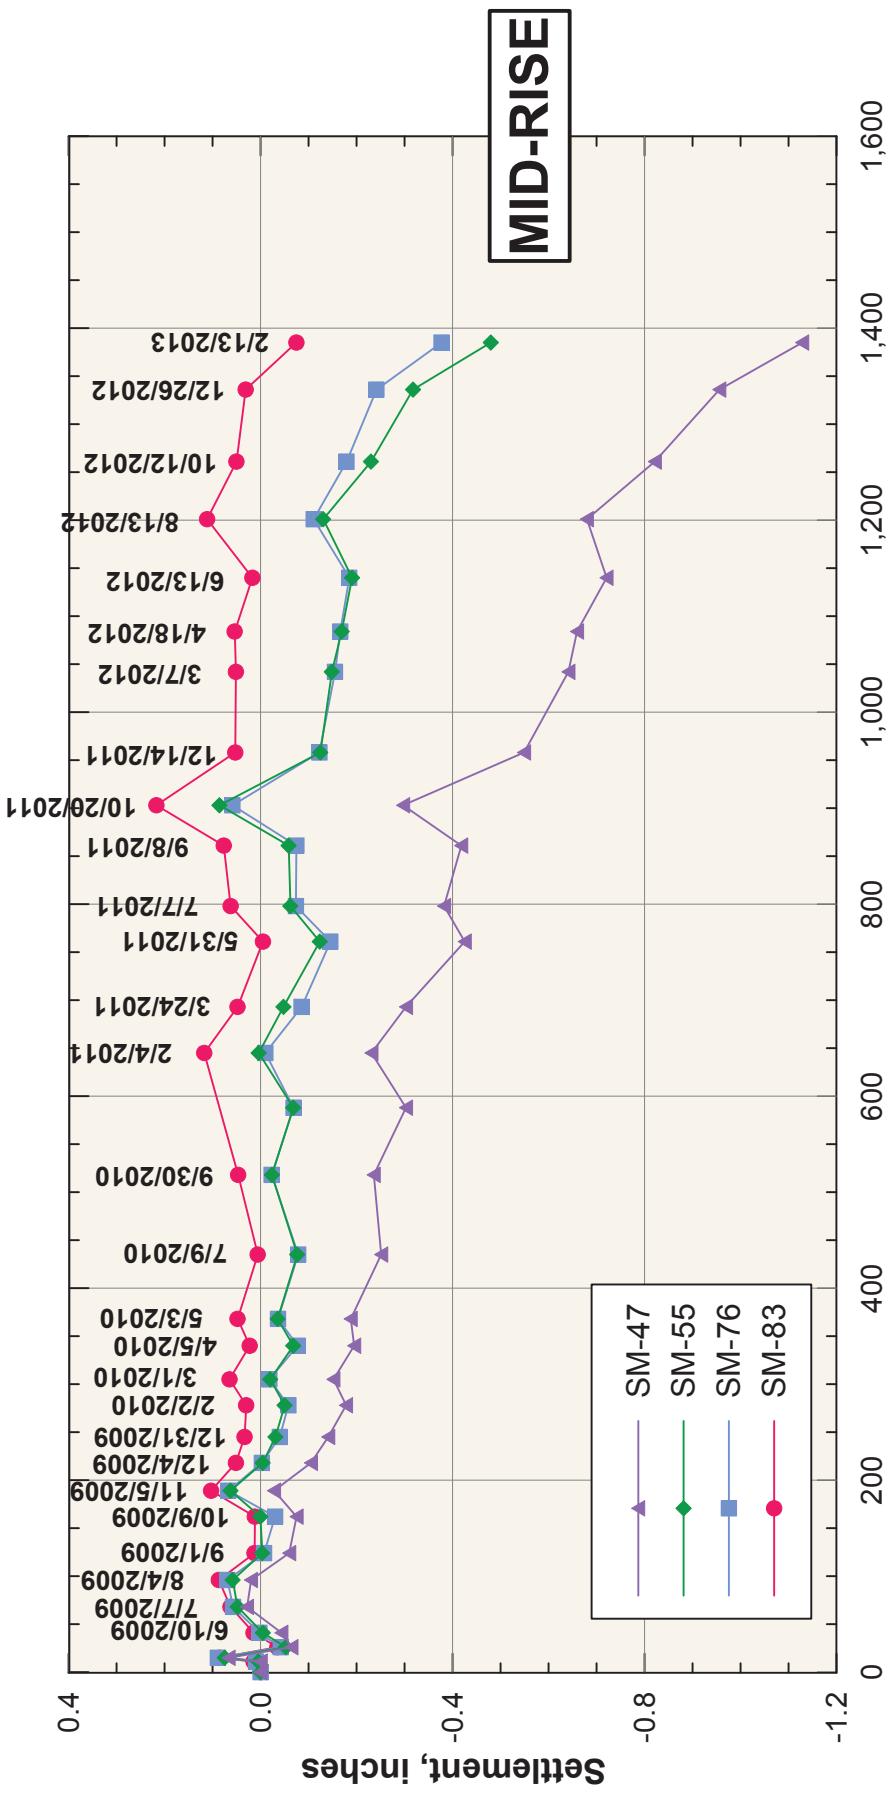



Note: Initial (Baseline) reading taken on 04/30/09

**SETTLEMENTS OF THE 301 MISSION TOWER
INCLUDING MONITORING DURING CONSTRUCTION**

Transbay Transit Center
301 Mission Monitoring
Transbay Joint Powers Authority
San Francisco, California

March 2013

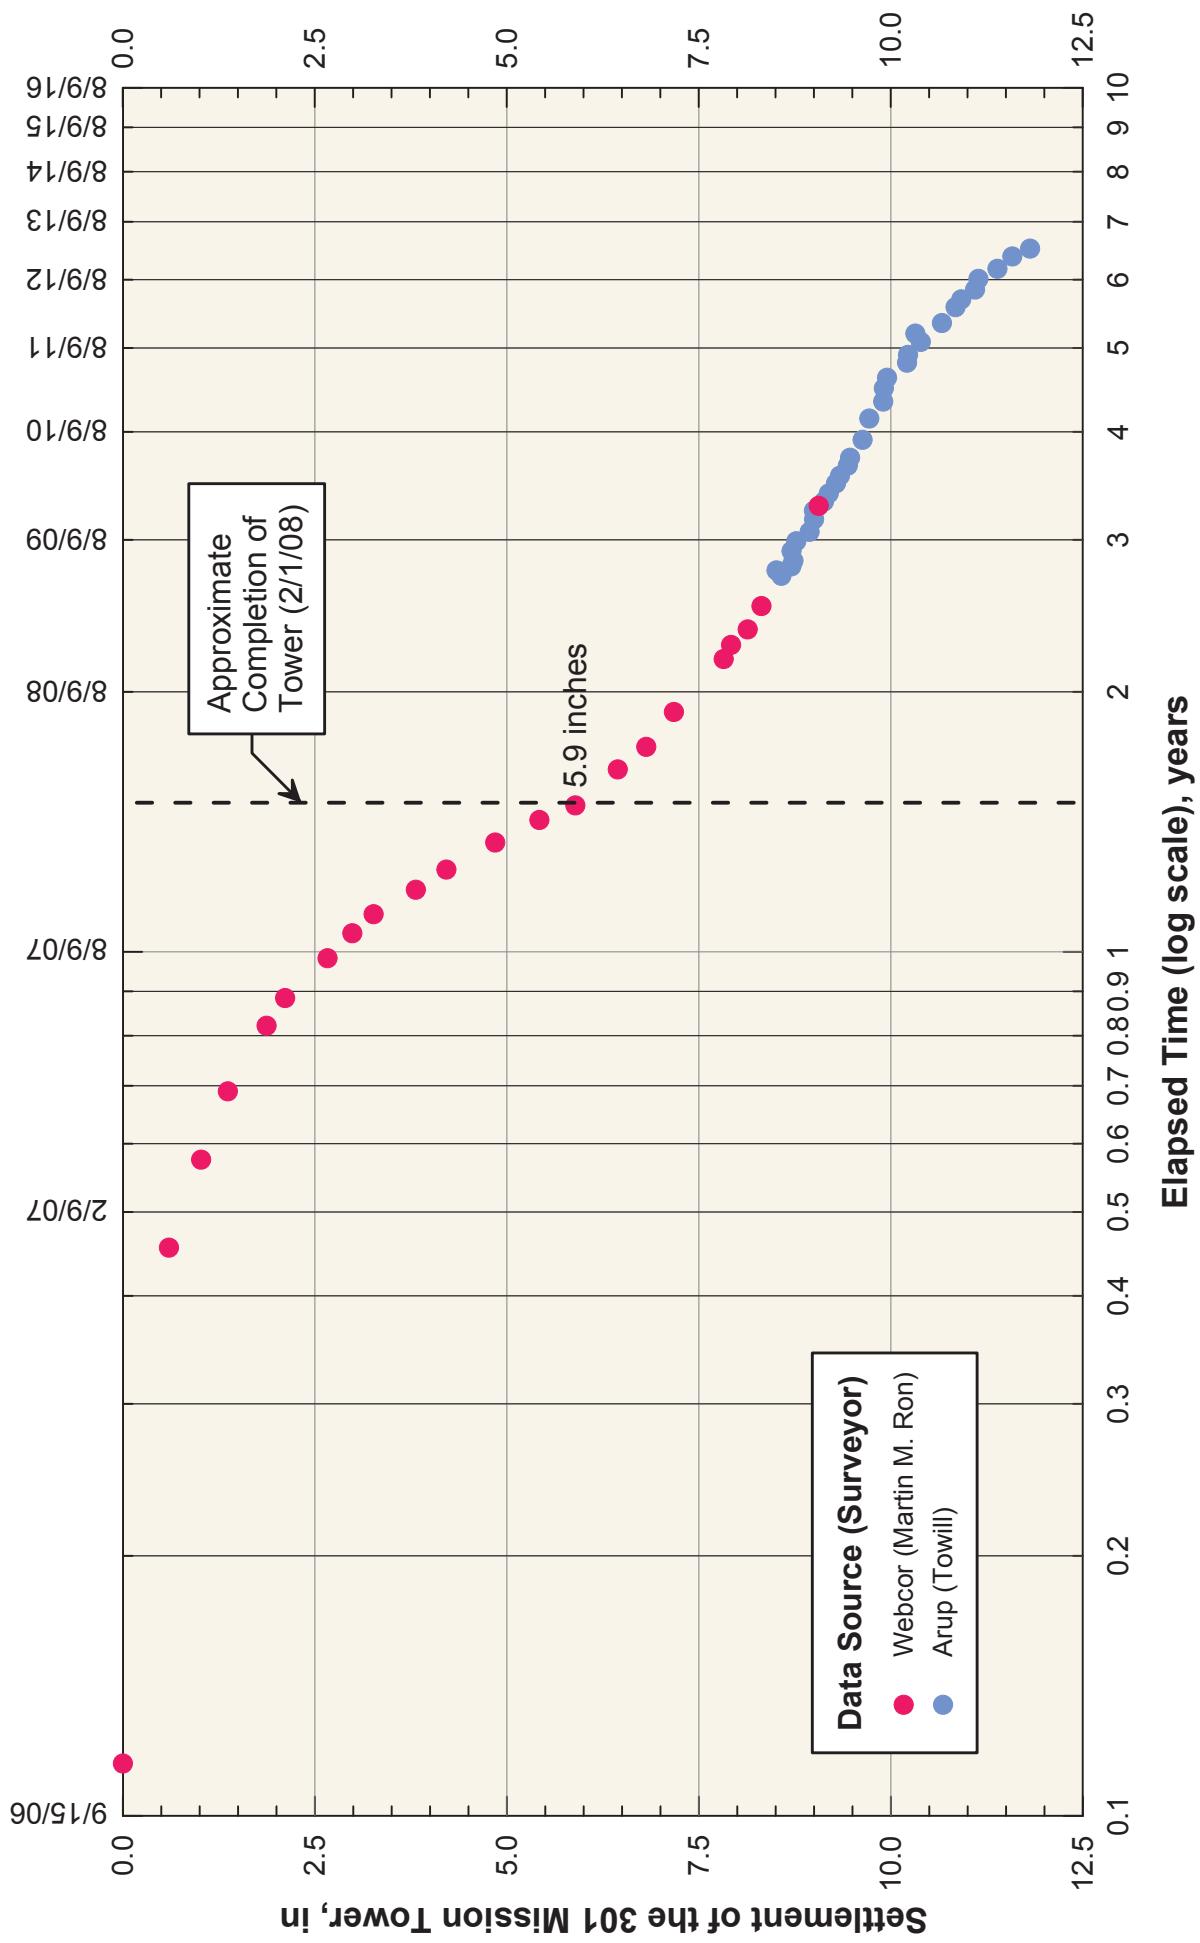

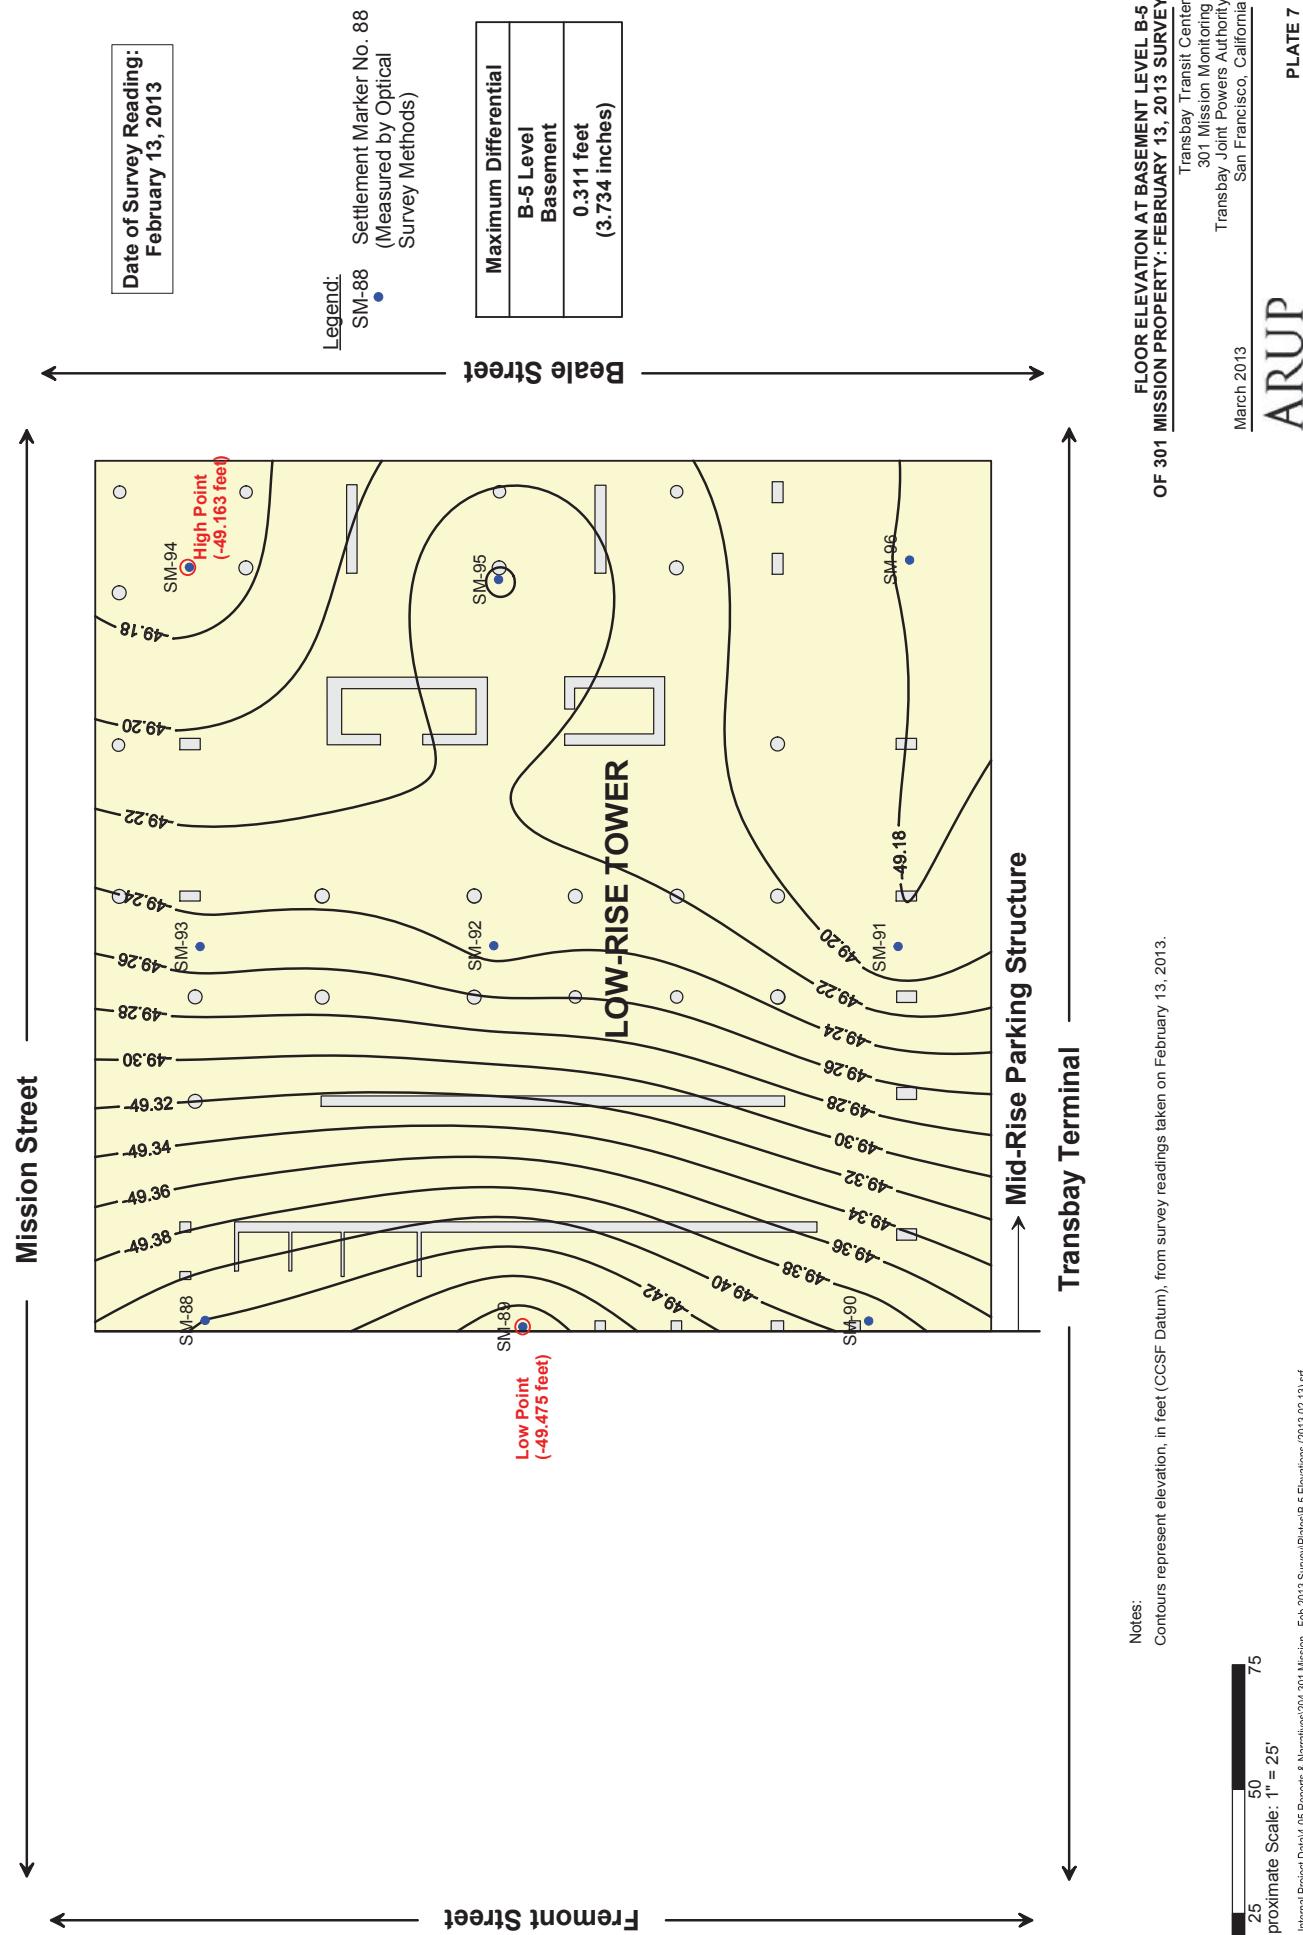

USF11200011324 Internal Project Data405 Reports & Narratives\204 301 Mission - Feb 2013 Survey\PiecesB-5 Elevations (20130213).srf

Approximate Scale: 1" = 25'

0 25 50 75

ARUP


PLATE 7

FLOOR ELEVATION AT BASEMENT LEVEL B-5

OF 301 MISSION PROPERTY: FEBRUARY 13, 2013 SURVEY

Transbay Transit Center
 301 Mission Monitoring
 Transbay Joint Powers Authority
 San Francisco, California

March 2013

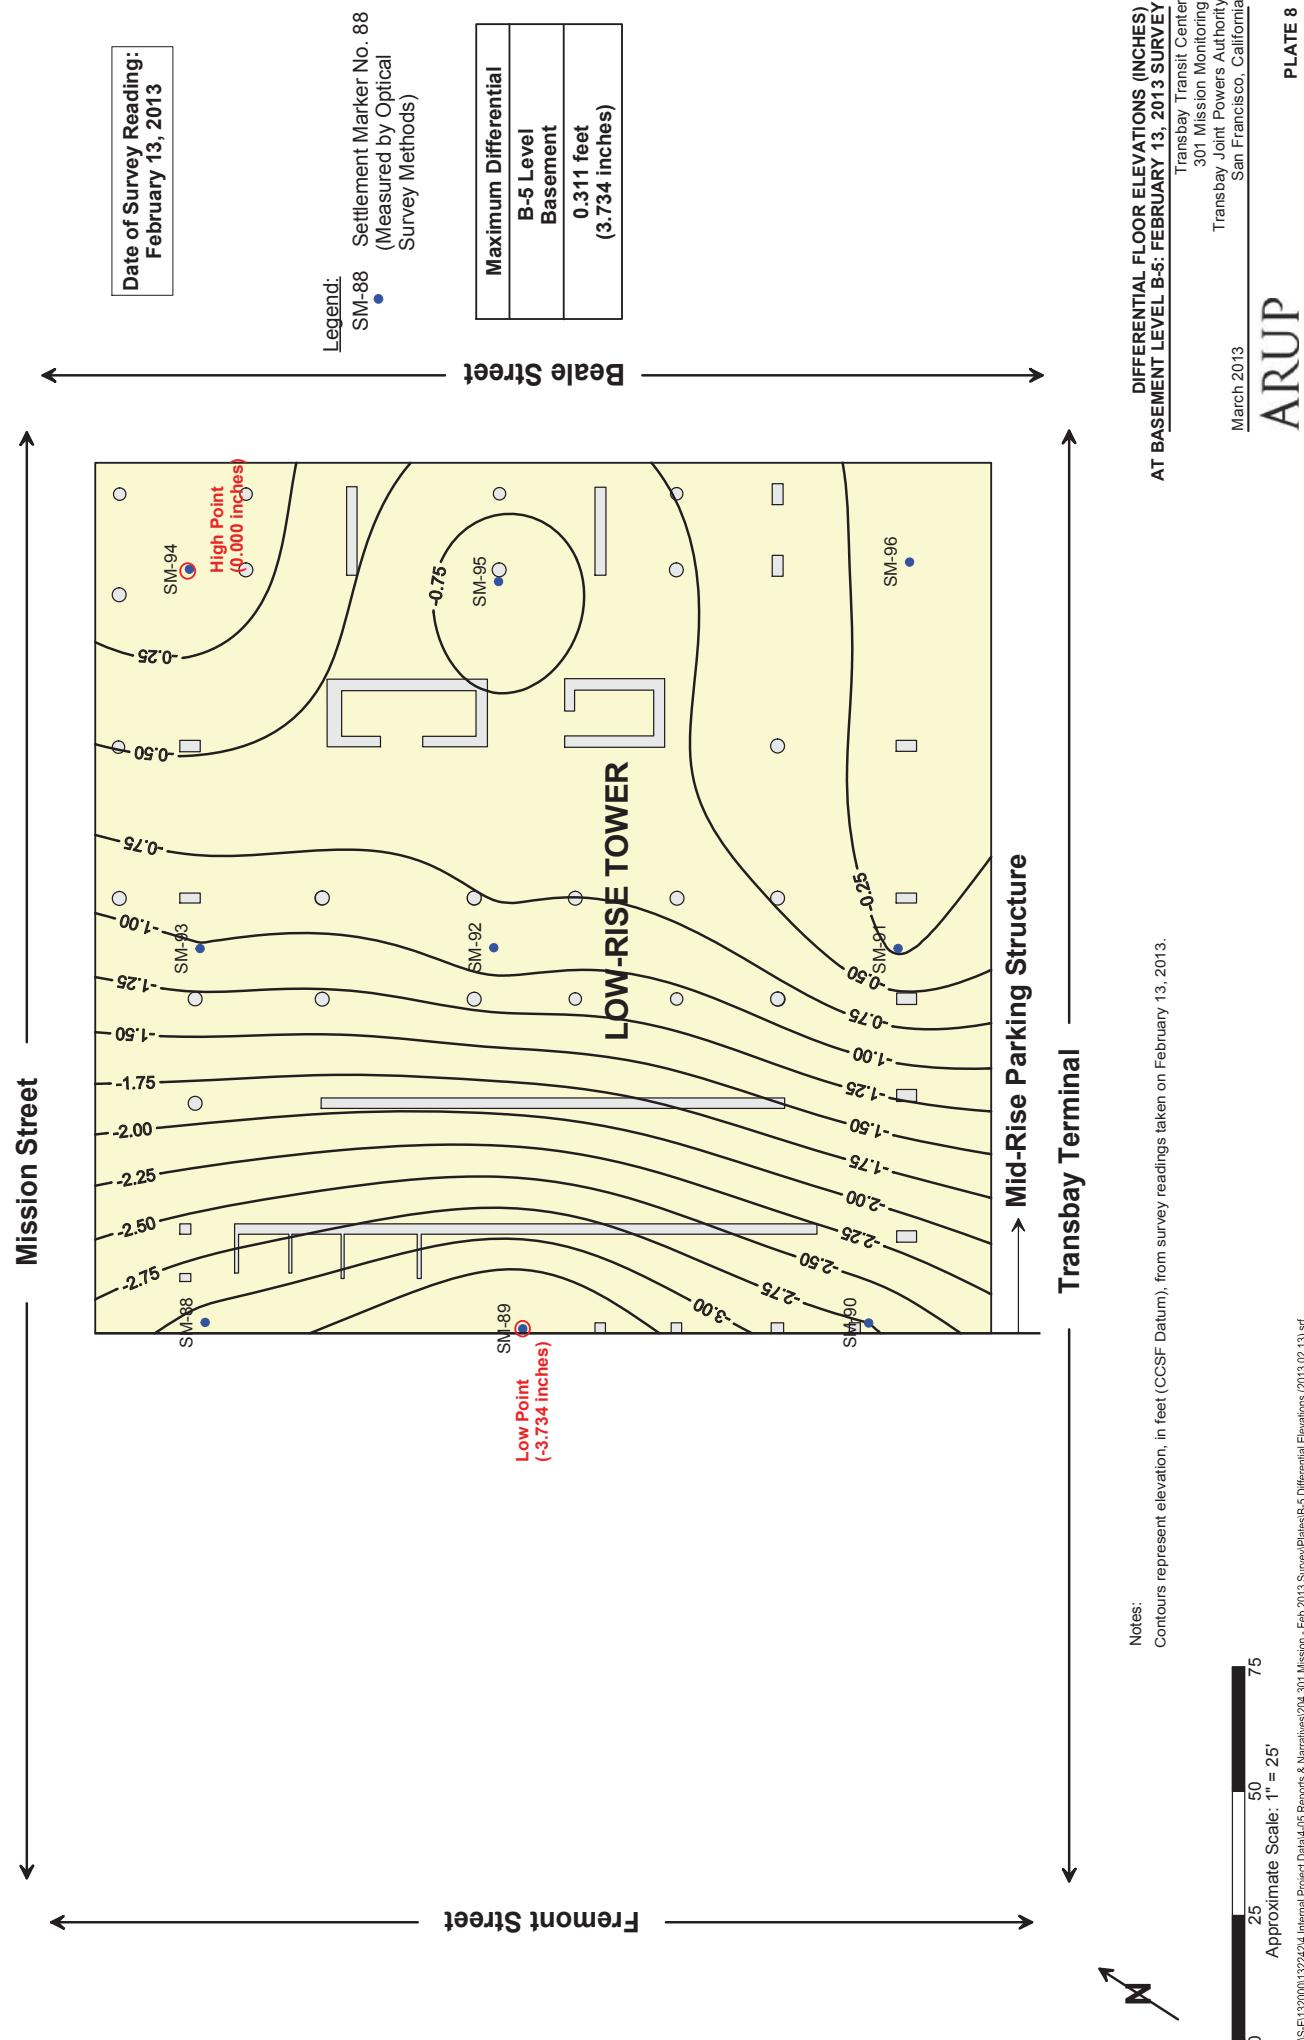

From: Brian Dykes
Sent: Tuesday, July 16, 2013 5:35 PM
To: 'Steven Hood'
Cc: Dennis Turchon; Stephen McLandrich; 'Nick O'Riordan'
Subject: 301 Mission Settlement Monitoring

Steven,
Here are the last two settlement monitoring memos from Arup and the raw data records for the same times.
Brian.

Brian Dykes
Principal Engineer
Transbay Joint Powers Authority
201 Mission Street, Suite 2100
San Francisco, CA 94105
415 597 4617 phone
415 597 4615 fax

Check out our progress at <http://transbaycenter.org/construction-updates/construction-cameras>

NOTE: This e-mail communication and any attachments hereto are covered by the Electronic Communications Privacy Act, 18 U.S.C. Sections 2510-2521, and are legally privileged. The information contained herein is confidential, and is intended only for the use of the individual or entity to whom it is addressed. If you are not the intended recipient of this e-mail communication (or an employee or agent responsible for delivering this communication to its intended recipient(s)), you are hereby notified that any retention, copying or further distribution of this e-mail communication and any attachments is strictly prohibited. If you are not the intended recipient, please notify the sender by telephoning 415-597-4620, or by forwarding an e-mail reply message addressed to TransAdmin@TransbayCenter.org confirming that you have already destroyed (deleted) the original e-mail communication and any and all copies thereof. Thank you.

Memorandum


ARUP

To	Brian Dykes (TJPA)	Date
		28 June 2013
Copies	Robert Beck (TJPA) Randy Volenec (PCPA) George Metzger (AAI)	Reference number 132242-60/MHG
From	Michael Gardner (Arup)	File reference 4-05 212
Subject	Transbay Transit Center: Results of April 2013 Settlement Survey at 301 Mission Property	Page 1 of 1

Under Arup's Geotechnical Contract with the Transbay Joint Powers Authority through Pelli Clark Pelli Architects, Arup is required to monitor the settlements of the buildings adjacent to the Transbay Transit Center prior to and during construction. We began the monitoring program for the 301 Mission property in April of 2009. This memorandum and the attached plates present an update to our memorandum dated March 27, 2013 with measurements made through April 2013.

List of Plates

- Plate 1 Floor Elevations at Level B-1 of 301 Mission Property: Periodic Survey – April 19, 2013
- Plate 2 Differential Floor Elevation (Inches) – April 19, 2013 Survey
- Plate 3 Contours of Settlements Measured at the 1st Level Basement of the 301 Mission St. Structure Between 04/30/2009 and 04/19/2013
- Plate 4 Settlement Over Time Floor Elevations at Level B-1 of 301 Mission Property – Tower: April 30, 2009 through April 19, 2013
- Plate 5 Settlement Over Time Floor Elevations at Level B-1 of 301 Mission Property – Mid-Rise: April 30, 2009 through April 19, 2013
- Plate 6 Settlements of the 301 Mission Tower Including Monitoring During Construction
- Plate 7 Floor Elevation at Basement Level B-5 of 301 Mission Property: April 19, 2013 Survey
- Plate 8 Differential Floor Elevations (Inches) at Basement Level B-5: April 19, 2013 Survey

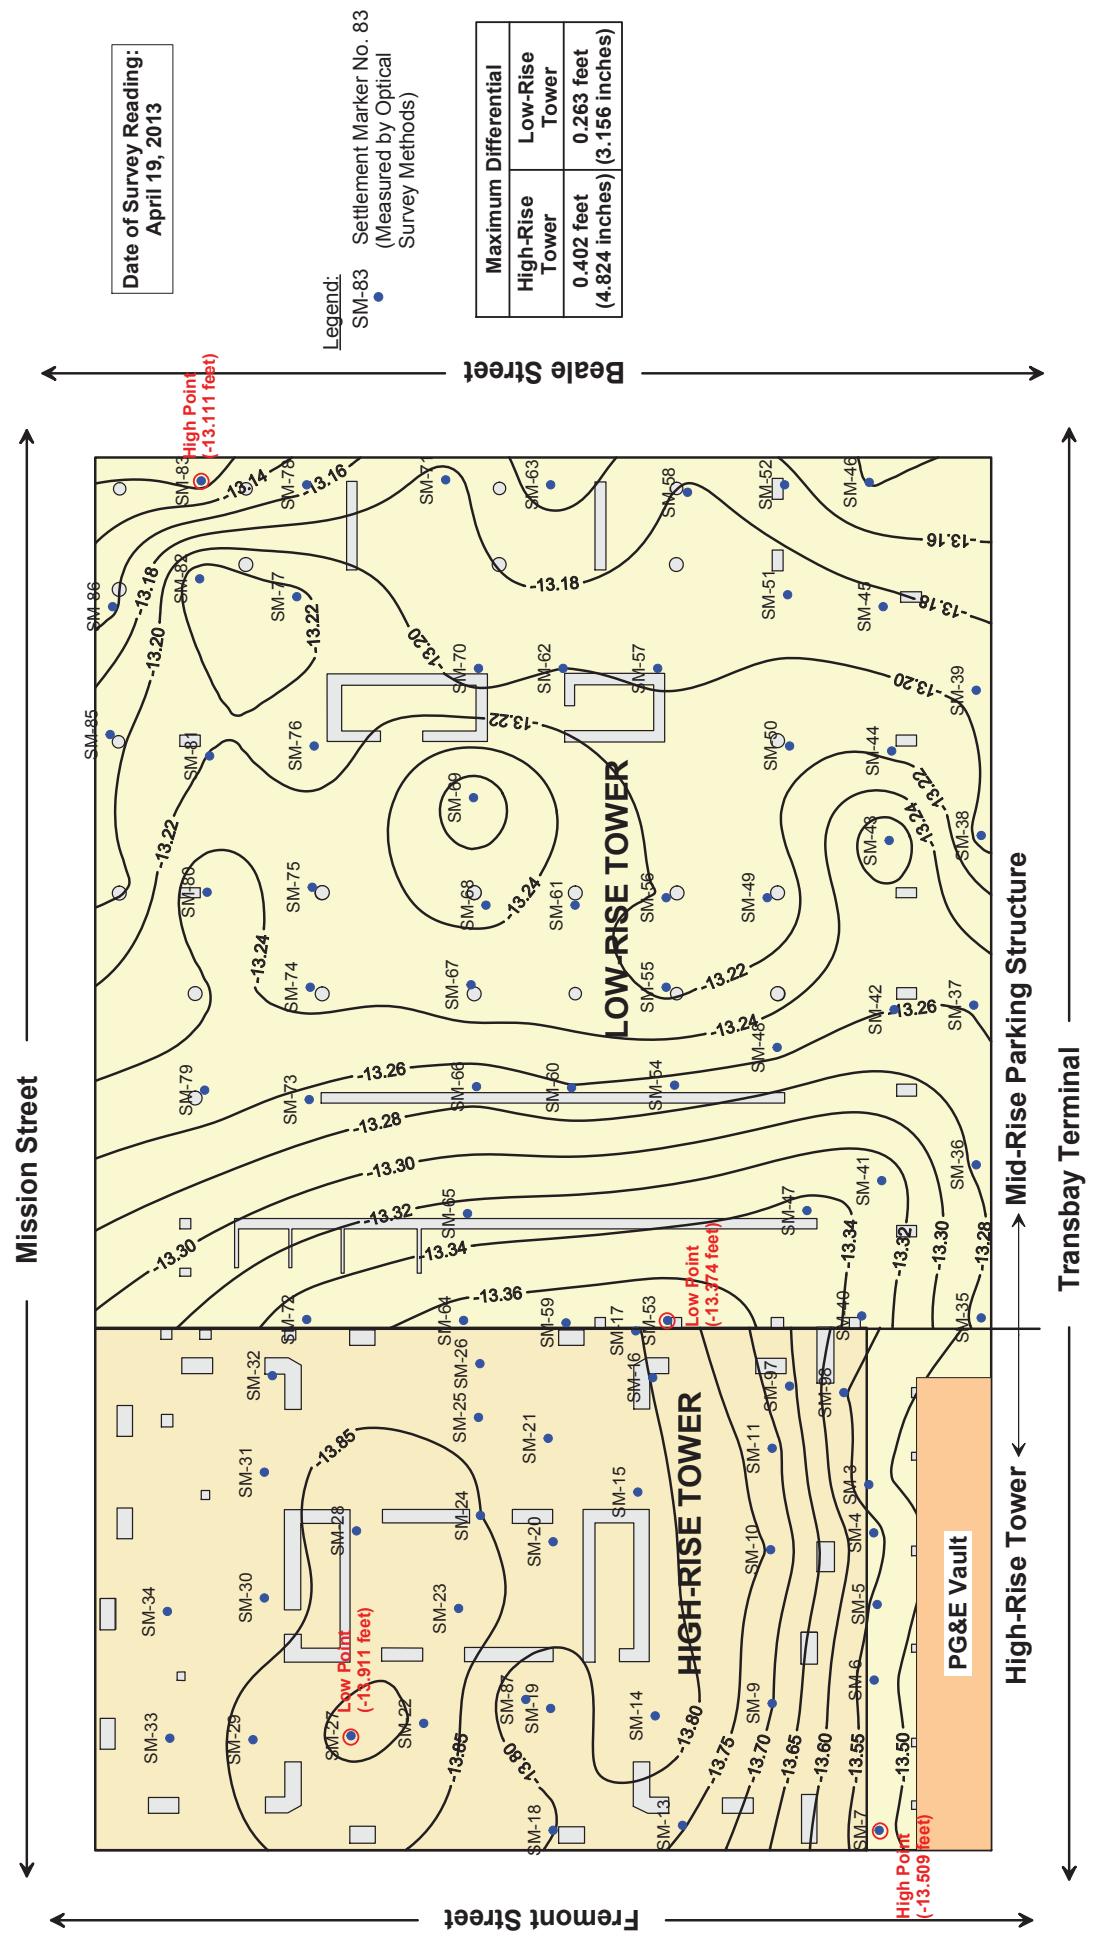


**FLOOR ELEVATIONS AT LEVEL B-1
OF 301 MISSION PROPERTY
PERIODIC SURVEY - APRIL 19, 2013**

Transbay Transit Center
301 Mission Monitoring
Transbay Joint Powers Authority
San Francisco, California

June 2013

ARUP

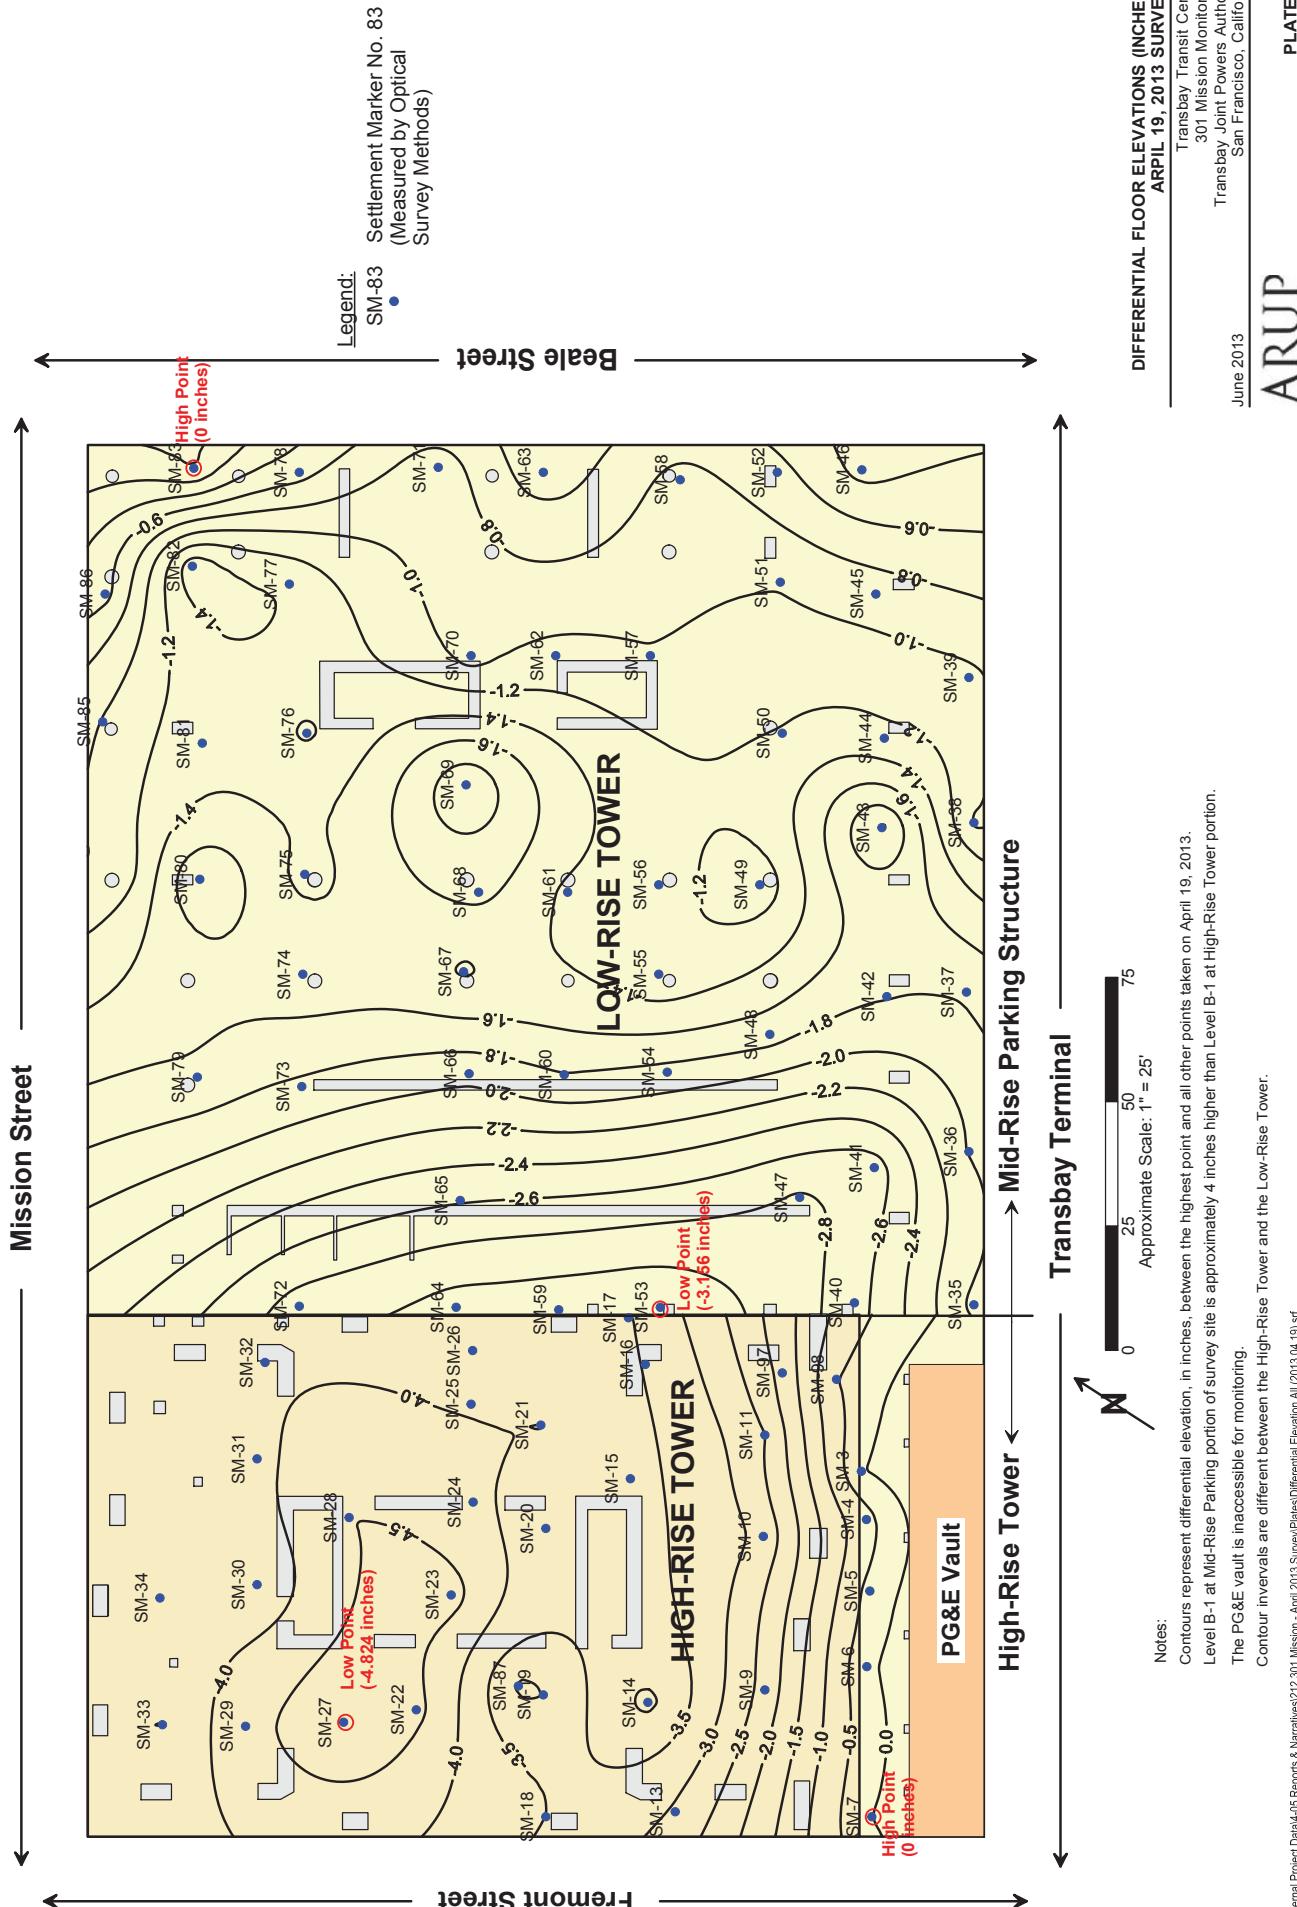

119-EU13200011322014 Internal Project Data4-05 Renorts & Narratives@212301 Mission - April 2013 Survey@212301 Mission Differential Elevation All @213 04 191.sdf


Notes:
Contours represent differential elevation, in inches, between the highest point and all other points taken on April 19, 2013.
Level B-1 at Mid-Rise Parking portion of survey site is approximately 4 inches higher than Level B-1 at High-Rise Tower portion.

San Francisco, California

PLATE 2

Transbay Joint Powers Authority
San Francisco, California


PLATE 2

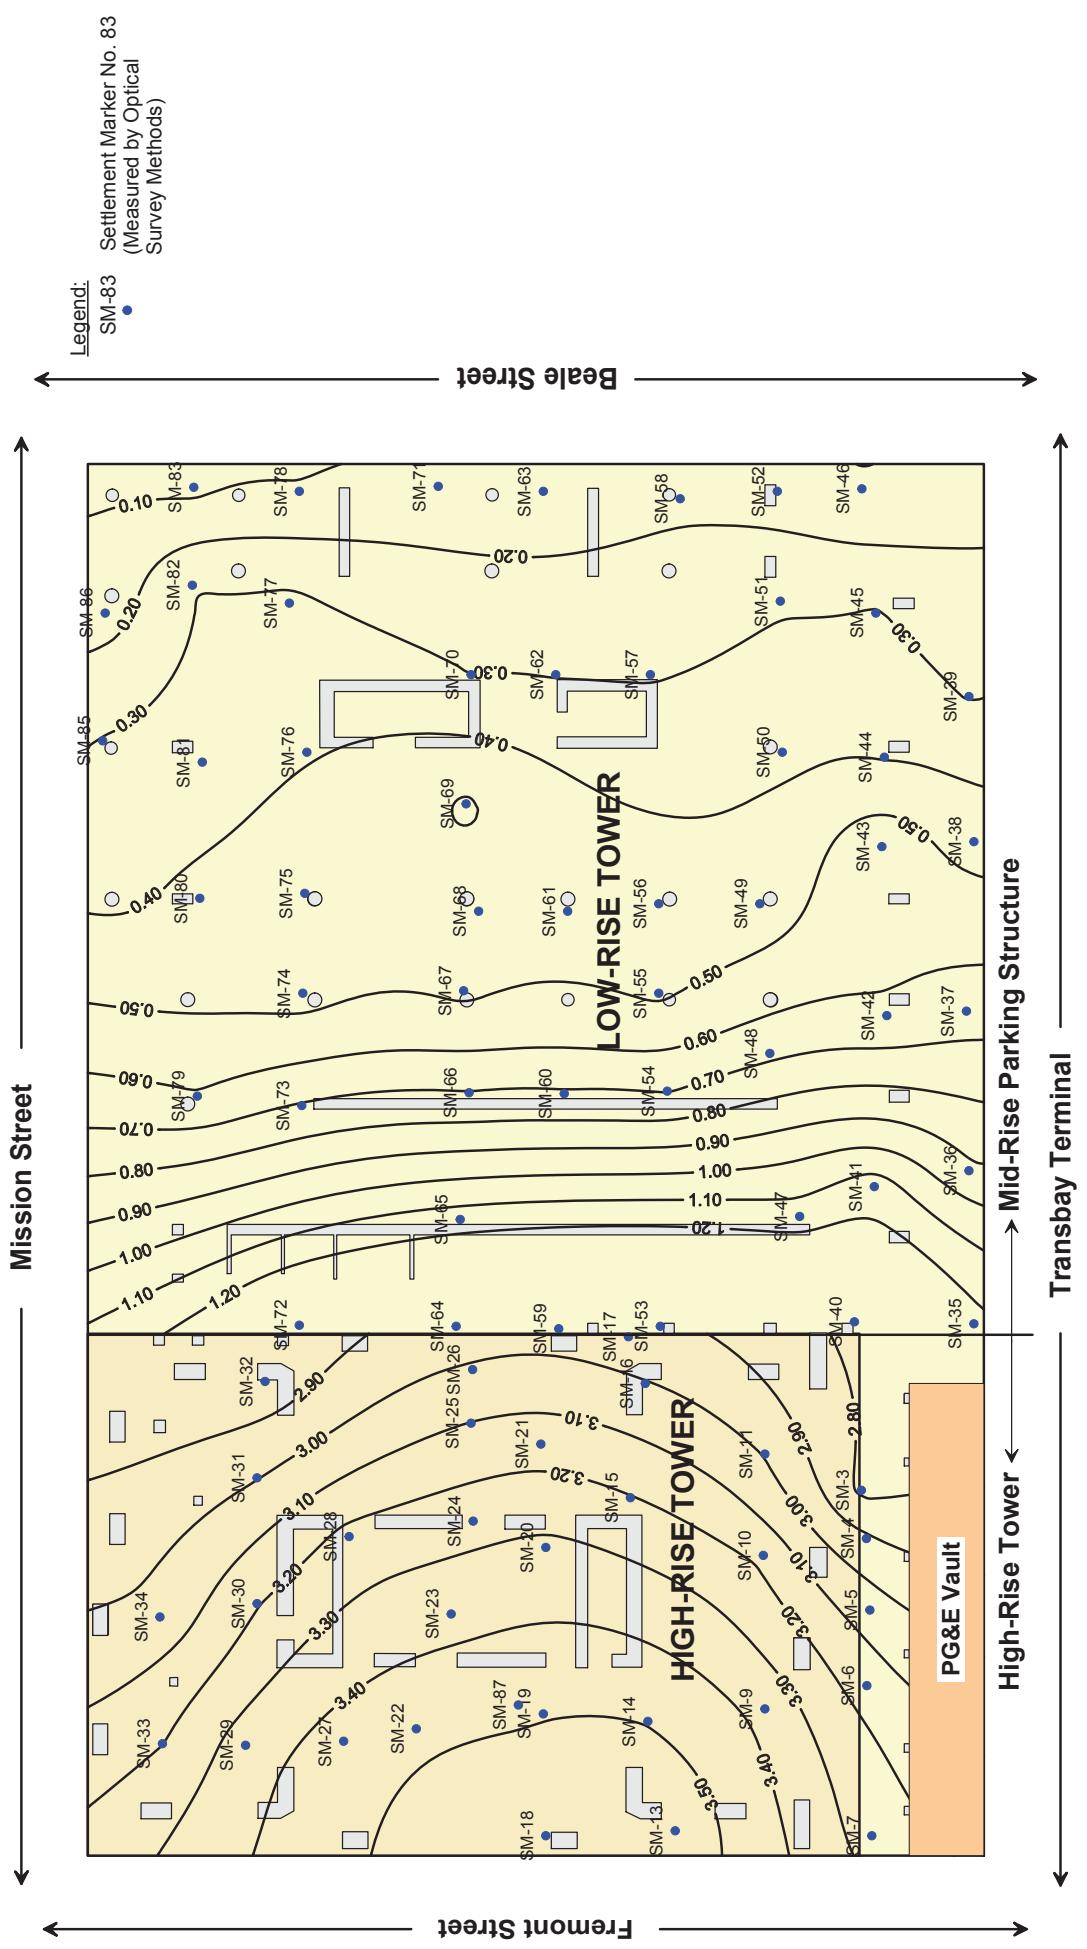

CONTOURS OF SETTLEMENTS MEASURED AT THE
1ST LEVEL BASEMENT OF THE 301 MISSION ST
STRUCTURE BETWEEN 04/30/2009 AND 04/19/2013

Transbay Transit Center
301 Mission Monitoring
Transbay Joint Powers Authority
San Francisco, California

June 2013

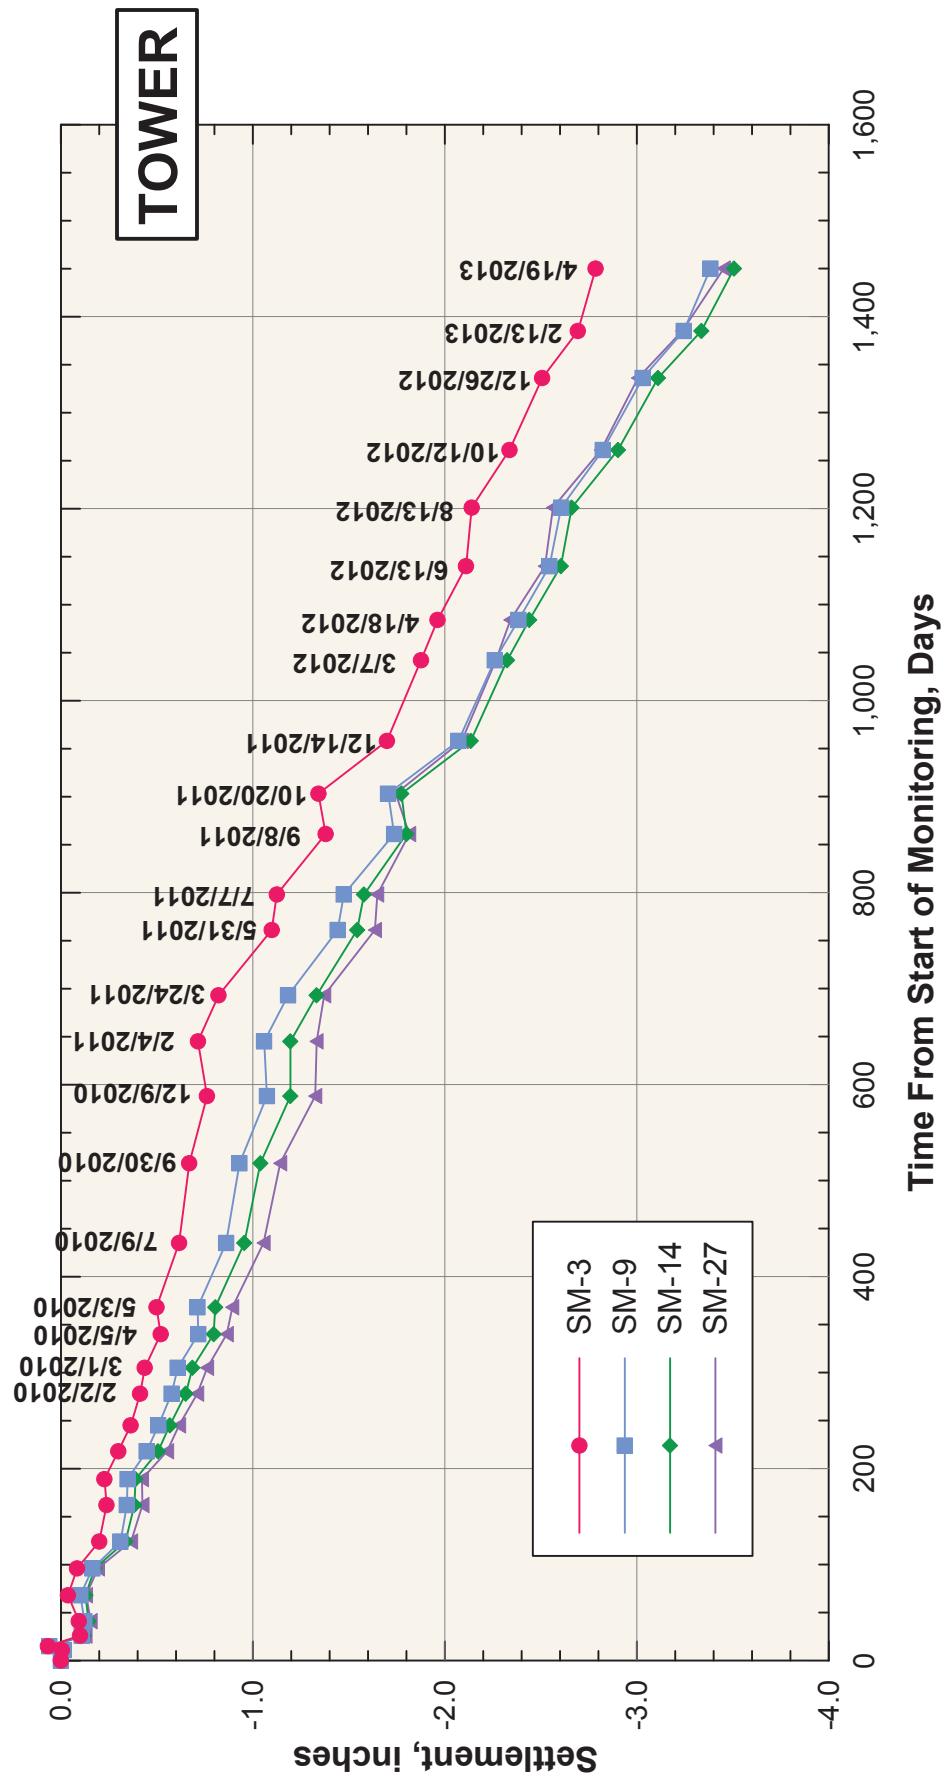

**SETTLEMENT OVER TIME
FLOOR ELEVATIONS AT LEVEL B-1
OF 301 MISSION PROPERTY - TOWER:
APRIL 30, 2009 THROUGH APRIL 19, 2013**


Transbay Transit Center
301 Mission Monitoring
Transbay Joint Powers Authority
San Francisco, California

ARUP


ARUP

**SETTLEMENT OVER TIME
FLOOR ELEVATIONS AT LEVEL B-1
OF 301 MISSION PROPERTY - MID-RISE:
APRIL 30, 2009 THROUGH APRIL 19, 2013**


Transbay Transit Center
301 Mission Monitoring
Transbay Joint Powers Authority
San Francisco, California

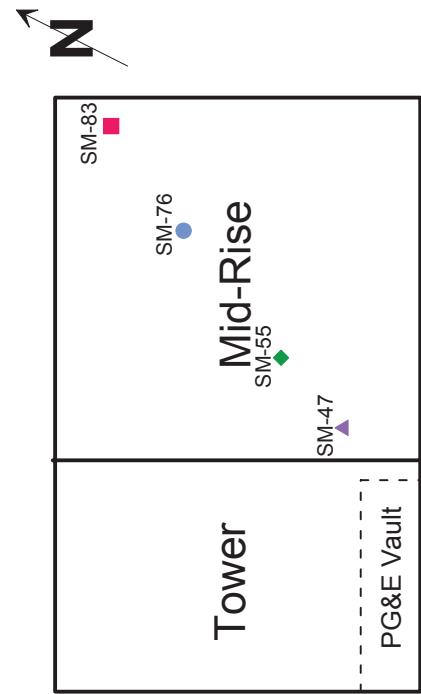

Time From Start of Monitoring, Days

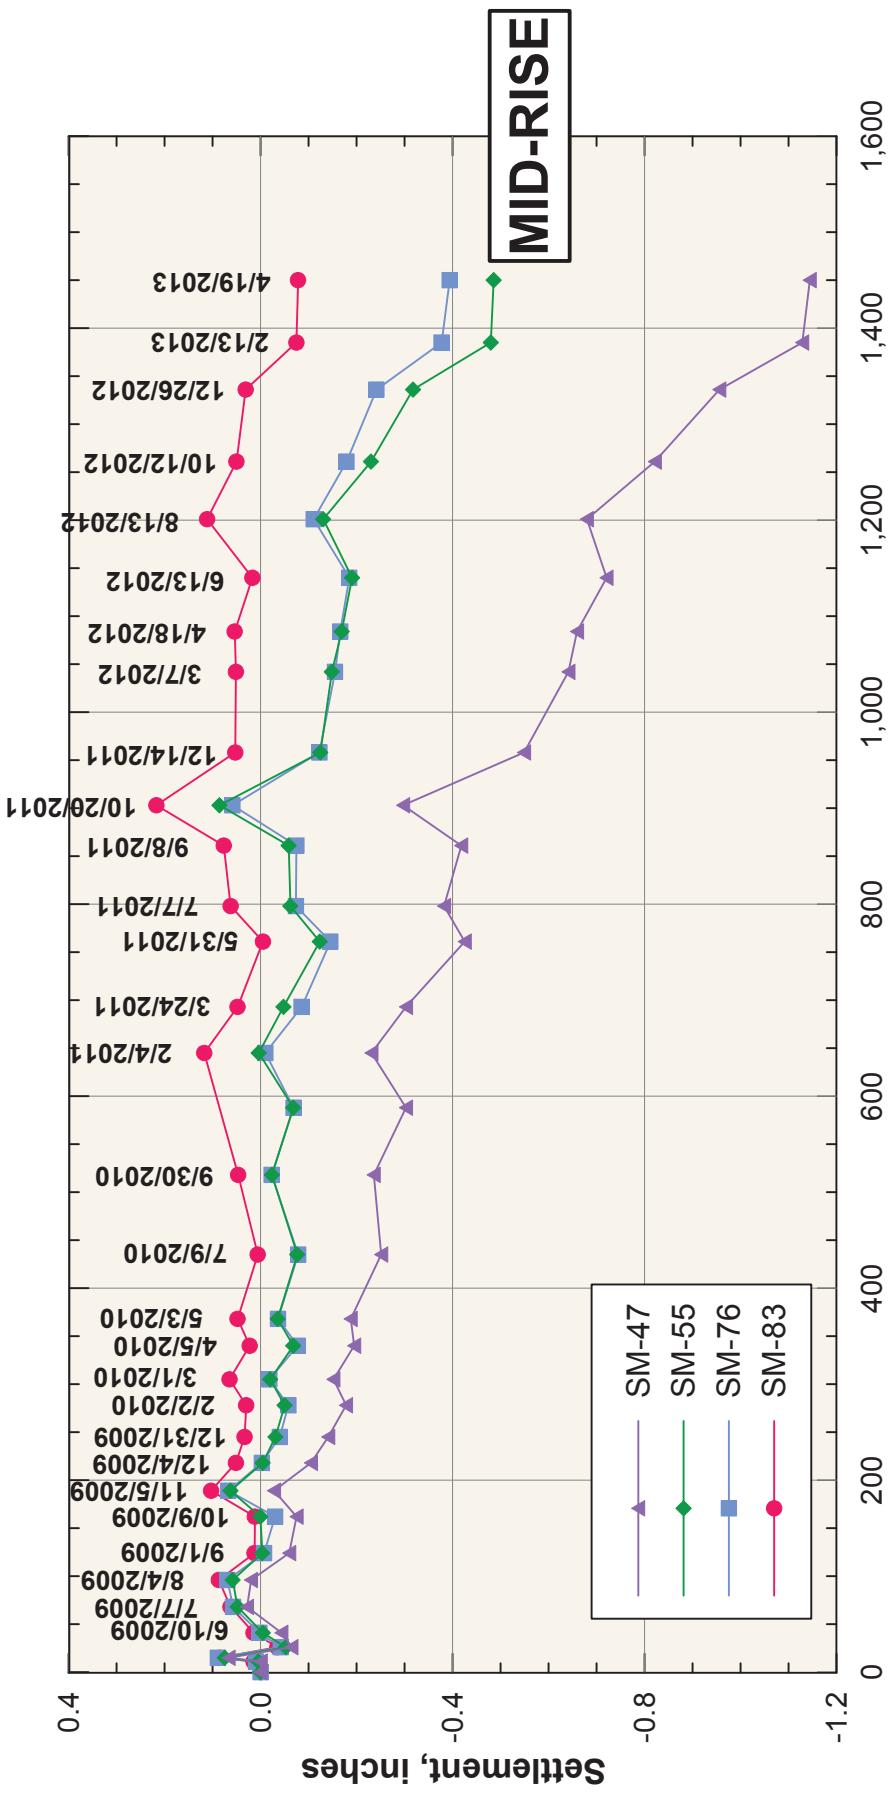

Note:
**Initial (Baseline) reading
taken on 04/30/09**

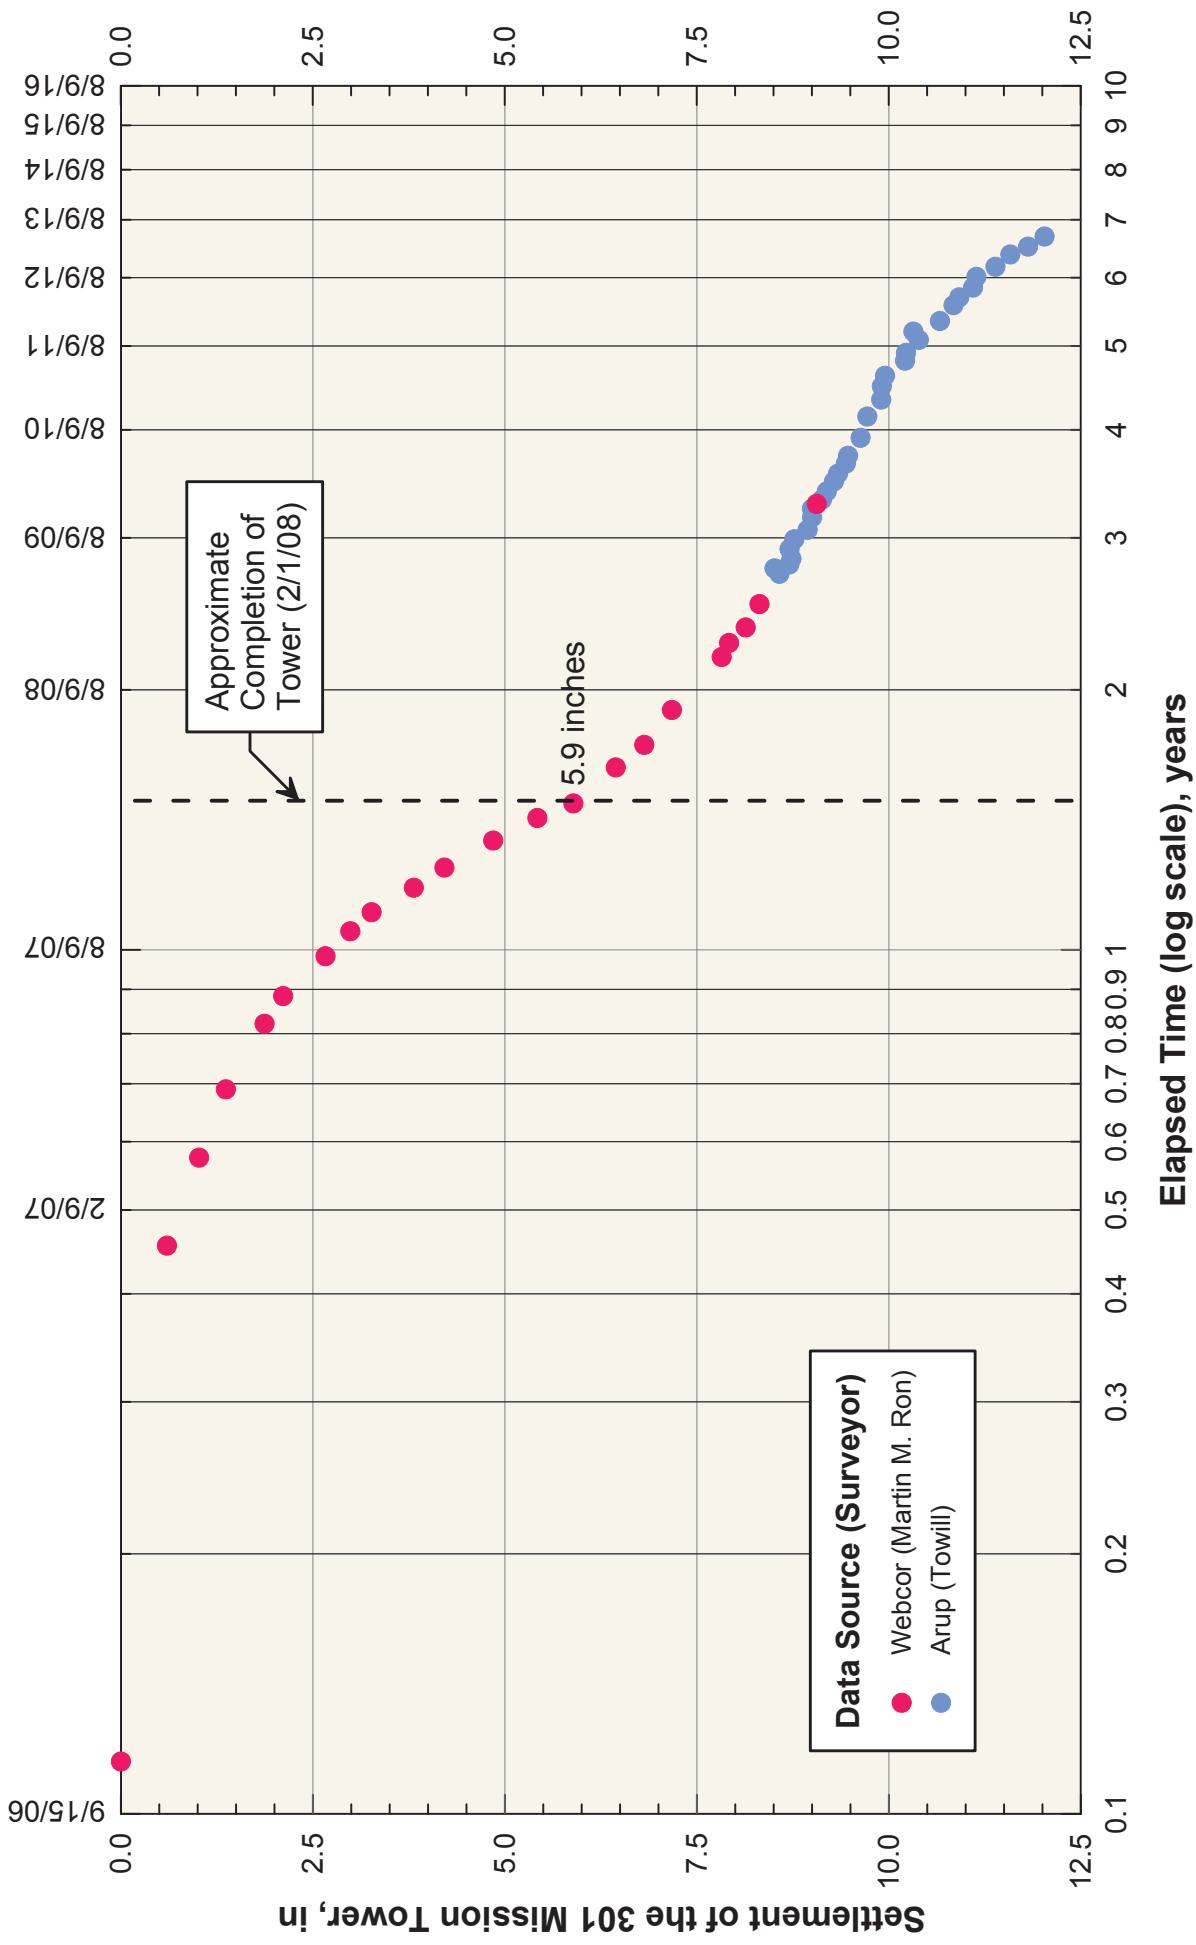


SETTLEMENTS OF THE 301 MISSION TOWER INCLUDING MONITORING DURING CONSTRUCTION

Transbay Transit Center
301 Mission Monitoring
Transbay Joint Powers Authority
San Francisco, California

June 2013

Beginning of Tower Construction: 8/9/06
End of Tower Construction: 2/1/08
Construction Duration: 542 days (1.5 years)

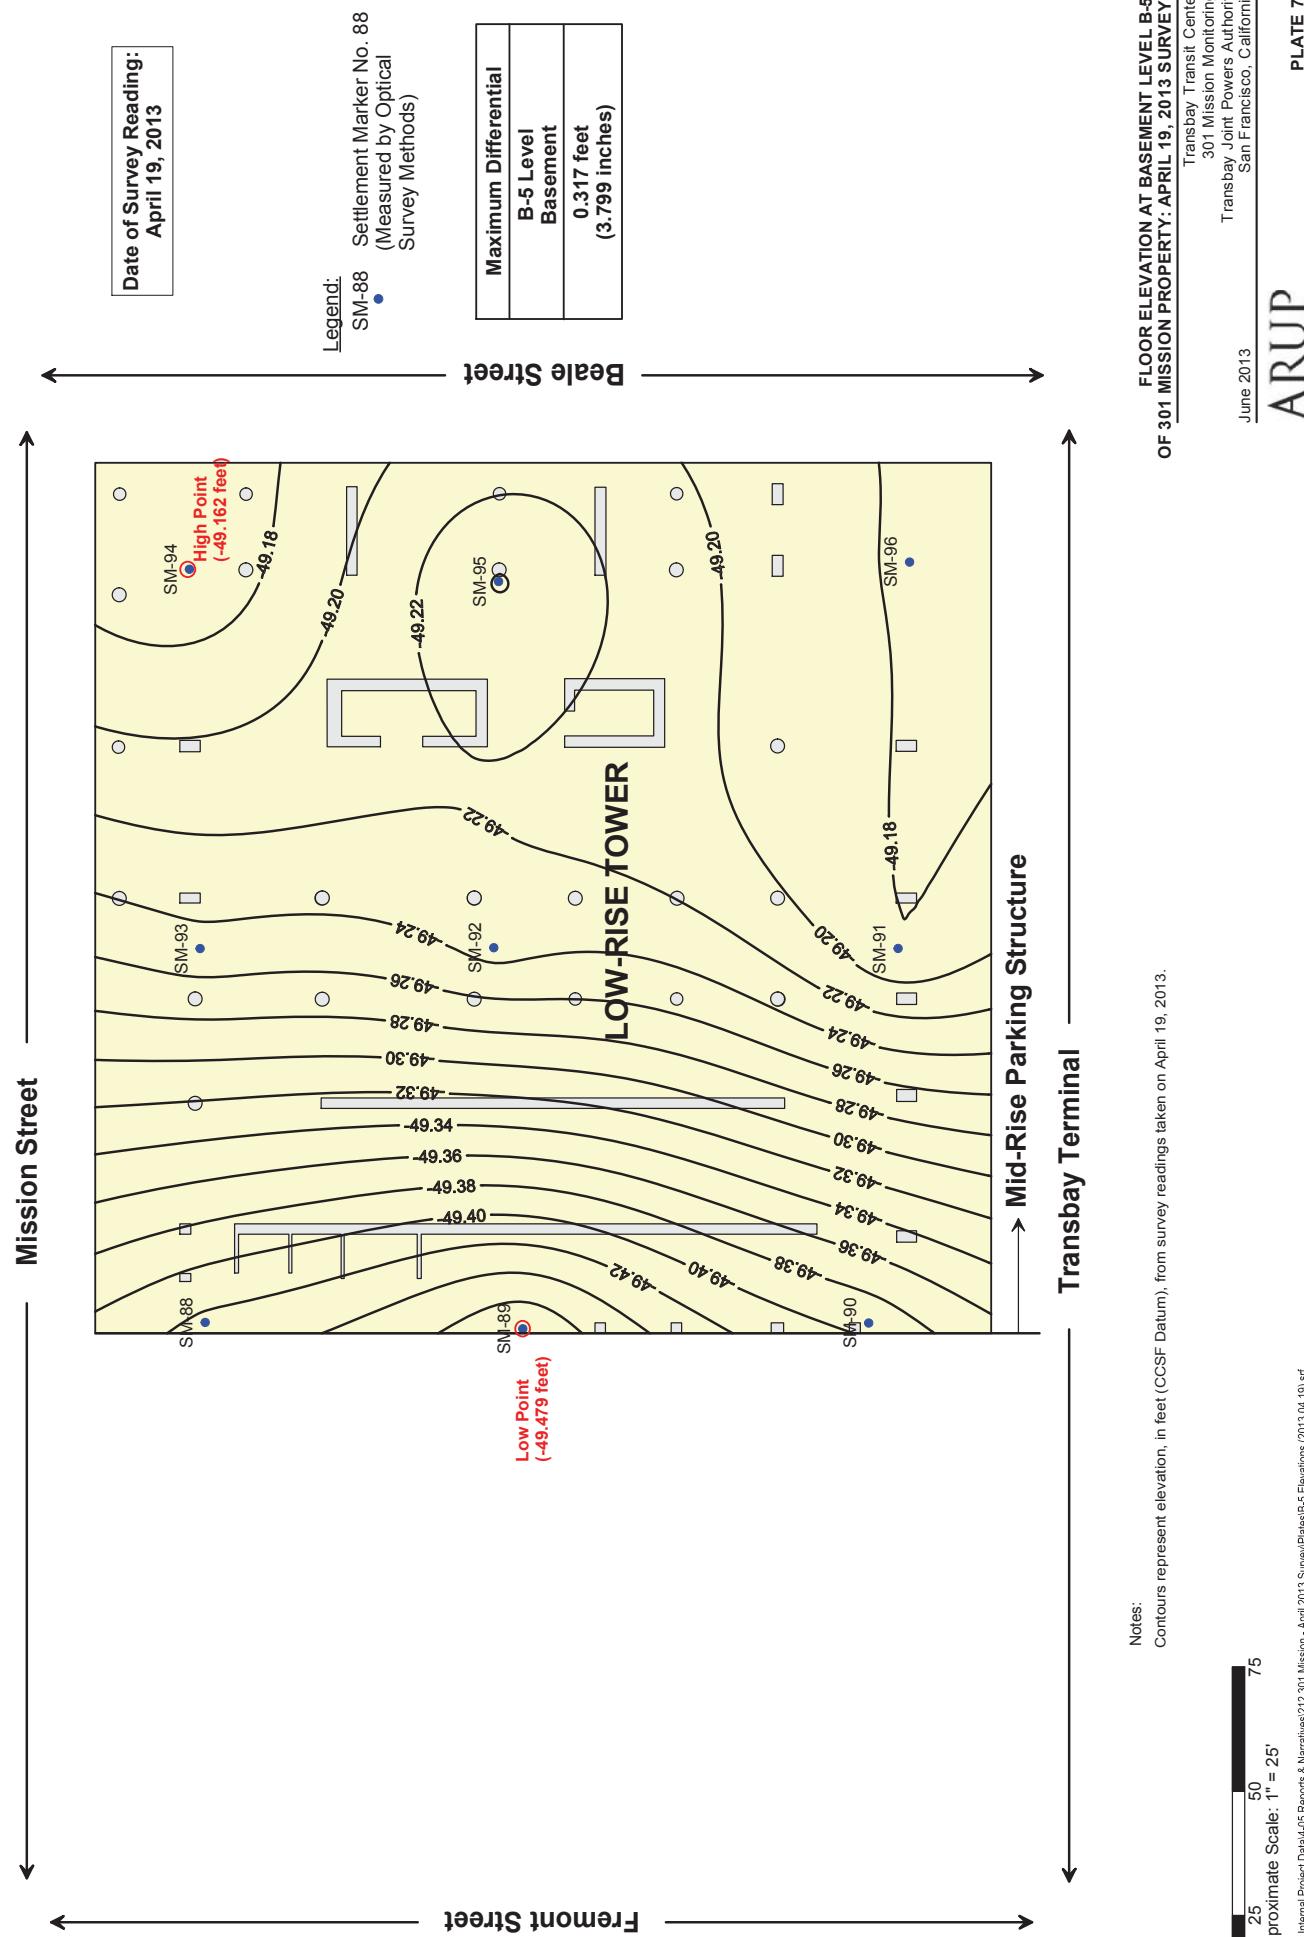

USFS12000113224 Internal Project Data445 Reports & Narratives\212_301 Mission - April 2013 Survey\Pales\B-5 Elevations (2013.04.19).srf


Approximate Scale: 1" = 25'

0 25 50 75

**FLOOR ELEVATION AT BASEMENT LEVEL B-5
OF 301 MISSION PROPERTY: APRIL 19, 2013 SURVEY**

Transbay Transit Center
301 Mission Monitoring
Transbay Joint Powers Authority
San Francisco, California

June 2013

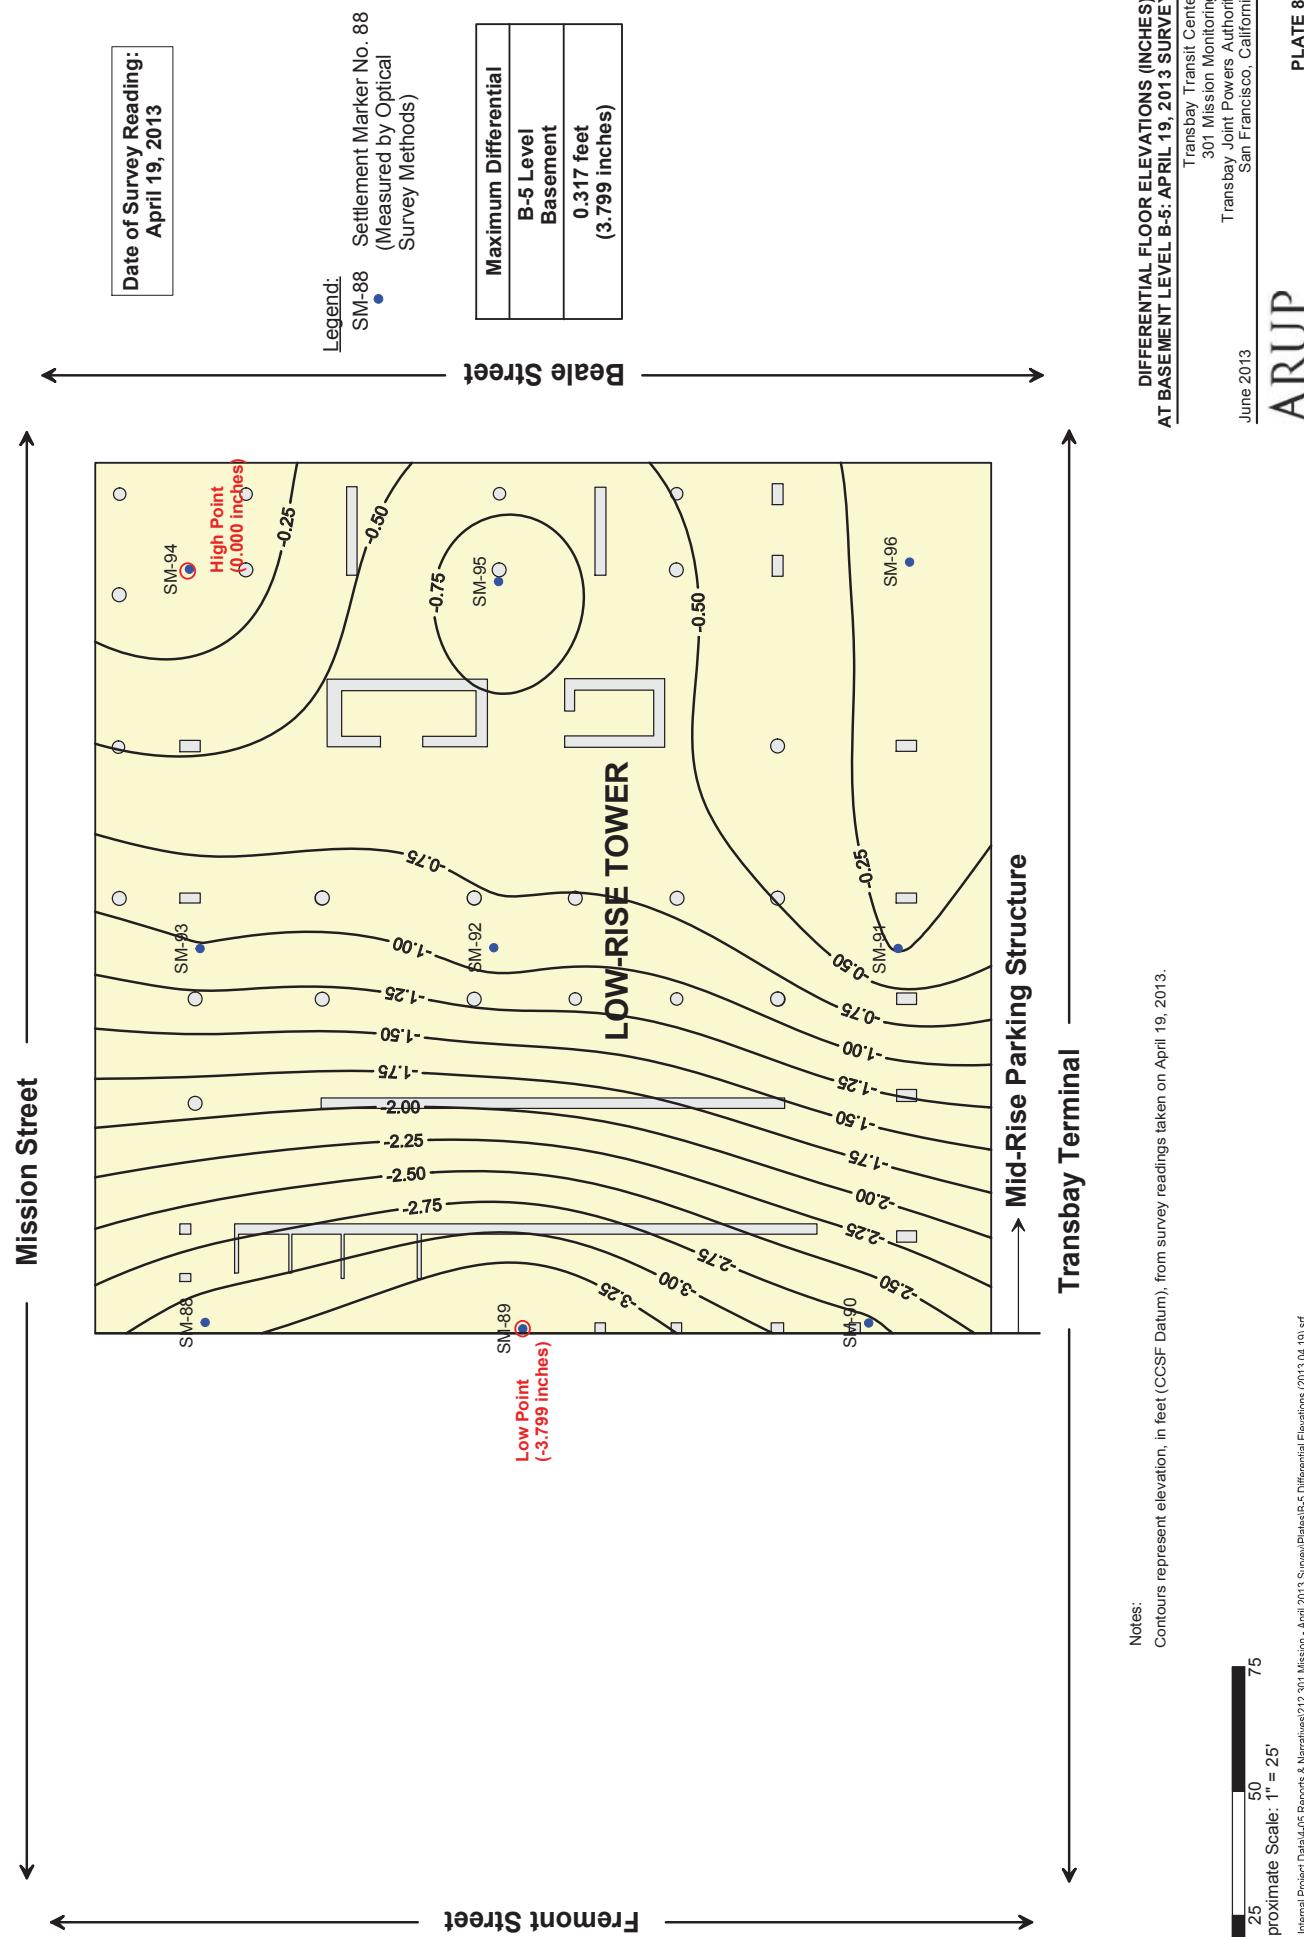

U.S.F.13200011324 Internal Project Data445 Reports & Narratives\1212 301 Mission - April 2013 Survey\Plates\B-5 Differential Elevation (2013.04.19).shp
 Approximate Scale: 1" = 25'

PLATE 8
ARUP

**DIFFERENTIAL FLOOR ELEVATIONS (INCHES)
AT BASEMENT LEVEL B-5, APRIL 19, 2013 SURVEY**

Transbay Transit Center
 301 Mission Monitoring
 Transbay Joint Powers Authority
 San Francisco, California

June 2013

Memorandum


ARUP

To	Brian Dykes (TJPA)	Date
		28 June 2013
Copies	Robert Beck (TJPA) Randy Volenec (PCPA) George Metzger (AAI)	Reference number 132242-60/MHG
From	Michael Gardner (Arup)	File reference 4-05 213
Subject	Transbay Transit Center: Results of June 2013 Settlement Survey at 301 Mission Property	Page 1 of 1

Under Arup's Geotechnical Contract with the Transbay Joint Powers Authority through Pelli Clark Pelli Architects, Arup is required to monitor the settlements of the buildings adjacent to the Transbay Transit Center prior to and during construction. We began the monitoring program for the 301 Mission property in April of 2009. This memorandum and the attached plates present an update to our memorandum dated June 28, 2013 with measurements made through June 2013.

List of Plates

- Plate 1 Floor Elevations at Level B-1 of 301 Mission Property: Periodic Survey – June 3, 2013
- Plate 2 Differential Floor Elevation (Inches) – June 3, 2013 Survey
- Plate 3 Contours of Settlements Measured at the 1st Level Basement of the 301 Mission St. Structure Between 04/30/2009 & 06/03/2013
- Plate 4 Settlement Over Time Floor Elevations at Level B-1 of 301 Mission Property – Tower: April 30, 2009 through June 3, 2013
- Plate 5 Settlement Over Time Floor Elevations at Level B-1 of 301 Mission Property – Mid-Rise: April 30, 2009 through June 3, 2013
- Plate 6 Settlements of the 301 Mission Tower Including Monitoring During Construction
- Plate 7 Floor Elevation at Basement Level B-5 of 301 Mission Property: June 3, 2013 Survey
- Plate 8 Differential Floor Elevations (Inches) at Basement Level B-5: June 3, 2013 Survey

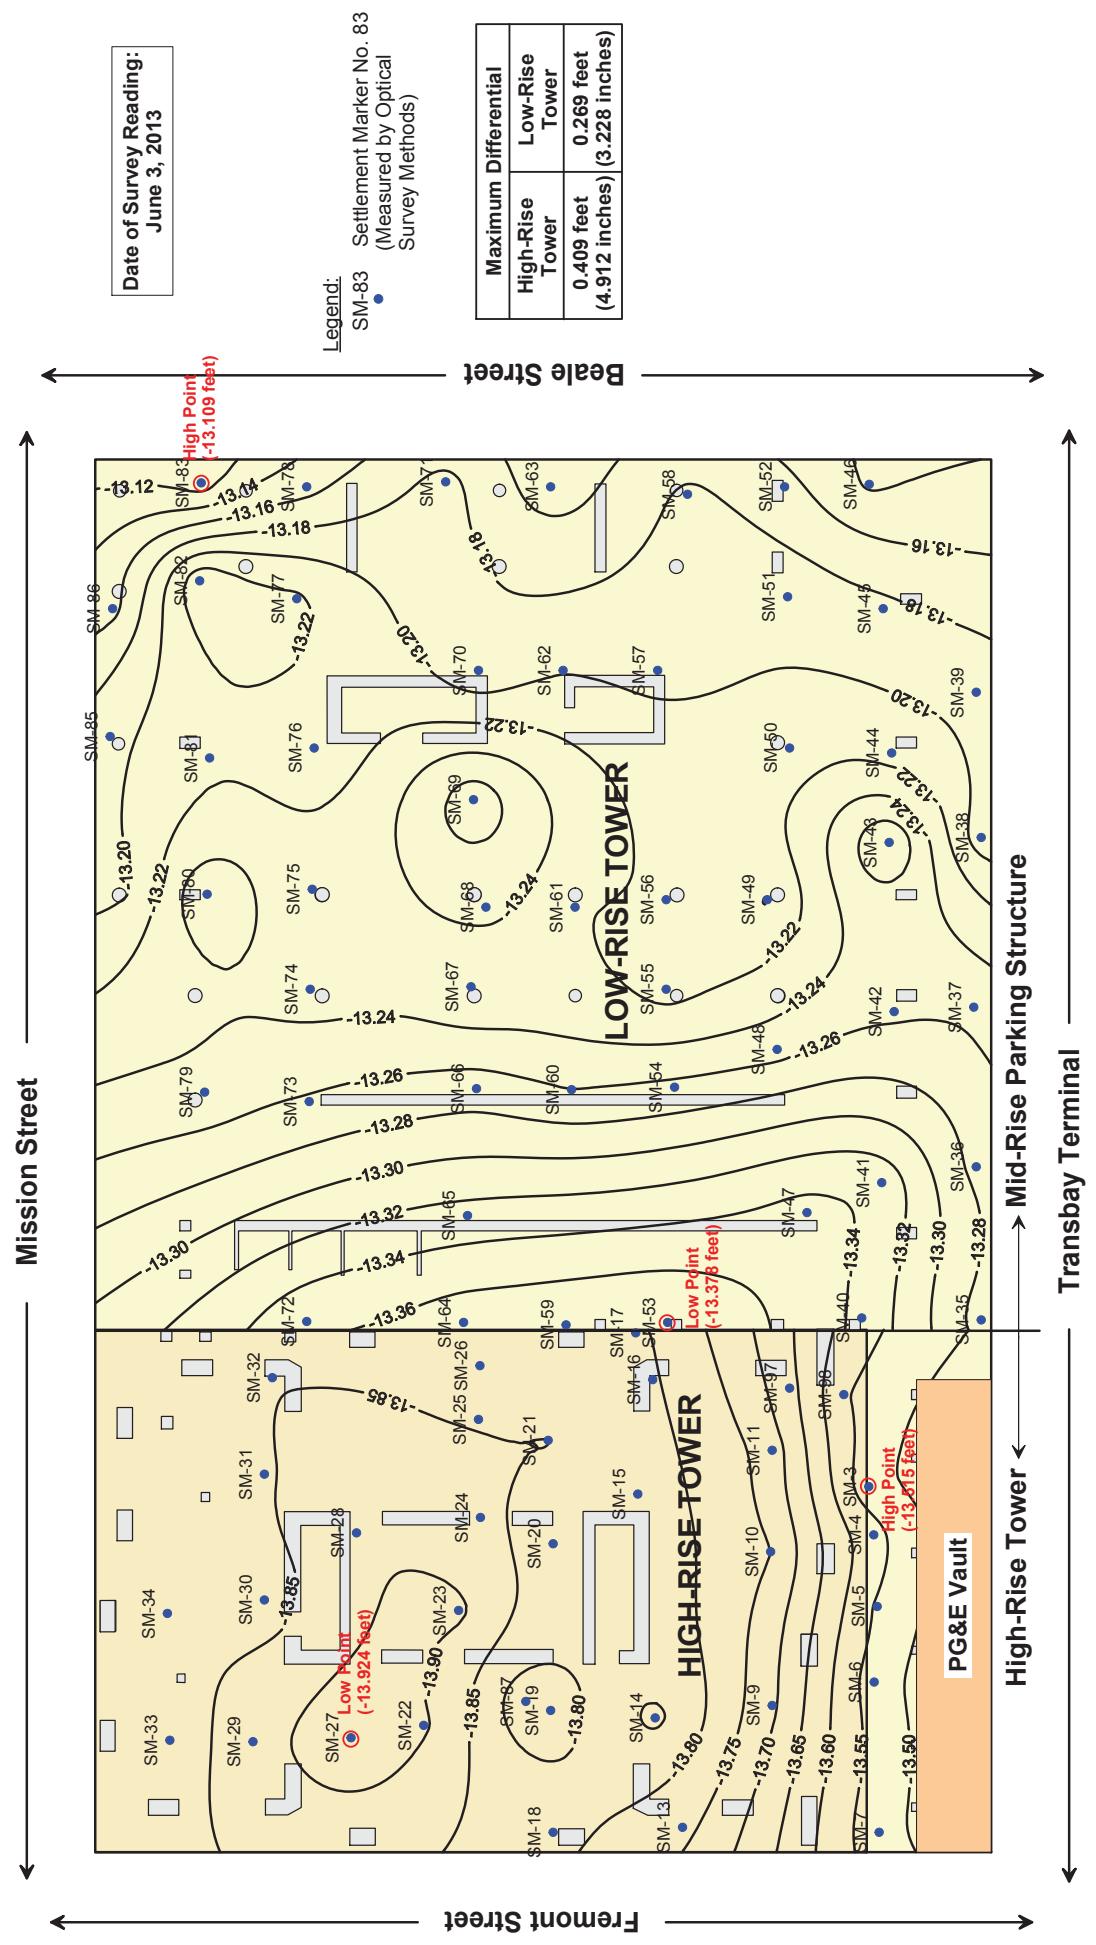

**FLOOR ELEVATIONS AT LEVEL B-1
OF 301 MISSION PROPERTY
PERIODIC SURVEY - JUNE 03, 2013**

Transbay Transit Center
301 Mission Monitoring
Transbay Joint Powers Authority
San Francisco, California

June 2013

Notes:
Contours represent elevation, in feet (CCSF Datum), from survey readings taken on June 3, 2013.
Level B-1 at Mid-Rise Parking portion of survey site is approximately 4 inches higher than Level B-1 at High-Rise Tower portion.

The PG&E vault is inaccessible for monitoring.

Approximate Scale: 1" = 25'
USFS12000113224 Internal Project Data405 Reports & Narratives\213 301 Mission - June 2013 Survey\Plots\Elevations All\213130603.srf

ARUP


PLATE 1


DIFFERENTIAL FLOOR ELEVATIONS (INCHES)
JUNE 03, 2013 SURVEY
Transbay Transit Center
301 Mission Monitoring
Transbay Joint Powers Authority
San Francisco, California

June 2013

U.S. F112000113224 Internal Project Data405 Reports & Narratives212 301 Mission - June 2013 Survey/Plates/Differential Elevation All (2013.06.03).scr

Legend:
SM-83 Settlement Marker No. 83
(Measured by Optical
Survey Methods)

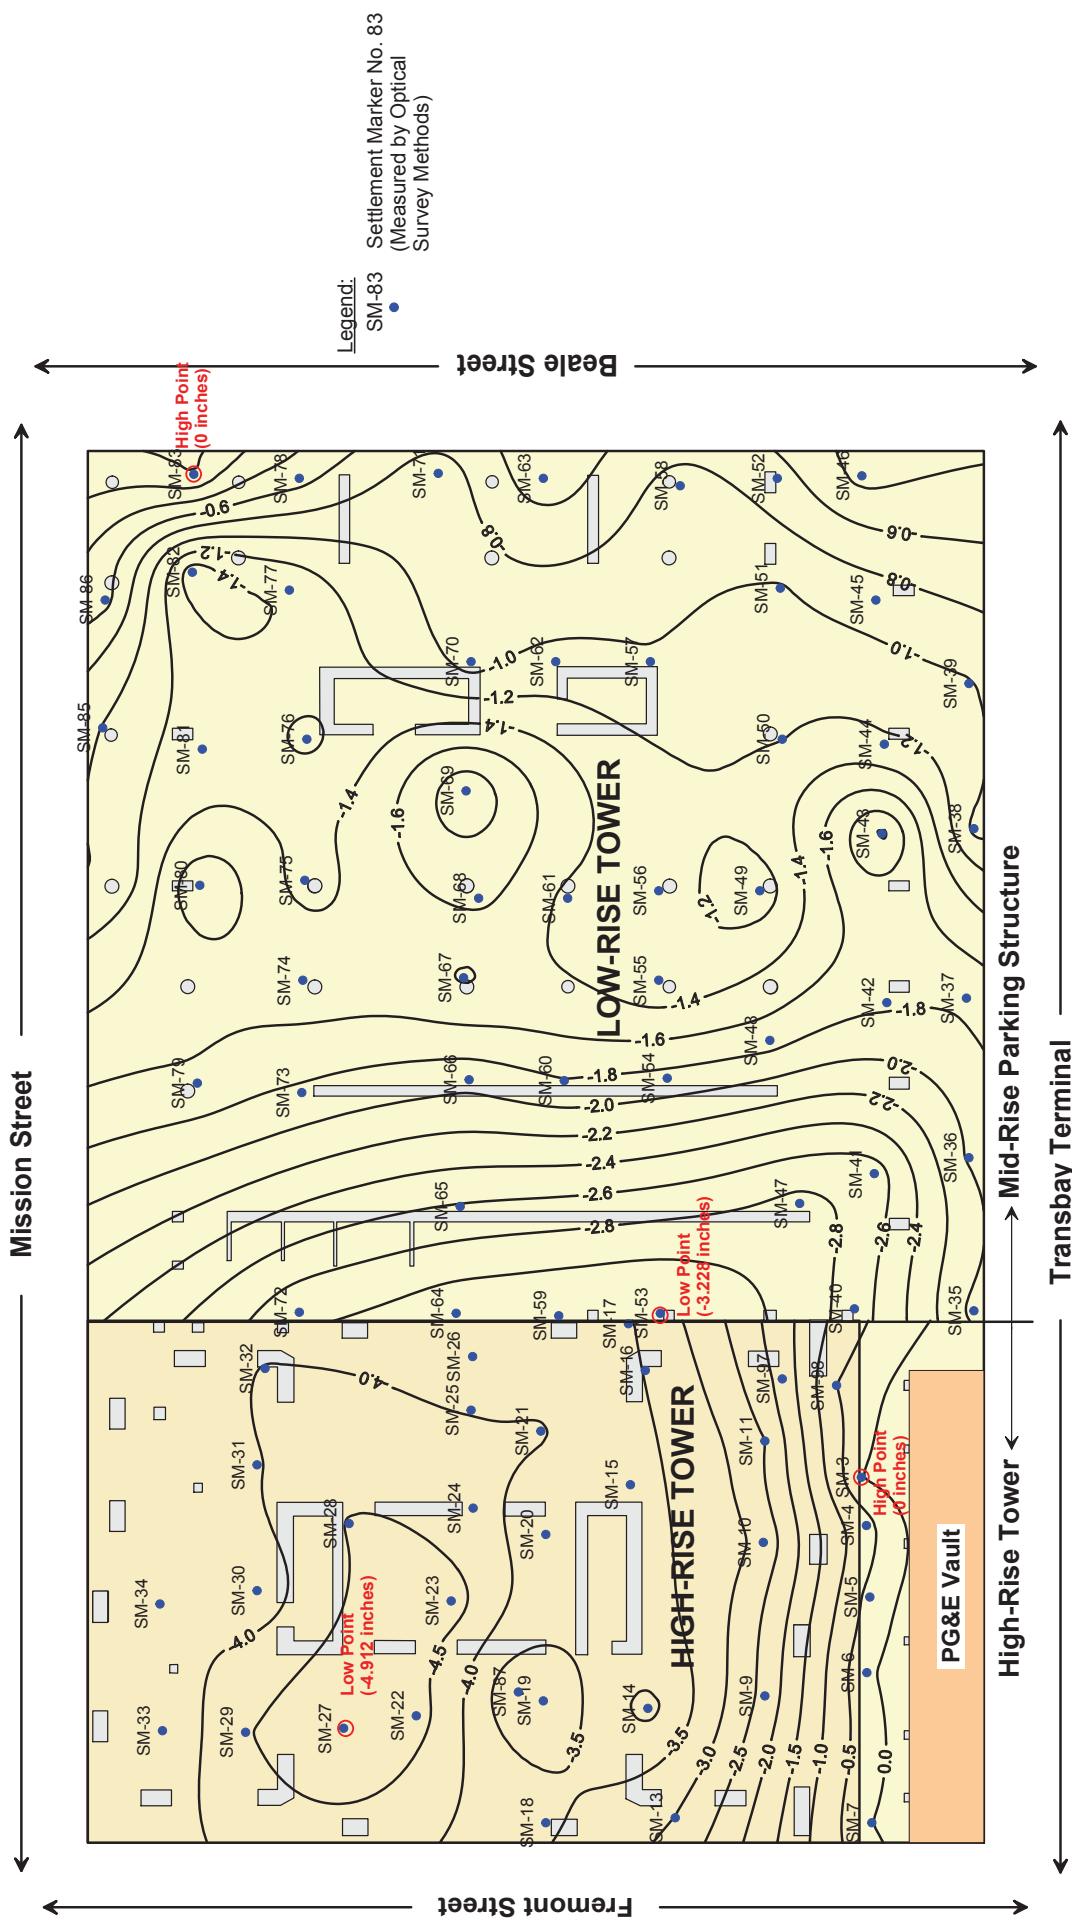

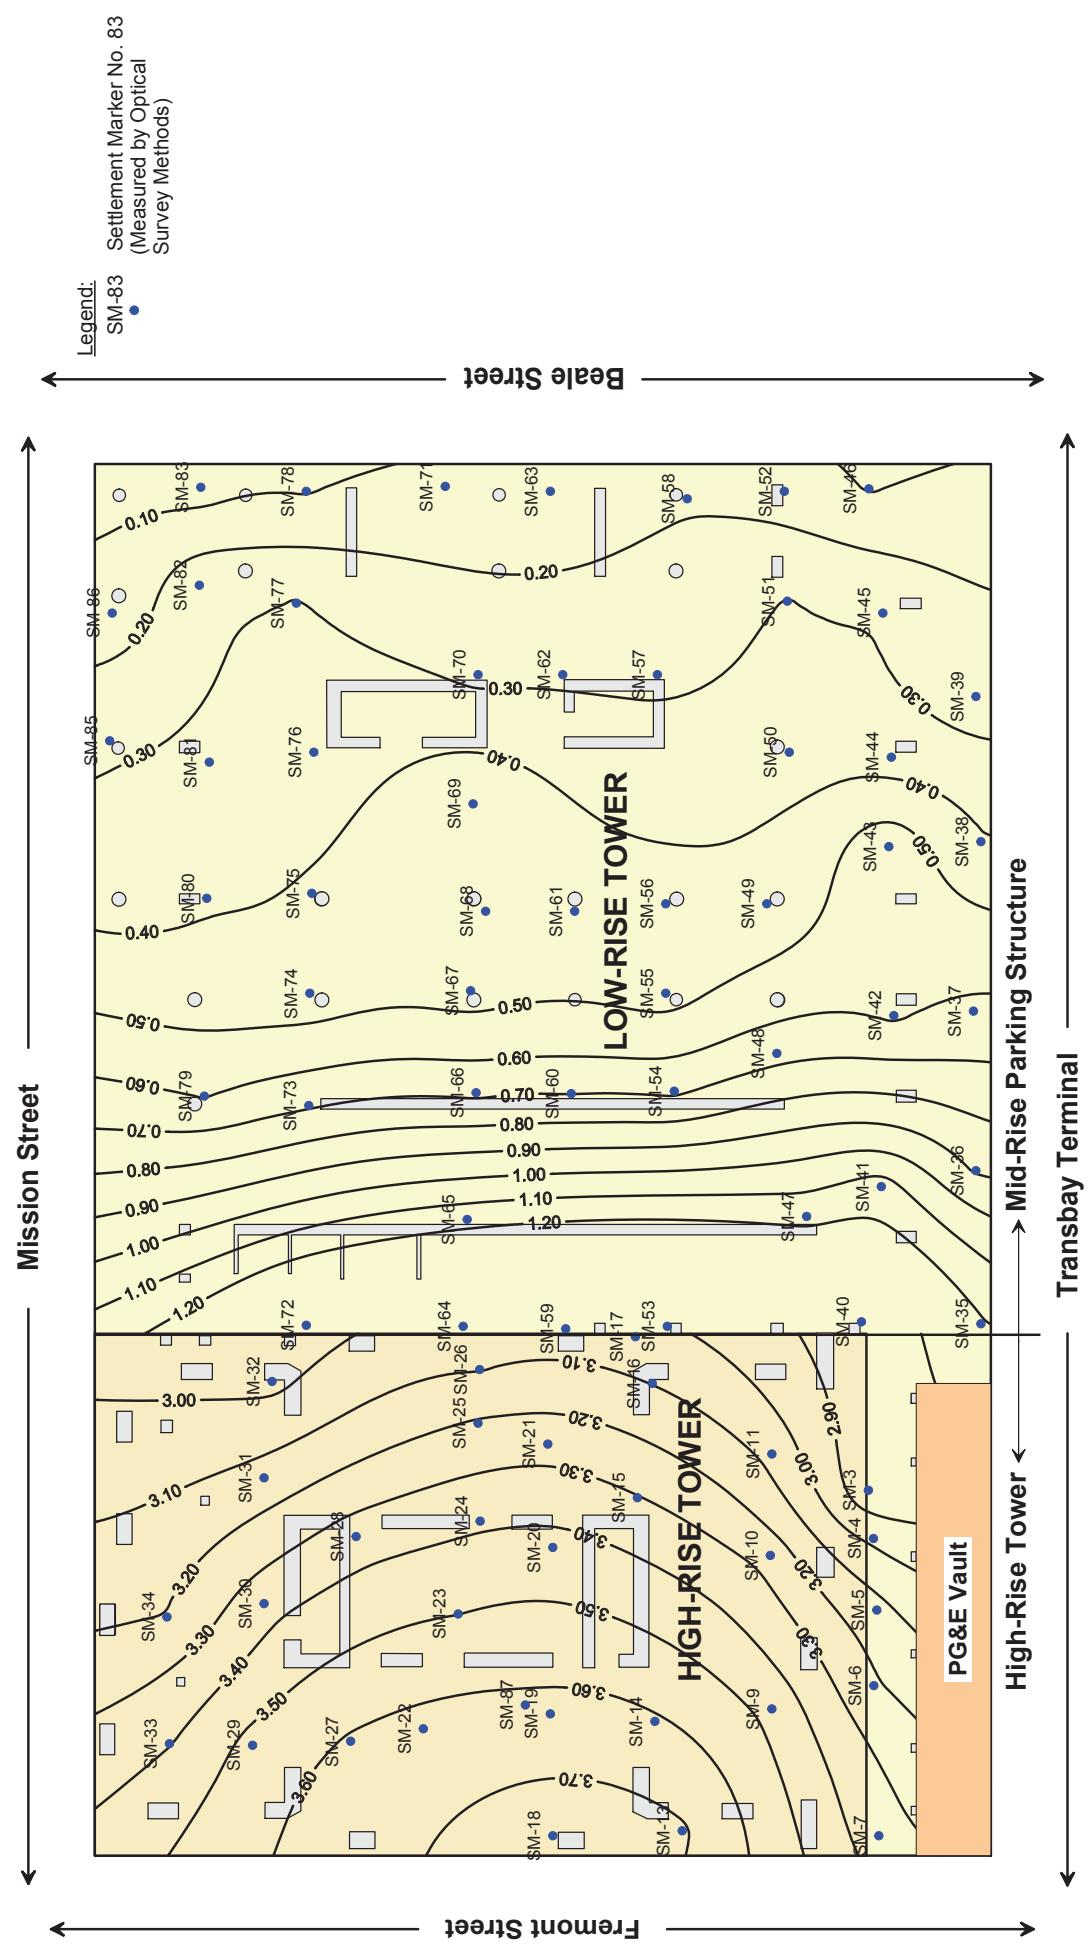

CONTOURS OF SETTLEMENTS MEASURED AT THE 1ST LEVEL BASEMENT OF THE 301 MISSION ST STRUCTURE BETWEEN 04/30/2009 & 06/03/2013
 Transbay Transit Center
 301 Mission Monitoring
 Transbay Joint Powers Authority
 San Francisco, California


June 2013

ARUP
 PLATE 3

Notes:
 Contours represent elevation change, in inches, between Baseline survey (April 30, 2009) and readings taken on June 3, 2013.
 Level B-1 at Mid-Rise Parking portion of survey site is approximately 4 inches higher than Level B-1 at High-Rise Tower portion.

The PG&E vault is inaccessible for monitoring.
 Negative values of settlement (within Low-rise Tower) indicate uplift.


Approximate Scale: 1" = 25'
 USFS120001132424 Internal Project Data\405 Reports & Narratives\213 301 Mission - June 2013 Survey\Ptles\Elevation changes All (2013.06.03).sr

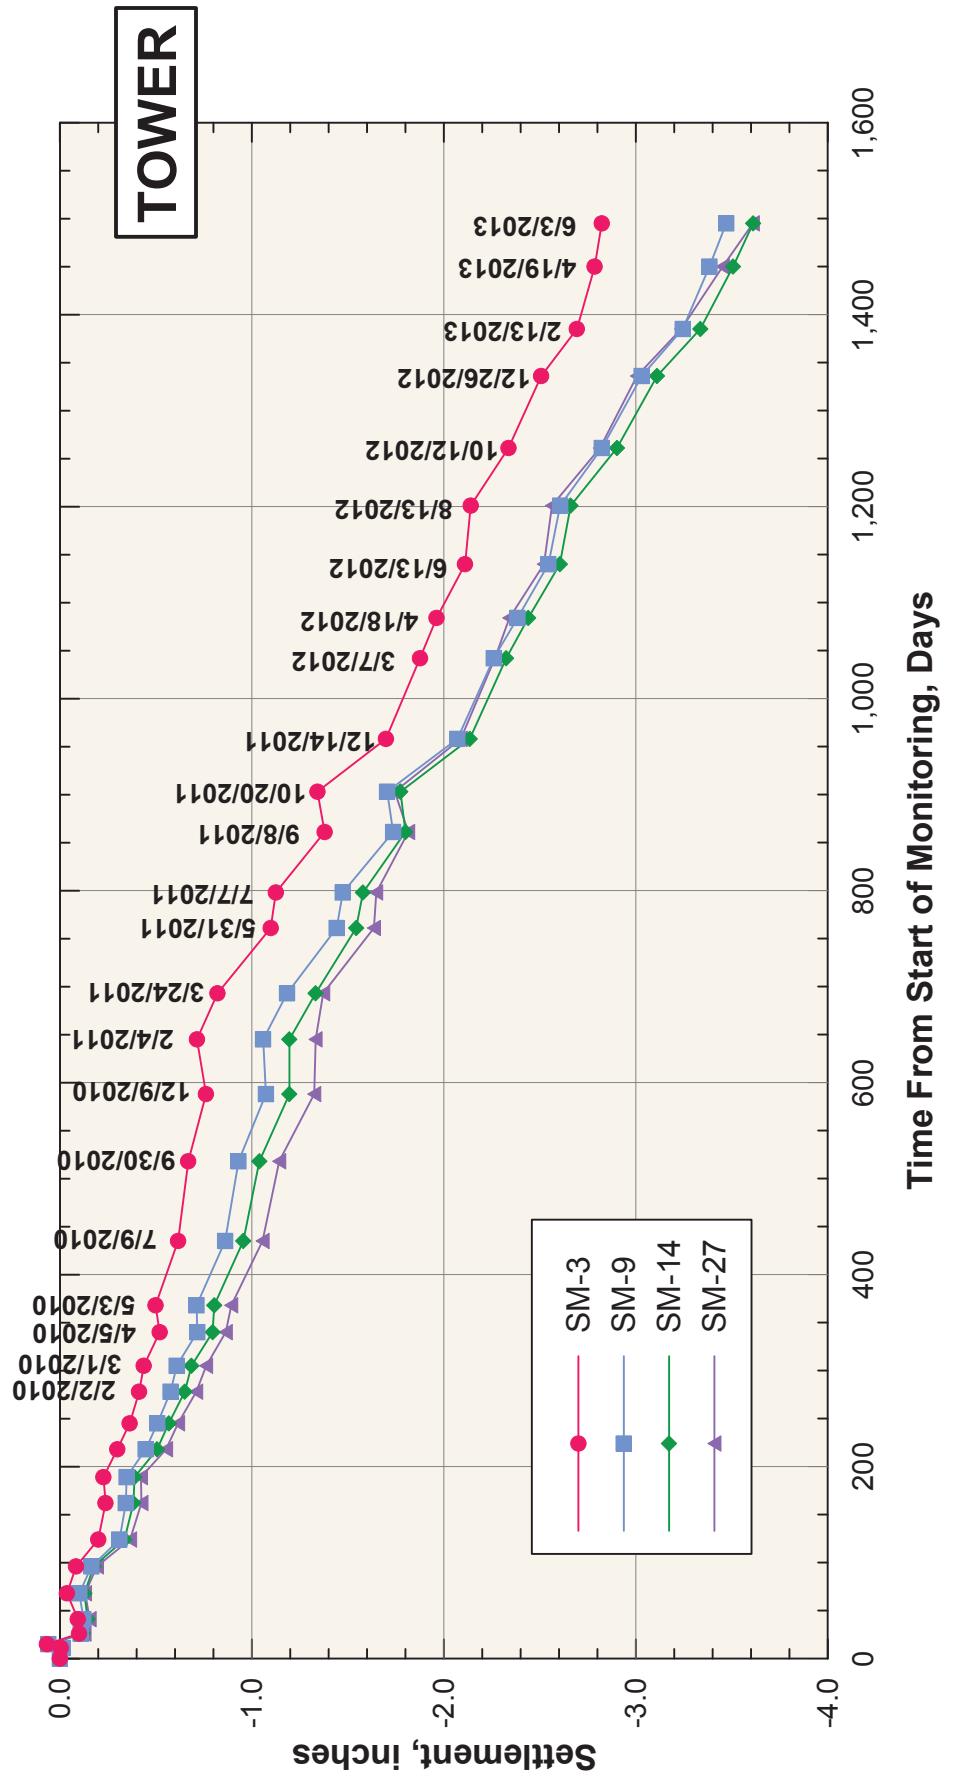


ARUP

**SETTLEMENT OVER TIME
FLOOR ELEVATIONS AT LEVEL B-1
OF 301 MISSION PROPERTY - MID-RISE:
APRIL 30, 2009 THROUGH JUNE 03, 2013**

Transbay Transit Center
301 Mission Monitoring
Transbay Joint Powers Authority
San Francisco, California

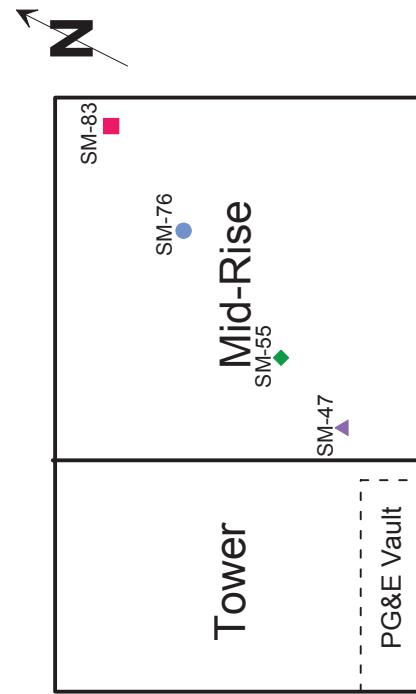

Time From Start of Monitoring, Days

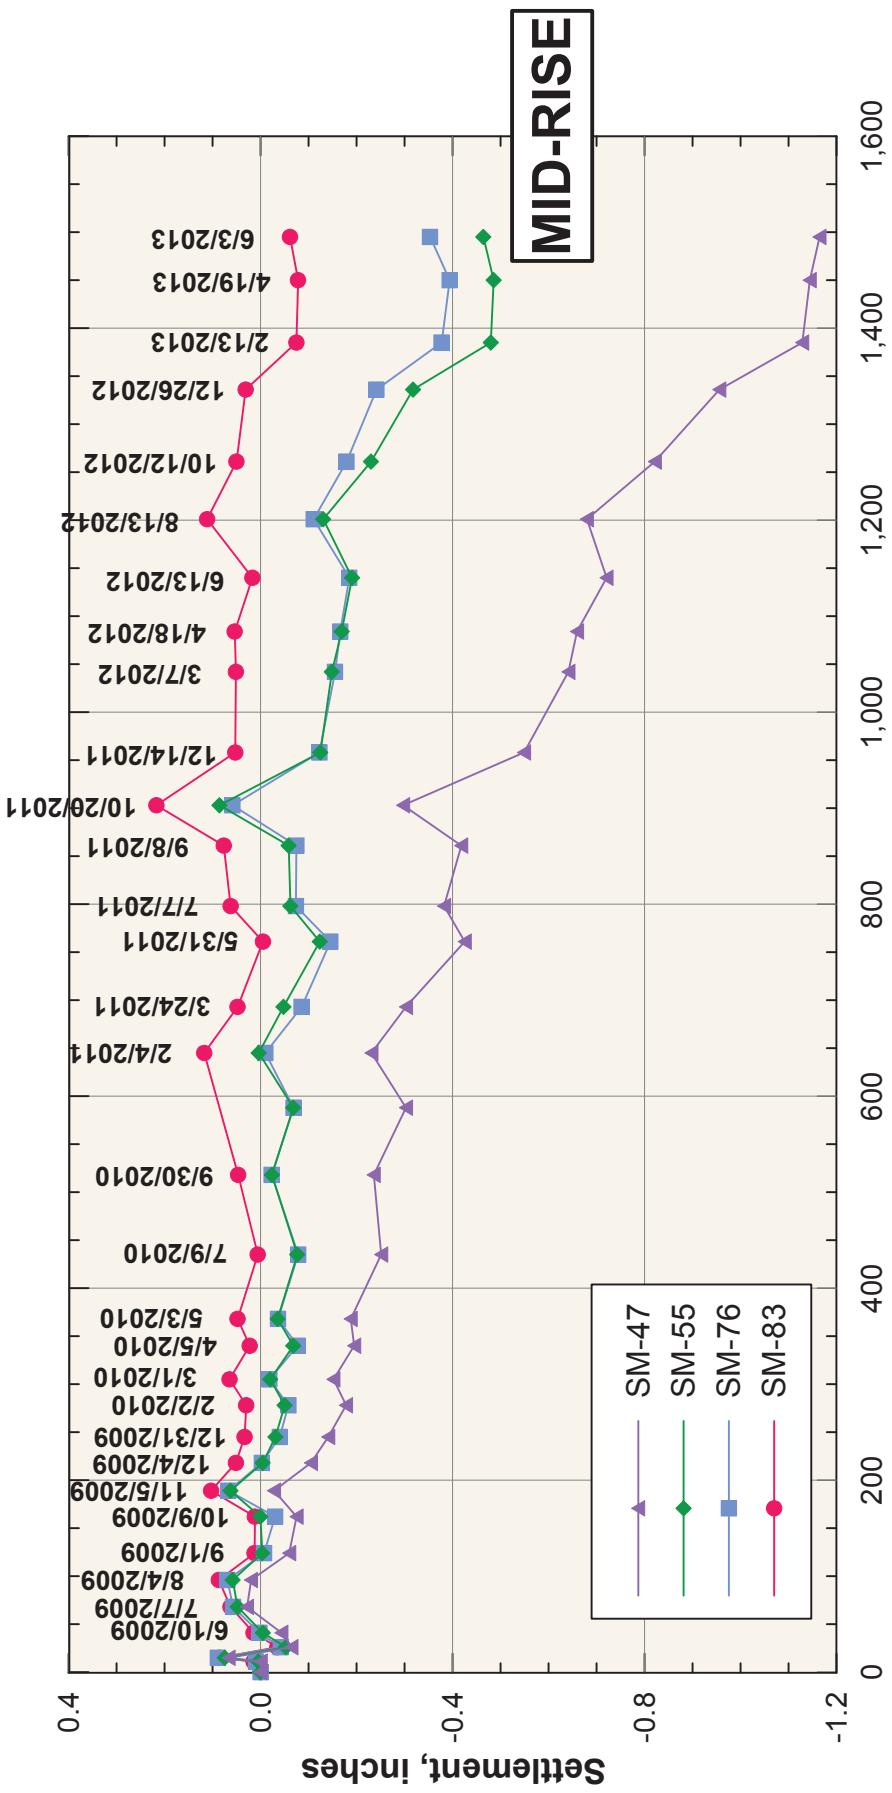


Note:
**Initial (Baseline) reading
taken on 04/30/09**

ARUP


**SETTLEMENTS OF THE 301 MISSION TOWER
INCLUDING MONITORING DURING CONSTRUCTION**


Transbay Transit Center
301 Mission Monitoring
Transbay Joint Powers Authority
San Francisco, California

June 2013

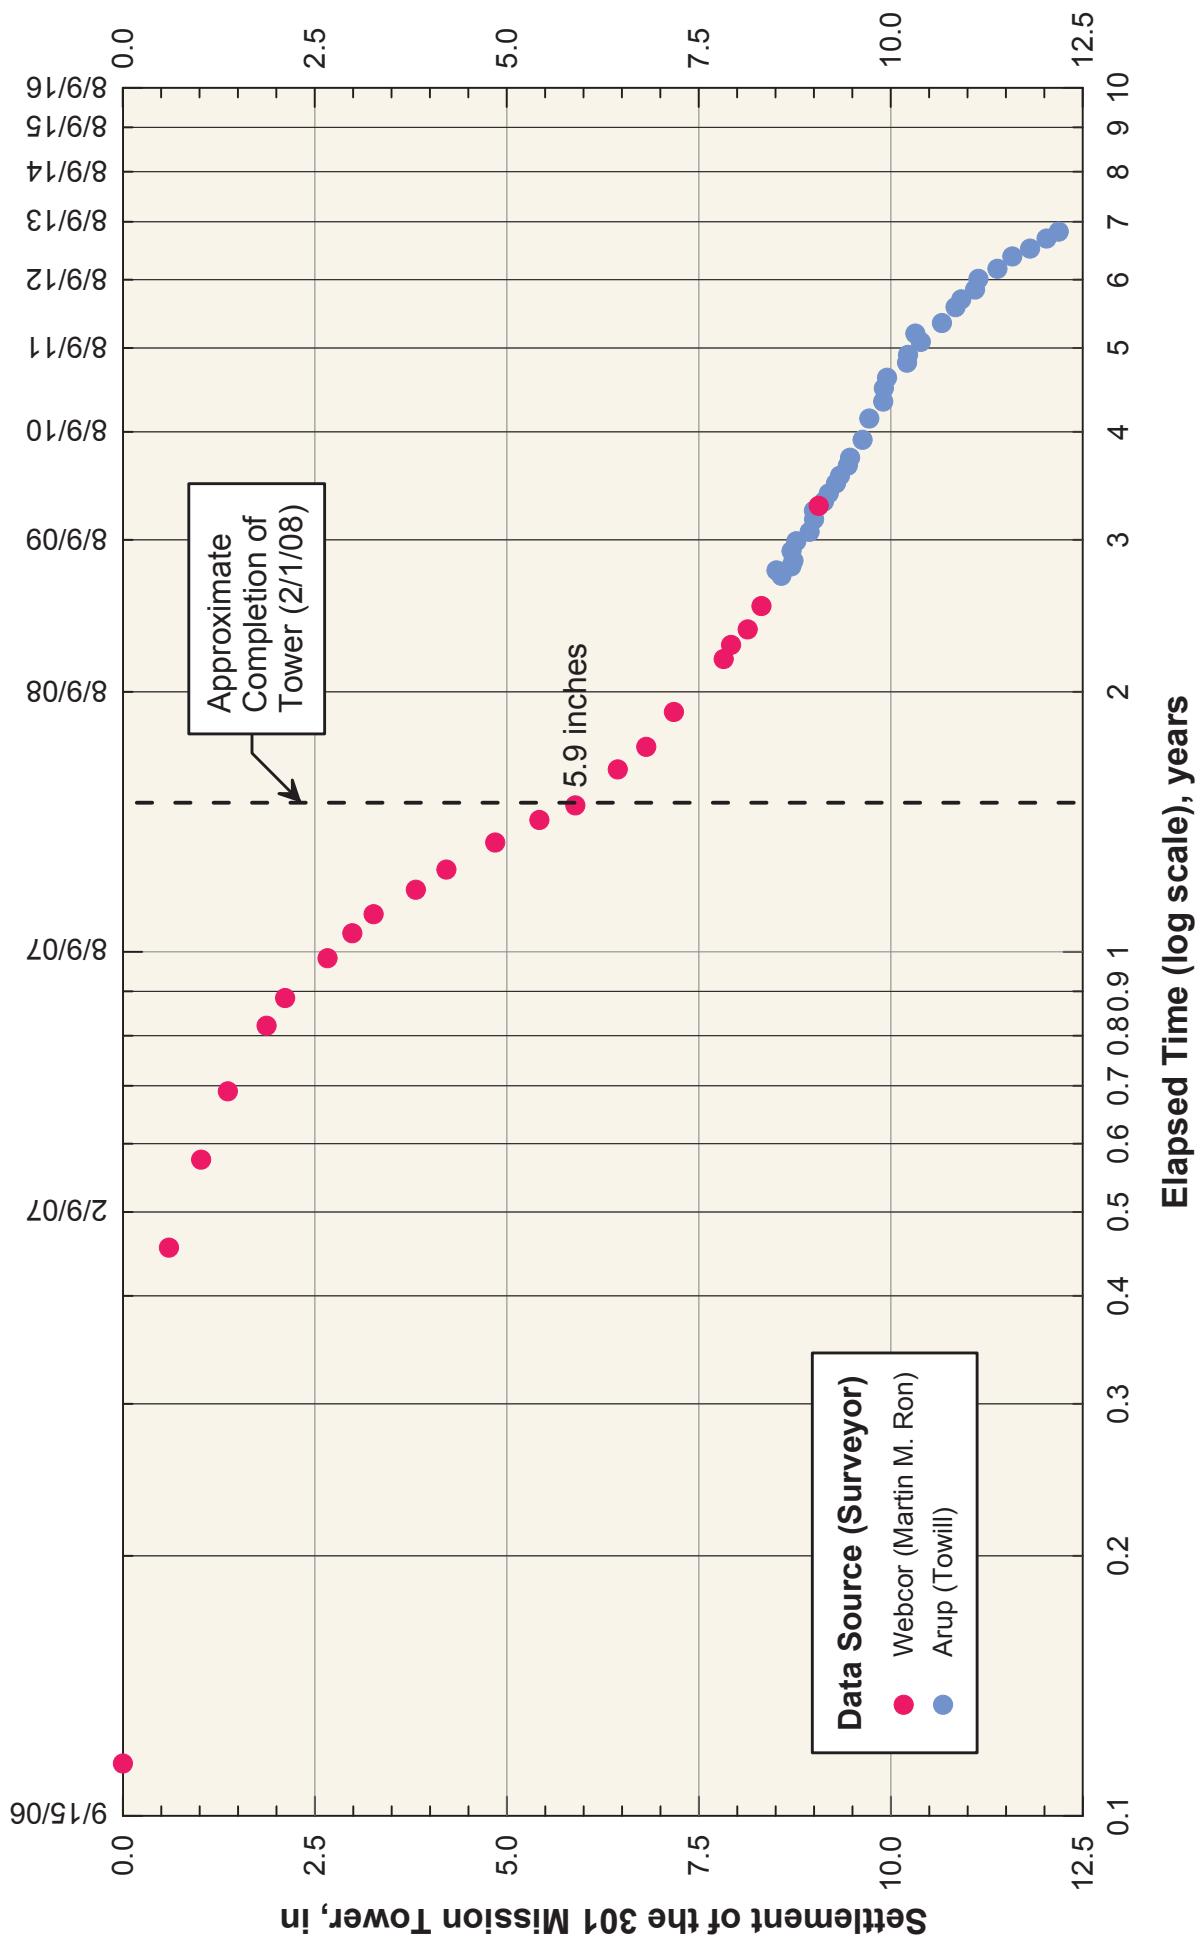

Beginning of Tower Construction: 8/9/06
End of Tower Construction: 2/1/08
Construction Duration: 542 days (1.5 years)

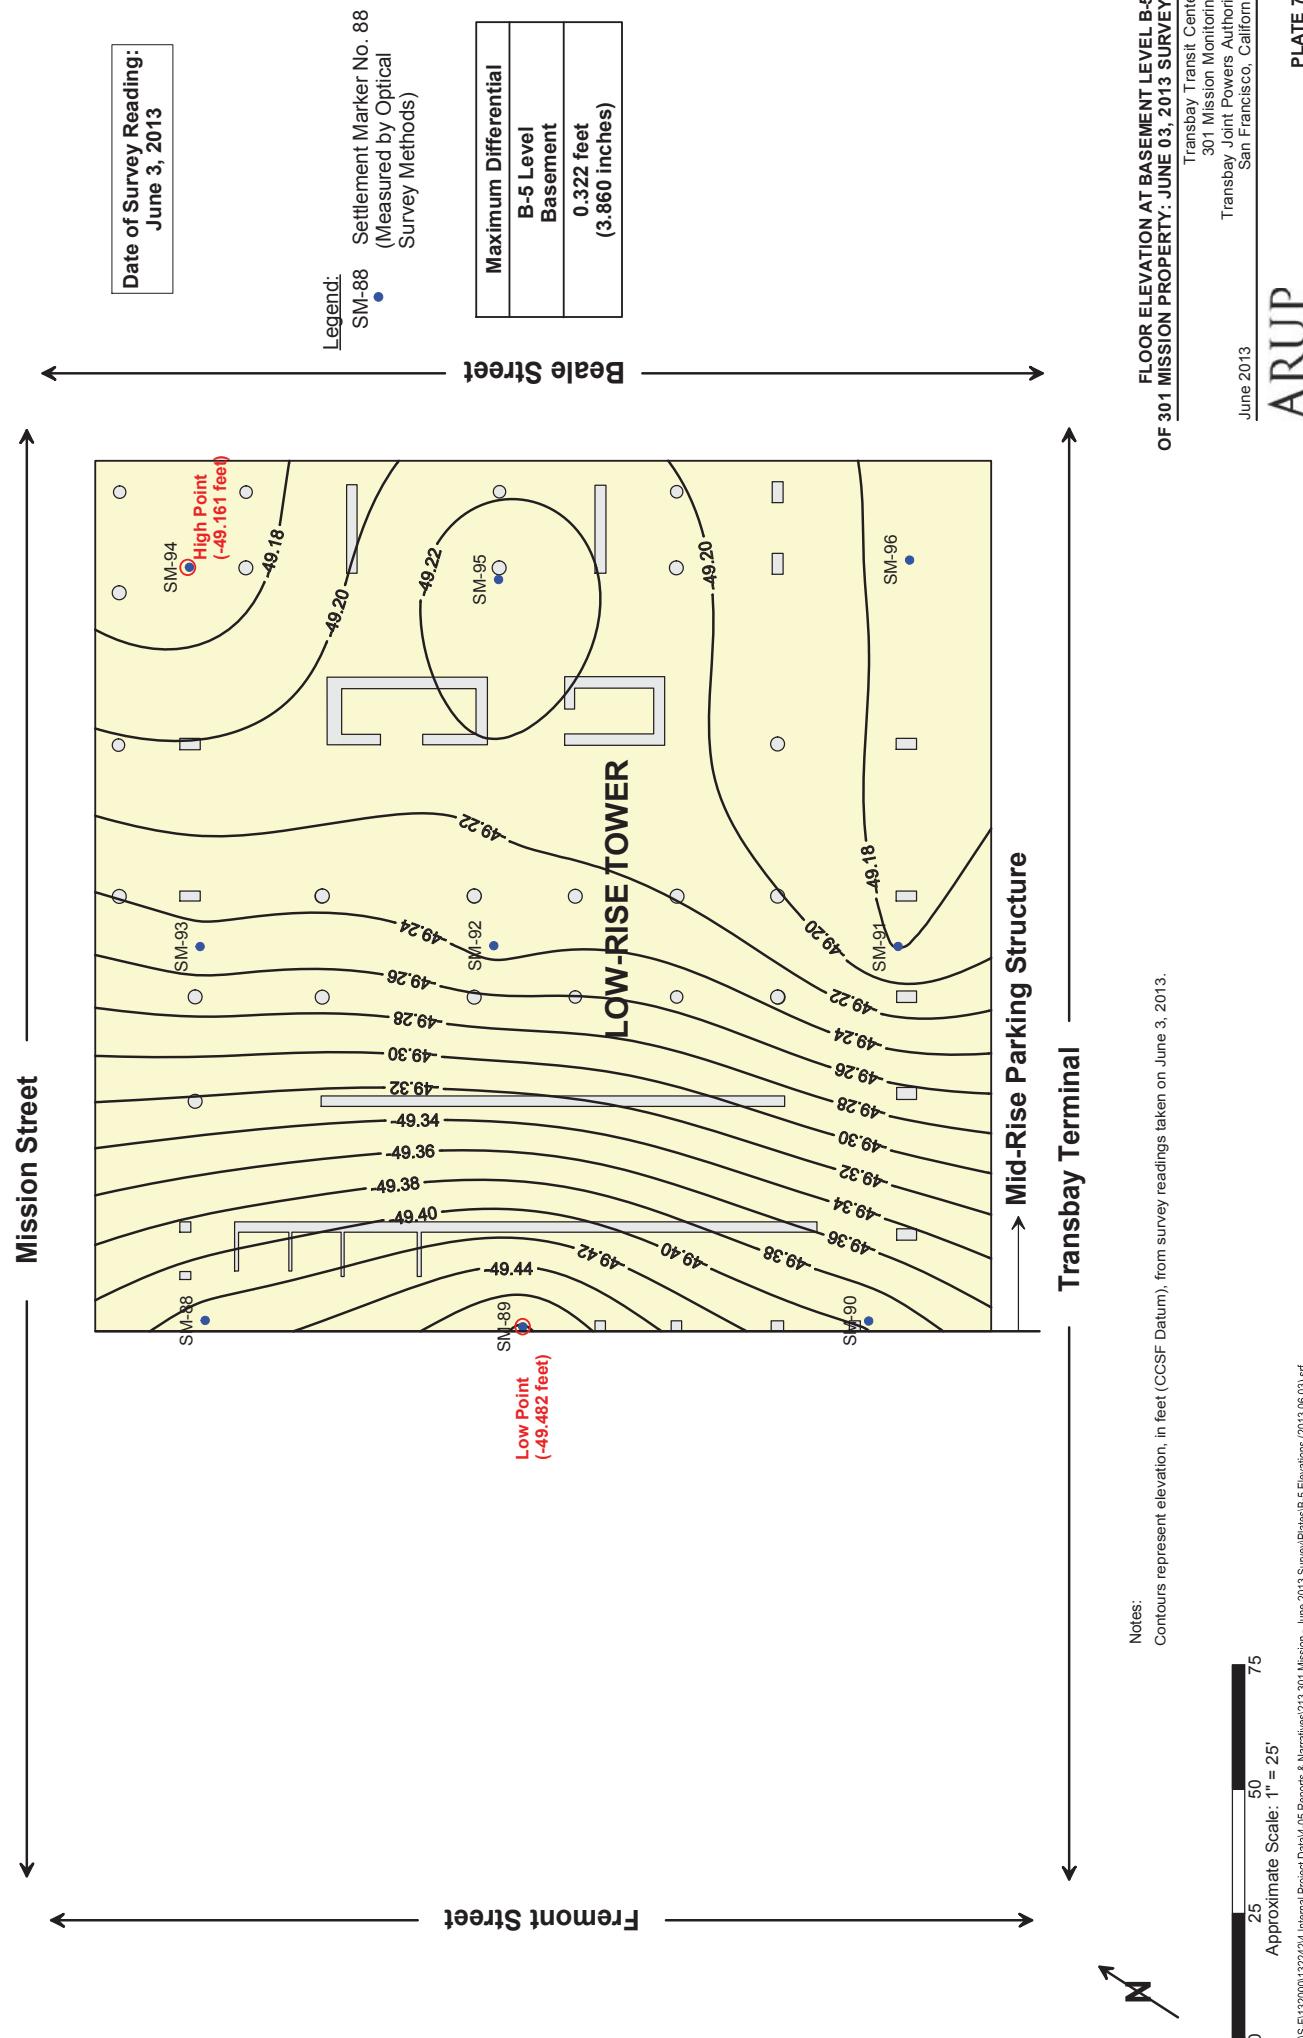

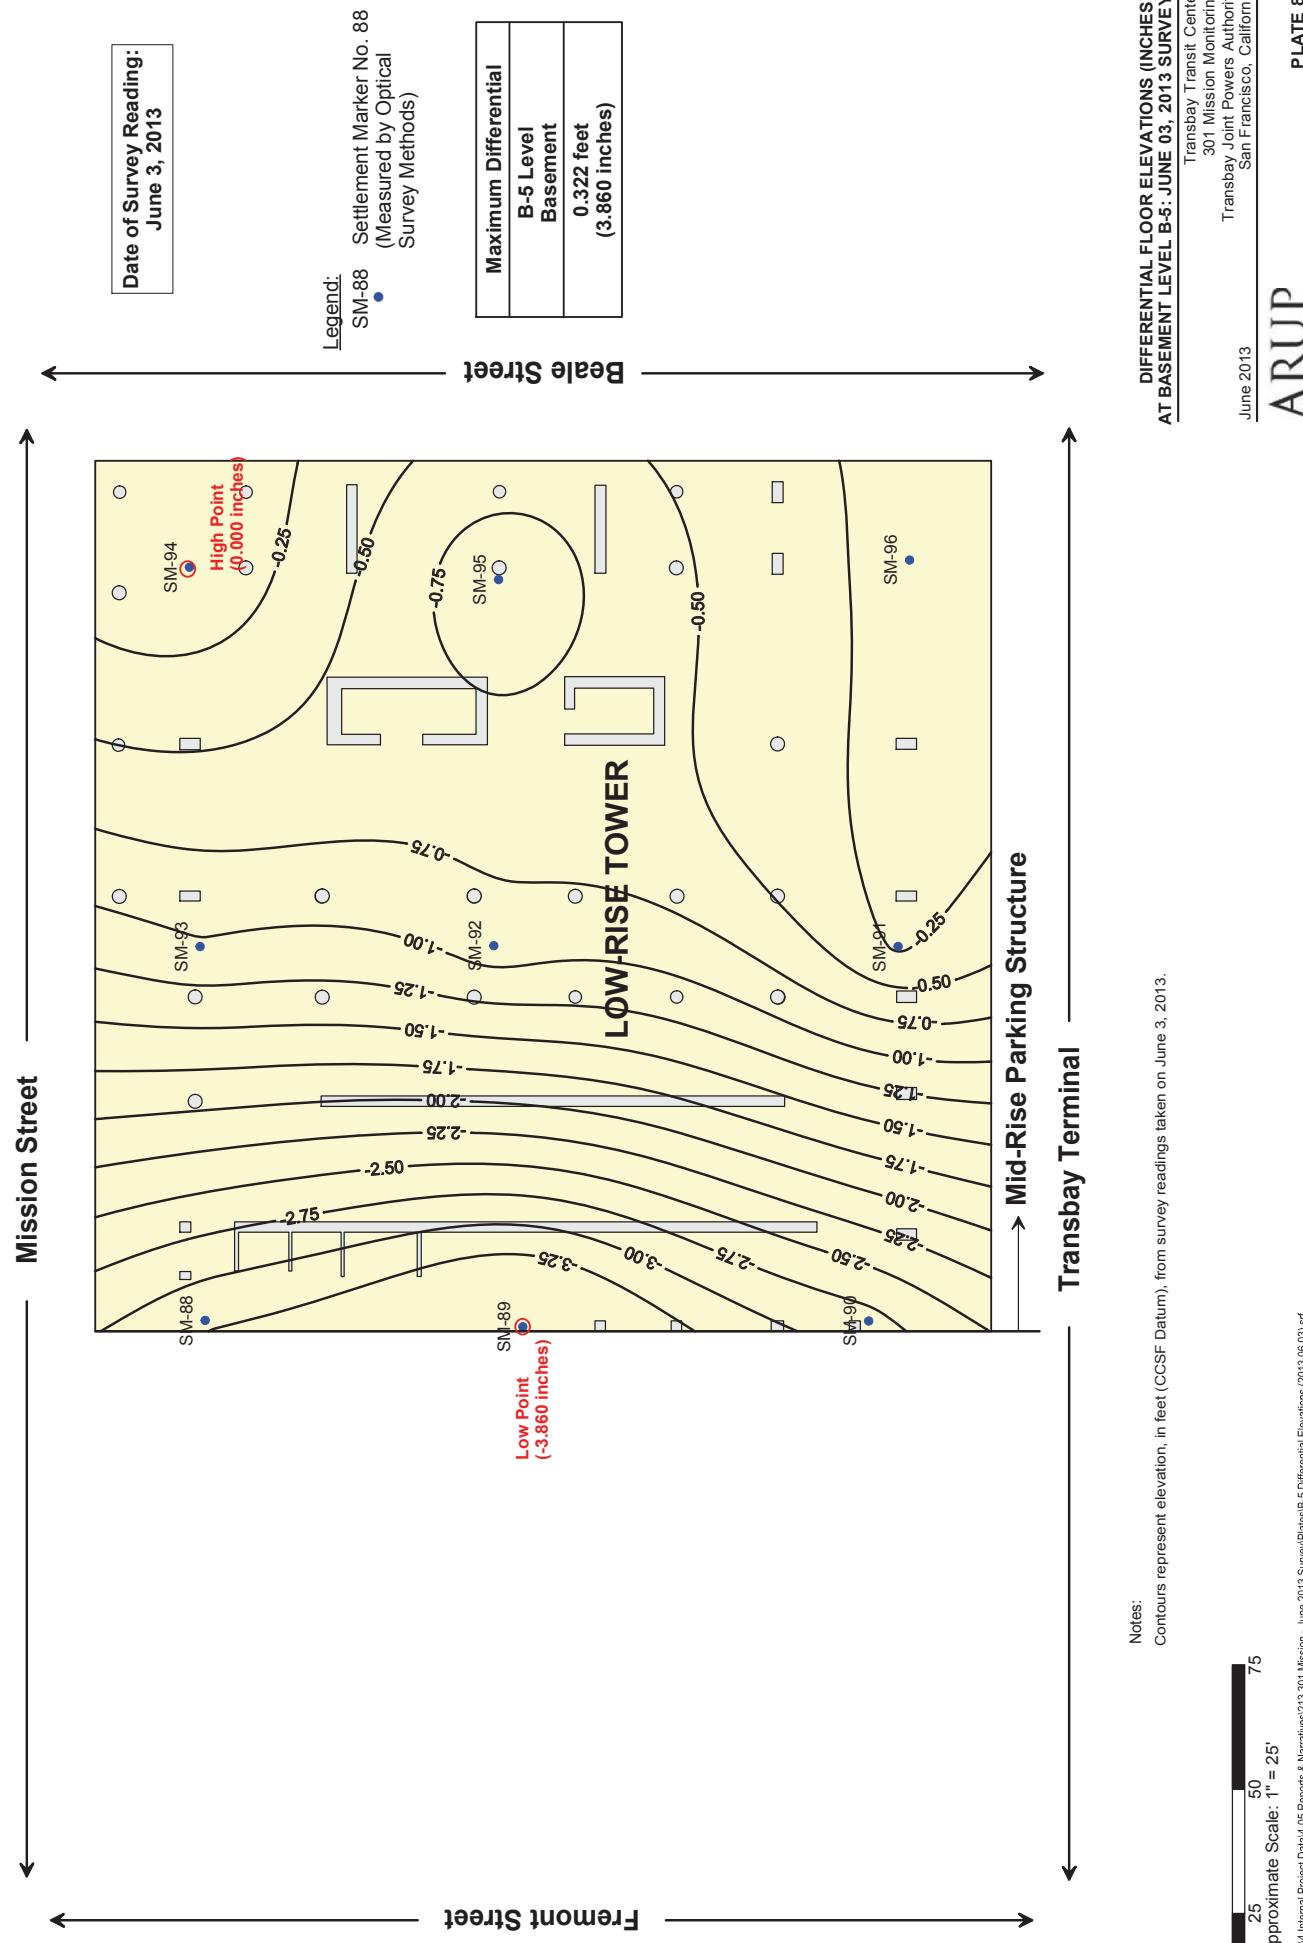

From: Brian Dykes <bdykes@transbaycenter.org>
Sent: Wednesday, November 20, 2013 1:51 PM
To: Steven Hood
Subject: FW: TTC - 301 Mission October Survey Memo
Attachments: 2013-11-13 Memo_301 Mission Settlement - Oct 2013 Survey.pdf

Steven,
Here is the October settlement memorandum from Arup. I now have the raw data readings and will forward them next.
Regards, Brian.

From: Stephen McLandrich [<mailto:stephen.mclandrich@arup.com>]
Sent: Wednesday, November 13, 2013 11:37 AM
To: Brian Dykes
Cc: Nick O'Riordan; Dennis Turchon; George Metzger; 'rvolenec@pcparch.com' (rvolenec@pcparch.com)
Subject: TTC - 301 Mission October Survey Memo

Brian,

Please find the attached memorandum which shows the October 2013 readings of the 301 Mission survey.

Please let me know if you have any questions.

Regards,
Stephen

Stephen McLandrich PE GE
Senior Geotechnical Engineer

Arup
560 Mission Street Suite 700 San Francisco CA 94105 USA
t +1 415 957 9445 d +1 415 946 0245
f +1 415 957 9096 c +1 415 310 1095
www.arup.com

Arup named ENR California's
DESIGN FIRM OF THE YEAR 2013

Memorandum


ARUP

To	Brian Dykes (TJPA)	Date
		13 November 2013
Copies	Randy Volenec (PCPA) George Metzger (AAI)	Reference number
		132242-60/MHG
From	Stephen McLandrich (Arup)	File reference
		4-05 213
Subject	Transbay Transit Center: Results of October 2013 Settlement Survey at 301 Mission Property	Page 1 of 1

Under Arup's Geotechnical Contract with the Transbay Joint Powers Authority through Pelli Clark Pelli Architects, Arup is required to monitor the settlements of the buildings adjacent to the Transbay Transit Center prior to and during construction. We began the monitoring program for the 301 Mission property in April of 2009. This memorandum and the attached plates present an update to our memorandum dated June 28, 2013 with measurements made through October 2013.

List of Plates

- Plate 1 Floor Elevations at Level B-1 of 301 Mission Property: Periodic Survey – October 9, 2013
- Plate 2 Differential Floor Elevation (Inches) – October 9, 2013 Survey
- Plate 3 Contours of Settlements Measured at the 1st Level Basement of the 301 Mission St. Structure Between 04/30/2009 & 10/09/2013
- Plate 4 Settlement Over Time Floor Elevations at Level B-1 of 301 Mission Property – Tower: April 30, 2009 through October 9, 2013
- Plate 5 Settlement Over Time Floor Elevations at Level B-1 of 301 Mission Property – Mid-Rise: April 30, 2009 through October 9, 2013
- Plate 6 Settlements of the 301 Mission Tower Including Monitoring During Construction
- Plate 7 Floor Elevation at Basement Level B-5 of 301 Mission Property: October 9, 2013 Survey
- Plate 8 Differential Floor Elevations (Inches) at Basement Level B-5: October 9, 2013 Survey

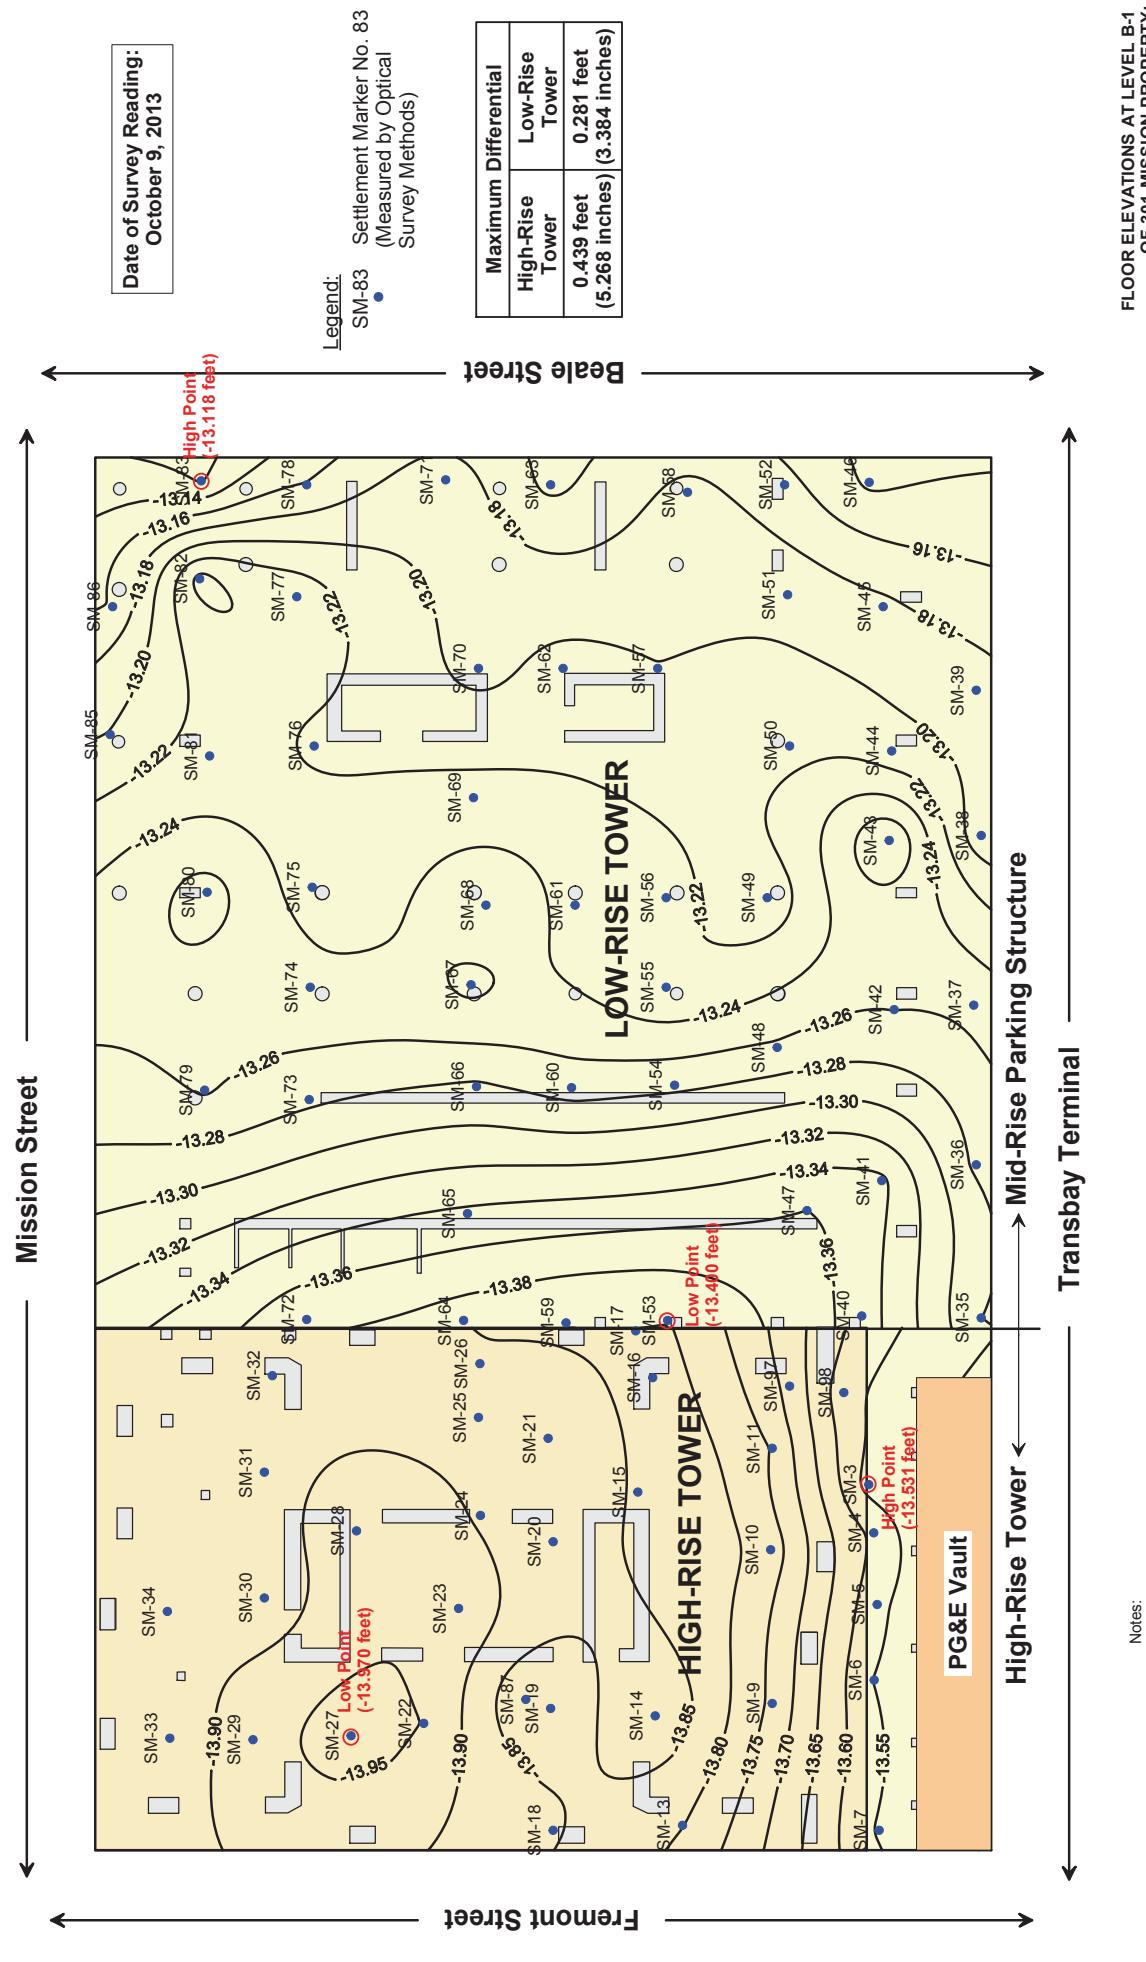

**FLOOR ELEVATIONS AT LEVEL B-1
OF 301 MISSION PROPERTY:
PERIODIC SURVEY - OCTOBER 9, 2013**

Transbay Transit Center
301 Mission Monitoring
Transbay Joint Powers Authority
San Francisco, California

November 2013

PLATE 1

ARUP


Notes:
 Contours represent elevation, in feet (CCSF Datum), from survey readings taken on October 9, 2013.
 Level B-1 at Mid-Rise Parking portion of survey site is approximately 4 inches higher than Level B-1 at High-Rise Tower portion.
 The PG&E vault is inaccessible for monitoring.


Approximate Scale: 1" = 25'
 JNS-F132000132424 Internal Project Data\4-05 Reports & Narratives\221_301 Mission - October 2013 Survey\Plates\Elevations All (2013.10.09).srf

ARUP

DIFFERENTIAL FLOOR ELEVATIONS (INCHES)
OCTOBER 9, 2013 SURVEY
Transbay Transit Center
301 Mission Monitoring
Transbay Joint Powers Authority
San Francisco, California

November 2013

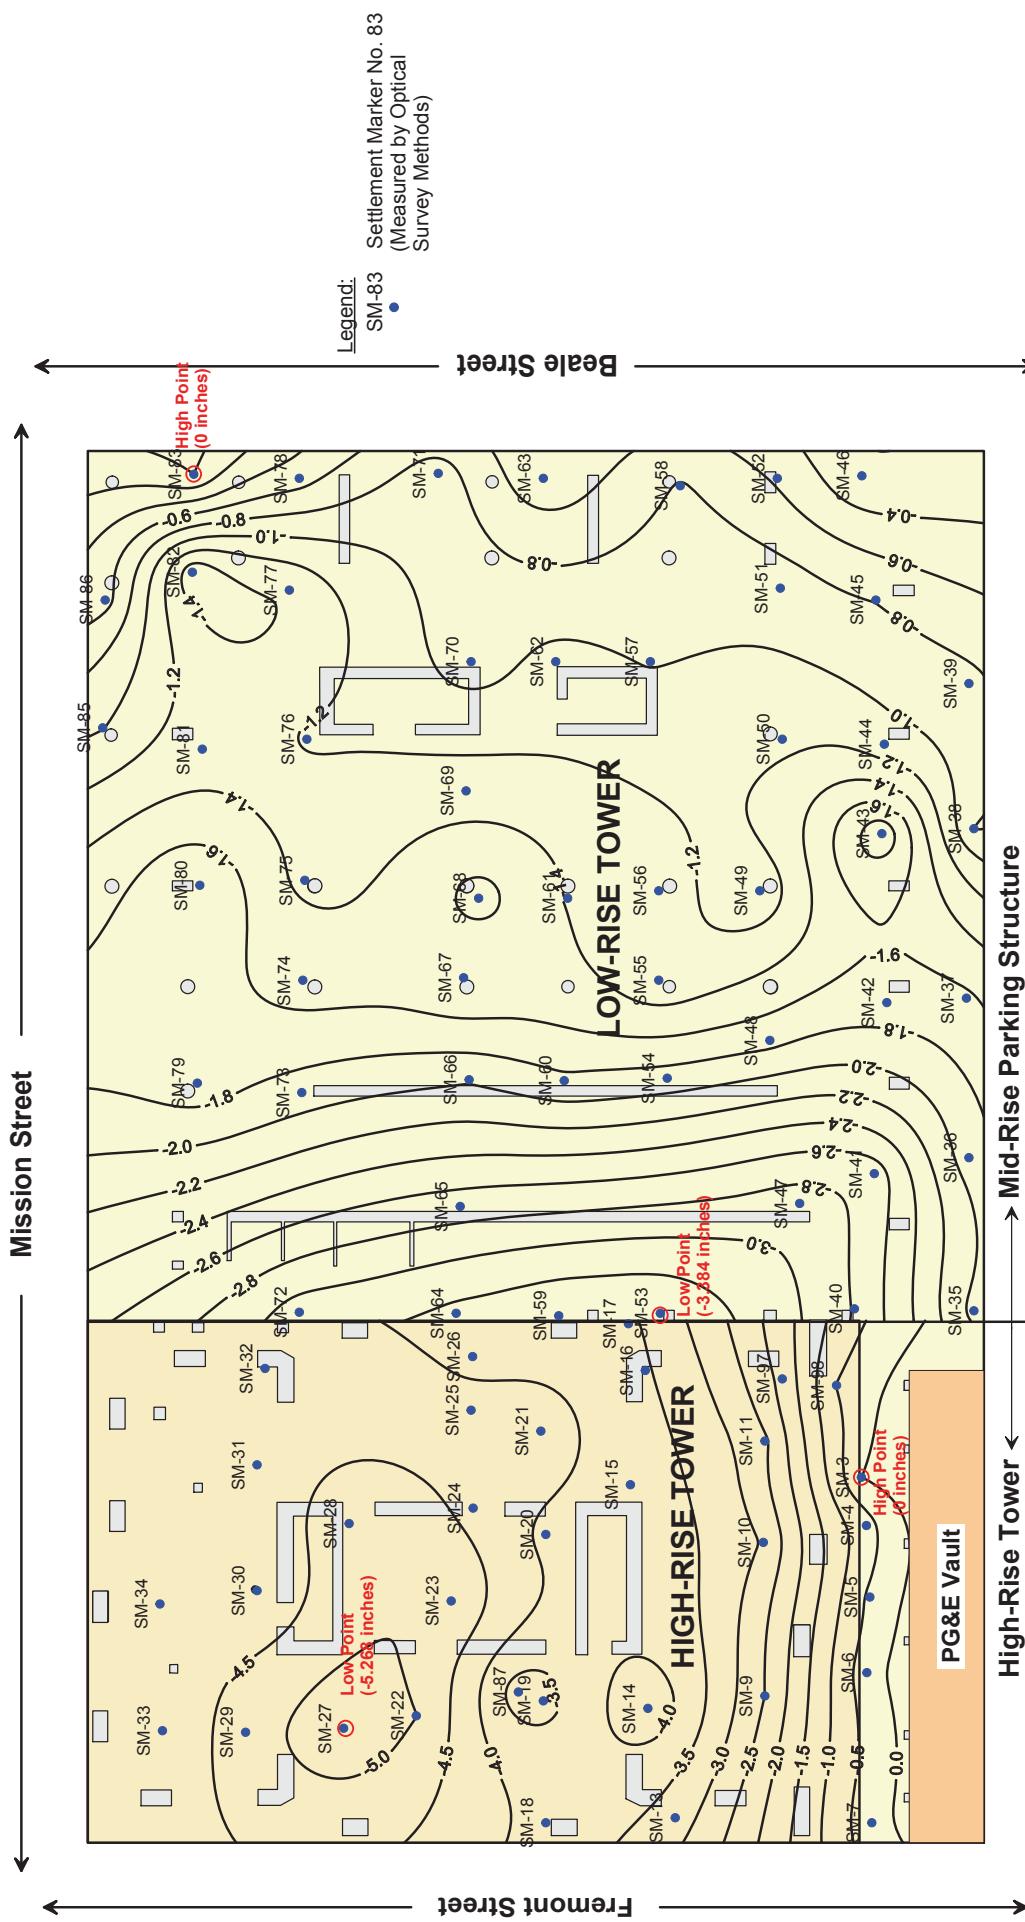

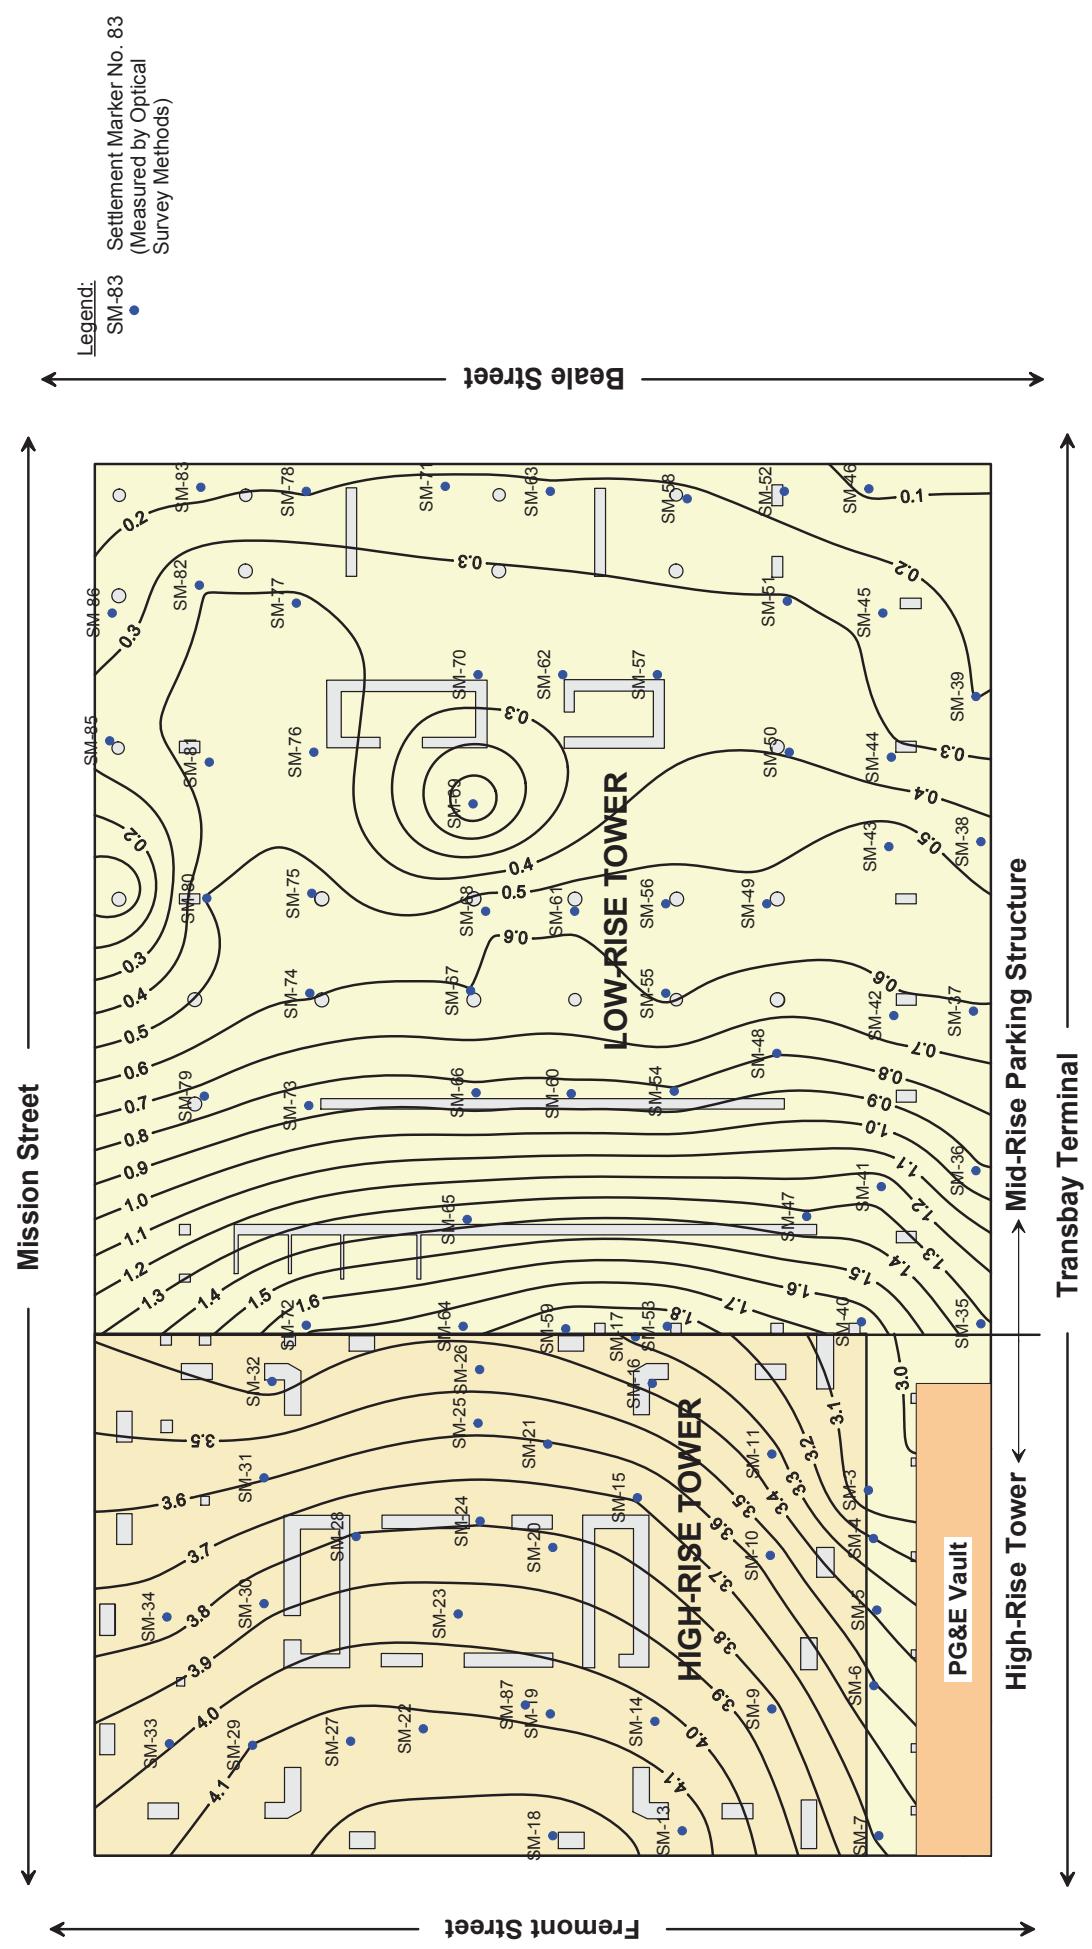


CONTOURS OF SETTLEMENTS MEASURED AT THE 1ST LEVEL BASEMENT OF THE 301 MISSION STREET STRUCTURE BETWEEN 04/30/2009 & 10/09/2013

Transbay Transit Center
301 Mission Monitoring
Transbay Joint Powers Authority
San Francisco, California

November 2013

ARUP


Note:
Initial (Baseline) reading
taken on 04/30/09

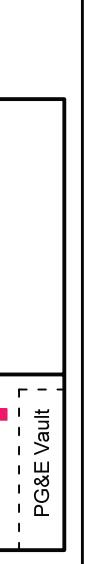

November 2013

**SETTLEMENT OVER TIME
FLOOR ELEVATIONS AT LEVEL B-1
OF 301 MISSION PROPERTY - TOWER:
APRIL 30, 2009 THROUGH OCTOBER 9, 2013**

Transbay Transit Center
301 Mission Monitoring
Transbay Joint Powers Authority
San Francisco, California

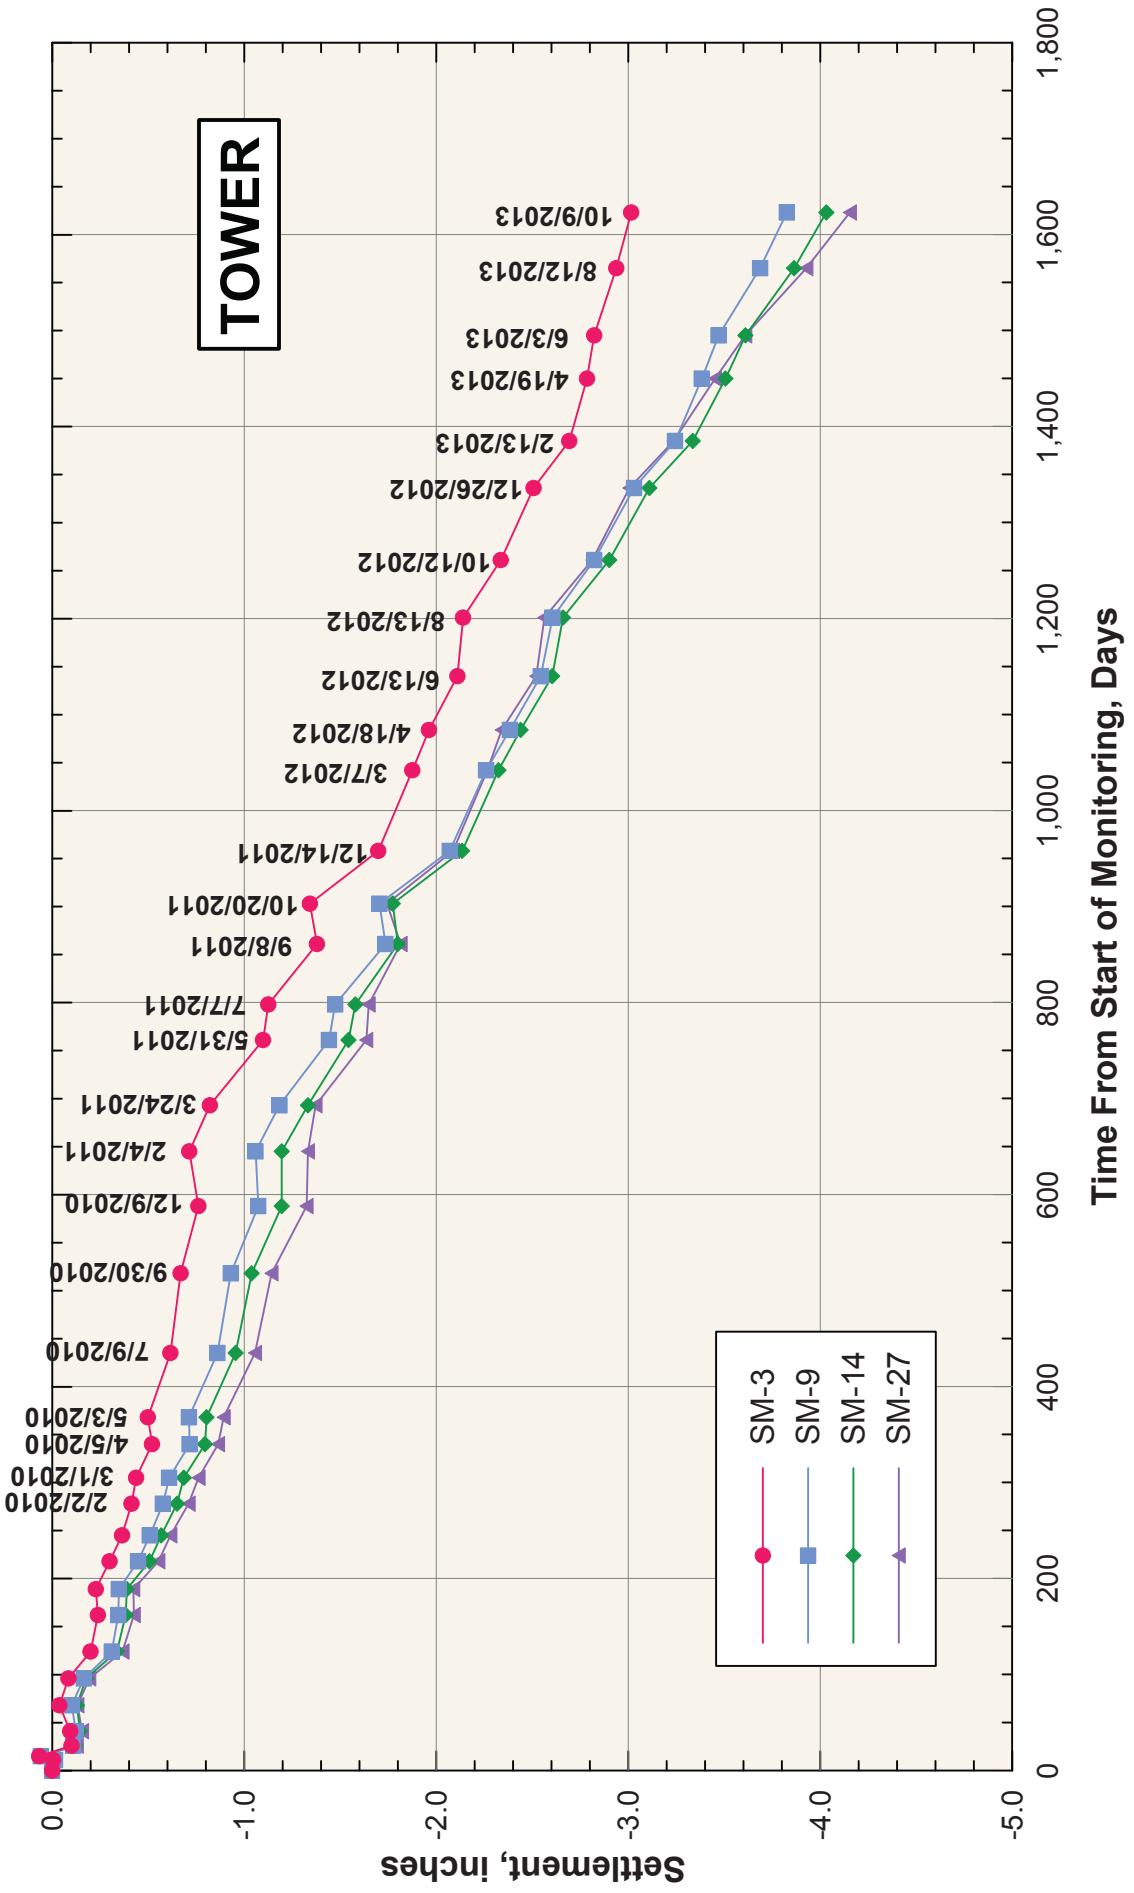



ARUP


Note:
Initial (Baseline) reading
taken on 04/30/09

J.S.F.1322424 Internal Project Data\4-05 Reports & Narratives\221 301 Mission - October 2013 Survey\Plates\Plate 5 Settlement Over Time - Midrise.grf

**SETTLEMENT OVER TIME
FLOOR ELEVATIONS AT LEVEL B-1
OF 301 MISSION PROPERTY - MID-RISE:
APRIL 30, 2009 THROUGH OCTOBER 9, 2013**

Transbay Transit Center
301 Mission Monitoring
Transbay Joint Powers Authority
San Francisco, California

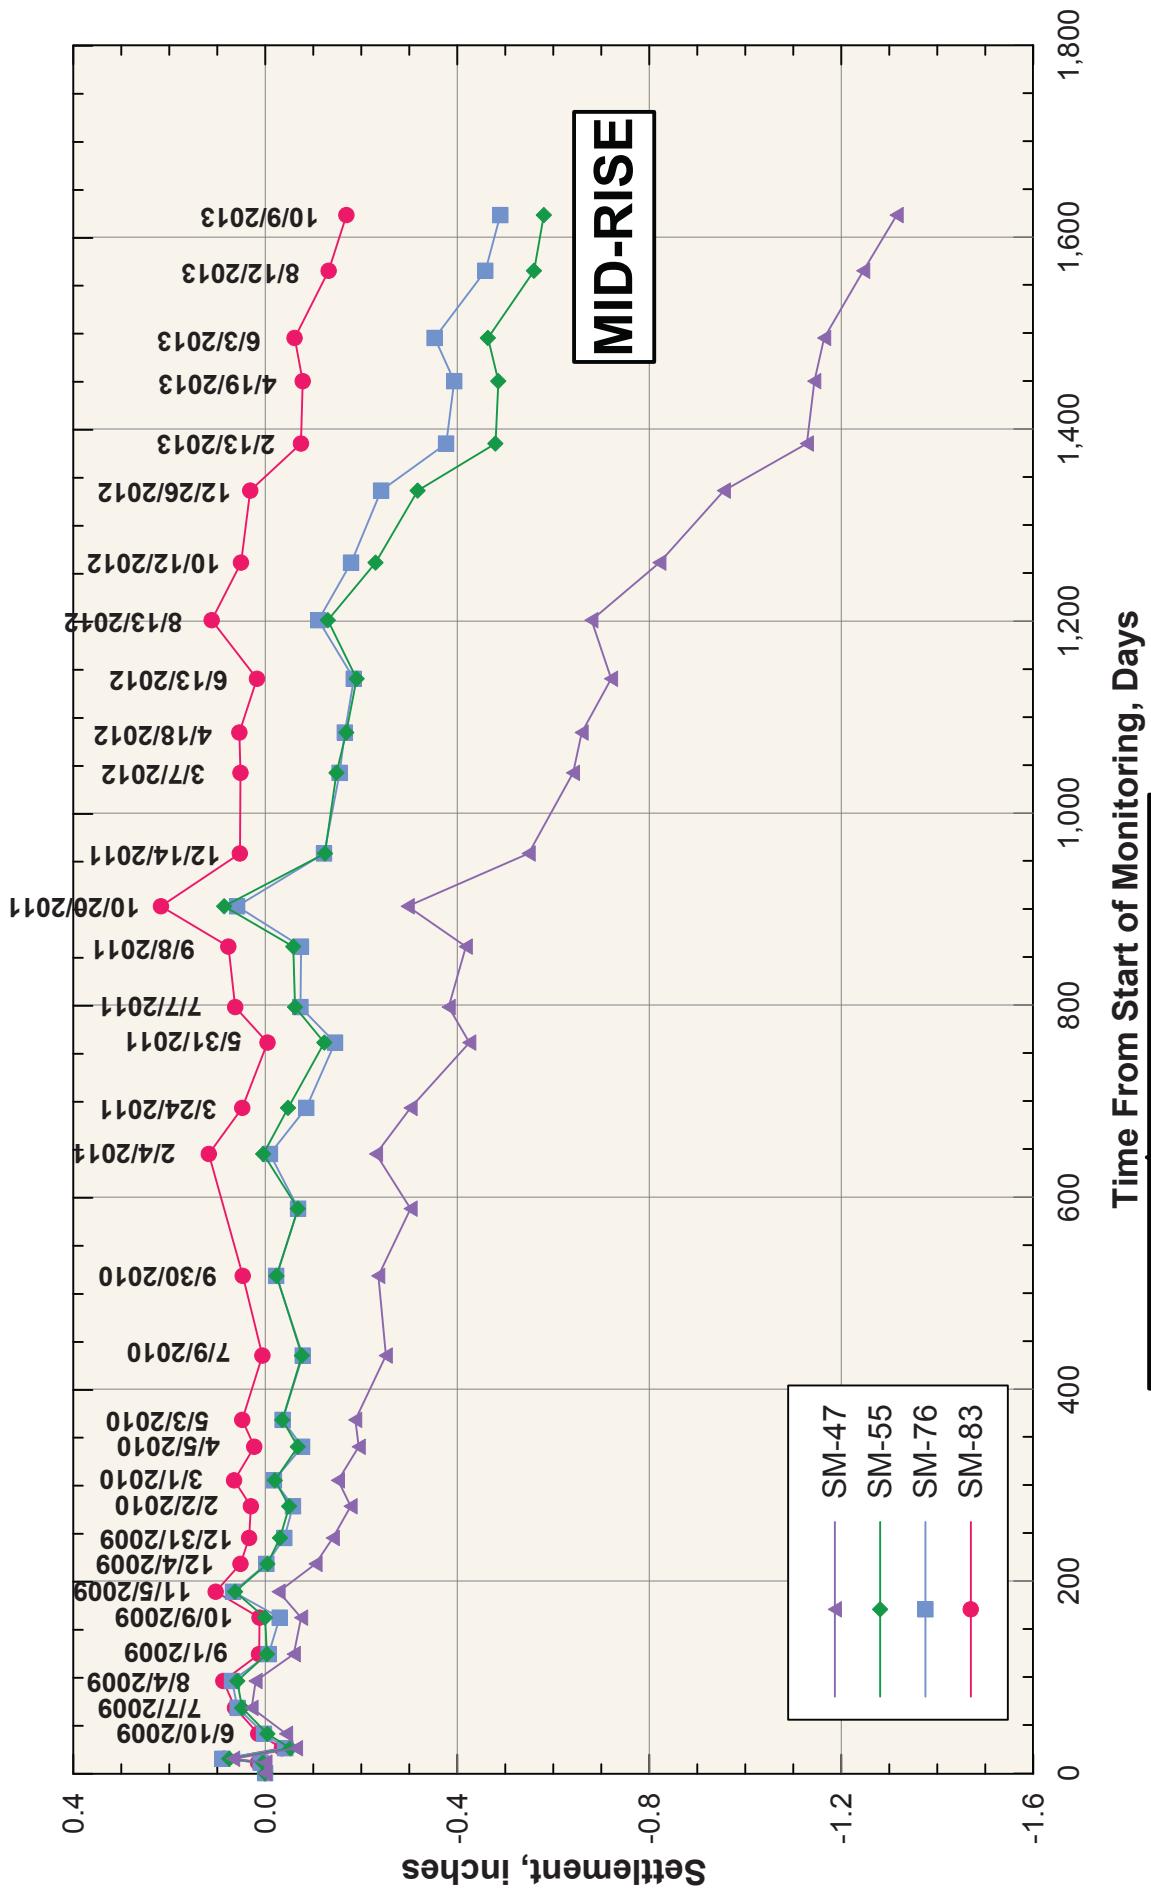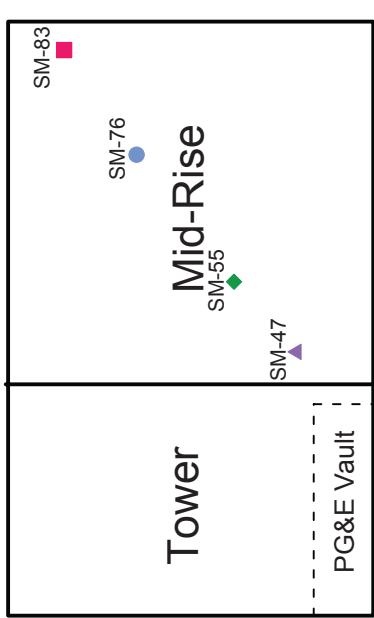

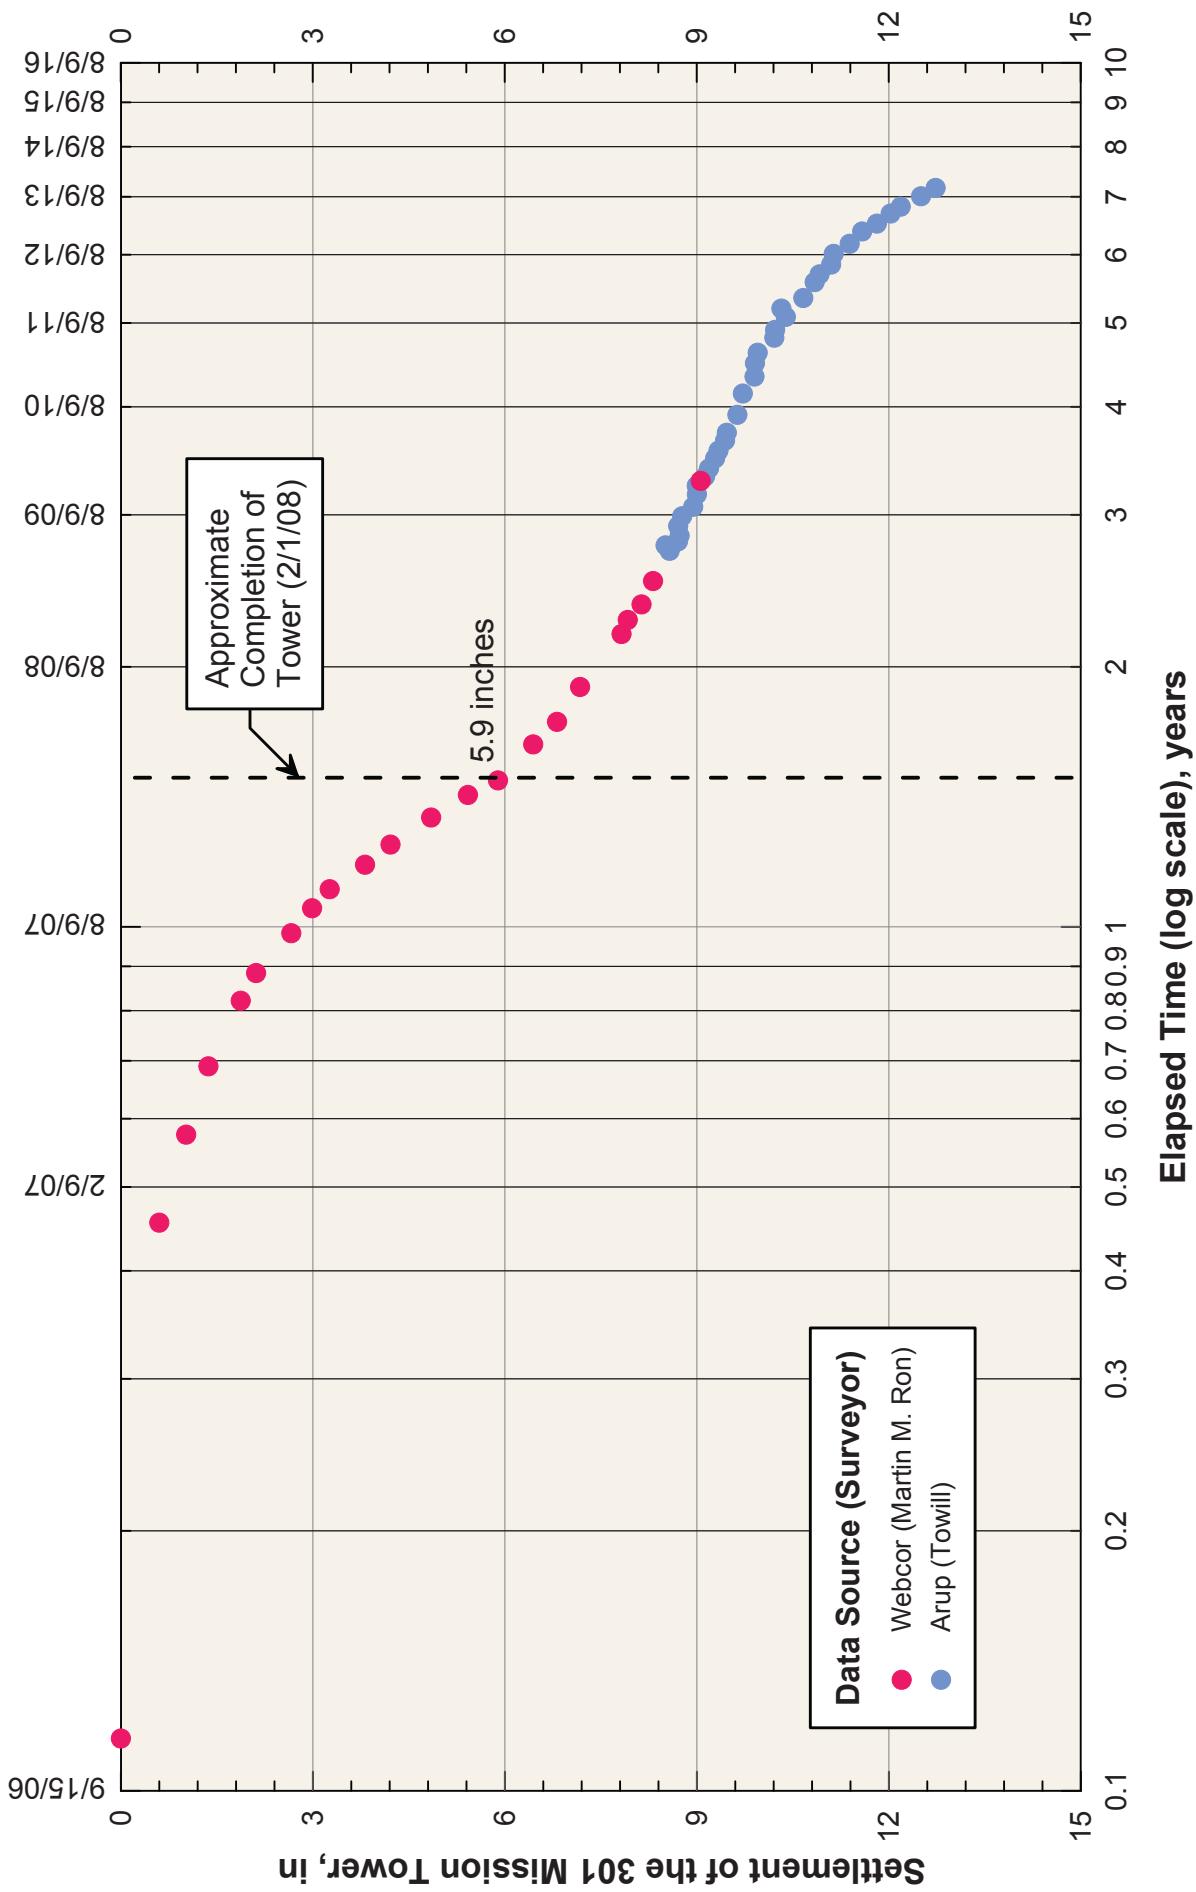


SETTLEMENTS OF THE 301 MISSION TOWER INCLUDING MONITORING DURING CONSTRUCTION


Transbay Transit Center
301 Mission Monitoring
Transbay Joint Powers Authority
San Francisco, California

November 2013

Beginning of Tower Construction: 8/9/06
End of Tower Construction: 2/1/08
Construction Duration: 542 days (1.5 years)

ARUP

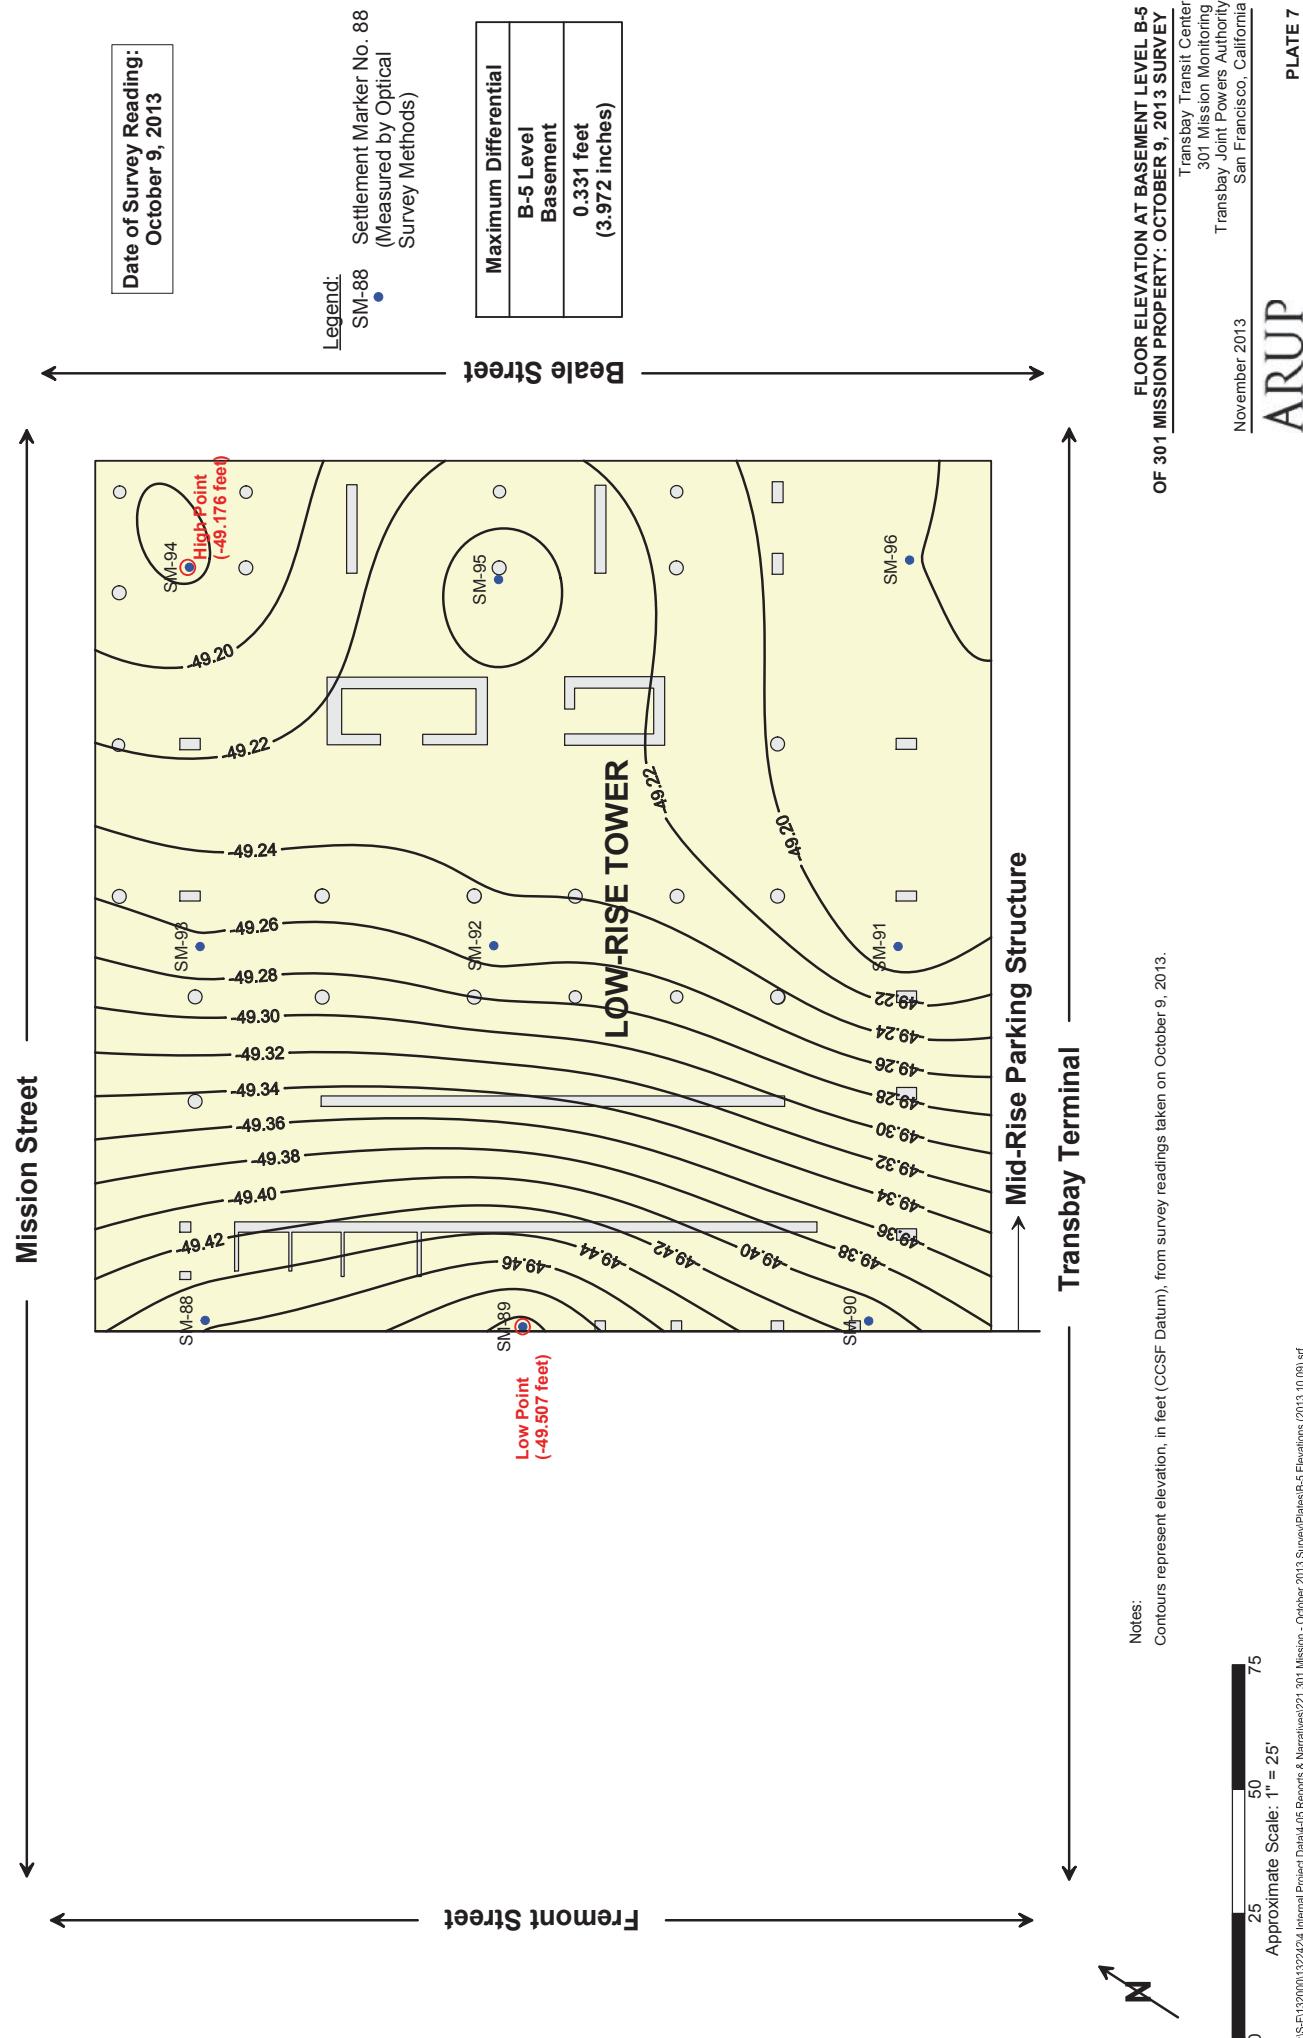

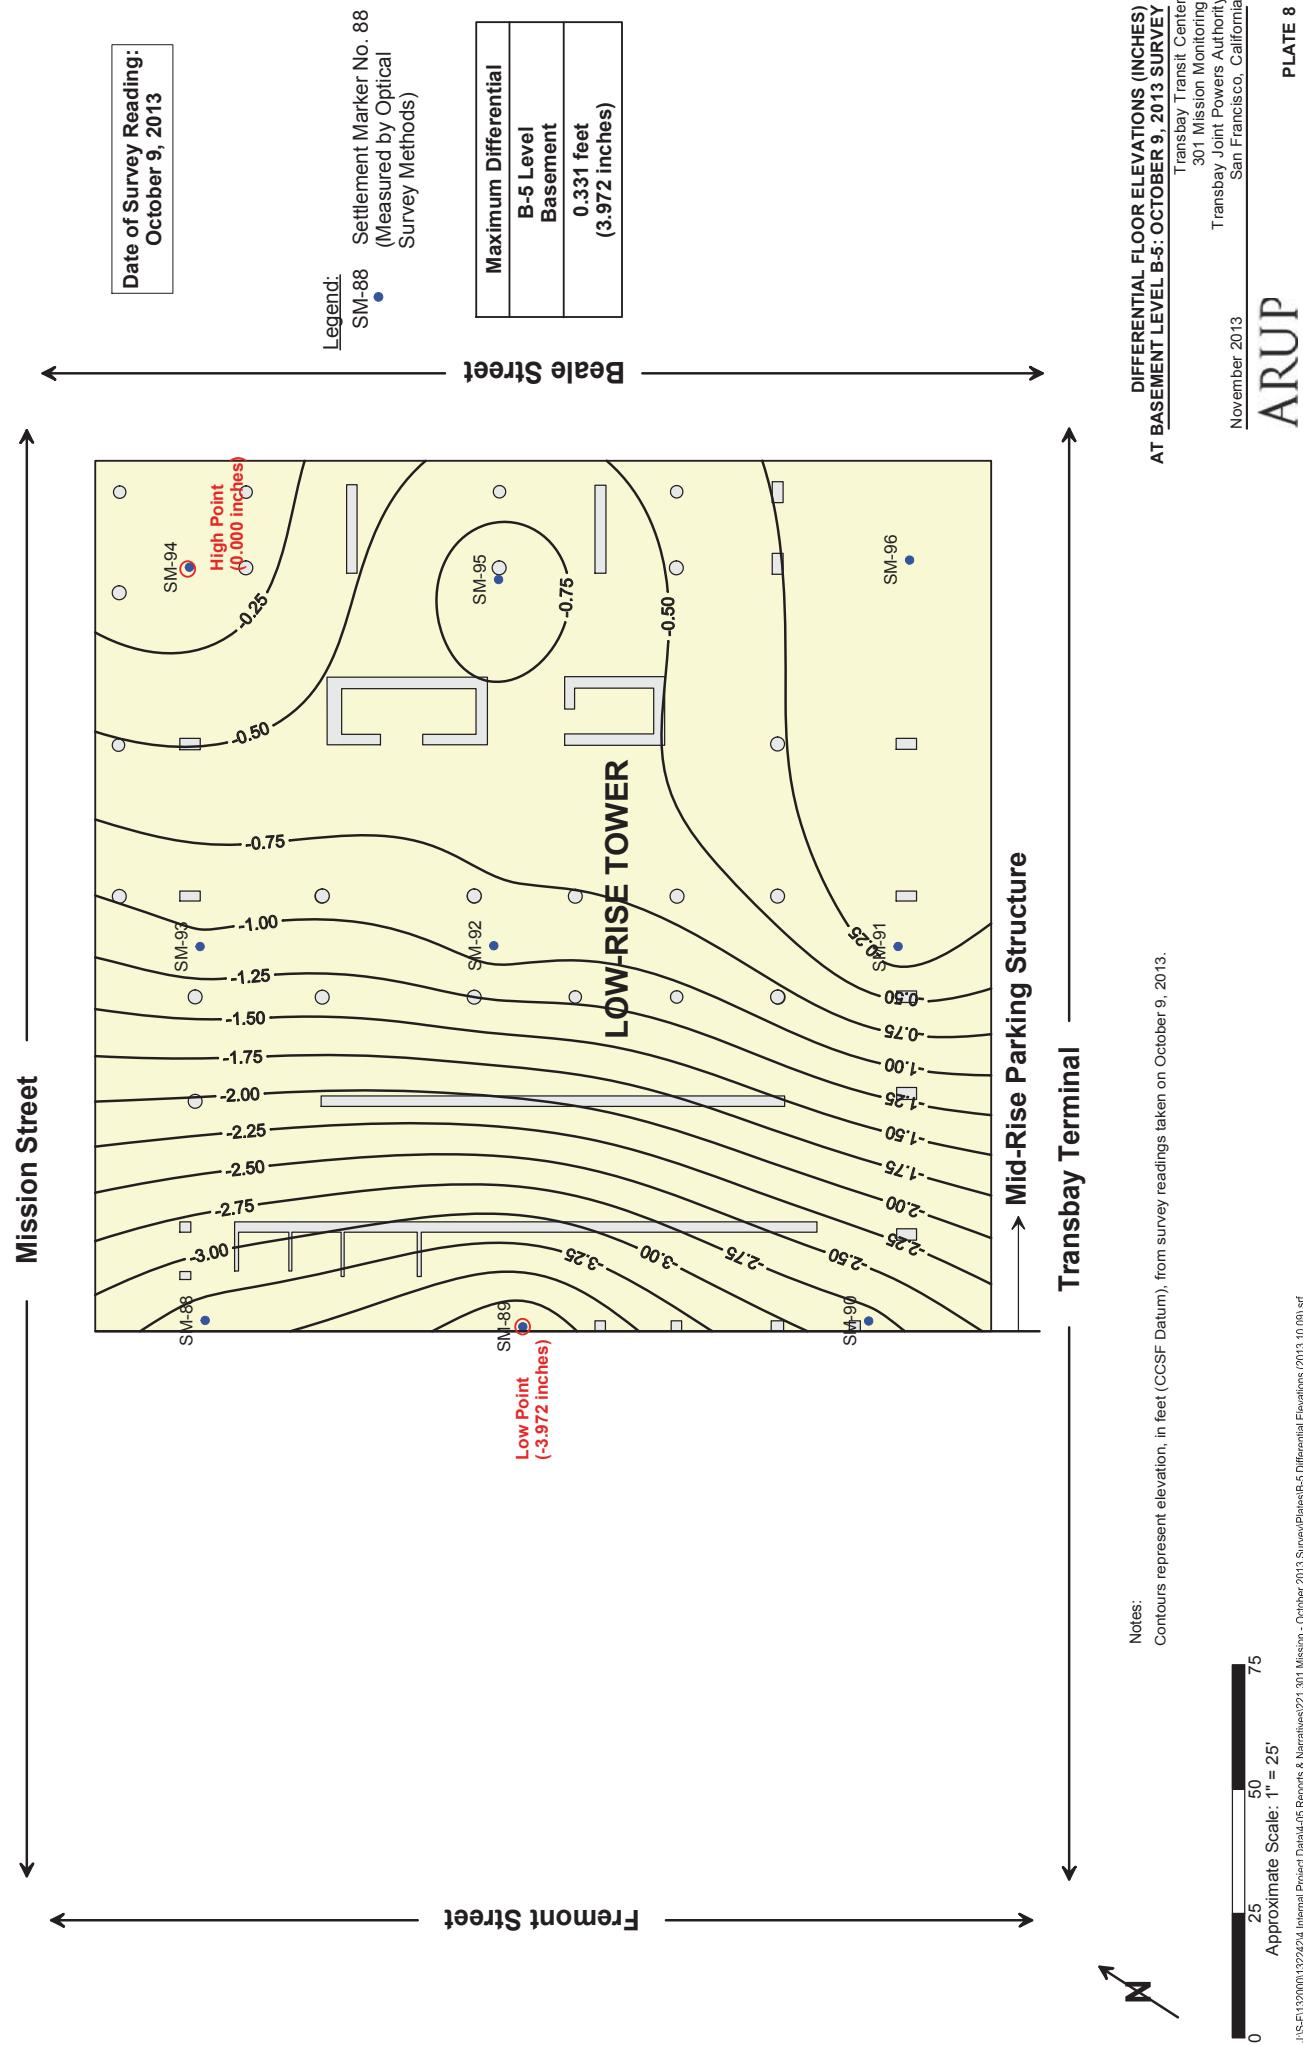

From: Brian Dykes <bdykes@transbaycenter.org>
Sent: Thursday, January 09, 2014 3:24 PM
To: Steven Hood
Cc: Dennis Turchon; Mark Zabaneh; Stephen McLandrich <stephen.mclandrich@arup.com> (stephen.mclandrich@arup.com)
Subject: FW: TTC - 301 Mission December 2013 Survey Memo
Attachments: 2014-01-09 Memo_301 Mission Settlement - Dec 2013 Survey.pdf; 301 Mission Monitoring Survey 12172013.xls

Steven,
Here are the settlement marker readings taken on December 17, 2013.
Stephen,
Thanks for sending these settlement readings. Please also send me the latest inclinometer readings.
Thanks, Brian.

From: Stephen McLandrich [<mailto:stephen.mclandrich@arup.com>]
Sent: Thursday, January 09, 2014 2:58 PM
To: Brian Dykes
Cc: 'rvolenec@pcparch.com' (rvolenec@pcparch.com); George Metzger; Nick O'Riordan; Jeff Dunn
Subject: TTC - 301 Mission December 2013 Survey Memo

Brian,

Please find the attached memo summarizing the latest monitoring data from the survey of the 301 Mission settlement markers.

Additionally, I attach the raw files from the surveyor.

Let me know if you have any questions.

Regards,
Stephen

Stephen McLandrich PE GE

Senior Geotechnical Engineer

Arup
560 Mission Street Suite 700 San Francisco CA 94105 USA
t +1 415 957 9445 d +1 415 946 0245
f +1 415 957 9096 c +1 415 310 1095
www.arup.com

Arup named ENR California's
DESIGN FIRM OF THE YEAR 2013

Memorandum


ARUP

To	Brian Dykes (TJPA)	Date
		9 January 2014
Copies	Randy Volenec (PCPA) George Metzger (AAI)	Reference number 132242-60/MHG
From	Stephen McLandrich (Arup)	File reference 4-05 224
Subject	Transbay Transit Center: Results of December 2013 Settlement Survey at 301 Mission Property	Page 1 of 1

Under Arup's Geotechnical Contract with the Transbay Joint Powers Authority through Pelli Clark Pelli Architects, Arup is required to monitor the settlements of the buildings adjacent to the Transbay Transit Center prior to and during construction. We began the monitoring program for the 301 Mission property in April of 2009. This memorandum and the attached plates present an update to our memorandum dated November 13, 2013 with measurements made through December 2013.

List of Plates

- Plate 1 Floor Elevations at Level B-1 of 301 Mission Property: Periodic Survey – December 17, 2013
- Plate 2 Differential Floor Elevation (Inches) – December 17, 2013 Survey
- Plate 3 Contours of Settlements Measured at the 1st Level Basement of the 301 Mission St. Structure Between 04/30/2009 & 12/17/2013
- Plate 4 Settlement Over Time Floor Elevations at Level B-1 of 301 Mission Property – Tower: April 30, 2009 through December 17, 2013
- Plate 5 Settlement Over Time Floor Elevations at Level B-1 of 301 Mission Property – Mid-Rise: April 30, 2009 through December 17, 2013
- Plate 6 Settlements of the 301 Mission Tower Including Monitoring During Construction
- Plate 7 Floor Elevation at Basement Level B-5 of 301 Mission Property: December 17, 2013 Survey
- Plate 8 Differential Floor Elevations (Inches) at Basement Level B-5: December 17, 2013 Survey

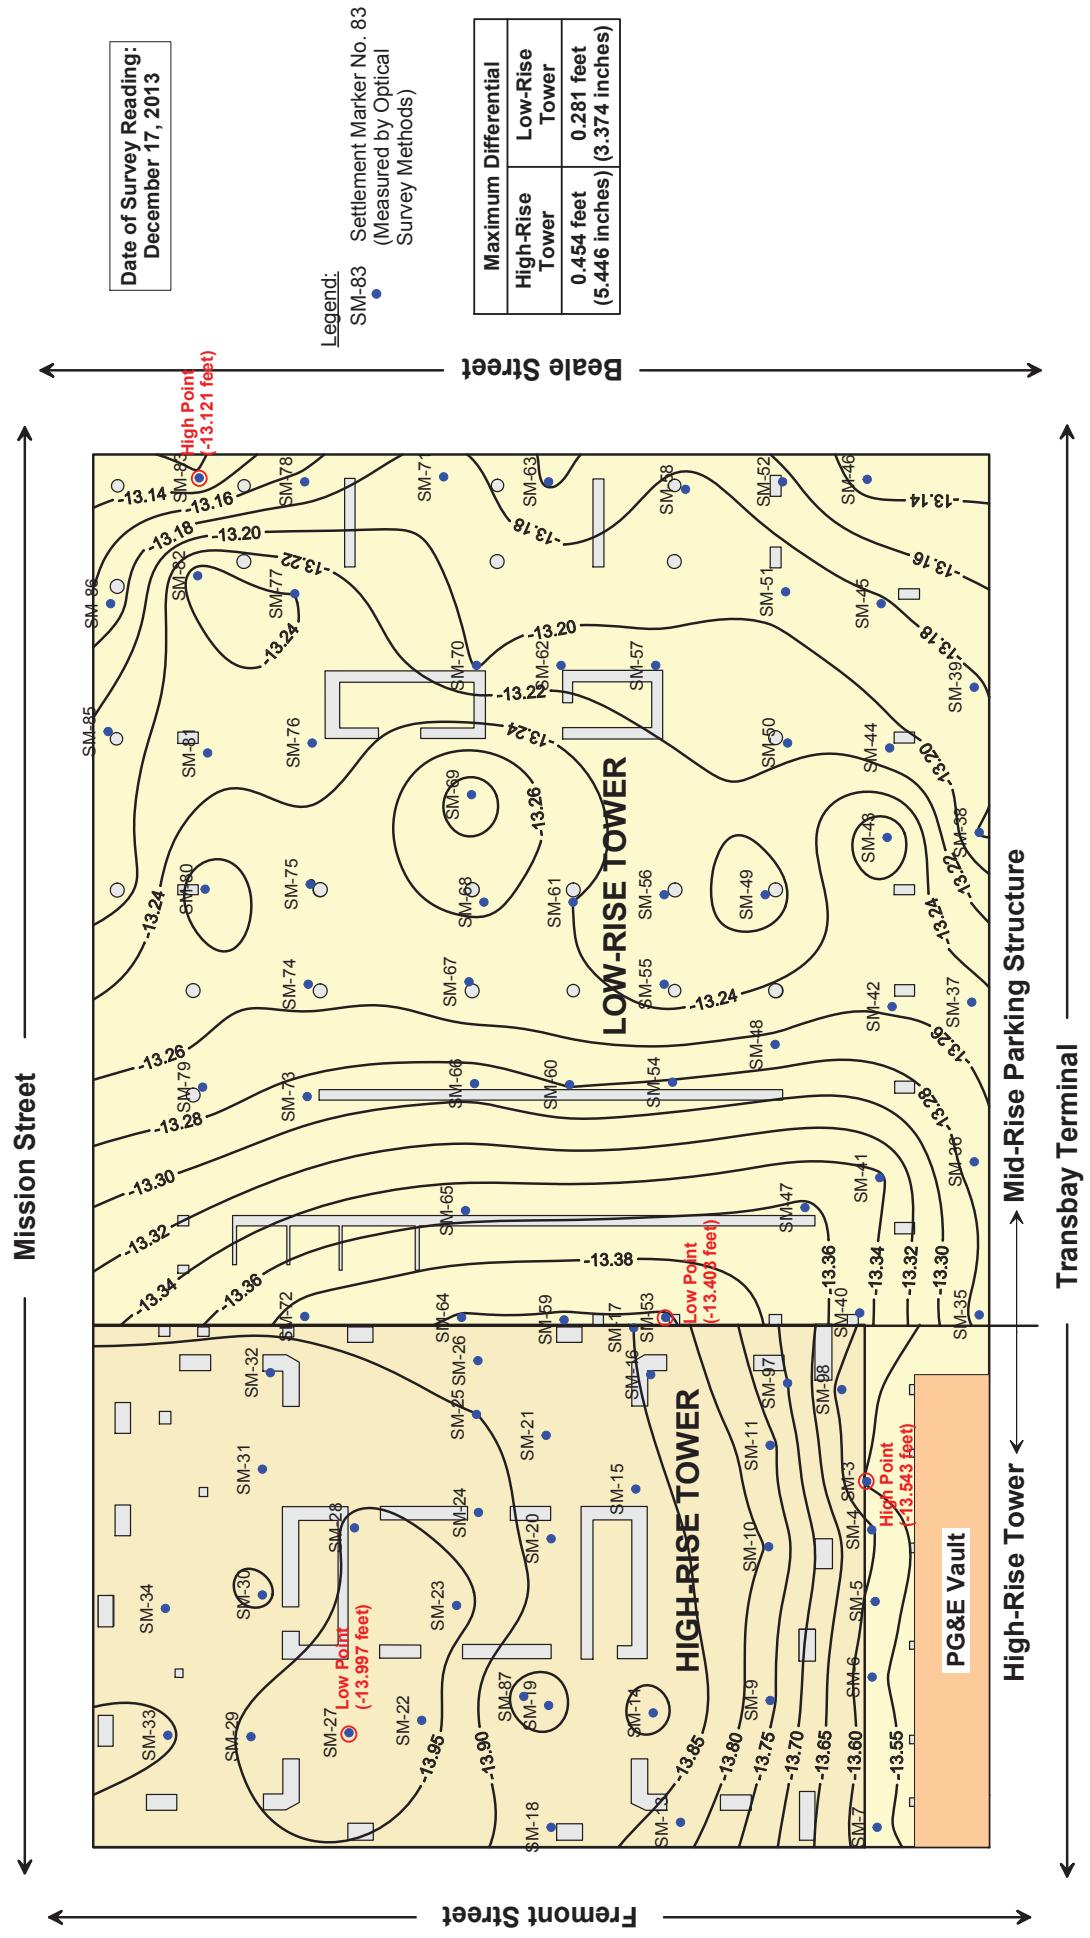

**FLOOR ELEVATIONS AT LEVEL B-1
OF 301 MISSION PROPERTY:
PERIODIC SURVEY - DECEMBER 17, 2013**

Transbay Transit Center
301 Mission Monitoring
Transbay Joint Powers Authority
San Francisco, California

January 2014


ARUP

ARUP

**DIFFERENTIAL FLOOR ELEVATIONS (INCHES)
DECEMBER 17, 2013 SURVEY**

Transbay Transit Center
301 Mission Monitoring
Transbay Joint Powers Authority
San Francisco, California


January 2014

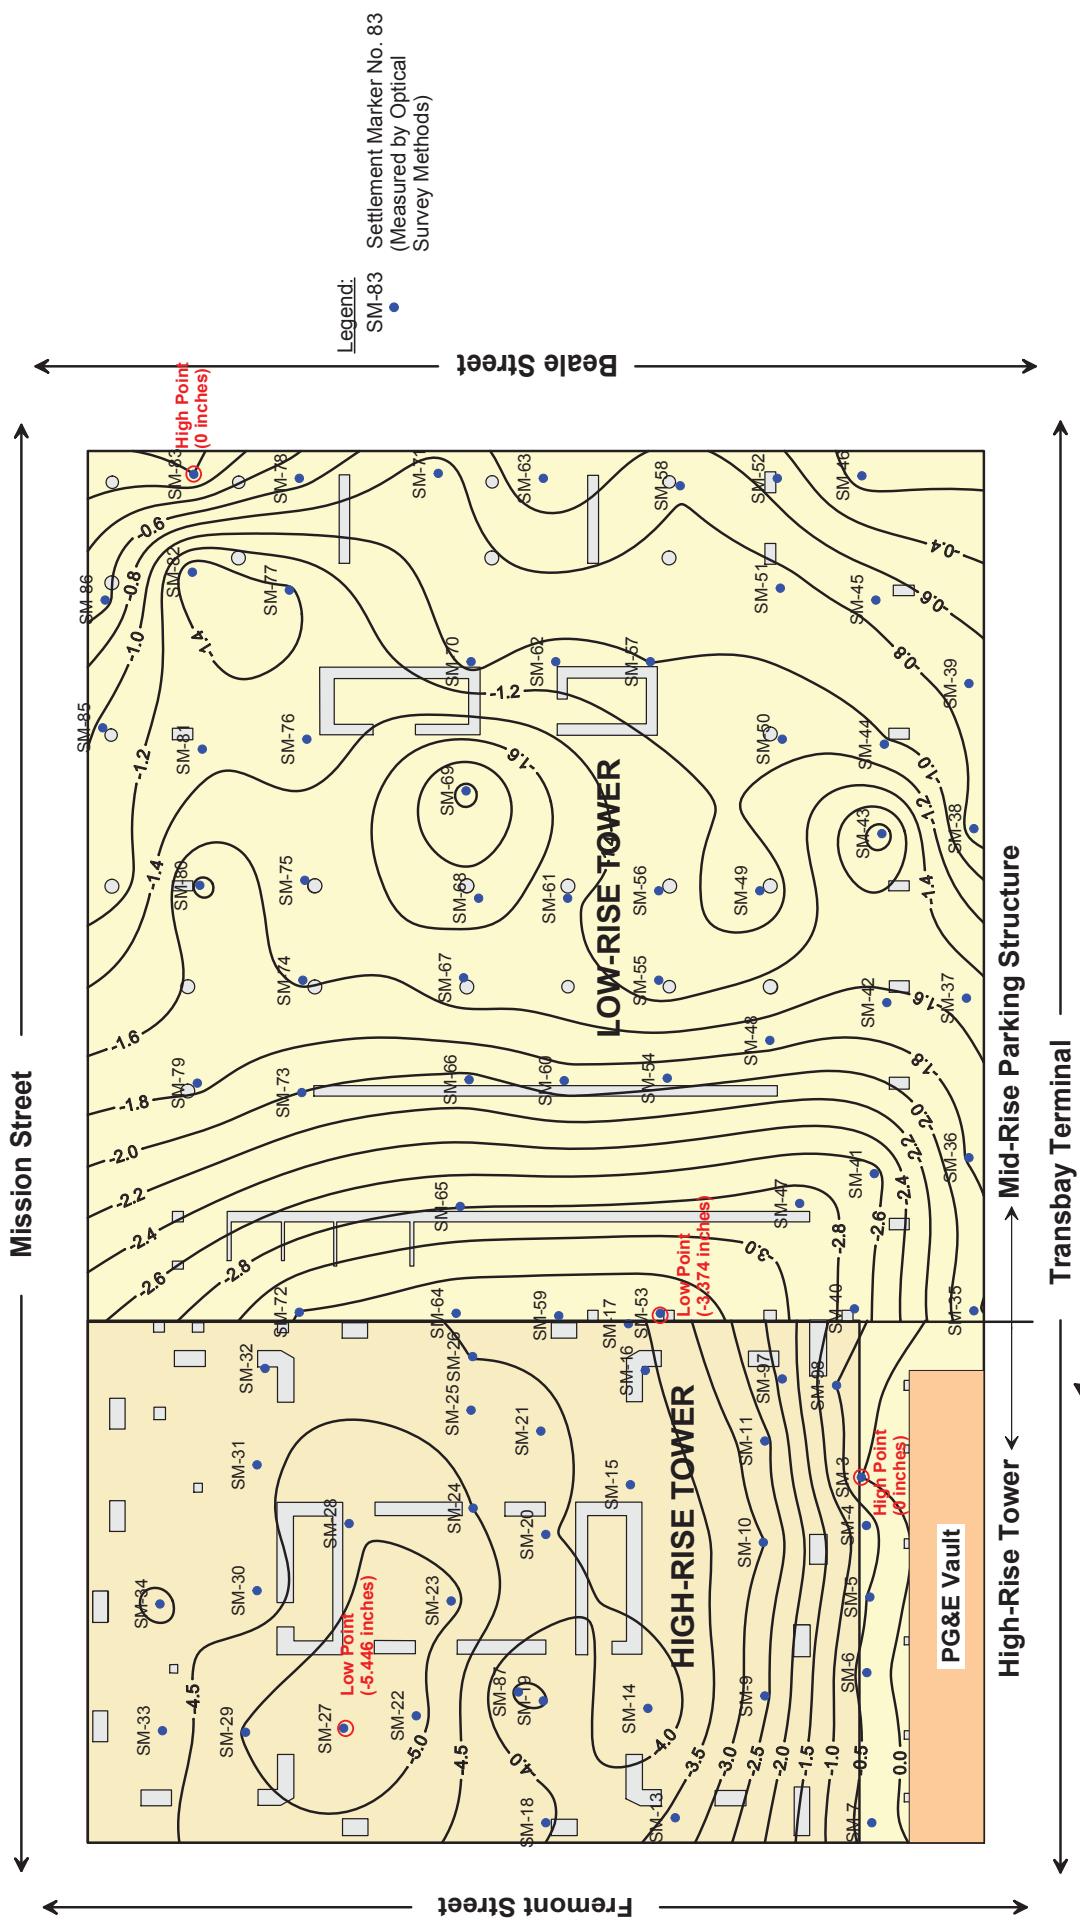

CONTOURS OF SETTLEMENTS MEASURED AT THE 1ST LEVEL BASEMENT OF THE 301 MISSION ST STRUCTURE BETWEEN 04/30/2009 & 12/17/2013


Transbay Transit Center
301 Mission Monitoring
Transbay Joint Powers Authority
San Francisco, California

January 2014

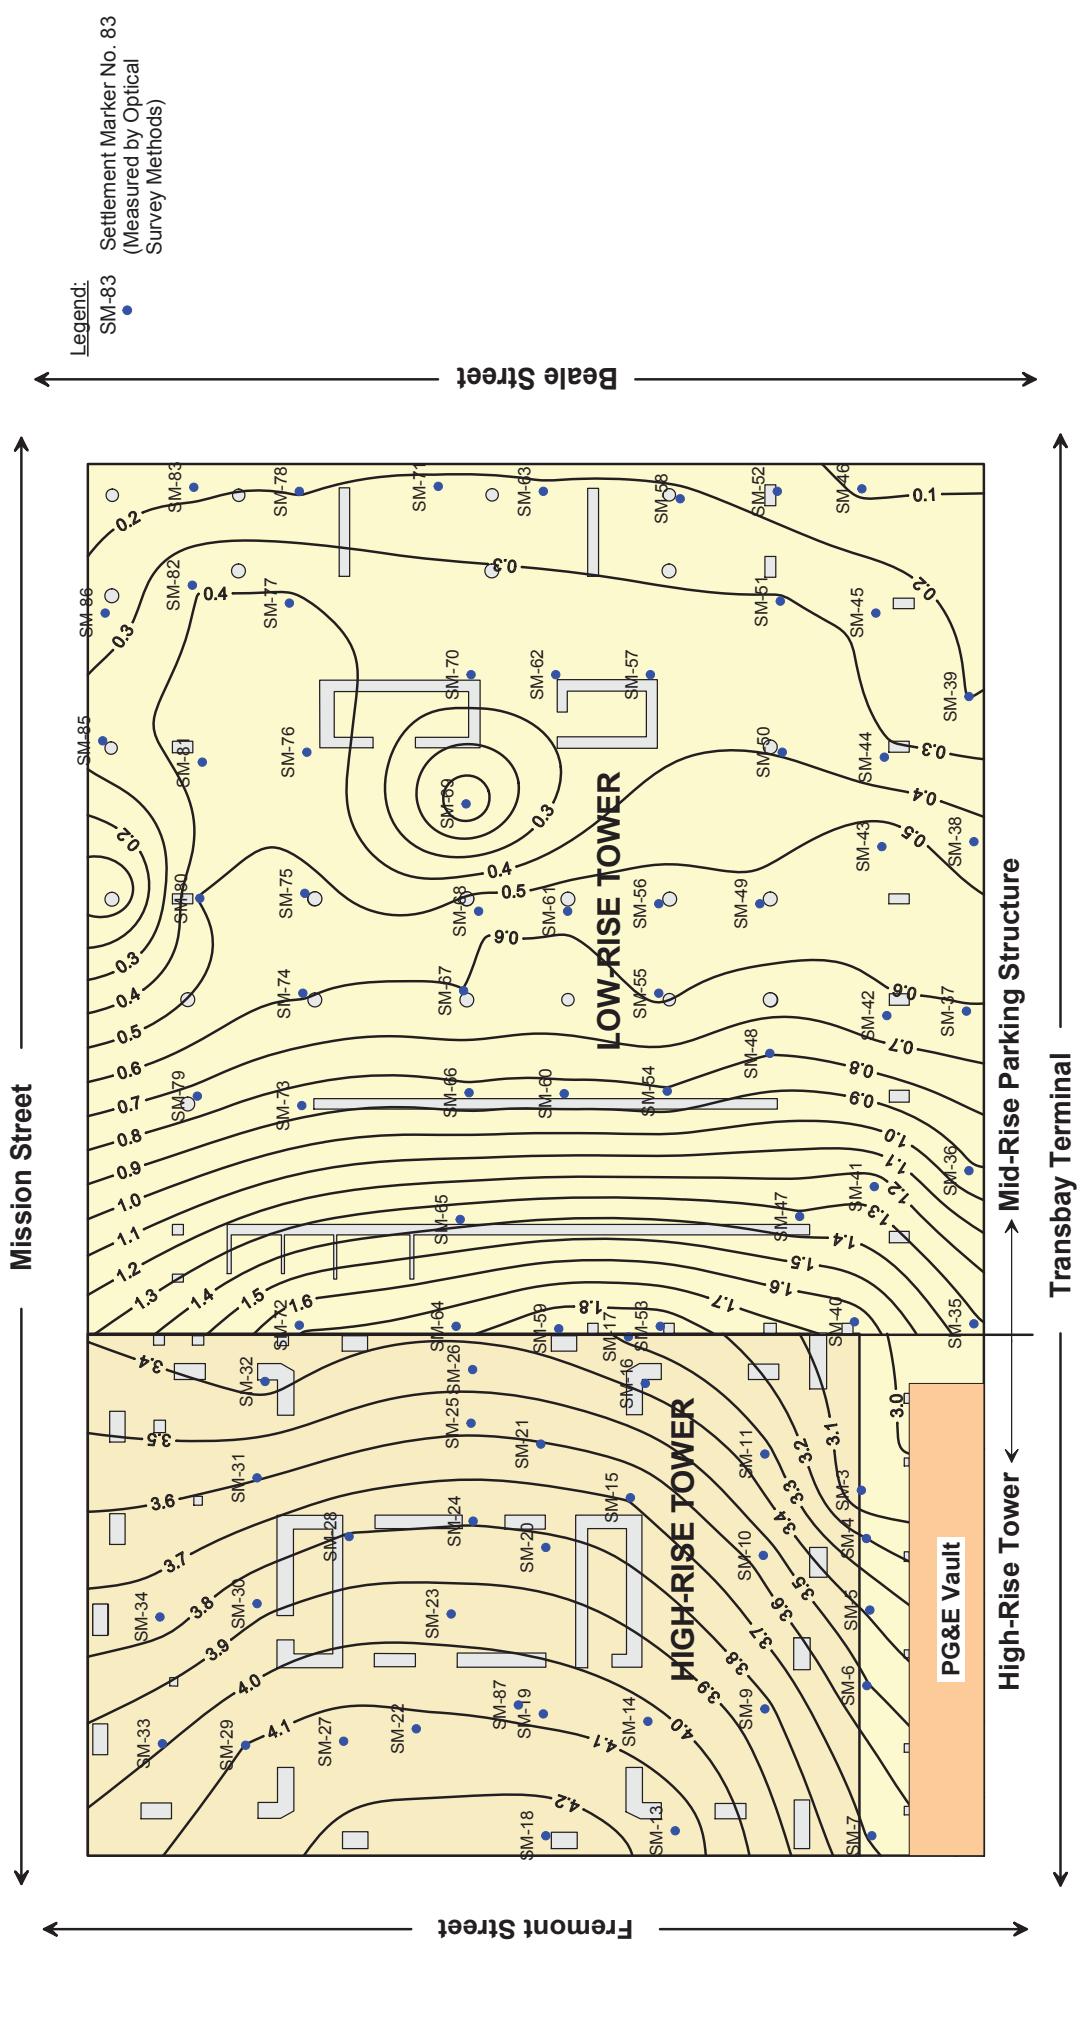

ARUP

Note:
Initial (Baseline) reading
taken on 04/30/09

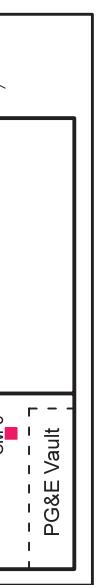


SM-27
SM-14 Tower
SM-9
SM-3
PG&E Vault

**SETTLEMENT OVER TIME
FLOOR ELEVATIONS AT LEVEL B-1
OF 301 MISSION PROPERTY- TOWER:
APRIL 30, 2009 THROUGH DECEMBER 17, 2013**

Transbay Transit Center
301 Mission Monitoring
Transbay Joint Powers Authority
San Francisco, California

Time From Start of Monitoring, Days

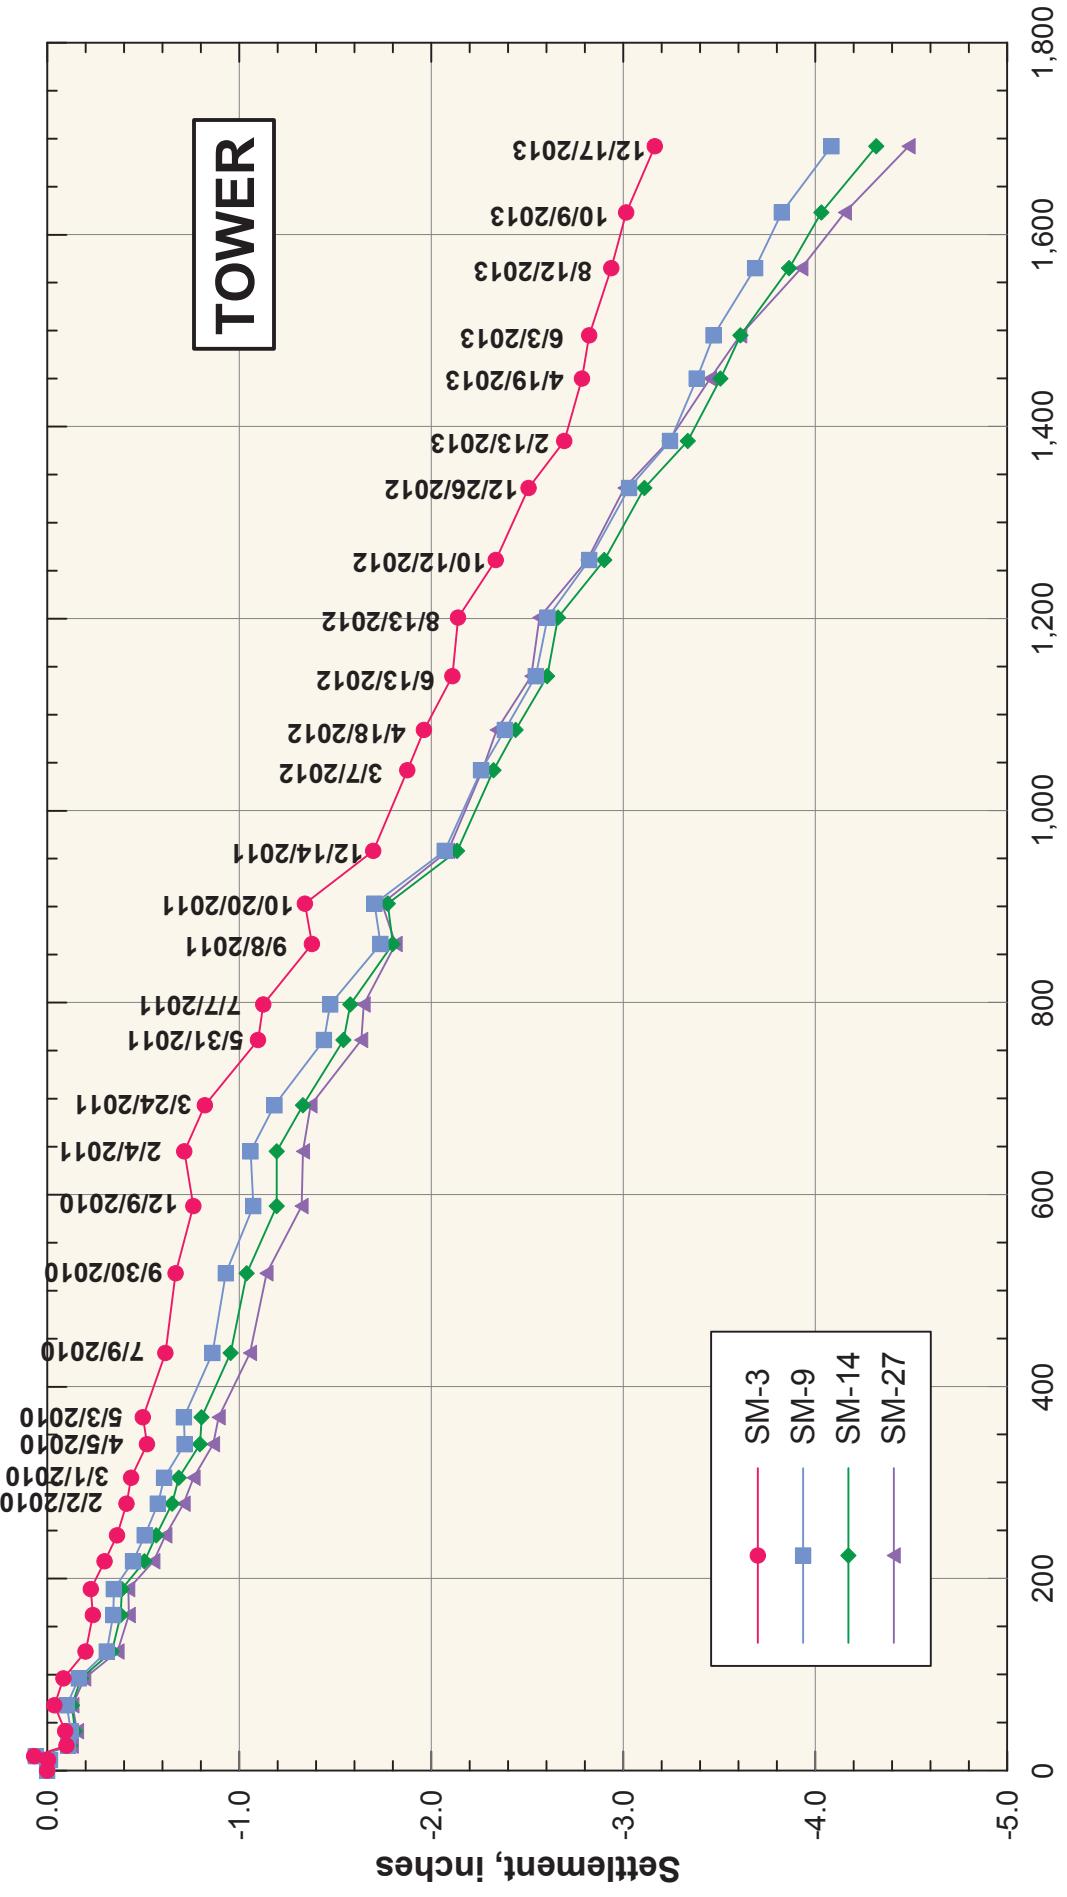



ARUP

Note:
Initial (Baseline) reading
taken on 04/30/09

J.S.F.1320001322424 Internal Project Data4-05 Reports & Narratives\224 301 Mission - December 2013 Survey\Plates\Plate 5 Settlement Over Time - Midrise.grf

**SETTLEMENT OVER TIME
FLOOR ELEVATIONS AT LEVEL B-1
OF 301 MISSION PROPERTY - MID-RISE:
APRIL 30, 2009 THROUGH DECEMBER 17, 2013**

Transbay Transit Center
301 Mission Monitoring
Transbay Joint Powers Authority
San Francisco, California

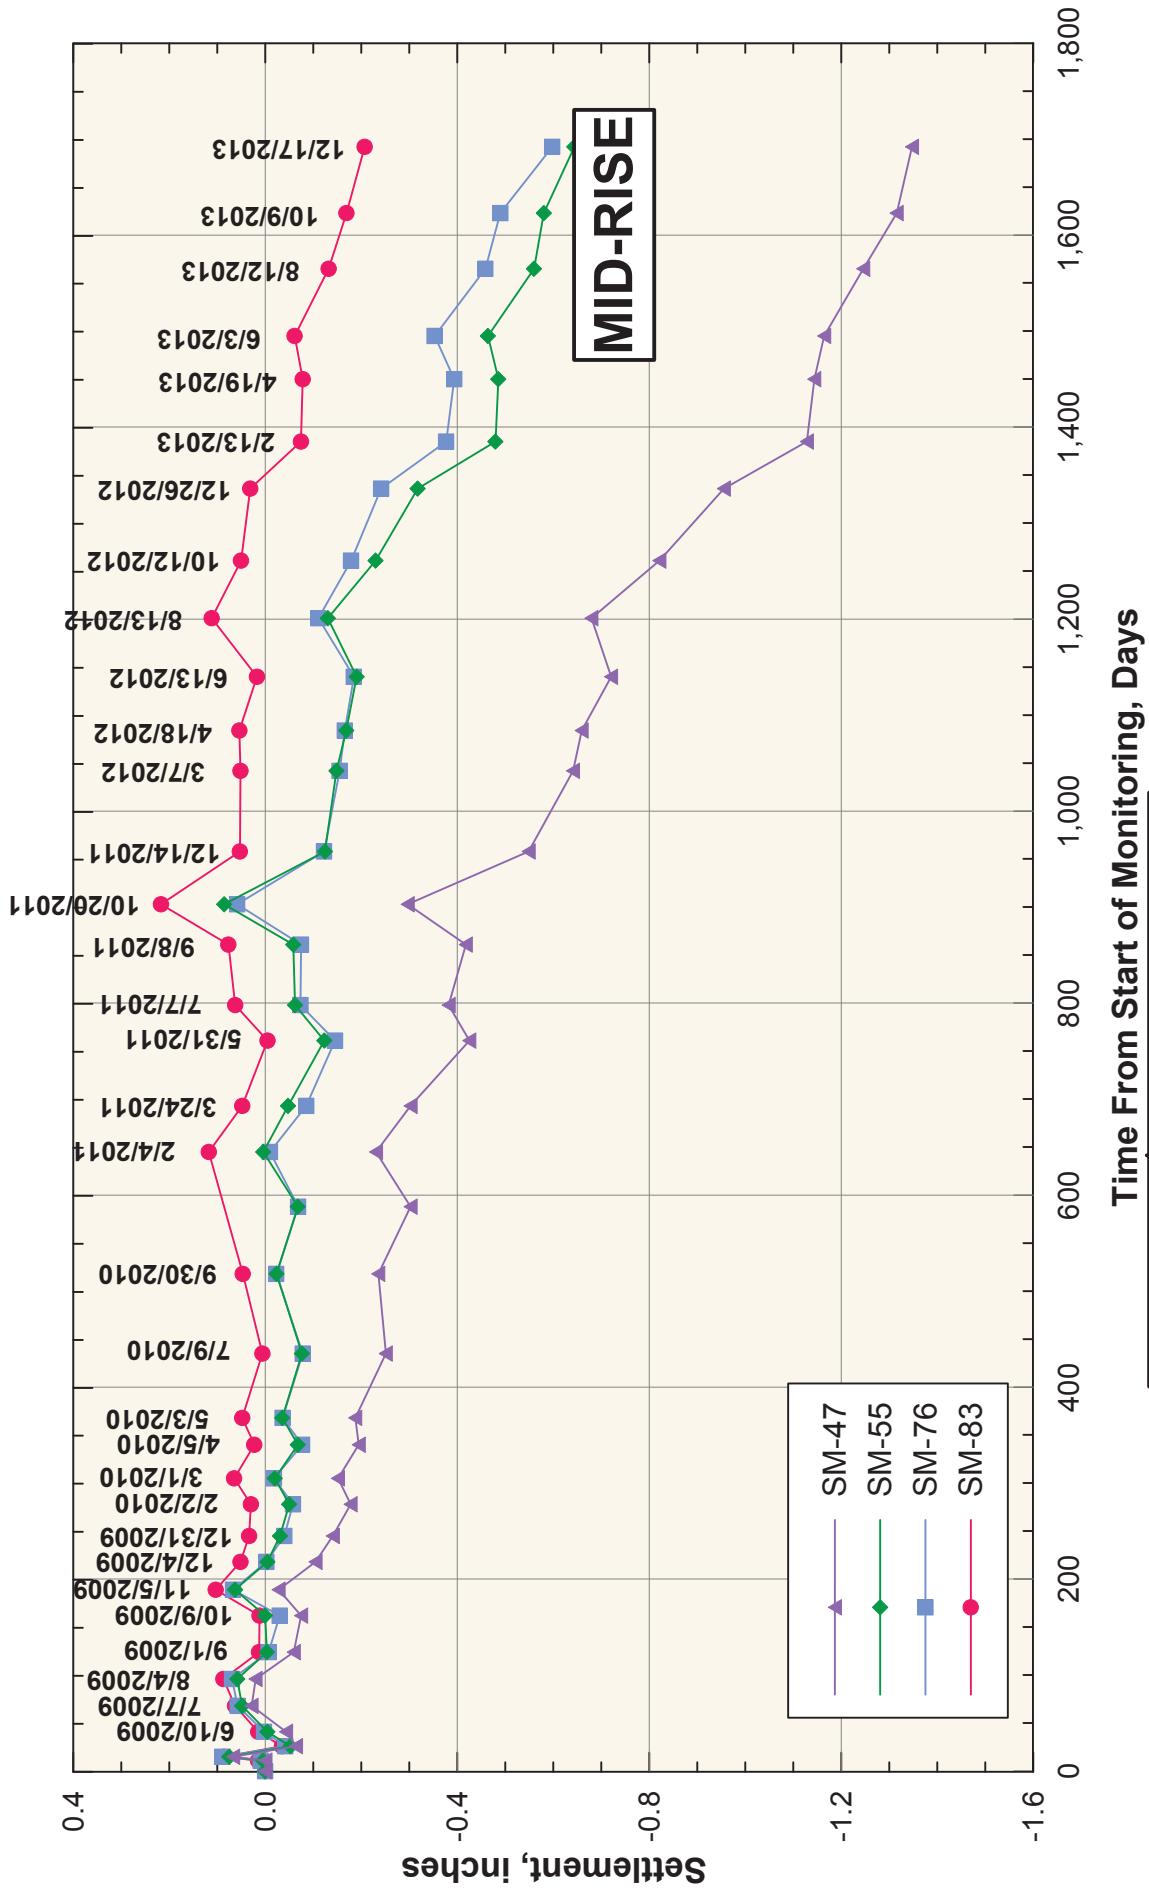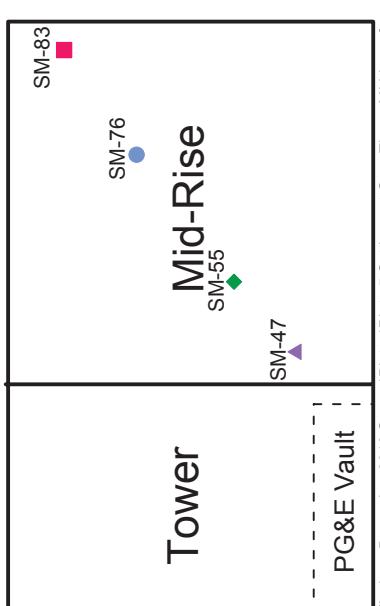


ARUP

**SETTLEMENTS OF THE 301 MISSION TOWER
INCLUDING MONITORING DURING CONSTRUCTION**

Transbay Transit Center
301 Mission Monitoring
Transbay Joint Powers Authority
San Francisco, California


January 2014

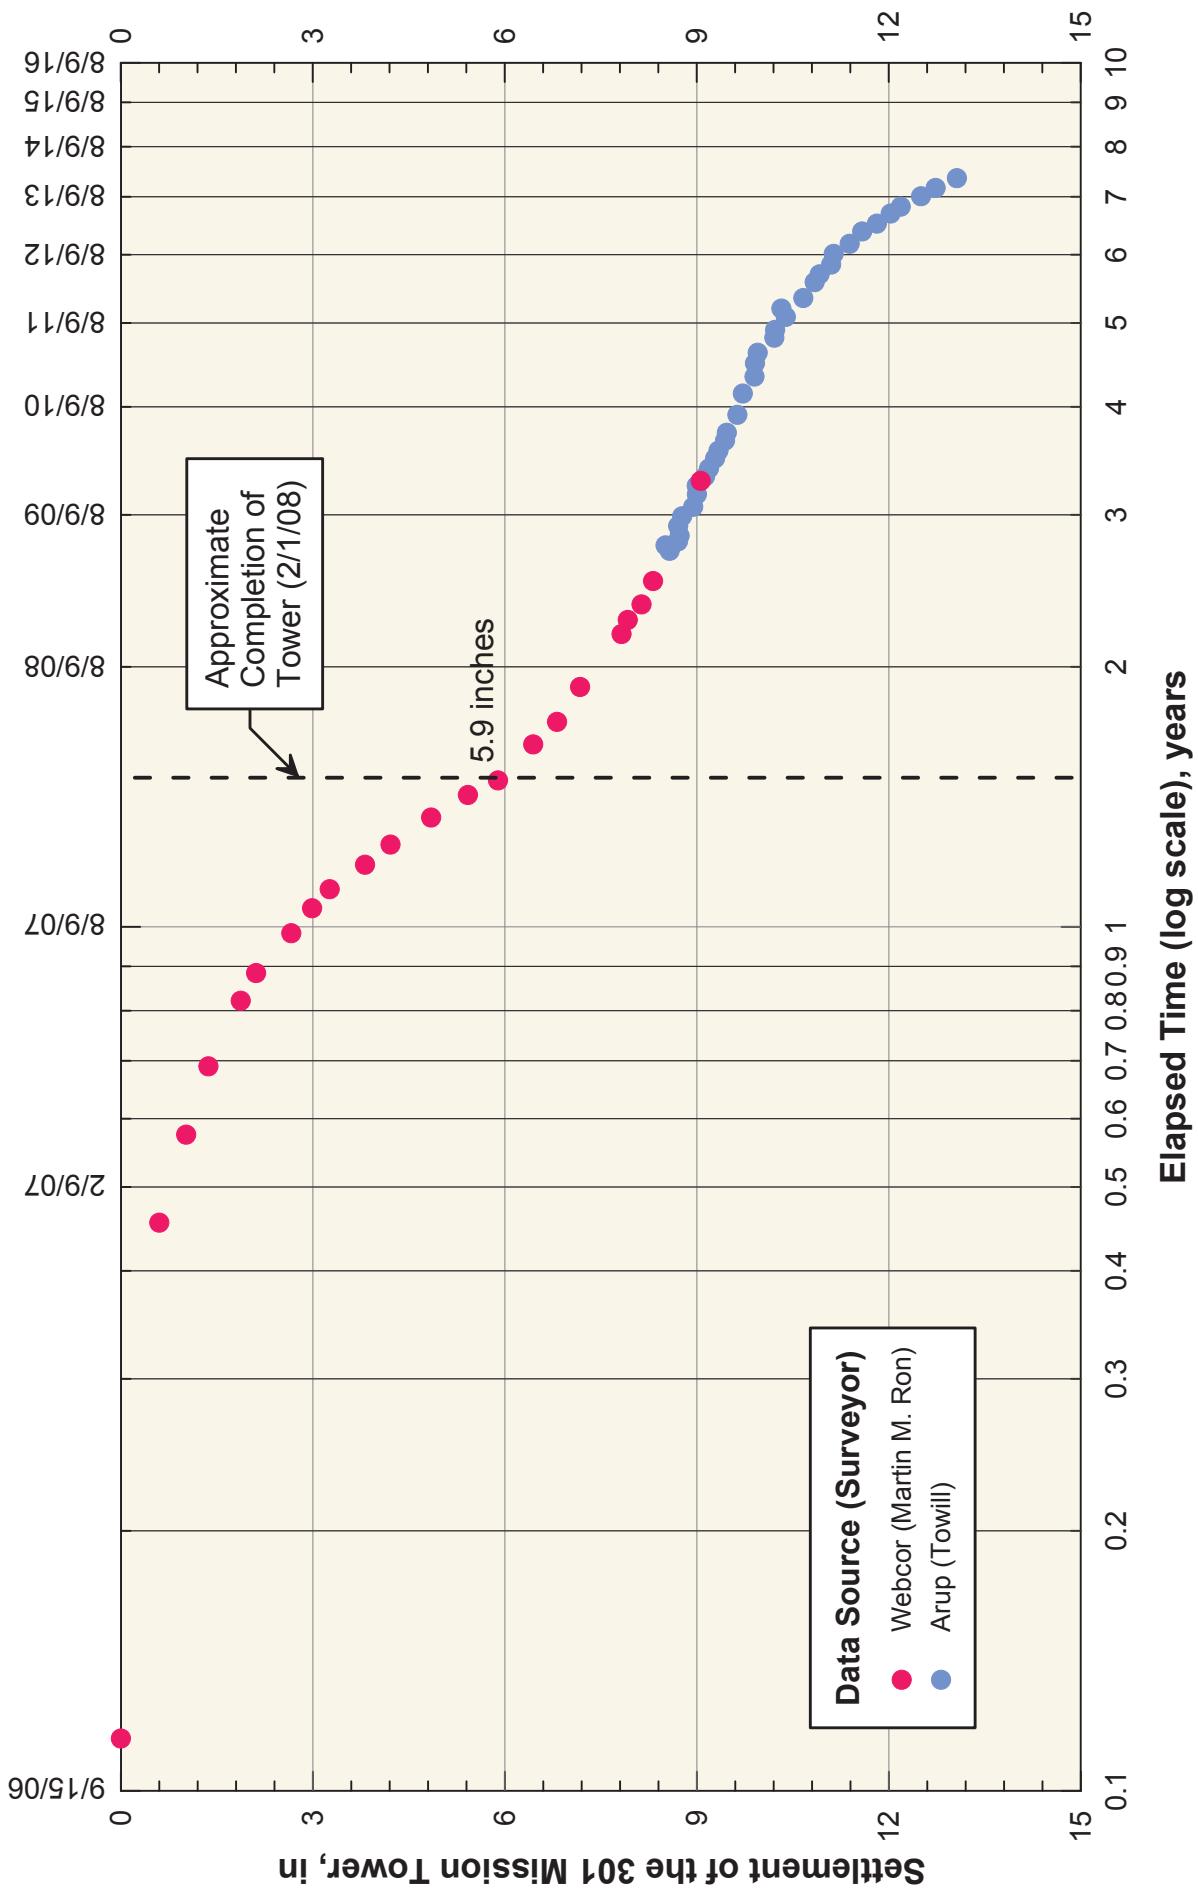


Data Source (Surveyor)

- Webcor (Martin M. Ron)
- Arup (Towill)

Beginning of Tower Construction: 8/9/06
End of Tower Construction: 2/1/08
Construction Duration: 542 days (1.5 years)

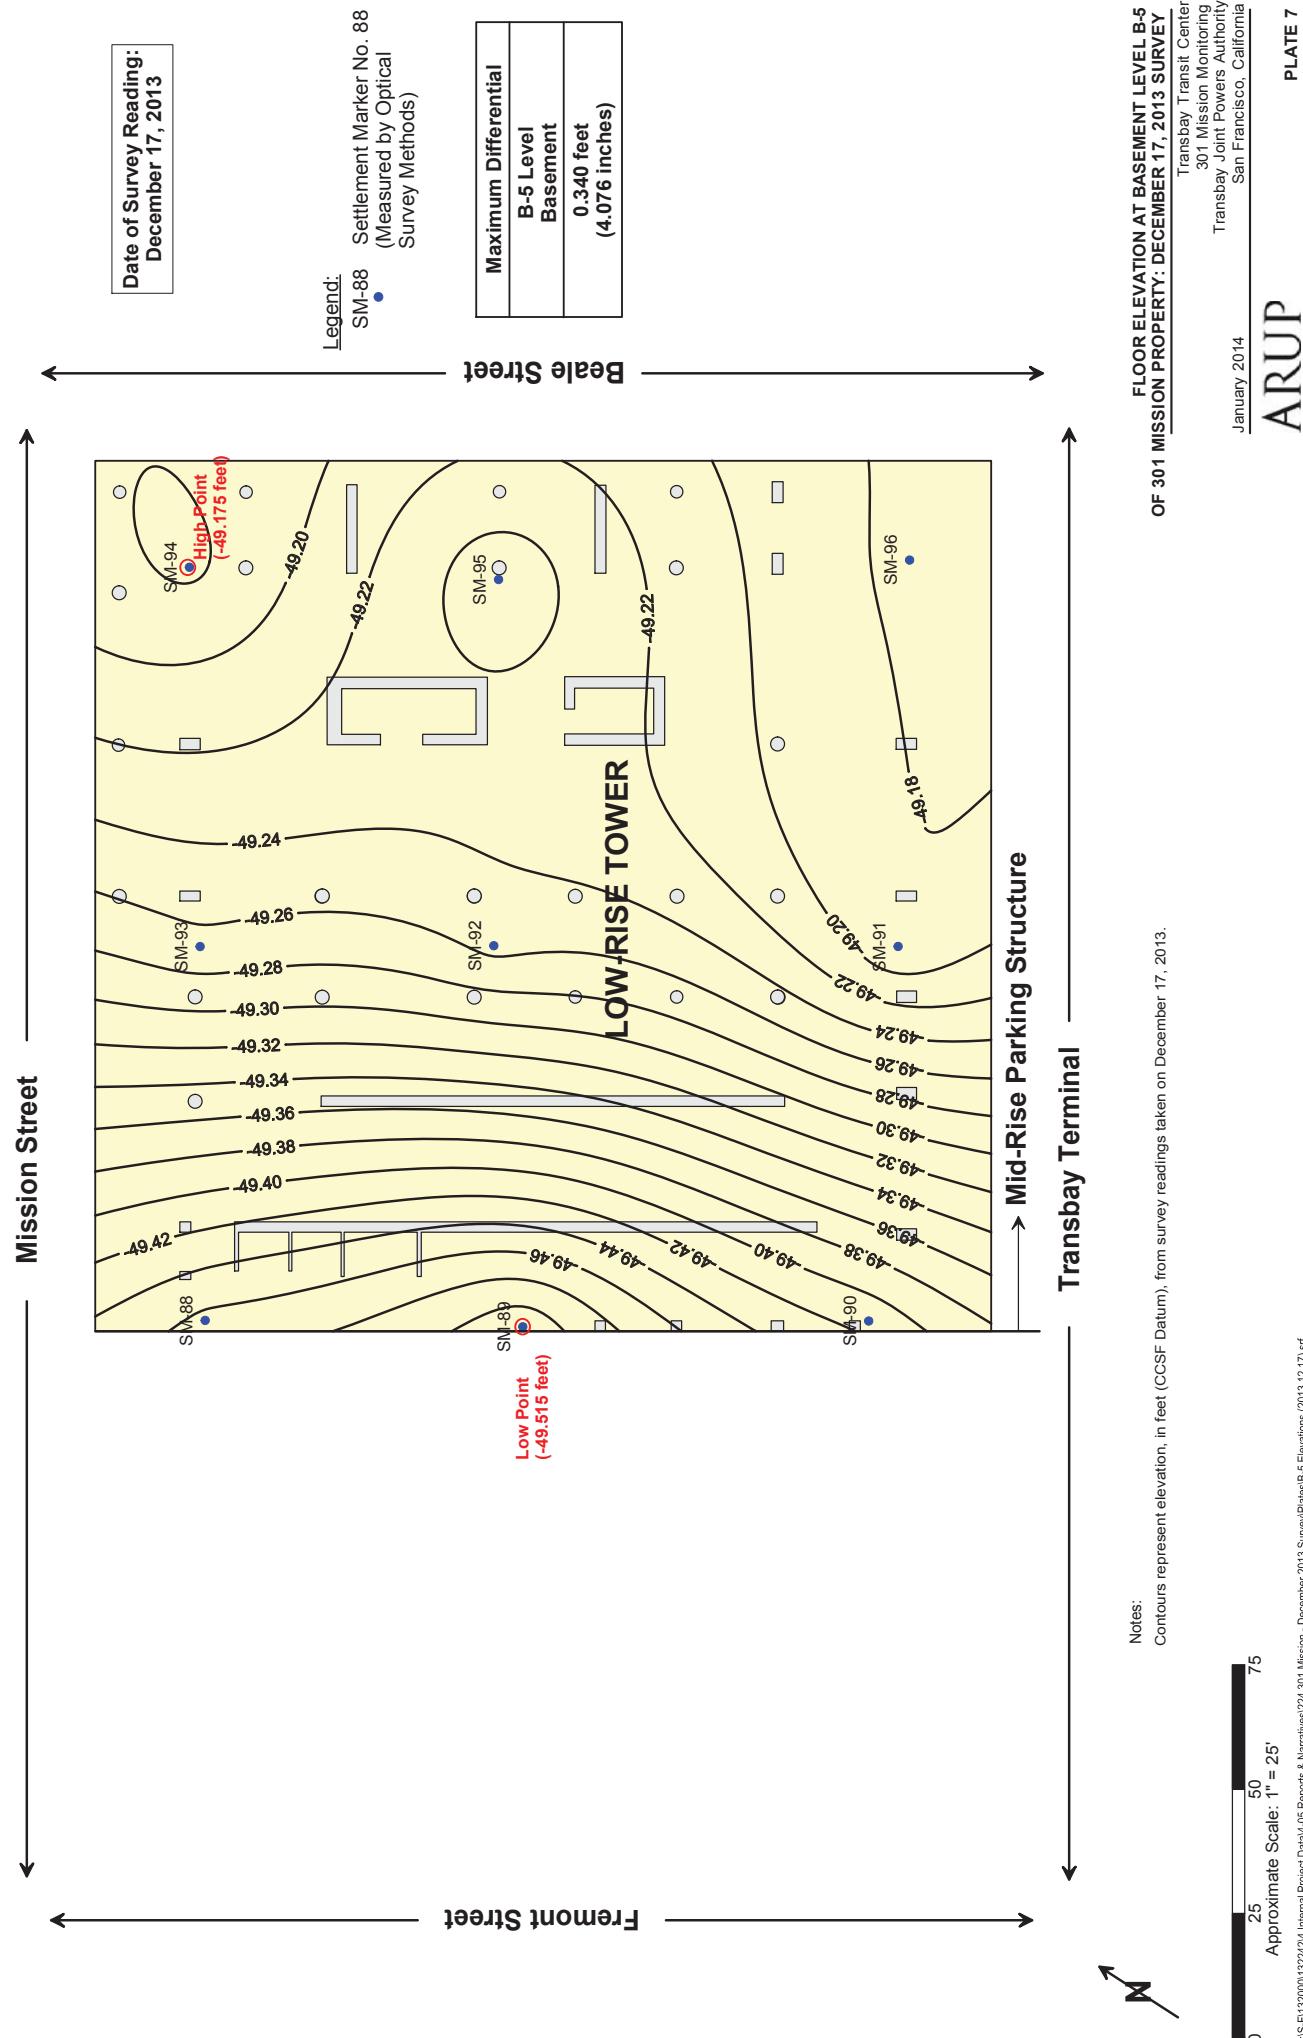

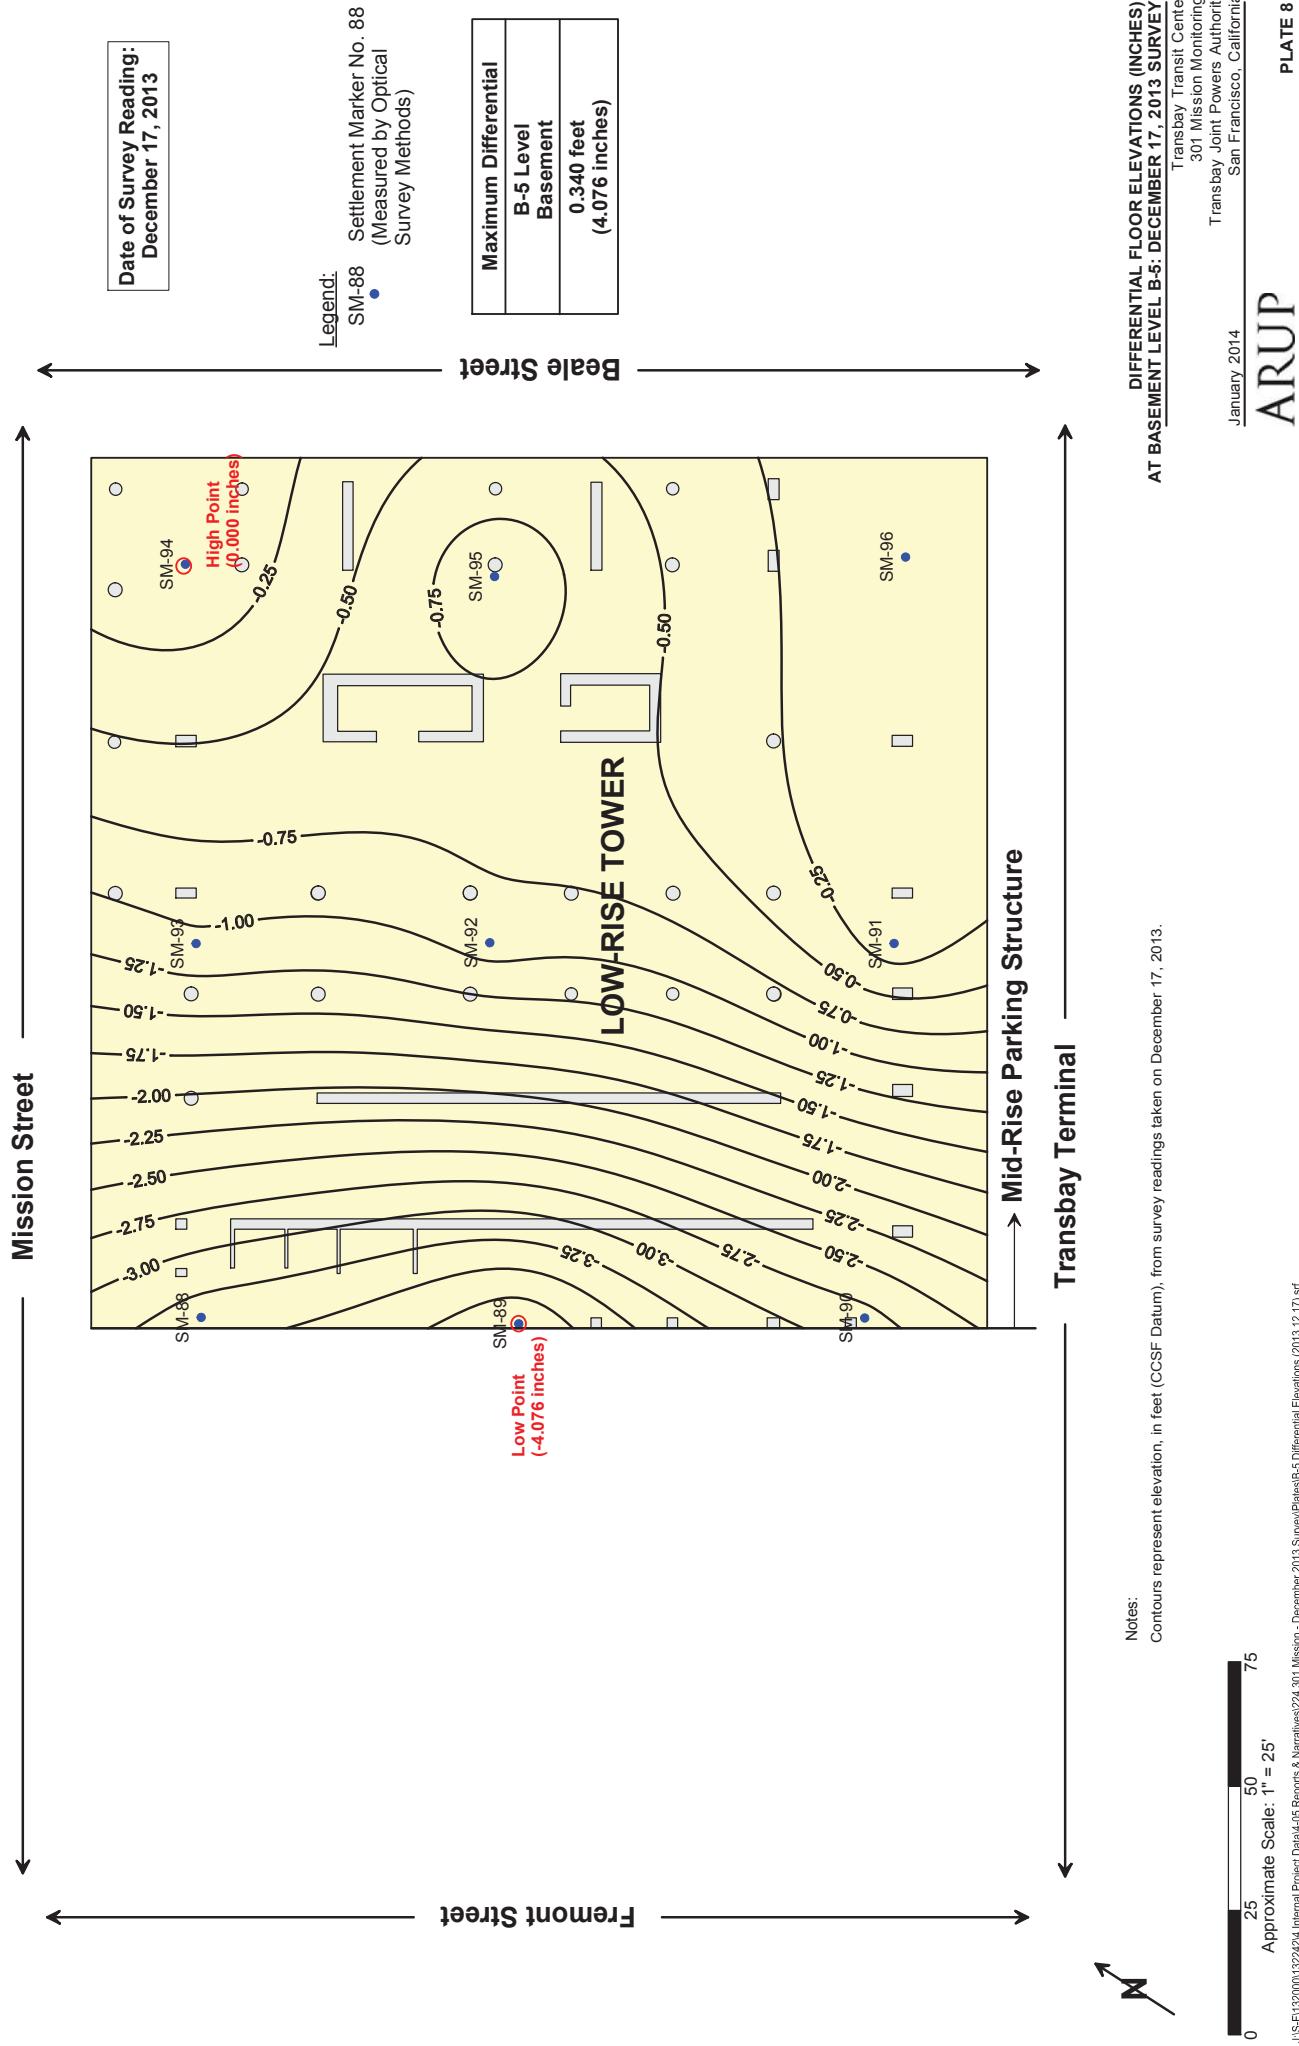

From: Brian Dykes
Sent: Tuesday, March 04, 2014 4:38 PM
To: 'Steven Hood'
Cc: Stephen McLandrich; 'Nick O'Riordan'
Subject: Meeting Request Regarding 301Mission Settlement

Steve,

I am responding to your letter dated February 26, 2014 requesting an early meeting between the engineers representing Millennium Properties and the TJPA.

We are available to meet at 9am on March 11, 13, 14, 17 and 18. Please let us know your preferred day or days as soon as possible.

In order to cover the number of items listed in your letter, please send us your Item 5 "Settlement curve as plotted by De Simone Consulting" this week so we can review it prior to the meeting.

I have attached above the Arup Memo for survey results through February 13, 2013 and their excel spread sheet with the raw data.

All bulk excavation was completed on February 7 and the last tie down micro pile was installed on February 28.

Regards, Brian.

Brian Dykes
Principal Engineer
Transbay Joint Powers Authority
201 Mission Street, Suite 2100
San Francisco, CA 94105
415 597 4617 phone
415 597 4615 fax

Check out our progress at <http://transbaycenter.org/construction-updates/construction-cameras>

NOTE: This e-mail communication and any attachments hereto are covered by the Electronic Communications Privacy Act, 18 U.S.C. Sections 2510-2521, and are legally privileged. The information contained herein is confidential, and is intended only for the use of the individual or entity to whom it is addressed. If you are not the intended recipient of this e-mail communication (or an employee or agent responsible for delivering this communication to its intended recipient(s)), you are hereby notified that any retention, copying or further distribution of this e-mail communication and any attachments is strictly prohibited. If you are not the intended recipient, please notify the sender by telephoning 415-597-4620, or by forwarding an e-mail reply message addressed to TransAdmin@TransbayCenter.org confirming that you have already destroyed (deleted) the original e-mail communication and any and all copies thereof. Thank you.

Memorandum


ARUP

To	Brian Dykes (TJPA)	Date
		28 February 2014
Copies	Randy Volenec (PCPA) George Metzger (AAI)	Reference number 132242-60/MHG
From	Stephen McLandrich (Arup)	File reference 4-05 224
Subject	Transbay Transit Center: Results of February 2014 Settlement Survey at 301 Mission Property	Page 1 of 1

Under Arup's Geotechnical Contract with the Transbay Joint Powers Authority through Pelli Clark Pelli Architects, Arup is required to monitor the settlements of the buildings adjacent to the Transbay Transit Center prior to and during construction. We began the monitoring program for the 301 Mission property in April of 2009. This memorandum and the attached plates present an update to our memorandum dated January 9, 2014 with measurements made through February 2014.

List of Plates


- Plate 1 Floor Elevations at Level B-1 of 301 Mission Property: Periodic Survey – February 13, 2014
- Plate 2 Differential Floor Elevation (Inches) – February 13, 2014 Survey
- Plate 3 Contours of Settlements Measured at the 1st Level Basement of the 301 Mission St. Structure Between 04/30/2009 & 2/13/2014
- Plate 4 Settlement Over Time Floor Elevations at Level B-1 of 301 Mission Property – Tower: April 30, 2009 through February 13, 2014
- Plate 5 Settlement Over Time Floor Elevations at Level B-1 of 301 Mission Property – Mid-Rise: April 30, 2009 through February 13, 2014
- Plate 6 Settlements of the 301 Mission Tower Including Monitoring During Construction
- Plate 7 Floor Elevation at Basement Level B-5 of 301 Mission Property: February 13, 2014 Survey
- Plate 8 Differential Floor Elevations (Inches) at Basement Level B-5: February 13, 2014 Survey

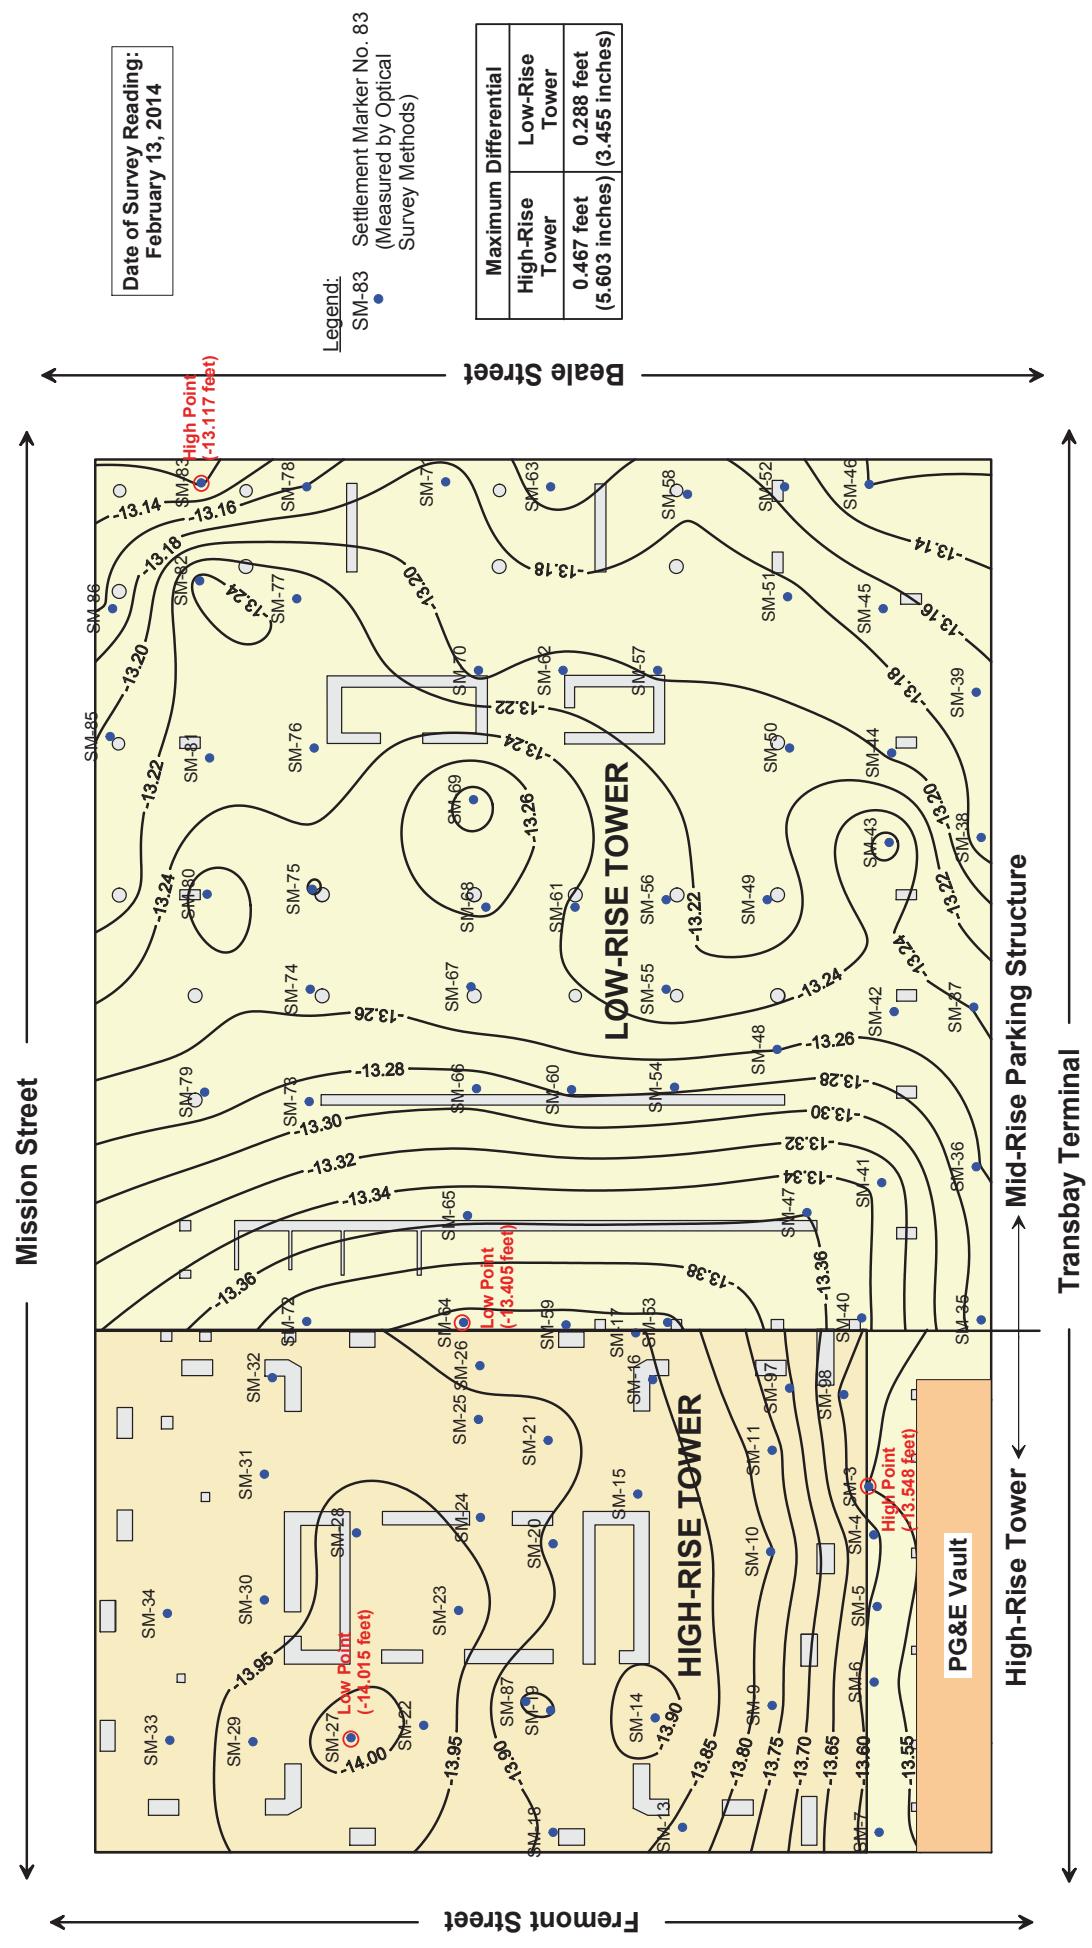


**FLOOR ELEVATIONS AT LEVEL B-1
OF 301 MISSION PROPERTY:
PERIODIC SURVEY - FEBRUARY 13, 2014**

Transbay Transit Center
301 Mission Monitoring
Transbay Joint Powers Authority
San Francisco, California

February 2014

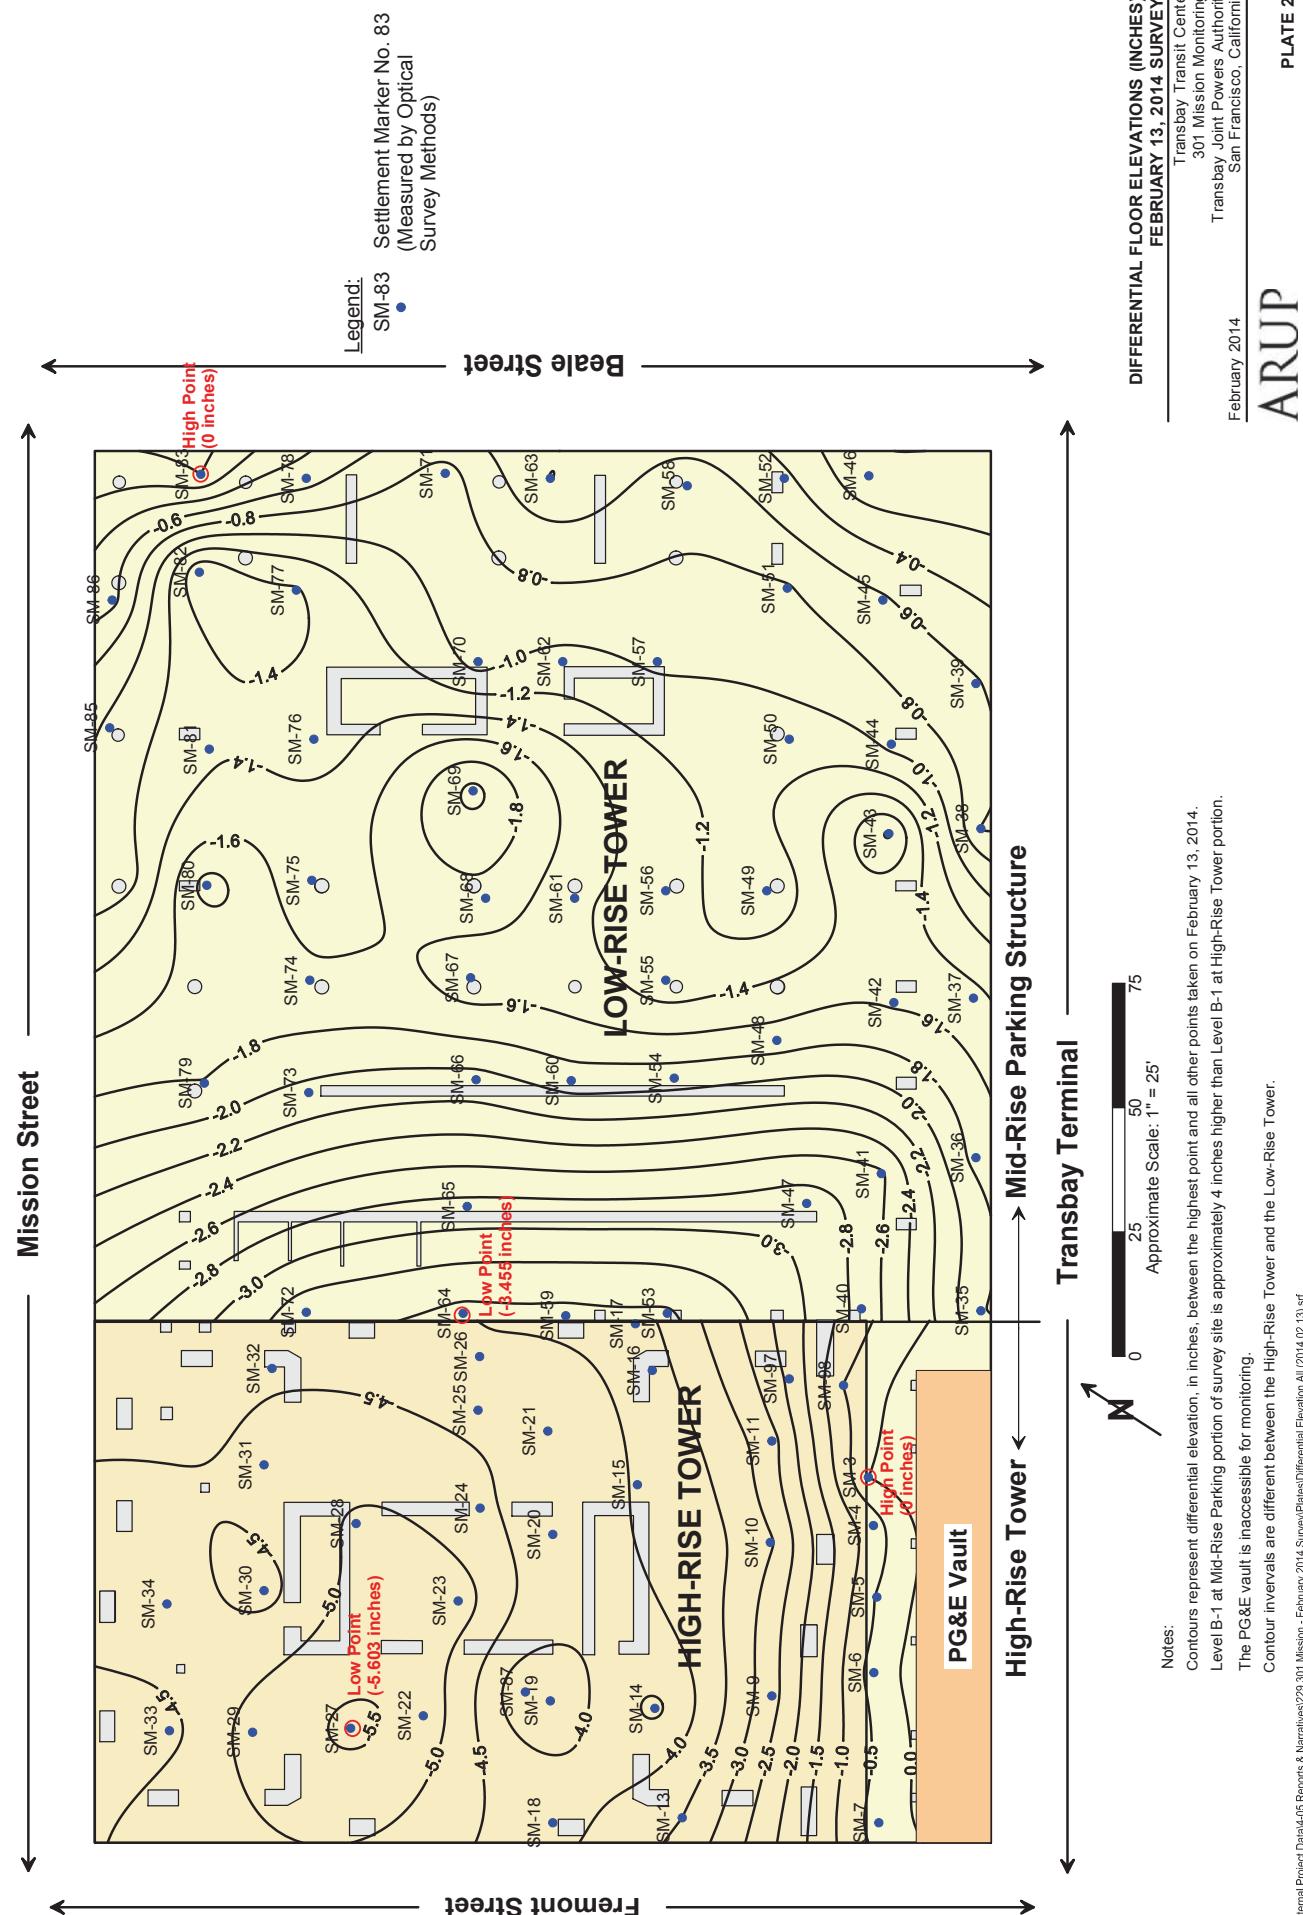

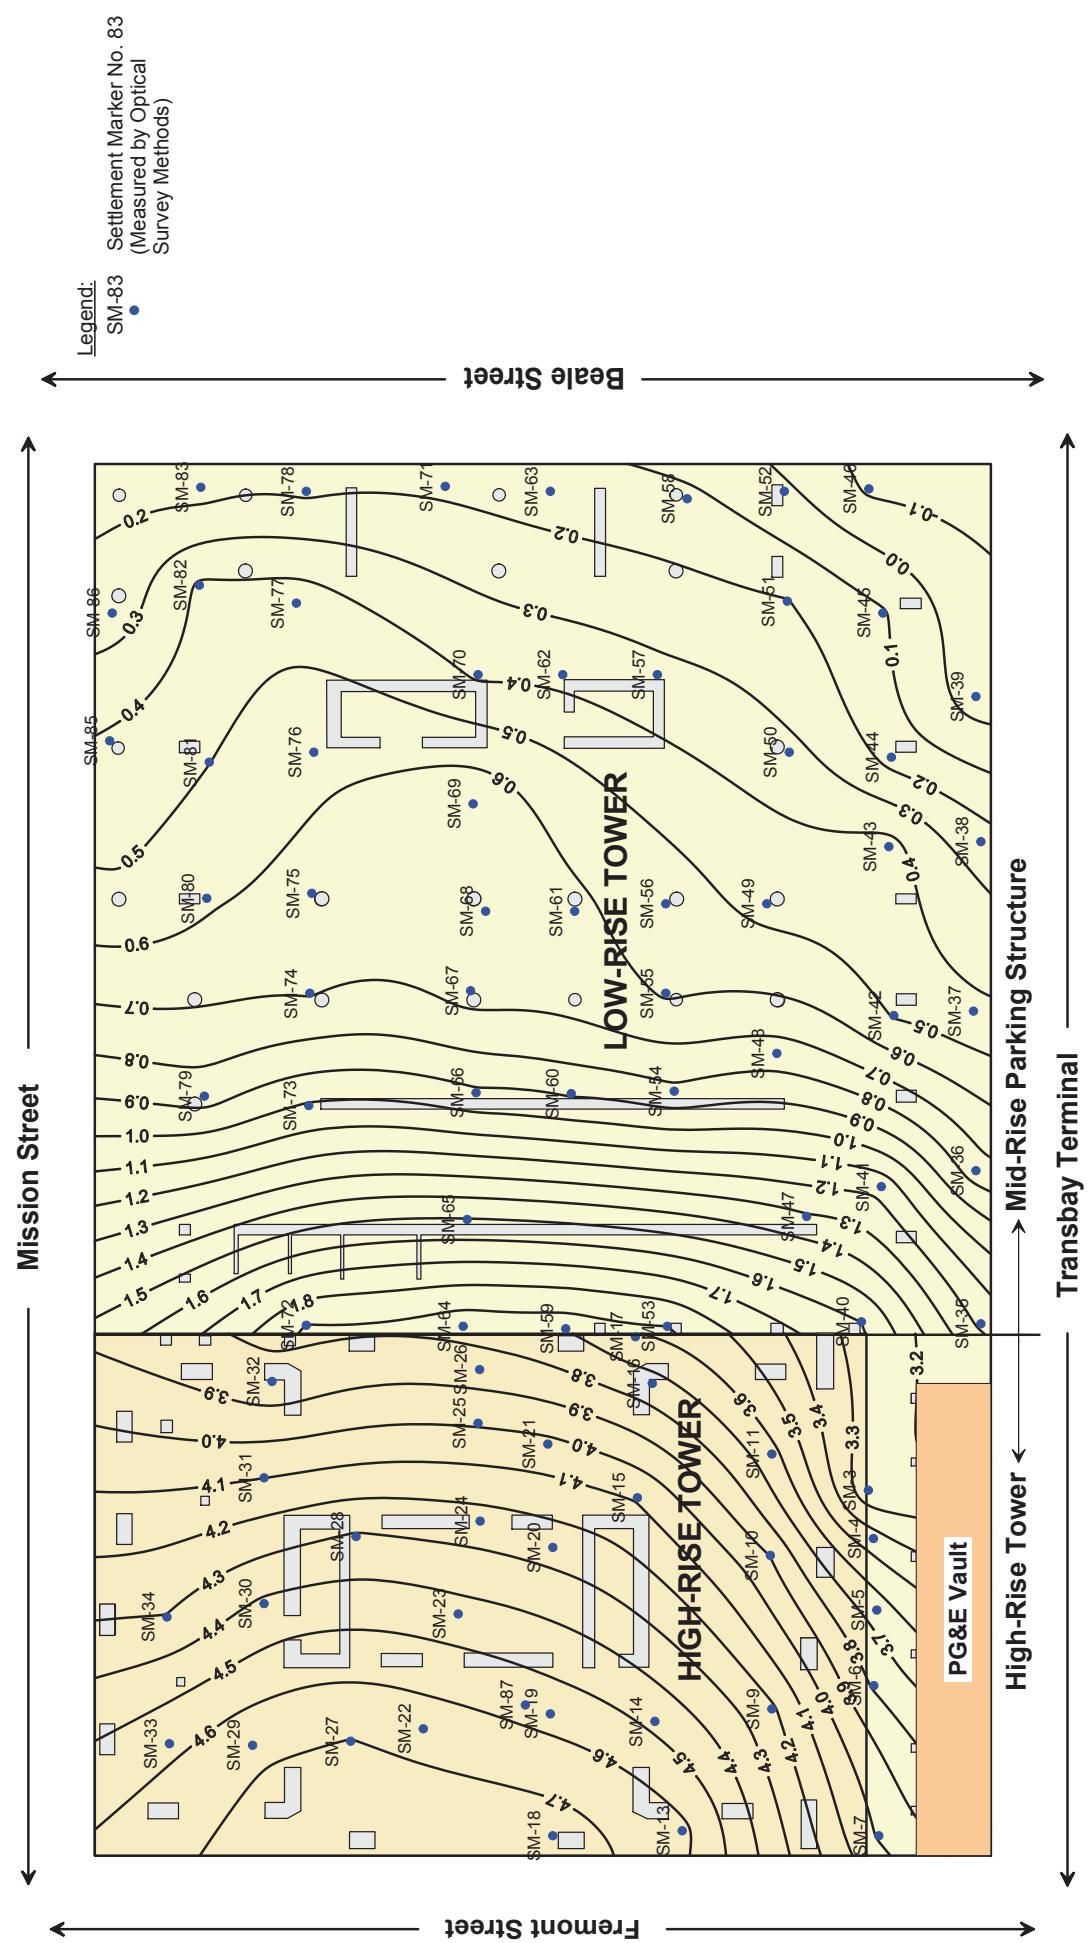

CONTOURS OF SETTLEMENTS MEASURED AT THE 1ST LEVEL BASEMENT OF THE 301 MISSION ST STRUCTURE BETWEEN 04/30/2009 & 12/17/2013

Transbay Transit Center
301 Mission Monitoring
Transbay Joint Powers Authority
San Francisco, California

February 2014

Notes:
Contours represent elevation change, in inches, between Baseline survey (April 30, 2009) and readings taken on February 13, 2014.
Level B-1 at Mid-Rise Parking portion of survey site is approximately 4 inches higher than Level B-1 at High-Rise Tower portion.

The PG&E vault is inaccessible for monitoring.

Negative values of settlement (within Low-rise Tower) indicate uplift.

Approximate Scale: 1" = 25'

JIS-F13200013224 Internal Project Data445 Regions - February 2014 Survey/Plate/Elevation changes All (20140213).stf

ARUP



Note:
Initial (Baseline) reading
taken on 04/30/09

J.S.F.13224214 Internal Project Data4-05 Reports & Narratives\229 301 Mission - February 2014 Survey\Plates\Plate 4 Settlement Over Time - Tower.grf

TOWER

SETTLEMENT OVER TIME
FLOOR ELEVATIONS AT LEVEL B-1
OF 301 MISSION PROPERTY- TOWER:
APRIL 30, 2009 THROUGH FEBRUARY 13, 2014

Transbay Transit Center
301 Mission Monitoring
Transbay Joint Powers Authority
San Francisco, California

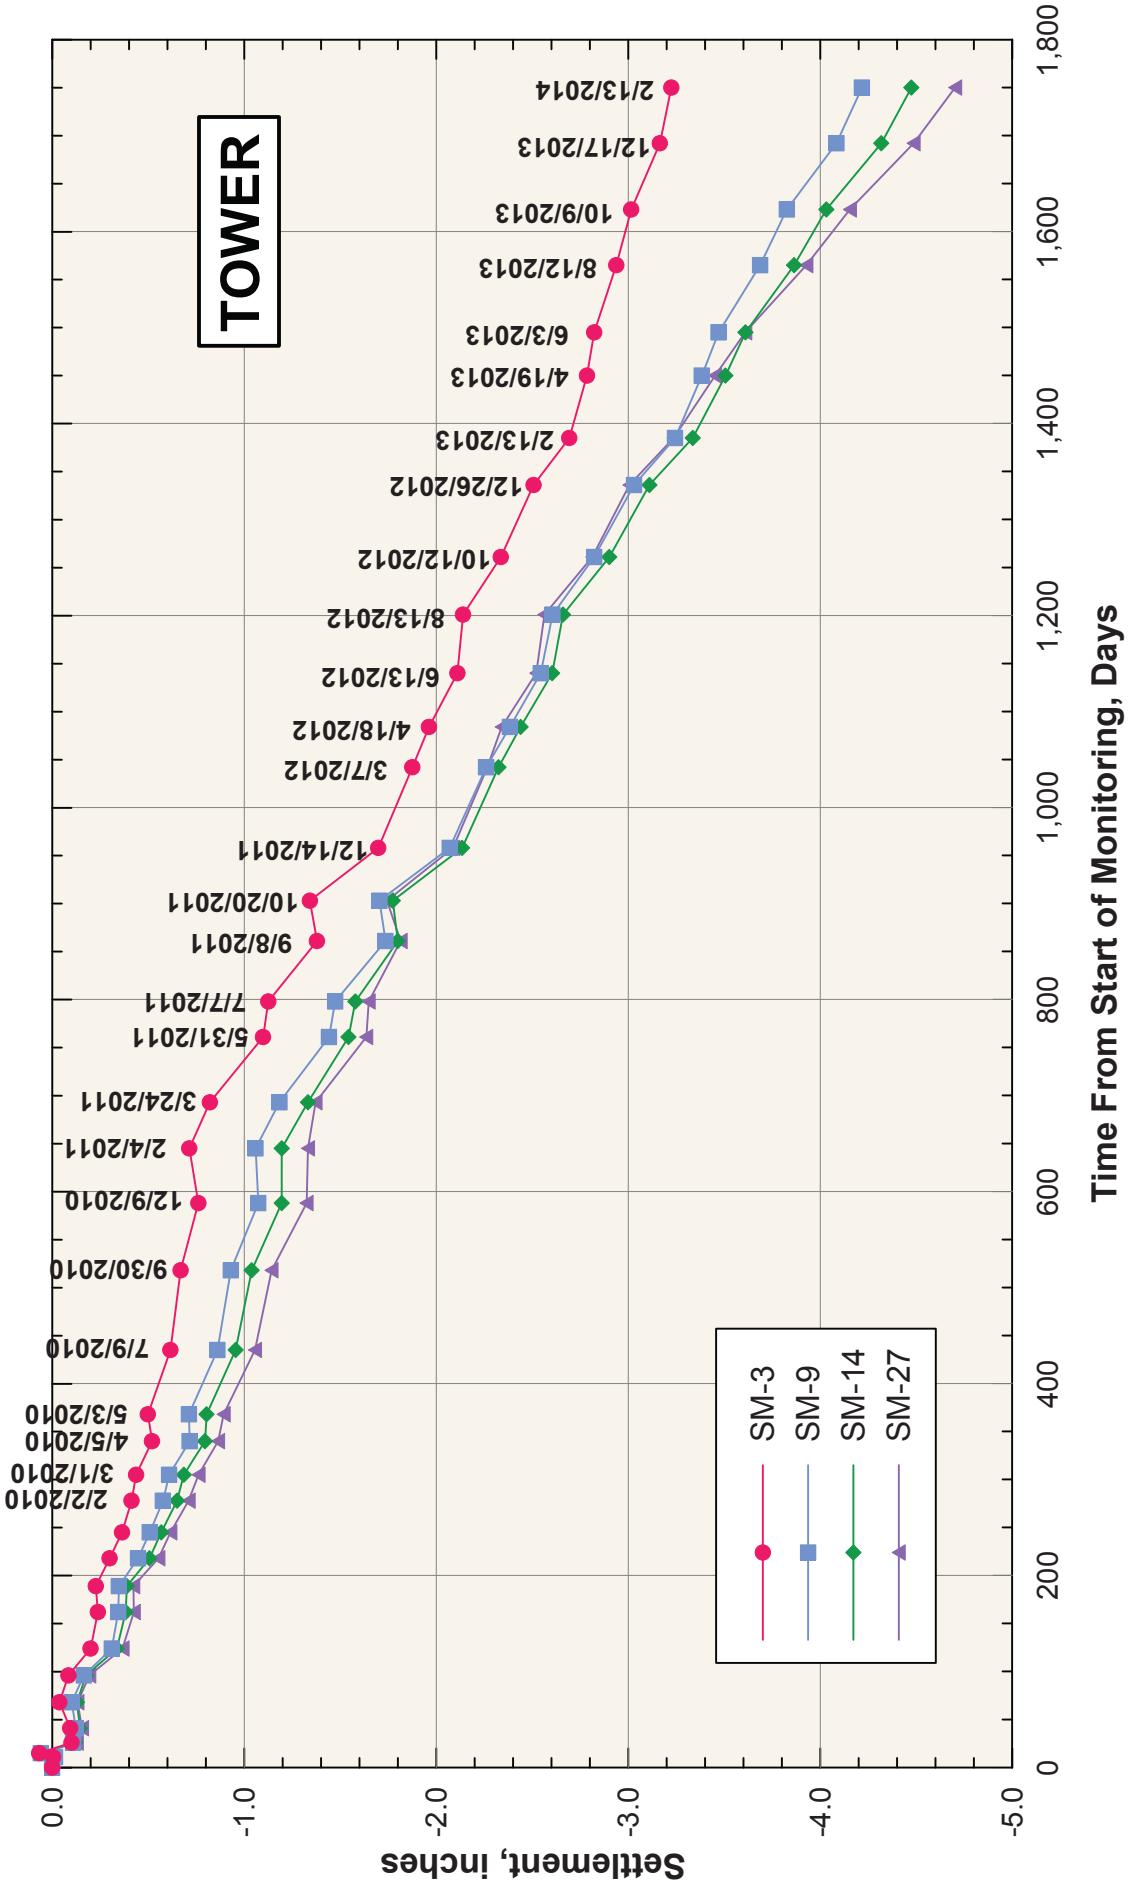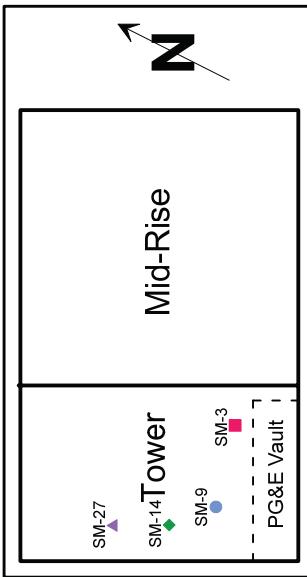



ARUP

Note:
Initial (Baseline) reading
taken on 04/30/09

J.S.F.13224214 Internal Project Data4-05 Reports & Narratives\229 301 Mission - February 2014 Survey\Plates\Plate 5 Settlement Over Time - Midrise.grf

SETTLEMENT OVER TIME
FLOOR ELEVATIONS AT LEVEL B-1
OF 301 MISSION PROPERTY - MID-RISE:
APRIL 30, 2009 THROUGH FEBRUARY 13, 2014


Transbay Transit Center
301 Mission Monitoring
Transbay Joint Powers Authority
San Francisco, California

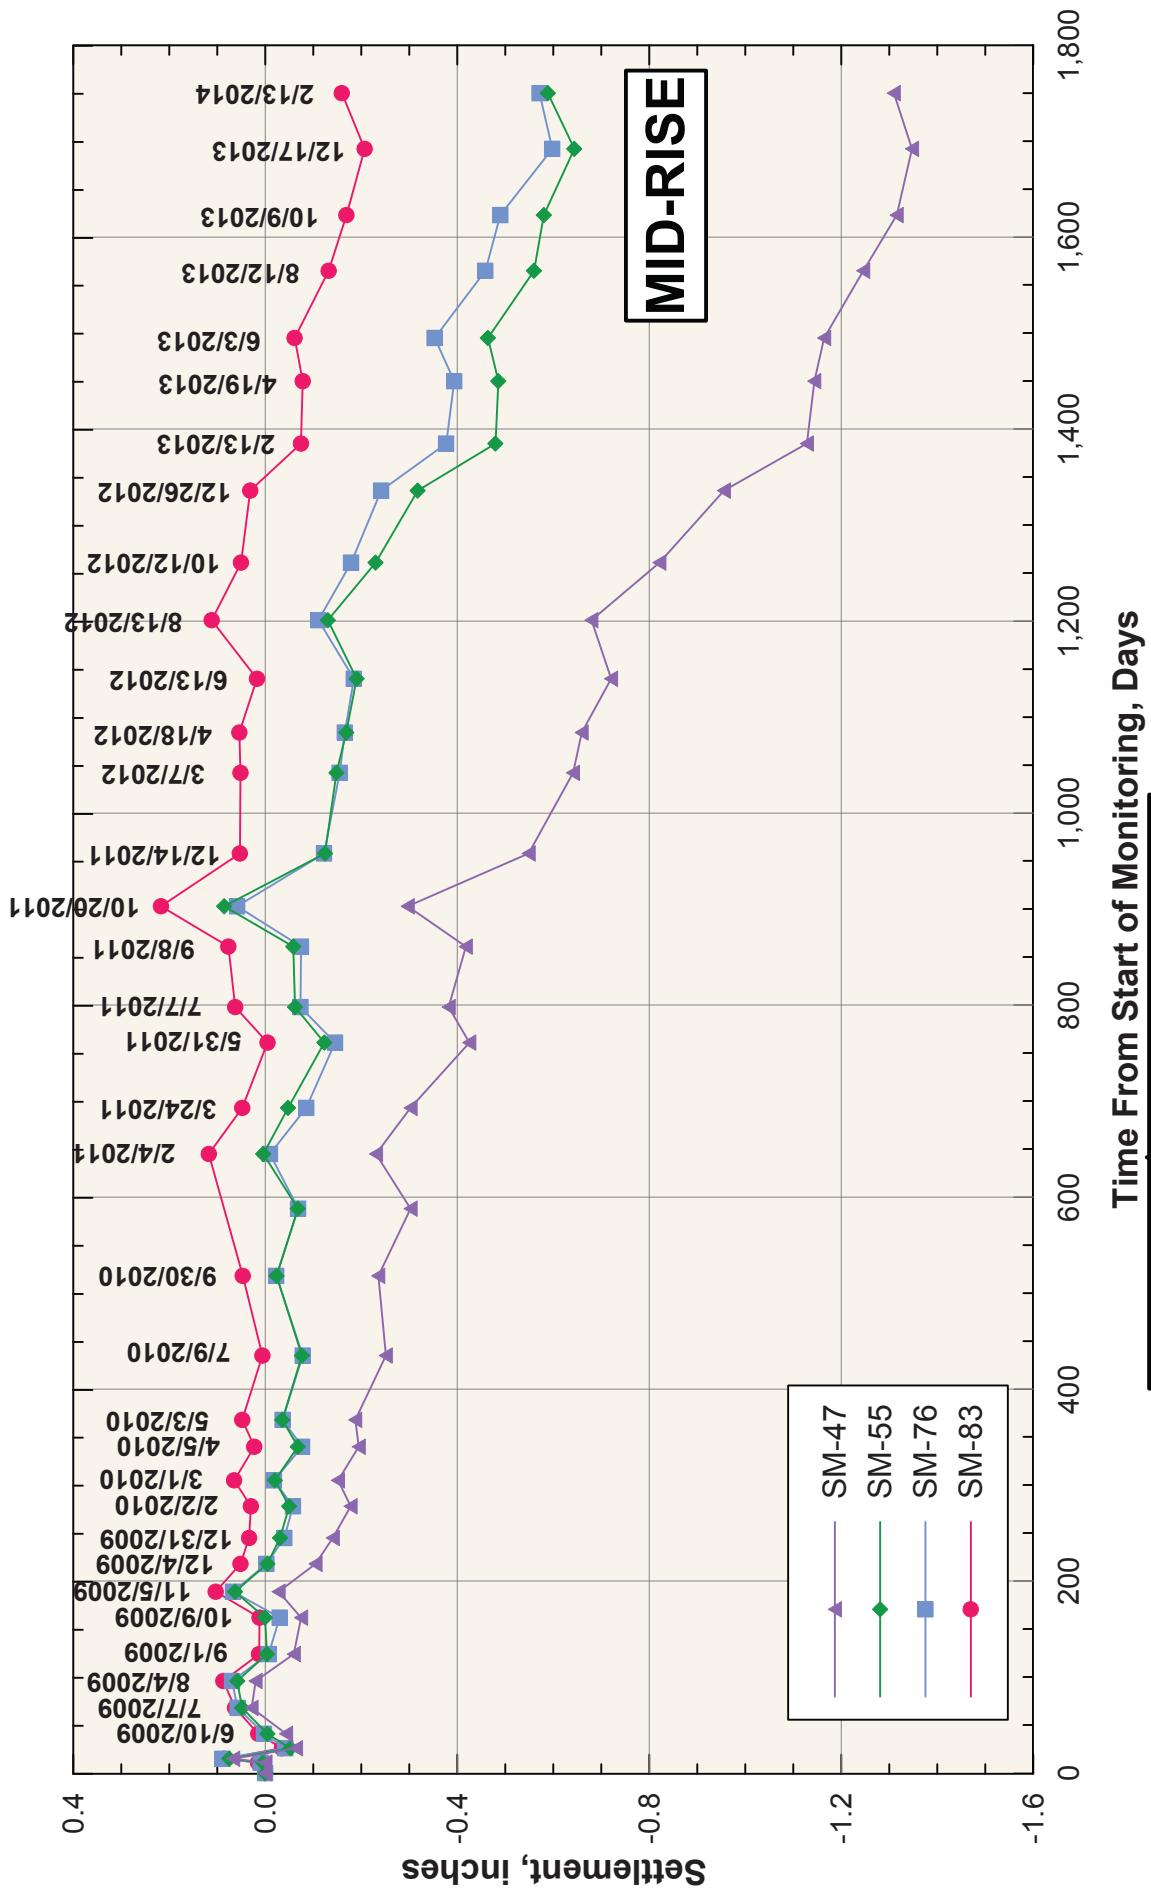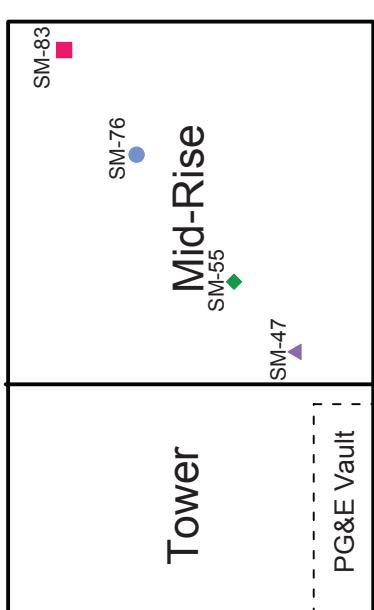



**SETTLEMENTS OF THE 301 MISSION TOWER
INCLUDING MONITORING DURING CONSTRUCTION**

Transbay Transit Center
301 Mission Monitoring
Transbay Joint Powers Authority
San Francisco, California

February 2014

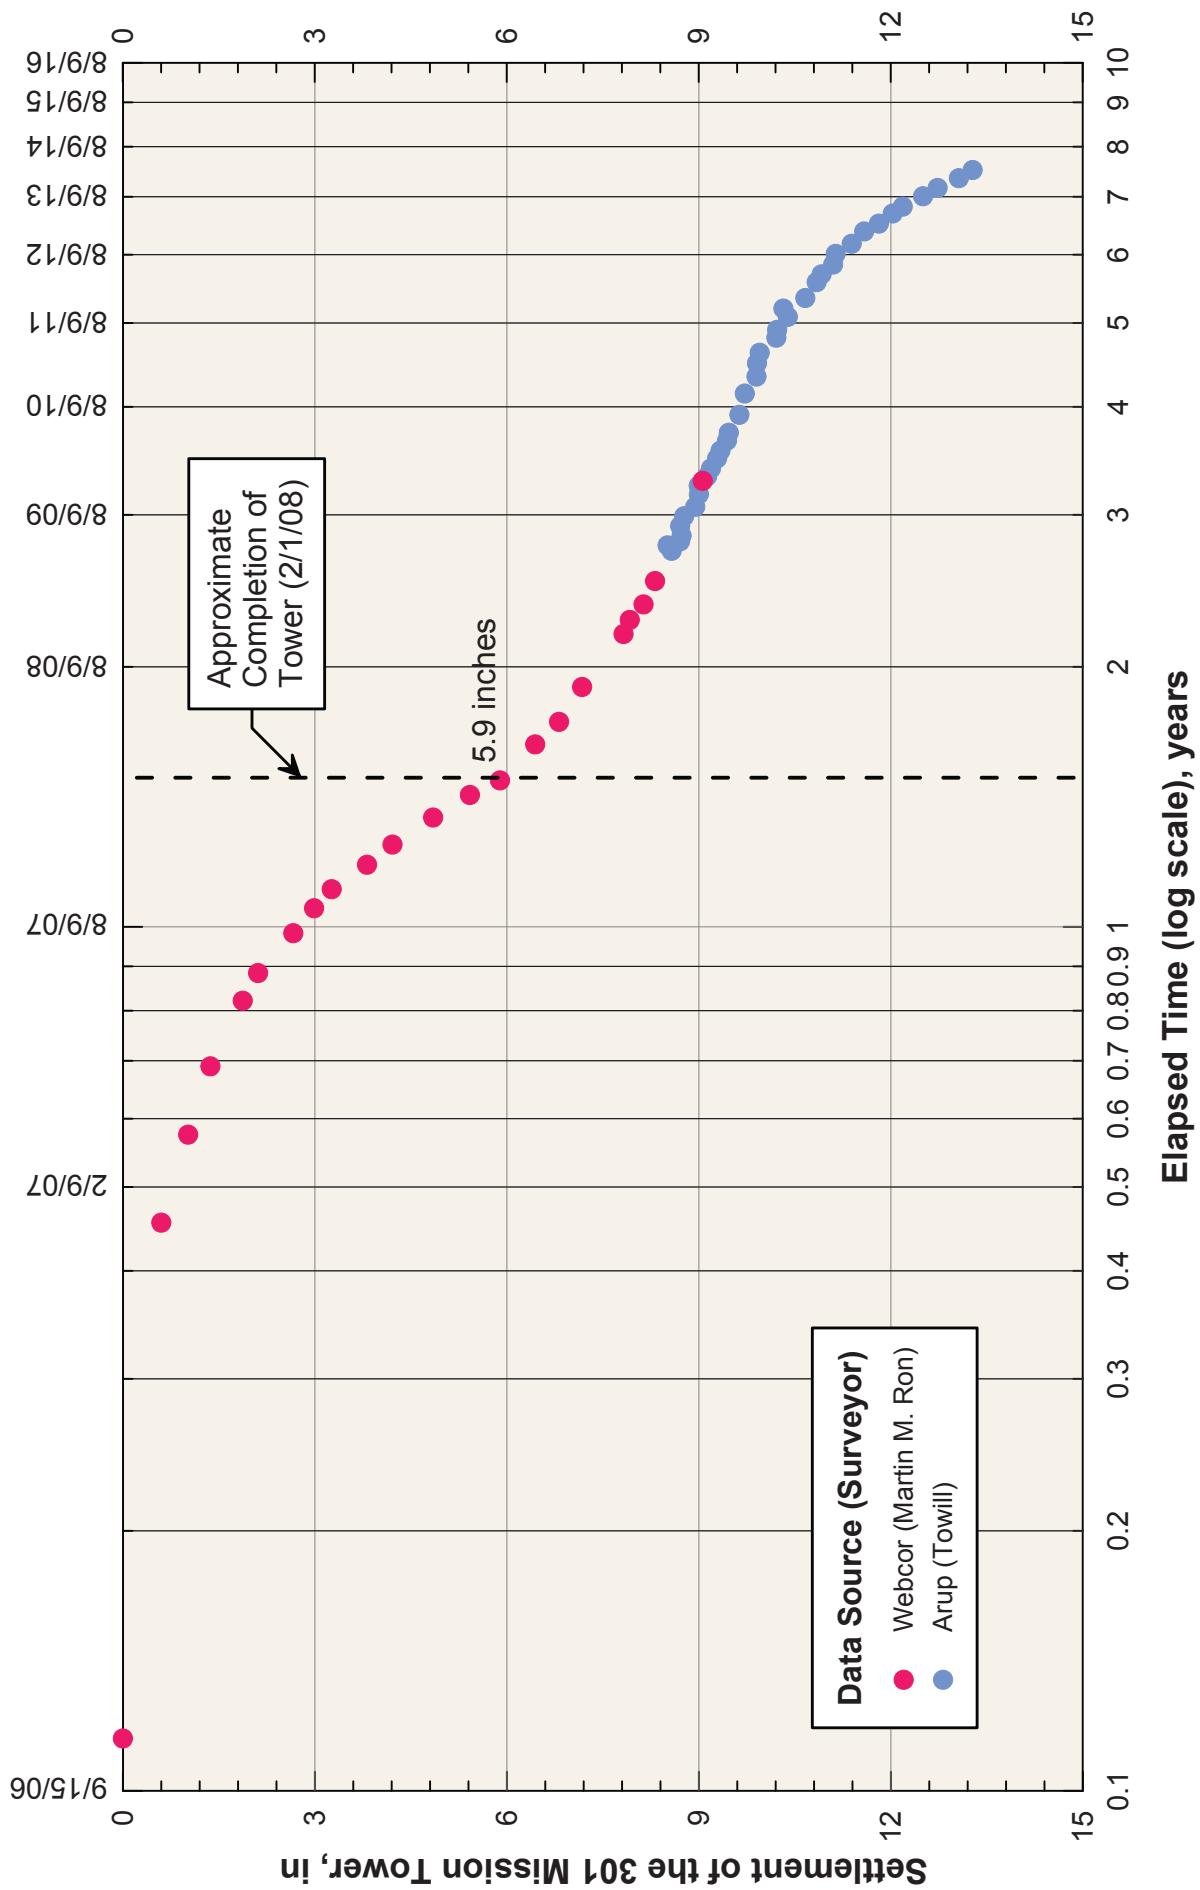

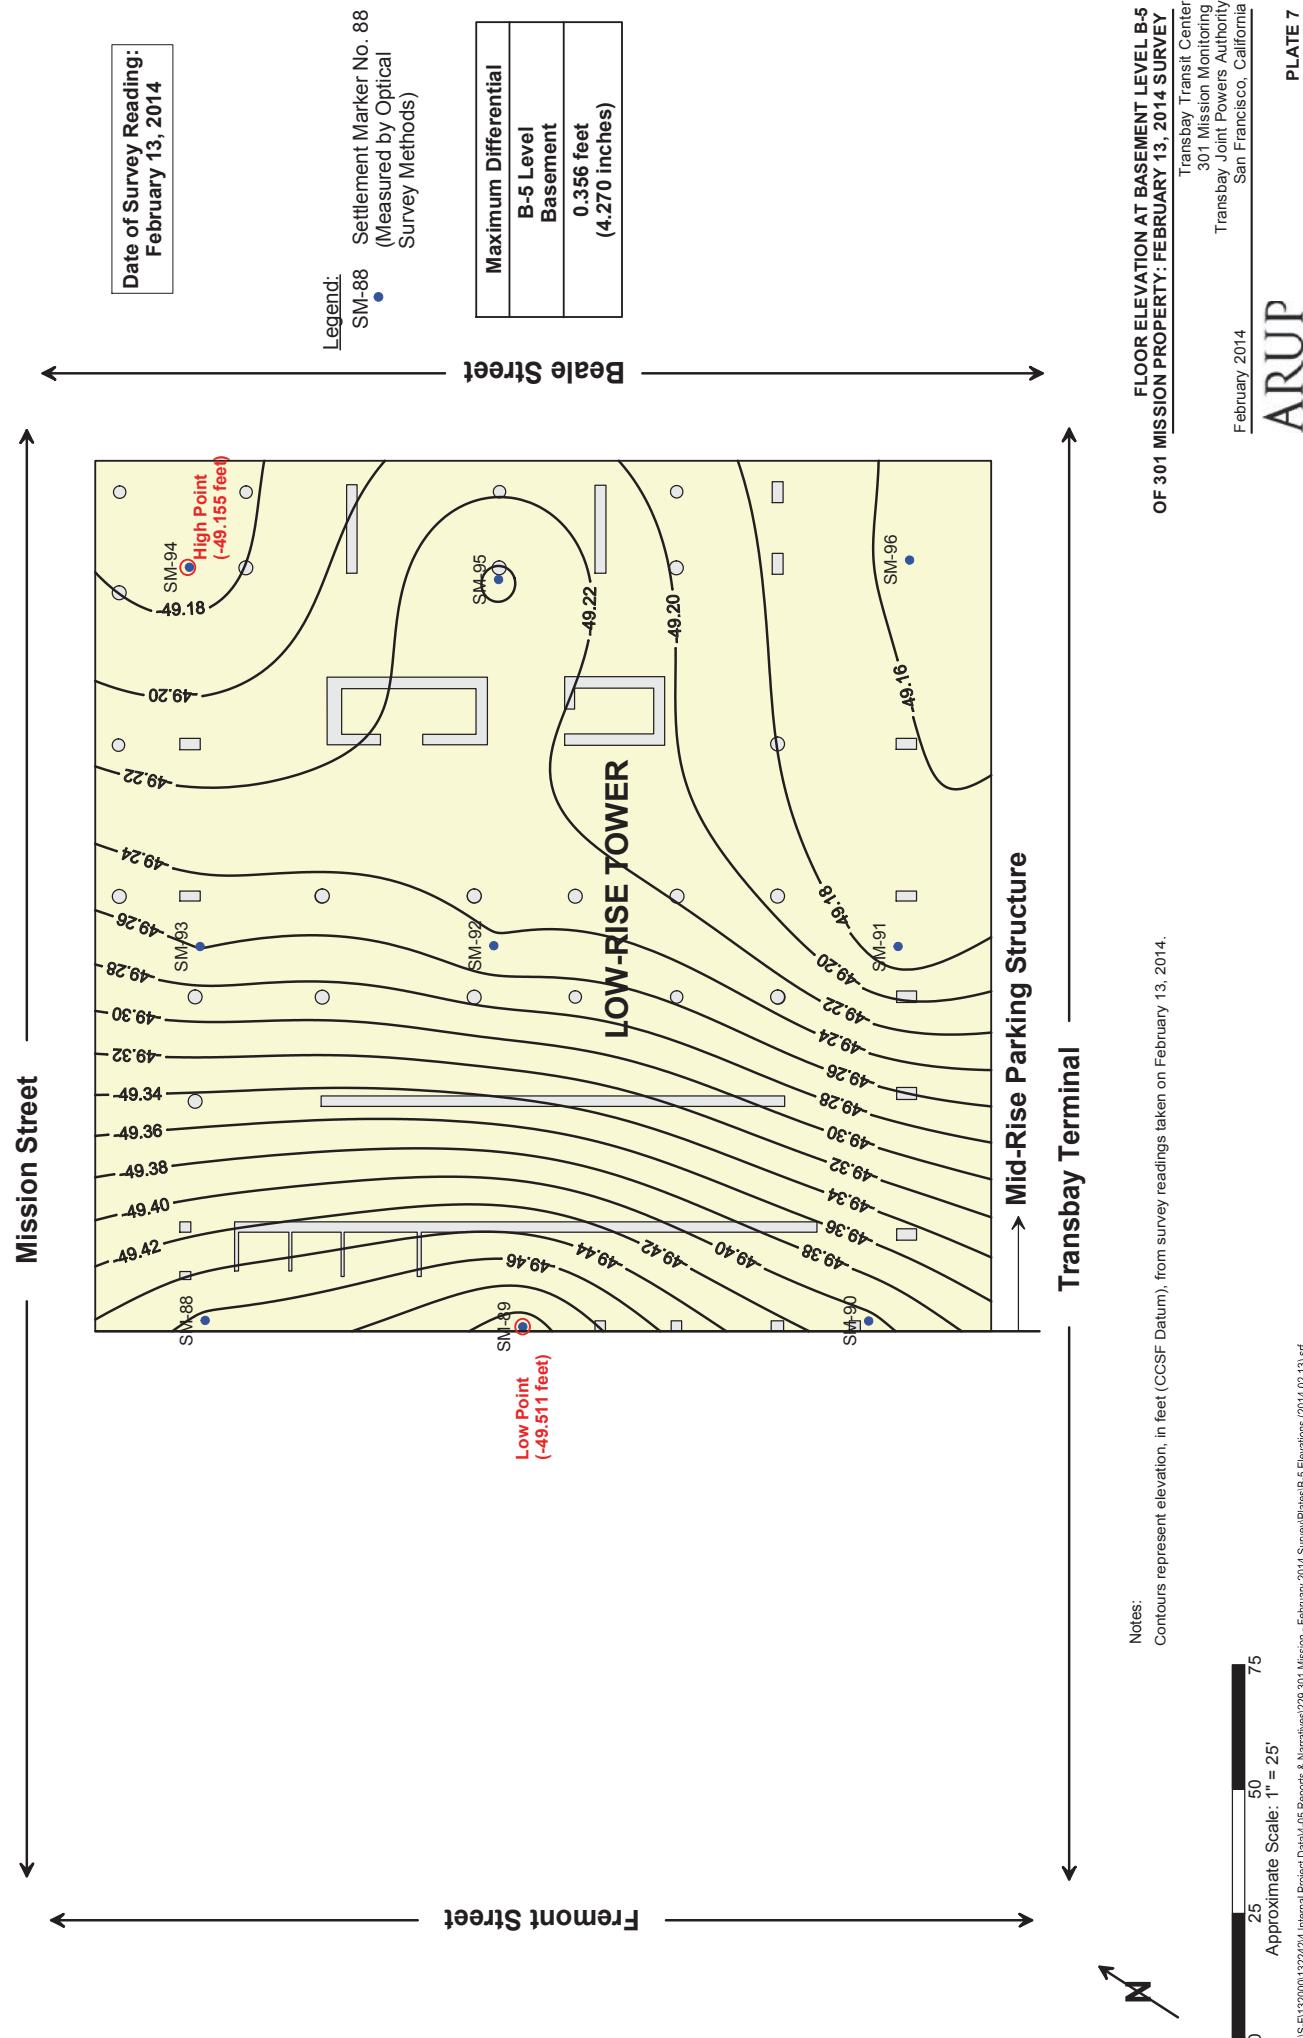

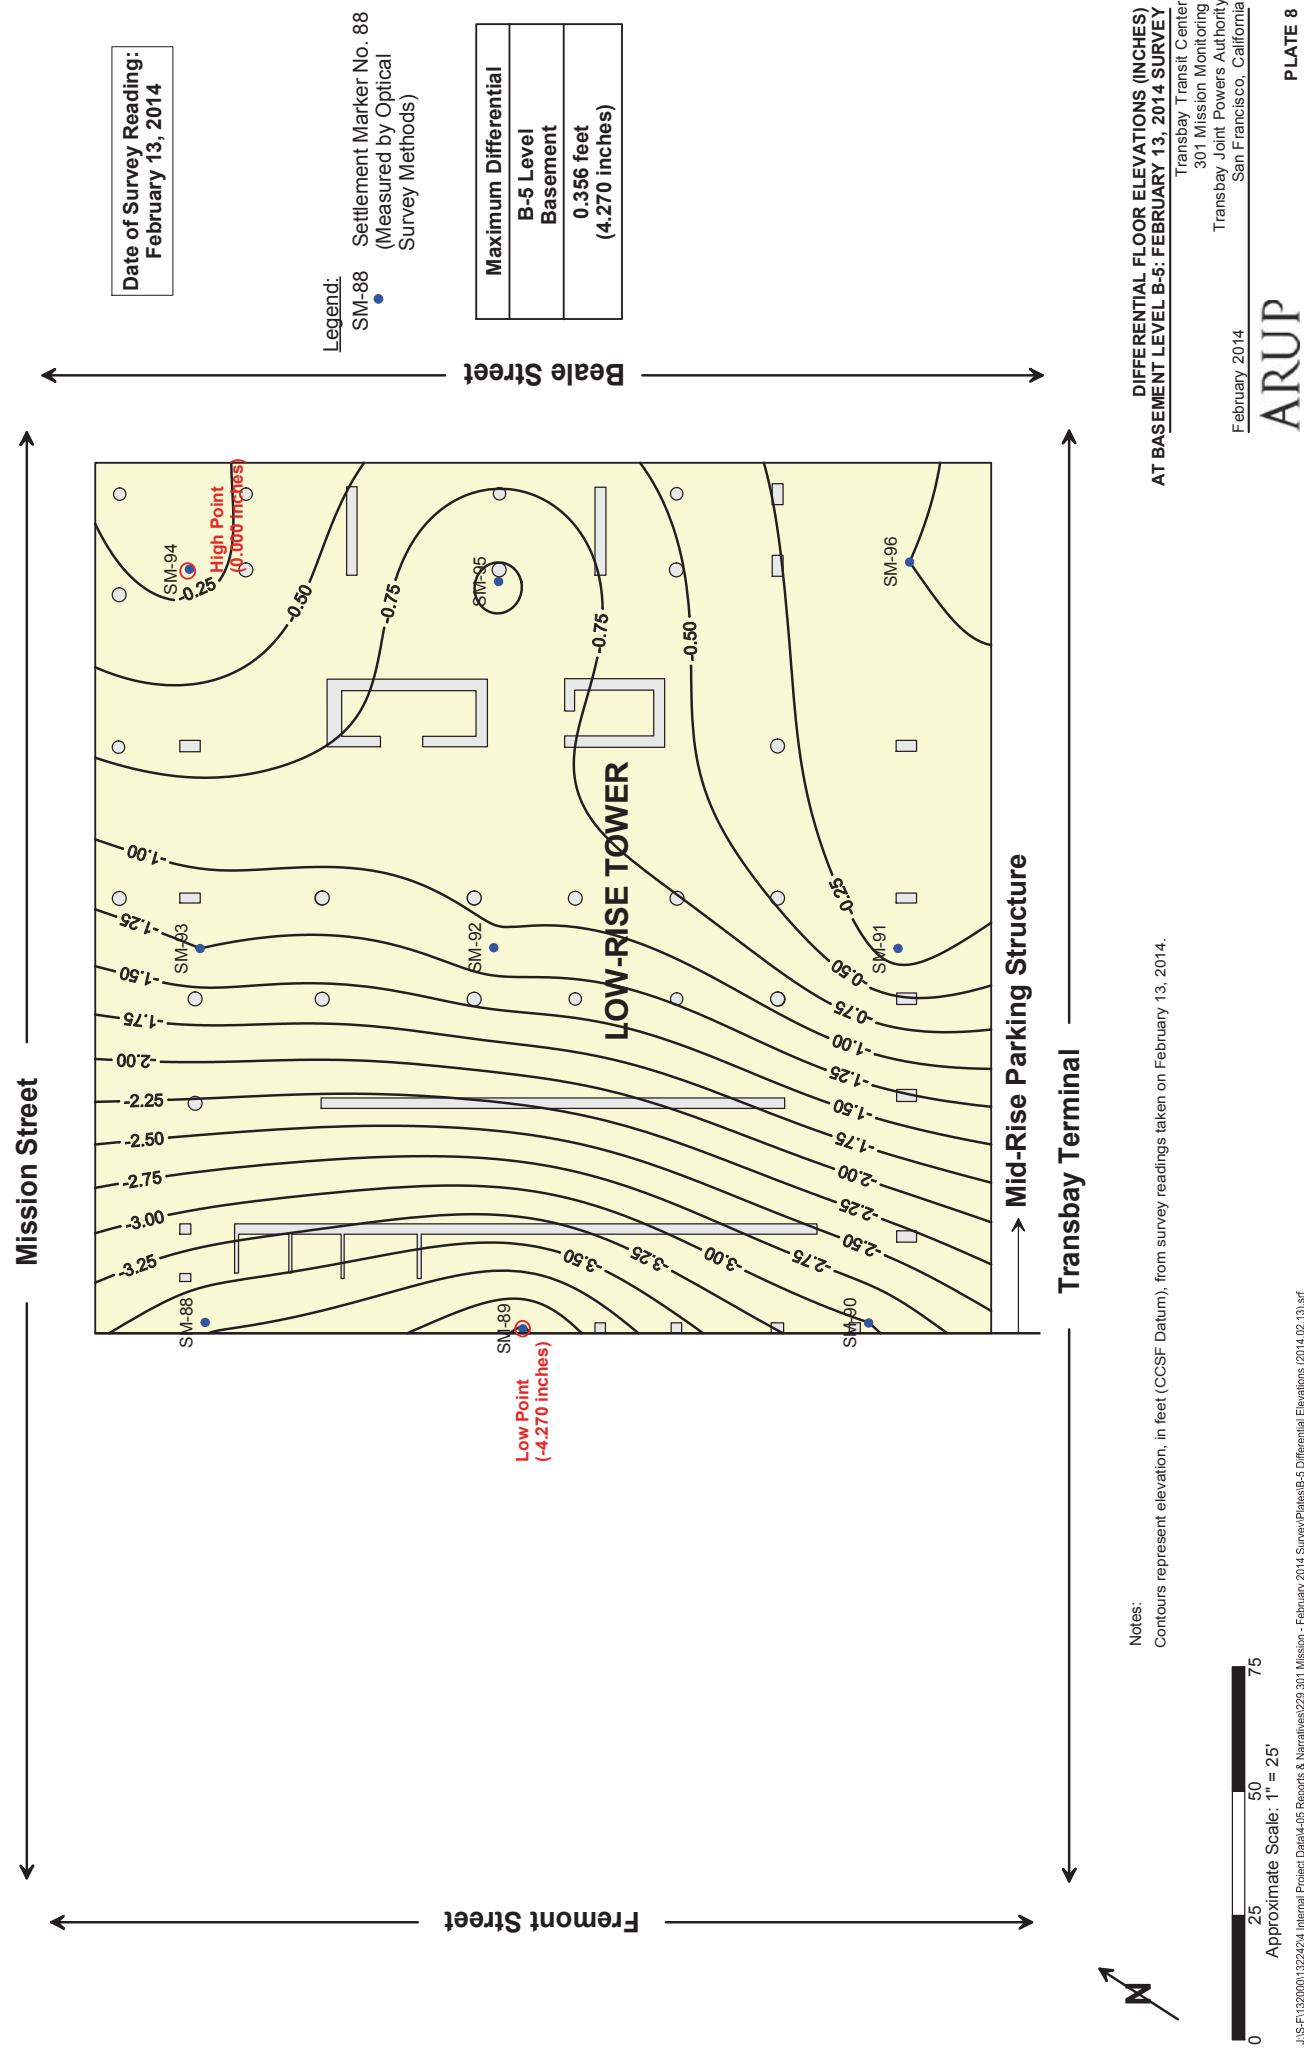

From: Brian Dykes
Sent: Wednesday, May 07, 2014 3:23 PM
To: Steven Hood
Cc: Margie Cleland; Nila Gonzales
Subject: FW: 301 Mission Monitoring Memo - April Survey
Attachments: 2014-05-07 Memo_301 Mission Settlement - Apr 2014 Survey.pdf; 301 Mission Monitoring Survey 04112014.xlsx

Steven,
Here are the settlement readings taken on April 11, 2014.

Margie,
Please file this email and the attachments with the 201 Mission Street correspondence.

Thanks, Brian.

From: Stephen McLandrich [<mailto:stephen.mclandrich@arup.com>]
Sent: Wednesday, May 07, 2014 2:20 PM
To: Brian Dykes
Cc: 'rvolenec@pcparch.com' (rvolenec@pcparch.com); George Metzger; Jeff Dunn; Nick O'Riordan
Subject: 301 Mission Monitoring Memo - April Survey

Brian,

Please find the attached survey memo for the April 2014 survey. Additionally, I attach the raw survey data as we have been sending this as well now.

Let me know if you have any questions.

Regards,
Stephen

Stephen McLandrich PE GE

Senior Geotechnical Engineer

Arup
560 Mission Street Suite 700 San Francisco CA 94105 USA
t +1 415 957 9445 d +1 415 946 0245
f +1 415 957 9096 e +1 415 310 1095
www.arup.com

Arup named ENR California's
DESIGN FIRM OF THE YEAR 2013

Check out our progress at <http://transbaycenter.org/construction-updates/construction-cameras>

NOTE: This e-mail communication and any attachments hereto are covered by the Electronic Communications Privacy Act, 18 U.S.C. Sections 2510-2521, and are legally privileged. The information contained herein is confidential, and is intended only for the use of the individual or entity to whom it is addressed. If you are not the intended recipient of this e-mail communication (or an employee or agent responsible for delivering this communication to its intended recipient(s)), you are hereby notified that any retention, copying or further distribution of this e-mail communication and any attachments is strictly prohibited. If you are not the intended recipient, please notify the sender by telephoning 415-597-4620, or by forwarding an e-mail reply message addressed to TransAdmin@TransbayCenter.org confirming that you have already destroyed (deleted) the original e-mail communication and any and all copies thereof. Thank you.

Memorandum


ARUP

To	Brian Dykes (TJPA)	Date
		May 7, 2014
Copies	Randy Volenec (PCPA) George Metzger (AAI)	Reference number 132242
From	Stephen McLandrich (Arup)	File reference 4-05 236
Subject	Transbay Transit Center: Results of April 2014 Settlement Survey at 301 Mission Property	Page 1 of 1

Under Arup's Geotechnical Contract with the Transbay Joint Powers Authority through Pelli Clark Pelli Architects, Arup is required to monitor the settlements of the buildings adjacent to the Transbay Transit Center prior to and during construction. We began the monitoring program for the 301 Mission property in April of 2009. This memorandum and the attached plates present an update to our memorandum dated February 28, 2014 with measurements made through April 2014.

List of Plates

- Plate 1 Floor Elevations at Level B-1 of 301 Mission Property: Periodic Survey – April 11, 2014
- Plate 2 Differential Floor Elevation (Inches) April 11, 2014 Survey
- Plate 3 Contours of Settlements Measured at the 1st Level Basement of the 301 Mission St. Structure Between 04/30/2009 & 4/11/2014
- Plate 4 Settlement Over Time Floor Elevations at Level B-1 of 301 Mission Property – Tower: April 30, 2009 through April 11, 2014
- Plate 5 Settlement Over Time Floor Elevations at Level B-1 of 301 Mission Property – Mid-Rise: April 30, 2009 through April 11, 2014
- Plate 6 Settlements of the 301 Mission Tower Including Monitoring During Construction
- Plate 7 Floor Elevation at Basement Level B-5 of 301 Mission Property: April 11, 2014 Survey
- Plate 8 Differential Floor Elevations (Inches) at Basement Level B-5: April 11, 2014 Survey

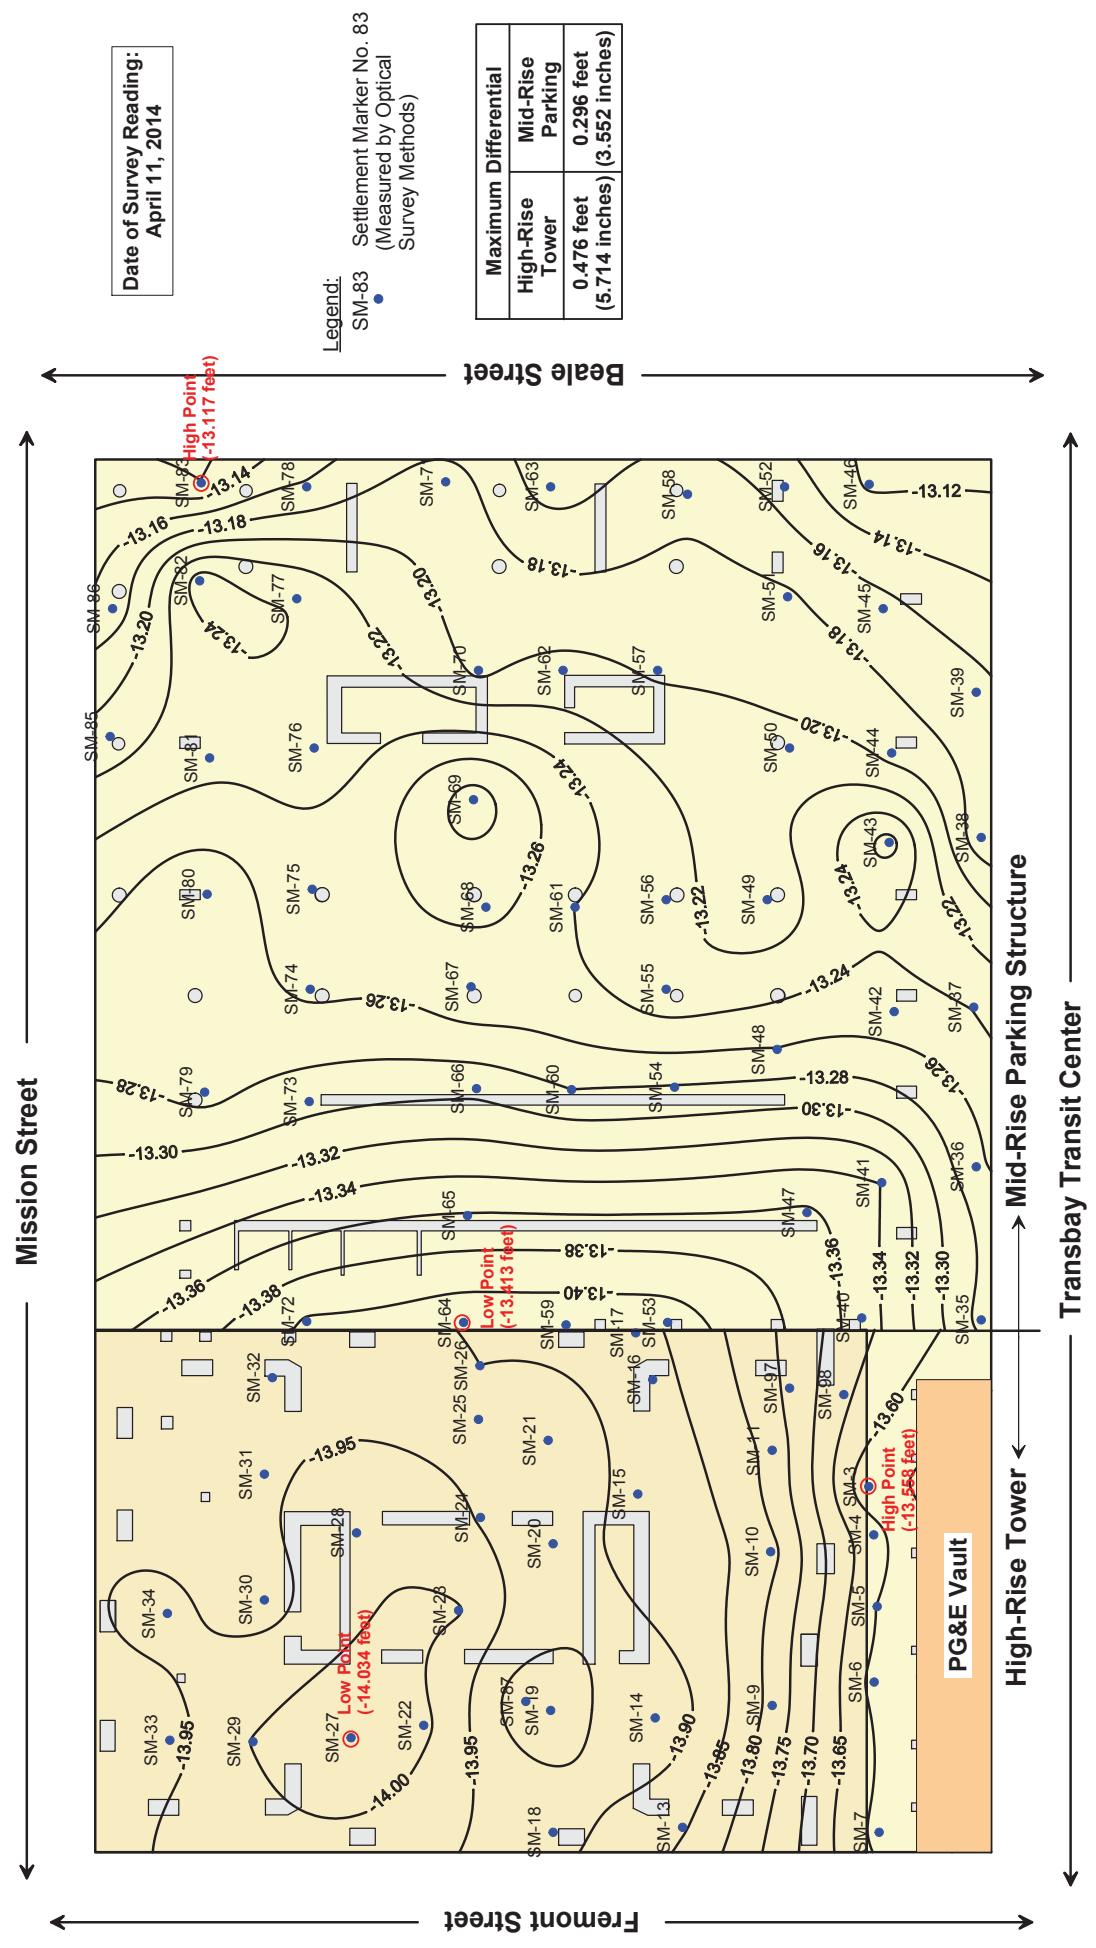

**FLOOR ELEVATIONS AT LEVEL B-1
OF 301 MISSION PROPERTY:
PERIODIC SURVEY - APRIL 11, 2014**

Transbay Transit Center
301 Mission Monitoring
Transbay Joint Powers Authority
San Francisco, California

May 2014


ARUP


Notes:
Contours represent elevation, in feet (CCSF Datum), from survey readings taken on April 11, 2014.
Level B-1 at Mid-Rise Parking portion of survey site is approximately 4 inches higher than Level B-1 at High-Rise Tower portion.
The PG&E vault is inaccessible for monitoring.

USF113224 Internal Project Data\45 Reports & Narratives\236 301 Mission - April 2014 Survey\Plates\Elevations All (2014.04.11).srf

Approximate Scale: 1" = 25'



0 25 50 75

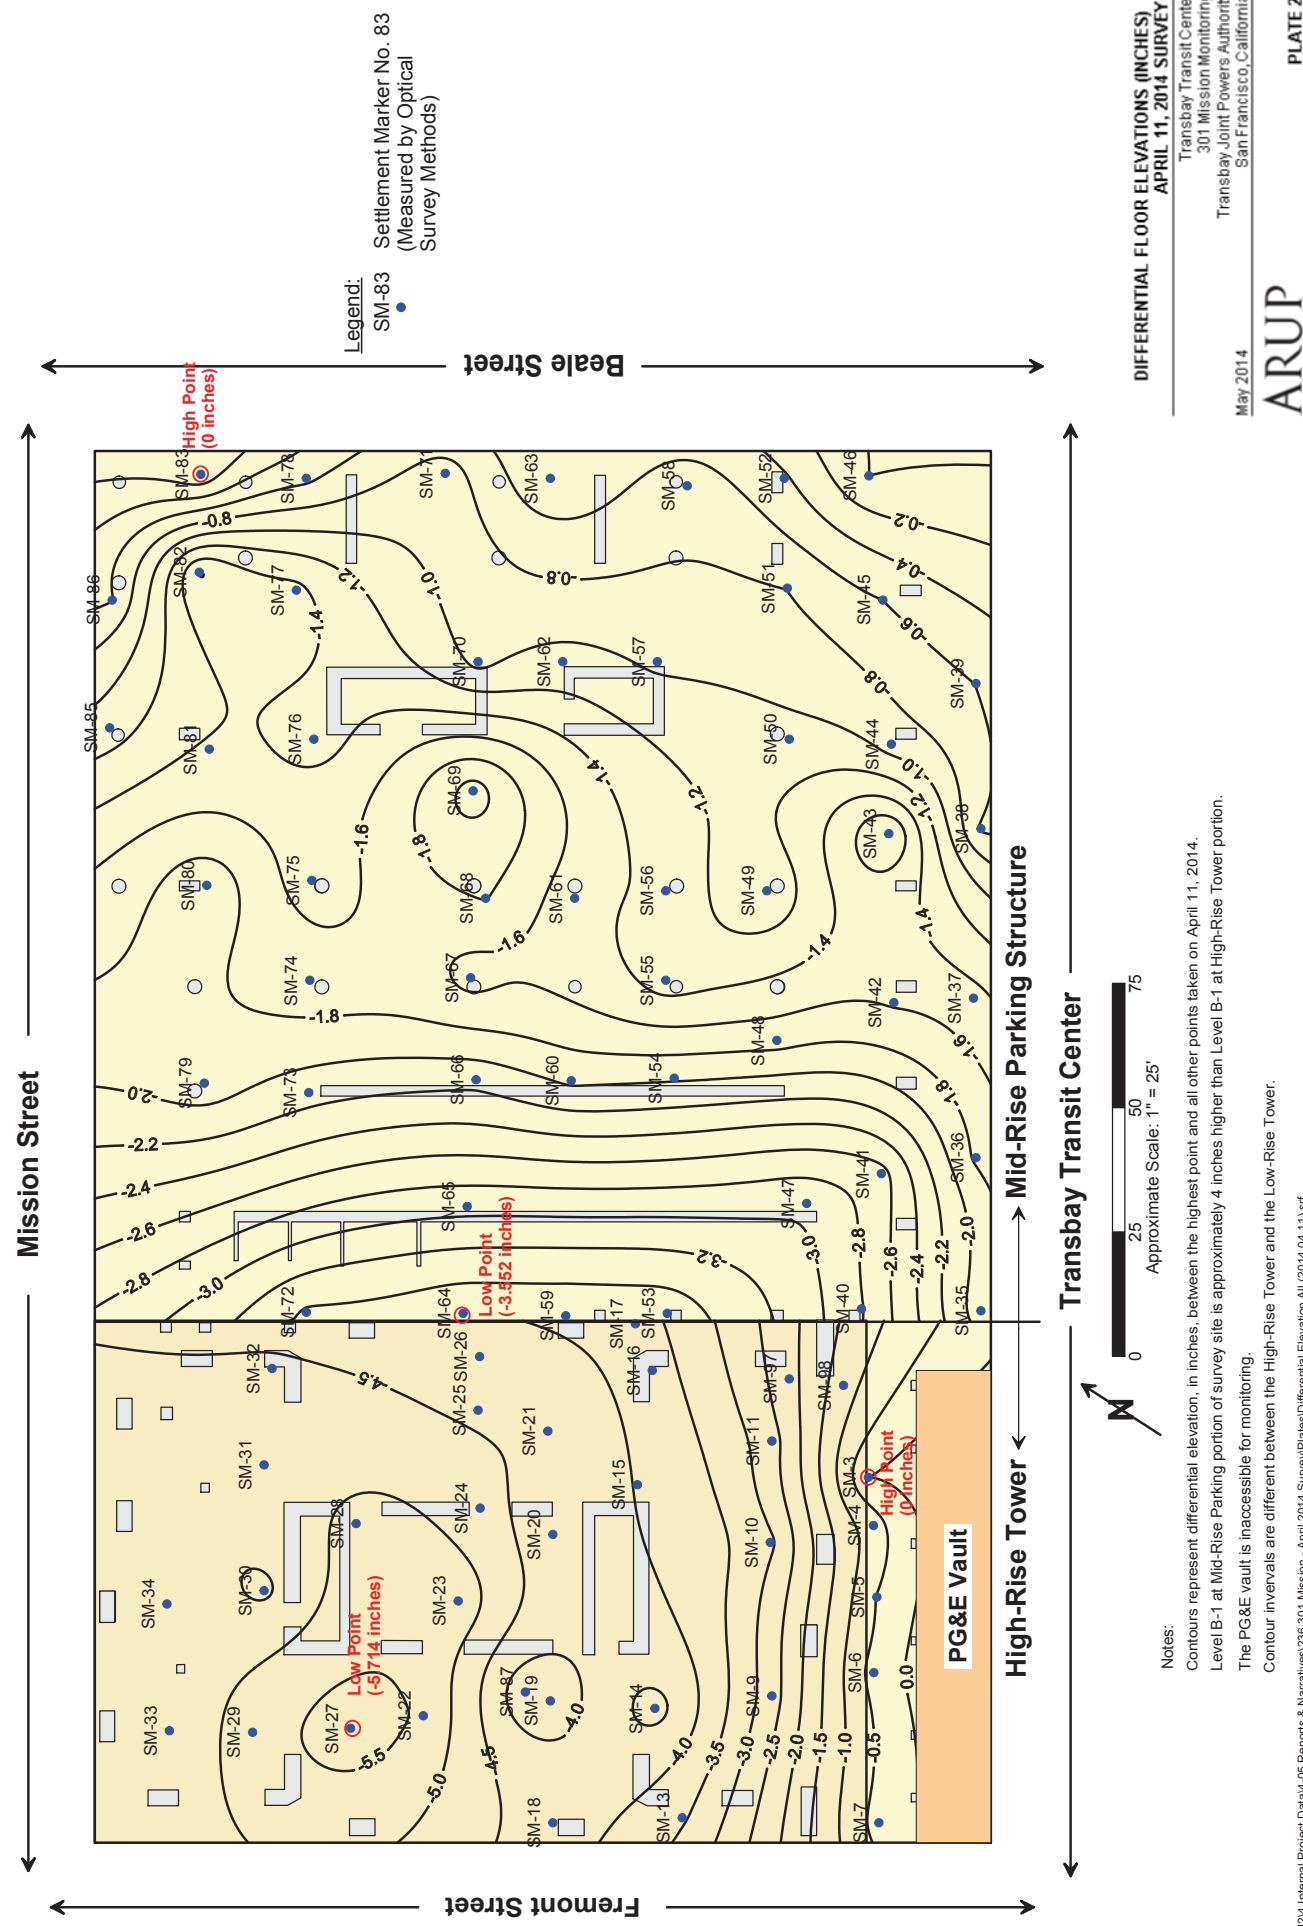

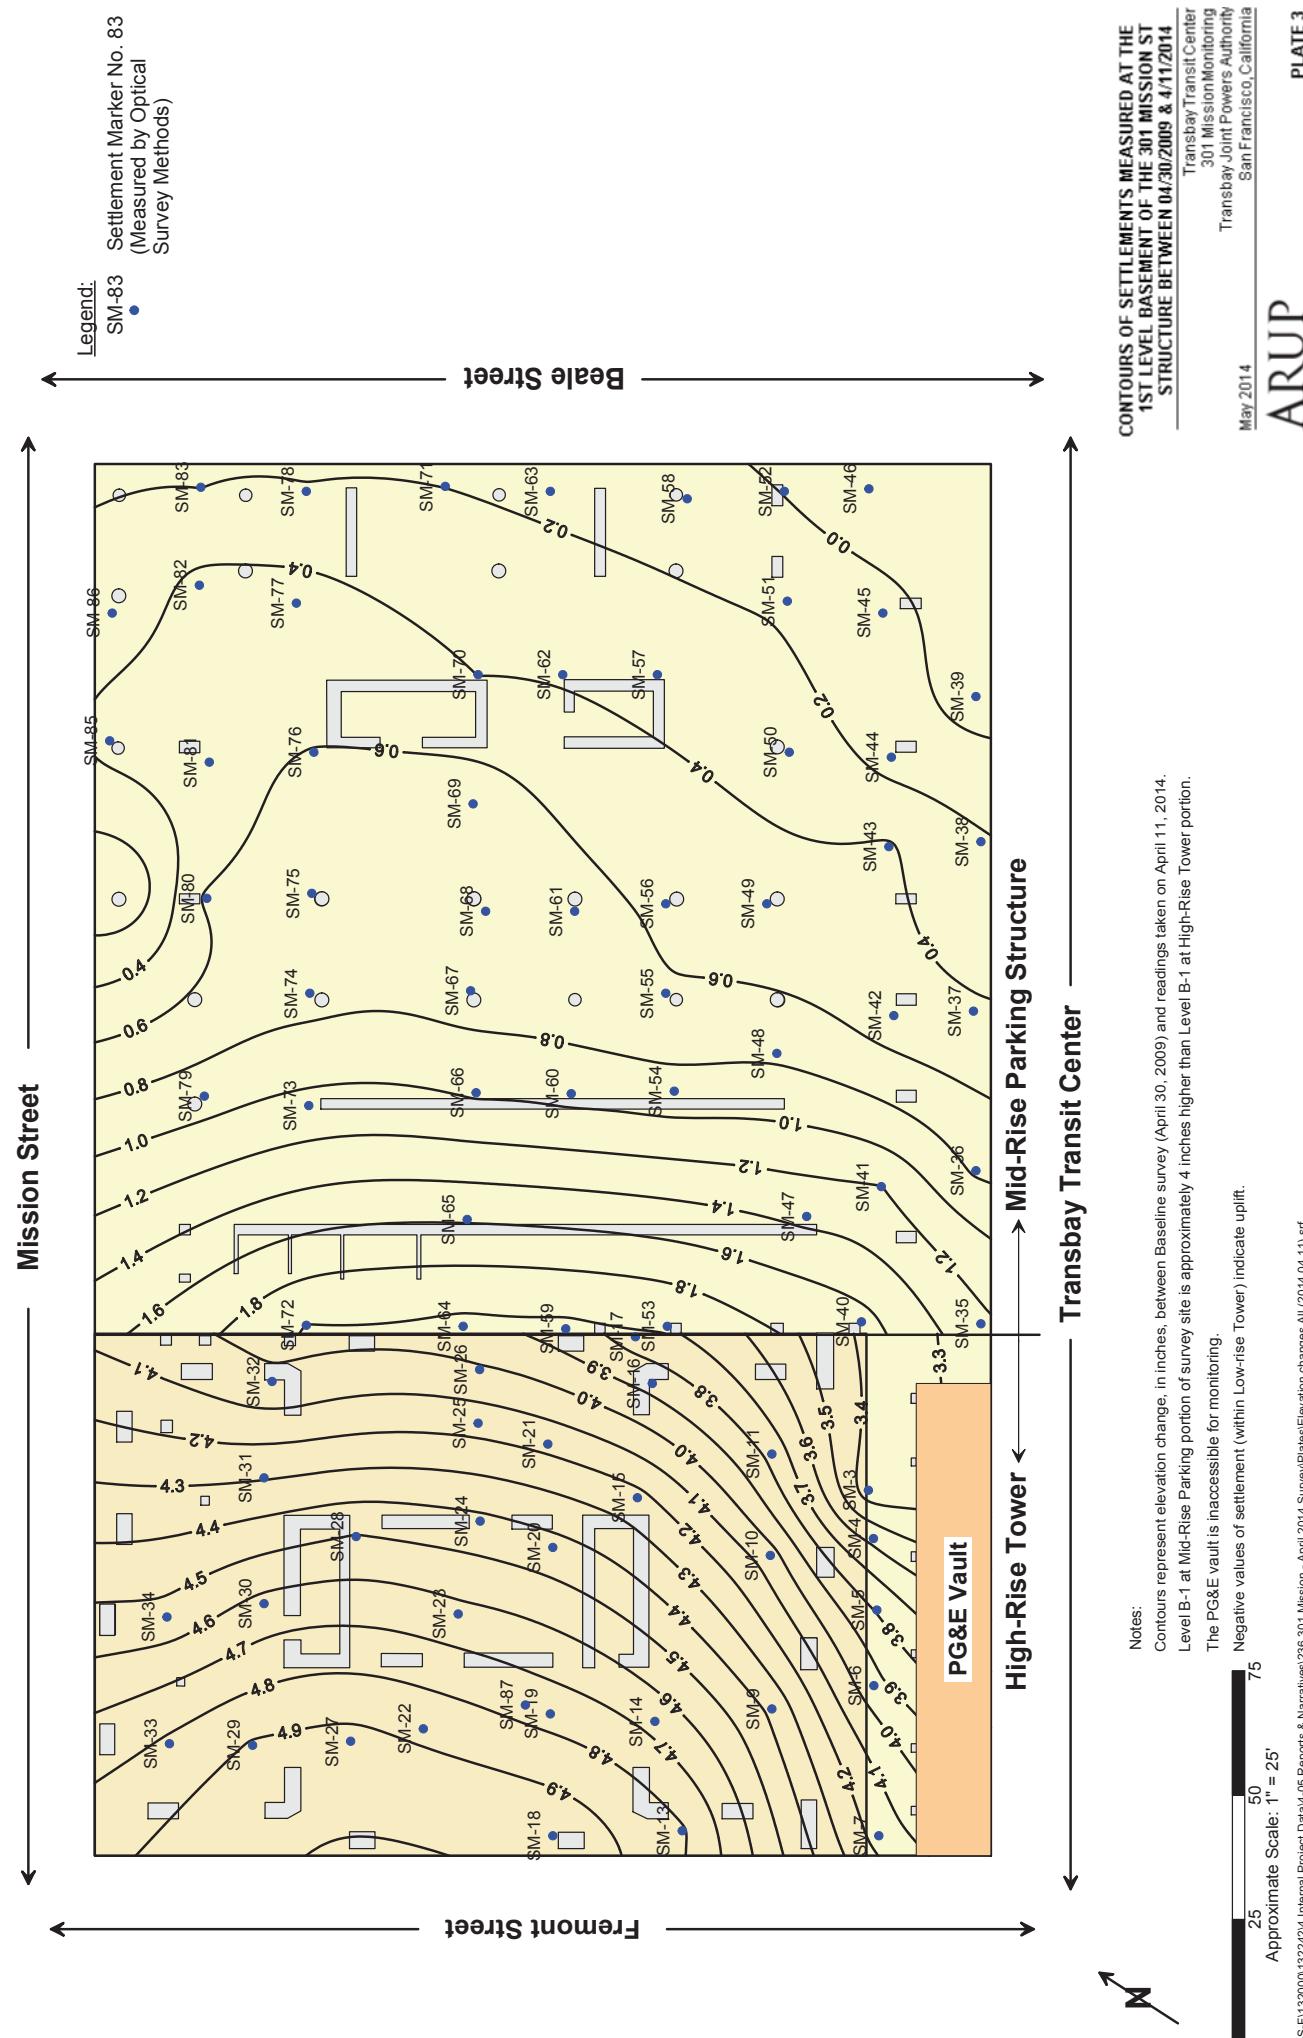

Note:
Initial (Baseline) reading
taken on 04/30/09

\global\arup{com}\arup{americas}\obs\SF132000132244 Internal Project Data\4-05 Reports & Narratives\236 301 Mission - April 2014 Survey\Plates\Plate 4 Settlement Over Time - Tower.grf

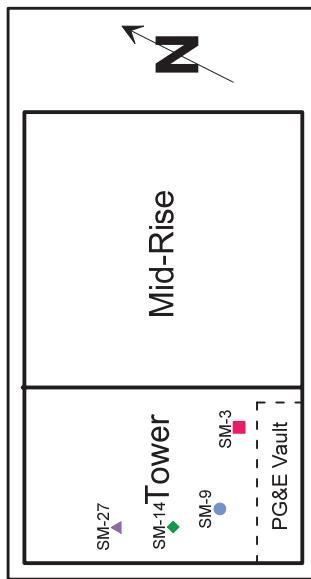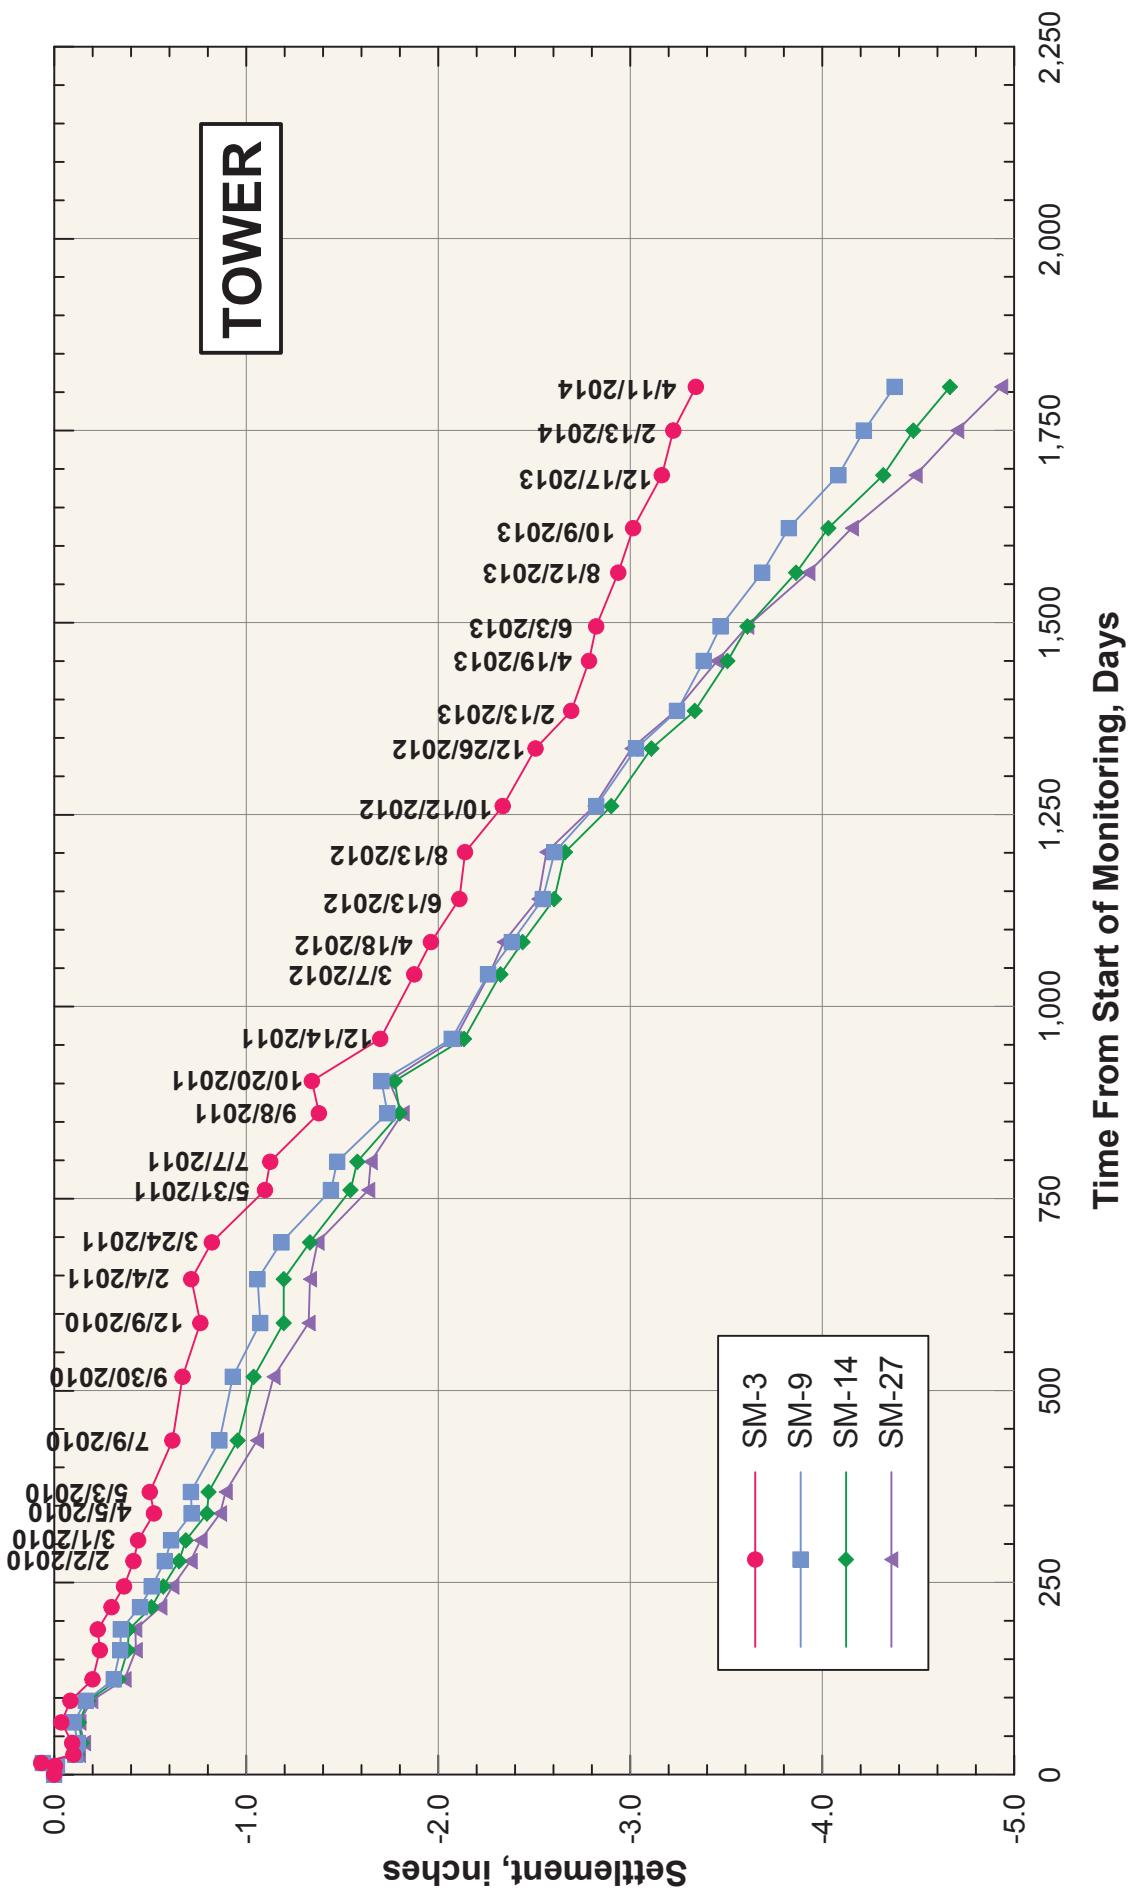



ARUP

\global\arup{com}\arup{americas}\obs\132000\132244 Internal Project Data\404 Reports & Narratives\236 301 Mission - April 2014 Survey\Plates\Plate 5 Settlement Over Time - Midrise.grf

Note:
Initial (Baseline) reading
taken on 04/30/09

**SETTLEMENT OVER TIME
FLOOR ELEVATIONS AT LEVEL B-1
OF 301 MISSION PROPERTY - MID-RISE:
APRIL 30, 2009 THROUGH APRIL 11, 2014**

Transbay Transit Center
301 Mission Monitoring
Transbay Joint Powers Authority
San Francisco, California

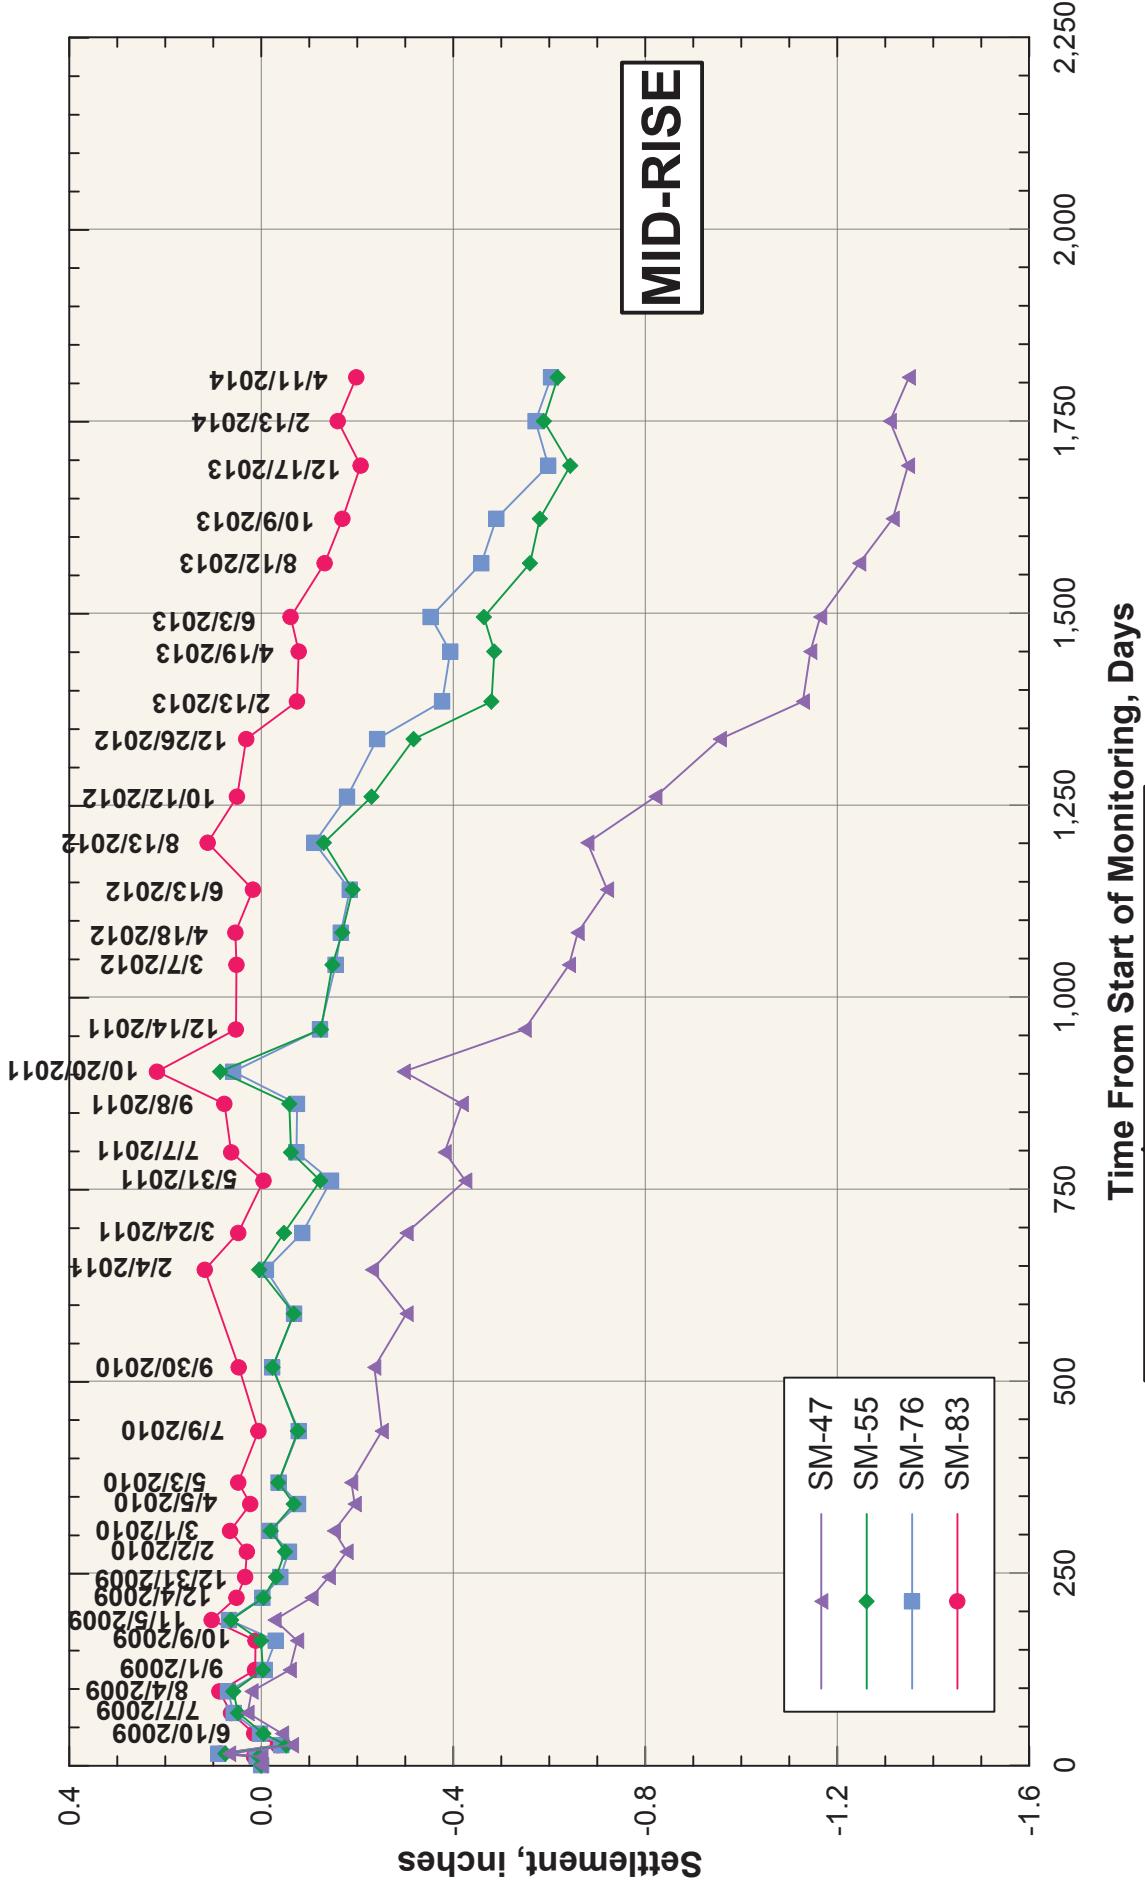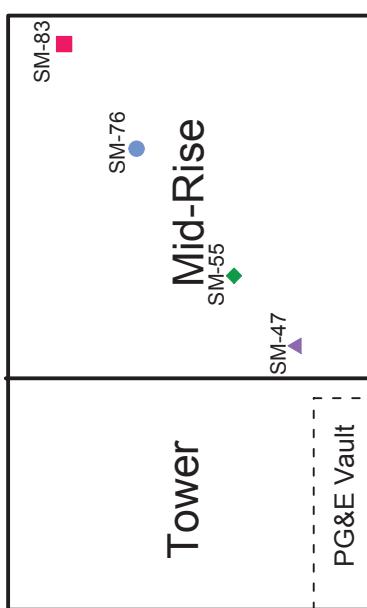


ARUP


**SETTLEMENTS OF THE 301 MISSION TOWER
INCLUDING MONITORING DURING CONSTRUCTION**


Transbay Transit Center
301 Mission Monitoring
Transbay Joint Powers Authority
San Francisco, California

May 2014

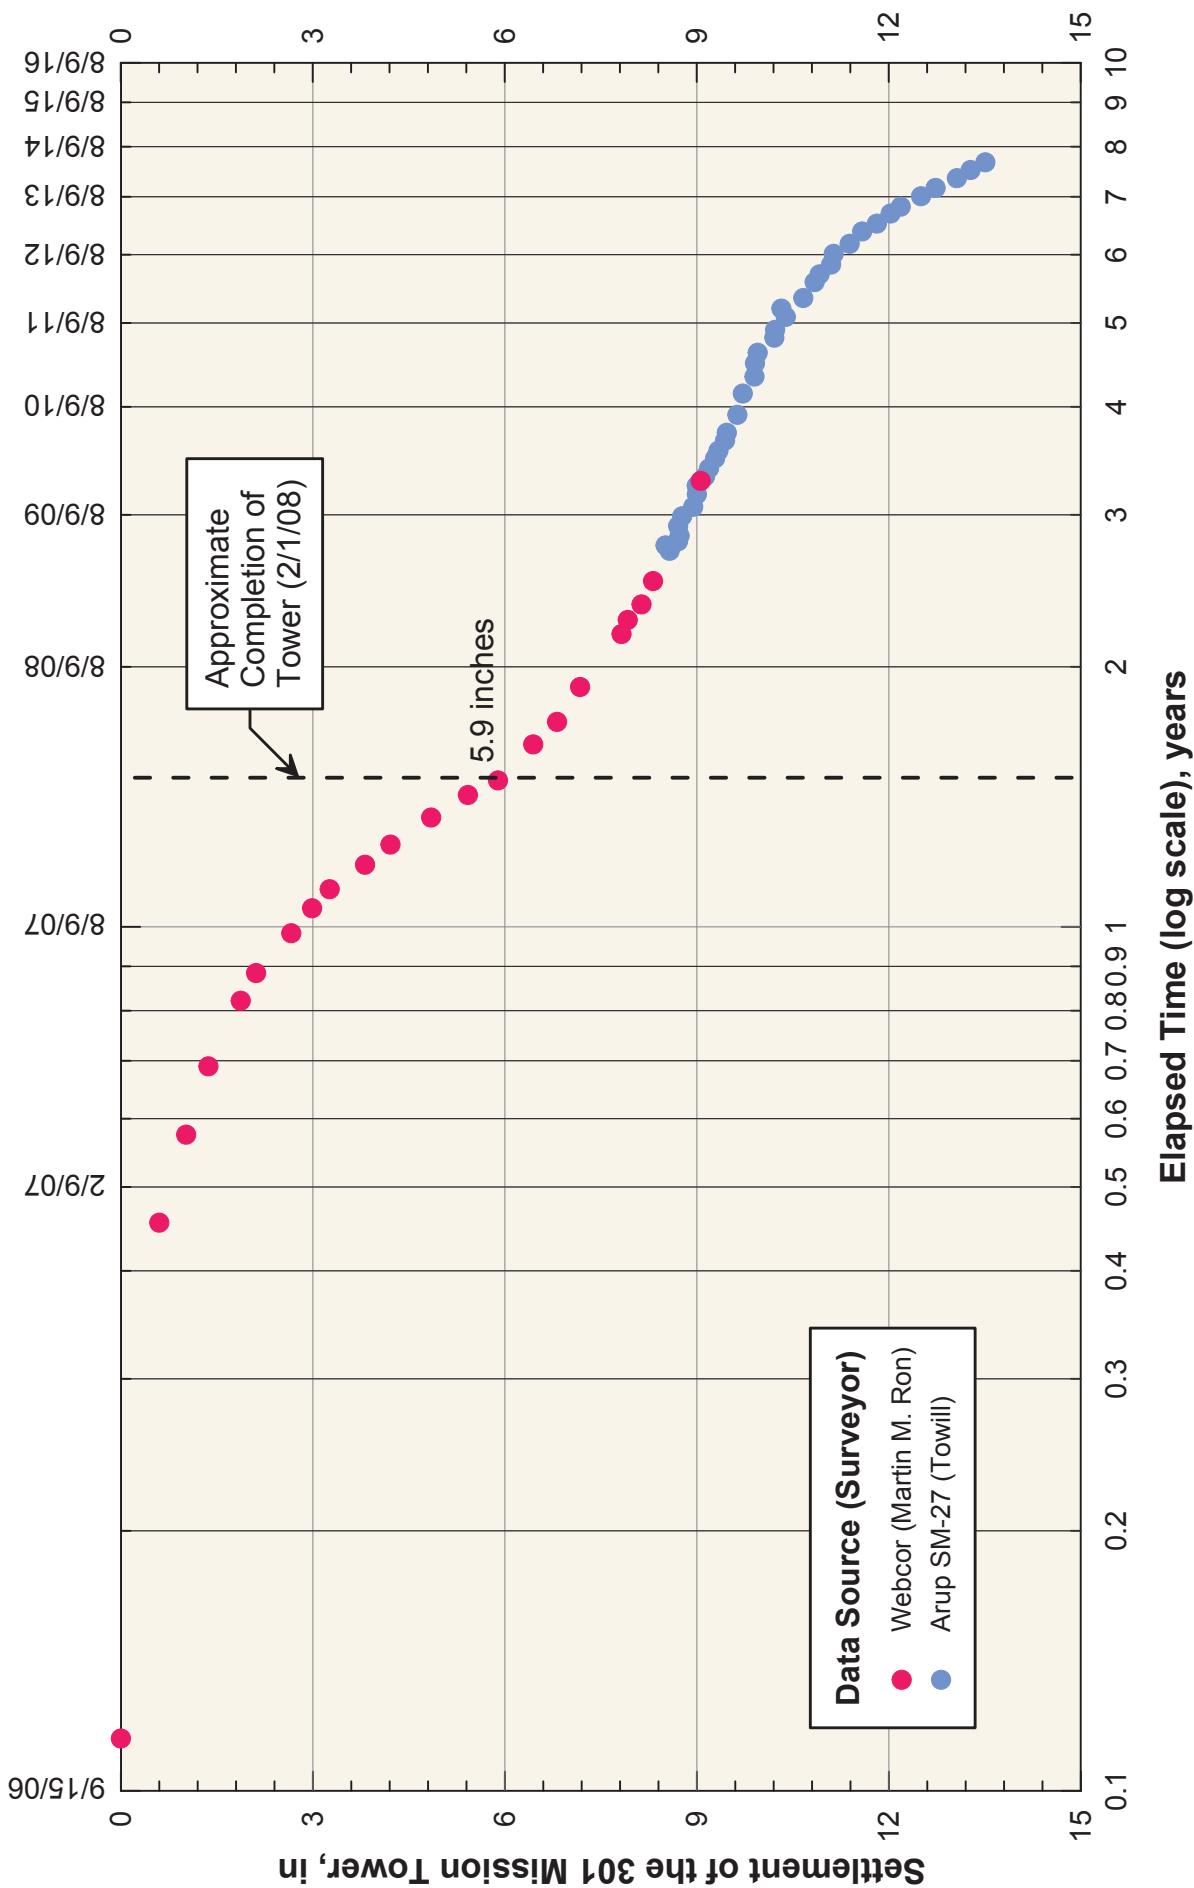

Beginning of Tower Construction: 8/9/06
End of Tower Construction: 2/1/08
Construction Duration: 542 days (1.5 years)

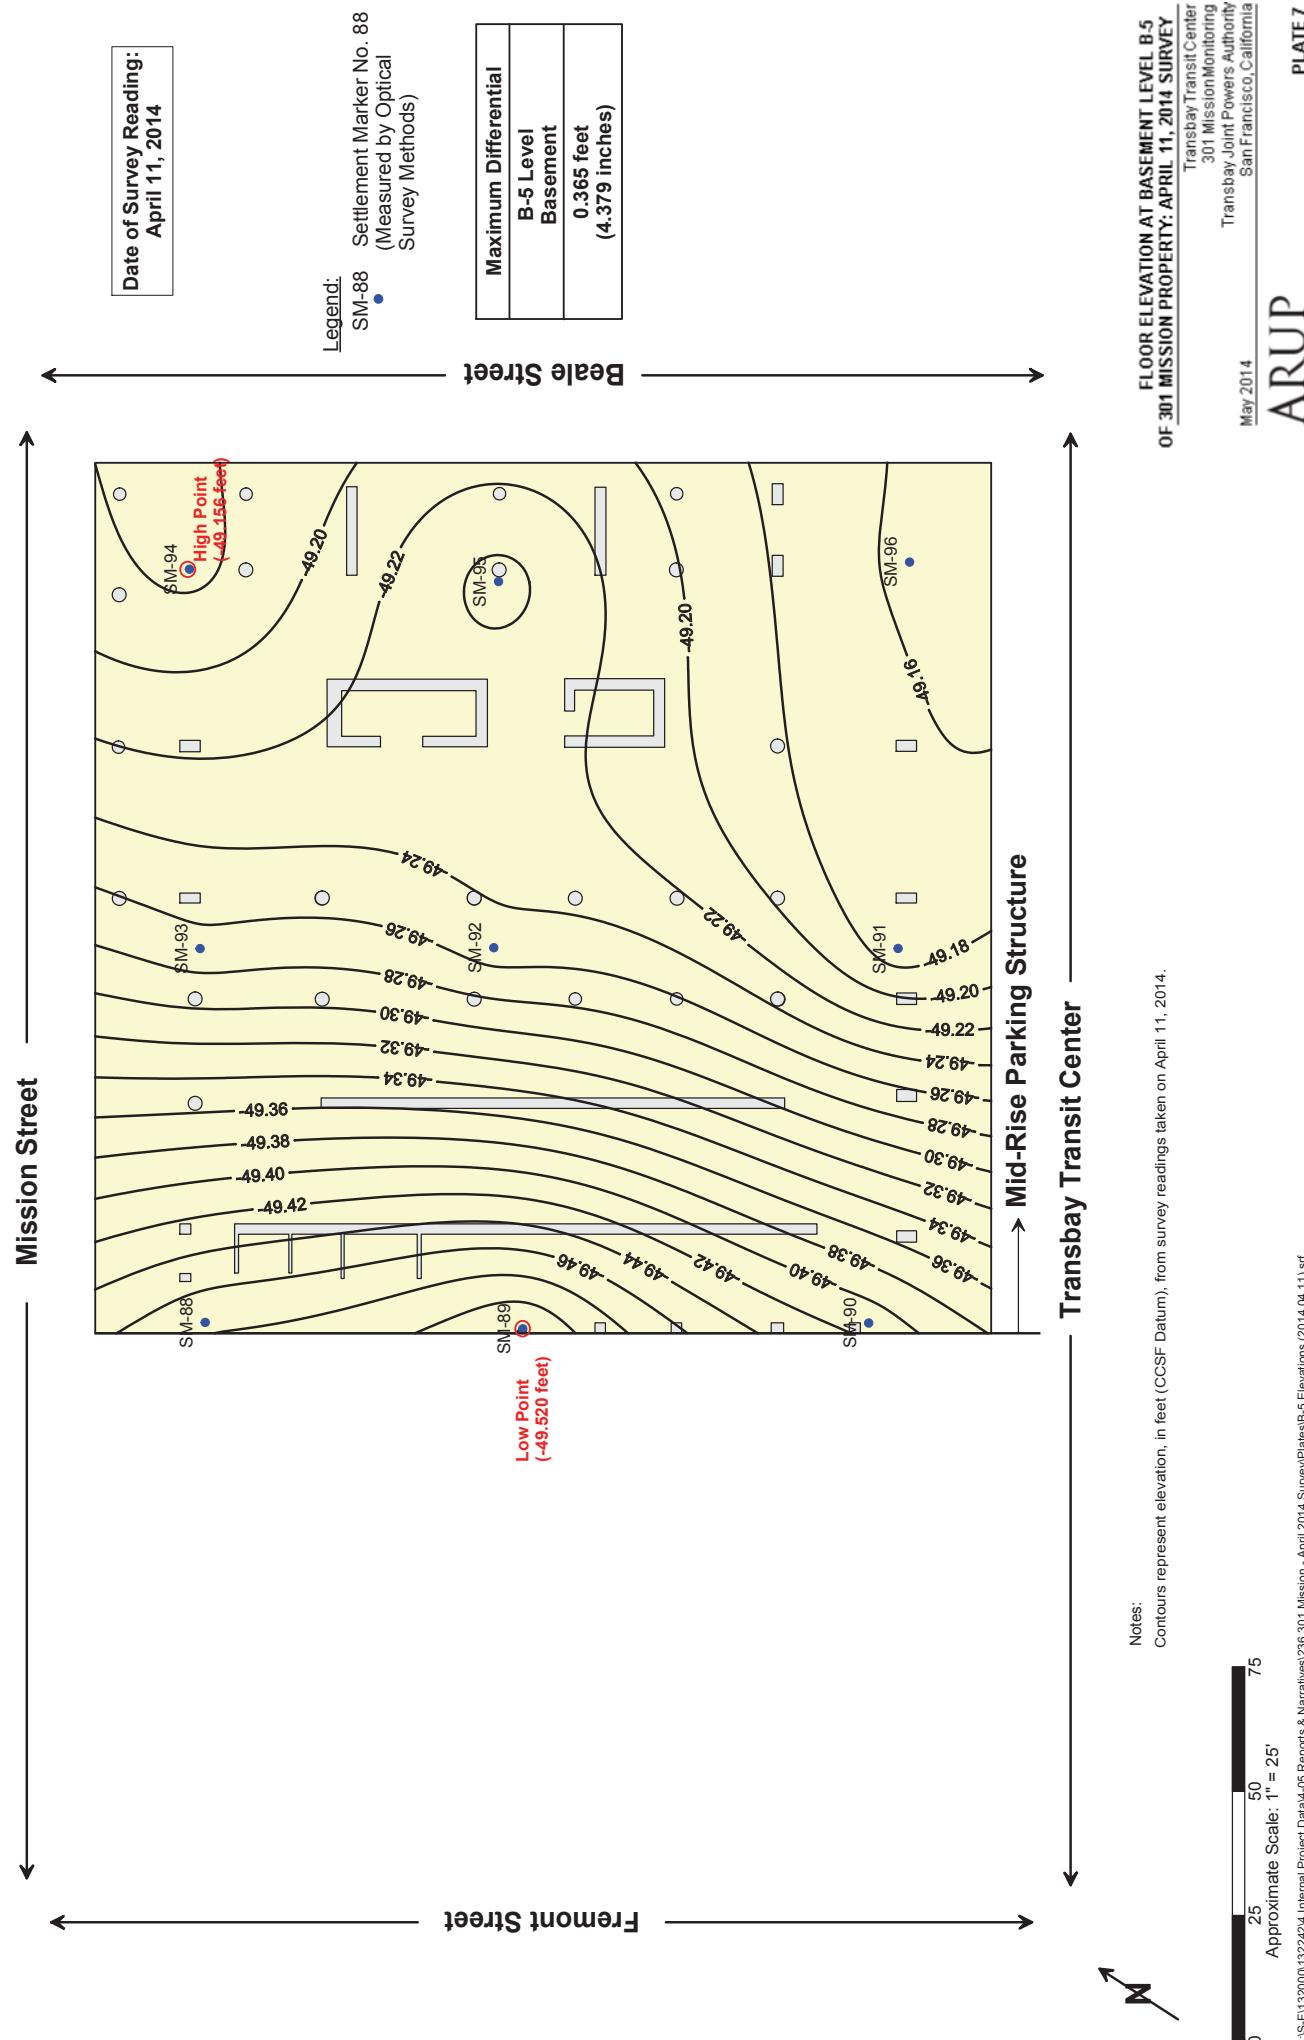

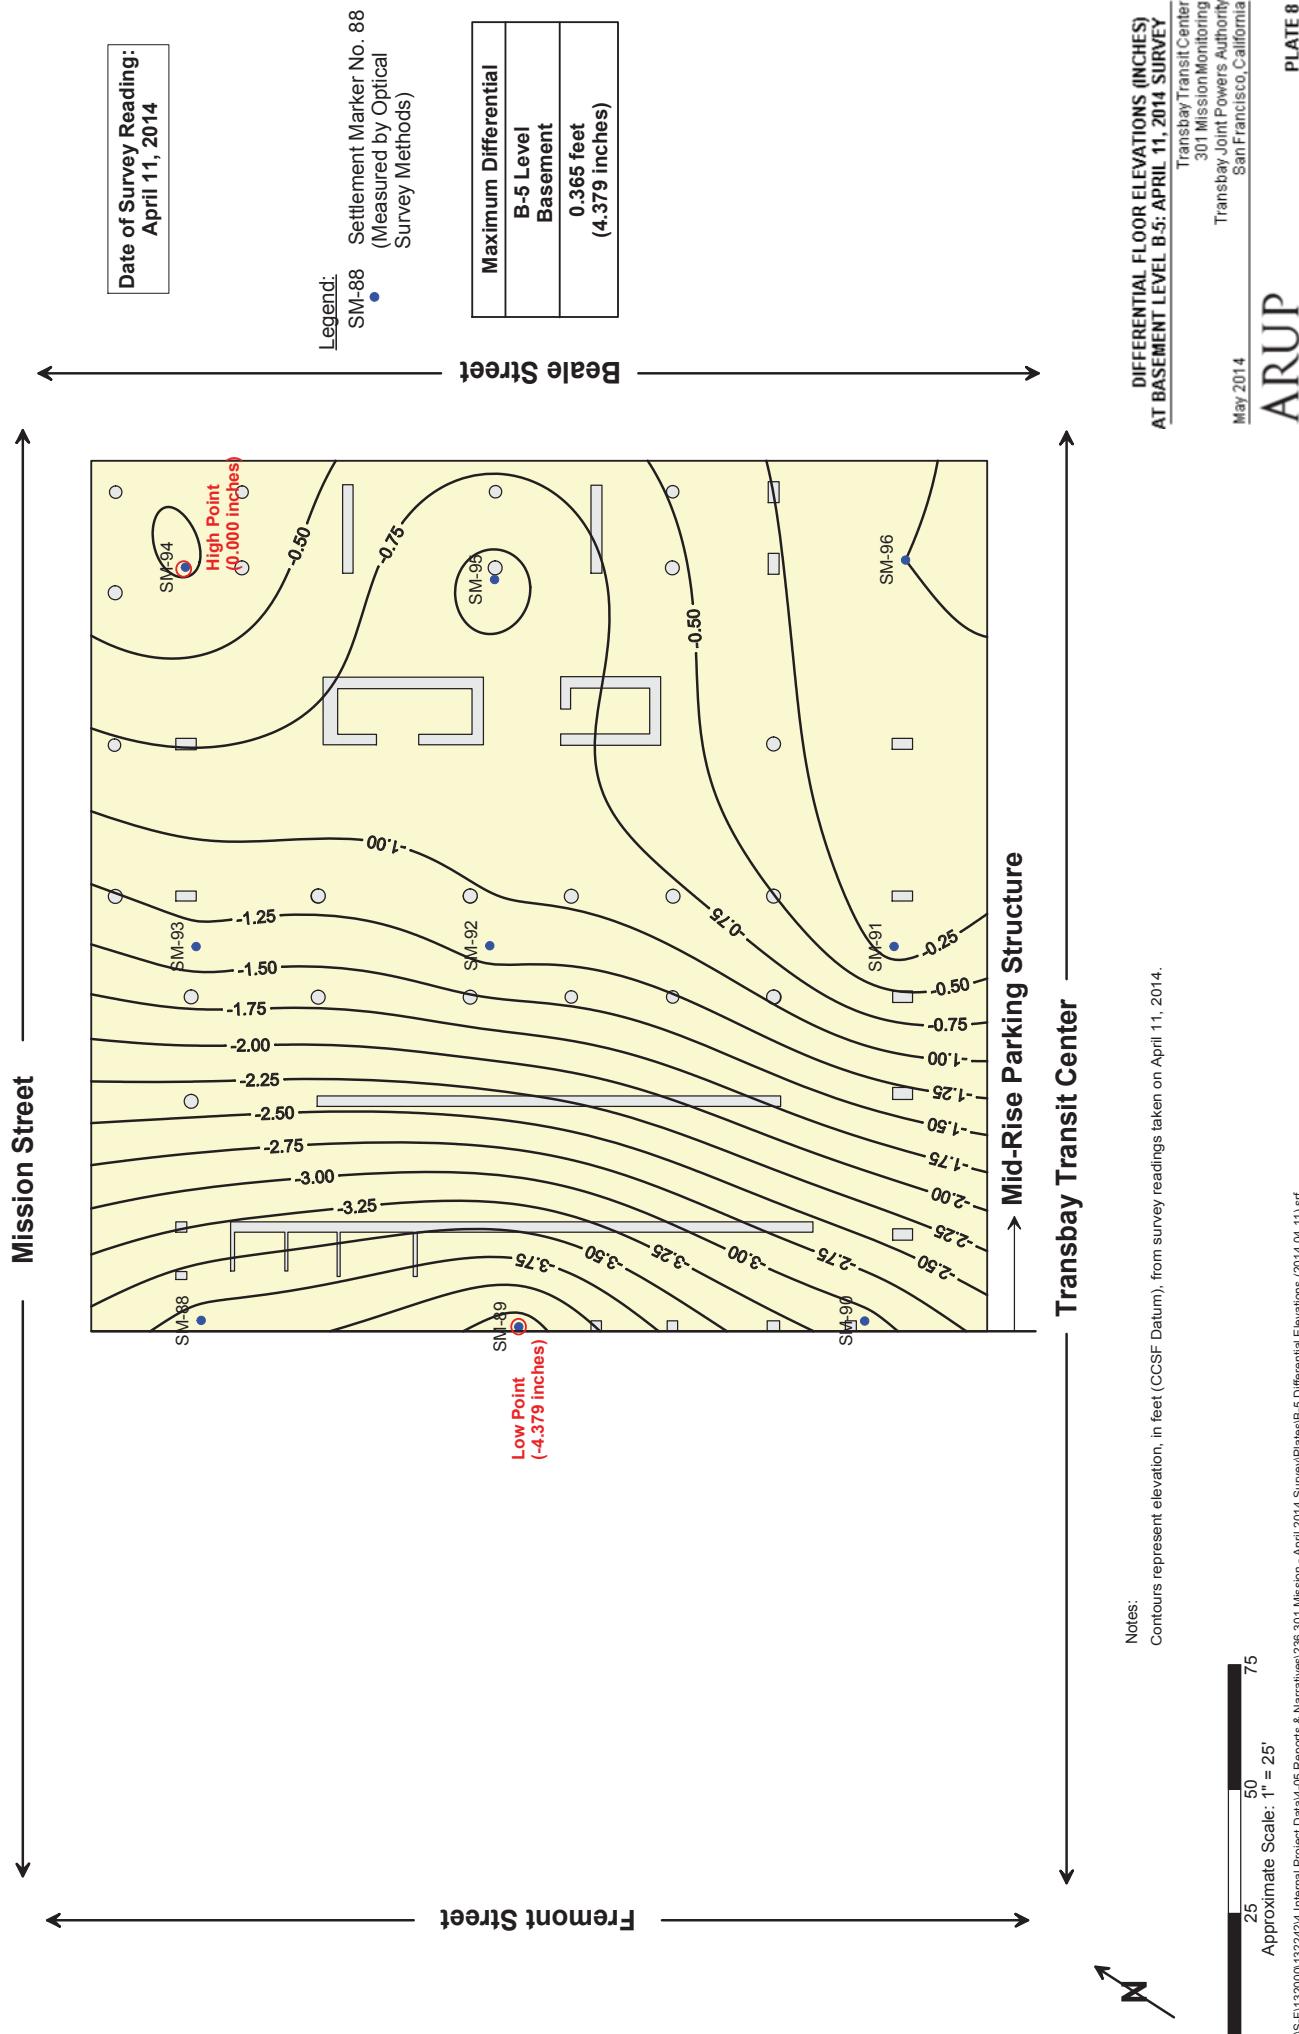

From: Brian Dykes
Sent: Friday, August 22, 2014 3:13 PM
To: Steven Hood
Subject: FW: TTC - 301 Mission June Survey

Steve,

This email and the attached settlement records were sent to me the day after I disconnected the email forwarding to my cell phone and left for a long vacation in France and England. I returned this week and have worked backwards through more than 800 emails. So I am now forwarding these results to you.

I am sorry for the delay as it does not appear that anyone else on the copy list forwarded the readings to you.

Regards, Brian.

From: Stephen McLandrich [<mailto:stephen.mclandrich@arup.com>]
Sent: Thursday, July 24, 2014 10:39 AM
To: Brian Dykes
Cc: Dennis Turchon; Andrew W. Schwartz (schwartz@smwlaw.com); schexnayder@smwlaw.com; 'rvolenec@pcparch.com' (rvolenec@pcparch.com); George Metzger; Nick O'Riordan; Jeff Dunn
Subject: TTC - 301 Mission June Survey

Brian,

Please find the attached 301 Mission settlement memo for the June survey. We completed it last month however I forgot to transmit it to you until this morning. Also, I attach the latest raw data file from the surveyor.

Let me know if you have any questions.

Regards,
Stephen

Stephen McLandrich PE GE
Senior Geotechnical Engineer

Arup
560 Mission Street Suite 700 San Francisco CA 94105 USA
t +1 415 957 9445 d +1 415 946 0245
f +1 415 957 9096 c +1 415 310 1095
www.arup.com

Check out our progress at <http://transbaycenter.org/construction-updates/construction-cameras>

NOTE: This e-mail communication and any attachments hereto are covered by the Electronic Communications Privacy Act, 18 U.S.C. Sections 2510-2521, and are legally privileged. The information contained herein is confidential, and is intended only for the use of the individual or entity to whom it is addressed. If you are not the intended recipient of this e-mail communication (or an employee or agent responsible for delivering this communication to its intended recipient(s)), you are hereby notified that any retention, copying or further distribution of this e-mail communication and any attachments is strictly prohibited. If you are not the intended recipient, please notify the sender by telephoning 415-597-4620, or by forwarding an e-mail reply message addressed to TransAdmin@TransbayCenter.org confirming that you have already destroyed (deleted) the original e-mail communication and any and all copies thereof. Thank you.

Memorandum


ARUP

To	Brian Dykes (TJPA)	Date
		June 27, 2014
Copies	Randy Volenec (PCPA) George Metzger (AAI)	Reference number 132242
From	Stephen McLandrich (Arup)	File reference 4-05 238
Subject	Transbay Transit Center: Results of June 2014 Settlement Survey at 301 Mission Property	Page 1 of 1

Under Arup's Geotechnical Contract with the Transbay Joint Powers Authority through Pelli Clark Pelli Architects, Arup is required to monitor the settlements of the buildings adjacent to the Transbay Transit Center prior to and during construction. We began the monitoring program for the 301 Mission property in April of 2009. This memorandum and the attached plates present an update to our memorandum dated May 7, 2014 with measurements made through June 2014.

List of Plates

- Plate 1 Floor Elevations at Level B-1 of 301 Mission Property: Periodic Survey – June 11, 2014
- Plate 2 Differential Floor Elevation (Inches) June 11, 2014 Survey
- Plate 3 Contours of Settlements Measured at the 1st Level Basement of the 301 Mission St. Structure Between 04/30/2009 & 6/11/2014
- Plate 4 Settlement Over Time Floor Elevations at Level B-1 of 301 Mission Property – Tower: April 30, 2009 through June 11, 2014
- Plate 5 Settlement Over Time Floor Elevations at Level B-1 of 301 Mission Property – Mid-Rise: April 30, 2009 through June 11, 2014
- Plate 6 Settlements of the 301 Mission Tower Including Monitoring During Construction
- Plate 7 Floor Elevation at Basement Level B-5 of 301 Mission Property: June 11, 2014 Survey
- Plate 8 Differential Floor Elevations (Inches) at Basement Level B-5: June 11, 2014 Survey

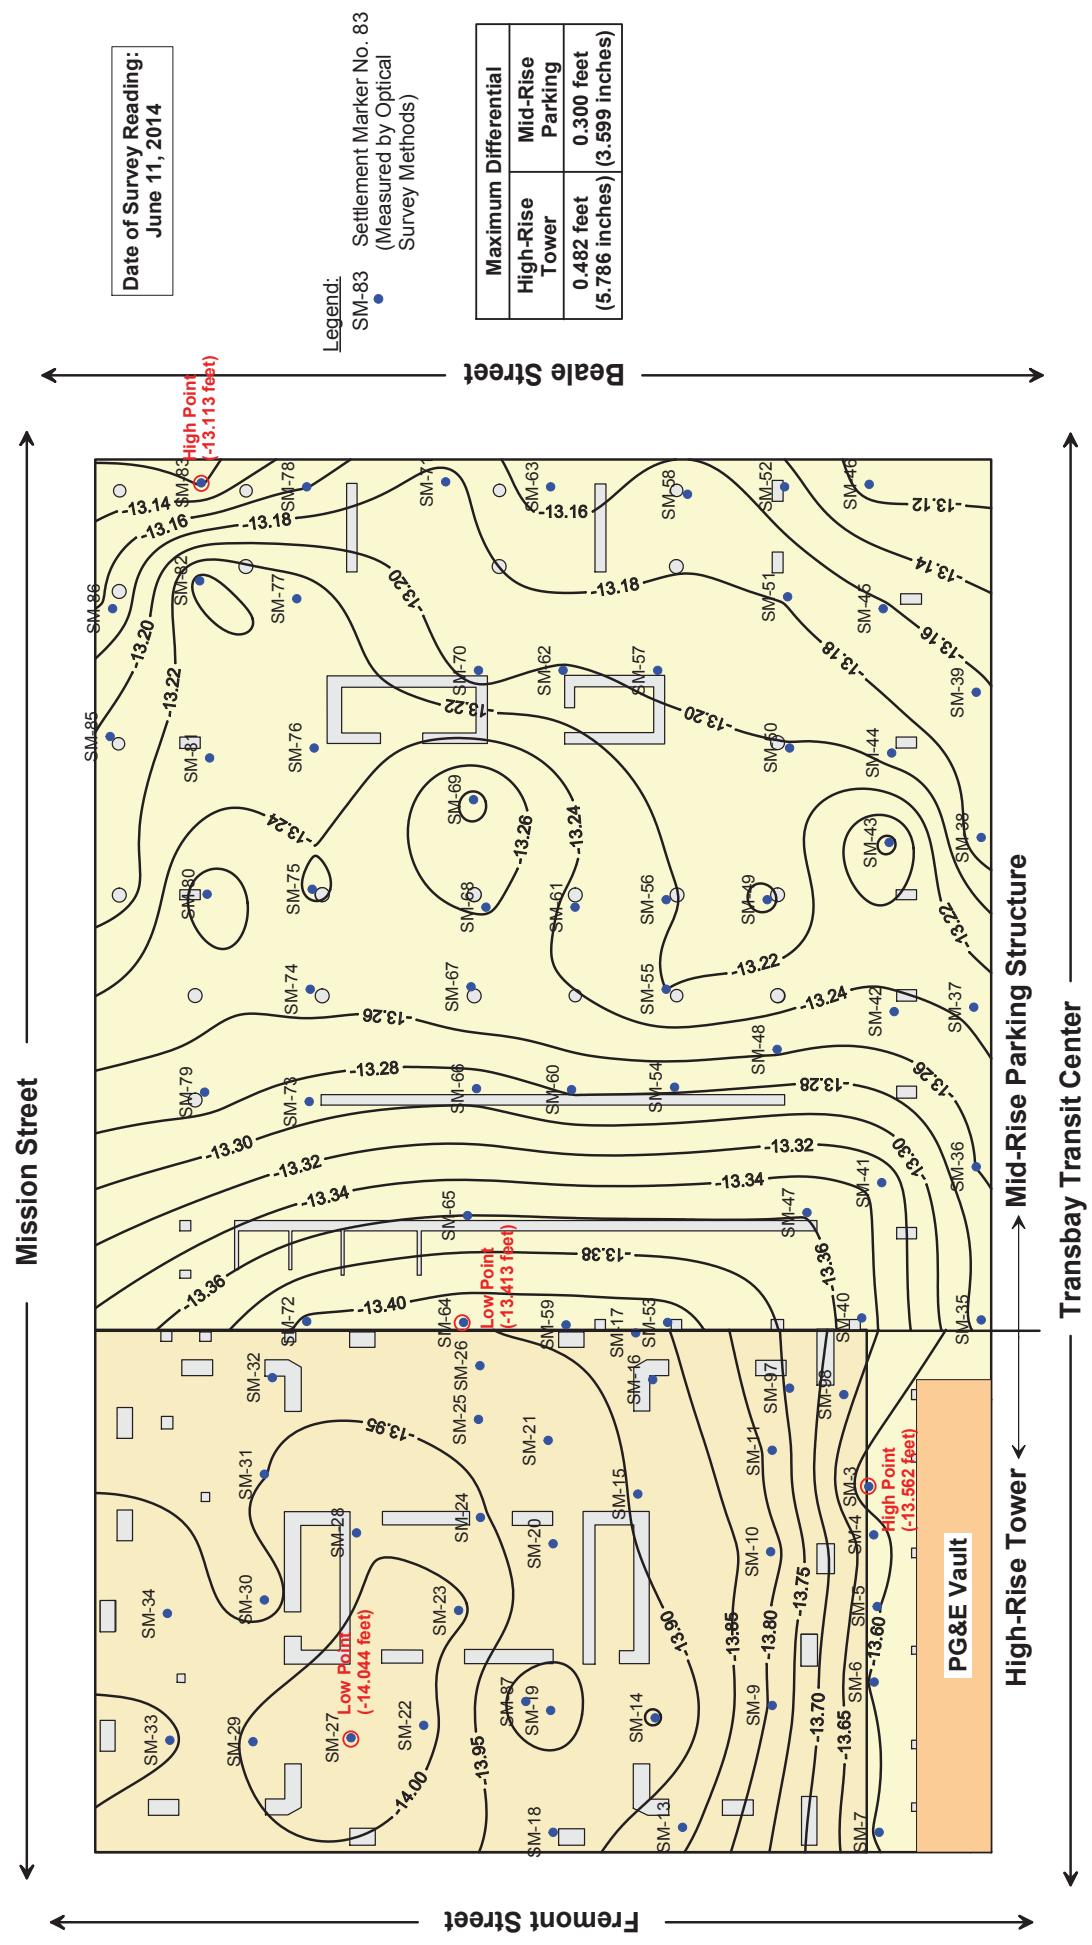

**FLOOR ELEVATIONS AT LEVEL B-1
OF 301 MISSION PROPERTY:
PERIODIC SURVEY - JUNE 11, 2014**

Transbay Transit Center
301 Mission Monitoring
Transbay Joint Powers Authority
San Francisco, California

June 2014


ARUP

PLATE 1

USFS13224 Internal Project Data\45 Reports & Narratives\238\301 Mission - June 2014 Survey\Ptates\Elevations All (20140611).srf

Approximate Scale: 1" = 25'

0 25 50 75

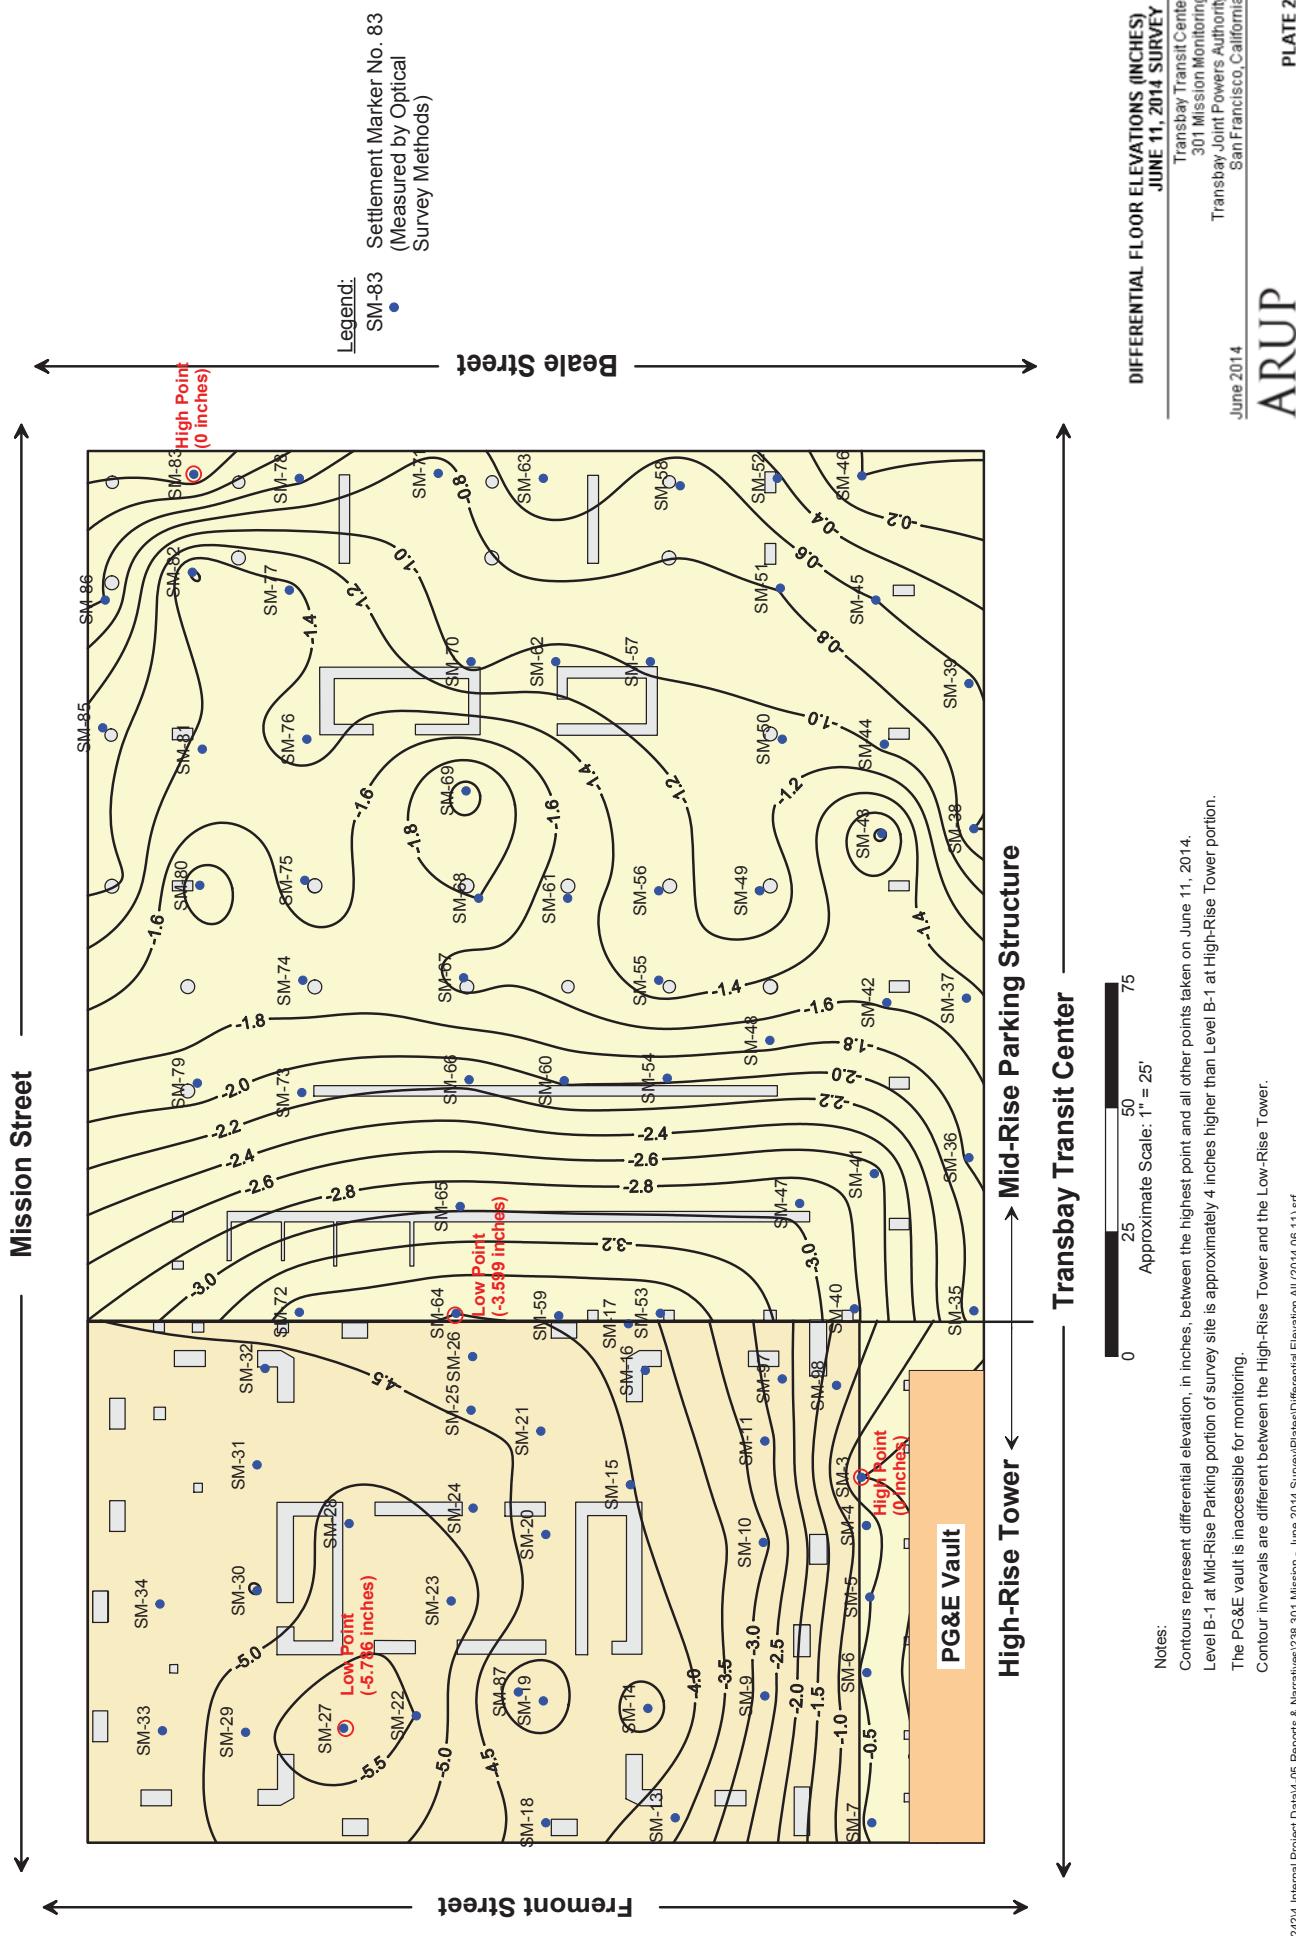


J:\S-F\132000\132242\4 Internal Project Data\4-05 Reports & Narratives\238 301 Mission - June 2014 Survey\Plates\Diffential Elevation All (2014.06.11).srf

ARUP

**CONTOURS OF SETTLEMENTS MEASURED AT THE
1ST LEVEL BASEMENT OF THE 301 MISSION ST
STRUCTURE BETWEEN 04/30/2009 & 6/11/2014**

Transbay Transit Center
301 Mission Monitoring
Transbay Joint Powers Authority
San Francisco, California

June 2014

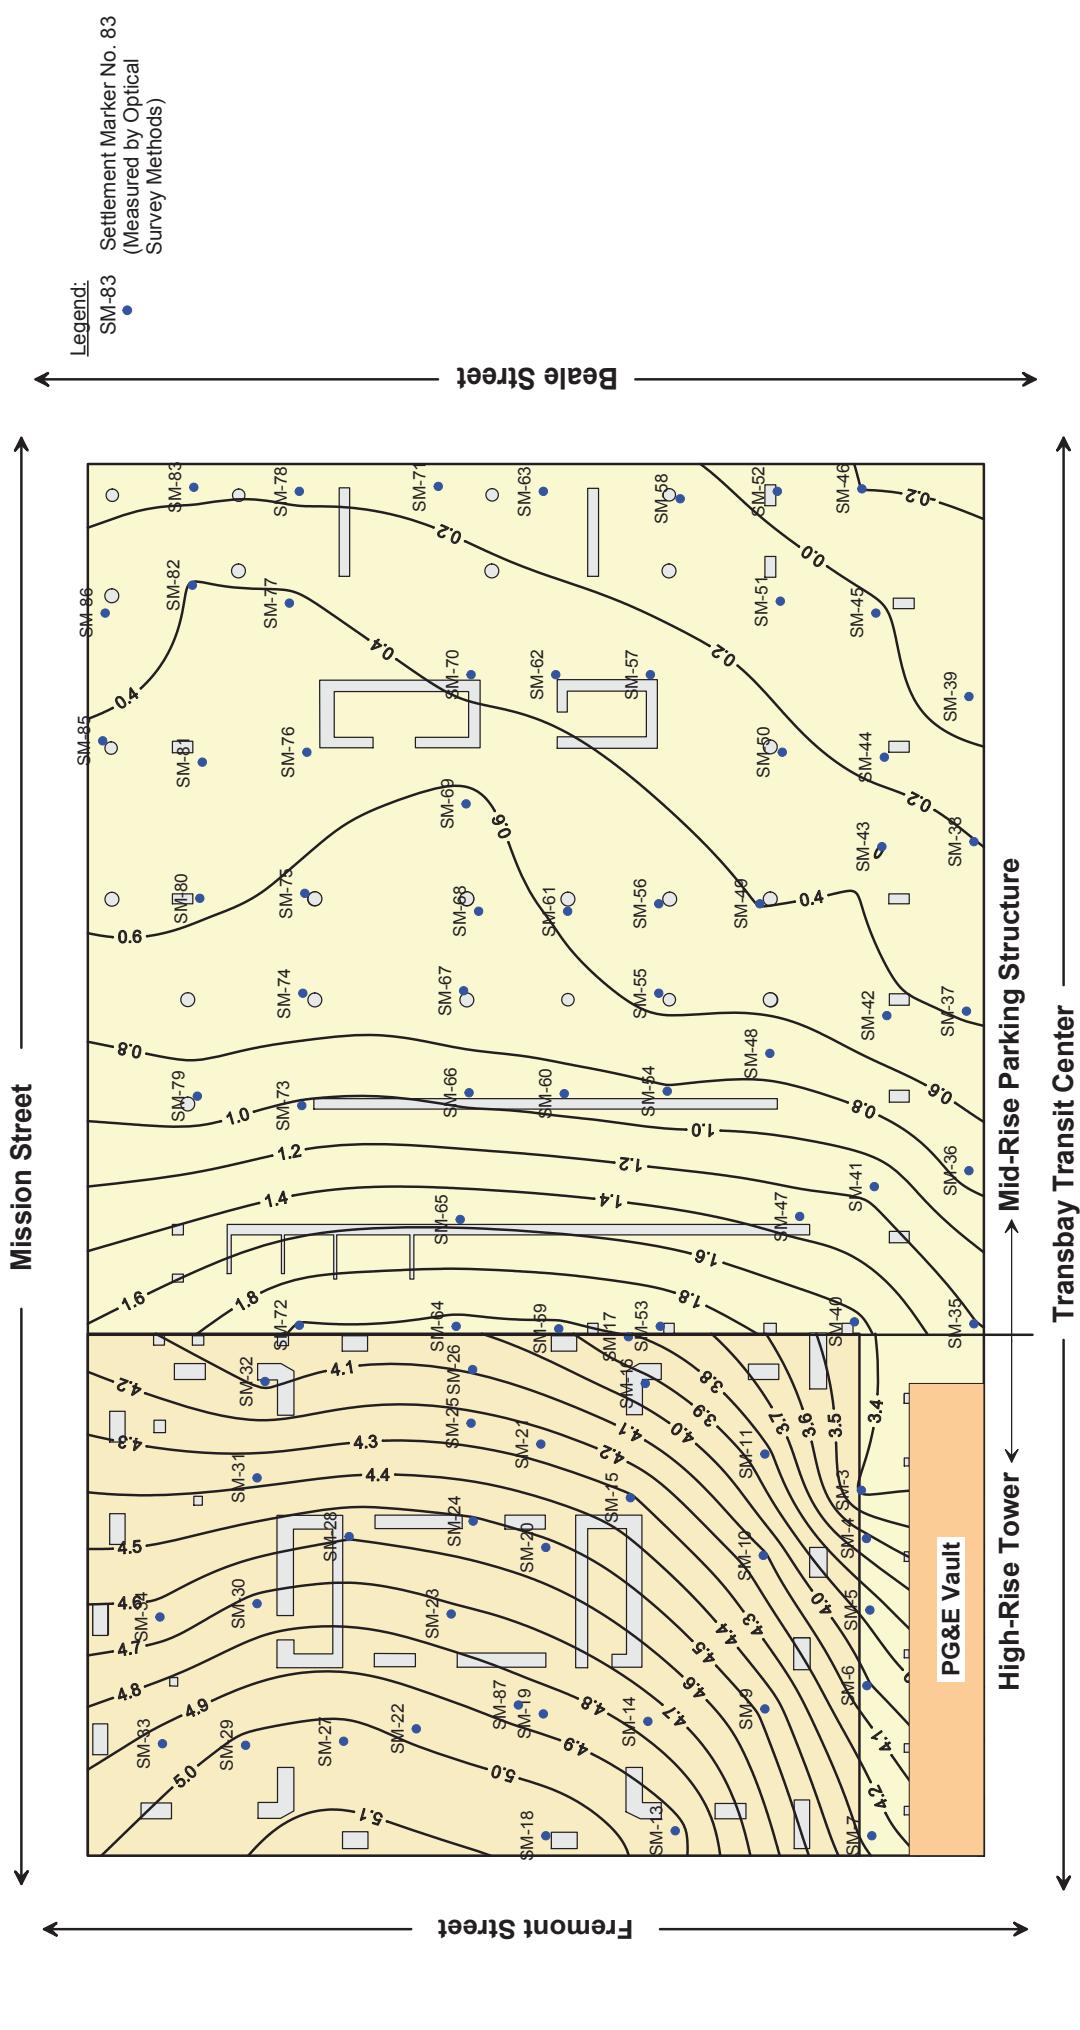


ARUP

Note:
Initial (Baseline) reading
taken on 04/30/09

USFS/FTI/32000/013224/24 Internal Project Data/4-05 Reports & Narratives/238-301 Mission - June 2014 Survey/Plates/Plate 4 Settlement Over Time - Tower.grf

**SETTLEMENT OVER TIME
FLOOR ELEVATIONS AT LEVEL B-1
OF 301 MISSION PROPERTY- TOWER:
APRIL 30, 2009 THROUGH JUNE 11, 2014**

Transbay Transit Center
301 Mission Monitoring
Transbay Joint Powers Authority
San Francisco, California

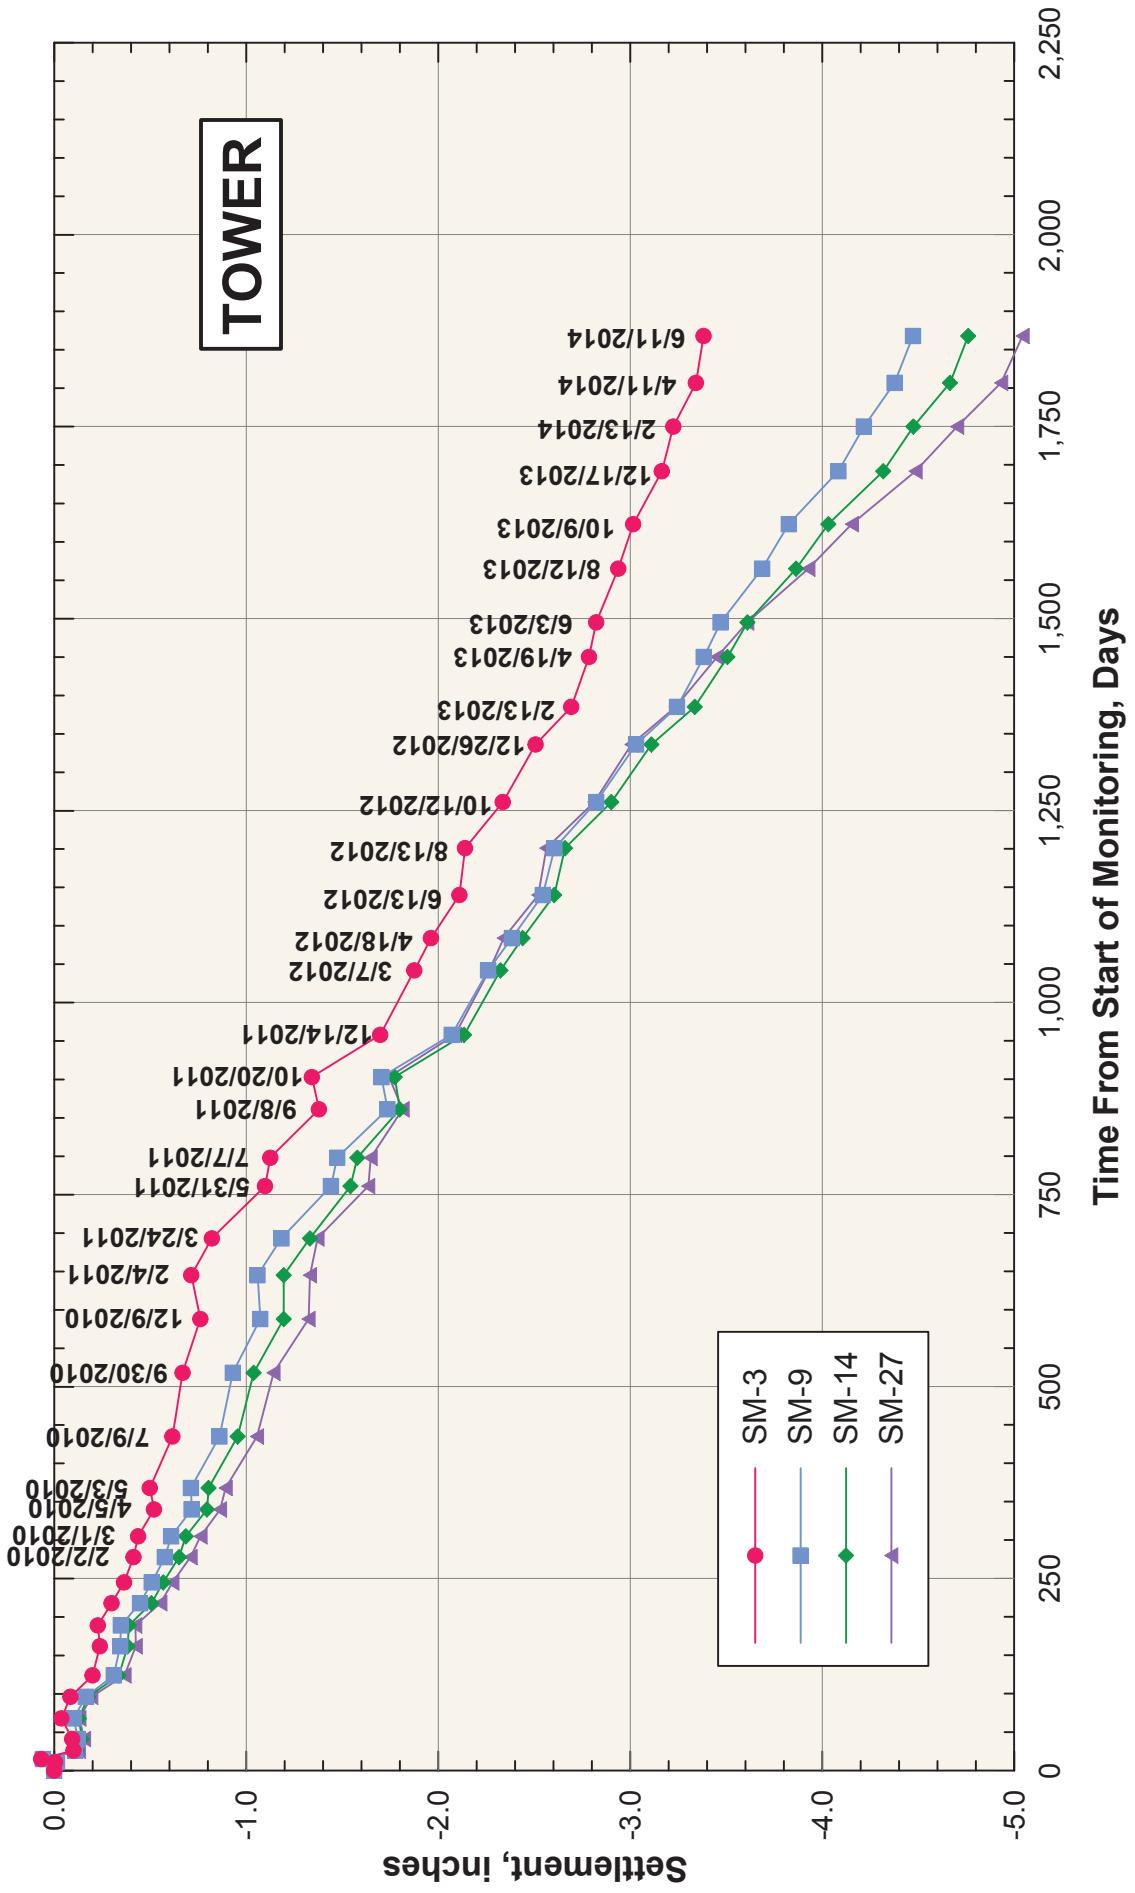



ARUP

Note:
Initial (Baseline) reading
taken on 04/30/09

J.S.F.13224214 Internal Project Data4-05 Reports & Narratives\238 301 Mission - June 2014 Survey\Plates\Plate 5 Settlement Over Time - Midrise.grf

**SETTLEMENT OVER TIME
FLOOR ELEVATIONS AT LEVEL B-1
OF 301 MISSION PROPERTY - MID-RISE:
APRIL 30, 2009 THROUGH JUNE 11, 2014**

Transbay Transit Center
301 Mission Monitoring
Transbay Joint Powers Authority
San Francisco, California

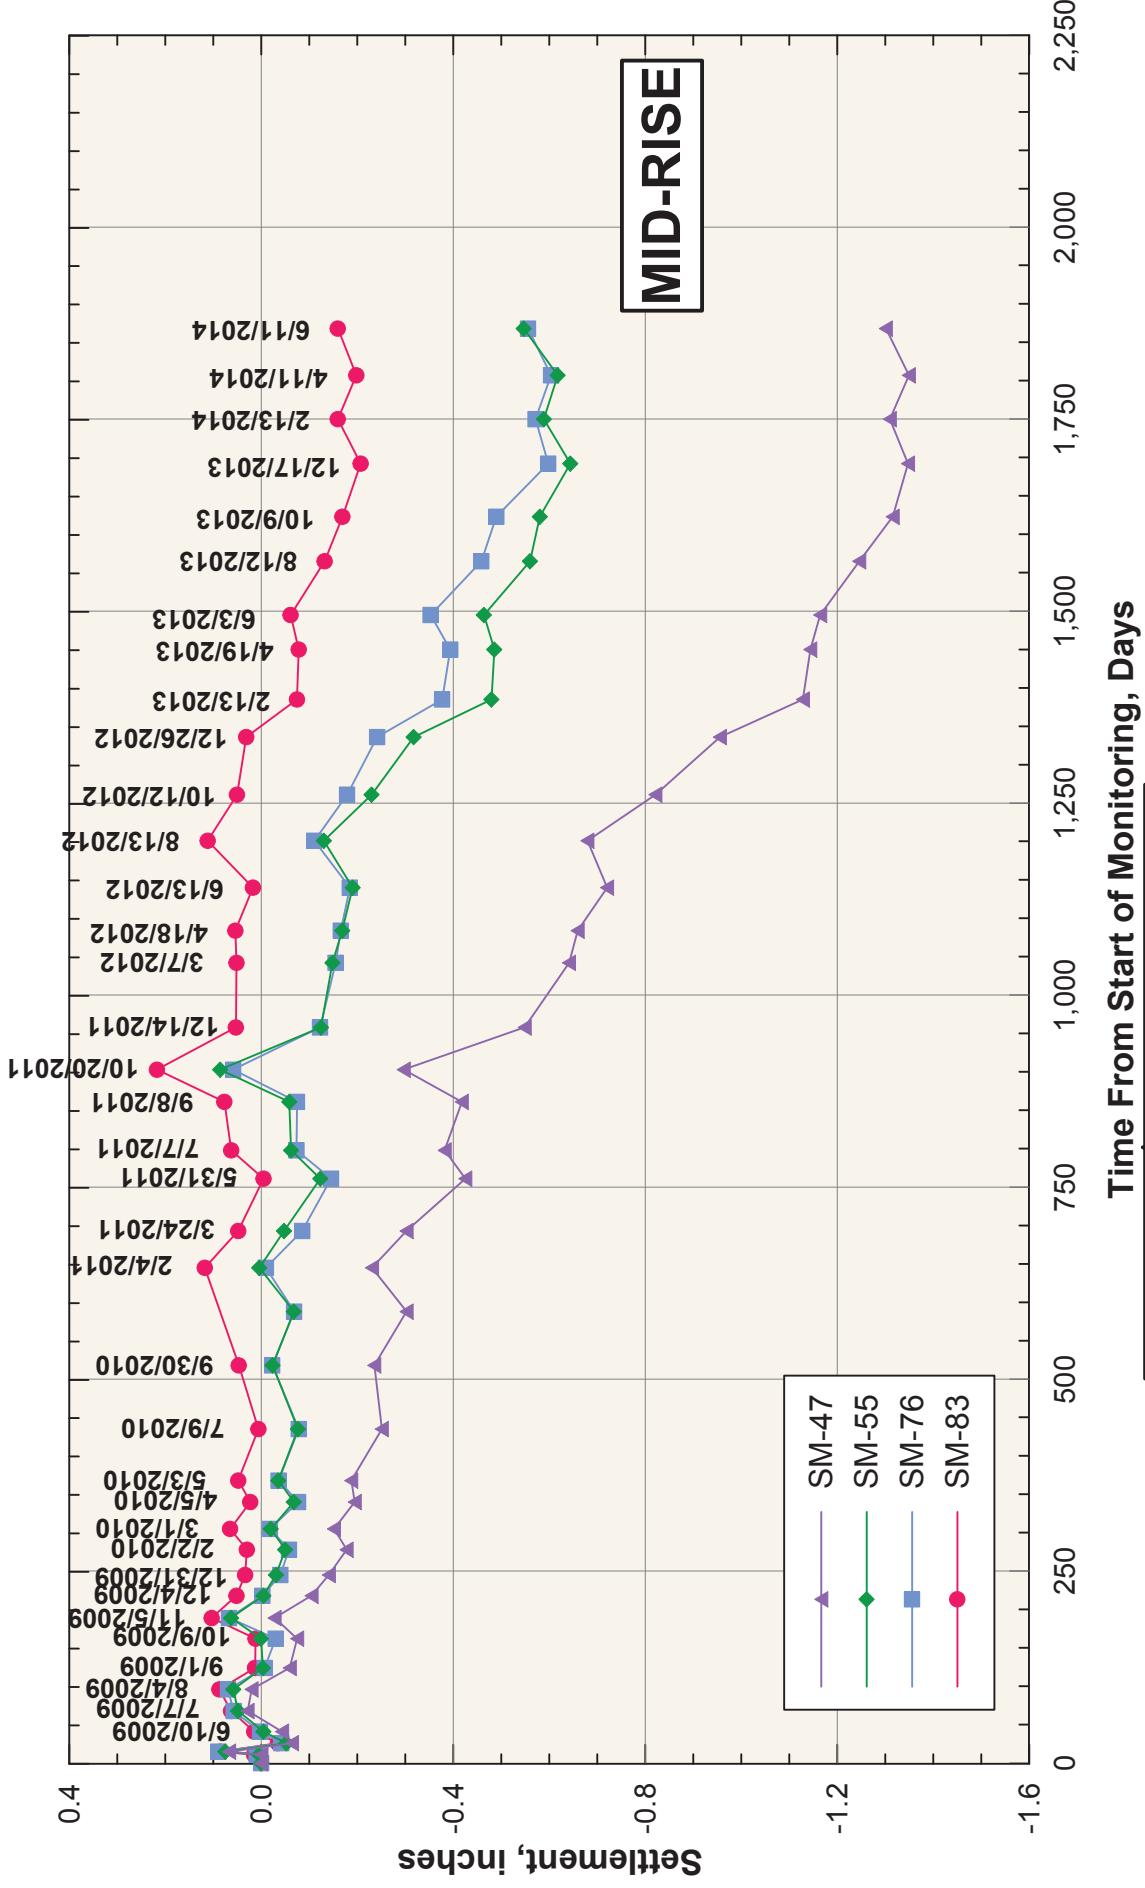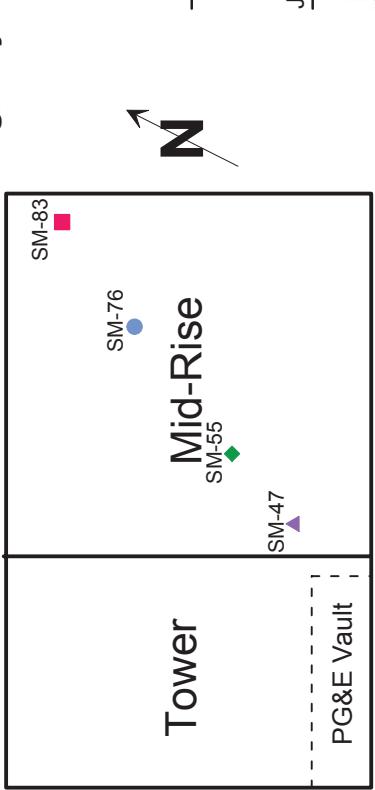



ARUP


**SETTLEMENTS OF THE 301 MISSION TOWER
INCLUDING MONITORING DURING CONSTRUCTION**

Transbay Transit Center
301 Mission Monitoring
Transbay Joint Powers Authority
San Francisco, California

Beginning of Tower Construction: 8/9/06
End of Tower Construction: 2/1/08
Construction Duration: 542 days (1.5 years)

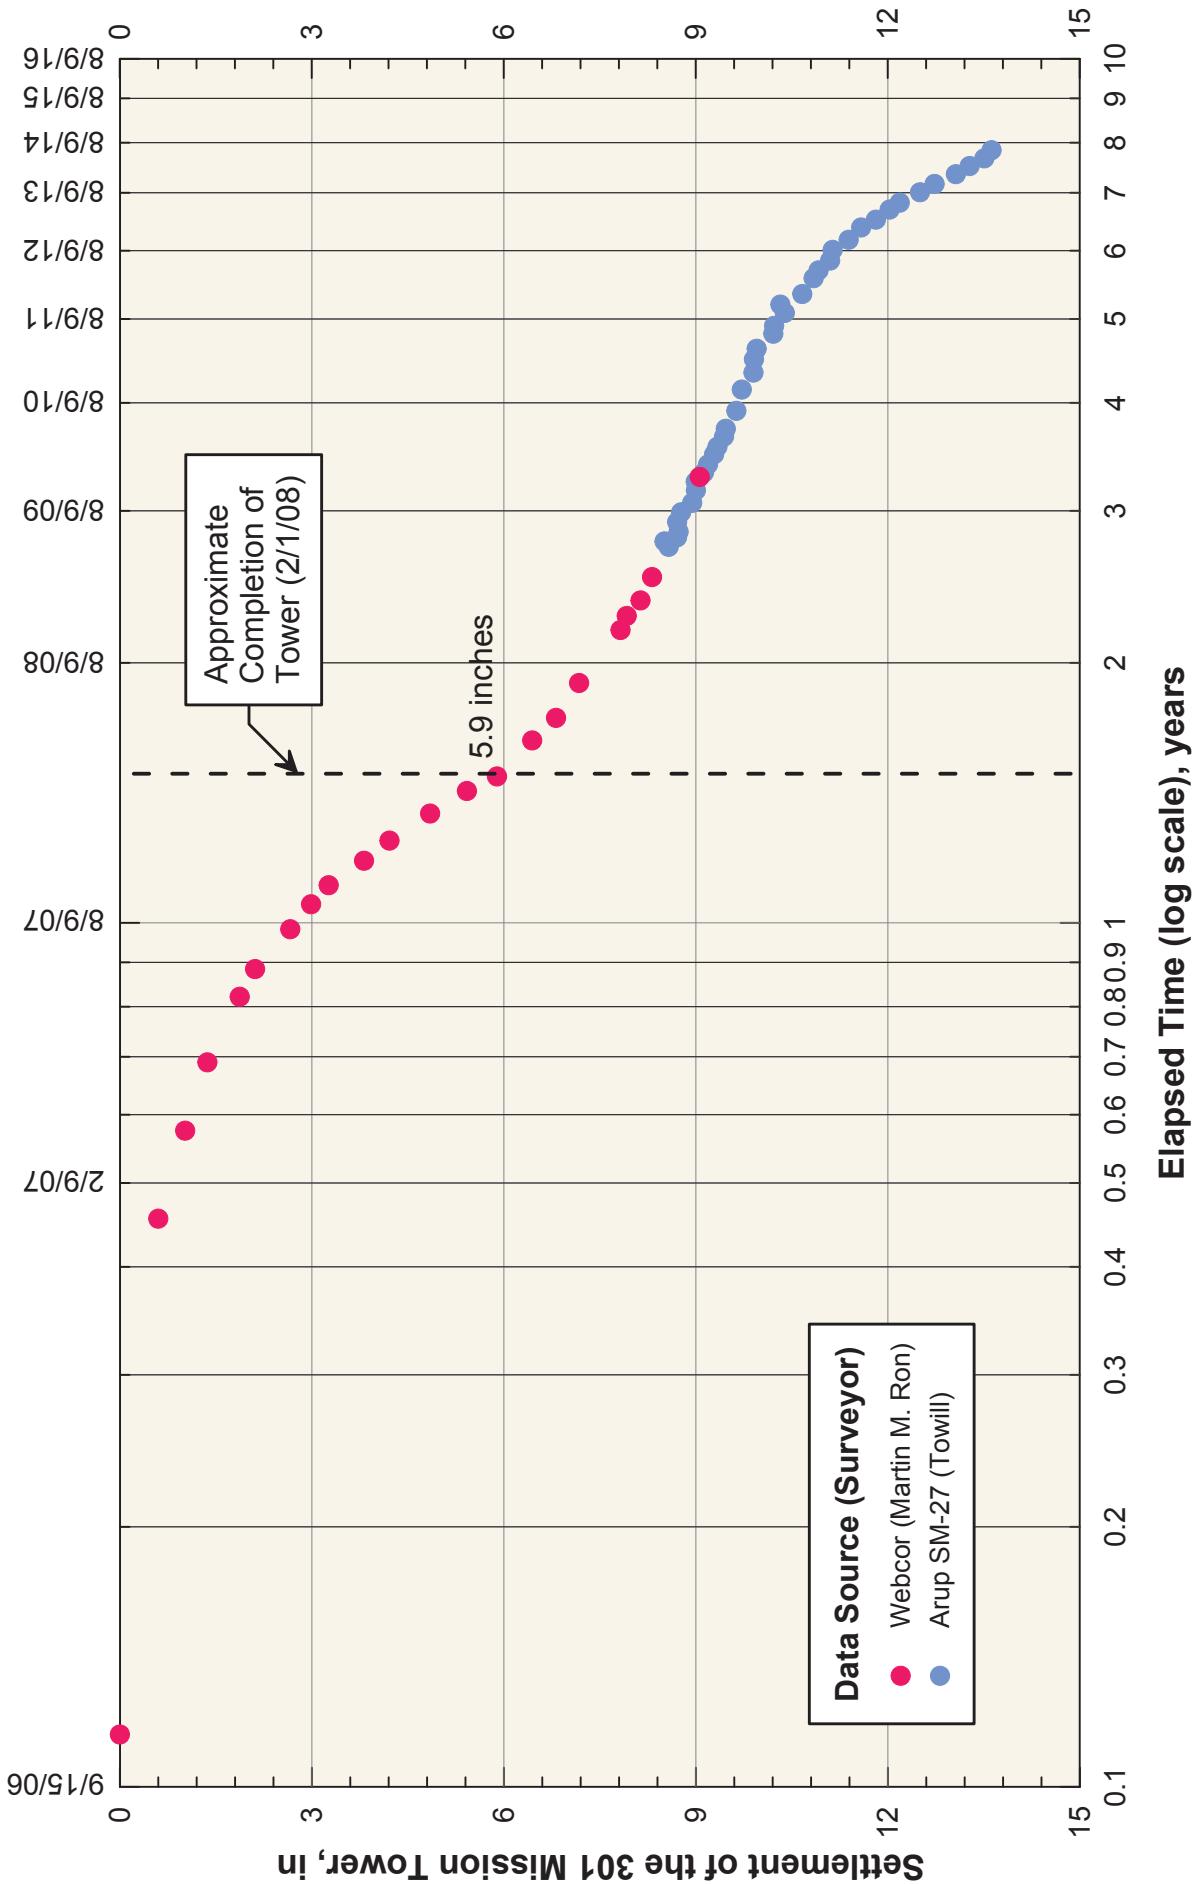

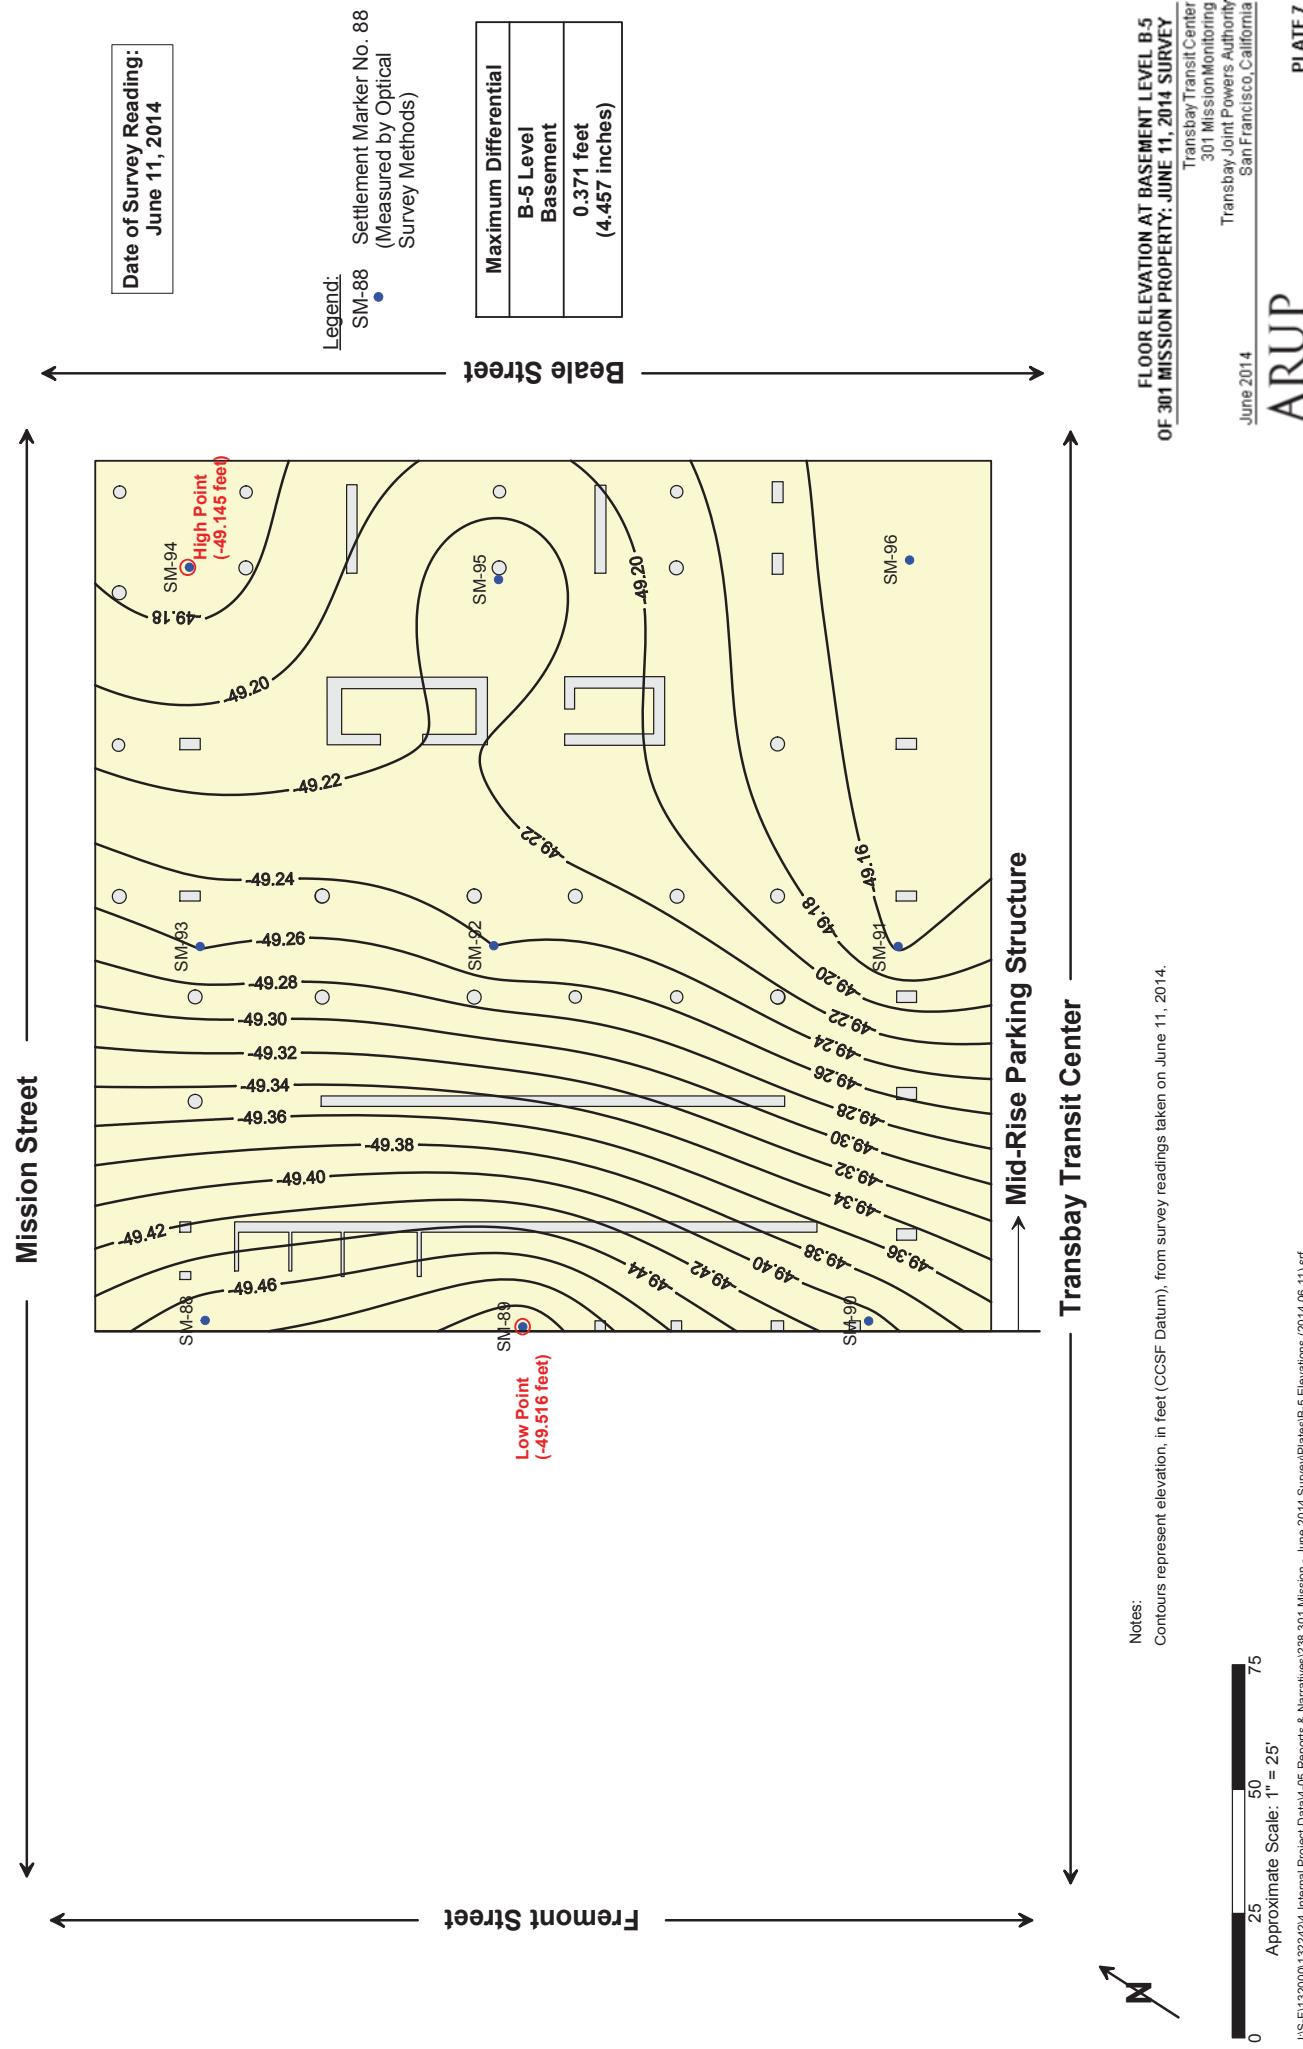

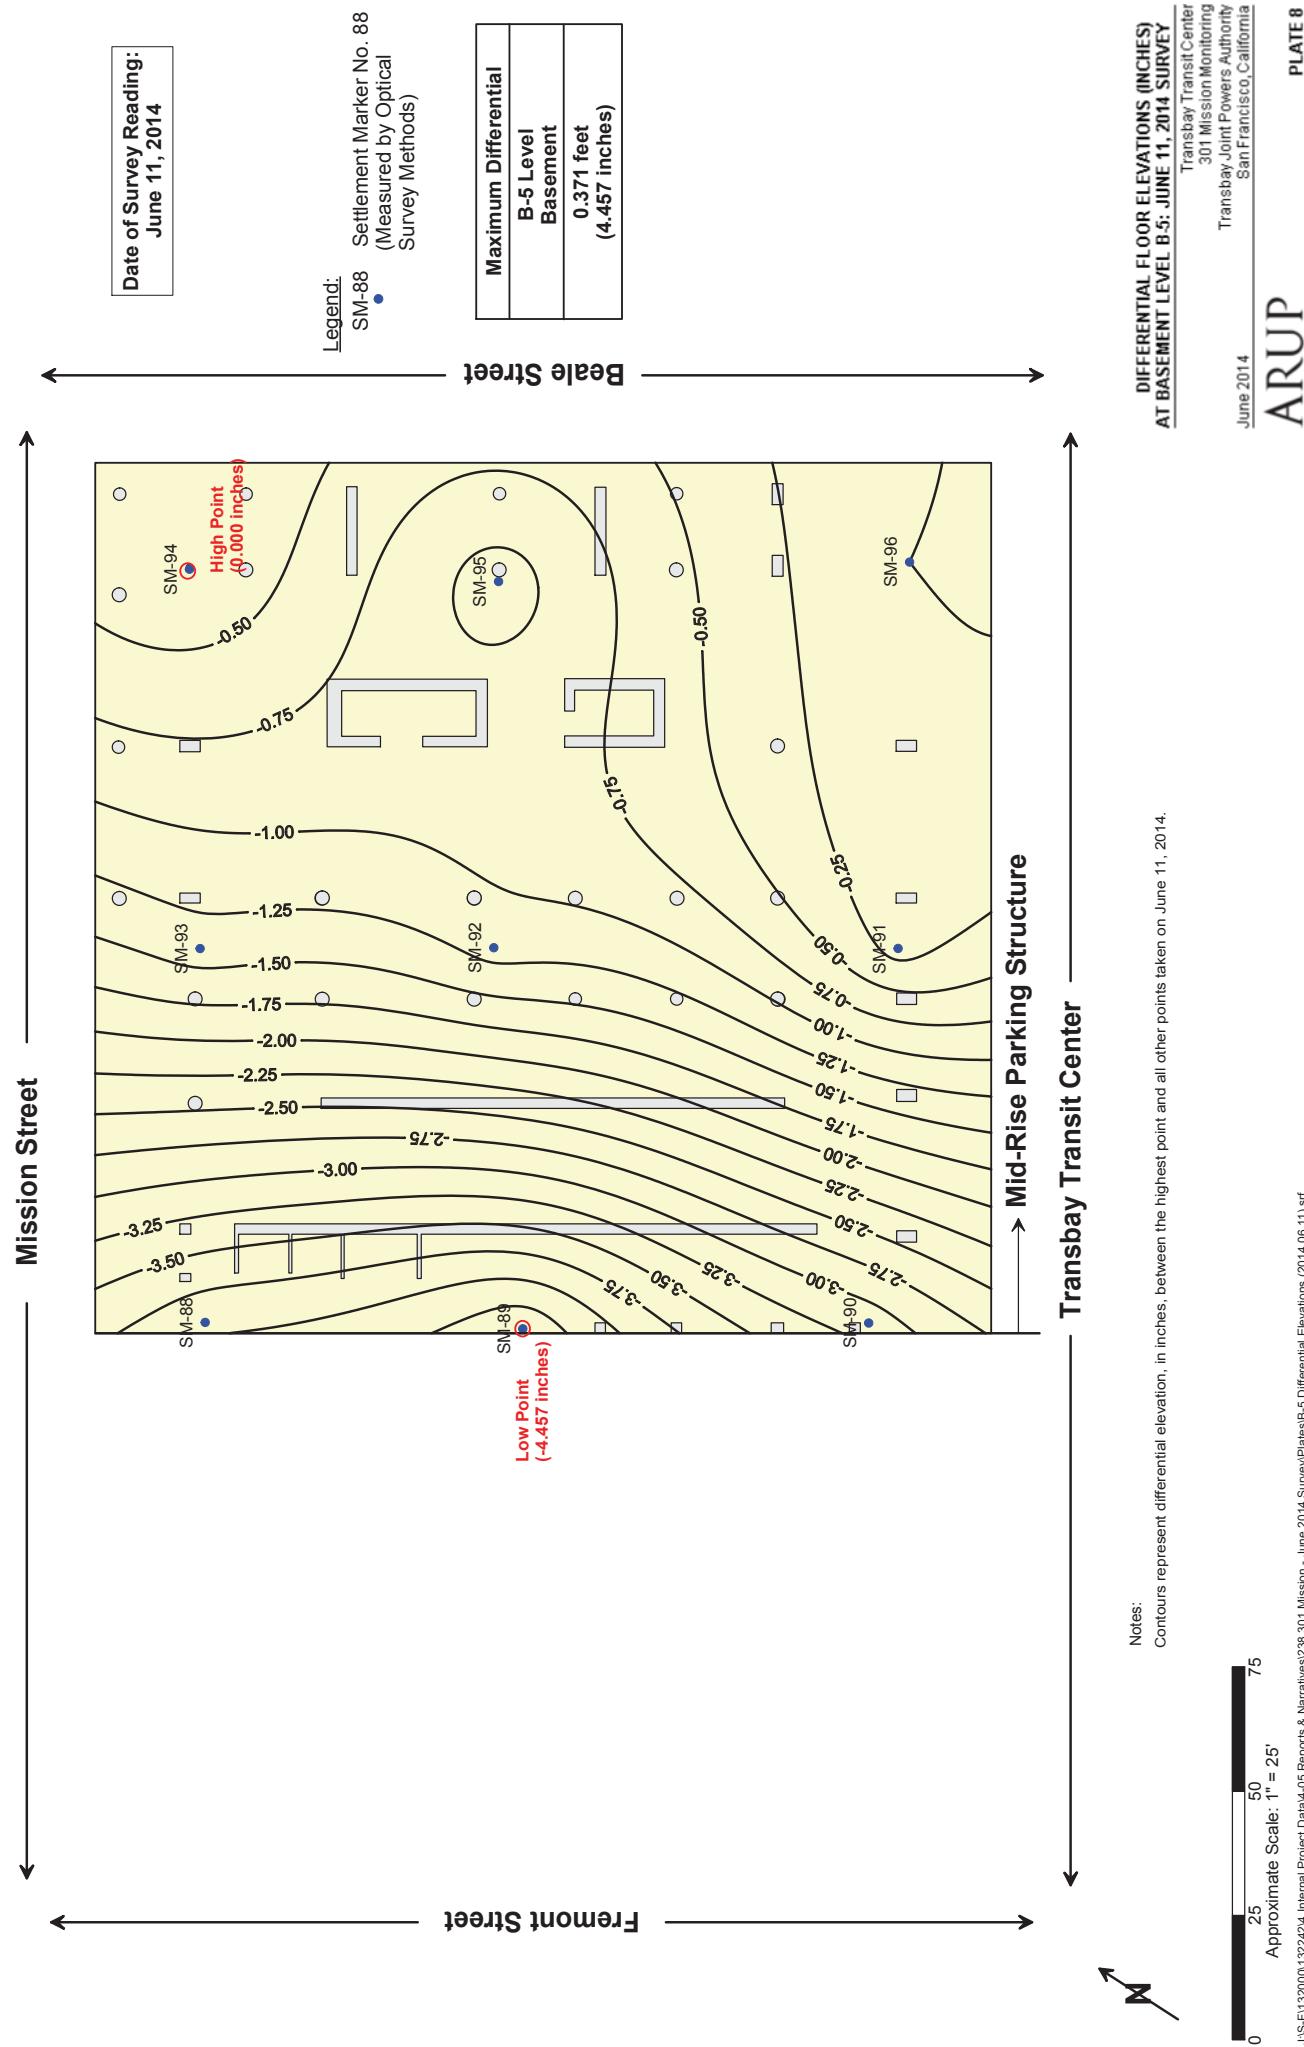

From: Brian Dykes
Sent: Monday, September 08, 2014 8:22 AM
To: Steven Hood
Cc: Margie Cleland
Subject: FW: TTC - Latest 301 Mission monitoring memo - August readings

Steve,
Here is the latest set of survey readings taken on August 5, 2014.
Margie,
Please copy to the files.
Thanks, Brian.

From: Stephen McLandrich [<mailto:stephen.mclandrich@arup.com>]
Sent: Thursday, September 04, 2014 5:32 PM
To: Brian Dykes
Cc: Andrew W. Schwartz (schwartz@smwlaw.com); George Metzger; 'rvolenec@pcparch.com' (rvolenec@pcparch.com); Nick O'Riordan; Jeff Dunn; DeeDee Maggi; Dennis Turchon
Subject: TTC - Latest 301 Mission monitoring memo - August readings

Brian,

Please find the attached monitoring memorandum and survey readings.

Regards,
Stephen

Stephen McLandrich PE GE
Senior Geotechnical Engineer

Arup
560 Mission Street Suite 700 San Francisco CA 94105 USA
t +1 415 957 9445 d +1 415 946 0245
f +1 415 957 9096 c +1 415 310 1095
www.arup.com

Check out our progress at <http://transbaycenter.org/construction-updates/construction-cameras>

NOTE: This e-mail communication and any attachments hereto are covered by the Electronic Communications Privacy Act, 18 U.S.C. Sections 2510-2521, and are legally privileged. The information contained herein is confidential, and is intended only for the use of the individual or entity to whom it is addressed. If you are not the intended recipient of this e-mail communication (or an employee or agent responsible for delivering this communication to its intended recipient(s)), you are hereby notified that any retention, copying or further distribution of this e-mail communication and any attachments is strictly prohibited. If you are not the intended recipient, please notify the sender by telephoning 415-597-4620, or by forwarding an e-mail reply message addressed to TransAdmin@TransbayCenter.org confirming that you have already destroyed (deleted) the original e-mail communication and any and all copies thereof. Thank you.

Memorandum


ARUP

To	Brian Dykes (TJPA)	Date
		September 4, 2014
Copies	Randy Volenec (PCPA) George Metzger (AAI)	Reference number 132242
From	Stephen McLandrich (Arup)	File reference 4-05 240
Subject	Transbay Transit Center: Results of August 2014 Settlement Survey at 301 Mission Property	Page 1 of 1

Under Arup's Geotechnical Contract with the Transbay Joint Powers Authority through Pelli Clark Pelli Architects, Arup is required to monitor the settlements of the buildings adjacent to the Transbay Transit Center prior to and during construction. We began the monitoring program for the 301 Mission property in April of 2009. This memorandum and the attached plates present an update to our memorandum dated June 27, 2014 with measurements made through August 2014.

List of Plates

- Plate 1 Floor Elevations at Level B-1 of 301 Mission Property: Periodic Survey – August 5, 2014
- Plate 2 Differential Floor Elevation (Inches) August 5, 2014 Survey
- Plate 3 Contours of Settlements Measured at the 1st Level Basement of the 301 Mission St. Structure Between 04/30/2009 & 8/5/2014
- Plate 4 Settlement Over Time Floor Elevations at Level B-1 of 301 Mission Property – Tower: April 30, 2009 through August 5, 2014
- Plate 5 Settlement Over Time Floor Elevations at Level B-1 of 301 Mission Property – Mid-Rise: April 30, 2009 through August 5, 2014
- Plate 6 Settlements of the 301 Mission Tower Including Monitoring During Construction
- Plate 7 Floor Elevation at Basement Level B-5 of 301 Mission Property: August 5, 2014 Survey
- Plate 8 Differential Floor Elevations (Inches) at Basement Level B-5: August 5, 2014 Survey

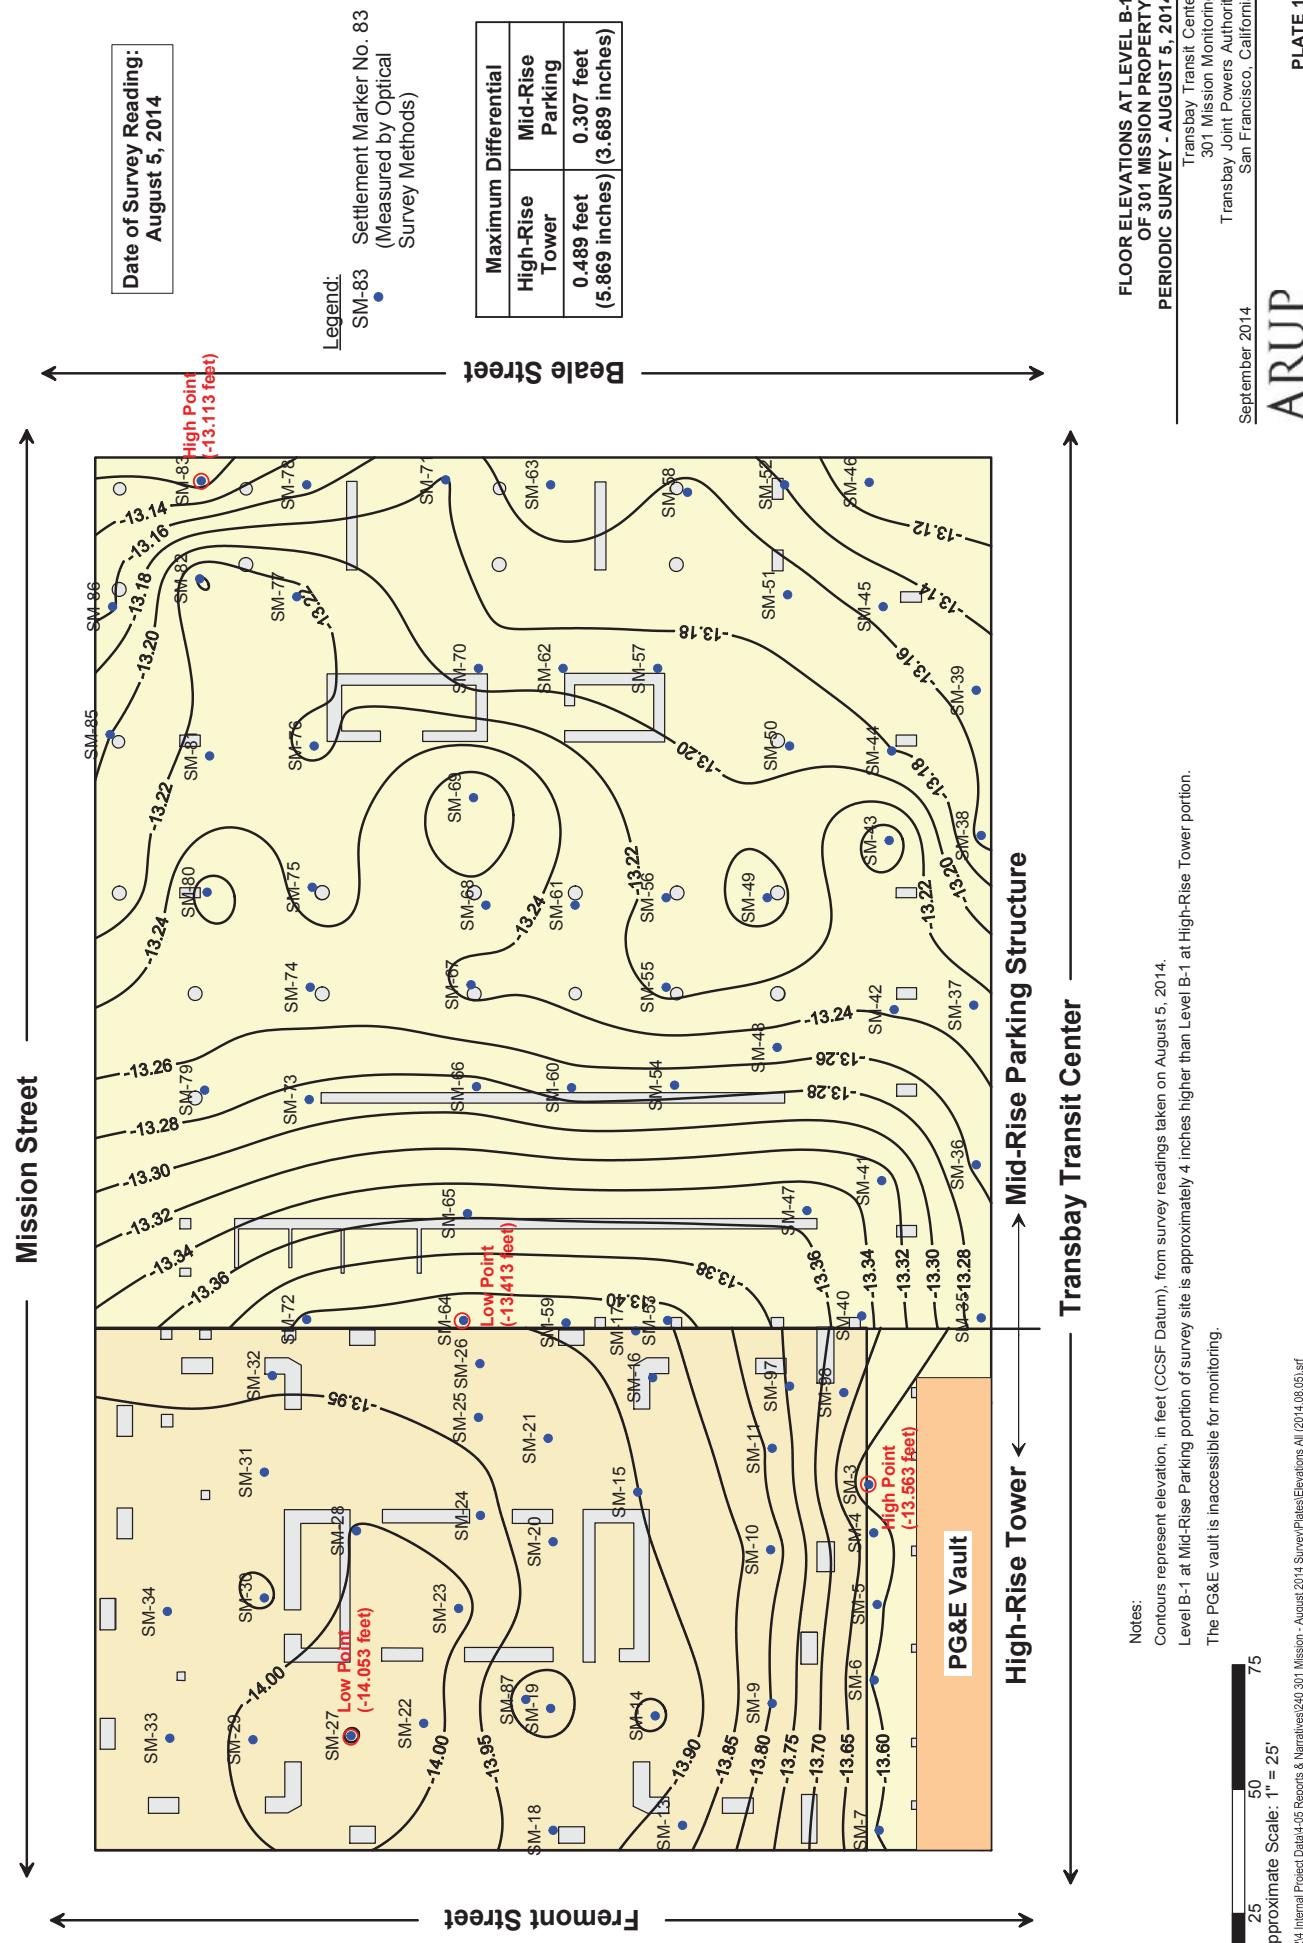

**FLOOR ELEVATIONS AT LEVEL B-1
OF 301 MISSION PROPERTY
PERIODIC SURVEY - AUGUST 5, 2014**

Transbay Transit Center
301 Mission Monitoring
Transbay Joint Powers Authority
San Francisco, California

September 2014

ARUP

Notes:
 Contours represent elevation, in feet (CCSF Datum), from survey readings taken on August 5, 2014.
 Level B-1 at Mid-Rise Parking portion of survey site is approximately 4 inches higher than Level B-1 at High-Rise Tower portion.
 The PG&E vault is inaccessible for monitoring.

Approximate Scale: 1" = 25'
 JISI12000132242 Internal Project Data 4-05 Reports & Narratives 240 301 Mission - August 2014 Survey/Patent/Elevations All (2014.08.05).srf

25 50 75
0


ARUP


DIFFERENTIAL FLOOR ELEVATIONS (INCHES)
AUGUST 5, 2014 SURVEY
Transbay Transit Center
301 Mission Monitoring
Transbay Joint Powers Authority
San Francisco, California

September 2014

U.S. EPA 2000/1322424 Internal Project Data4.05 Reports & Narratives240 301 Mission - August 2014 Survey\\Plates\\Differential Elevation All\\20140805.spt

Legend:
SM-83 Settlement Marker No. 83
(Measured by Optical
Survey Methods)

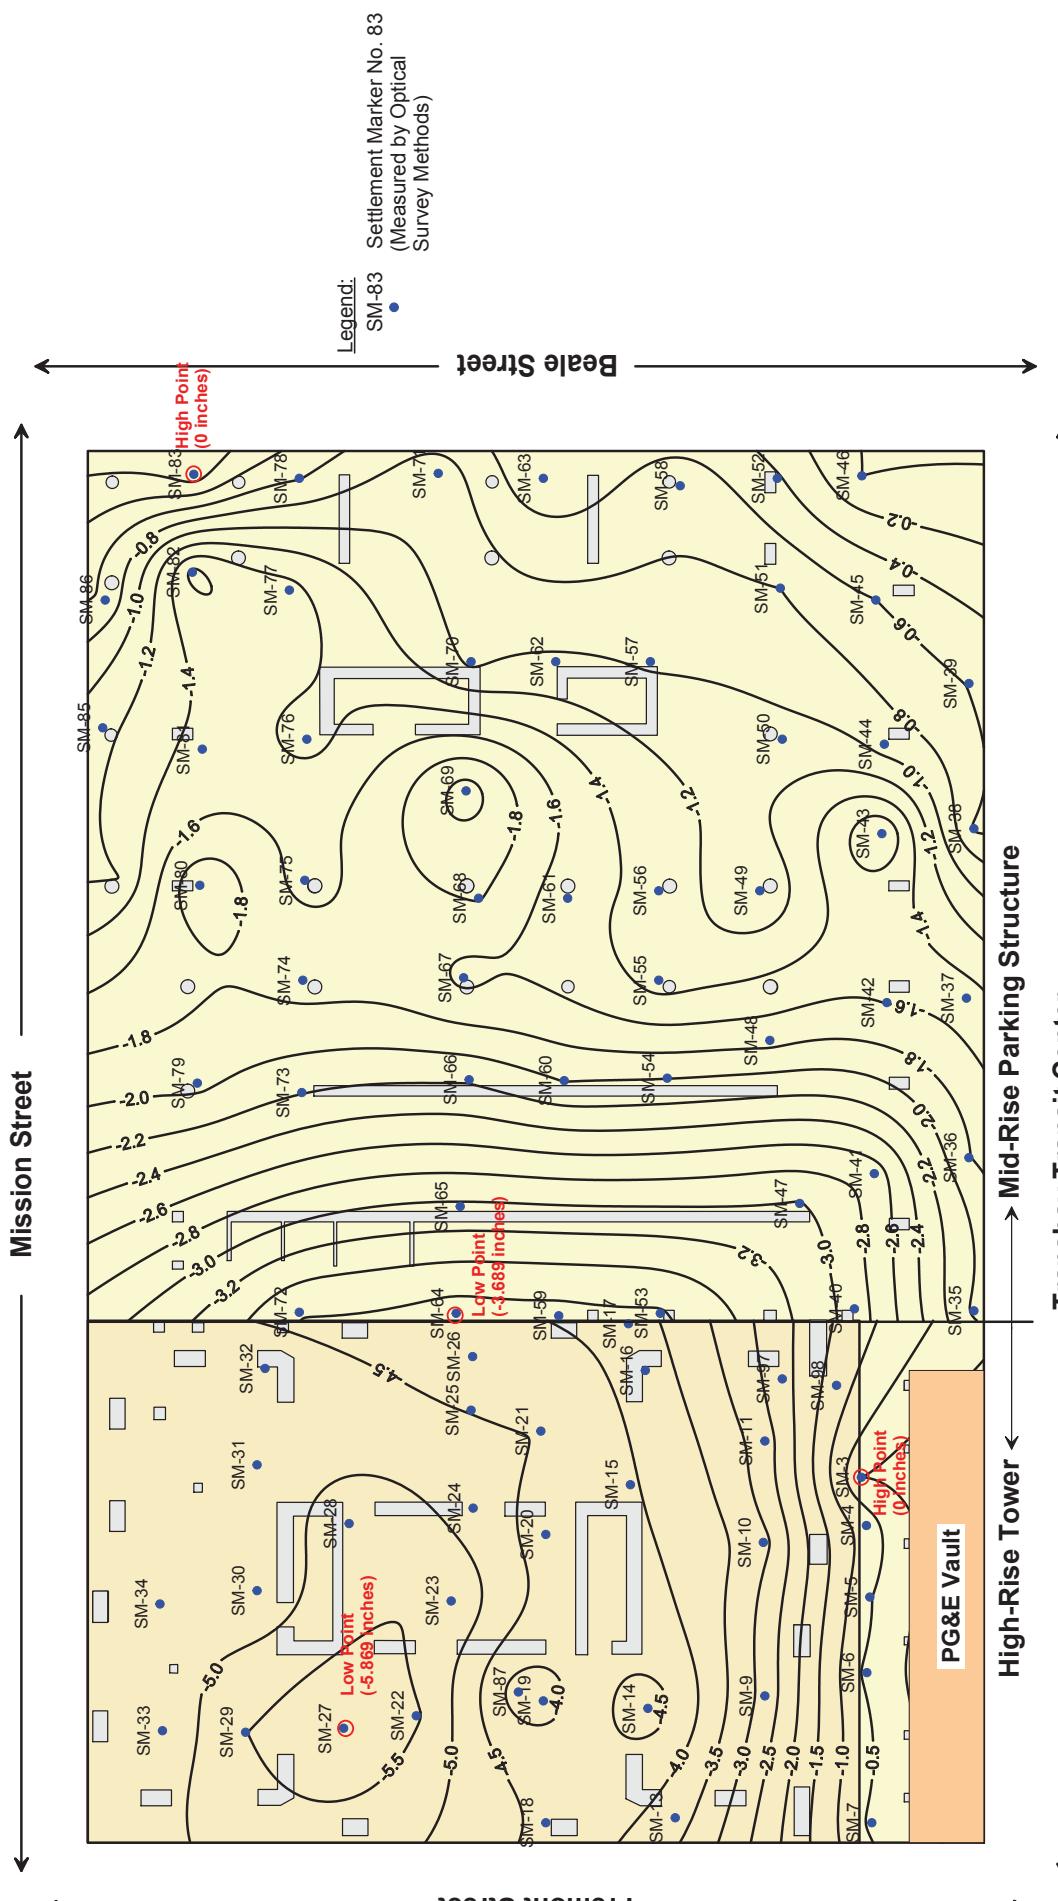

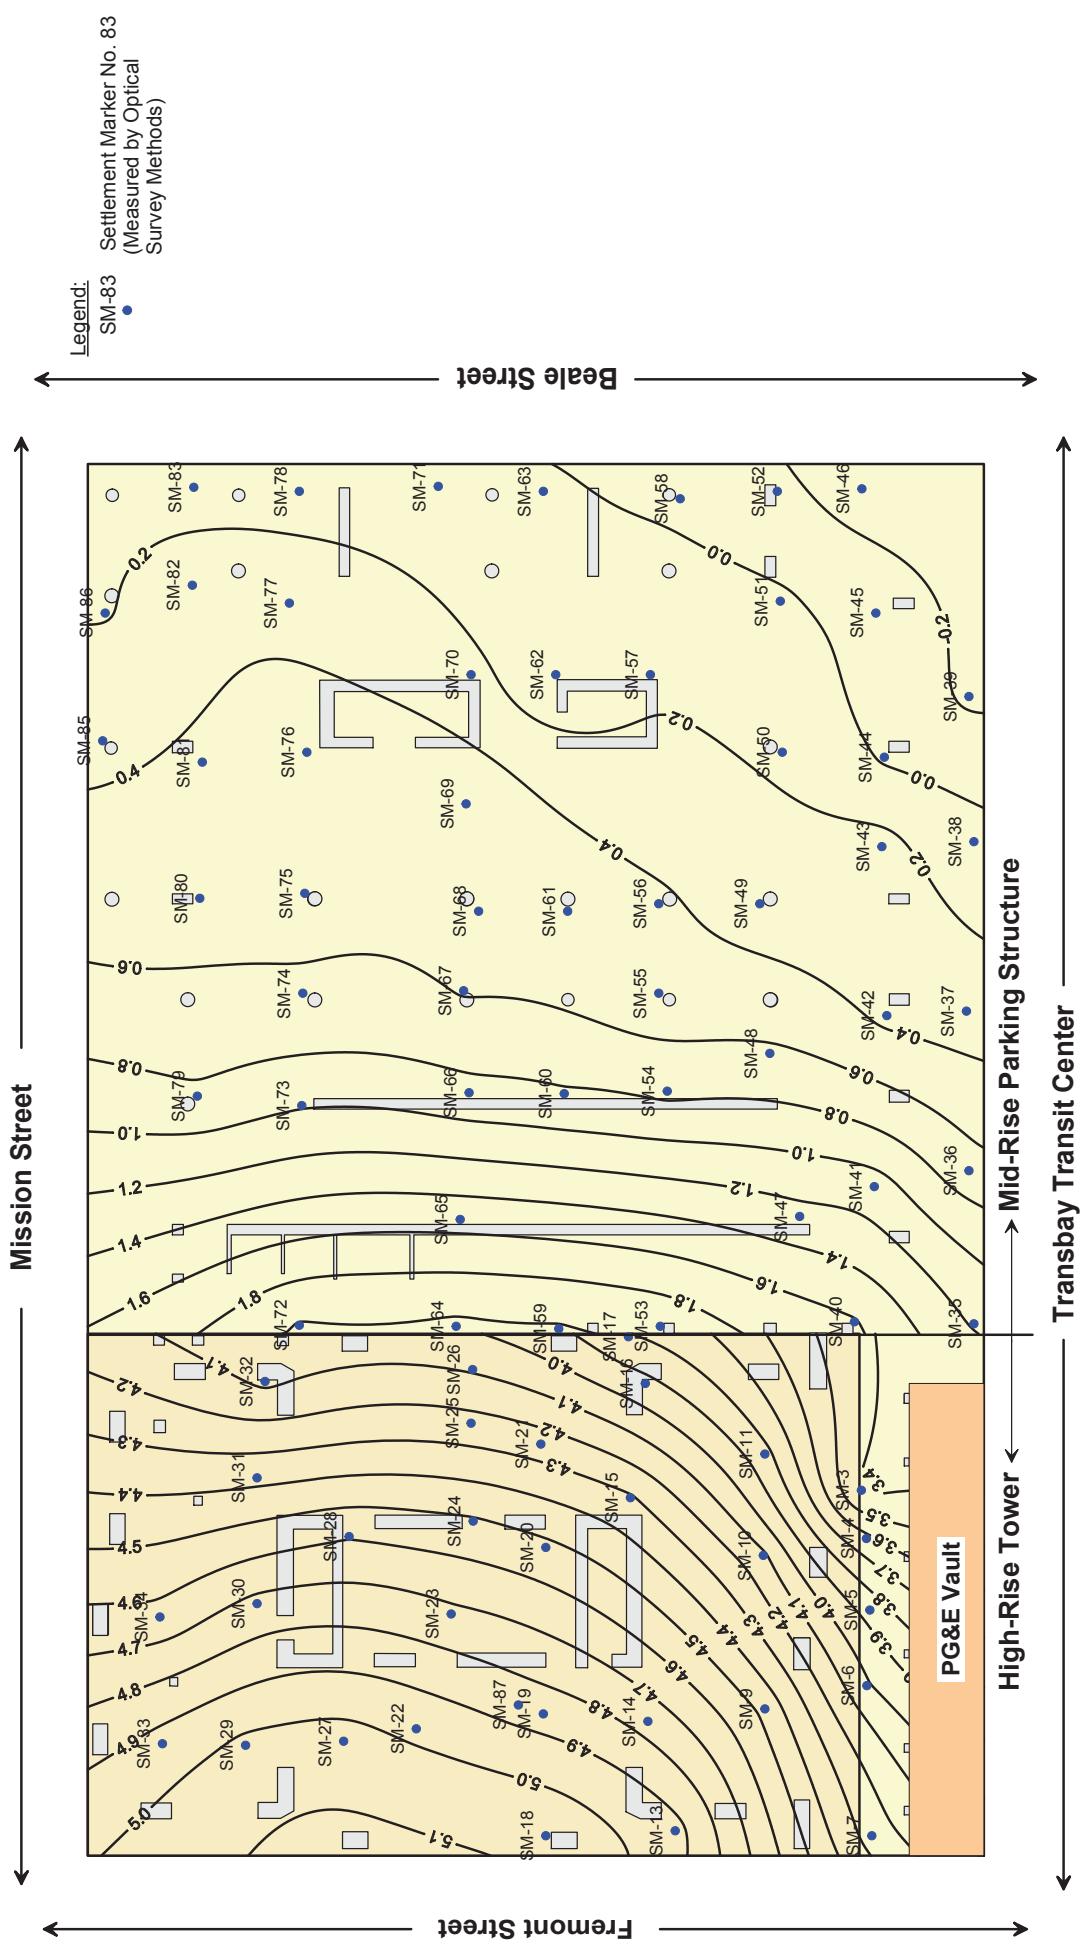

**CONTOURS OF SETTLEMENTS MEASURED AT THE
1ST LEVEL BASEMENT OF THE 301 MISSION ST
STRUCTURE BETWEEN 04/30/2009 & 8/5/2014**

September 2014

Transbay Transit Center
301 Mission Monitoring
Transbay Joint Powers Authority
San Francisco, California

PLATE 3

Contours represent elevation change, in inches, between baseline survey (April 30, 2009) and readings taken on August 3, 2014. Level B-1 at Mid-Rise Parking portion of survey site is approximately 4 inches higher than Level B-1 at High-Rise Tower portion.

The PG&E vault is inaccessible for monitoring.

Negative values of settlement (within Low-rise Tower) indicate uplift.

J-S-F13200013224: Internal Project Data|05-Reports & Narratives|240 301 Mission - August 2014 Survey Plates|Elevation changes|All (2014.08.05) srf

Level B

The PG
Level B

Negative values of settlement (within Low-rise

version - August 2014 SurveyPlates{Elevation changes All (2014.08.05).srf

STRUCTURE

September 2014

ARUI

PLATE 3




ARUP


Note:
Initial (Baseline) reading
taken on 04/30/09

**SETTLEMENT OVER TIME
FLOOR ELEVATIONS AT LEVEL B-1
OF 301 MISSION PROPERTY- TOWER:
APRIL 30, 2009 THROUGH AUGUST 5, 2014**

Transbay Transit Center
301 Mission Monitoring
Transbay Joint Powers Authority
San Francisco, California

Time From Start of Monitoring, Days

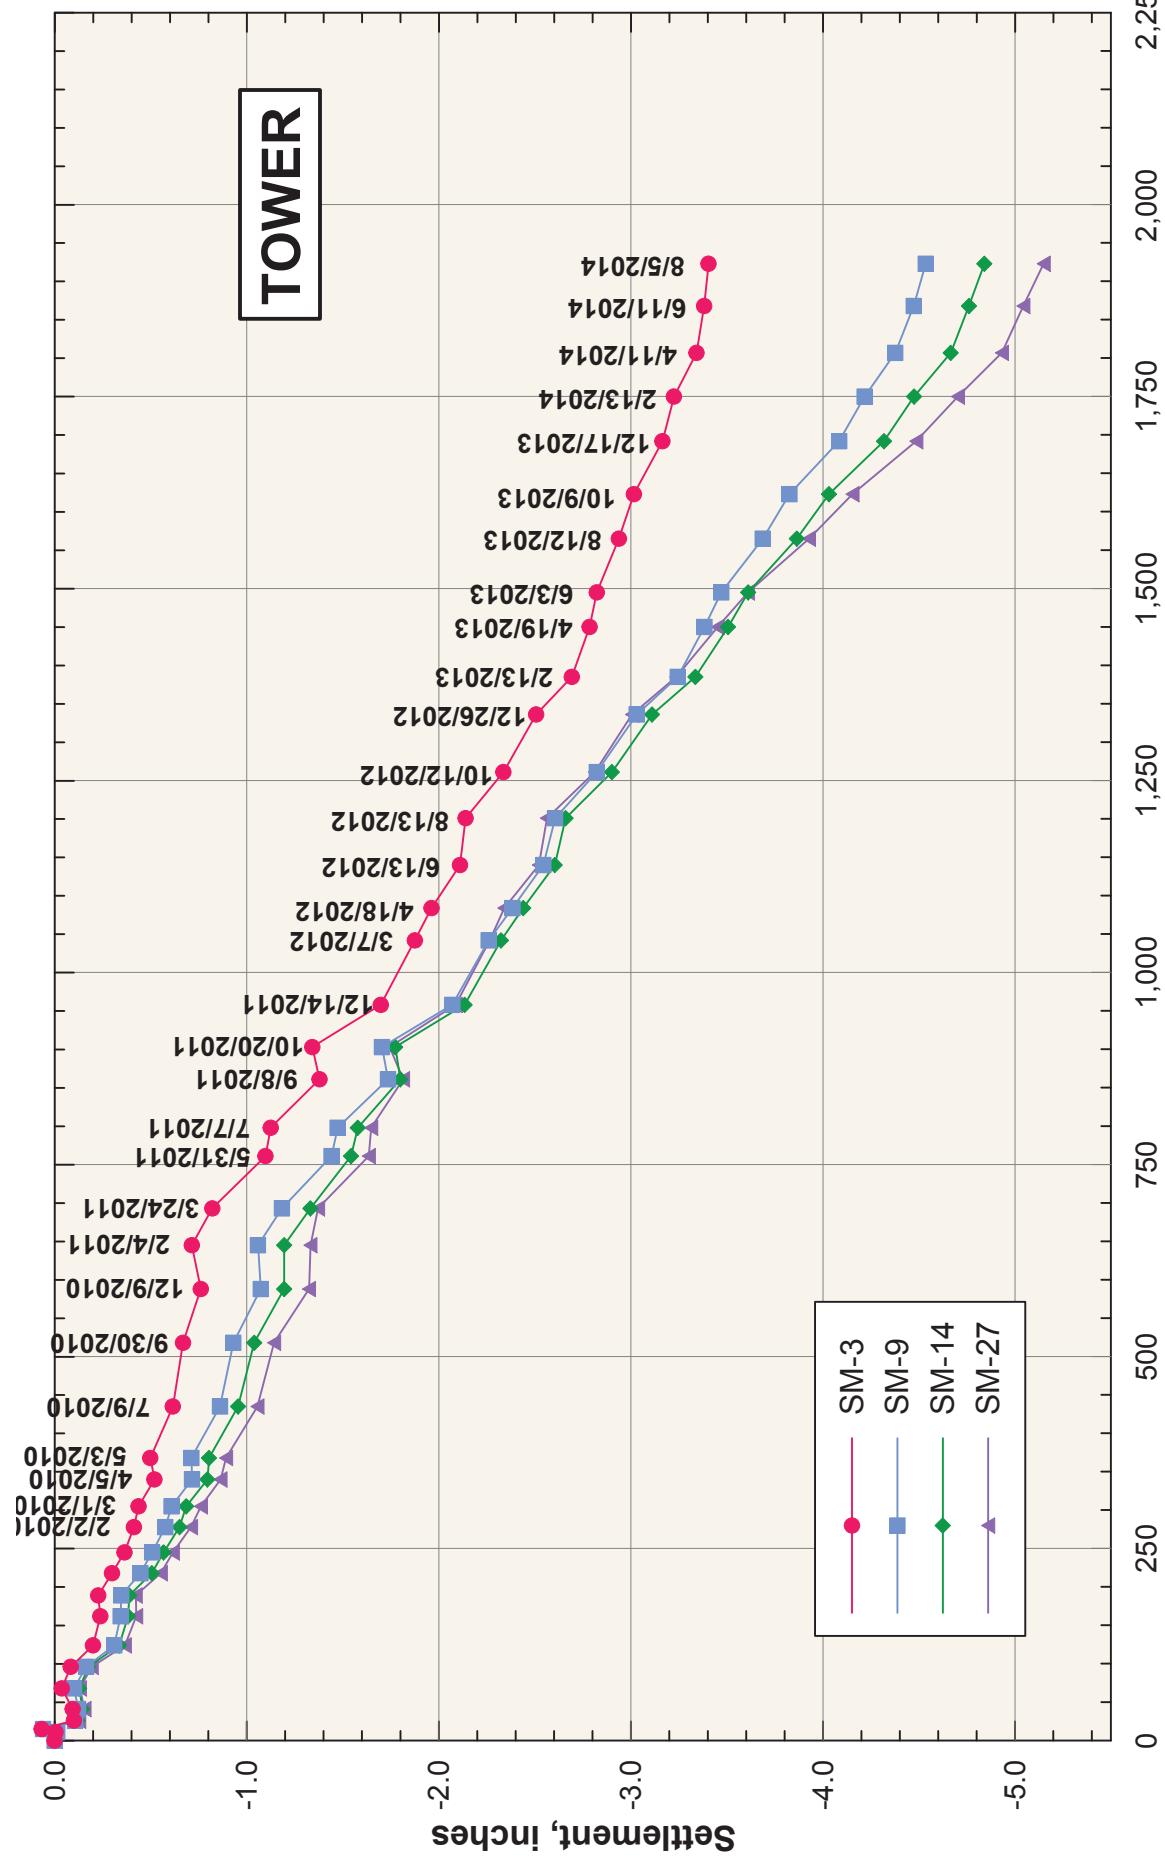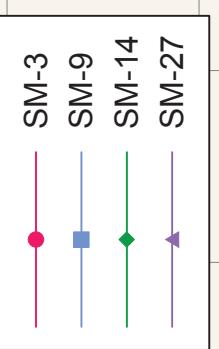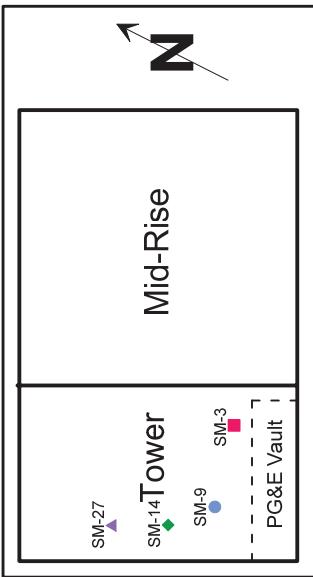

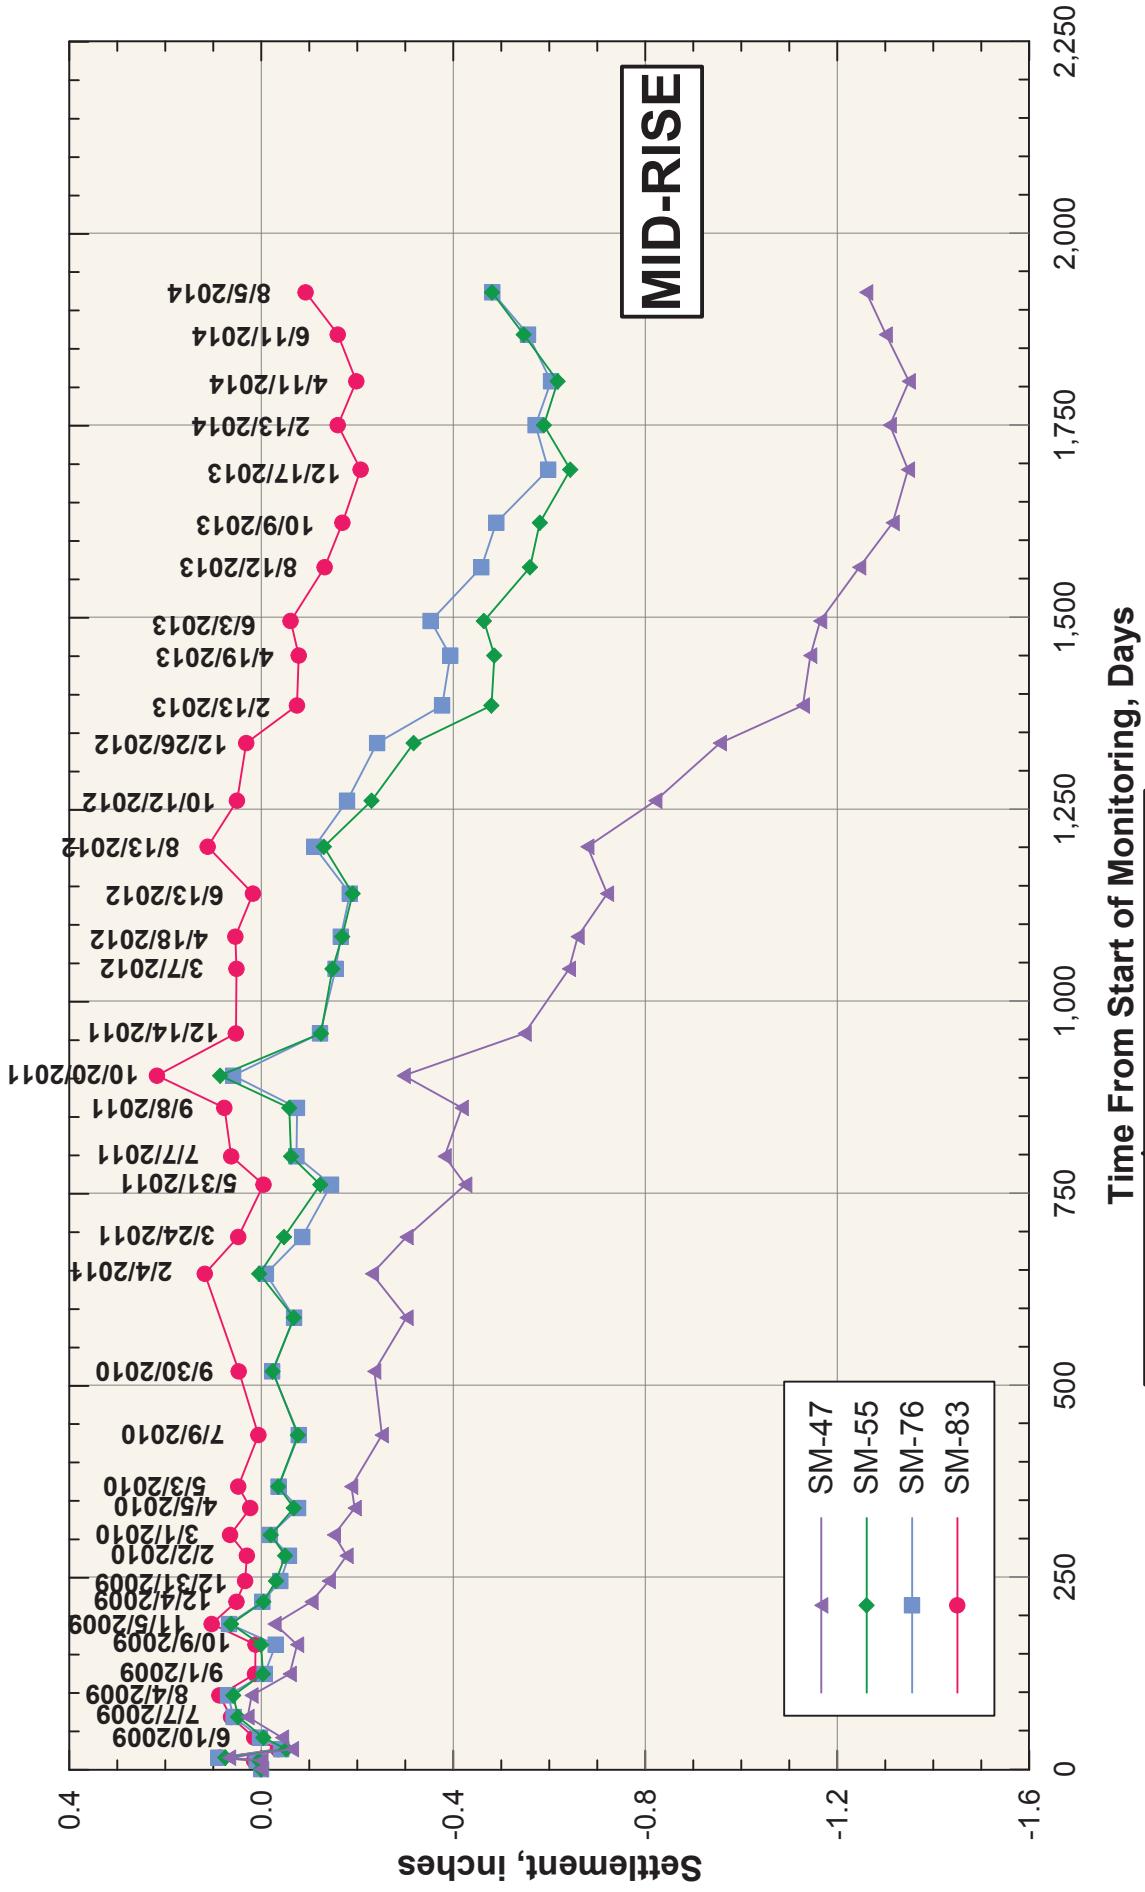


**SETTLEMENT OVER TIME
FLOOR ELEVATIONS AT LEVEL B-1
OF 301 MISSION PROPERTY - MID-RISE:
APRIL 30, 2009 THROUGH AUGUST 5, 2014**

Transbay Transit Center
301 Mission Monitoring
Transbay Joint Powers Authority
San Francisco, California

September 2014
ARUP

Note:
**Initial (Baseline) reading
taken on 04/30/09**

ARUP

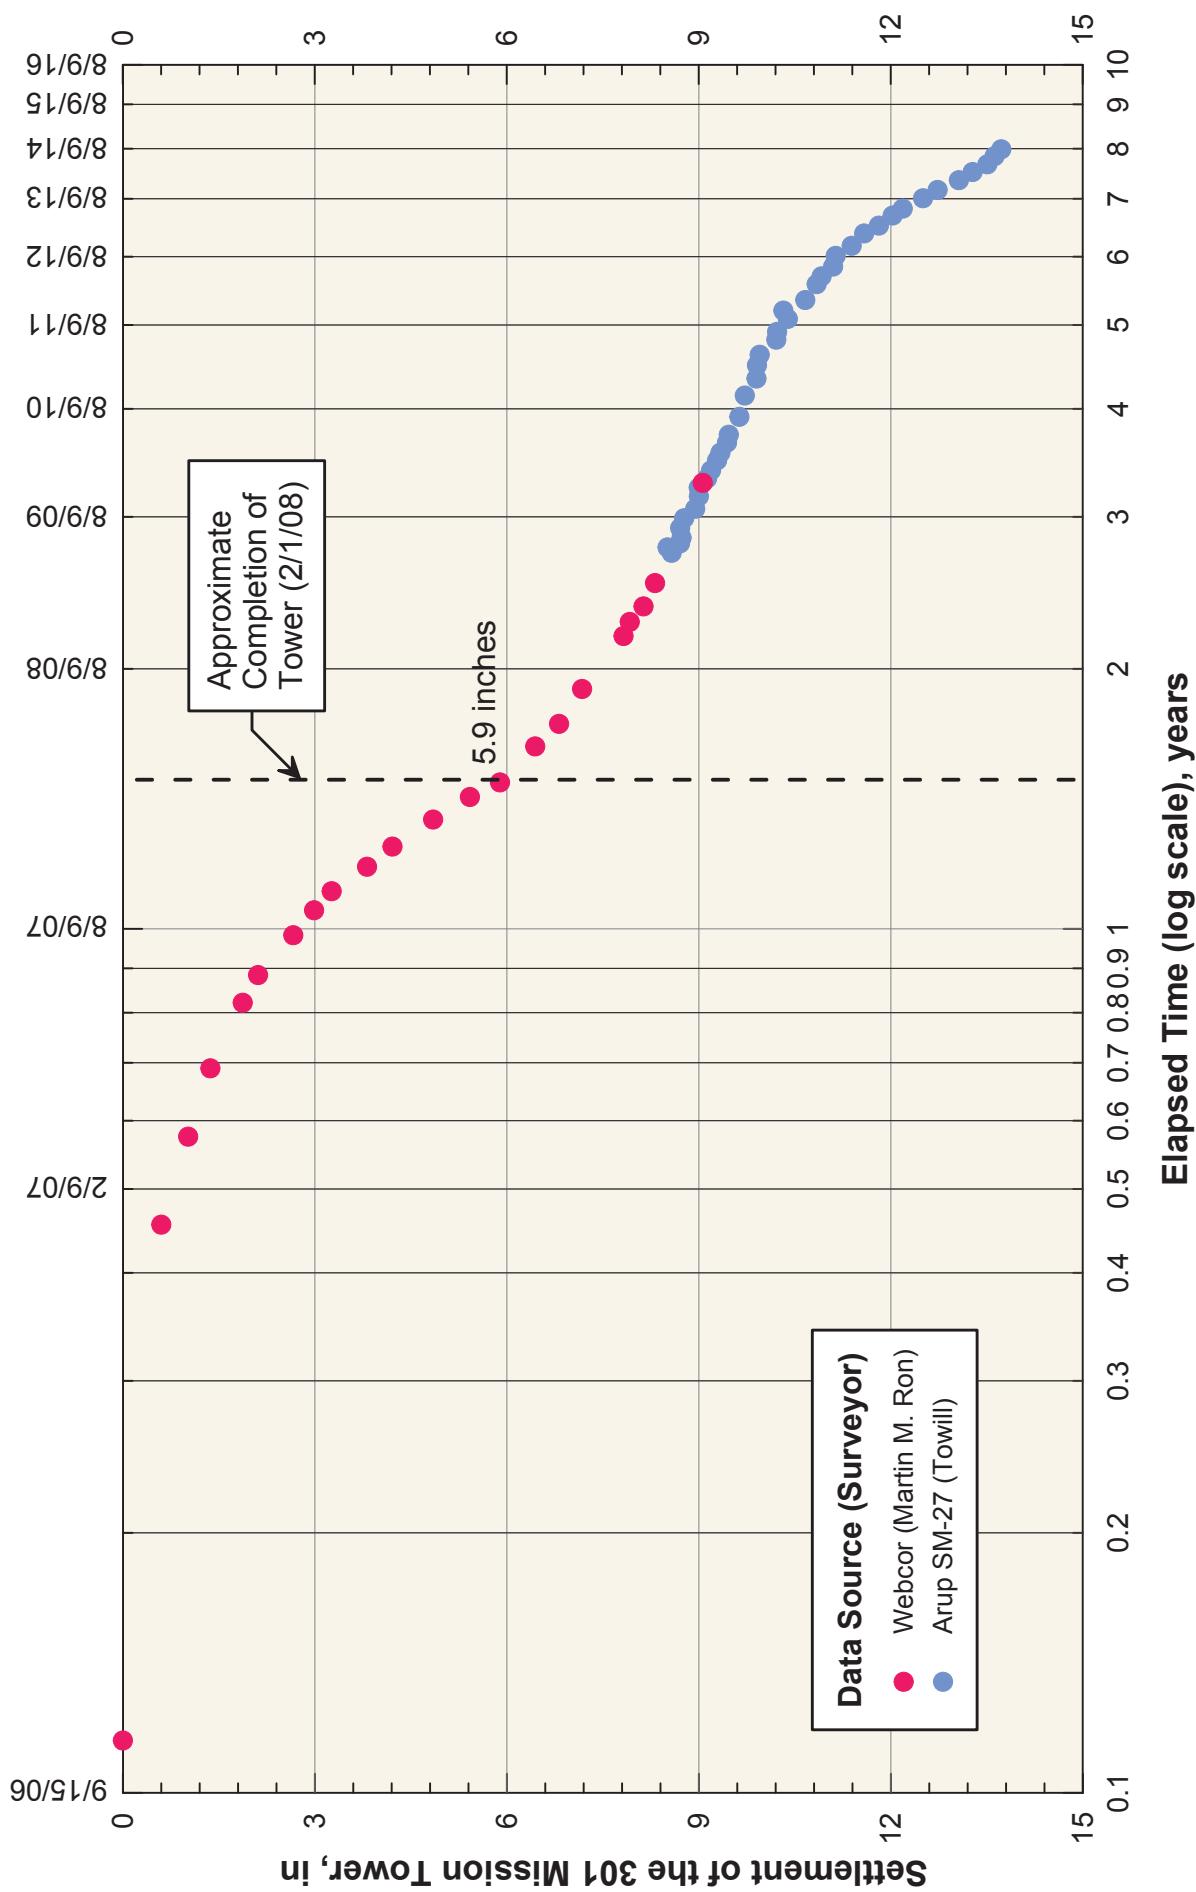



**SETTLEMENTS OF THE 301 MISSION TOWER
INCLUDING MONITORING DURING CONSTRUCTION**

Transbay Transit Center
301 Mission Monitoring
Transbay Joint Powers Authority
San Francisco, California

September 2014

Beginning of Tower Construction: 8/9/06
End of Tower Construction: 2/1/08
Construction Duration: 542 days (1.5 years)

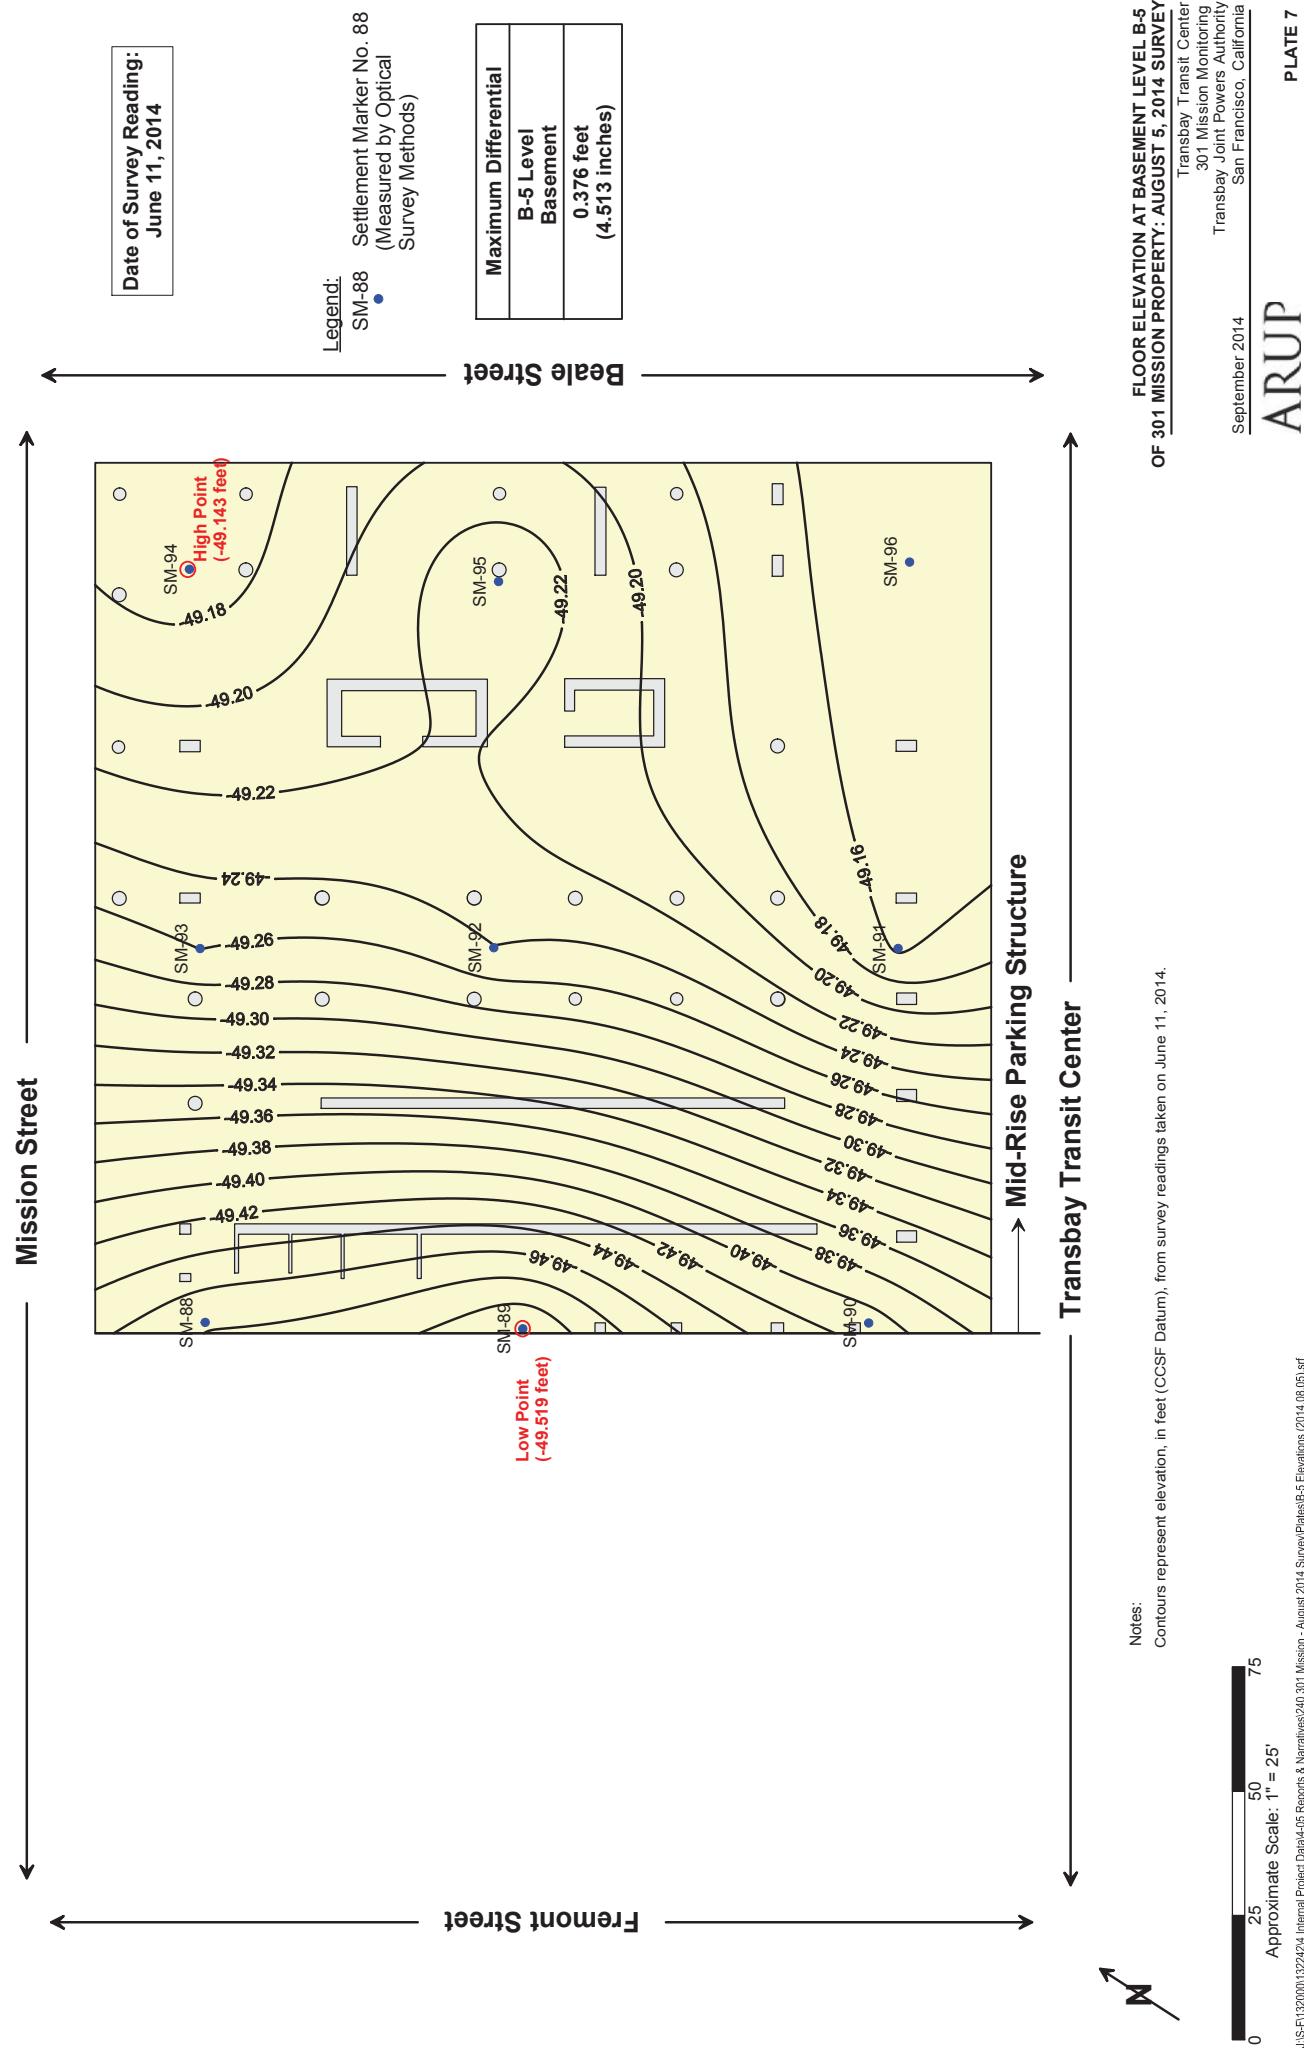

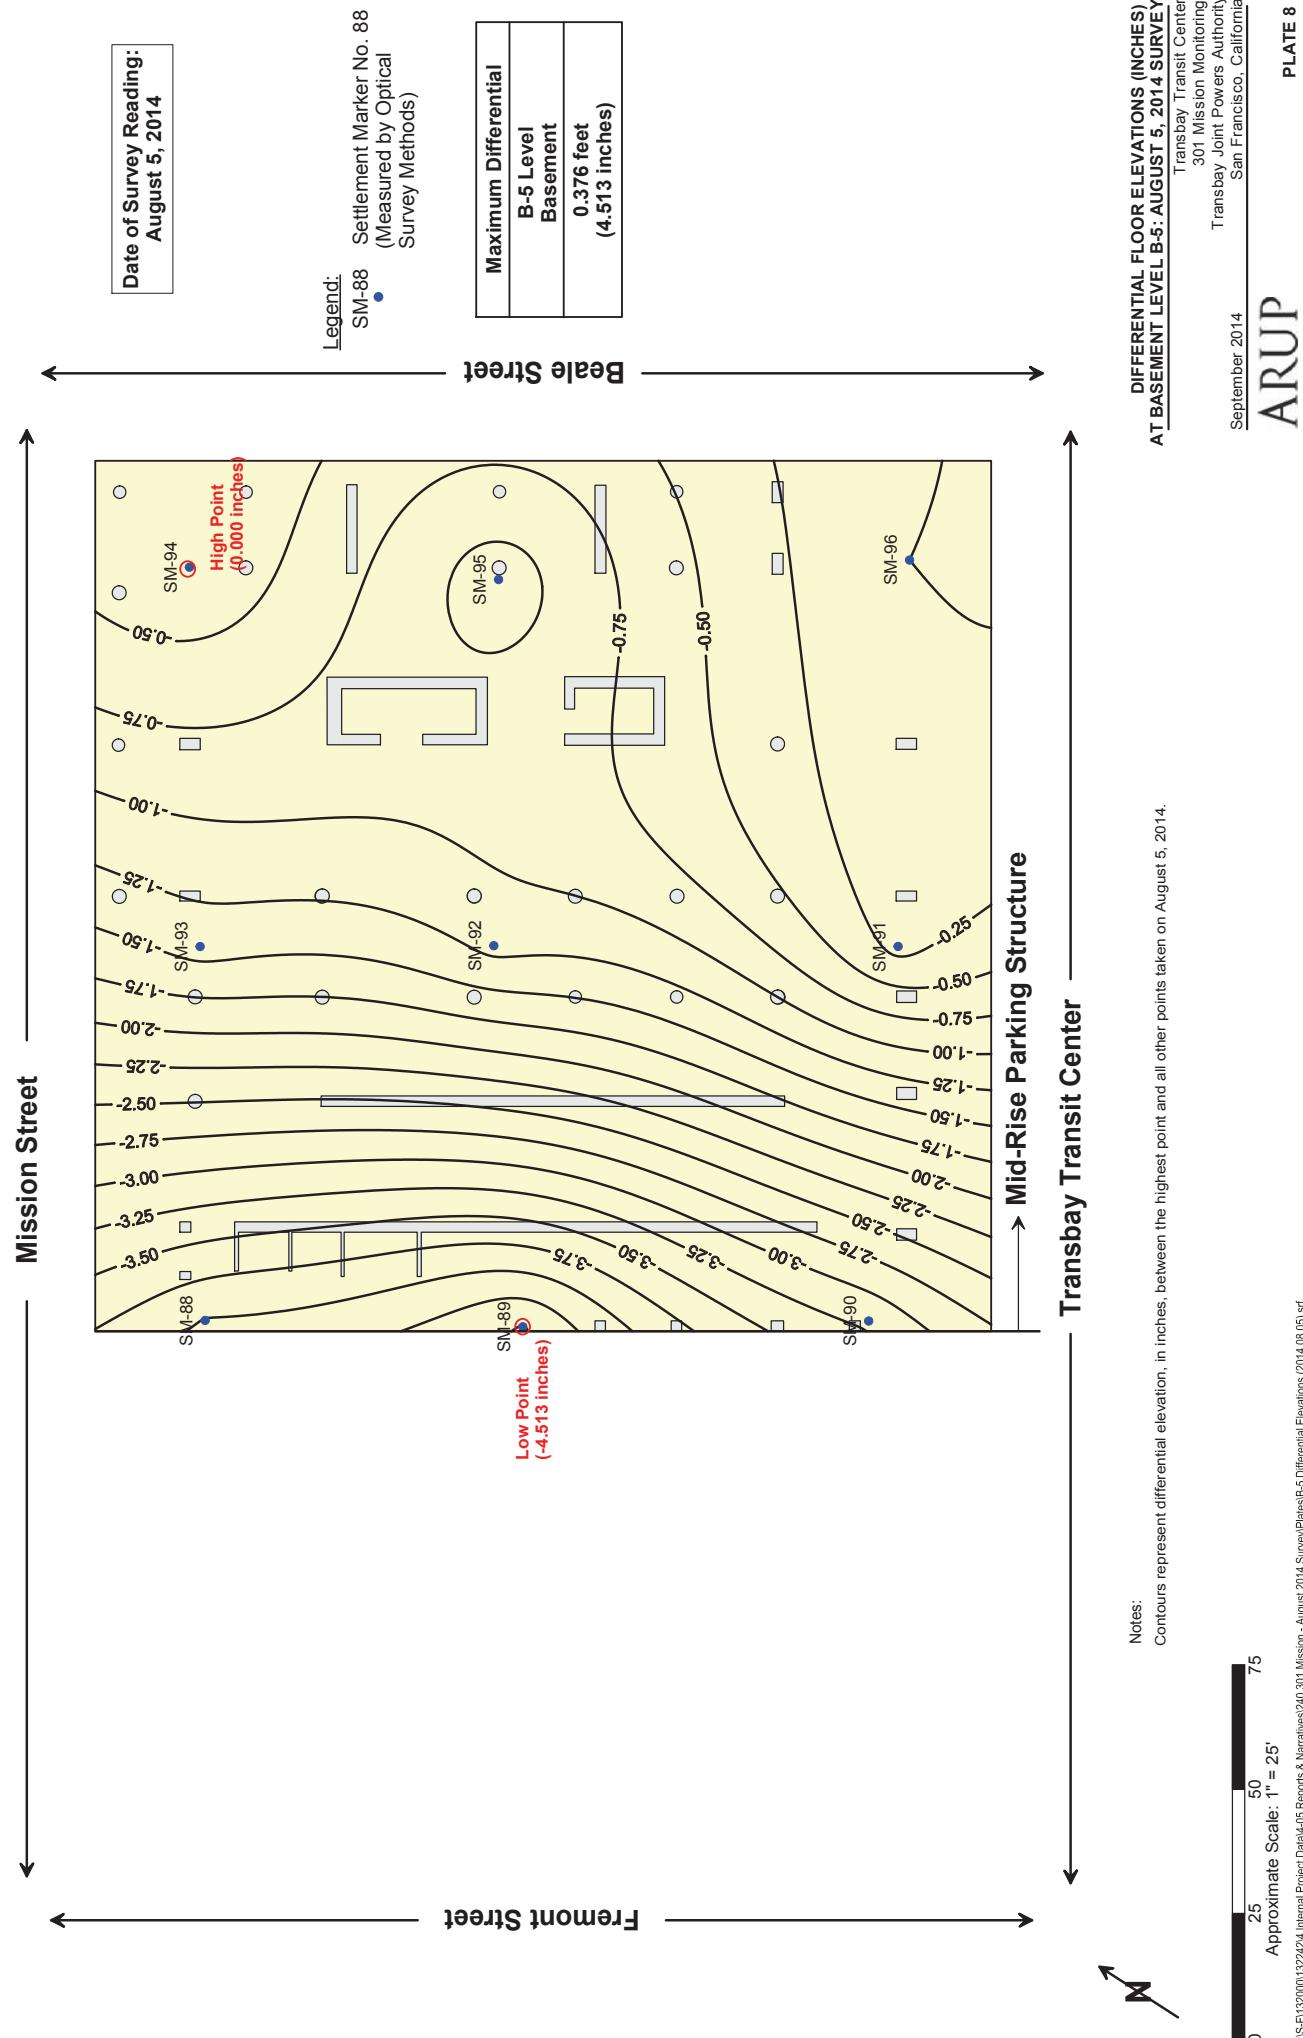

From: Brian Dykes
Sent: Thursday, December 18, 2014 3:40 PM
To: Steven Hood
Cc: Margie Cleland
Subject: FW: 301 Mission - October & December Survey

Steve,
Attached are the settlement survey results for October 21 and December 11, 2014.
Brian.

From: Stephen McLandrich [<mailto:stephen.mclandrich@arup.com>]
Sent: Thursday, December 11, 2014 12:12 PM
To: Brian Dykes
Cc: Dennis Turchon; 'rvolenec@pcparch.com' (rvolenec@pcparch.com); George Metzger; Nick O'Riordan; John Eddy
Subject: 301 Mission - October & December Survey

Brian,

Please find the attached survey memos for 301 Mission.

When I opened the file from the October memo to create this December memo, I noticed that the October memo was not pdf'd and therefore we did not transmit it to you. I am transmitting it now. I have kept the date as October 21, 2014.

Regarding inclinometers and piezometers, we continue to take periodic readings during the build-out. We are not regularly publishing these intermediate readings however, at your request, we will publish all readings since the last memo which was October 17, 2014.

Let me know if you have any questions.

Cheers,
Stephen

Stephen McLandrich PE GE
Senior Geotechnical Engineer

Arup
560 Mission Street Suite 700 San Francisco CA 94105 USA

t +1 415 957 9445 **d** +1 415 946 0245

f +1 415 957 9096 **c** +1 415 310 1095

www.arup.com

Check out our progress at <http://transbaycenter.org/construction-updates/construction-cameras>

NOTE: This e-mail communication and any attachments hereto are covered by the Electronic Communications Privacy Act, 18 U.S.C. Sections 2510-2521, and are legally privileged. The information contained herein is confidential, and is intended only for the use of the individual or entity to whom it is addressed. If you are not the intended recipient of this e-mail communication (or an employee or agent responsible for delivering this communication to its intended recipient(s)), you are hereby notified that any retention, copying or further distribution of this e-mail communication and any attachments is strictly prohibited. If you are not the intended recipient, please notify the sender by telephoning 415-597-4620, or by forwarding an e-mail reply message addressed to TransAdmin@TransbayCenter.org confirming that you have already destroyed (deleted) the original e-mail communication and any and all copies thereof. Thank you.

Memorandum


ARUP

To	Brian Dykes (TJPA)	Date
		October 21, 2014
Copies	Randy Volenec (PCPA) George Metzger (AAI)	Reference number 132242
From	Stephen McLandrich (Arup)	File reference 4-05 243
Subject	Transbay Transit Center: Results of October 2014 Settlement Survey at 301 Mission Property	Page 1 of 1

Under Arup's Geotechnical Contract with the Transbay Joint Powers Authority through Pelli Clark Pelli Architects, Arup is required to monitor the settlements of the buildings adjacent to the Transbay Transit Center prior to and during construction. We began the monitoring program for the 301 Mission property in April of 2009. This memorandum and the attached plates present an update to our memorandum dated September 4, 2014 with measurements made through October 2014.

List of Plates

- Plate 1 Floor Elevations at Level B-1 of 301 Mission Property: Periodic Survey – October 9, 2014
- Plate 2 Differential Floor Elevation (Inches) October 9, 2014 Survey
- Plate 3 Contours of Settlements Measured at the 1st Level Basement of the 301 Mission St. Structure Between 04/30/2009 & 10/9/2014
- Plate 4 Settlement Over Time Floor Elevations at Level B-1 of 301 Mission Property – Tower: April 30, 2009 through October 9, 2014
- Plate 5 Settlement Over Time Floor Elevations at Level B-1 of 301 Mission Property – Mid-Rise: April 30, 2009 through October 9, 2014
- Plate 6 Settlements of the 301 Mission Tower Including Monitoring During Construction
- Plate 7 Floor Elevation at Basement Level B-5 of 301 Mission Property: October 9, 2014 Survey
- Plate 8 Differential Floor Elevations (Inches) at Basement Level B-5: October 9, 2014 Survey

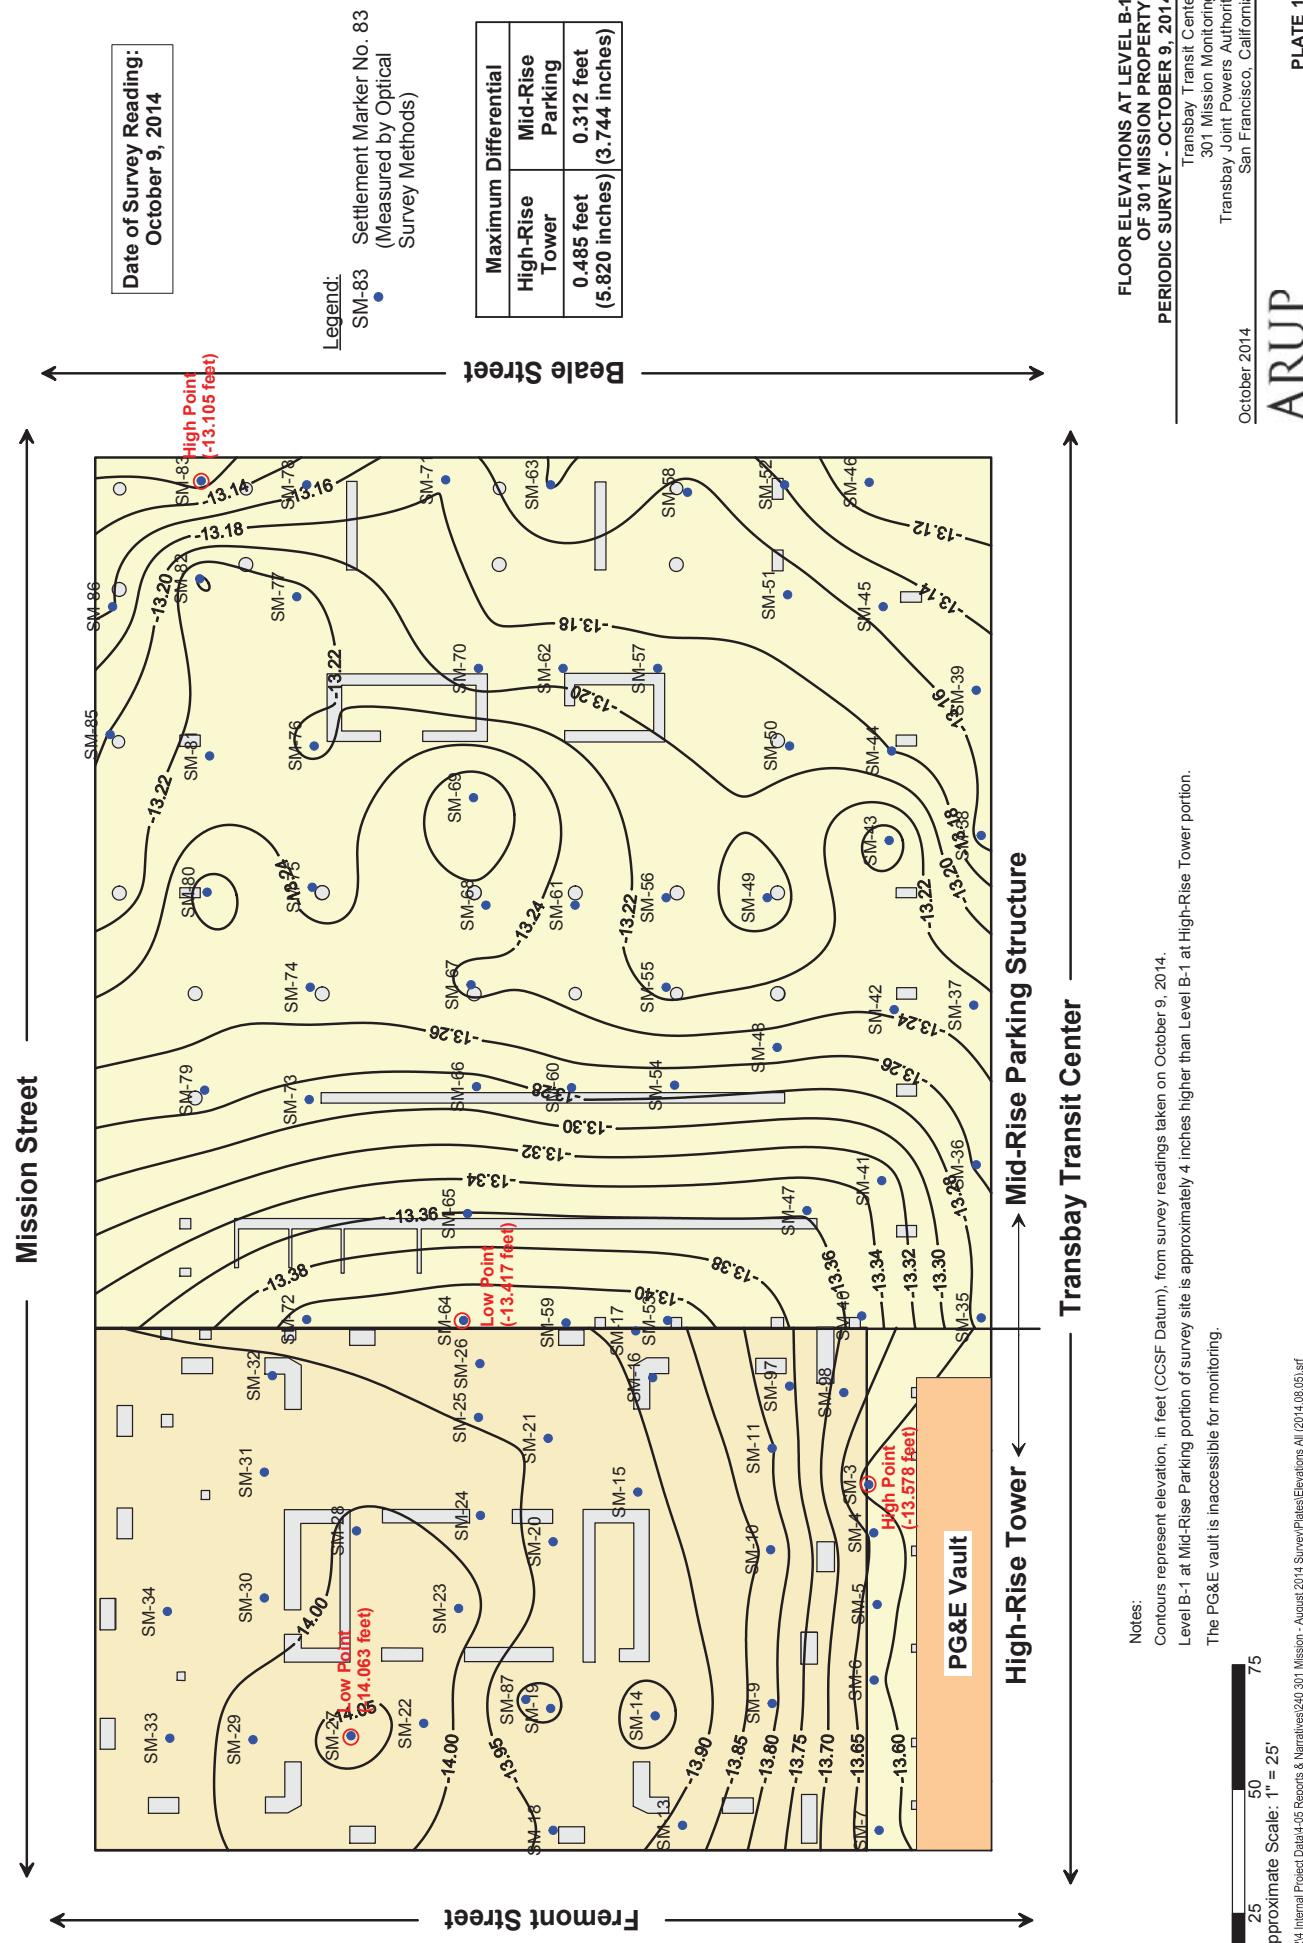

JISF120000132242 Internal Project Data4-05 Reports & Narratives\240 301 Mission - August 2014 Survey\Plots\Elevations All (2014.08.05).srf

Approximate Scale: 1" = 25'

25 50 75

0

**FLOOR ELEVATIONS AT LEVEL B-1
OF 301 MISSION PROPERTY
PERIODIC SURVEY - OCTOBER 9, 2014**

Transbay Transit Center
301 Mission Monitoring
Transbay Joint Powers Authority
San Francisco, California


ARUP

October 2014


DIFFERENTIAL FLOOR ELEVATIONS (INCHES)
OCTOBER 9, 2014 SURVEY
Transbay Transit Center
301 Mission Monitoring
Transbay Joint Powers Authority
San Francisco, California

U.S. F112000113224 Internal Project Data4.05 Reports & Narratives\240301 Mission - August 2014\08\05.spt

Legend:
SM-83 Settlement Marker No. 83
(Measured by Optical Survey Methods)

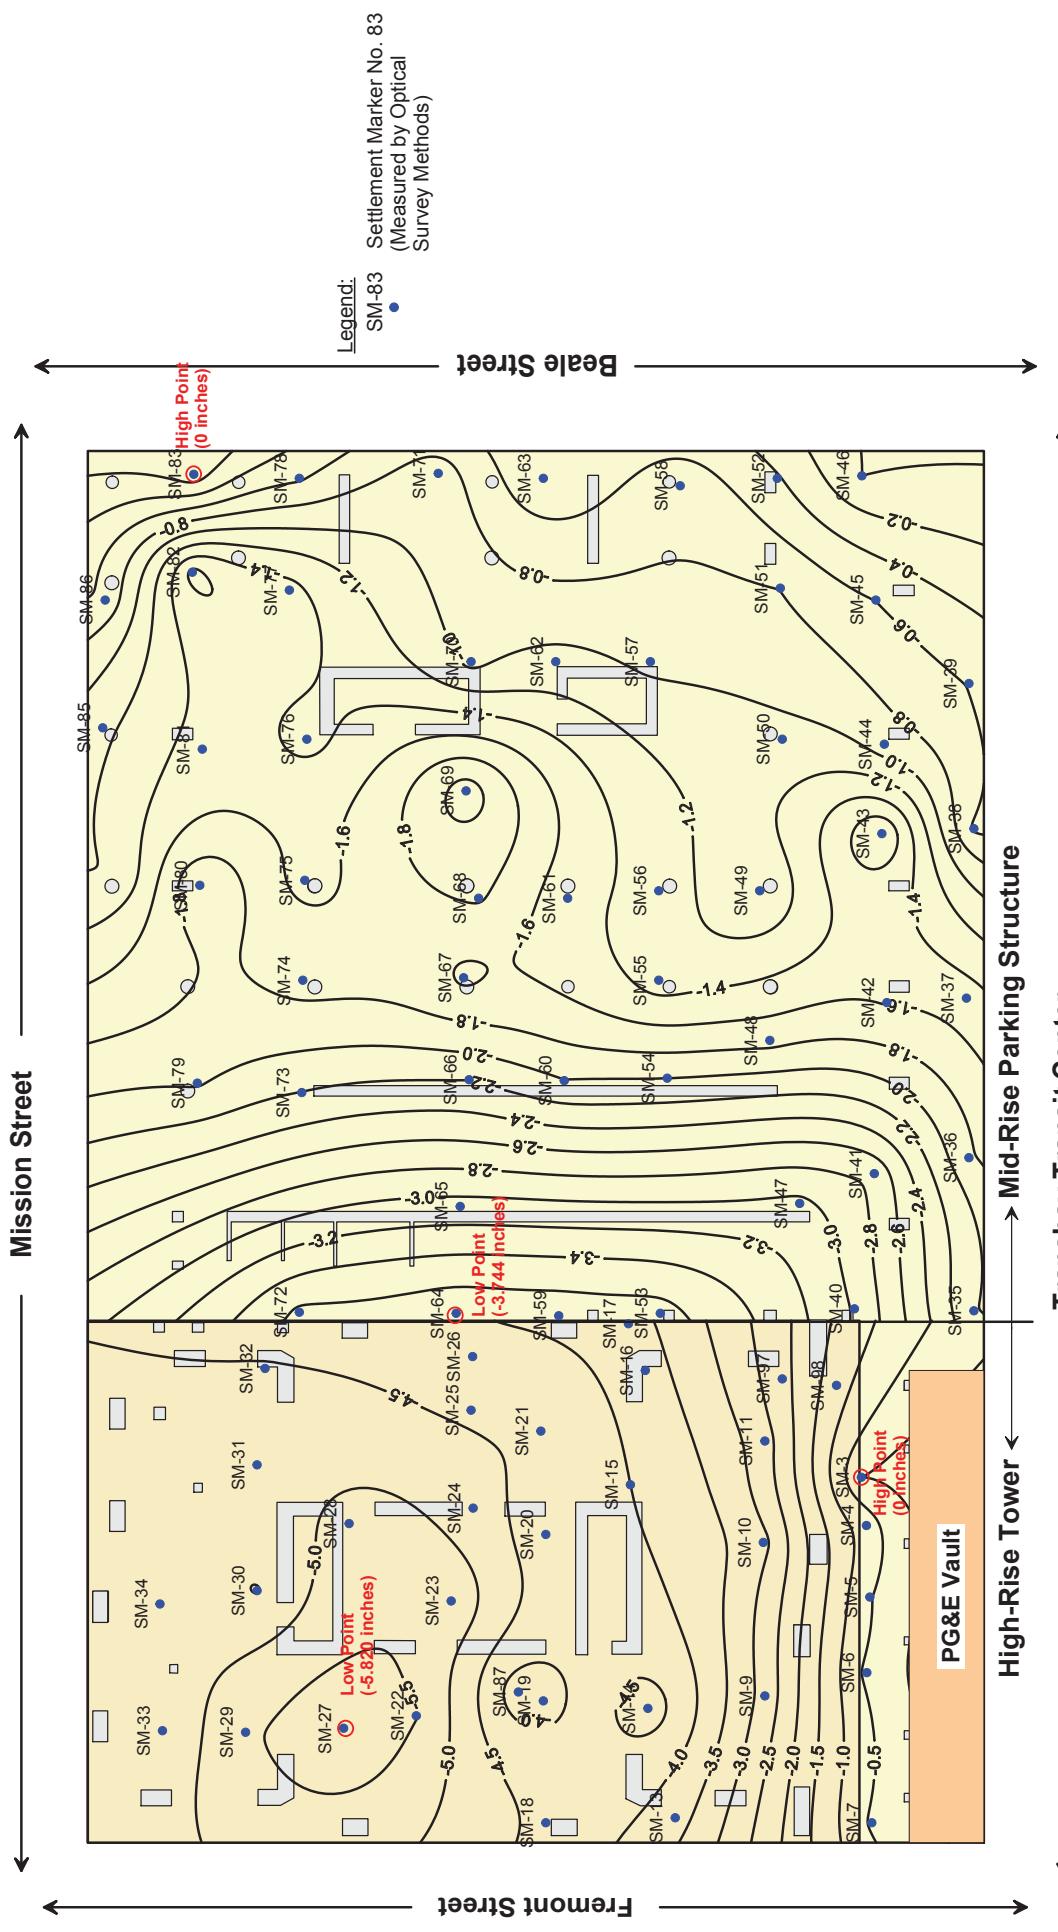

ARUP

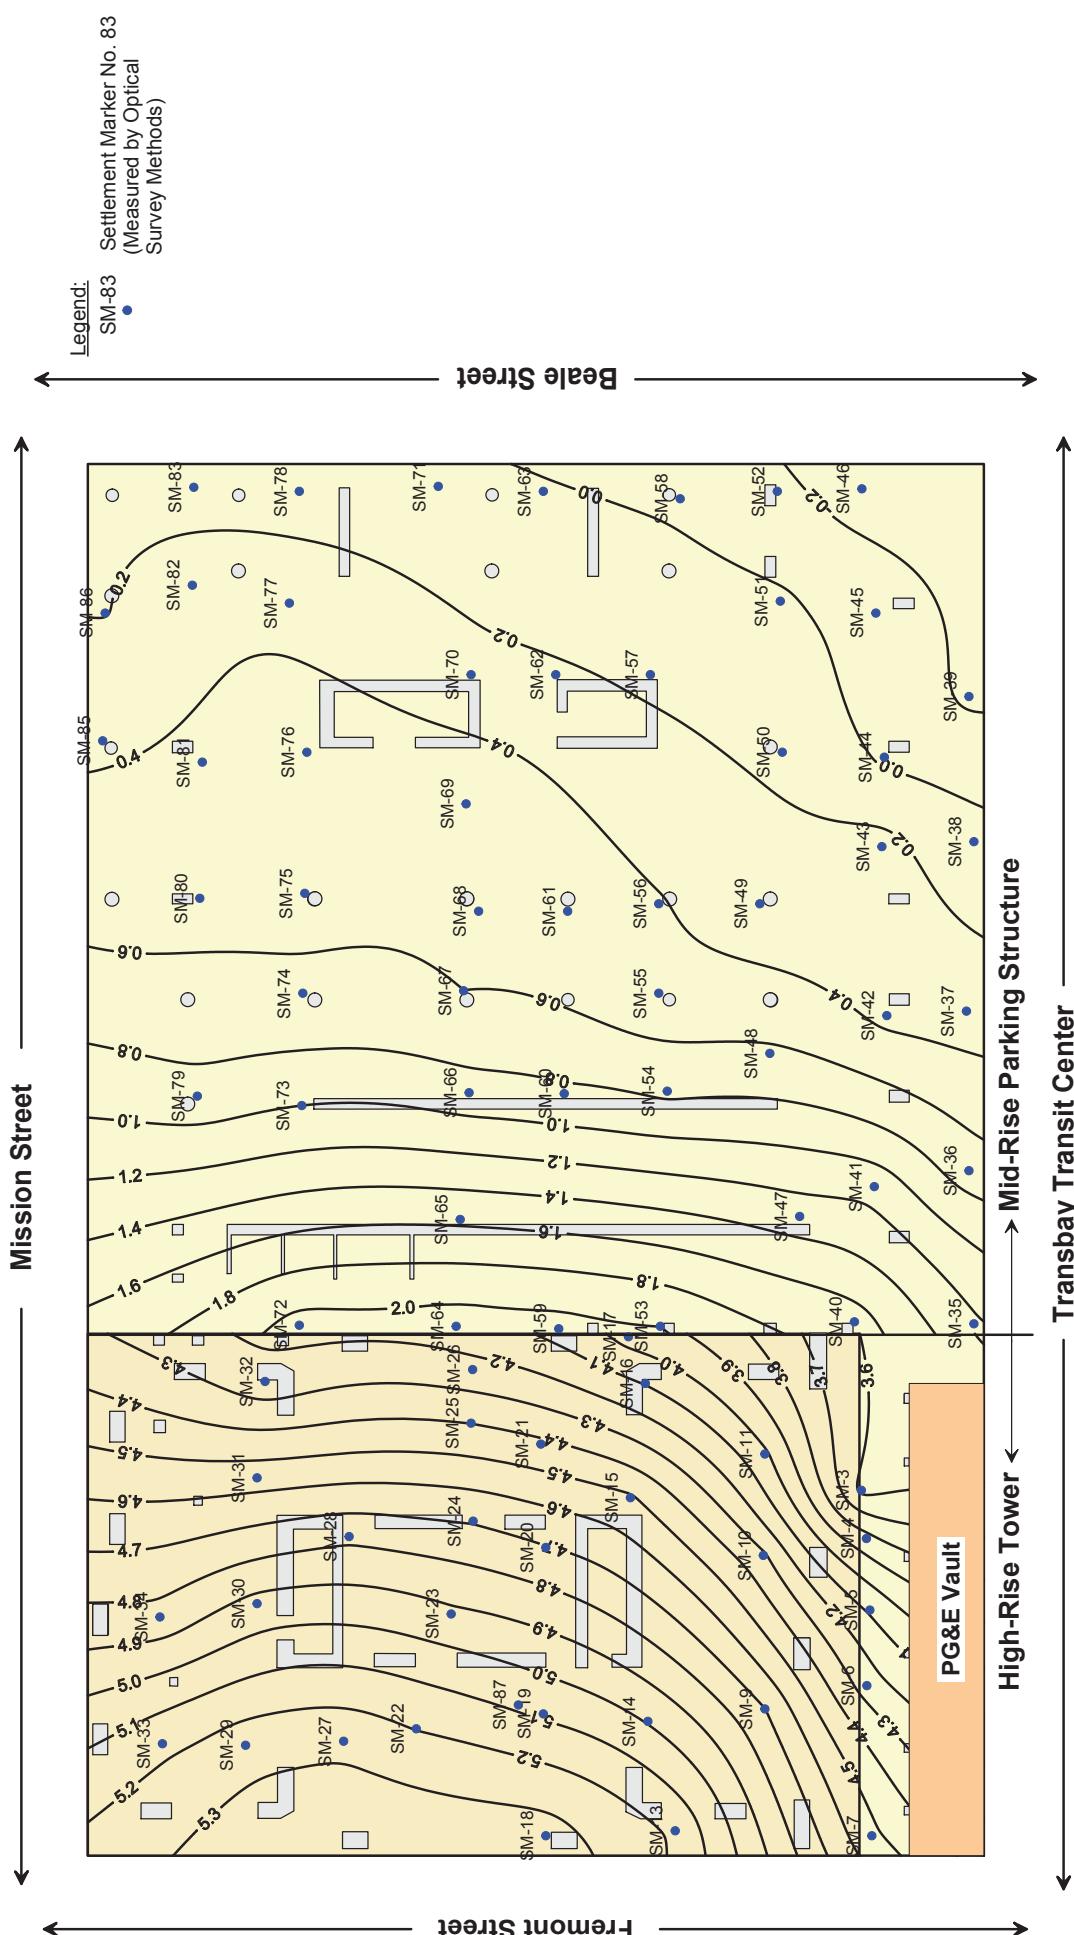

CONTOURS OF SETTLEMENTS MEASURED AT THE 1ST LEVEL BASEMENT OF THE 301 MISSION ST STRUCTURE BETWEEN 04/30/2009 & 10/9/2014

Transbay Transit Center
301 Mission Monitoring
Transbay Joint Powers Authority
San Francisco, California

October 2014

JJS-F132000132424 Internal Project Data405 Reports & Narratives\201 Mission - August 2014 Survey\Plates\Elevation changes All\2014.08.05.srf

Approximate Scale: 1" = 25'

0 25 50 75

ARUP

Note:
Initial (Baseline) reading
taken on 04/30/09



**SETTLEMENT OVER TIME
FLOOR ELEVATIONS AT LEVEL B-1
OF 301 MISSION PROPERTY - TOWER:
APRIL 30, 2009 THROUGH OCTOBER 9, 2014**

Transbay Transit Center
301 Mission Monitoring
Transbay Joint Powers Authority
San Francisco, California

Time From Start of Monitoring, Days


0 250 500 750 1,000 1,250 1,500 1,750 2,000 2,250

SM-3
SM-9
SM-14
SM-27

-4.0 -3.0 -2.0 -1.0 0.0

Settlement, inches

TOWER

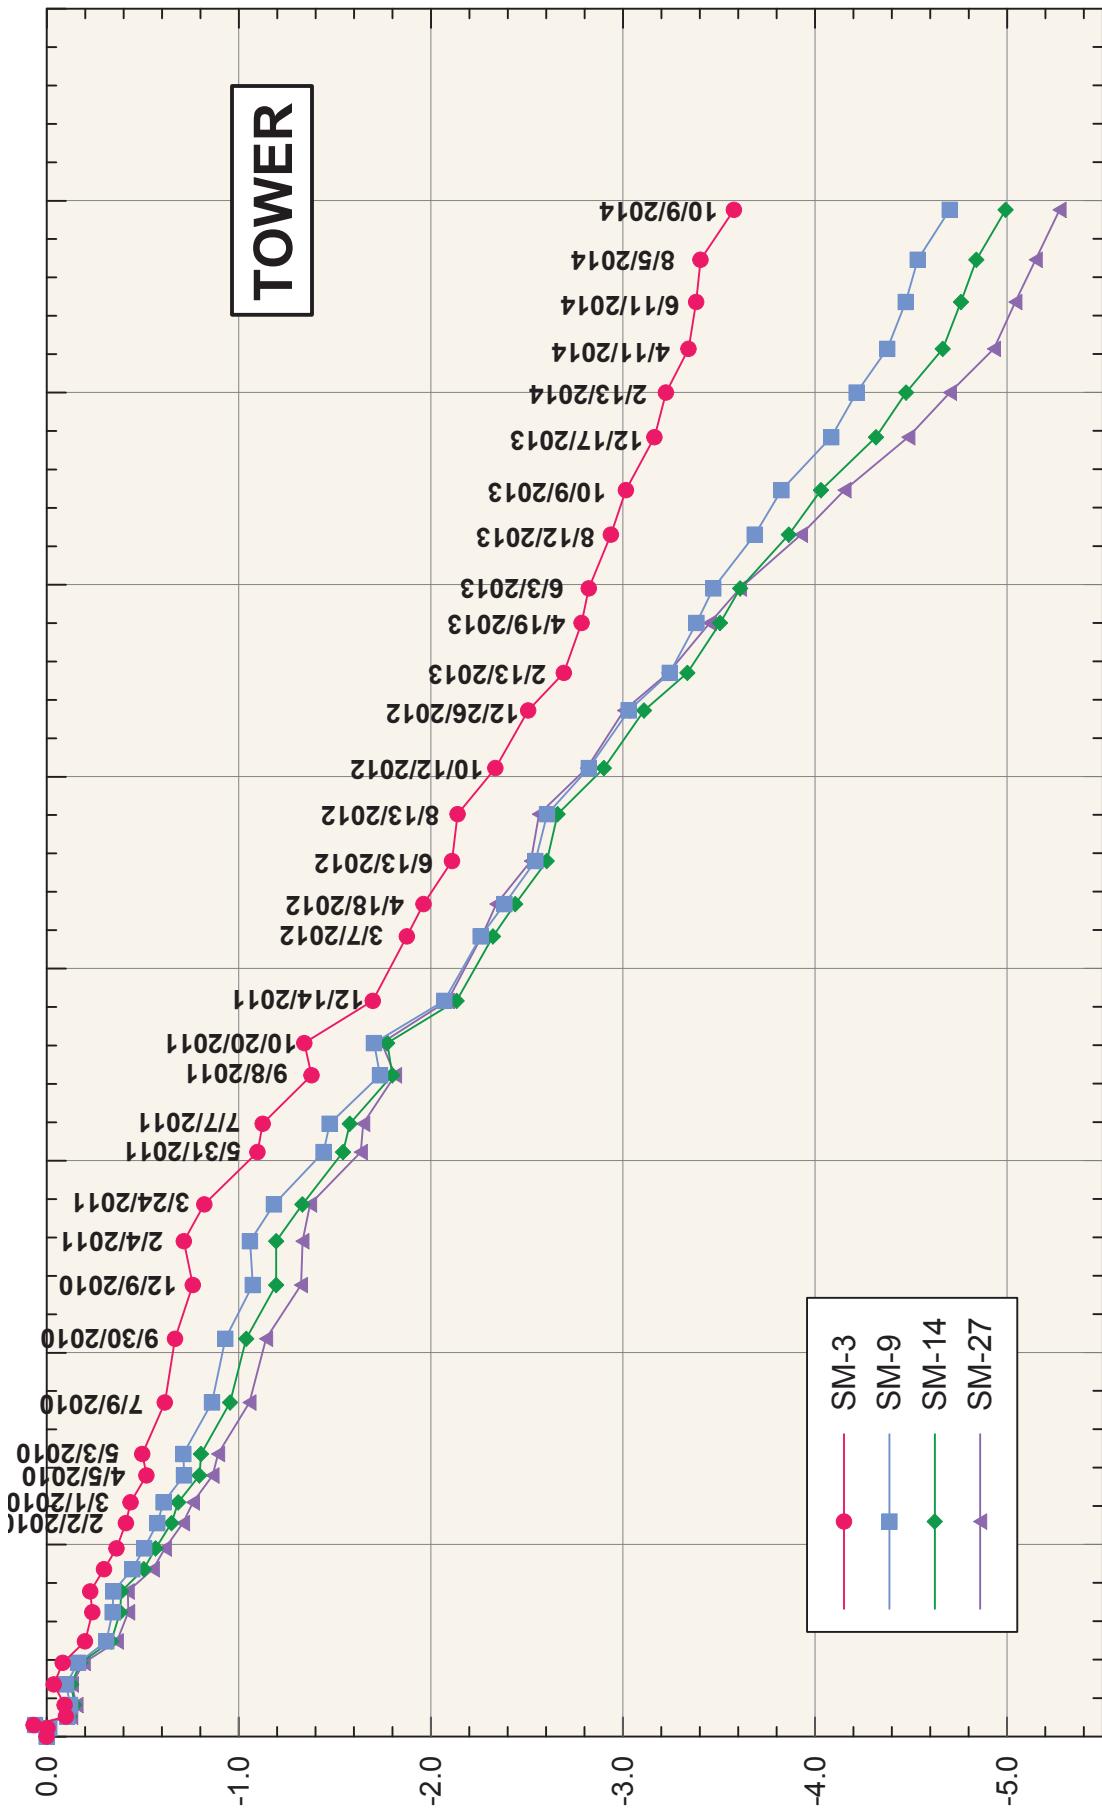



ARUP


Note:
Initial (Baseline) reading
taken on 04/30/09

J:\\S:\\FV\\13224214 Internal Project Data\\4-05 Reports & Narratives\\243 301 Mission - October 2014 Survey\\Plate 5 Settlement Over Time - Midrise.grf

**SETTLEMENT OVER TIME
FLOOR ELEVATIONS AT LEVEL B-1
OF 301 MISSION PROPERTY - MID-RISE:
APRIL 30, 2009 THROUGH OCTOBER 9, 2014**

Transbay Transit Center
301 Mission Monitoring
Transbay Joint Powers Authority
San Francisco, California

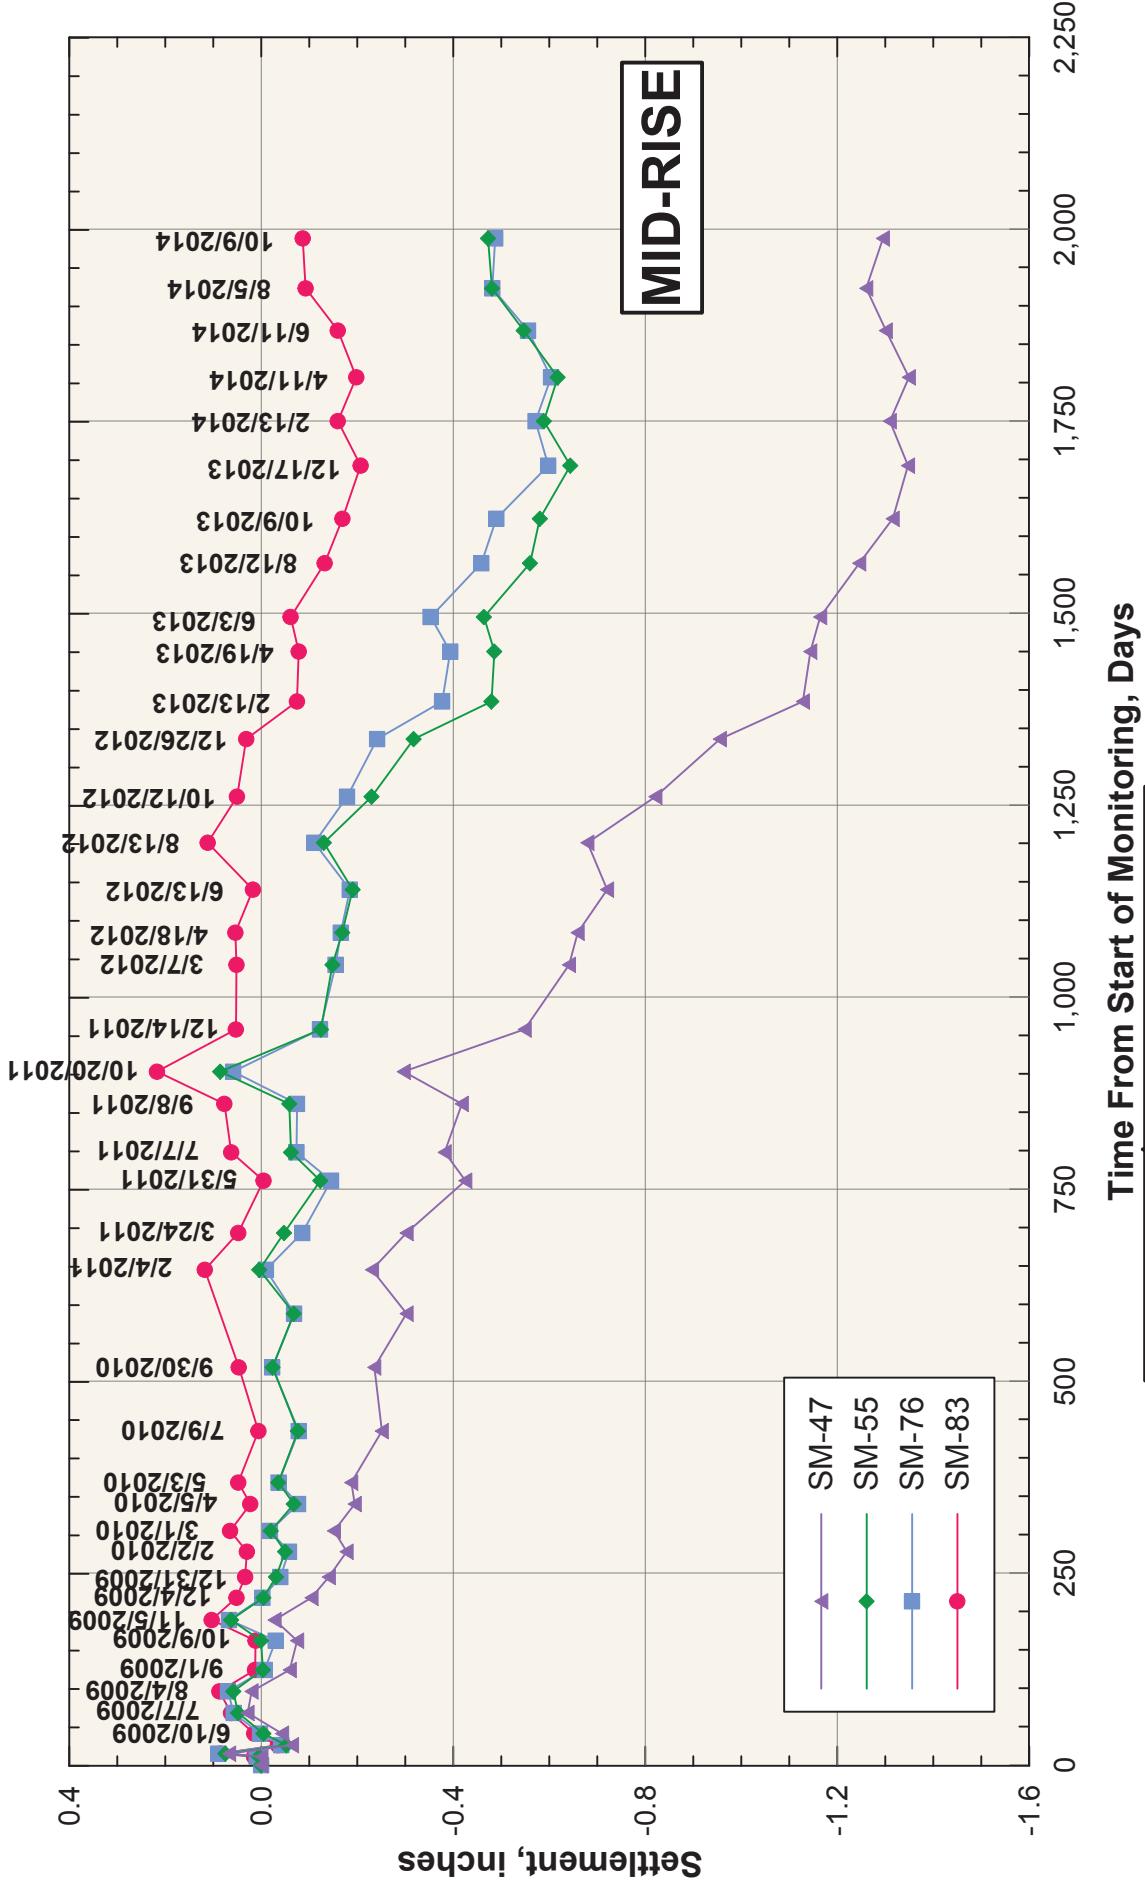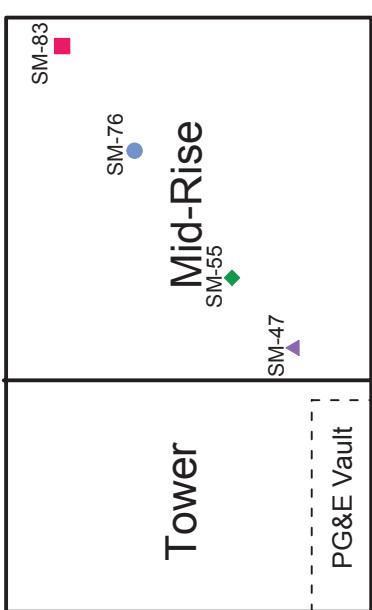

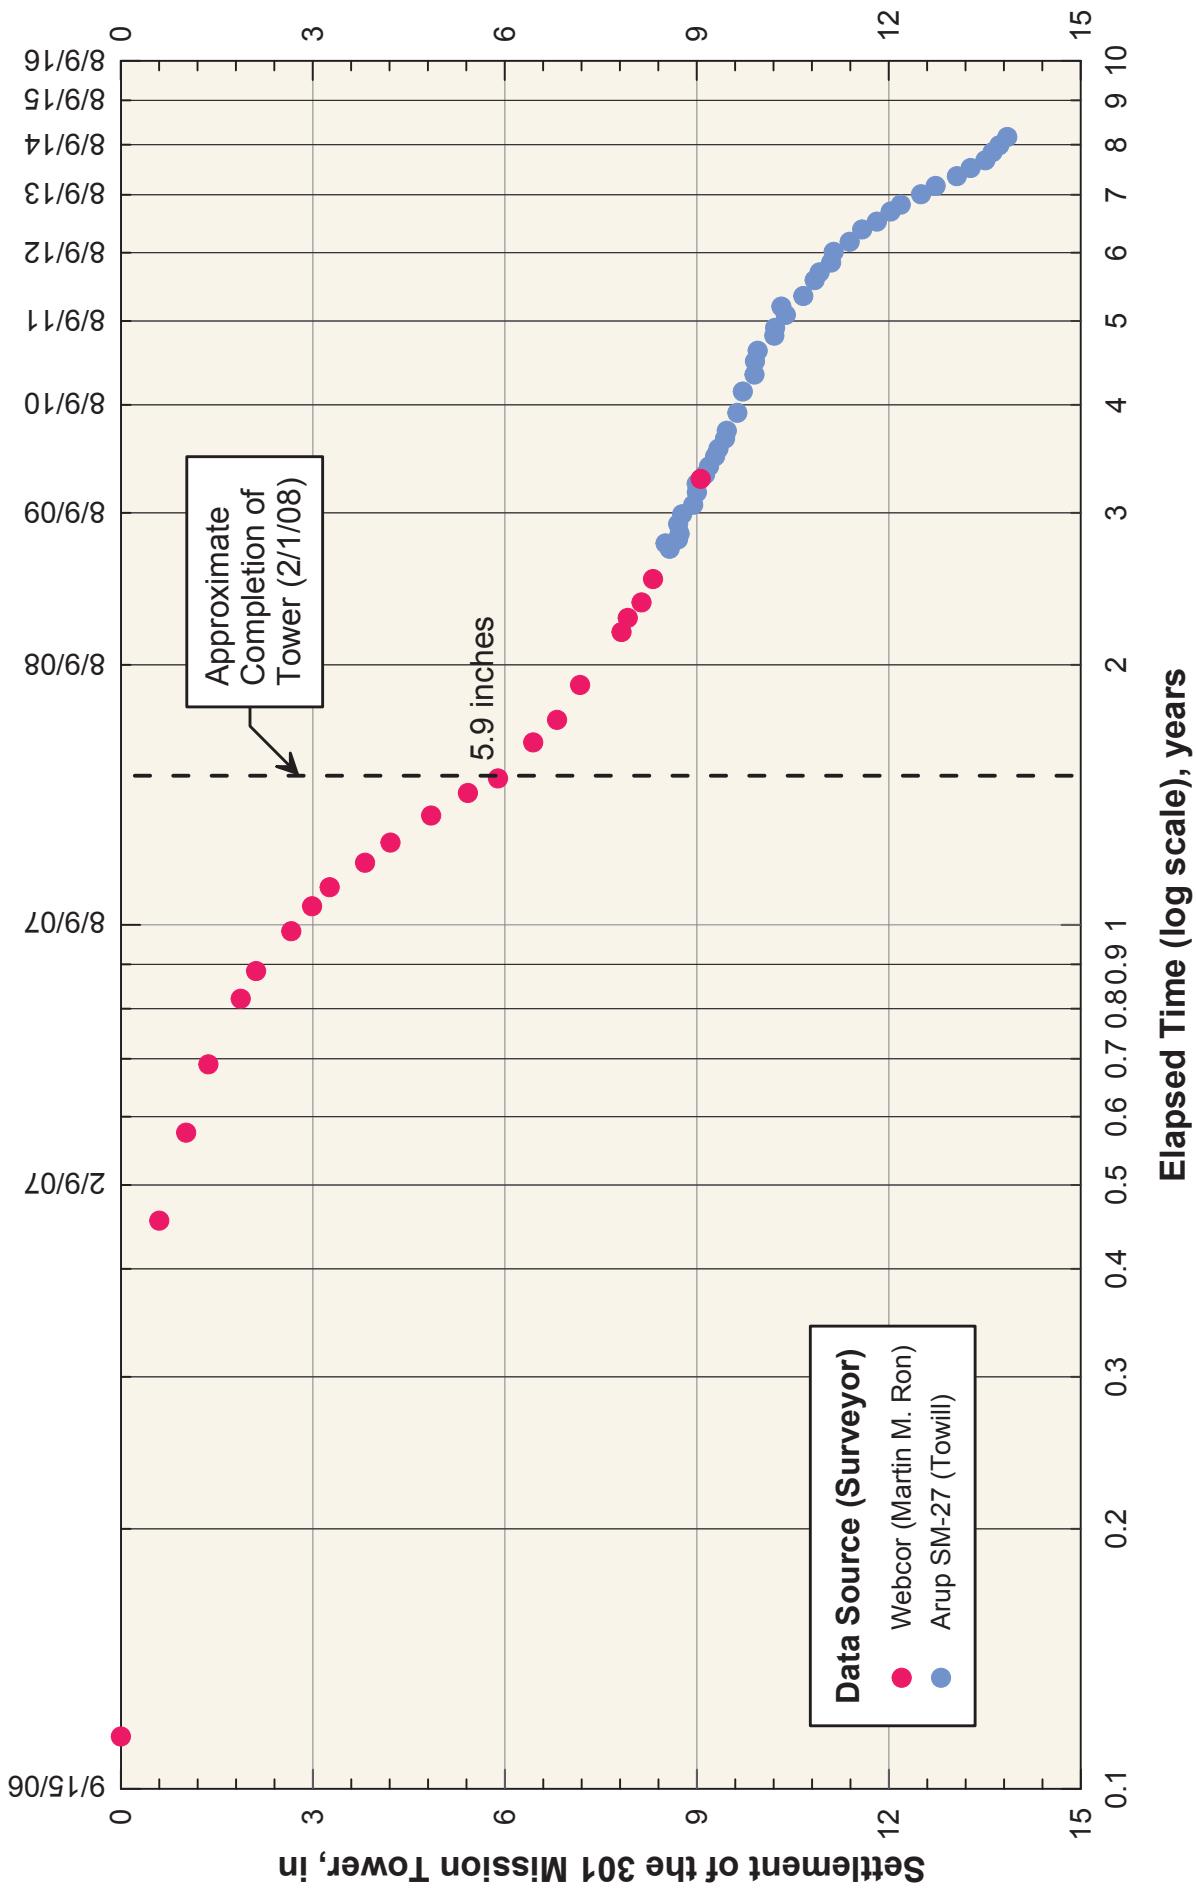



SETTLEMENTS OF THE 301 MISSION TOWER INCLUDING MONITORING DURING CONSTRUCTION

Transbay Transit Center
301 Mission Monitoring
Transbay Joint Powers Authority
San Francisco, California

October 2014

Beginning of Tower Construction: 8/9/06
End of Tower Construction: 2/1/08
Construction Duration: 542 days (1.5 years)

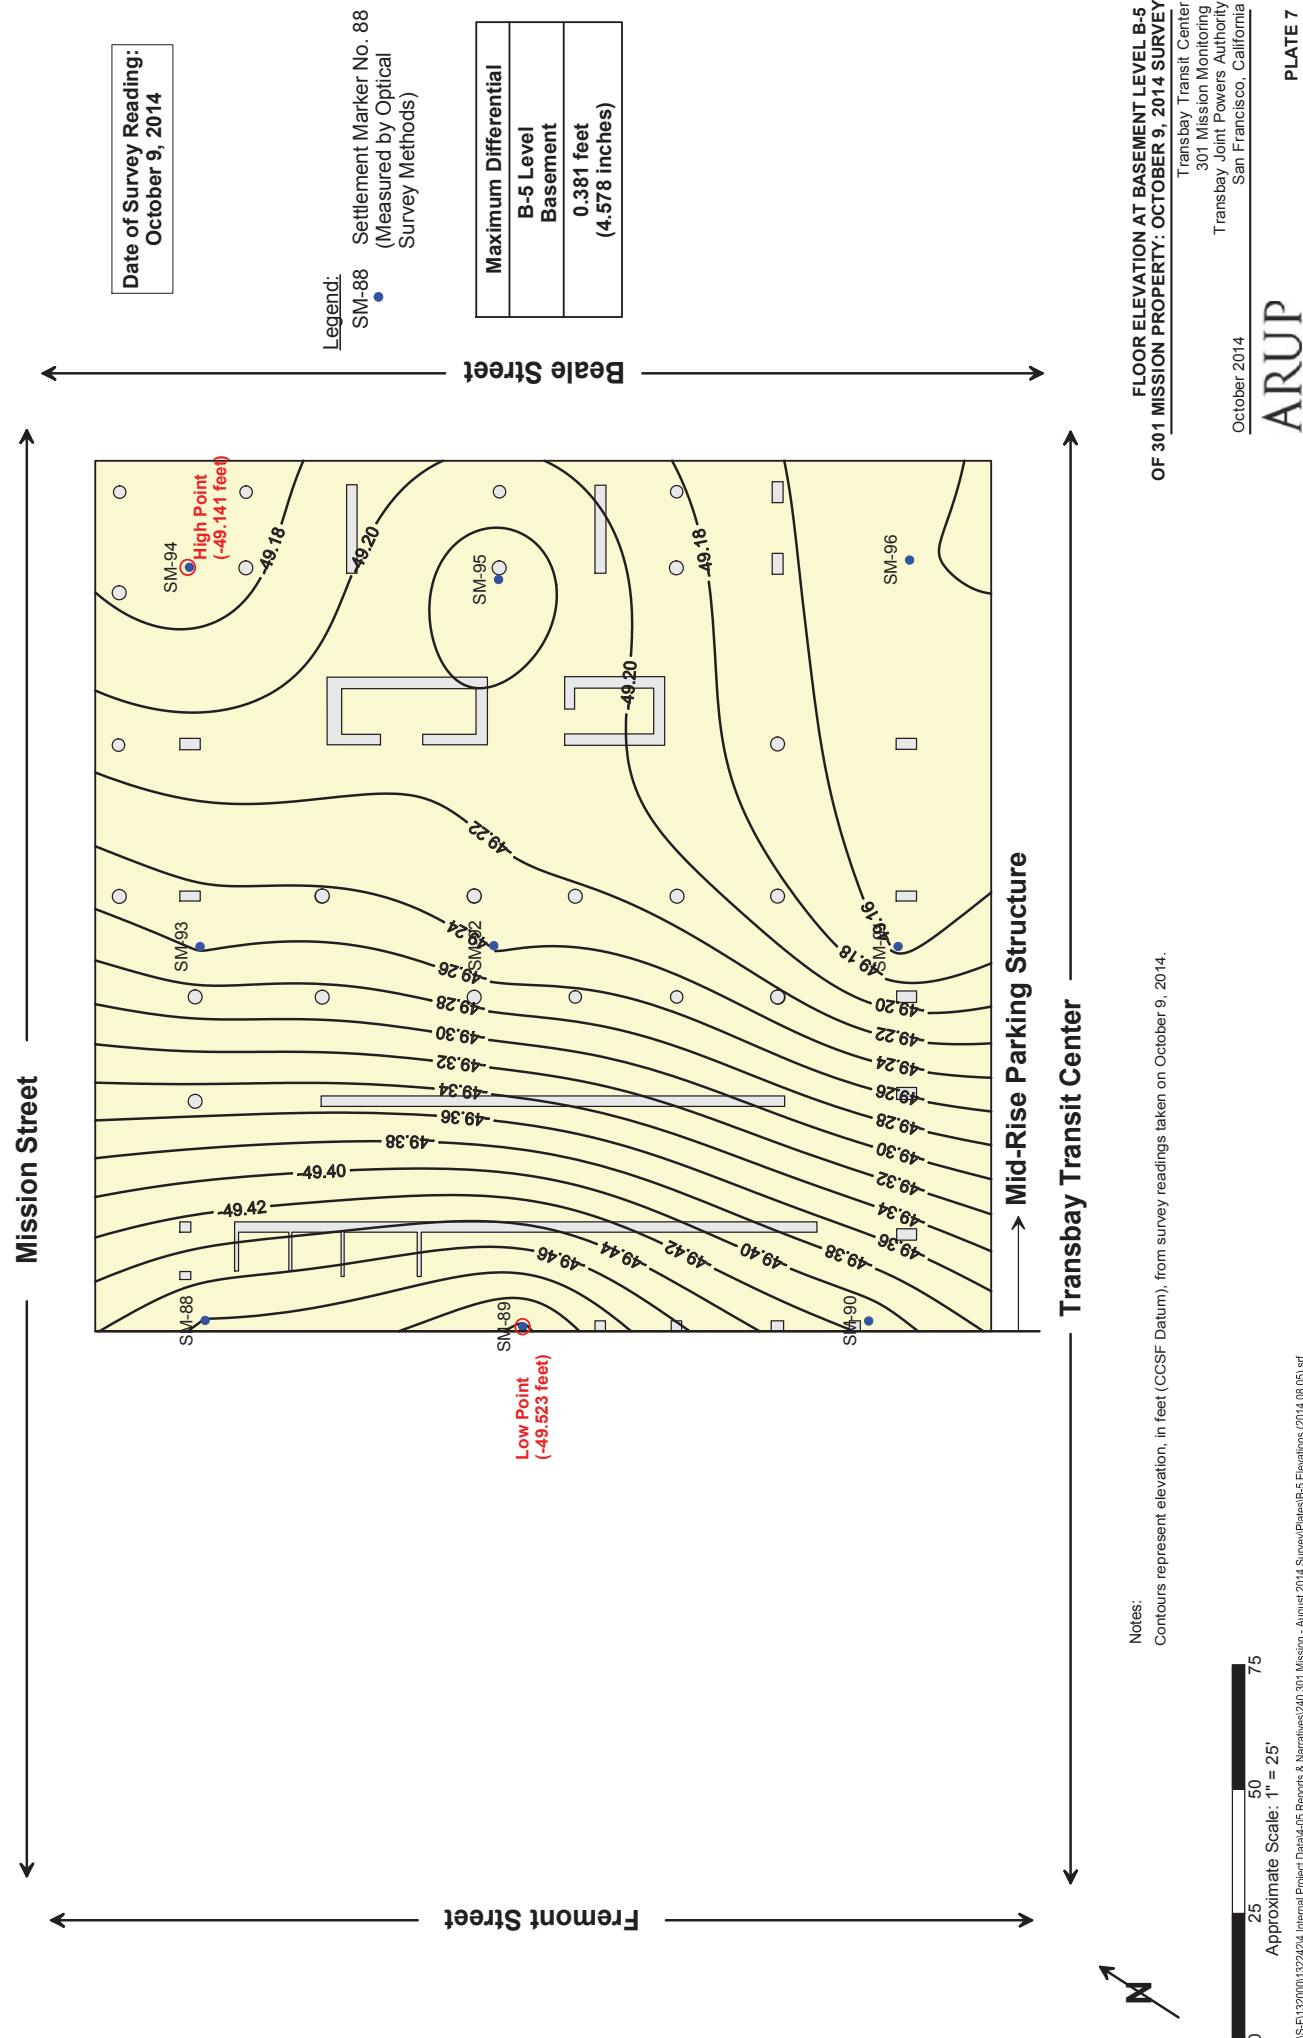

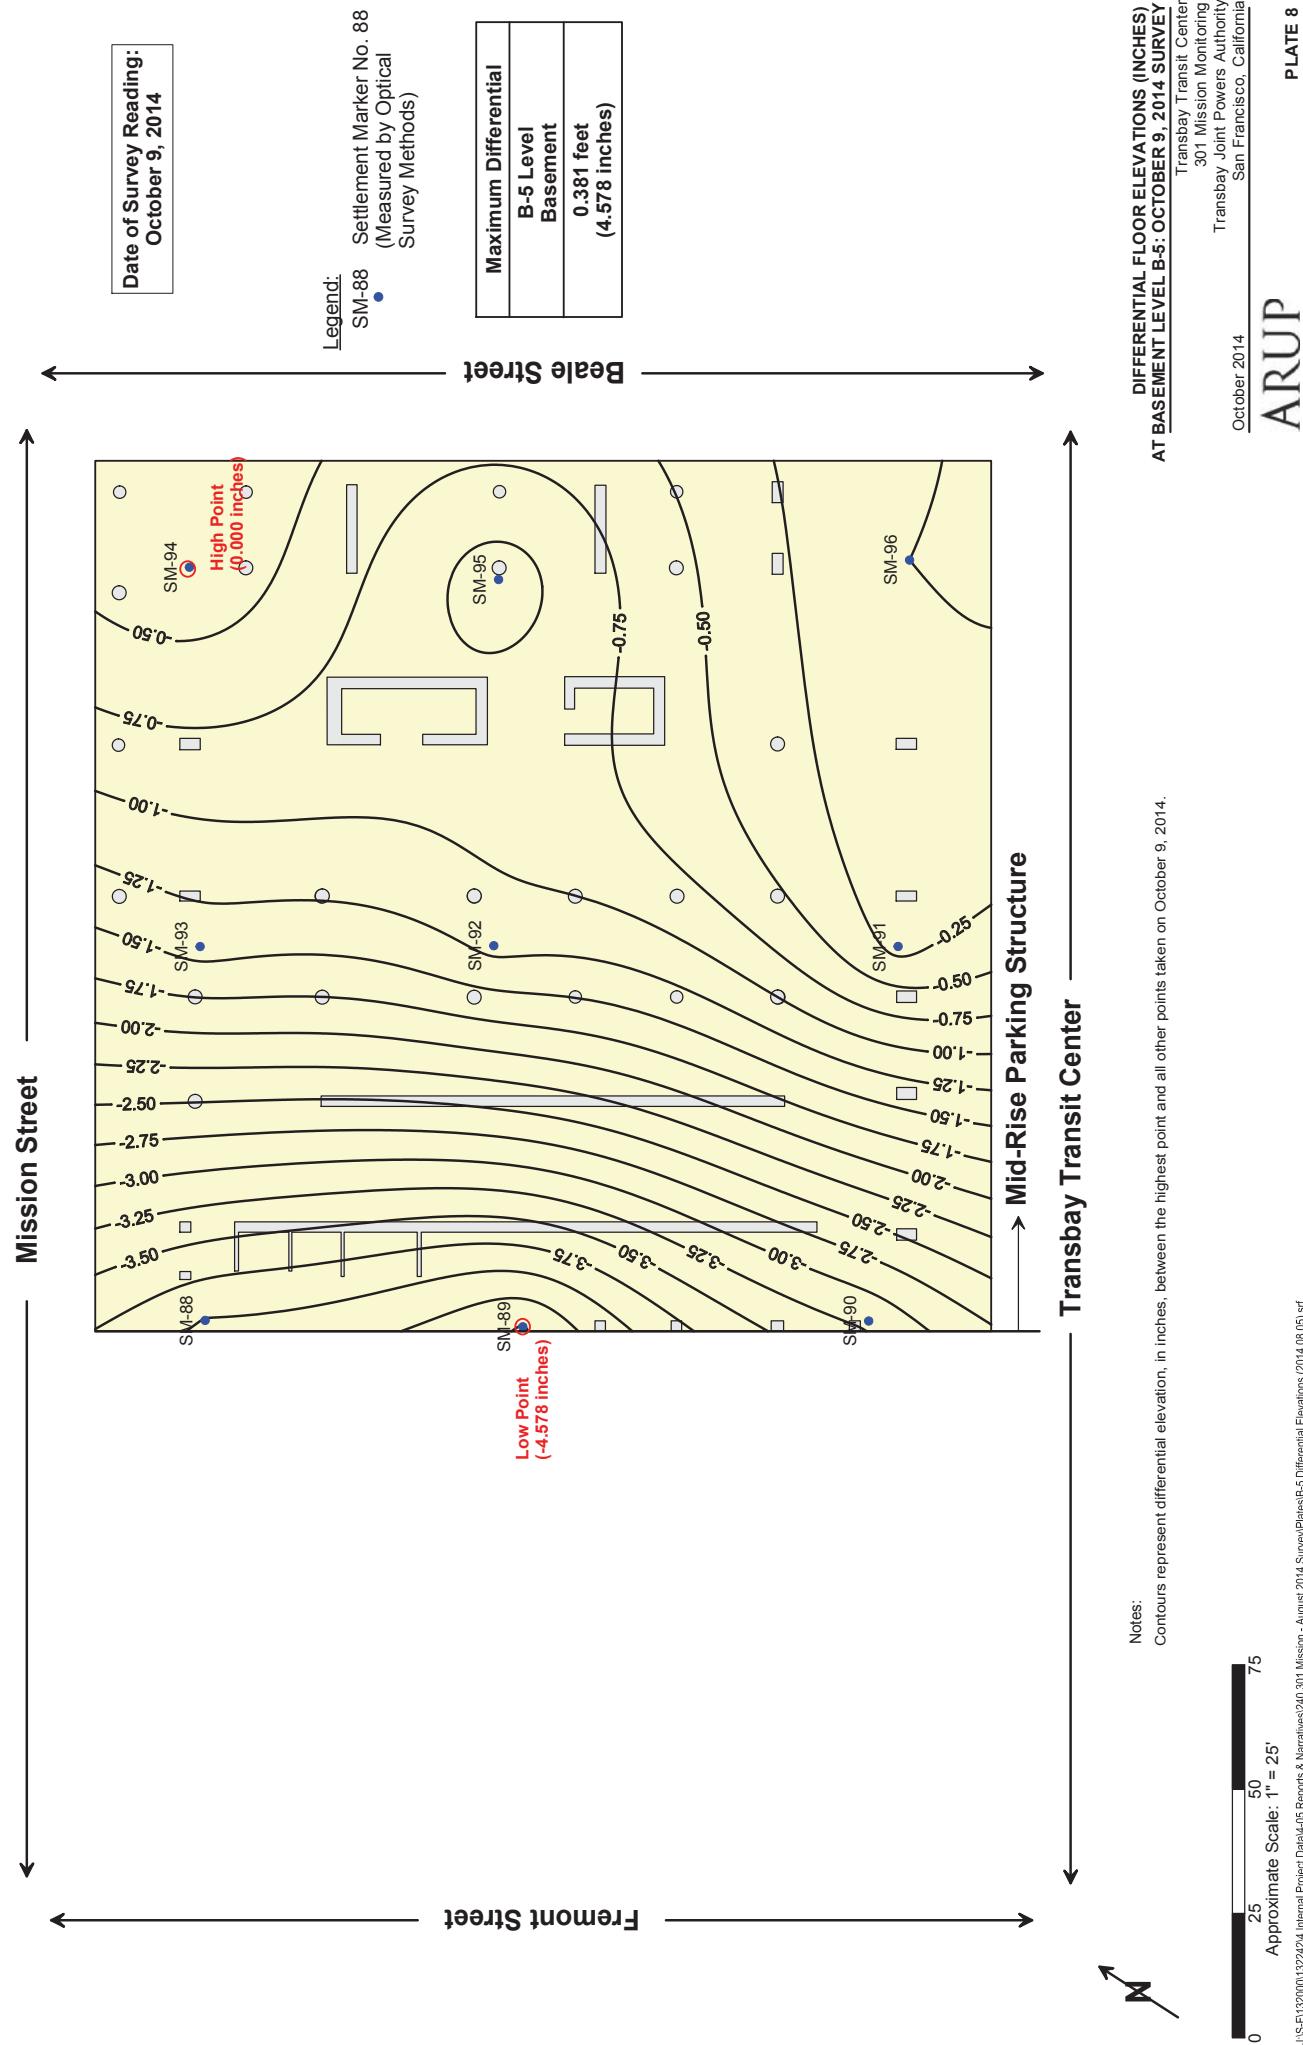

Memorandum


ARUP

To	Brian Dykes (TJPA)	Date
		December 11, 2014
Copies	Randy Volenec (PCPA) George Metzger (AAI)	Reference number 132242
From	Stephen McLandrich (Arup)	File reference 4-05 243
Subject	Transbay Transit Center: Results of December 2014 Settlement Survey at 301 Mission Property	Page 1 of 1

Under Arup's Geotechnical Contract with the Transbay Joint Powers Authority through Pelli Clark Pelli Architects, Arup is required to monitor the settlements of the buildings adjacent to the Transbay Transit Center prior to and during construction. We began the monitoring program for the 301 Mission property in April of 2009. This memorandum and the attached plates present an update to our memorandum dated October 21, 2014 with measurements made through December 2014.

List of Plates

- Plate 1 Floor Elevations at Level B-1 of 301 Mission Property: Periodic Survey – December 3, 2014
- Plate 2 Differential Floor Elevation (Inches) December 3, 2014 Survey
- Plate 3 Contours of Settlements Measured at the 1st Level Basement of the 301 Mission St. Structure Between 04/30/2009 & 12/3/2014
- Plate 4 Settlement Over Time Floor Elevations at Level B-1 of 301 Mission Property – Tower: April 30, 2009 through December 3, 2014
- Plate 5 Settlement Over Time Floor Elevations at Level B-1 of 301 Mission Property – Mid-Rise: April 30, 2009 through December 3, 2014
- Plate 6 Settlements of the 301 Mission Tower Including Monitoring During Construction
- Plate 7 Floor Elevation at Basement Level B-5 of 301 Mission Property: December 3, 2014 Survey
- Plate 8 Differential Floor Elevations (Inches) at Basement Level B-5: December 3, 2014 Survey

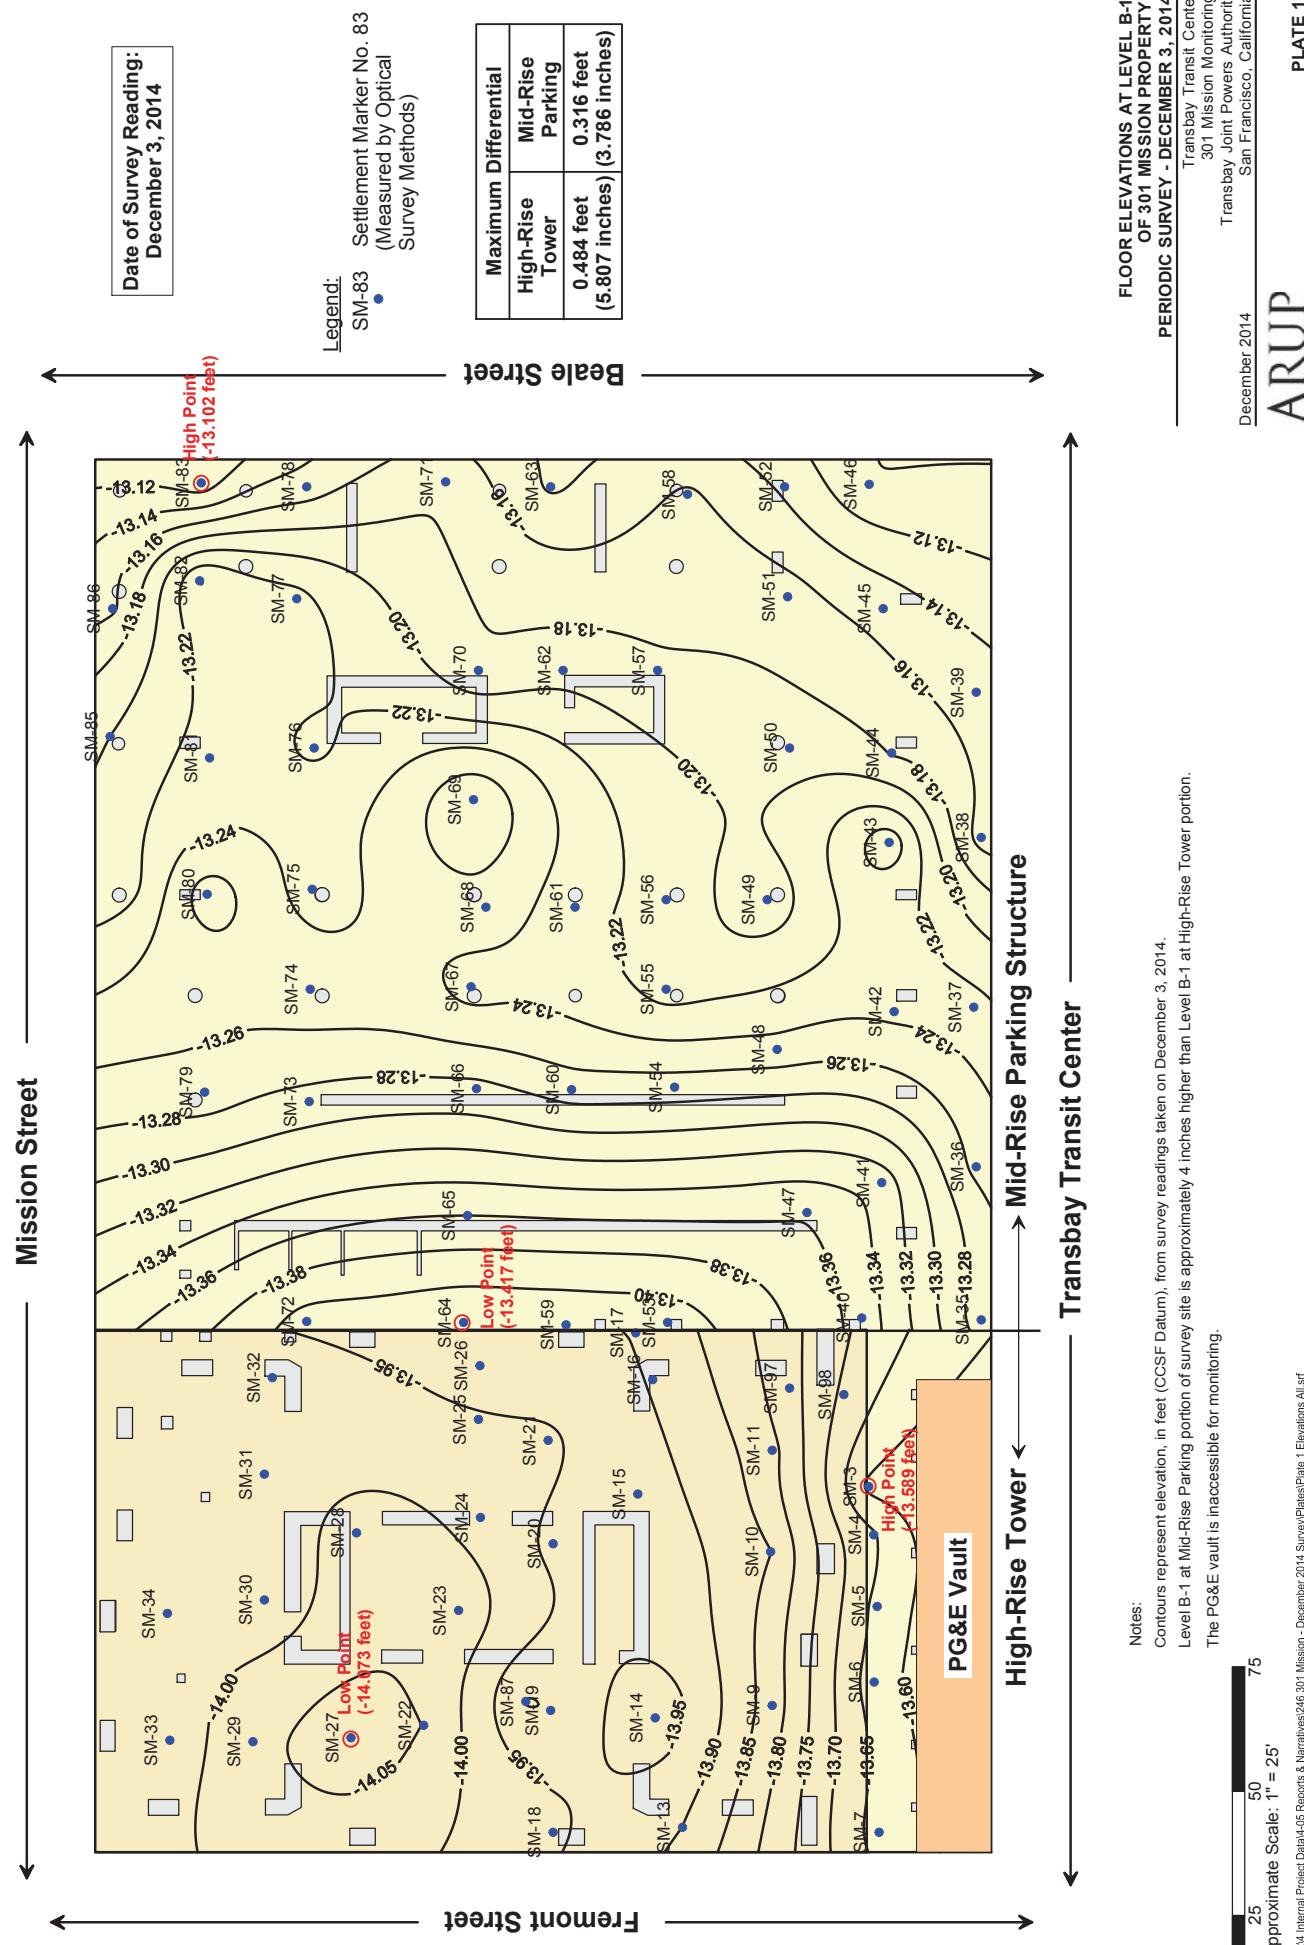


**FLOOR ELEVATIONS AT LEVEL B-1
OF 301 MISSION PROPERTY
PERIODIC SURVEY - DECEMBER 3, 2014**

Transbay Transit Center
301 Mission Monitoring
Transbay Joint Powers Authority
San Francisco, California

December 2014

Notes:
 Contours represent elevation, in feet (CCSF Datum), from survey readings taken on December 3, 2014.
 Level B-1 at Mid-Rise Parking portion of survey site is approximately 4 inches higher than Level B-1 at High-Rise Tower portion.
 The PG&E vault is inaccessible for monitoring.

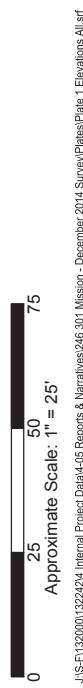


ARUP

**DIFFERENTIAL FLOOR ELEVATIONS (INCHES)
DECEMBER 3, 2014 SURVEY**

Transbay Transit Center
301 Mission Monitoring
Transbay Joint Powers Authority
San Francisco, California


December 2014

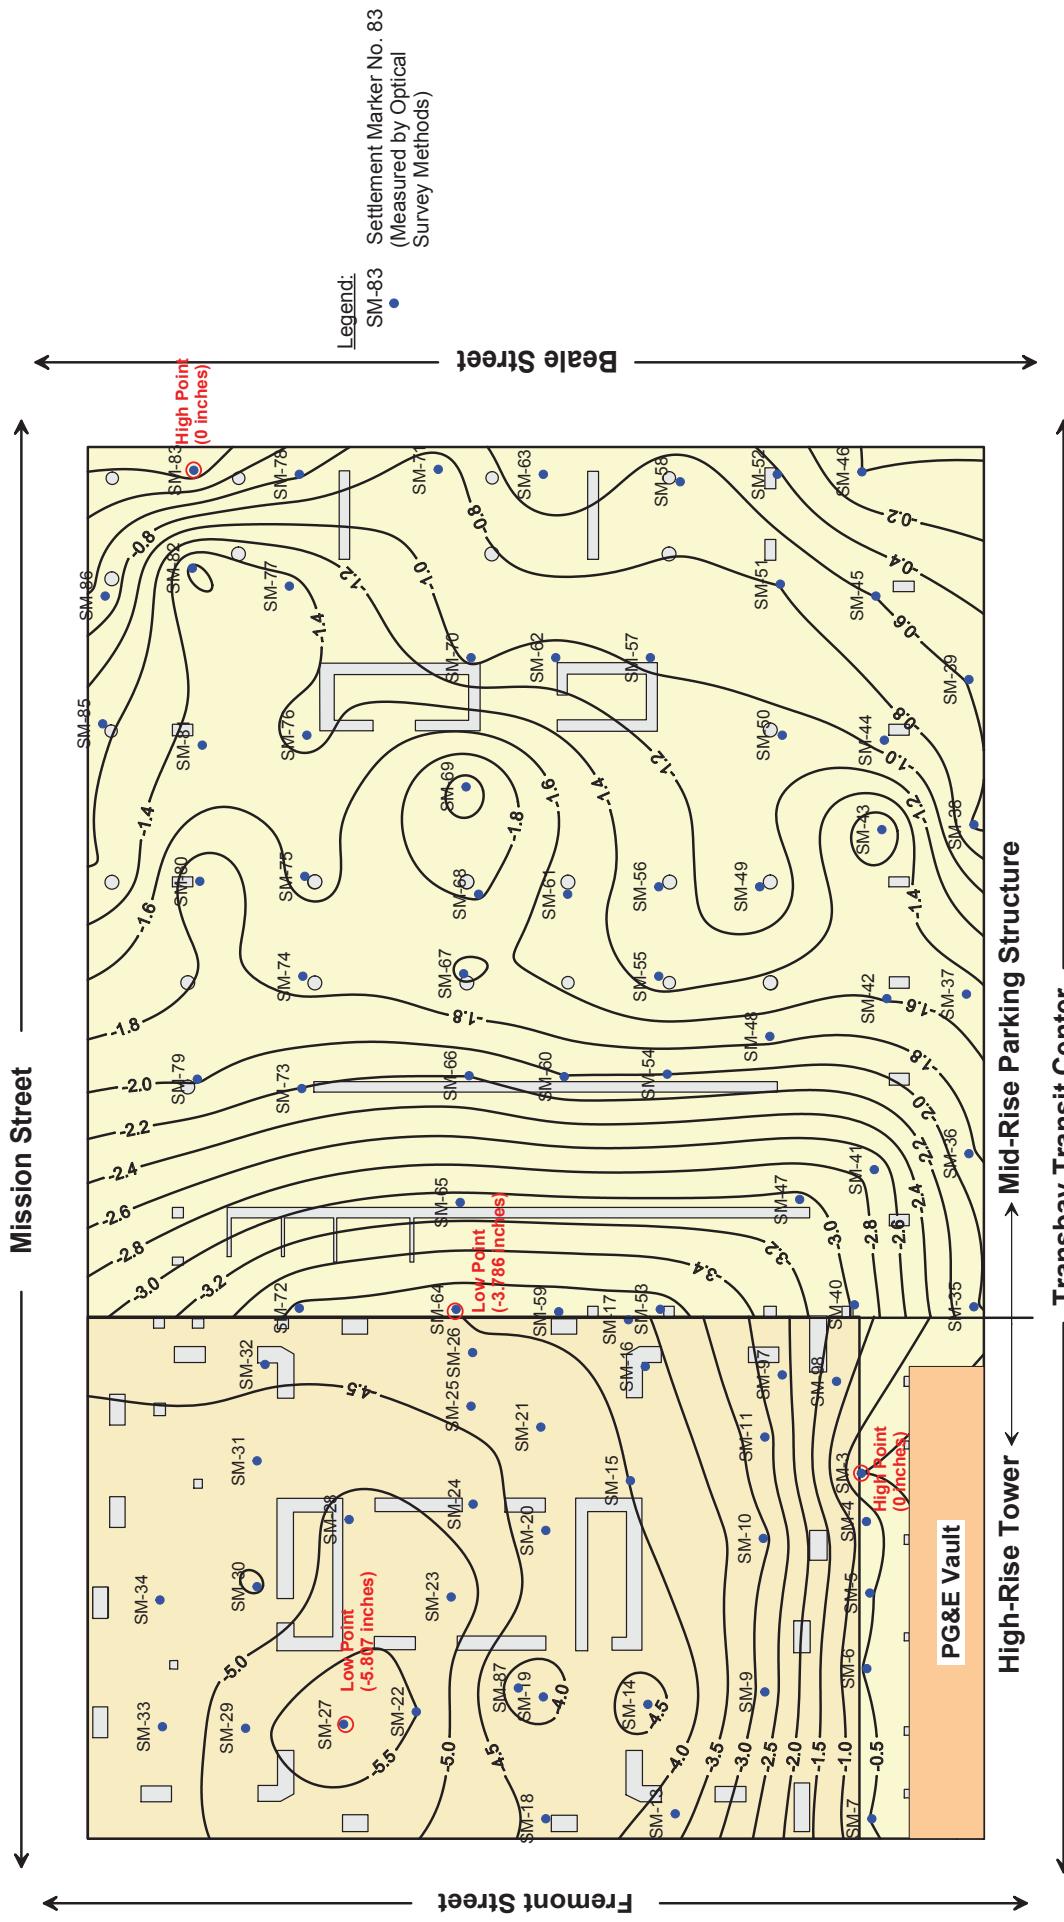


CONTOURS OF SETTLEMENTS MEASURED AT THE 1ST LEVEL BASEMENT OF THE 301 MISSION ST STRUCTURE BETWEEN 04/30/2009 & 12/31/2014

Transbay Transit Center
301 Mission Monitoring
Transbay Joint Powers Authority
San Francisco, California

December 2014

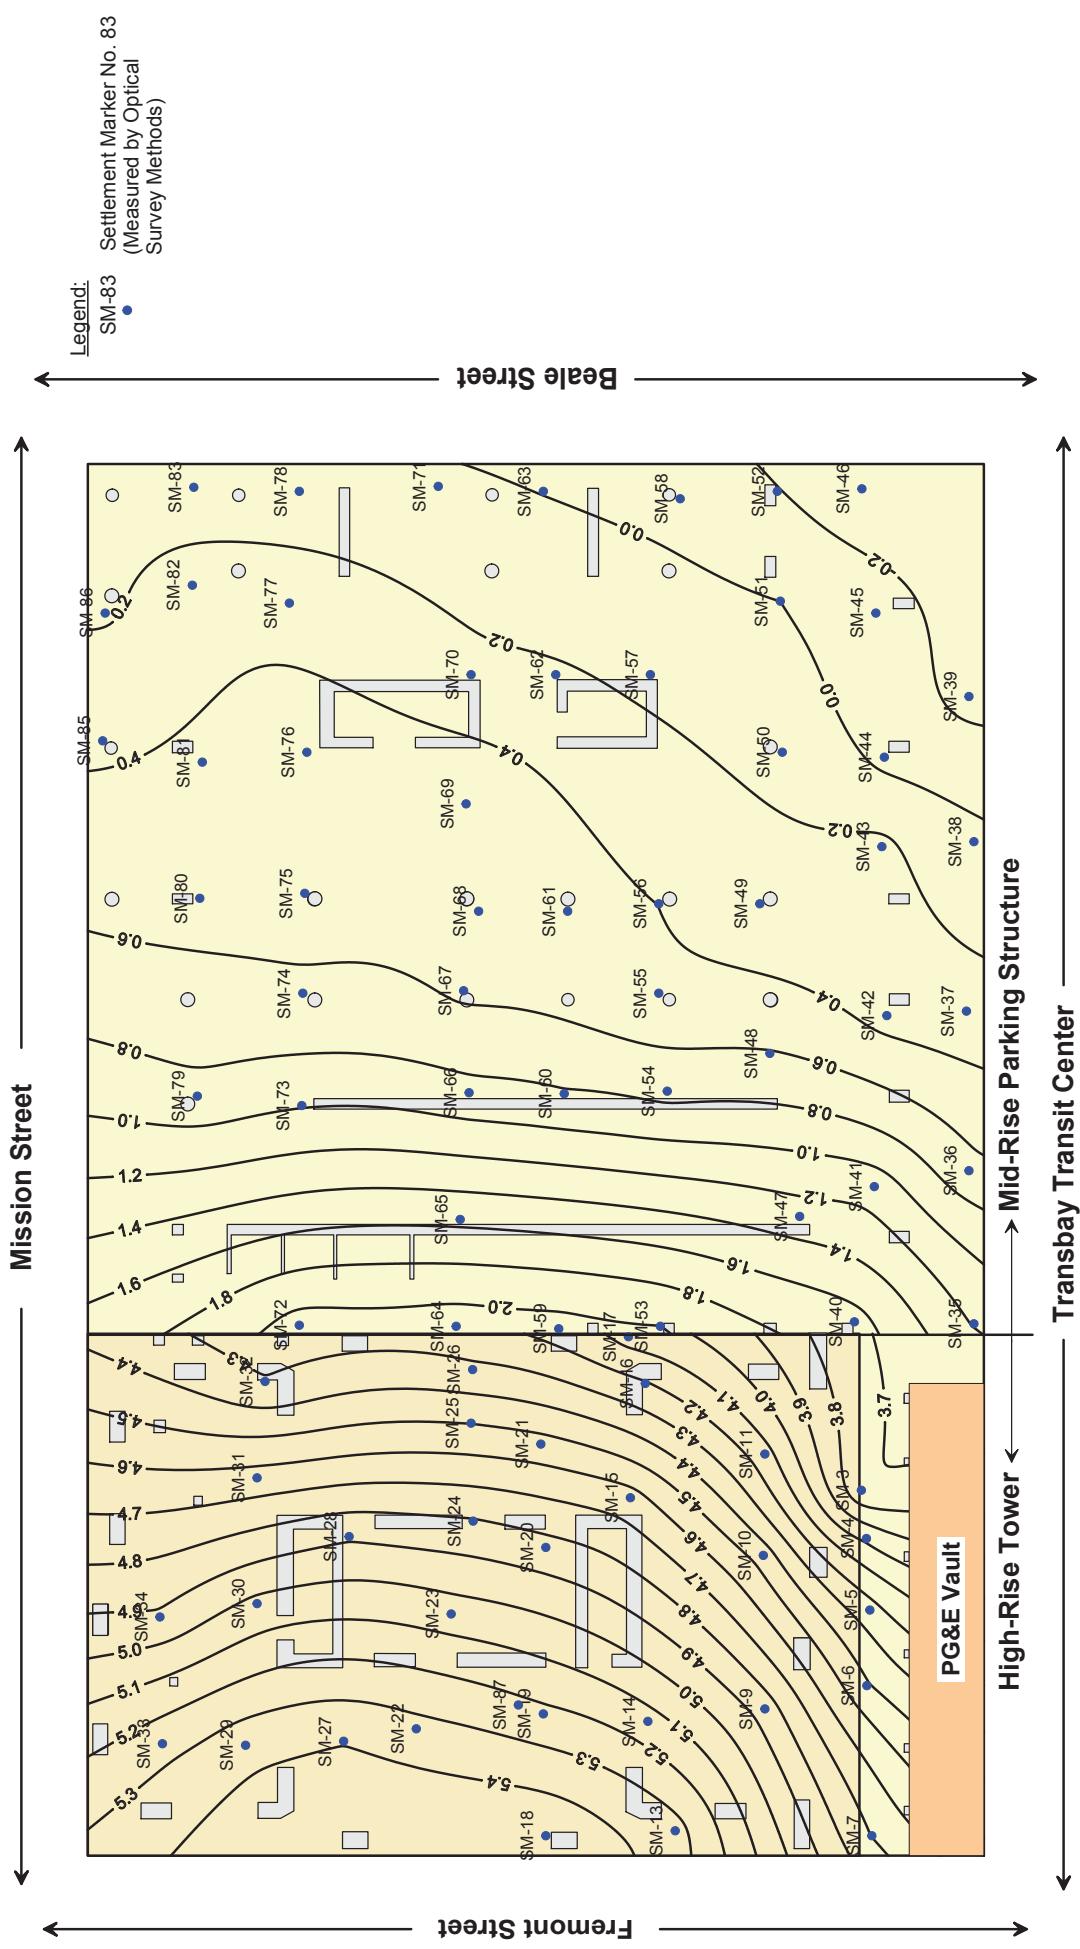

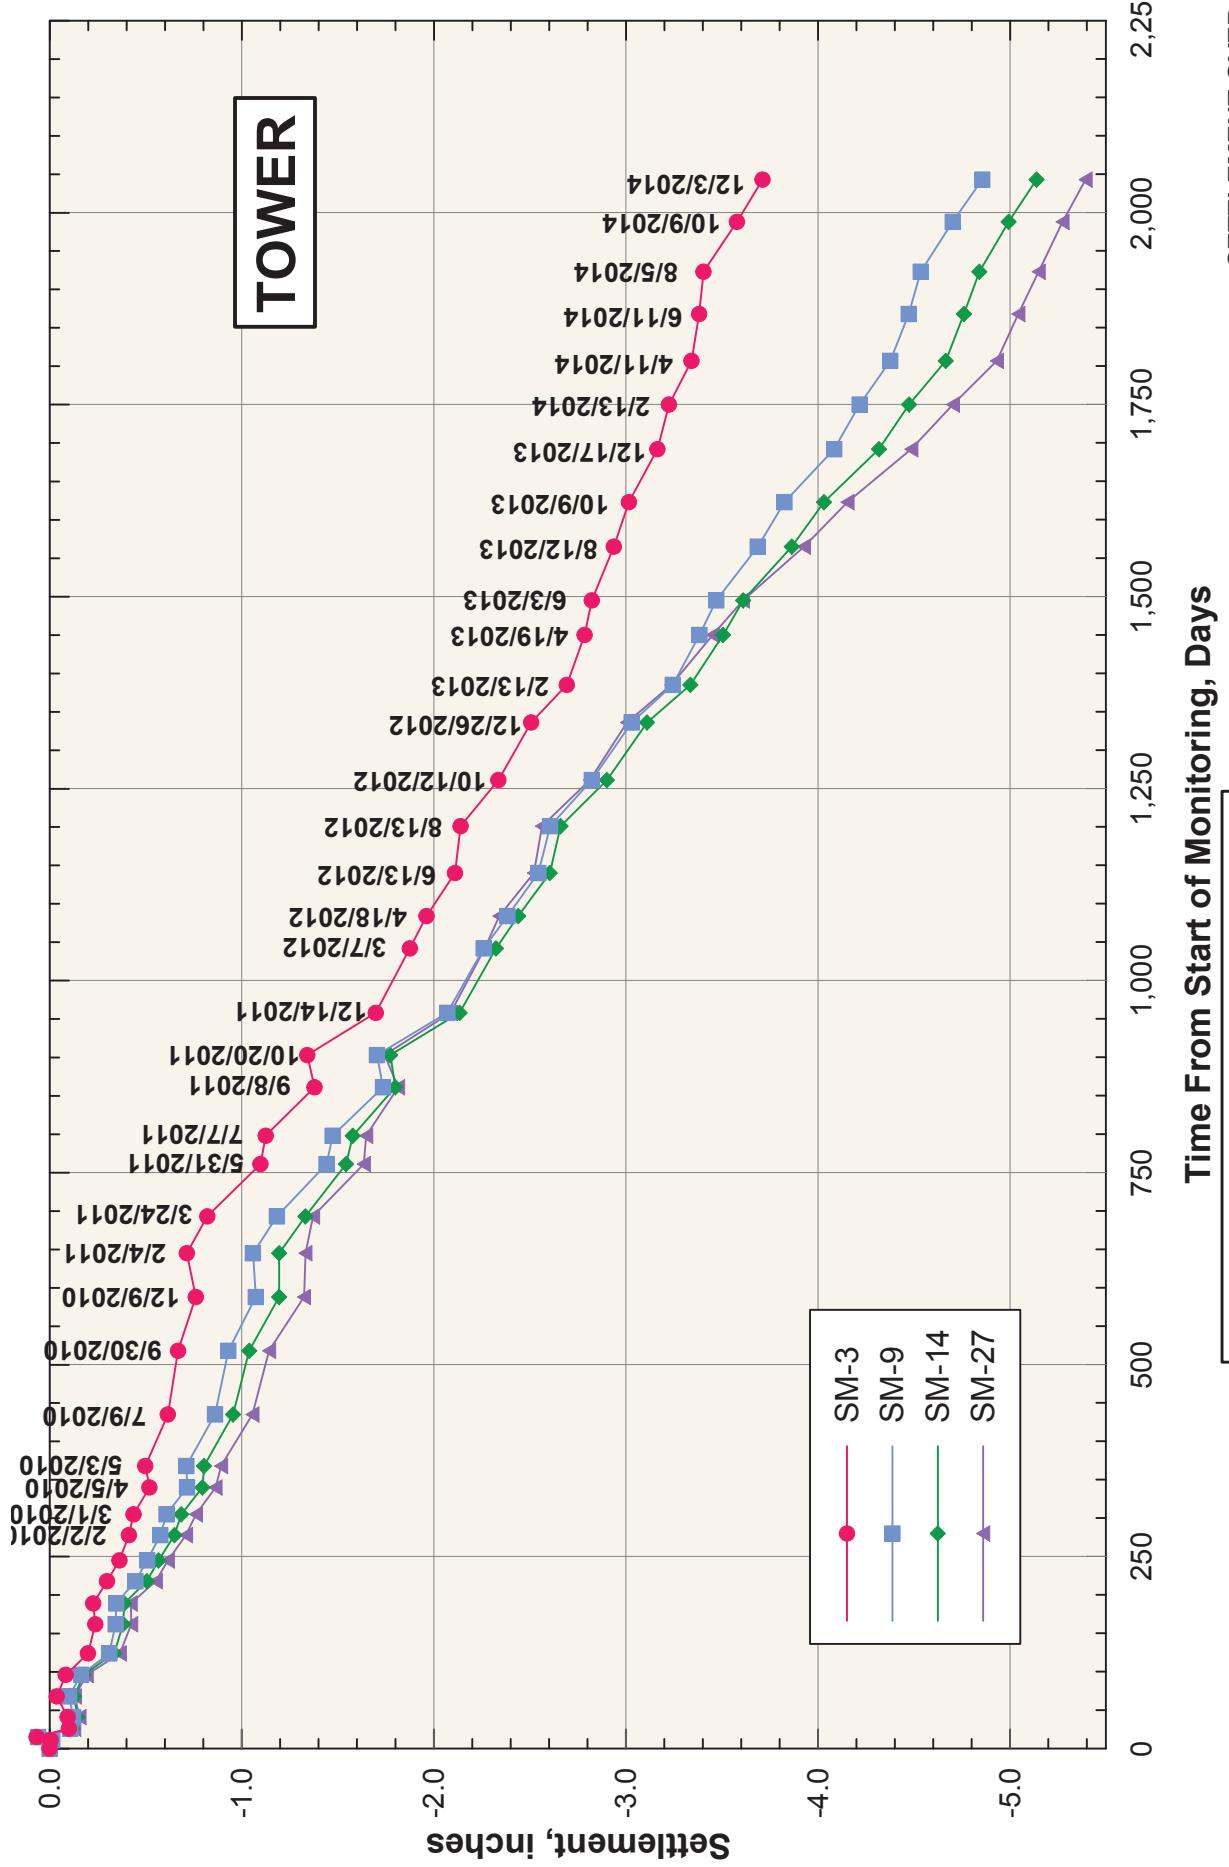

**SETTLEMENT OVER TIME
FLOOR ELEVATIONS AT LEVEL B-1
OF 301 MISSION PROPERTY- TOWER:
APRIL 30, 2009 THROUGH DECEMBER 3, 2014**

Transbay Transit Center
301 Mission Monitoring
Transbay Joint Powers Authority
San Francisco, California

December 2014

ARUP

J:SFV132001013222424 Internal Project Data4-05 Reports & Narratives\46_301 Mission - December 2014 Surveyor's Report 4 Settlement over time - Tower gir

ARUP



Note:
Initial (Baseline) reading
taken on 04/30/09


J.S.F.1320001322424 Internal Project Data4-05 Reports & Narratives\246 301 Mission - December 2014 Survey\Plates\Plate 5 Settlement Over Time - Midrise.grf


SETTLEMENT OVER TIME
FLOOR ELEVATIONS AT LEVEL B-1
OF 301 MISSION PROPERTY - MID-RISE:
APRIL 30, 2009 THROUGH DECEMBER 3, 2014


Transbay Transit Center
301 Mission Monitoring
Transbay Joint Powers Authority
San Francisco, California

December 2014

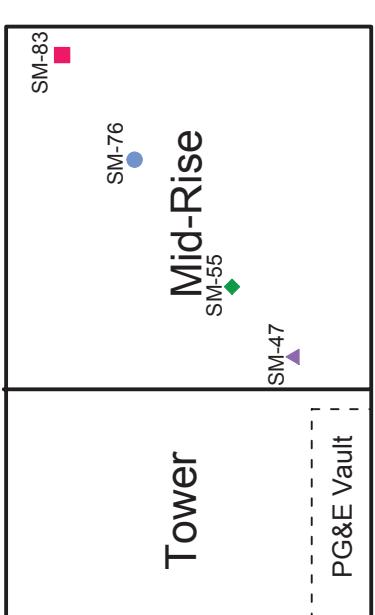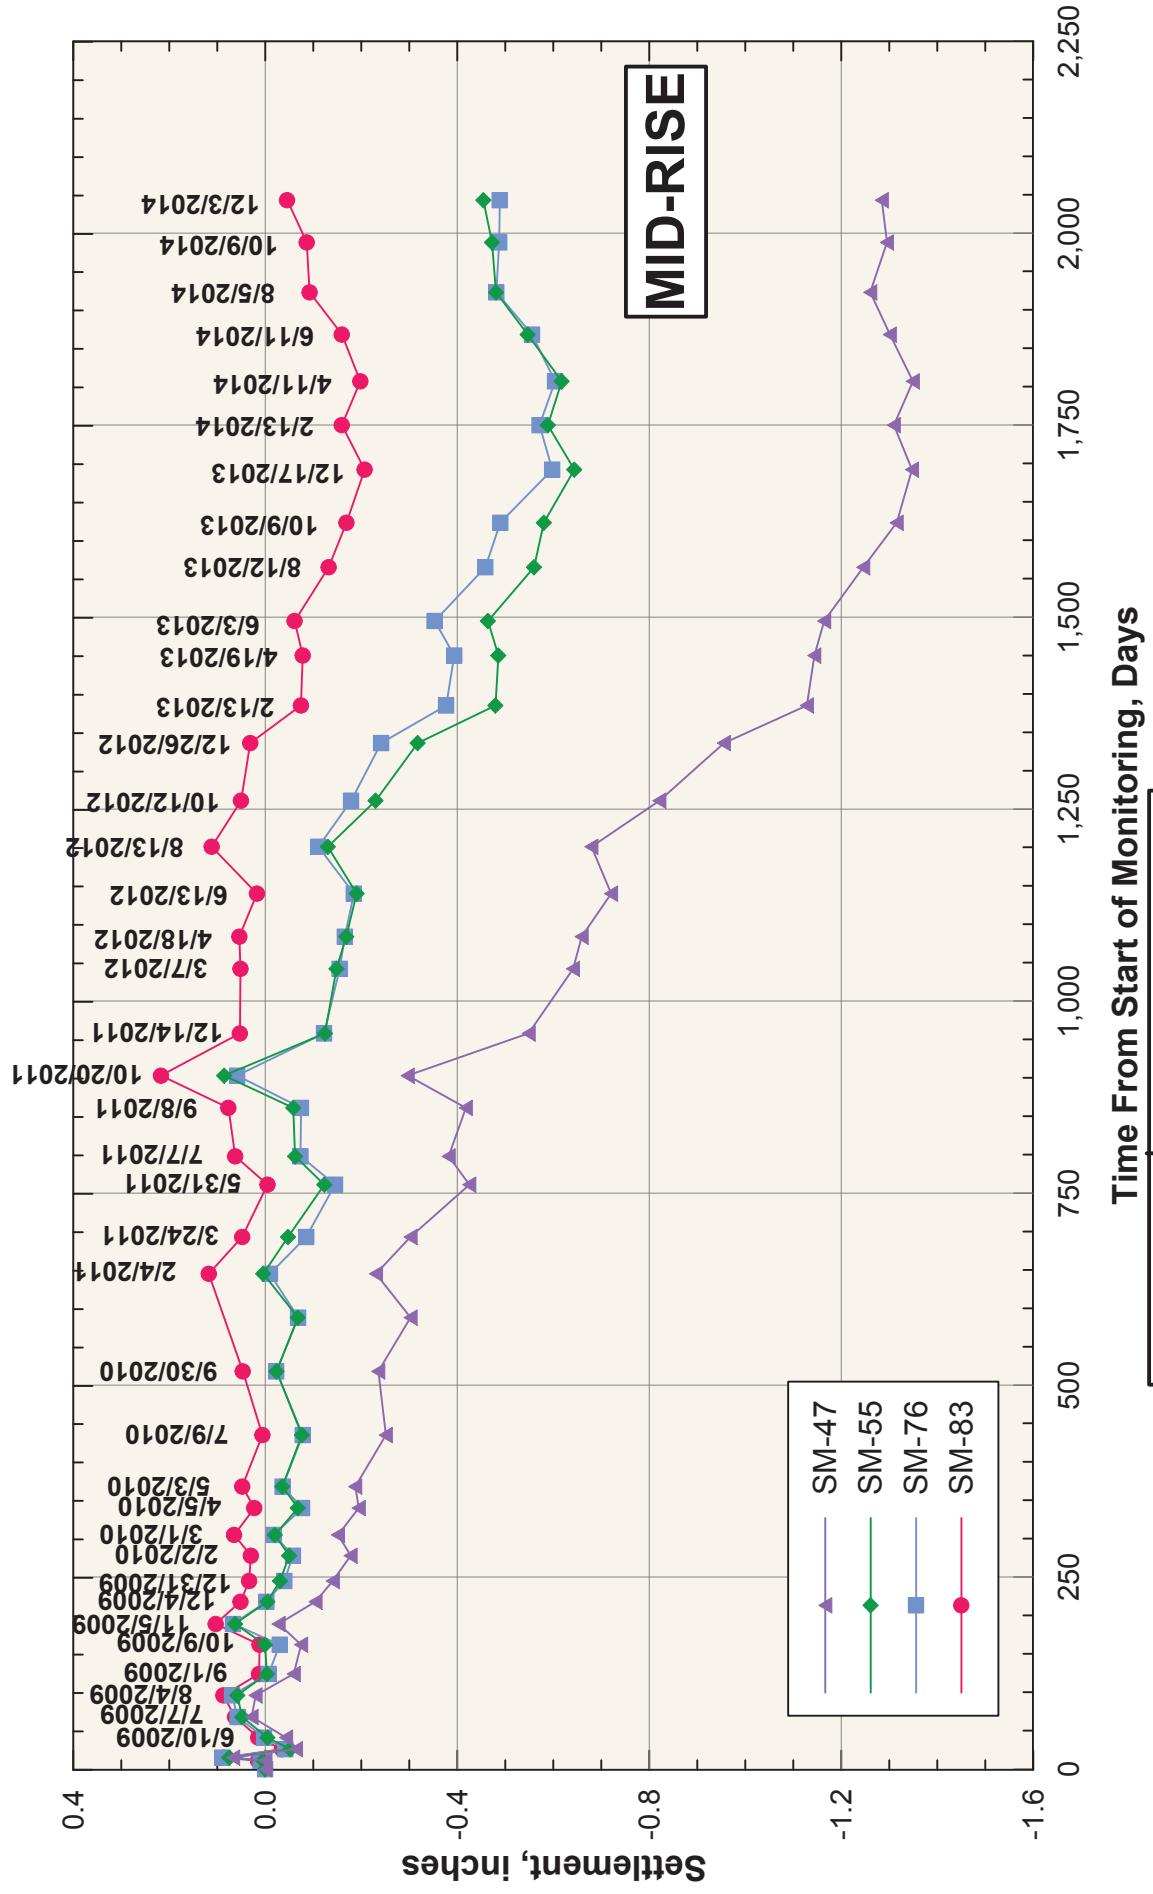

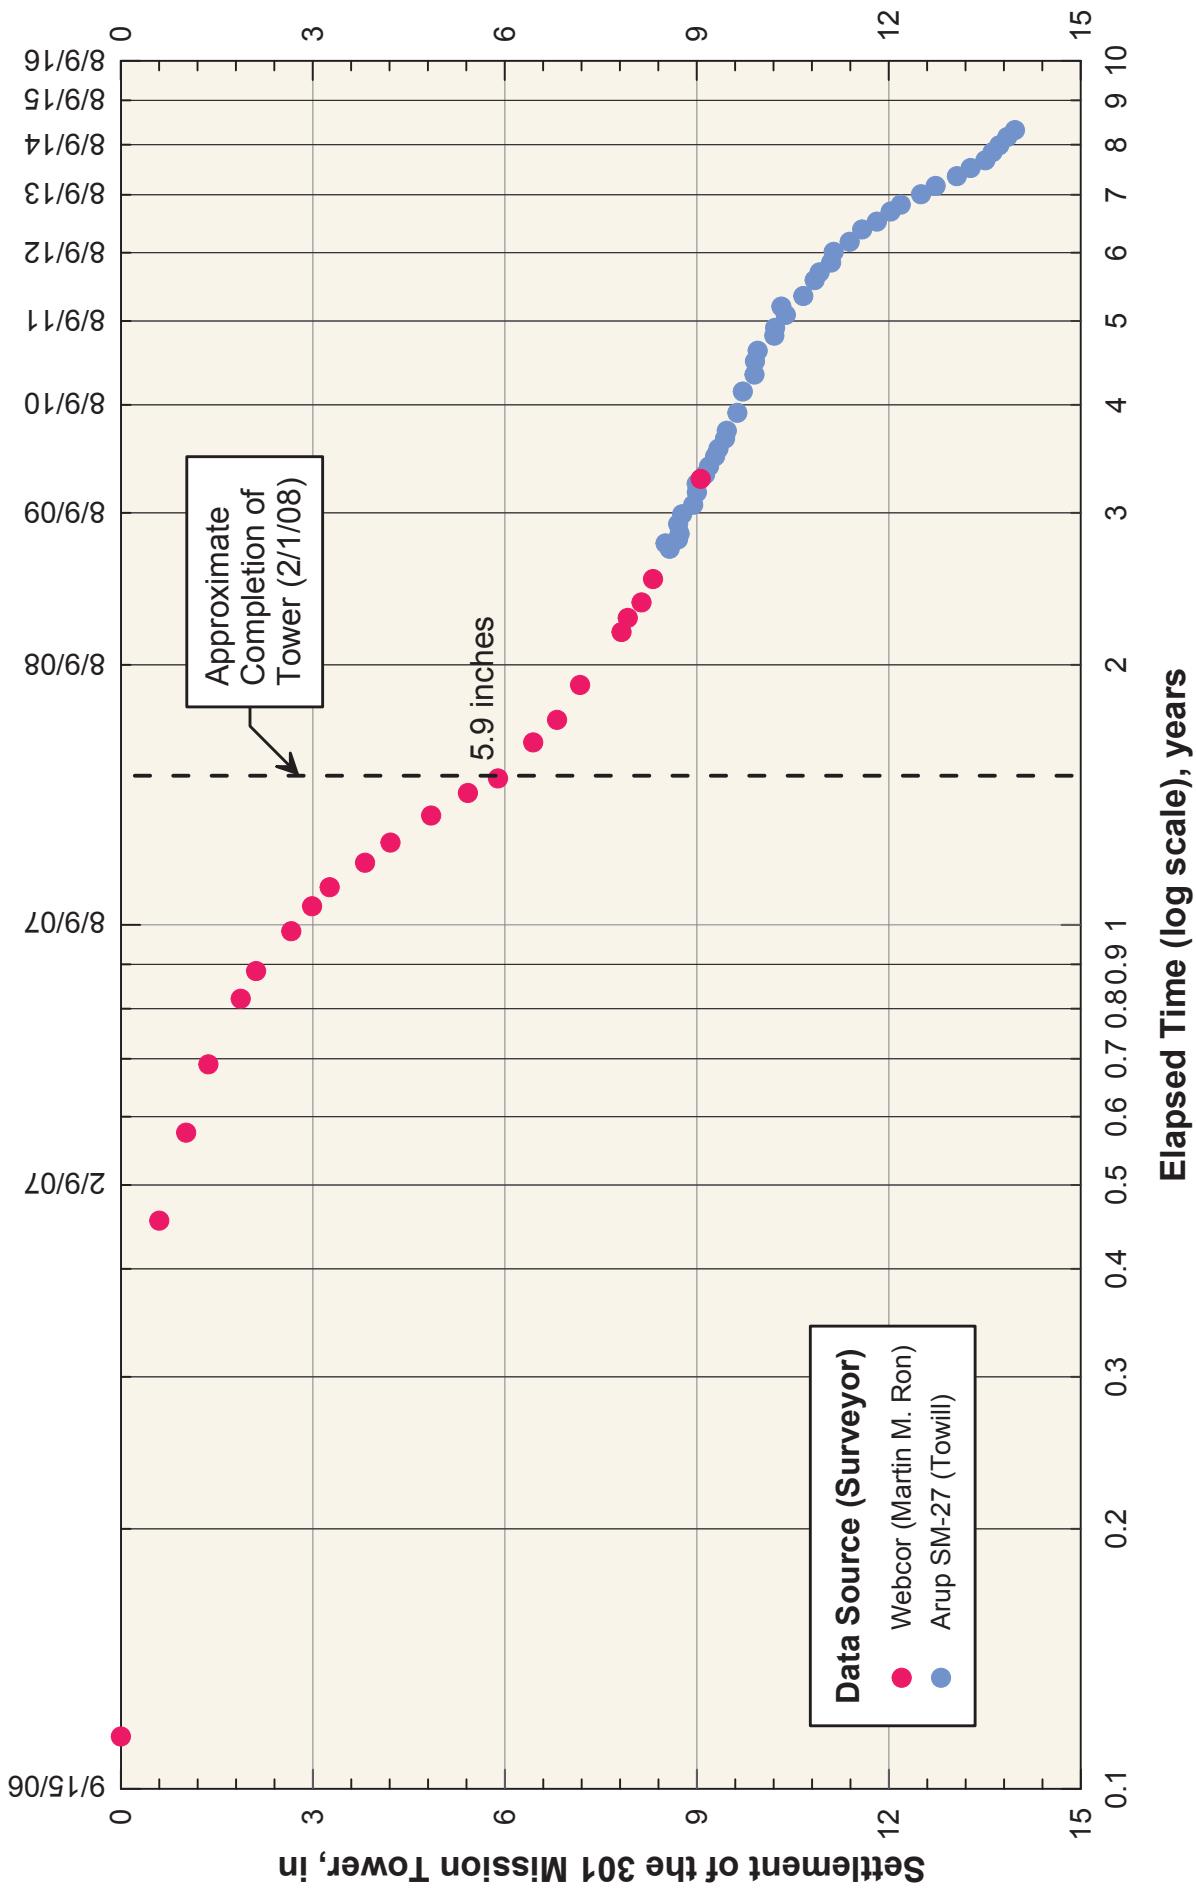

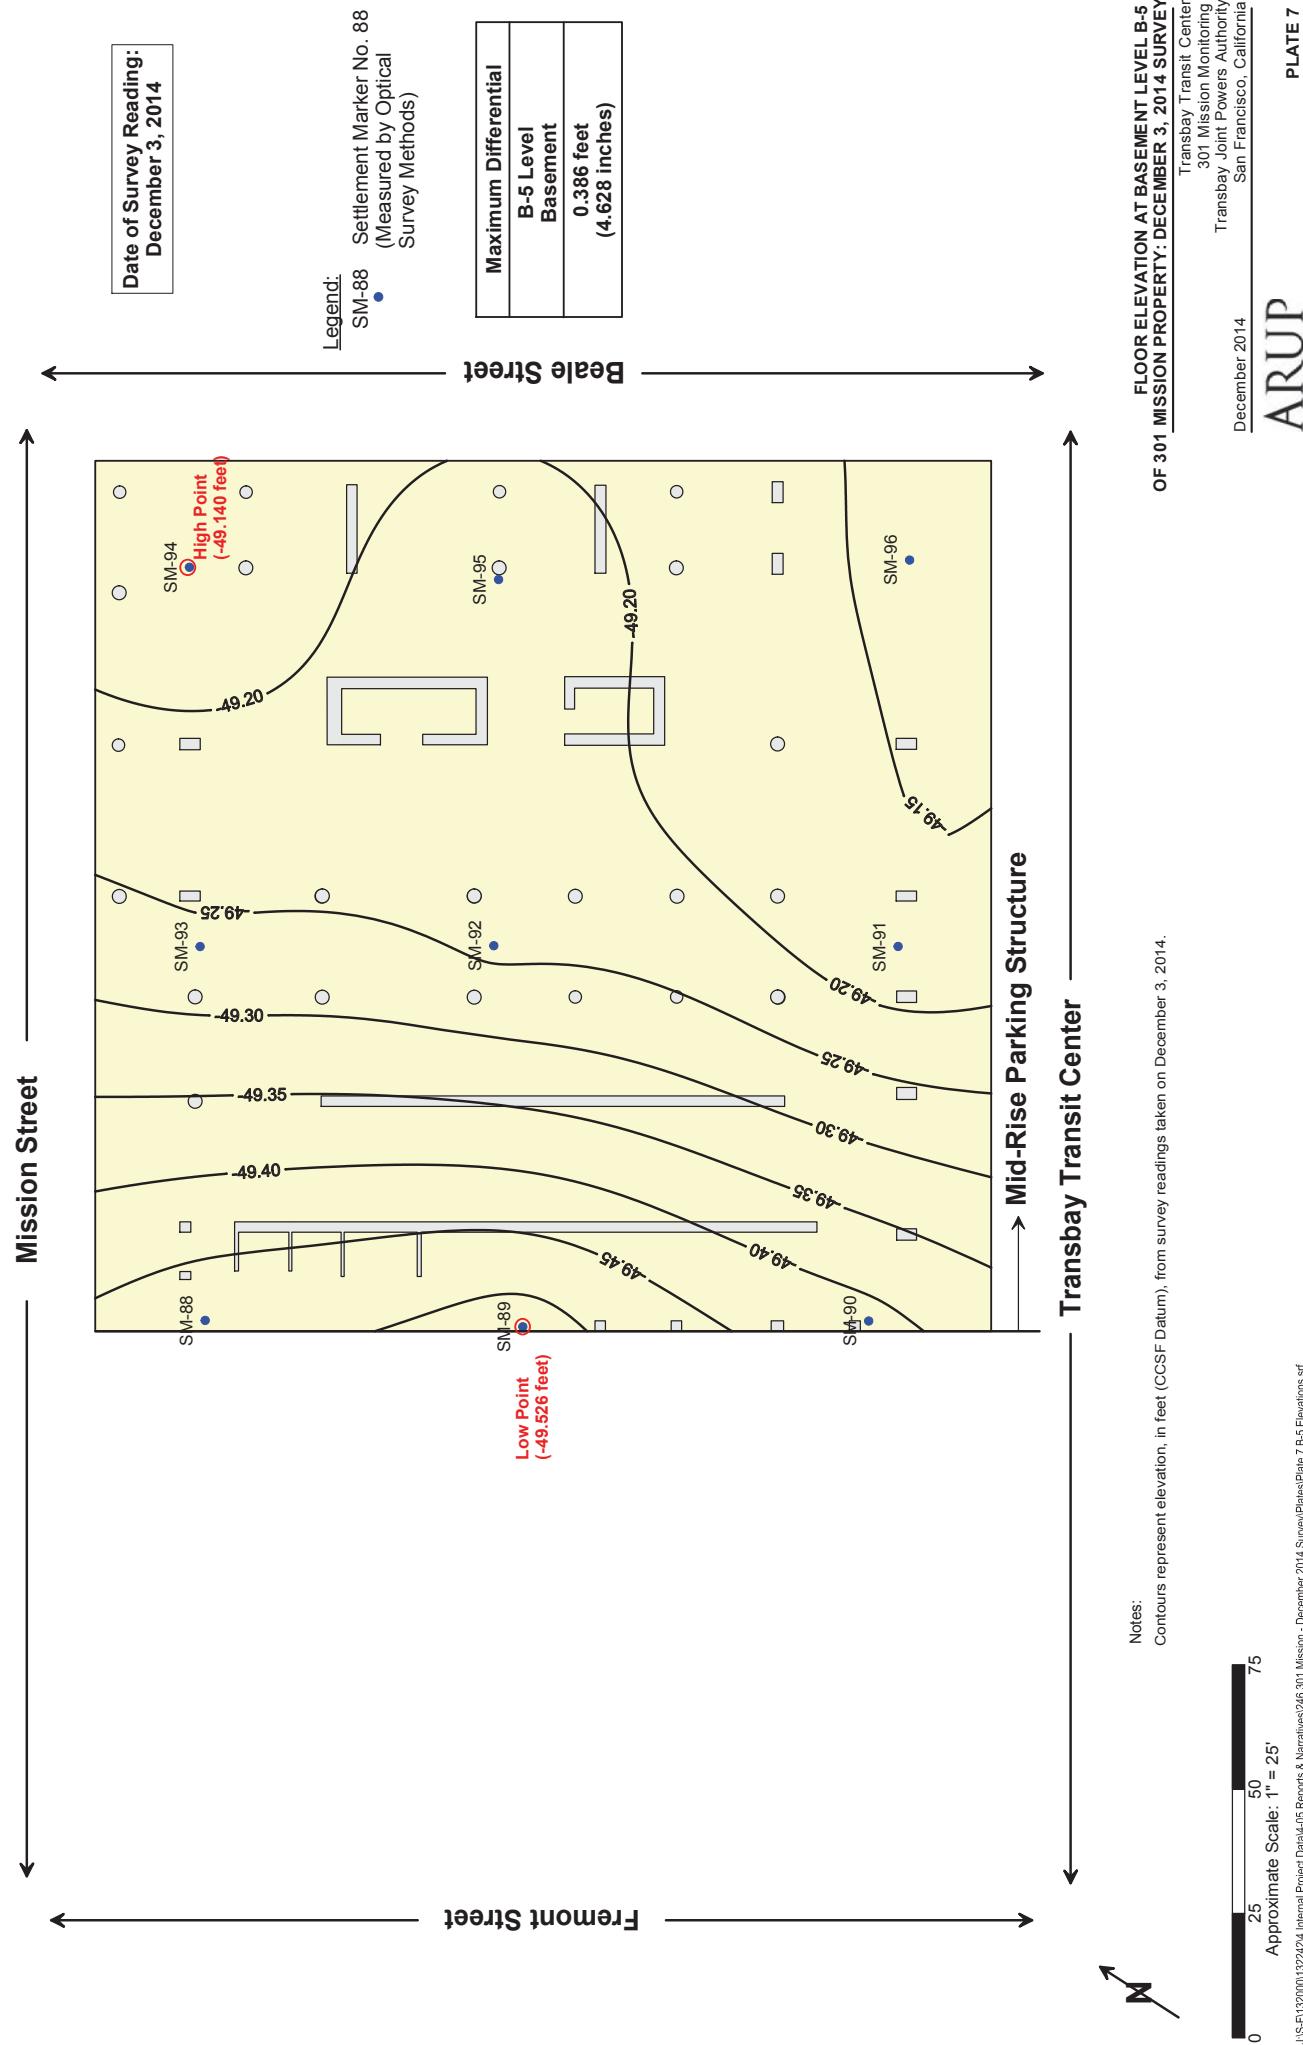

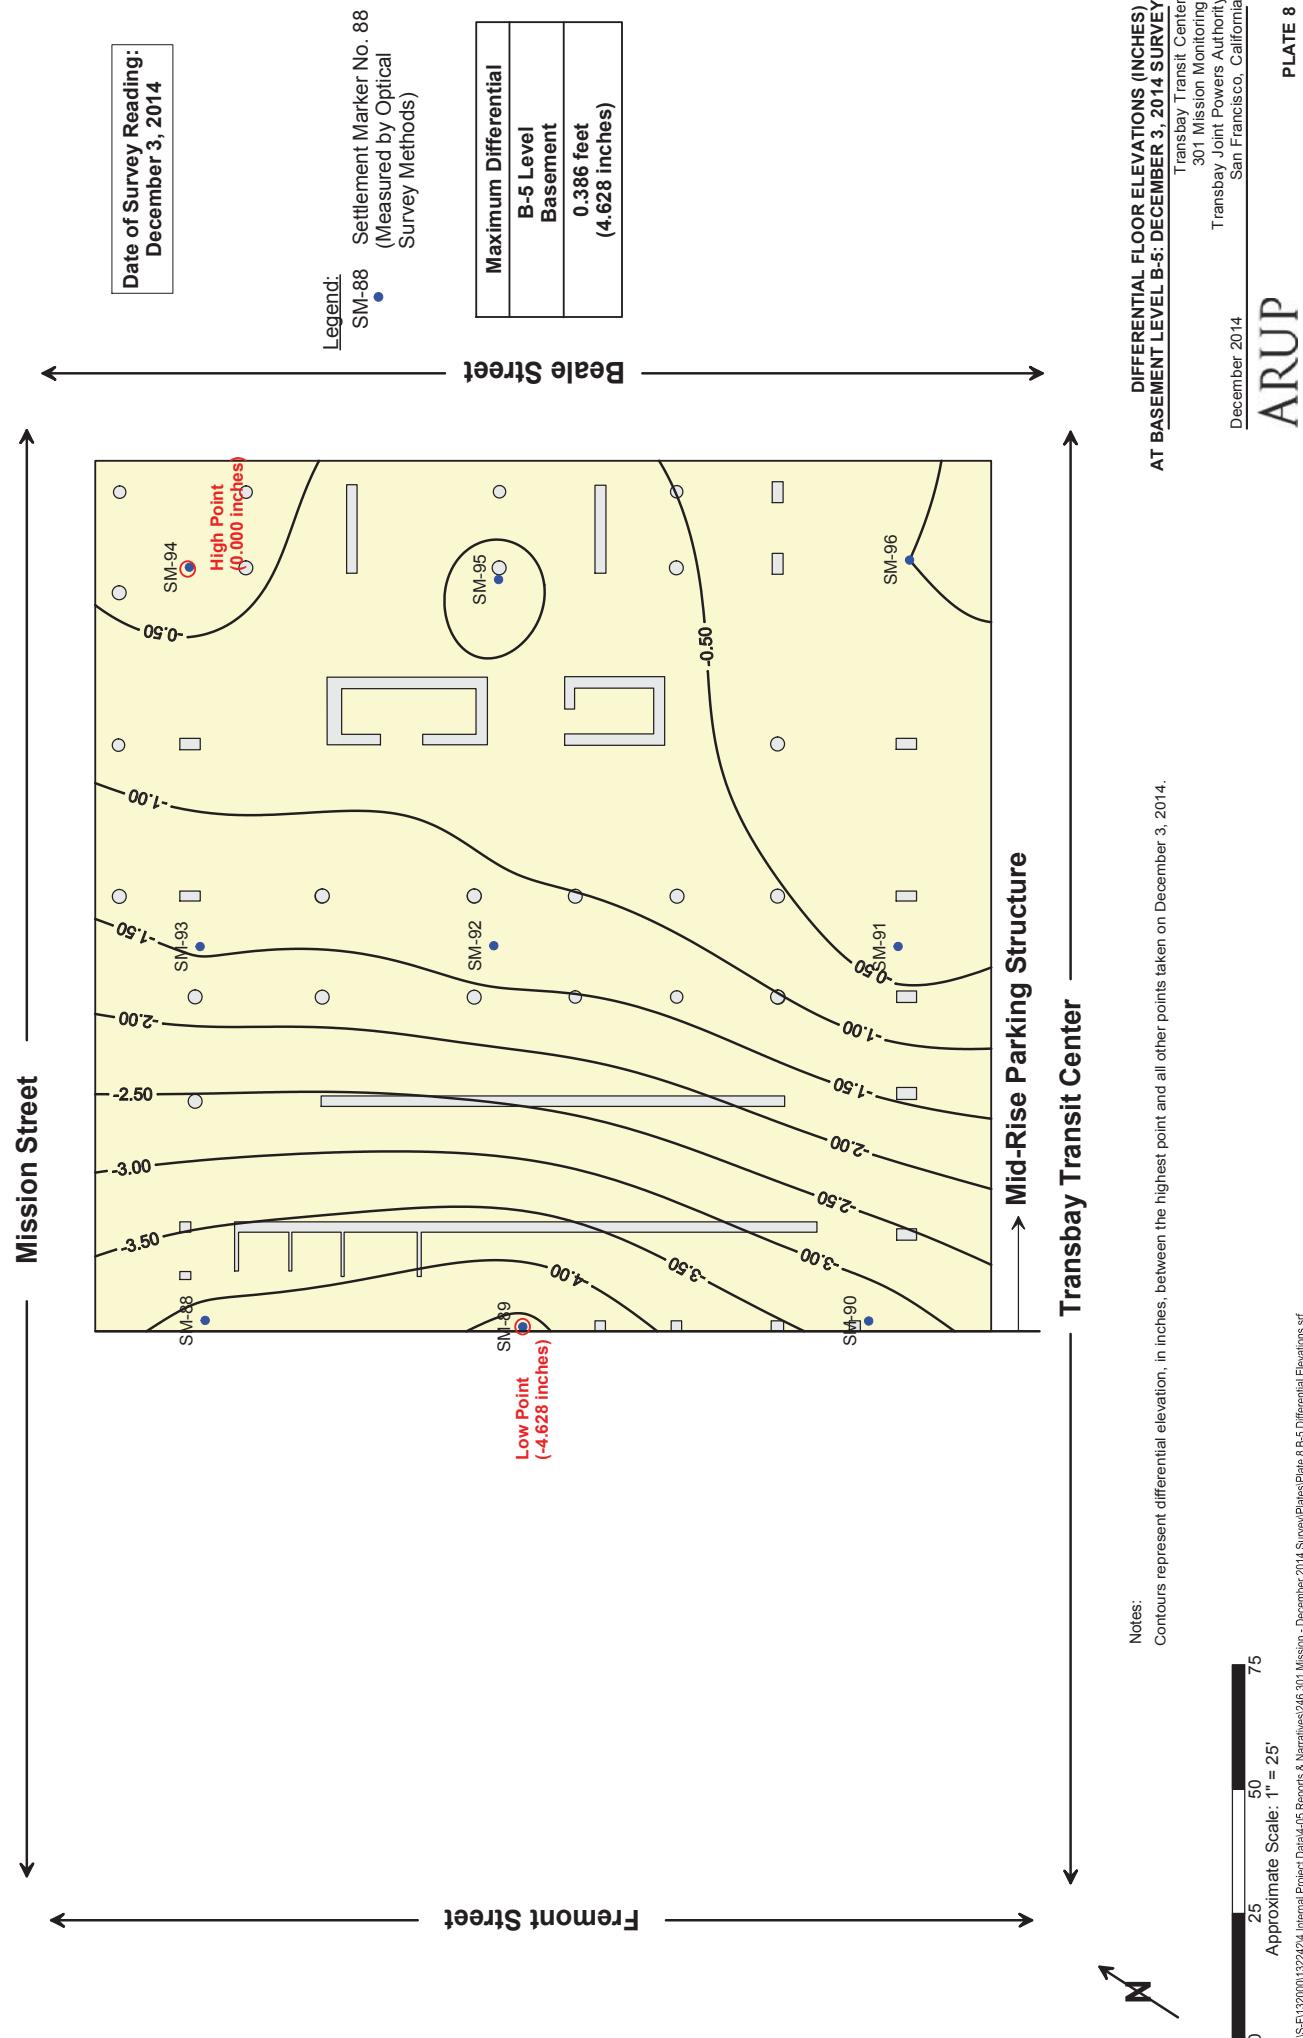

From: Brian Dykes
Sent: Friday, March 06, 2015 11:01 AM
To: 'shood@MillenniumPtrs.com'
Cc: Margie Cleland; Dennis Turchon; Mark Zabaneh; Nila Gonzales
Subject: February Survey Readings
Attachments: 2015-03-04 Memo_301 Mission Settlement - Feb 2015 Survey.pdf; Raw Data 301 Mission Settlement Survey Feb 2015.xlsx; 2015-03-05 Memo_301 Mission Instruments.pdf

Steve,
Here are the February settlement survey results memorandum and raw data, plus the instrument readings for inclinometers and piezometers.
Regards, Brian.

Margie,
Please file these reports in the correspondence to Millennium Partners.
Thanks, Brian.

Brian Dykes
Principal Engineer
Transbay Joint Powers Authority
201 Mission Street, Suite 2100
San Francisco, CA 94105
415 597 4617 phone
415 597 4615 fax



 Please consider the environment before printing this message.

Check out our progress at <http://transbaycenter.org/construction-updates/construction-cameras>

NOTE: This e-mail communication and any attachments hereto are covered by the Electronic Communications Privacy Act, 18 U.S.C. Sections 2510-2521, and are legally privileged. The information contained herein is confidential, and is intended only for the use of the individual or entity to whom it is addressed. If you are not the intended recipient of this e-mail communication (or an employee or agent responsible for delivering this communication to its intended recipient(s)), you are hereby notified that any retention, copying or further distribution of this e-mail communication and any attachments is strictly prohibited. If you are not the intended recipient, please notify the sender by telephoning 415-597-4620, or by forwarding an e-mail reply message addressed to TransAdmin@TransbayCenter.org confirming that you have already destroyed (deleted) the original e-mail communication and any and all copies thereof. Thank you.

Memorandum


ARUP

To	Brian Dykes (TJPA)	Date
		March 4, 2015
Copies	Randy Volenec (PCPA) George Metzger (AAI)	Reference number 132242
From	Stephen McLandrich (Arup)	File reference 4-05 243
Subject	Transbay Transit Center: Results of February 2015 Settlement Survey at 301 Mission Property	Page 1 of 1

Under Arup's Geotechnical Contract with the Transbay Joint Powers Authority through Pelli Clark Pelli Architects, Arup is required to monitor the settlements of the buildings adjacent to the Transbay Transit Center prior to and during construction. We began the monitoring program for the 301 Mission property in April of 2009. This memorandum and the attached plates present an update to our memorandum dated December 11, 2014 with measurements made through February 2015.

List of Plates

- Plate 1 Floor Elevations at Level B-1 of 301 Mission Property: Periodic Survey – February 12, 2015
- Plate 2 Differential Floor Elevation (Inches) February 12, 2015 Survey
- Plate 3 Contours of Settlements Measured at the 1st Level Basement of the 301 Mission St. Structure Between 04/30/2009 & 02/12/2014
- Plate 4 Settlement Over Time Floor Elevations at Level B-1 of 301 Mission Property – Tower: April 30, 2009 through February 12, 2015
- Plate 5 Settlement Over Time Floor Elevations at Level B-1 of 301 Mission Property – Mid-Rise: April 30, 2009 through February 12, 2015
- Plate 6 Settlements of the 301 Mission Tower Including Monitoring During Construction
- Plate 7 Floor Elevation at Basement Level B-5 of 301 Mission Property: February 12, 2015 Survey
- Plate 8 Differential Floor Elevations (Inches) at Basement Level B-5: February 12, 2015 Survey

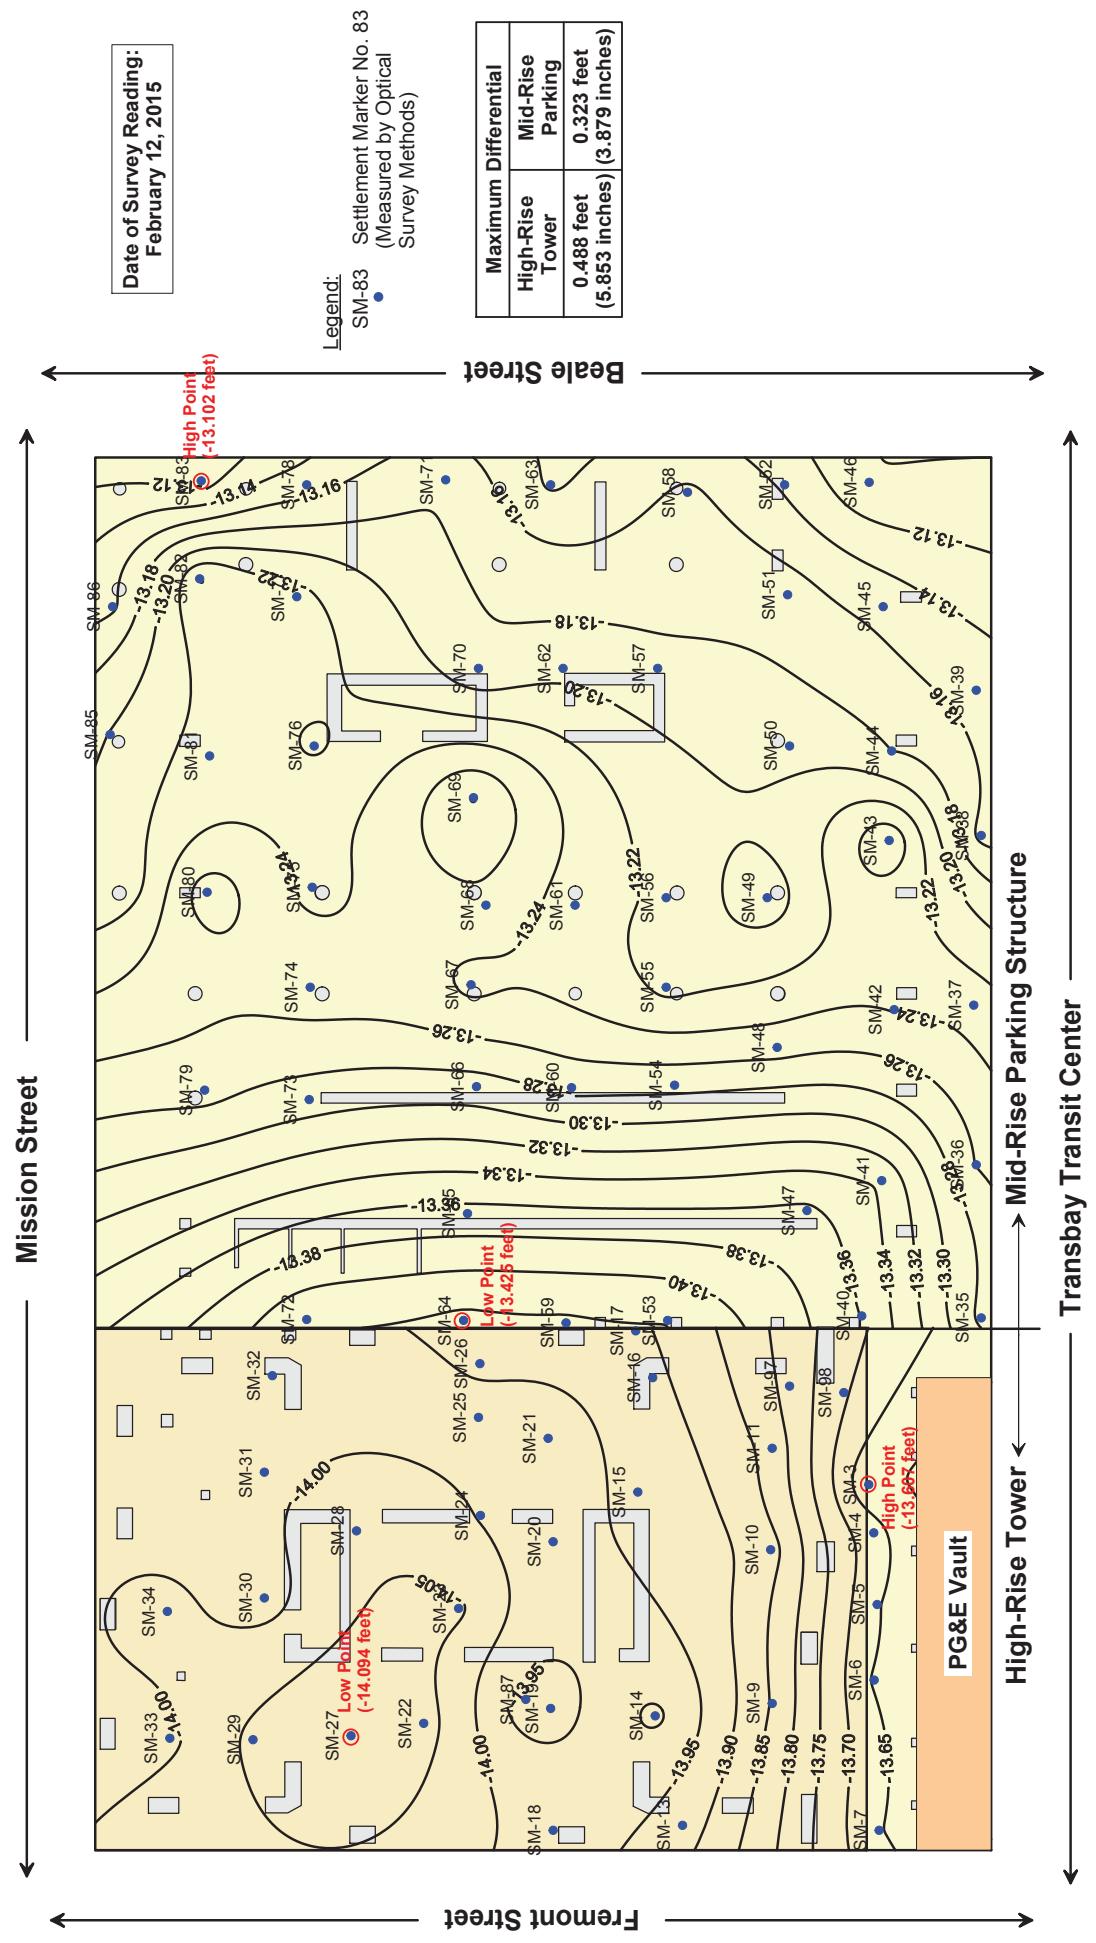

**FLOOR ELEVATIONS AT LEVEL B-1
OF 301 MISSION PROPERTY
PERIODIC SURVEY - FEBRUARY 12, 2015**

Transbay Transit Center
301 Mission Monitoring
Transbay Joint Powers Authority
San Francisco, California


March 2015


ARUP

ARUP

DIFFERENTIAL FLOOR ELEVATIONS (INCHES)
FEBRUARY 12, 2015 SURVEY
Transbay Transit Center
301 Mission Monitoring
Transbay Joint Powers Authority
San Francisco, California

March 2015

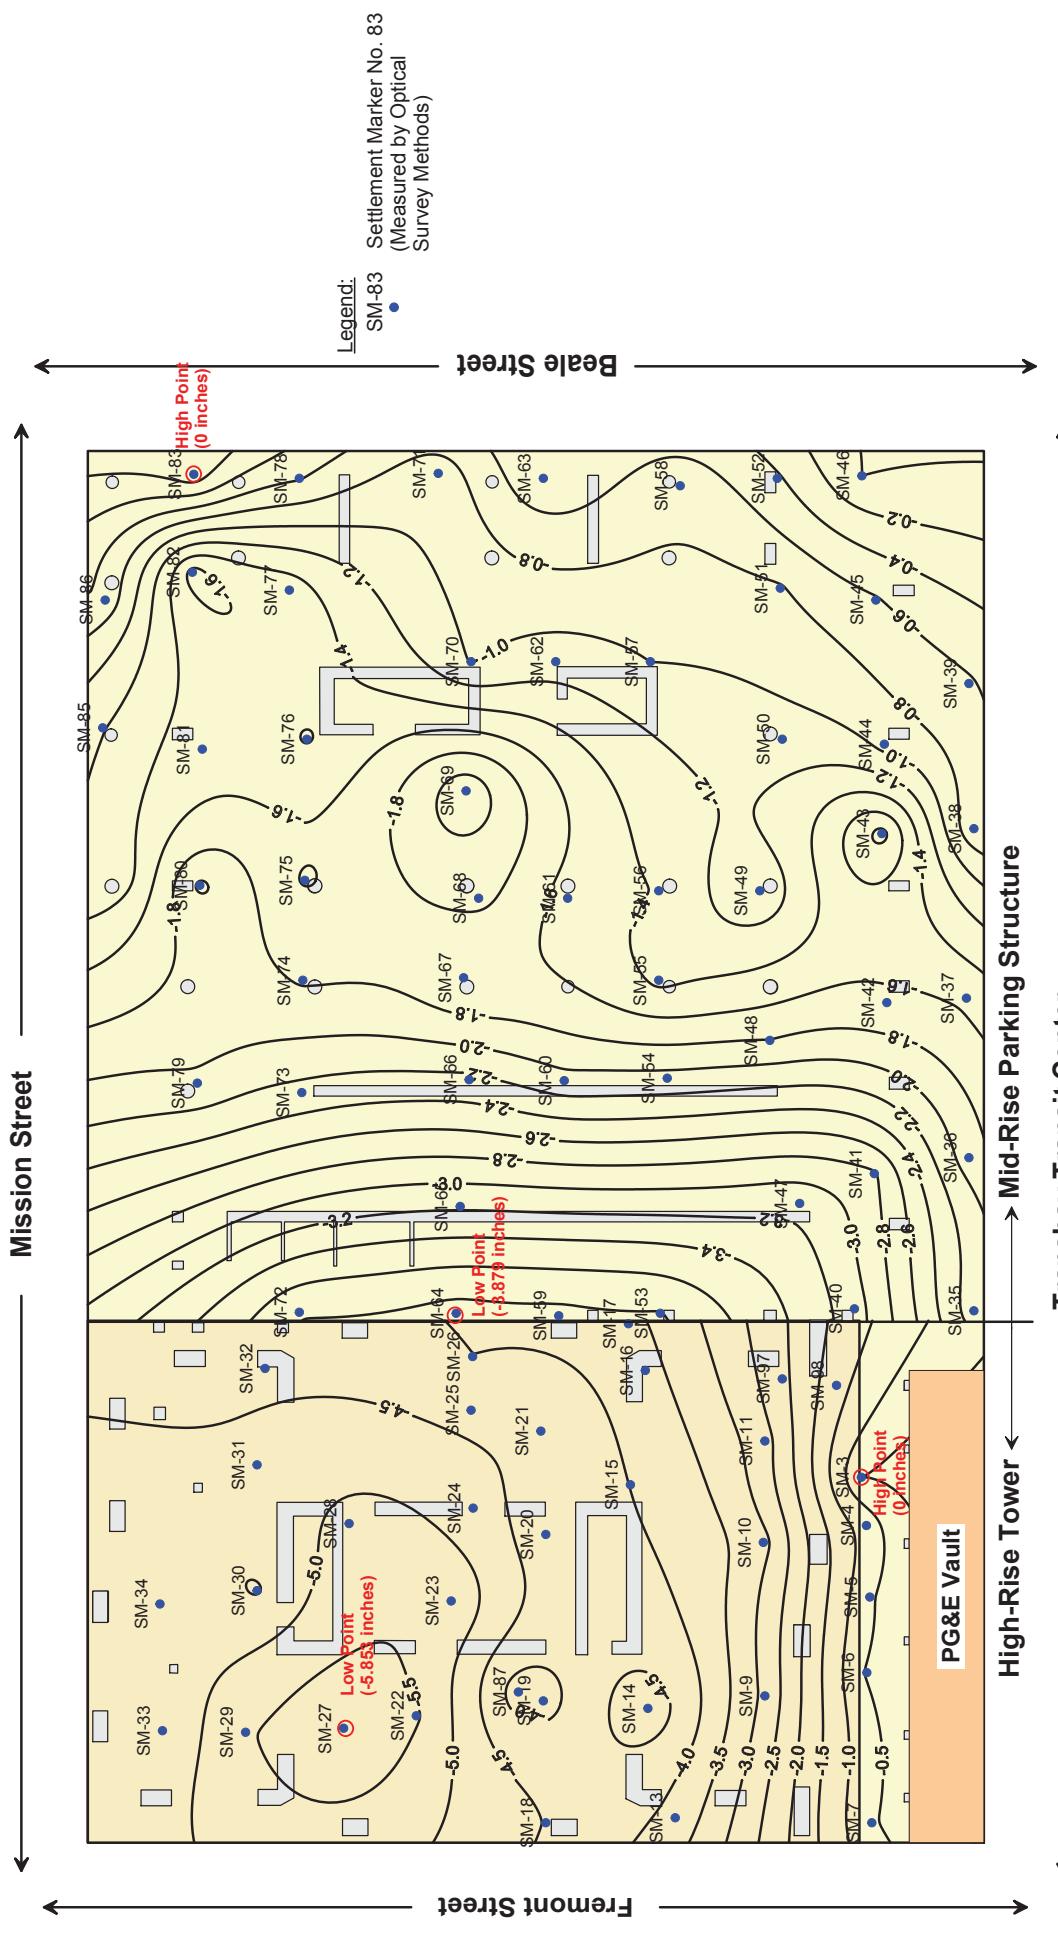

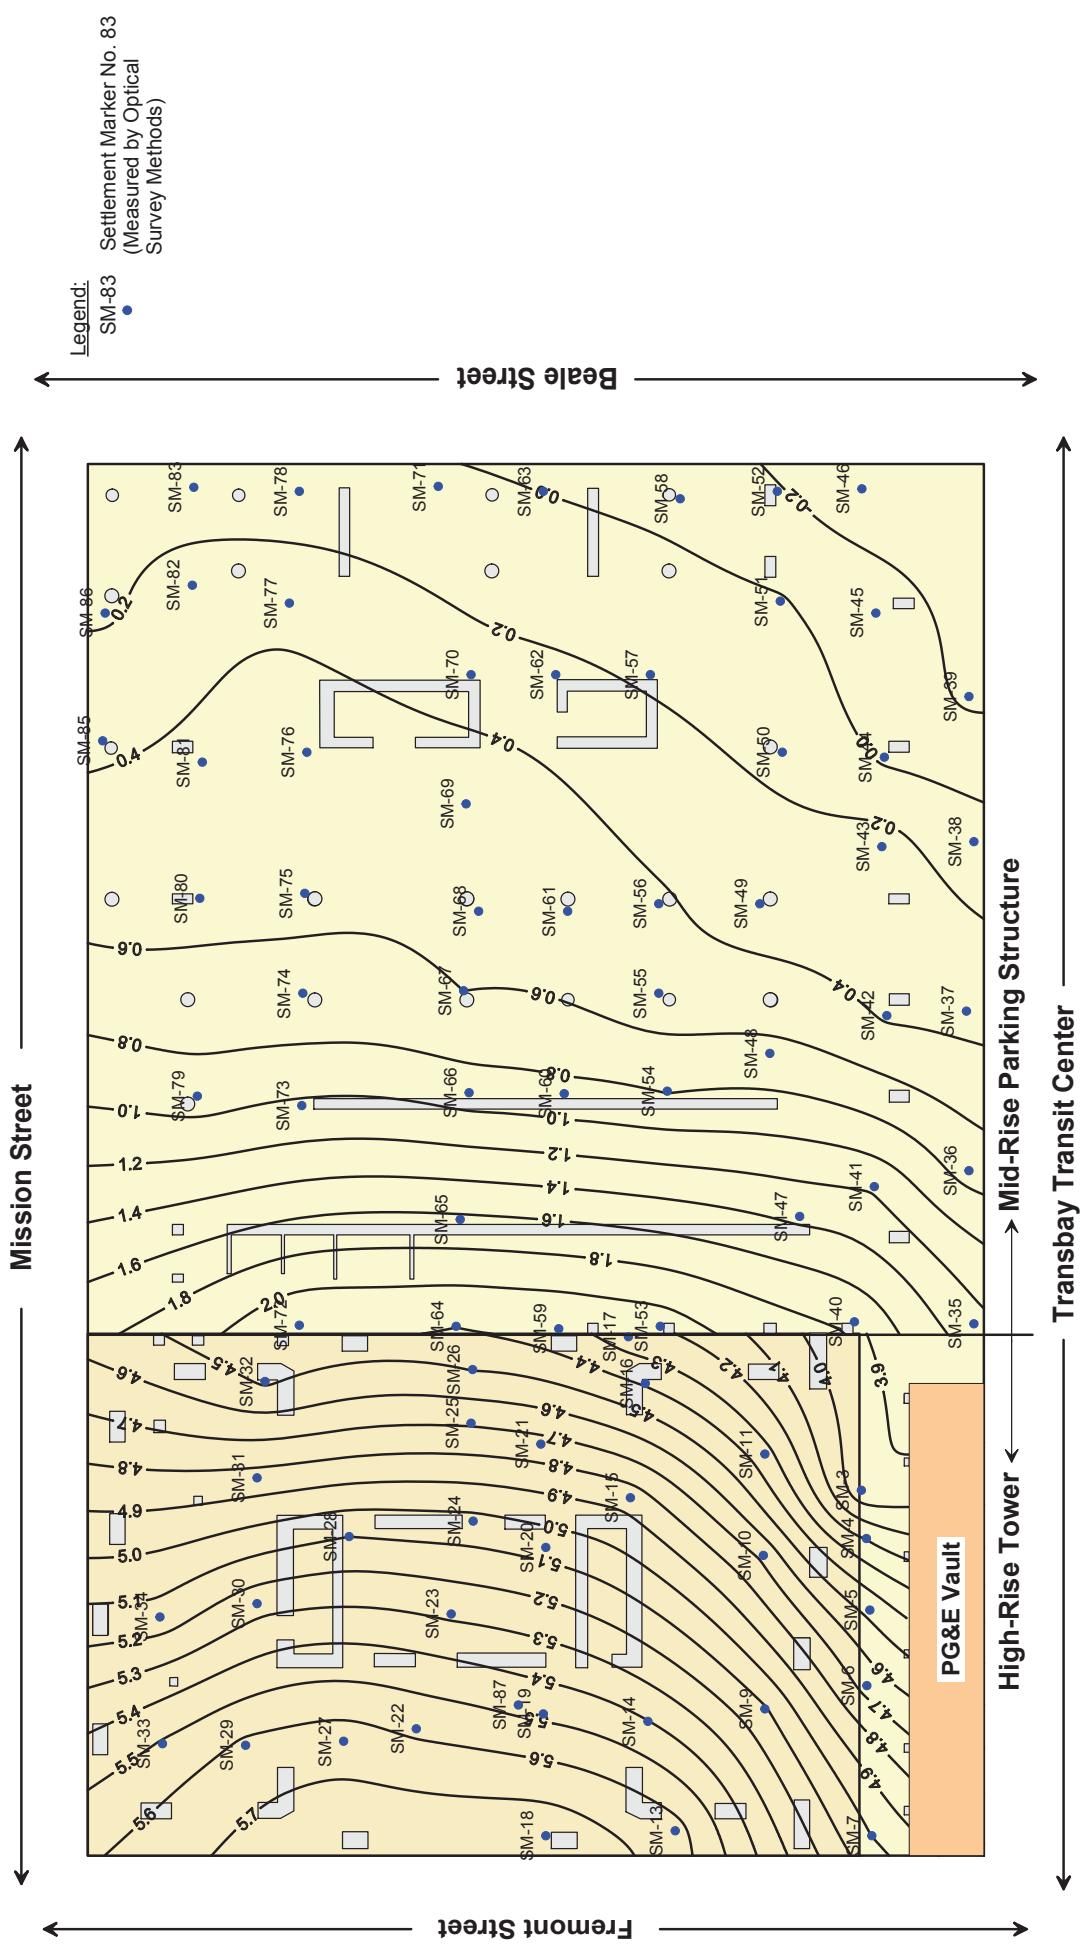

Notes:
 Contours represent elevation change, in inches, between Baseline survey (April 30, 2009) and readings taken on February 12, 2015.
 Level B-1 at Mid-Rise Parking portion of survey site is approximately 4 inches higher than Level B-1 at High-Rise Tower portion.
 The PG&E vault is inaccessible for monitoring.
 Negative values of settlement (within Low-rise Tower) indicate uplift.

CONTOURS OF SETTLEMENTS MEASURED AT THE 1ST LEVEL BASEMENT OF THE 301 MISSION ST STRUCTURE BETWEEN 04/30/2009 & 02/12/2015
 Transbay Transit Center
 301 Mission Monitoring
 Transbay Joint Powers Authority
 San Francisco, California
March 2015

ARUP

Transbay Transit Center
301 Mission Monitoring
Transbay Joint Powers Authority
San Francisco, California

APRIL 30, 2009 THROUGH FEBRUARY 12, 2015

SETTLEMENT OVER TIME



FLOOR ELEVATIONS AT LEVEL B-1

OF 301 MISSION PROPERTY - TOWER:

APRIL 30, 2009 THROUGH FEBRUARY 12, 2015

March 2015

Note:
Initial (Baseline) reading
taken on 04/30/09

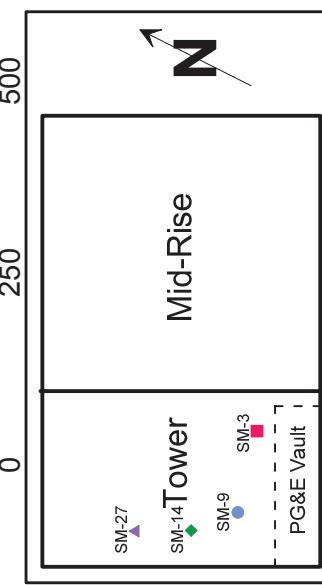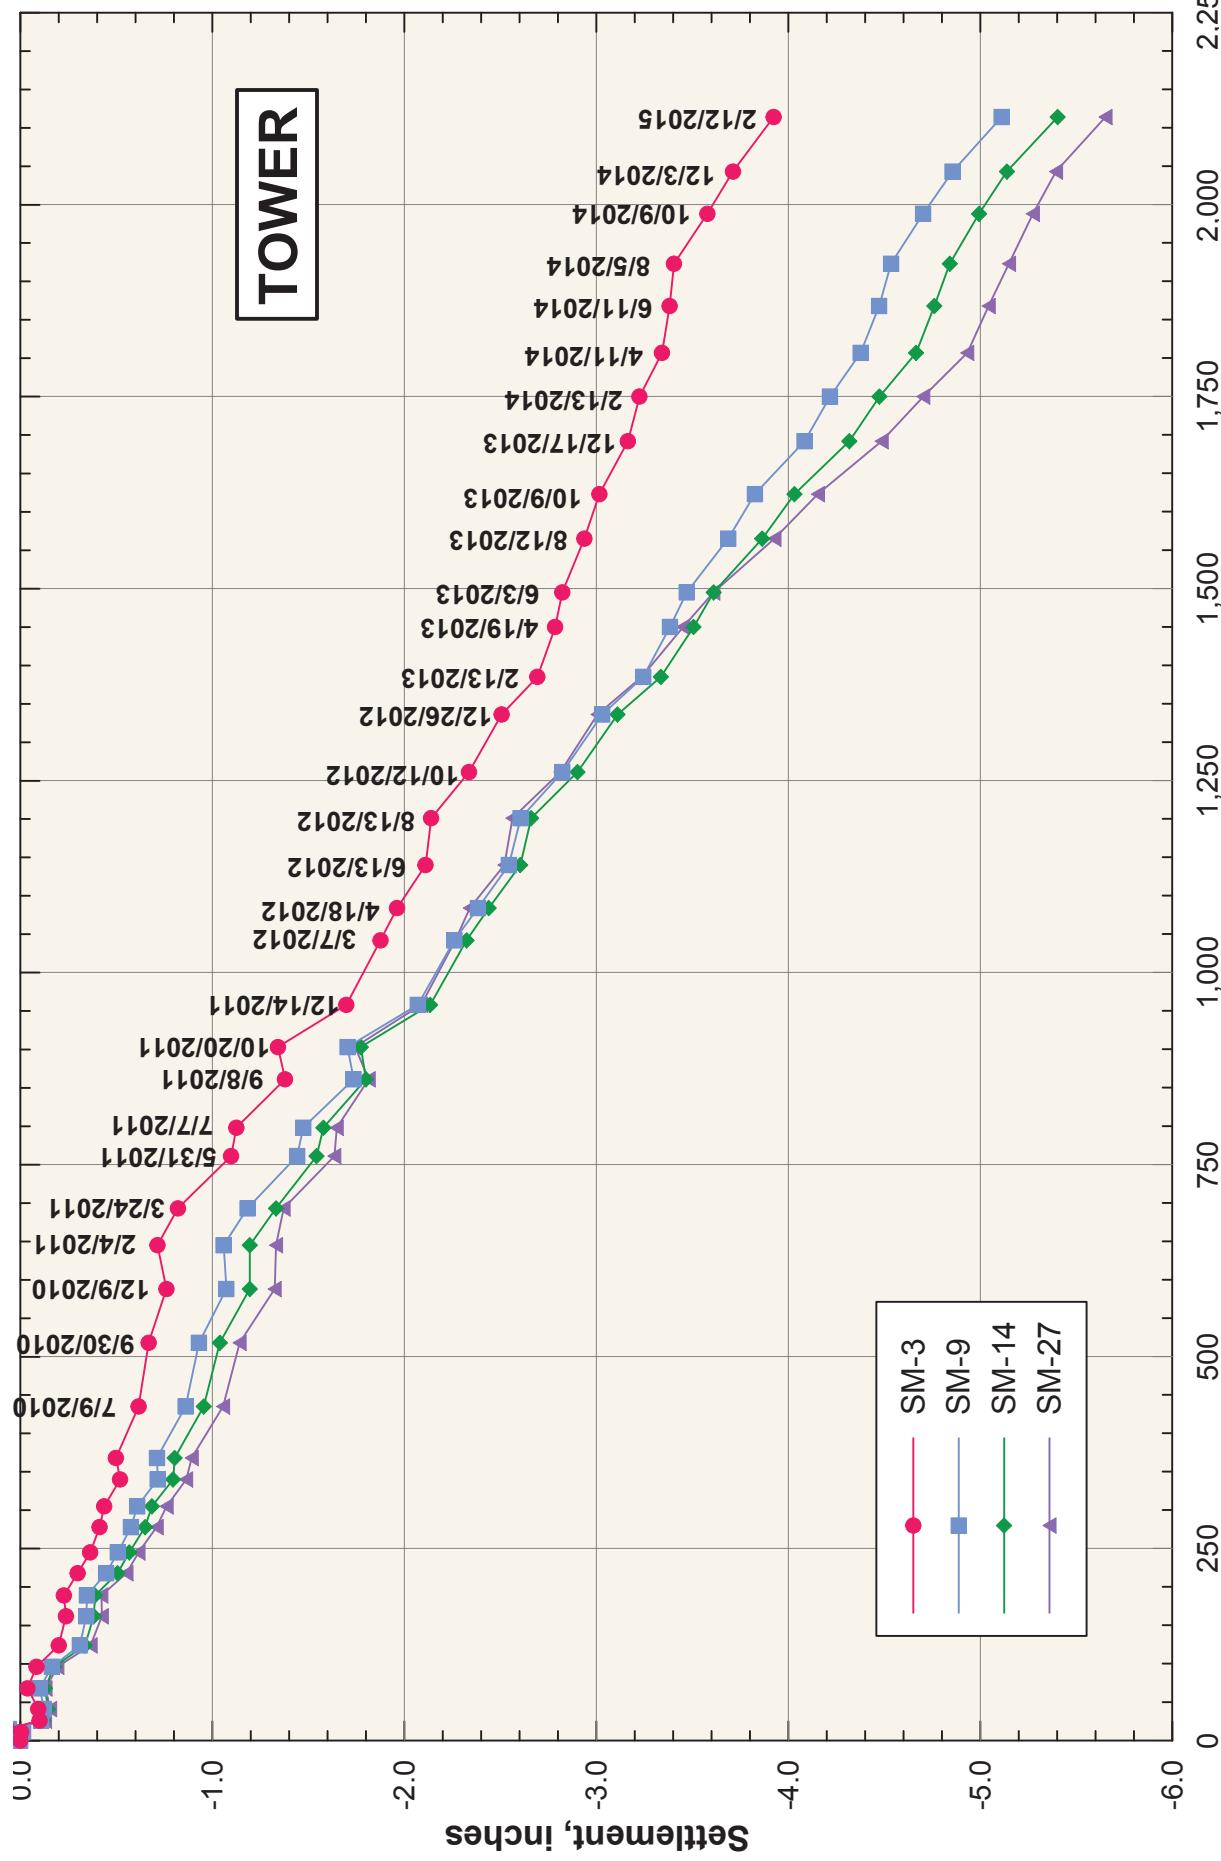



ARUP


Note:
Initial (Baseline) reading
taken on 04/30/09

J.S.F.132000.01322424 Internal Project Data4-05 Reports & Narratives\249 301 Mission - February 2015 Survey\Plates\Plate 5 Settlement Over Time - Midrise.grf

**SETTLEMENT OVER TIME
FLOOR ELEVATIONS AT LEVEL B-1
OF 301 MISSION PROPERTY - MID-RISE:
APRIL 30, 2009 THROUGH FEBRUARY 12, 2015**

Transbay Transit Center
301 Mission Monitoring
Transbay Joint Powers Authority
San Francisco, California

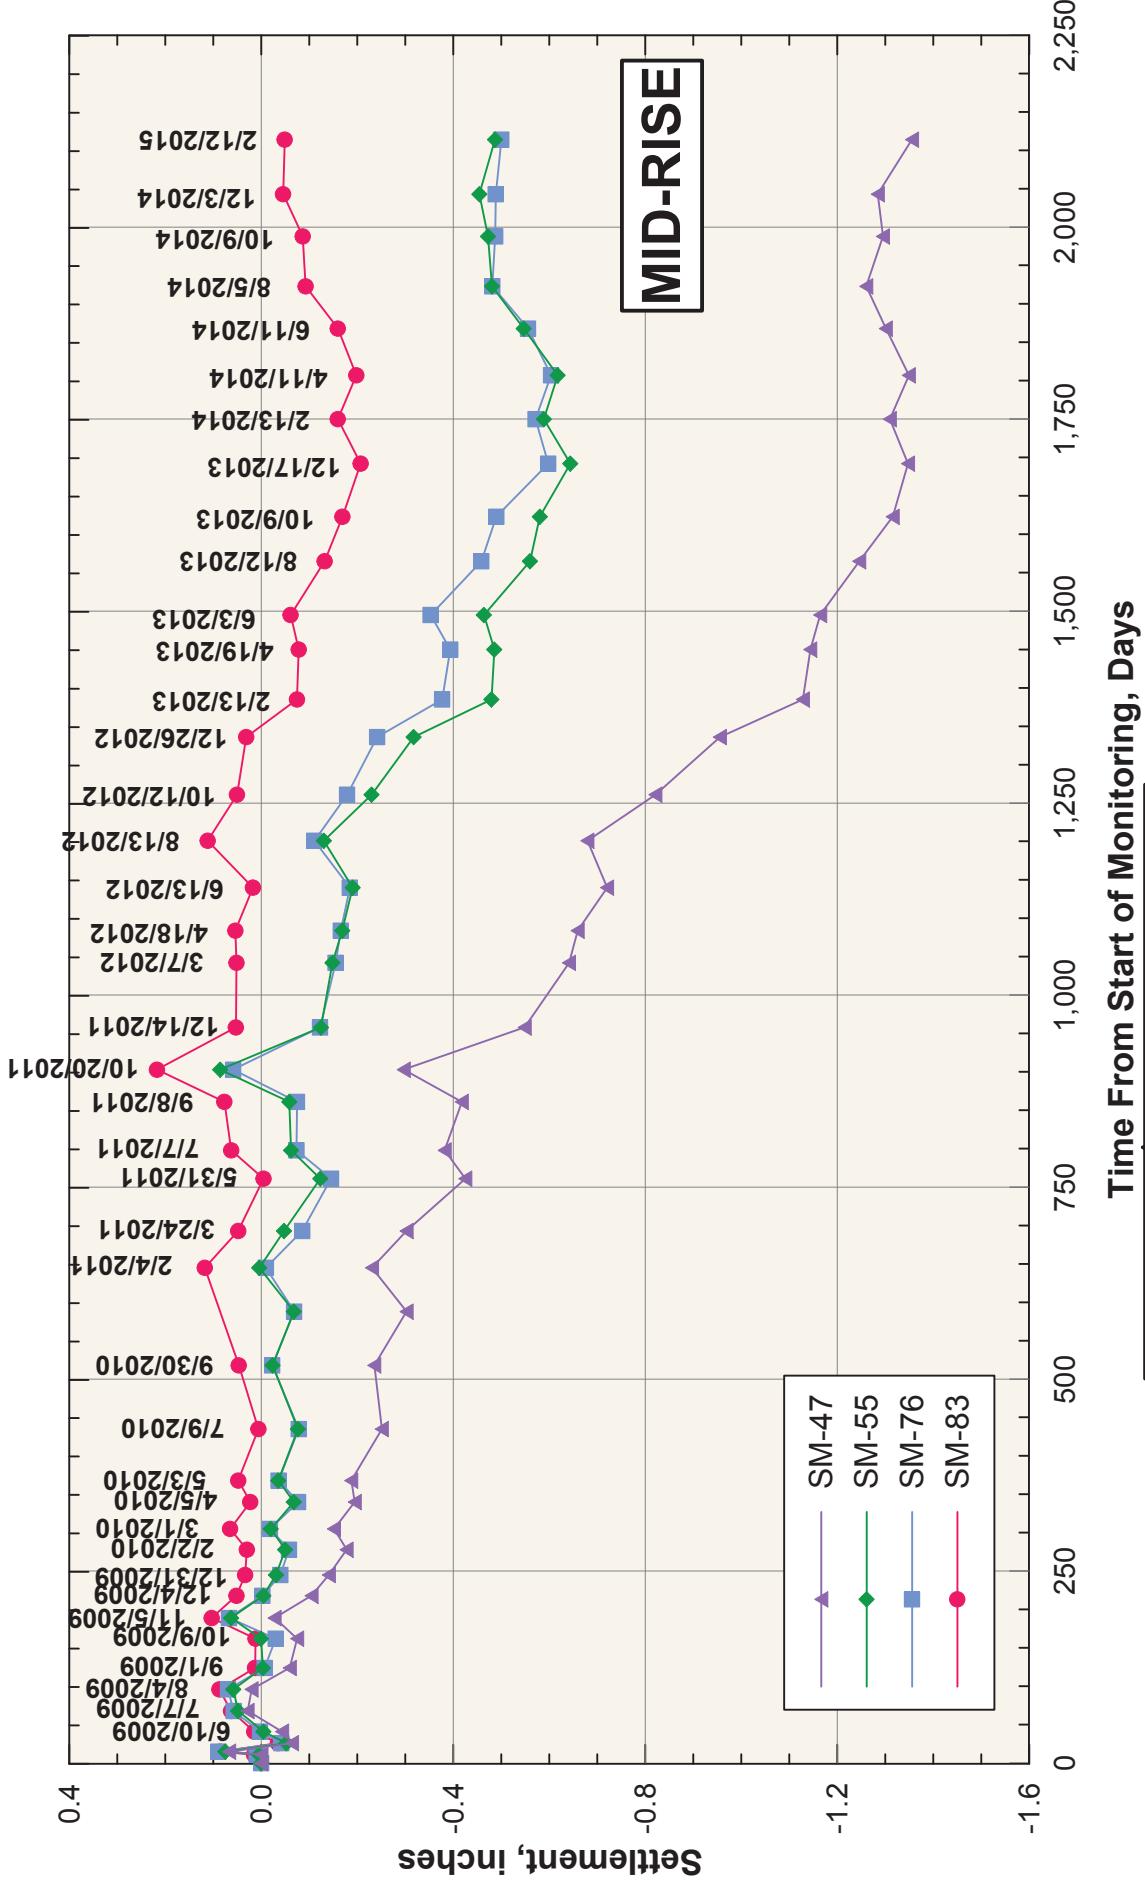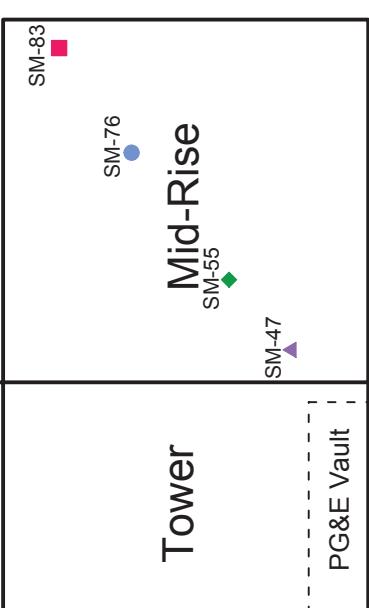

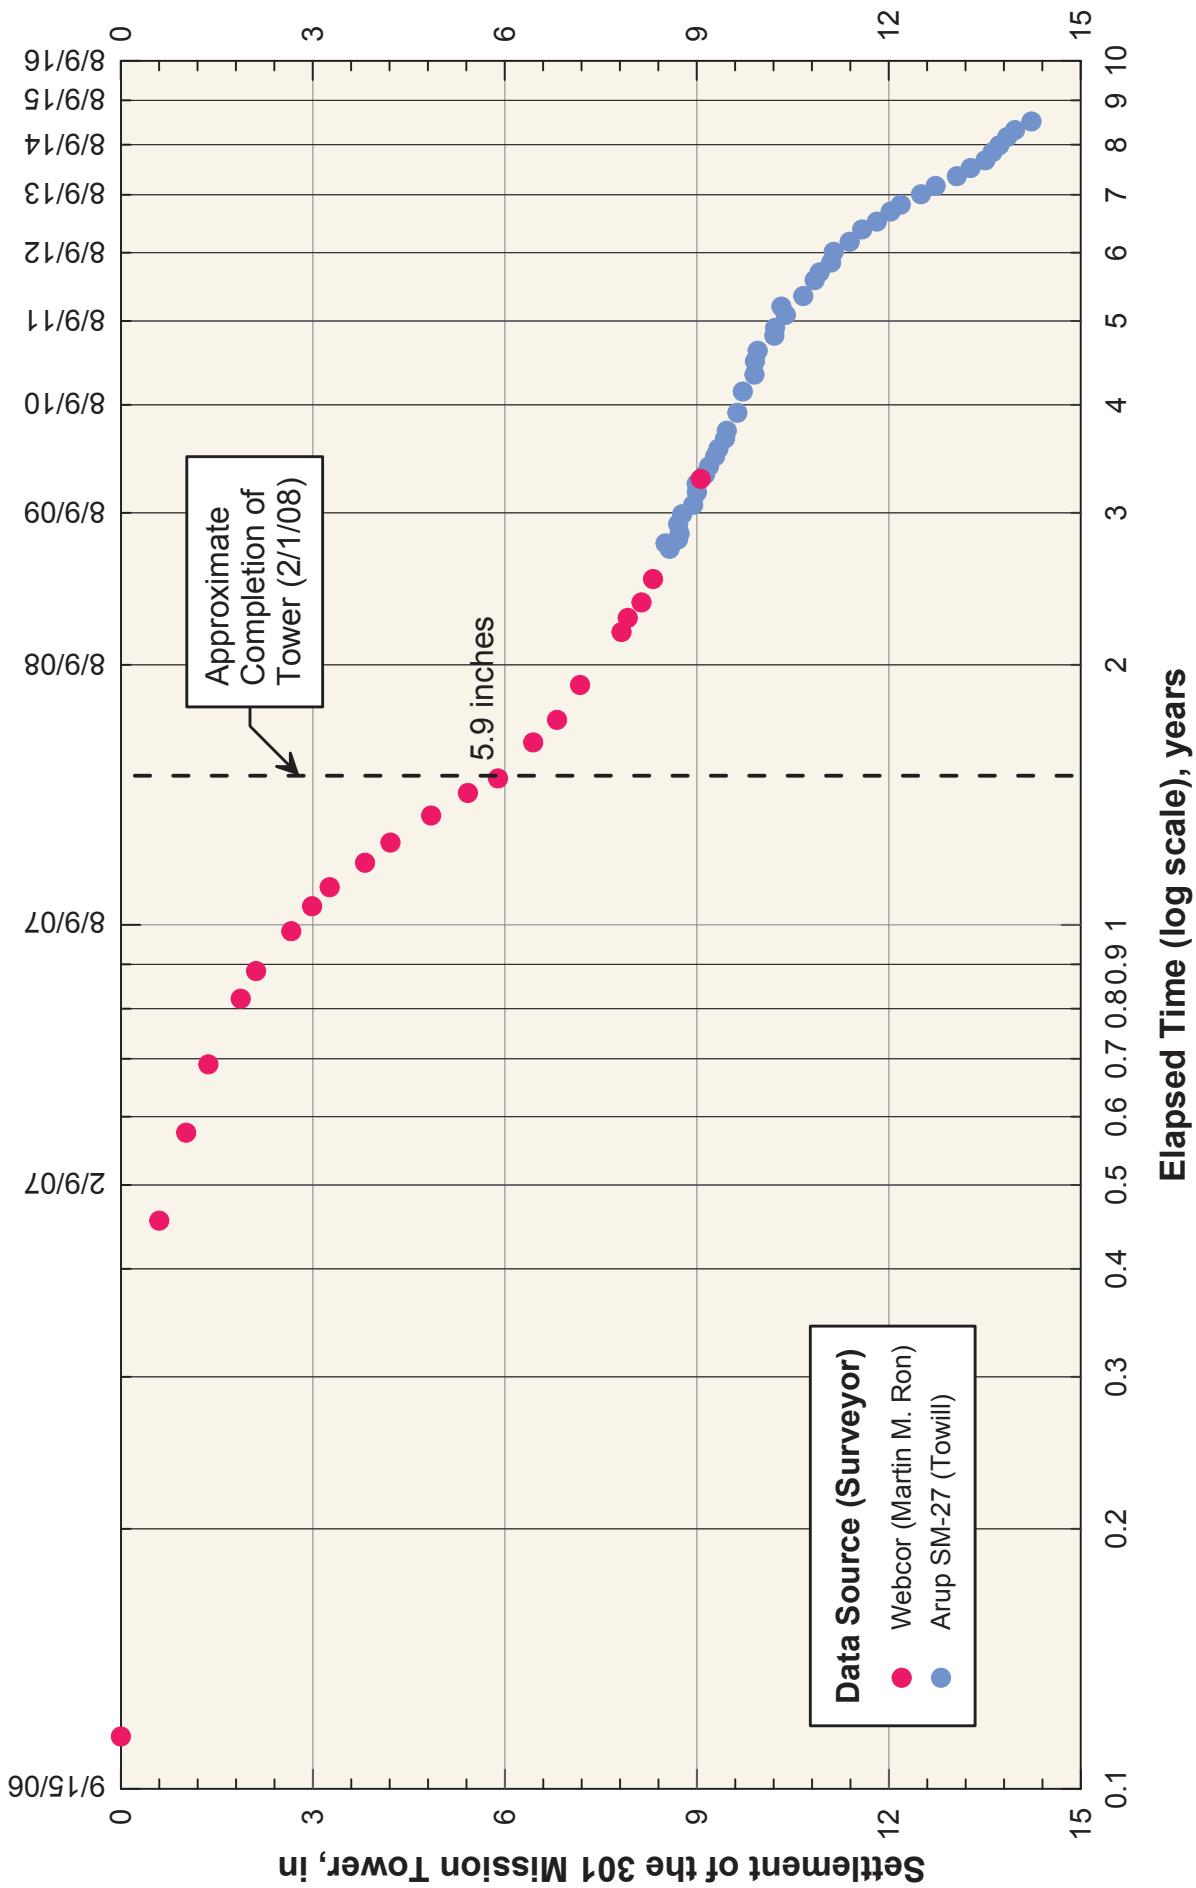



SETTLEMENTS OF THE 301 MISSION TOWER INCLUDING MONITORING DURING CONSTRUCTION

Transbay Transit Center
301 Mission Monitoring
Transbay Joint Powers Authority
San Francisco, California

March 2015

Beginning of Tower Construction: 8/9/06
End of Tower Construction: 2/1/08
Construction Duration: 542 days (1.5 years)

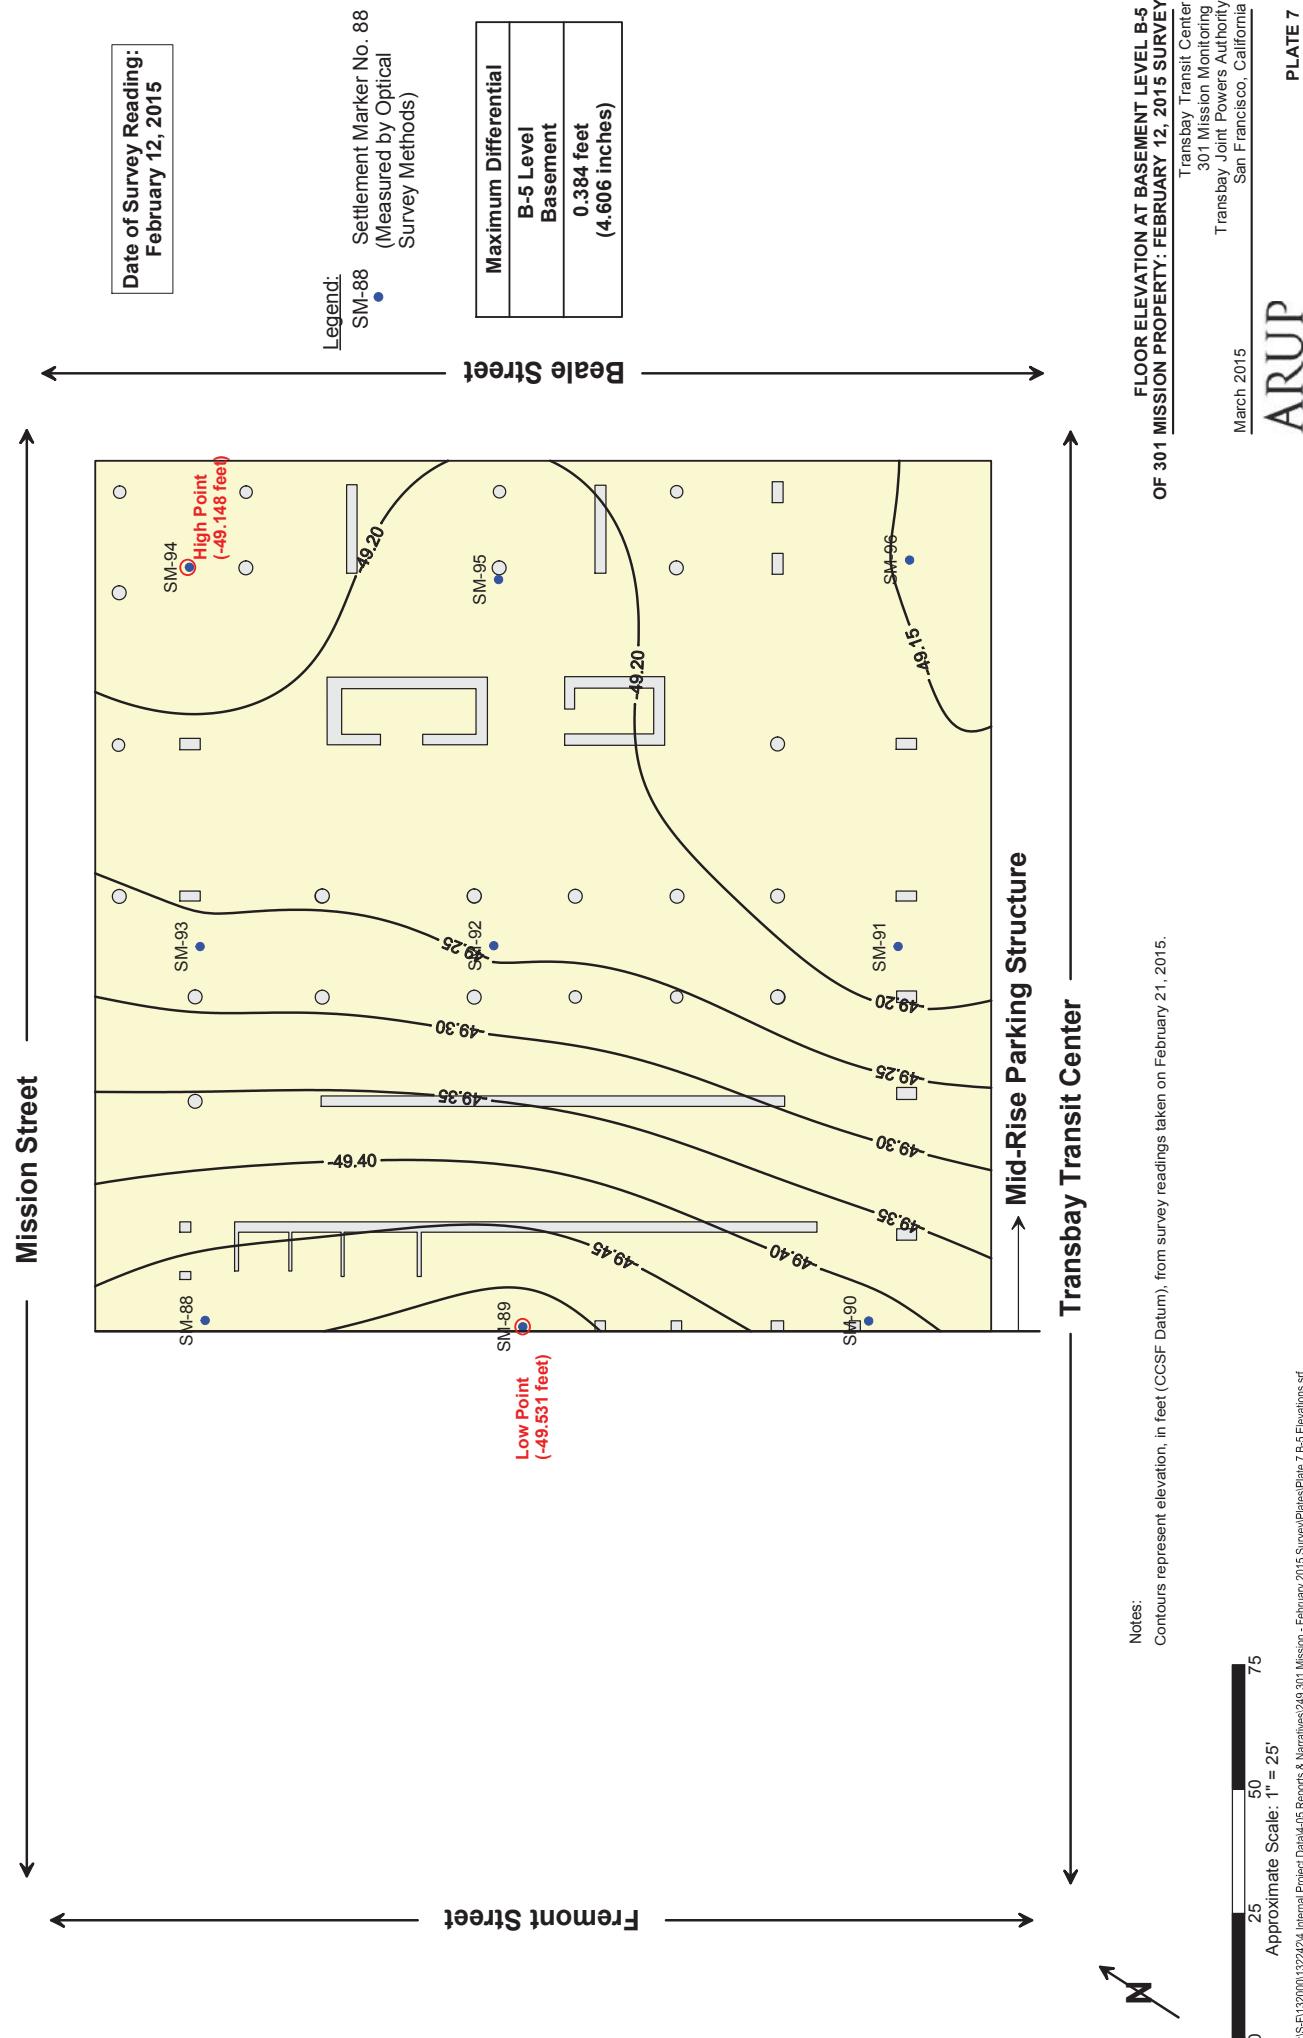

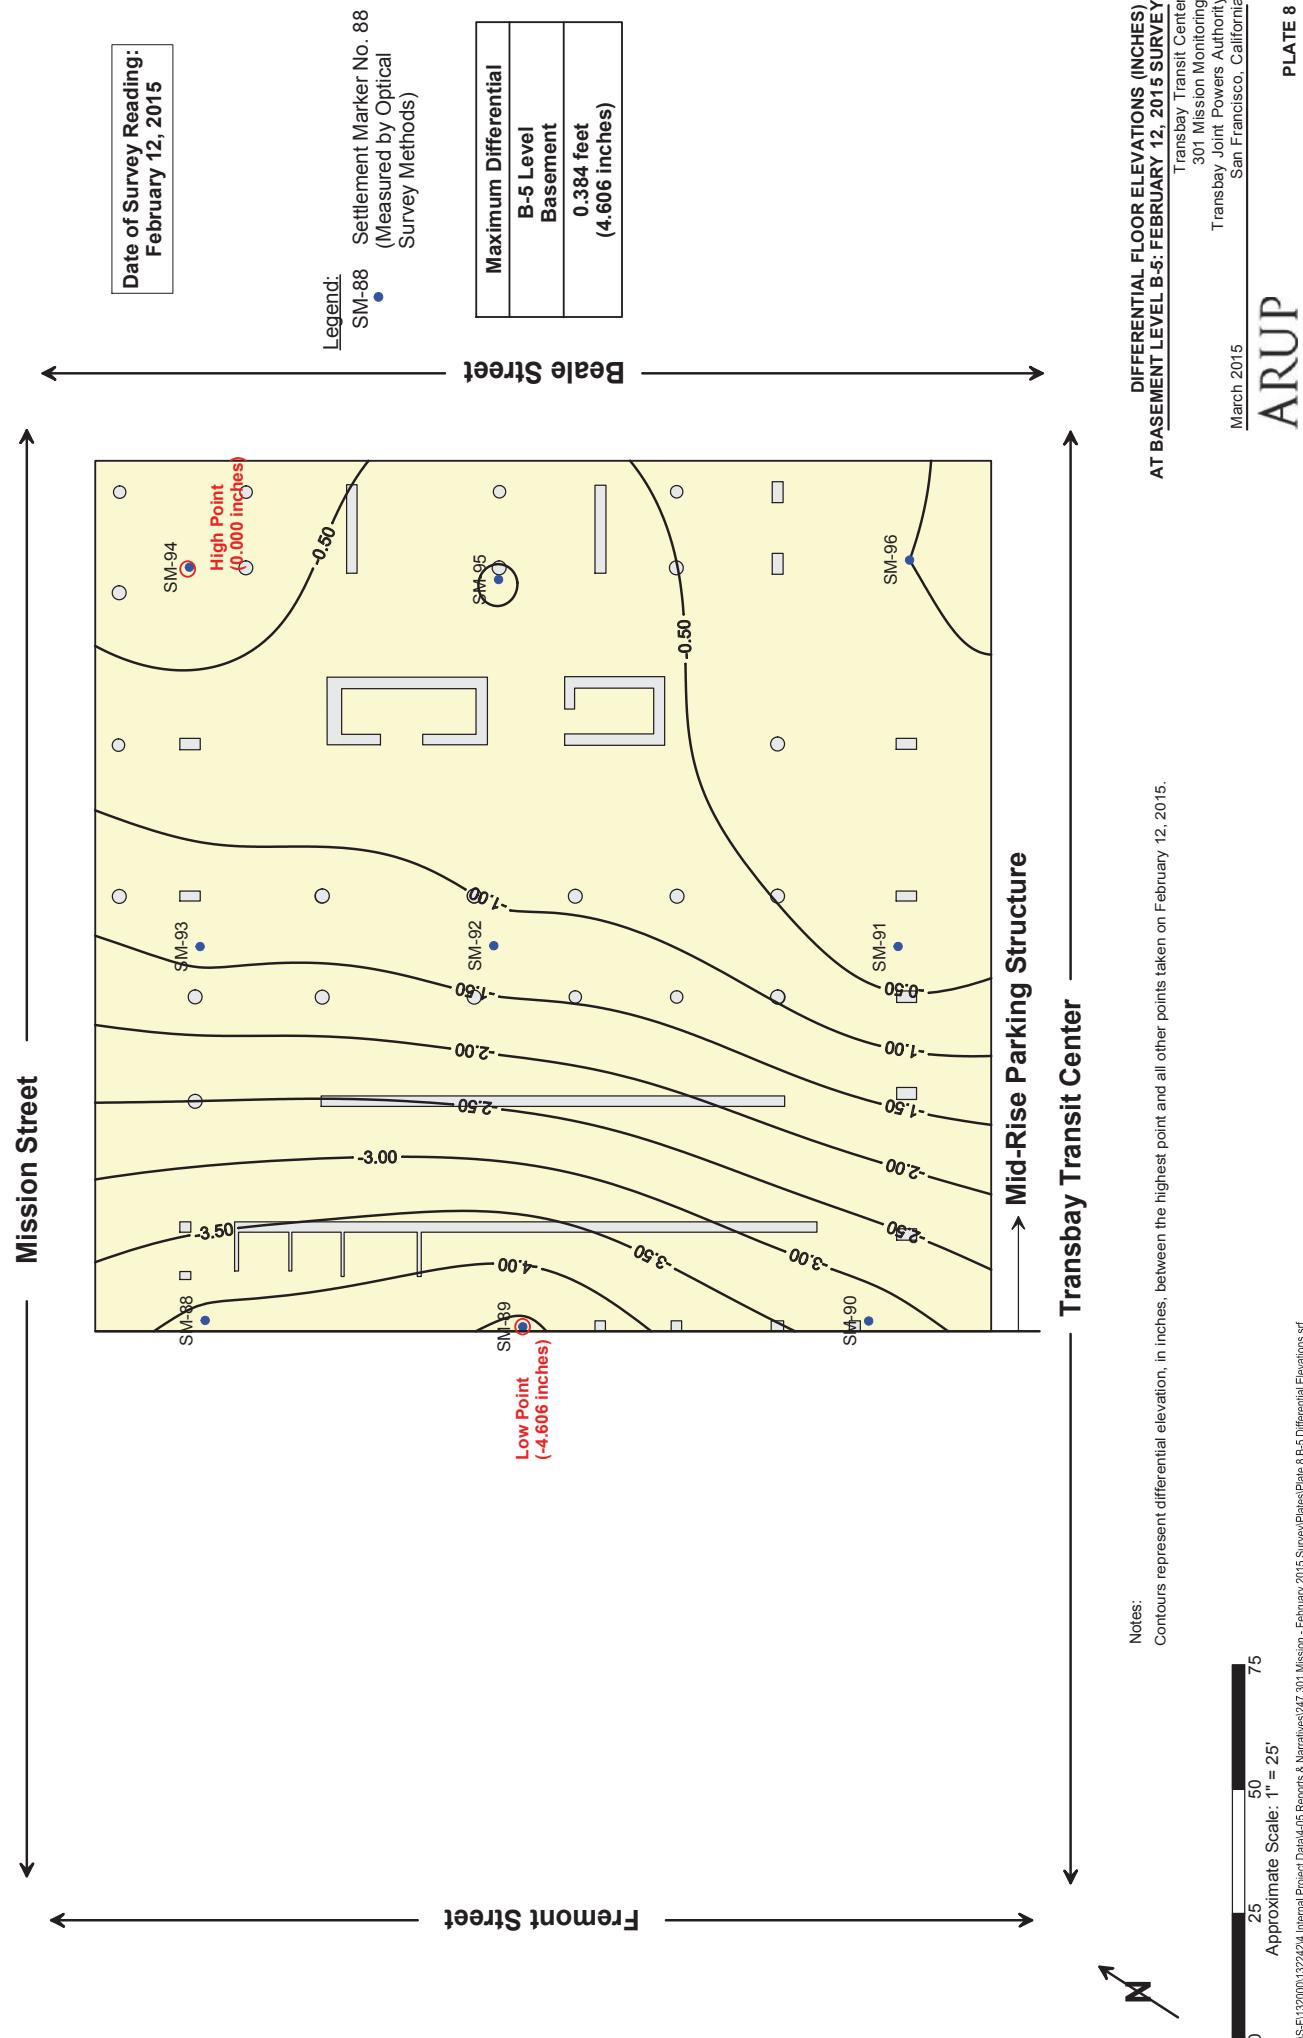

From: Brian Dykes
Sent: Wednesday, April 22, 2015 3:37 PM
To: 'shood@MillenniumPtrs.com'
Cc: Stephen.mclandrich@arup.com
Subject: Millennium Tower Survey Data

Steve,

Attached is a diagram and two tables on which are plotted the rate of movement of the Millennium Tower over time based on the data the TJPA has already provided to Millennium Partners.

The data appears to show that the tilt of the Tower to the west is increasing.

Brian.


Brian Dykes
Principal Engineer
Transbay Joint Powers Authority
201 Mission Street, Suite 2100
San Francisco, CA 94105
415 597 4617 phone
415 597 4615 fax



 Please consider the environment before printing this message.

Check out our progress at <http://transbaycenter.org/construction-updates/construction-cameras>

NOTE: This e-mail communication and any attachments hereto are covered by the Electronic Communications Privacy Act, 18 U.S.C. Sections 2510-2521, and are legally privileged. The information contained herein is confidential, and is intended only for the use of the individual or entity to whom it is addressed. If you are not the intended recipient of this e-mail communication (or an employee or agent responsible for delivering this communication to its intended recipient(s)), you are hereby notified that any retention, copying or further distribution of this e-mail communication and any attachments is strictly prohibited. If you are not the intended recipient, please notify the sender by telephoning 415-597-4620, or by forwarding an e-mail reply message addressed to TransAdmin@TransbayCenter.org confirming that you have already destroyed (deleted) the original e-mail communication and any and all copies thereof. Thank you.

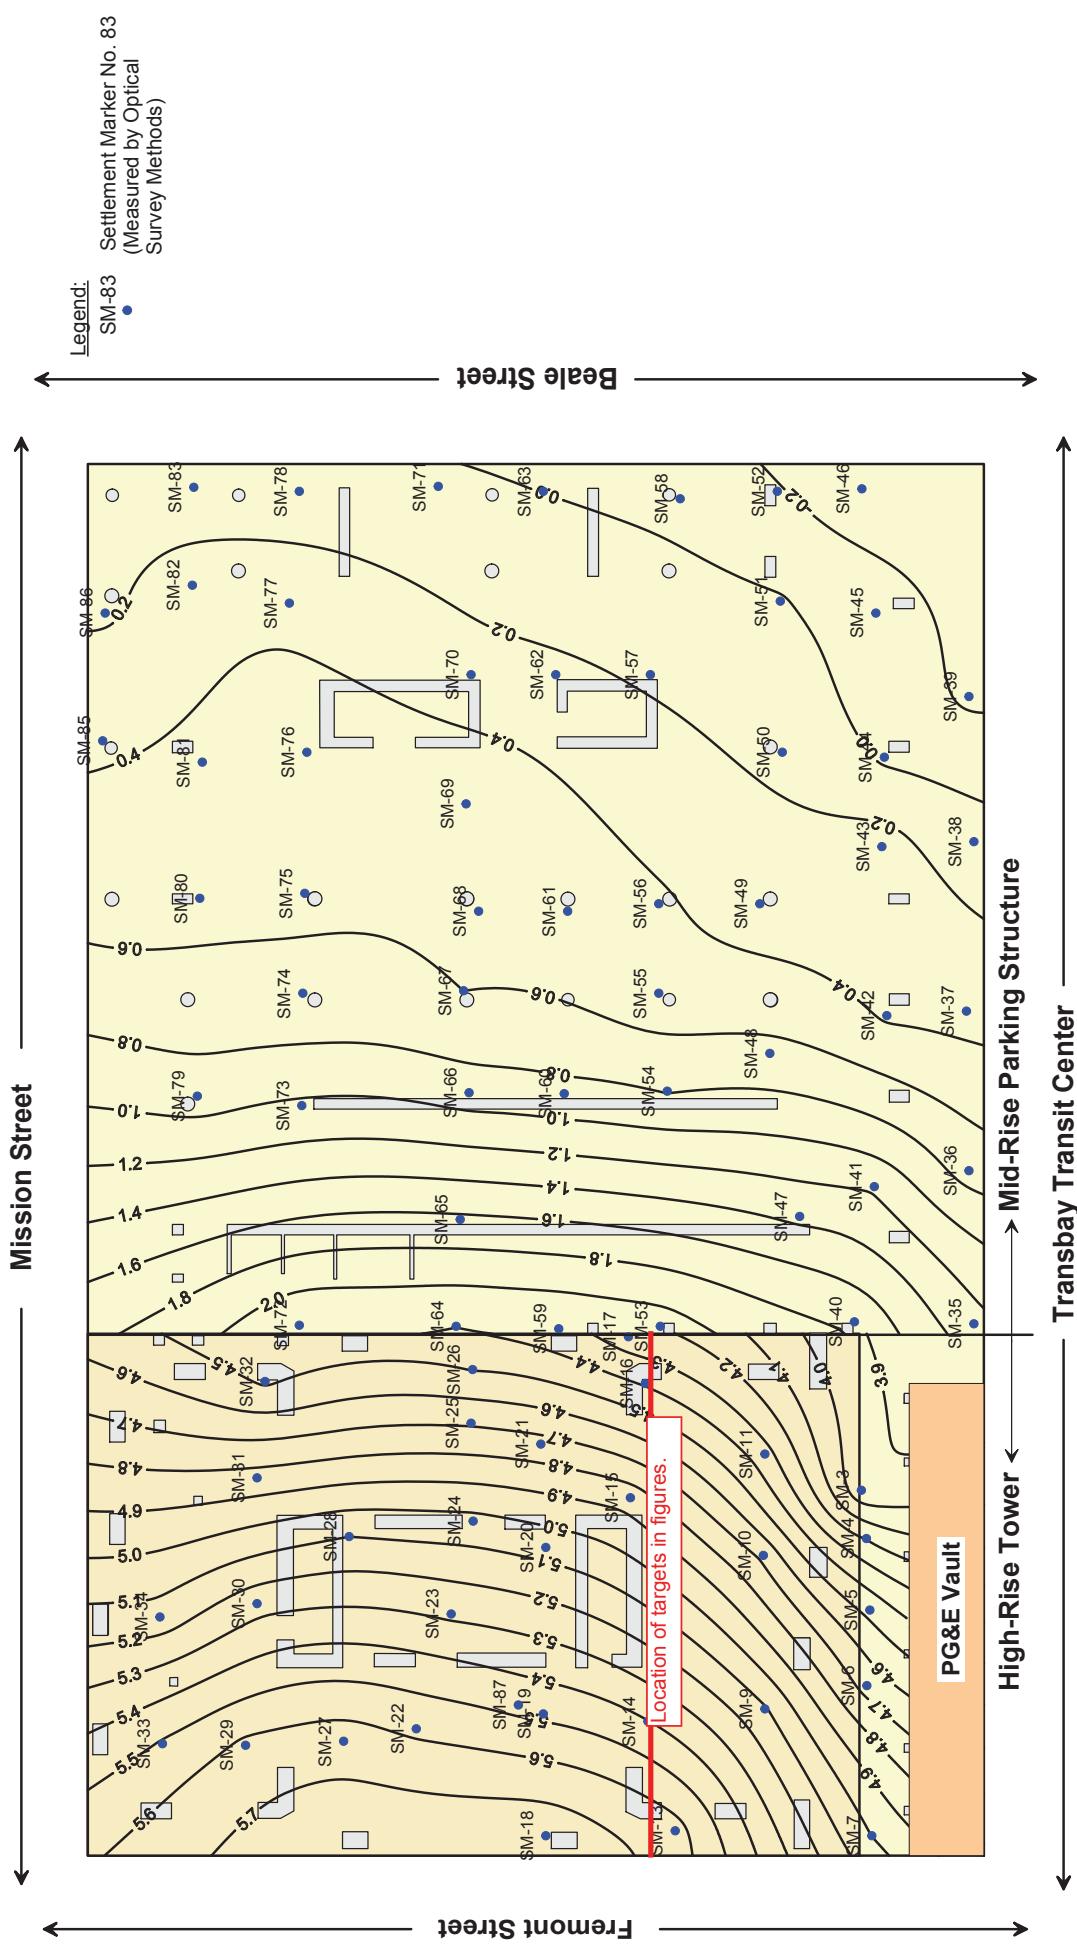


CONTOURS OF SETTLEMENTS MEASURED AT THE 1ST LEVEL BASEMENT OF THE 301 MISSION ST STRUCTURE BETWEEN 04/30/2009 & 02/12/2015
 Transbay Transit Center
 301 Mission Monitoring
 Transbay Joint Powers Authority
 San Francisco, California


March 2015

Notes:
 Contours represent elevation change, in inches, between Baseline survey (April 30, 2009) and readings taken on February 12, 2015.
 Level B-1 at Mid-Rise Parking portion of survey site is approximately 4 inches higher than Level B-1 at High-Rise Tower portion.

The PG&E vault is inaccessible for monitoring.
 Negative values of settlement (within Low-rise Tower) indicate uplift.

Approximate Scale: 1" = 25'
 0 25 50 75
 J:\\SF132000\\132242\\Internal Project\\Data405 Reports\\Narratives\\248\\301 Mission - February 2015 Survey\\Plates\\Plate 3

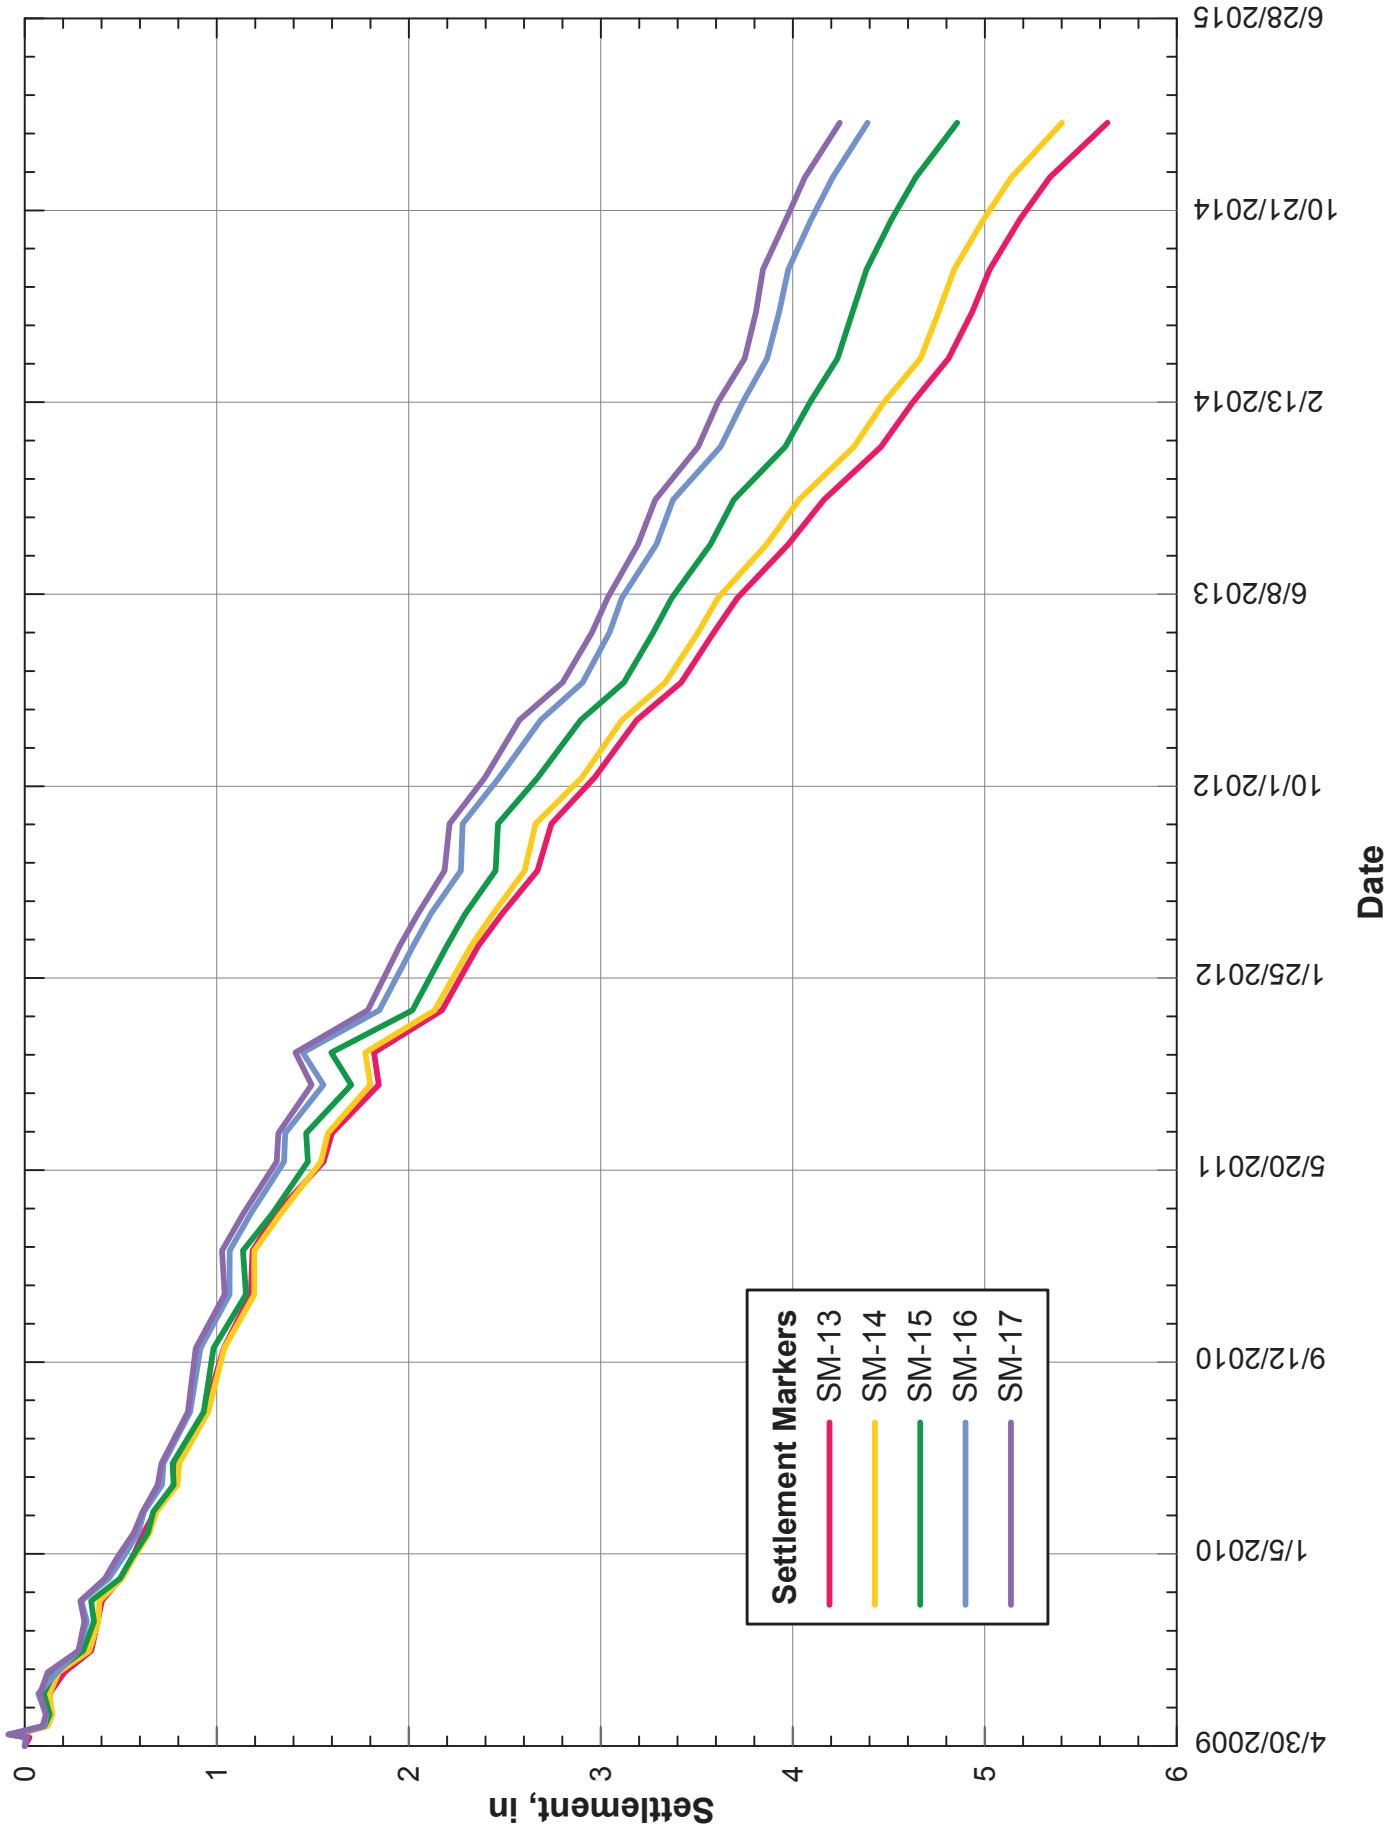

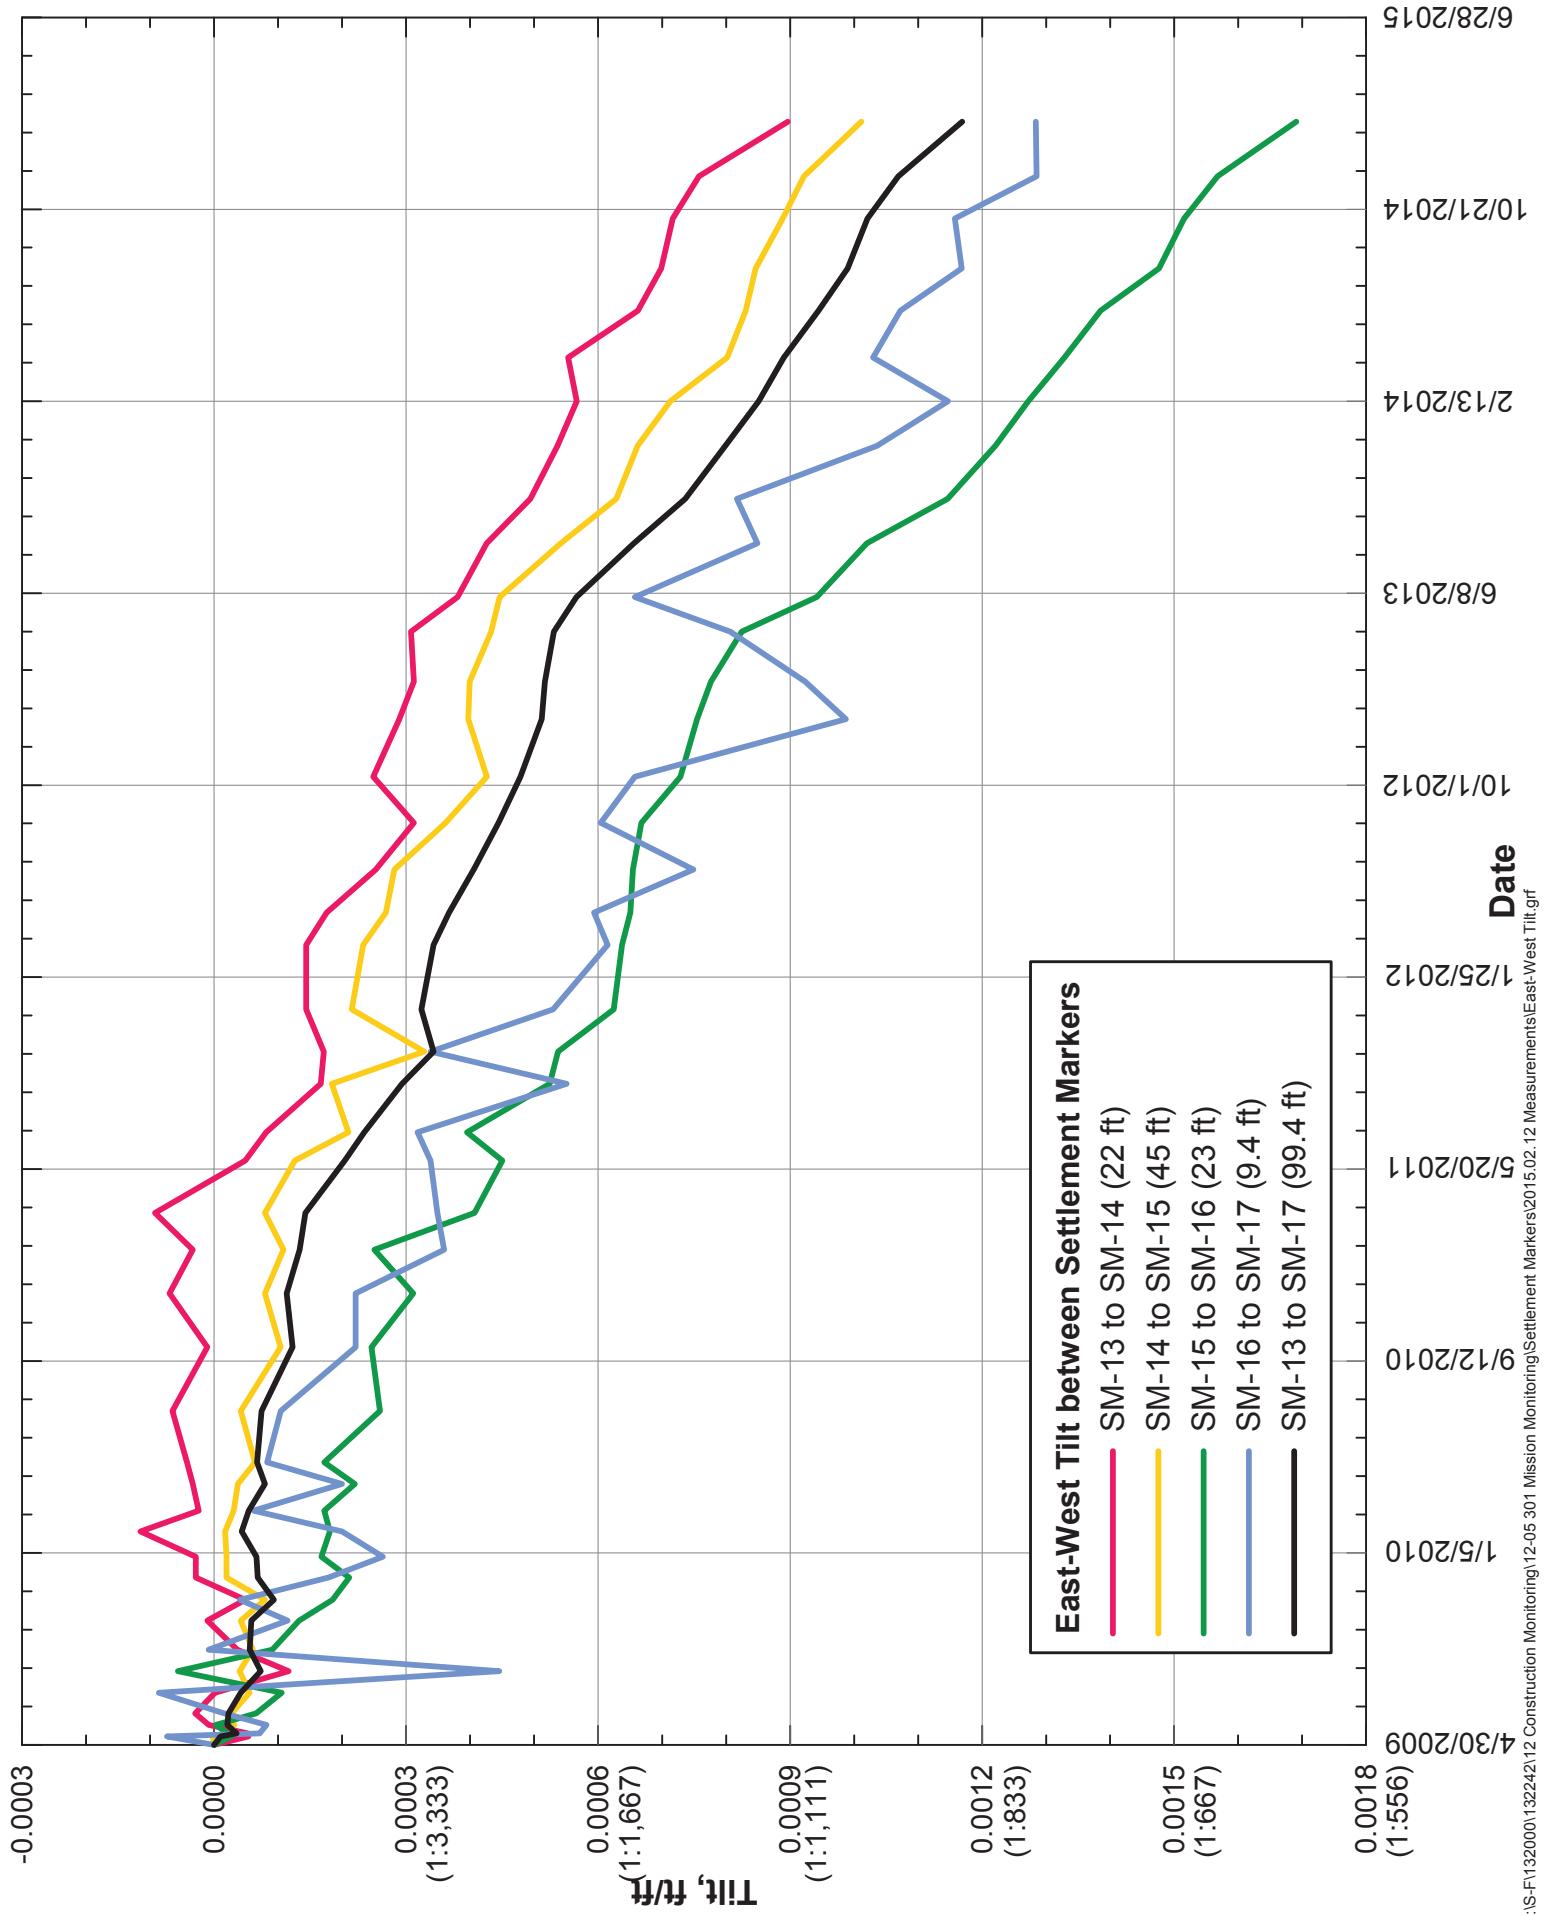

From: Brian Dykes
Sent: Wednesday, July 15, 2015 4:41 PM
To: 'shood@MillenniumPtrs.com'
Subject: FW: TTC - 301 Mission June 2015 Survey

Steve,
Here is the latest survey memorandum from Arup for the settlement readings taken in June 2015 together with the raw data values.
Regards, Brian.

From: Stephen McLandrich [<mailto:stephen.mclandrich@arup.com>]
Sent: Wednesday, July 15, 2015 12:02 PM
To: Brian Dykes
Cc: Jeff Dunn
Subject: TTC - 301 Mission June 2015 Survey

Brian,

Here is the memo for the June 2015 survey at 301 Mission as well as the raw values.

We hope to get the inclinometer memo to you later this week, however, there are some inclinometers that need to be re-done, so it may be next week.

Let me know if you have any questions.

Regards,
Stephen

Stephen McLandrich PE GE

Senior Geotechnical Engineer

Arup
560 Mission Street Suite 700 San Francisco CA 94105 USA
t +1 415 957 9445 d +1 415 946 0245
f +1 415 957 9096 c +1 415 310 1095
www.arup.com

Check out our progress at <http://transbaycenter.org/construction-updates/construction-cameras>

NOTE: This e-mail communication and any attachments hereto are covered by the Electronic Communications Privacy Act, 18 U.S.C. Sections 2510-2521, and are legally privileged. The information contained herein is confidential, and is intended only for the use of the individual or entity to whom it is addressed. If you are not the intended recipient of this e-mail communication (or an employee or agent responsible for delivering this communication to its intended recipient(s)), you are hereby notified that any retention, copying or further distribution of this e-mail communication and any attachments is strictly prohibited. If you are not the intended recipient, please notify the sender by telephoning 415-597-4620, or by forwarding an e-mail reply message addressed to TransAdmin@TransbayCenter.org confirming that you have already destroyed (deleted) the original e-mail communication and any and all copies thereof. Thank you.

Memorandum

ARUP


To	Brian Dykes (TJPA)	Date
		July 15, 2015
Copies	Randy Volenec (PCPA) George Metzger (AAI)	Reference number 132242
From	Stephen McLandrich (Arup) Taki Vlasakakis (Arup)	File reference 4-05 251
Subject	Transbay Transit Center: Results of June 2015 Settlement Survey at 301 Mission Property	Page 1 of 1

Under Arup's Geotechnical Contract with the Transbay Joint Powers Authority through Pelli Clark Pelli Architects, Arup is required to monitor the settlements of the buildings adjacent to the Transbay Transit Center prior to and during construction. We began the monitoring program for the 301 Mission property in April of 2009. This memorandum and the attached plates present an update to our memorandum dated February 12, 2015 with measurements made through June 2015.

Note Typo: should refer to "March 4, 2015" report

List of Plates

- Plate 1 Floor Elevations at Level B-1 of 301 Mission Property: Periodic Survey – June 4, 2015
- Plate 2 Differential Floor Elevation (Inches) June 4, 2015 Survey
- Plate 3 Contours of Settlements Measured at the 1st Level Basement of the 301 Mission St. Structure Between 04/30/2009 & 6/4/2014
- Plate 4 Settlement Over Time Floor Elevations at Level B-1 of 301 Mission Property – Tower: April 30, 2009 through June 4, 2015
- Plate 5 Settlement Over Time Floor Elevations at Level B-1 of 301 Mission Property – Mid-Rise: April 30, 2009 through June 4, 2015
- Plate 6 Settlements of the 301 Mission Tower Including Monitoring During Construction
- Plate 7 Floor Elevation at Basement Level B-5 of 301 Mission Property: June 4, 2015 Survey
- Plate 8 Differential Floor Elevations (Inches) at Basement Level B-5: June 4, 2015 Survey

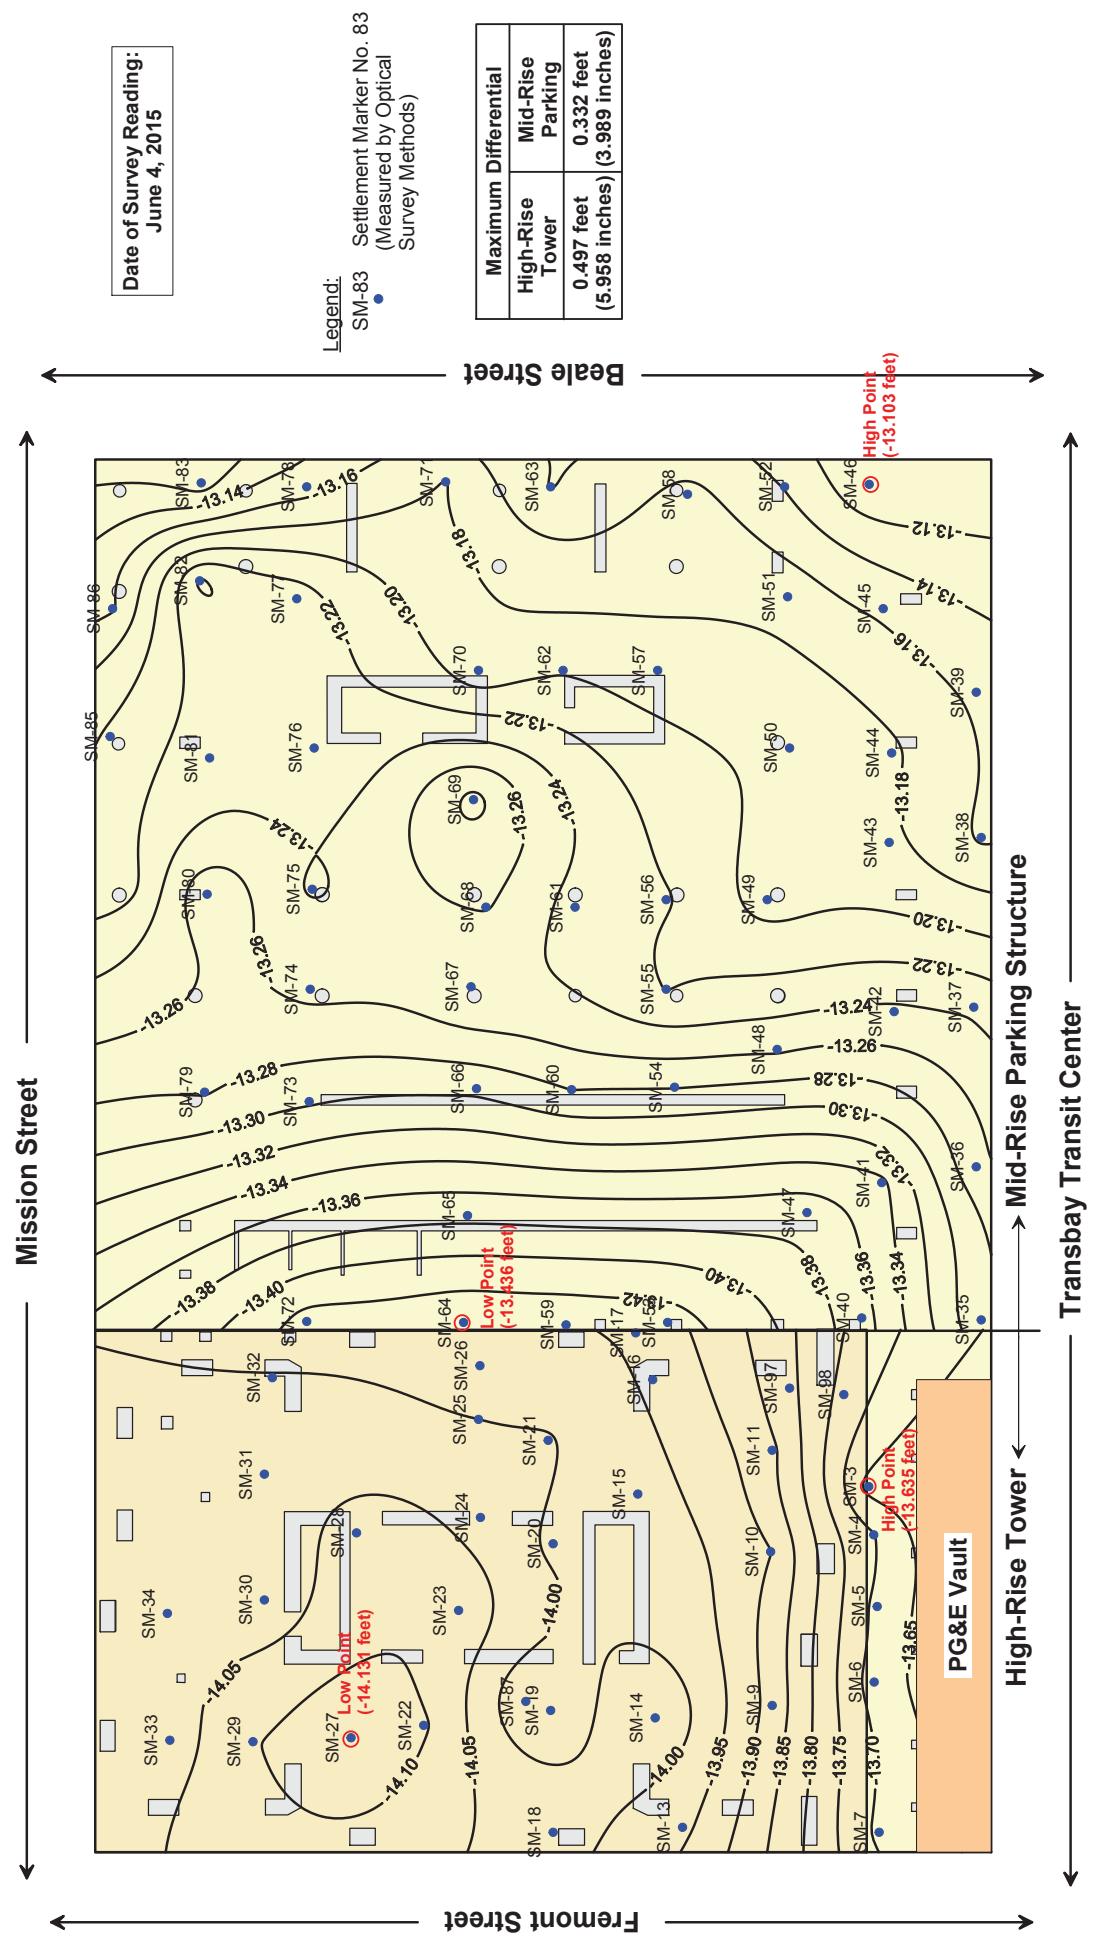

**FLOOR ELEVATIONS AT LEVEL B-1
OF 301 MISSION PROPERTY:
PERIODIC SURVEY - JUNE 4, 2015**

Transbay Transit Center
301 Mission Monitoring
Transbay Joint Powers Authority
San Francisco, California

July 2015

PLATE 1



Notes:


Contours represent elevation, in feet (CCSF Datum), from survey readings taken on June 4, 2015.

Level B-1 at Mid-Rise Parking portion of survey site is approximately 4 inches higher than Level B-1 at High-Rise Tower portion.


The PG&E vault is inaccessible for monitoring.

Approximate Scale: 1" = 25'

0 25 50 75

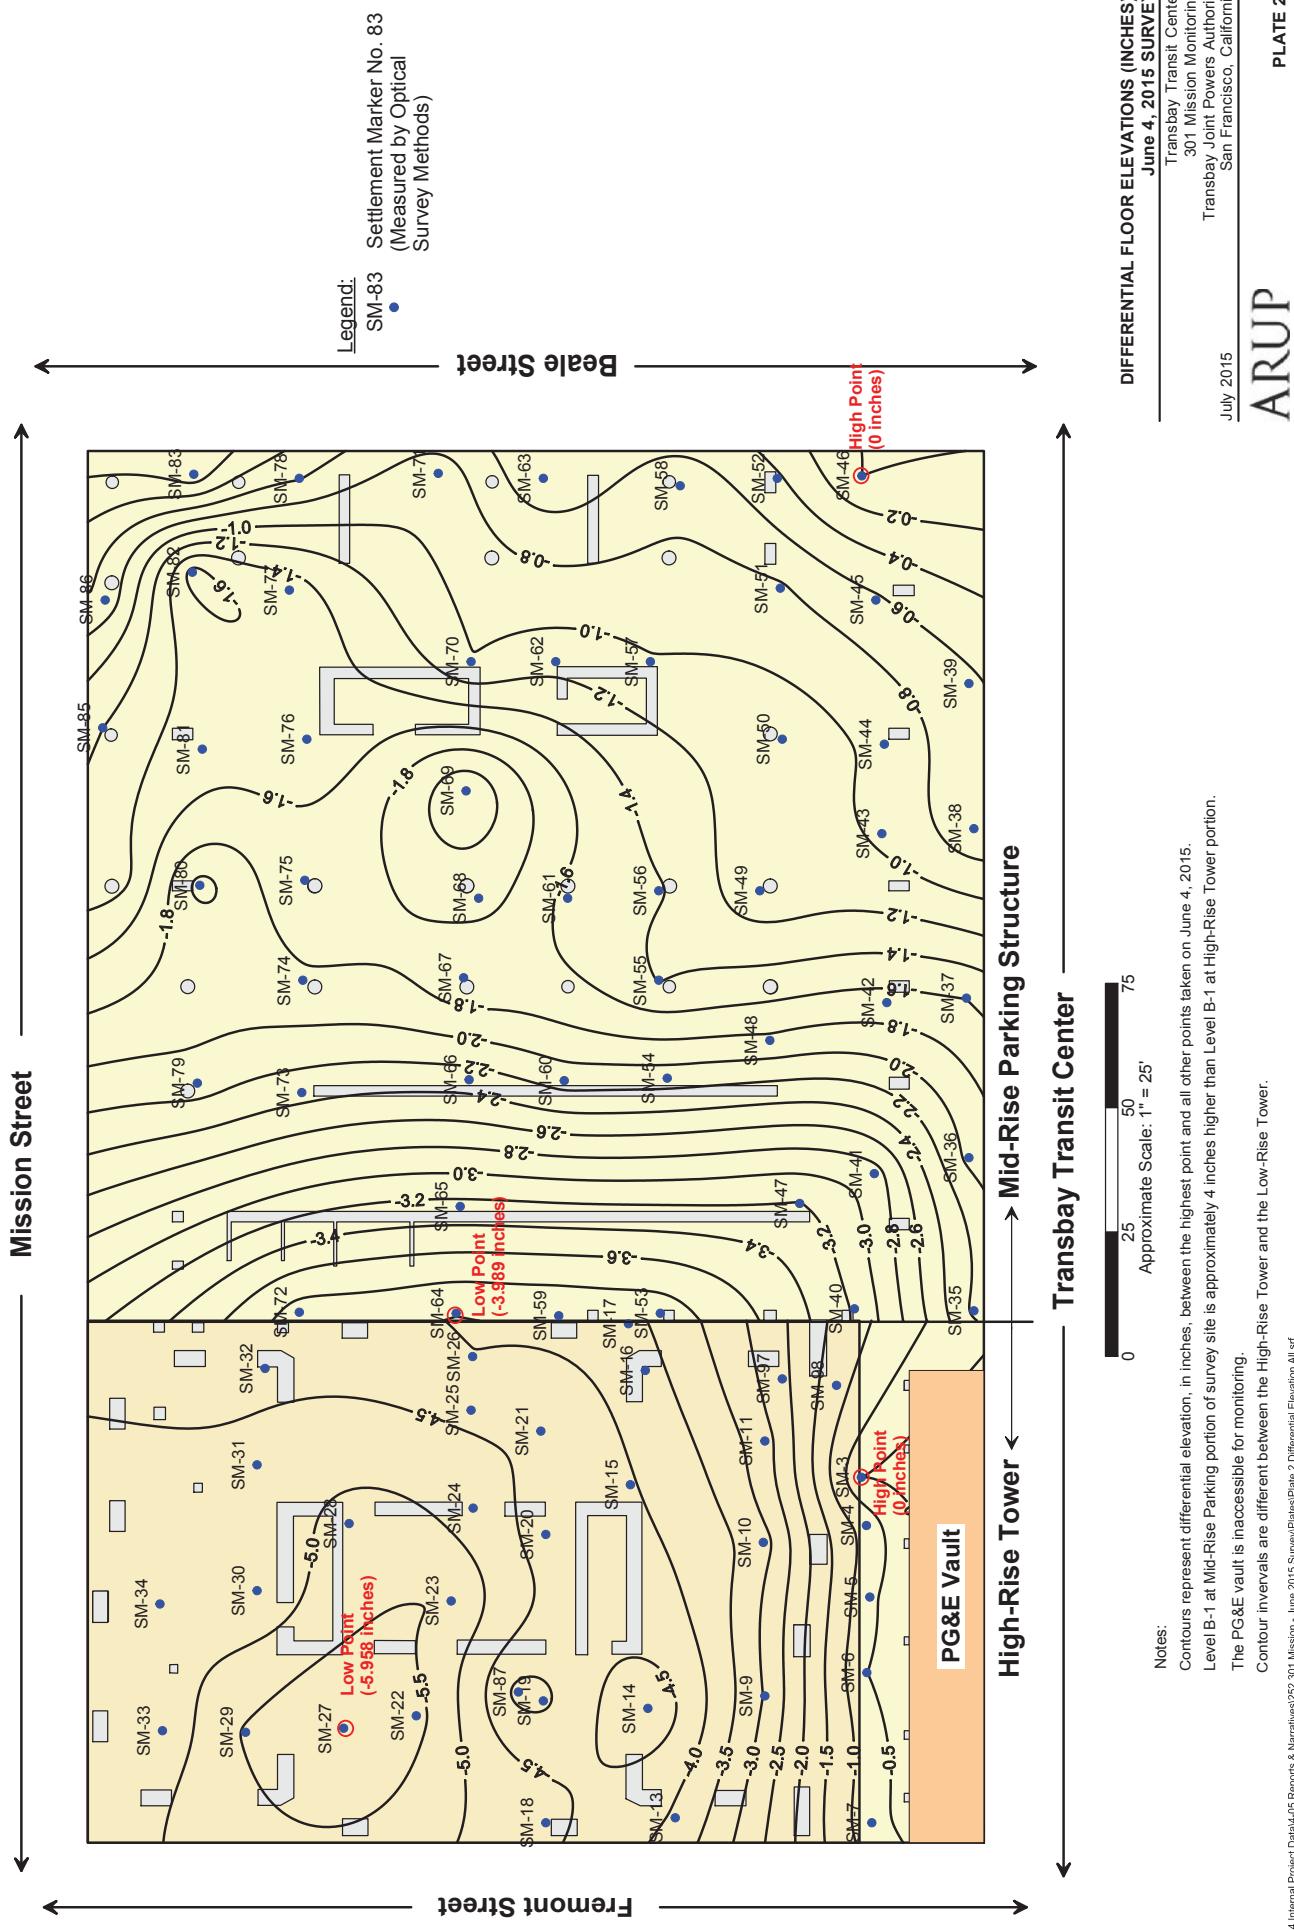

1-S_EU132200013224241d Internal Project Data4-05 Ronorts & Narratives252 301 Mission - June 2015 SurveyPlatesPlate 2 Differential Elevation All Srf Contour Intervals are uninterfere between the right


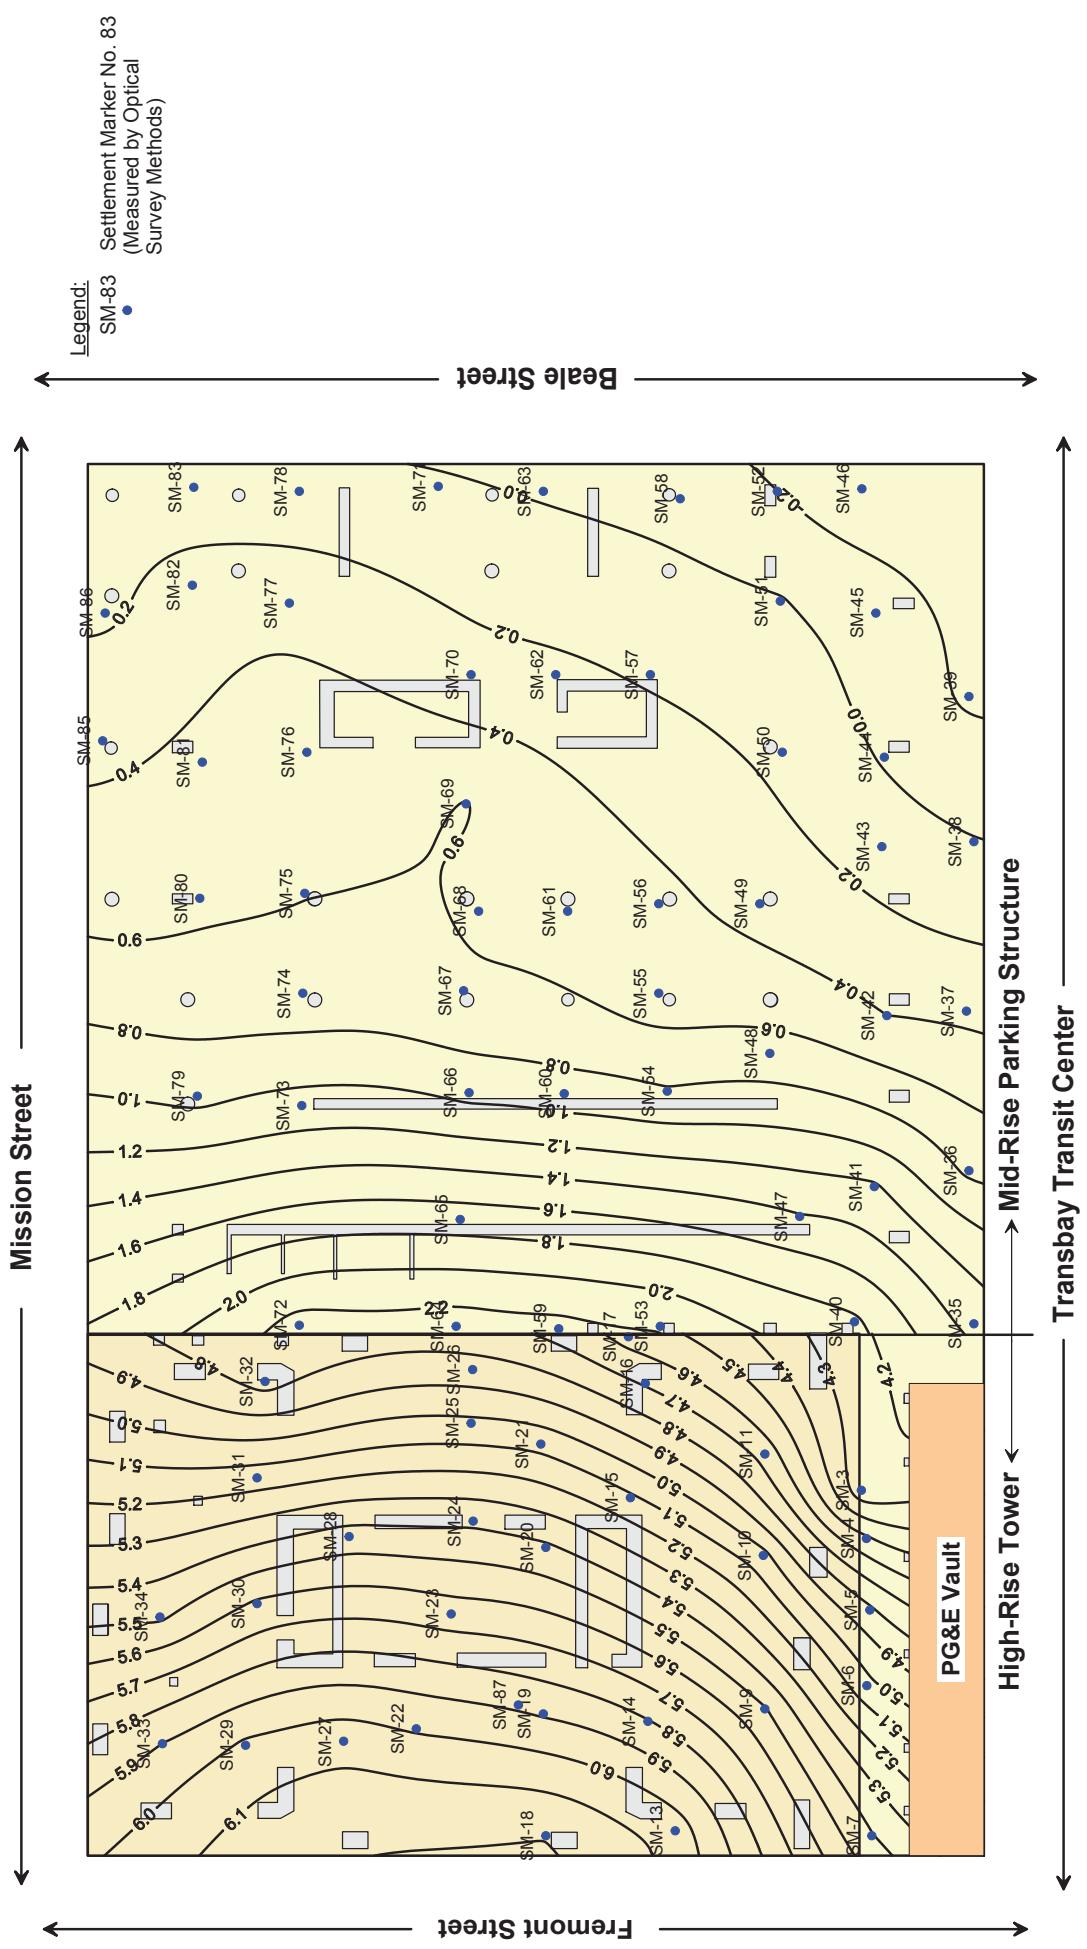


CONTOURS OF SETTLEMENTS MEASURED AT THE 1ST LEVEL BASEMENT OF THE 301 MISSION STRUCTURE BETWEEN 04/30/2009 & 6/4/2015

Transbay Transit Center
301 Mission Monitoring
Transbay Joint Powers Authority
San Francisco, California

July 2015

ARUP

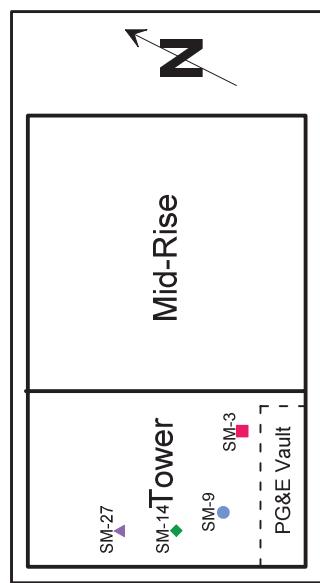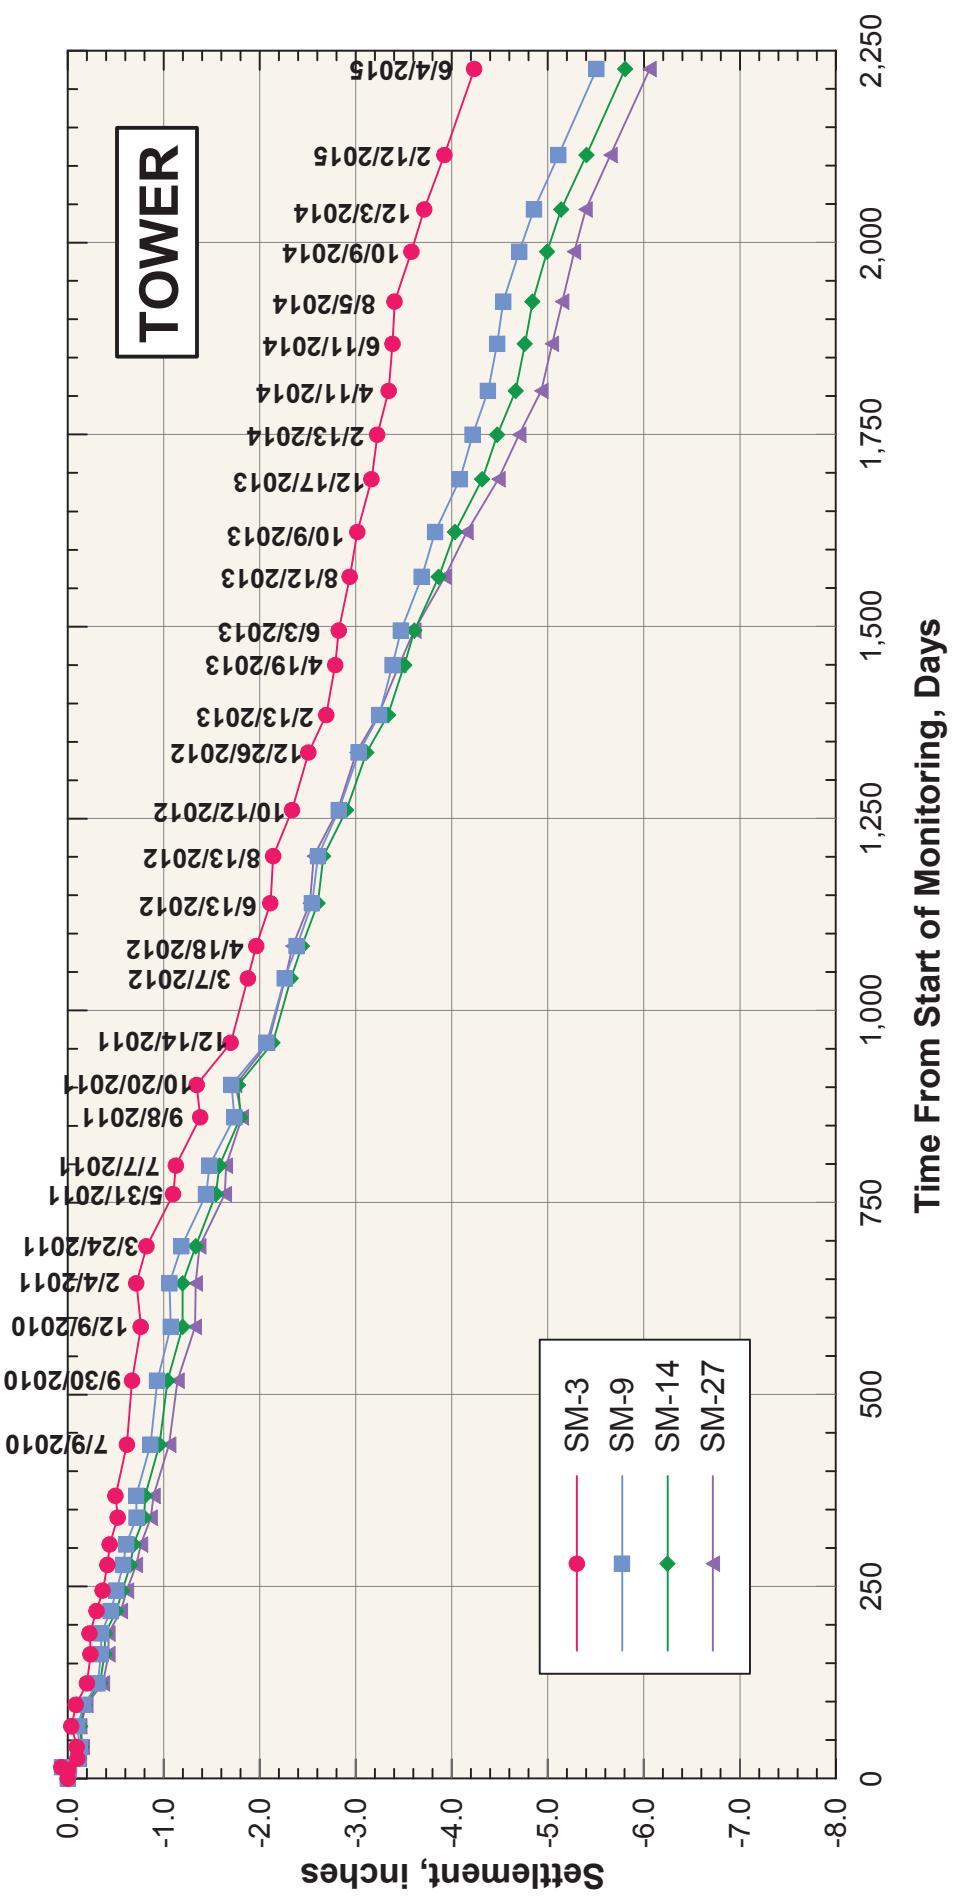

**SETTLEMENT OVER TIME
FLOOR ELEVATIONS AT LEVEL B-1
OF 301 MISSION PROPERTY- TOWER:
APRIL 30, 2009 THROUGH JUNE 4, 2015**

Transbay Transit Center
301 Mission Monitoring
Transbay Joint Powers Authority
San Francisco, California

ARUP

Note:
Initial (Baseline) reading
taken on 04/30/09

SM-47

Mid-Rise

SM-55

N

Tower



SM-76

PG&E Vault

SM-83

**SETTLEMENT OVER TIME
FLOOR ELEVATIONS AT LEVEL B-1
OF 301 MISSION PROPERTY - MID-RISE:
APRIL 30, 2009 THROUGH JUNE 4, 2015**

Transbay Transit Center
301 Mission Monitoring
Transbay Joint Powers Authority
San Francisco, California

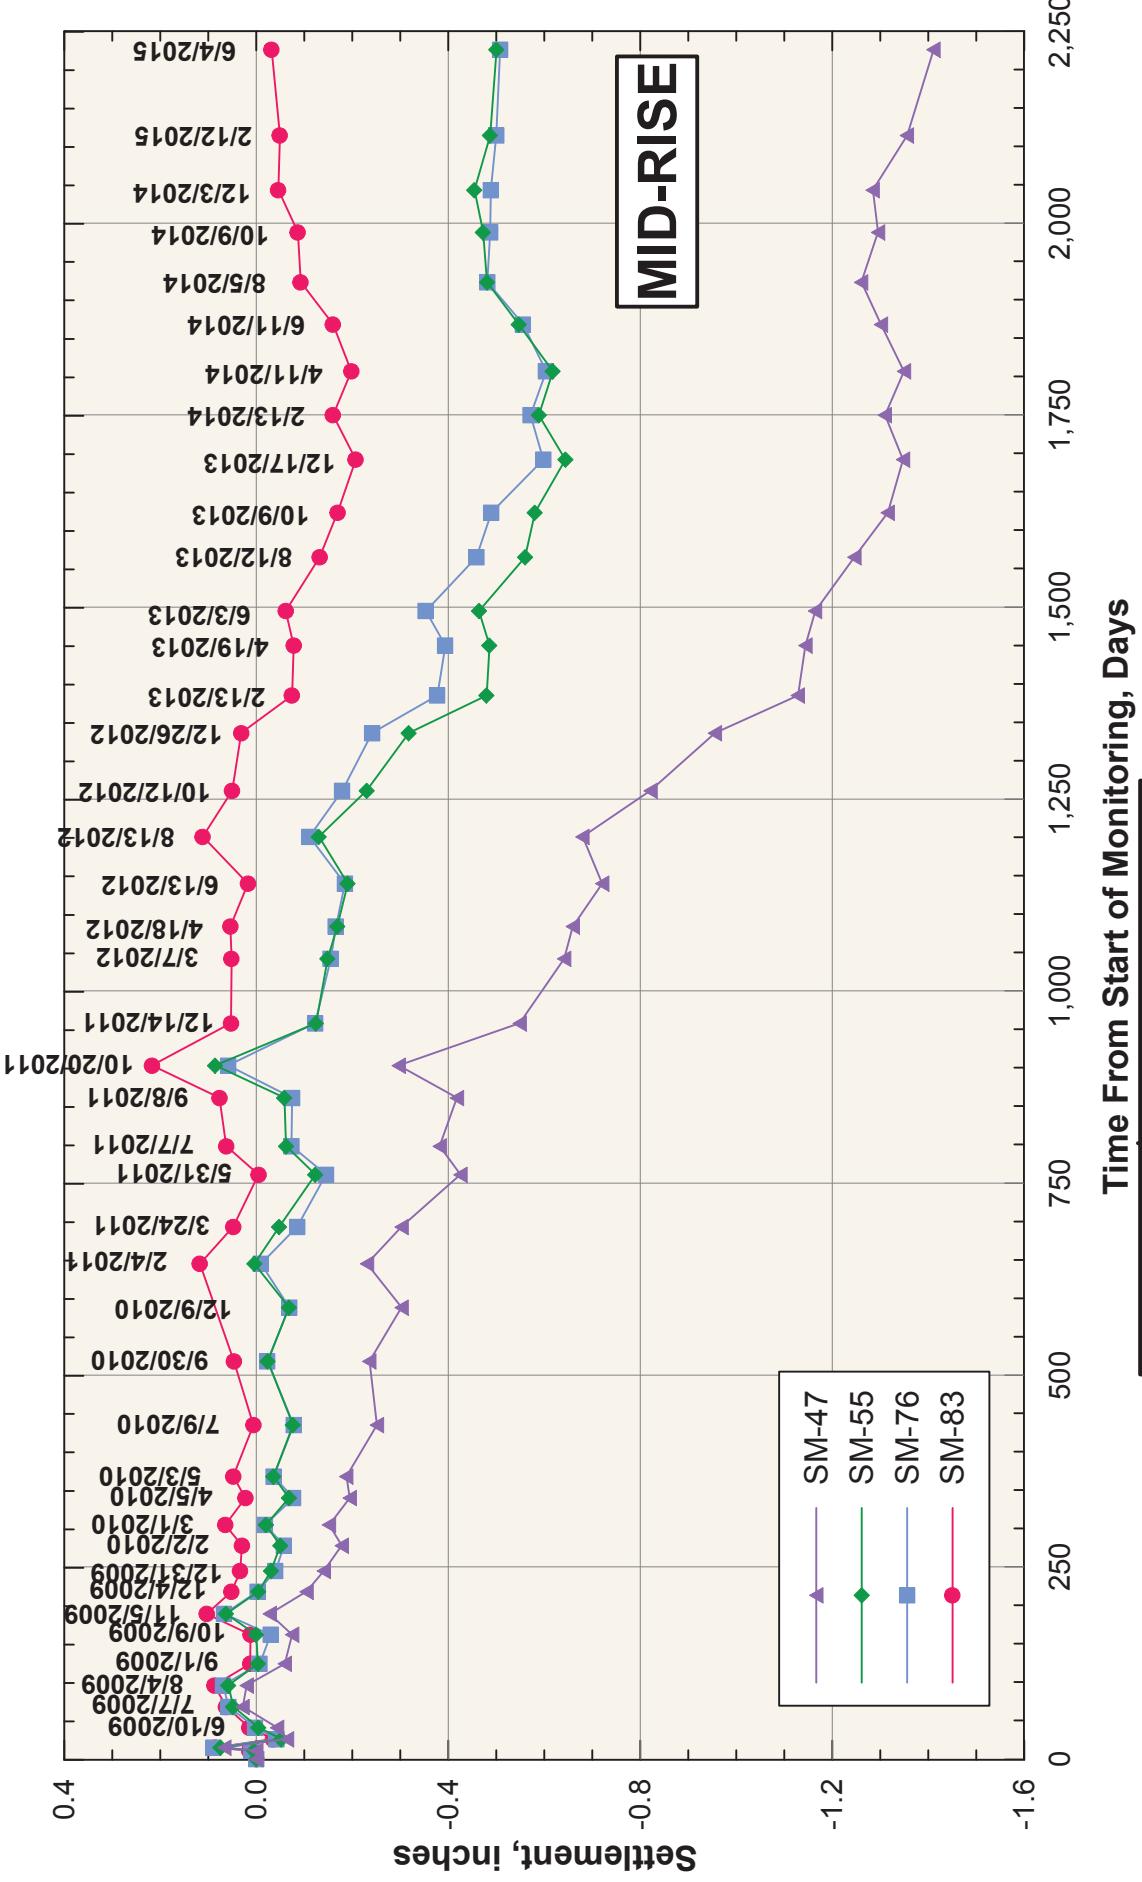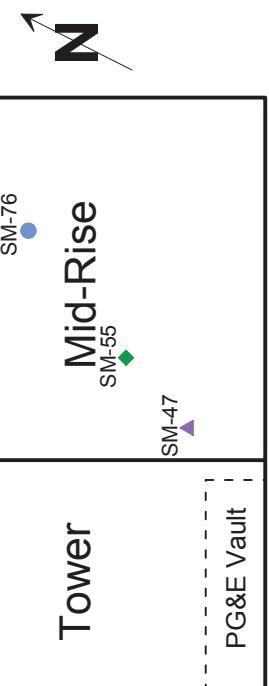


**SETTLEMENTS OF THE 301 MISSION TOWER
INCLUDING MONITORING DURING CONSTRUCTION**


Transbay Transit Center
301 Mission Monitoring
Transbay Joint Powers Authority
San Francisco, California


July 2015

Elapsed Time (log scale), years

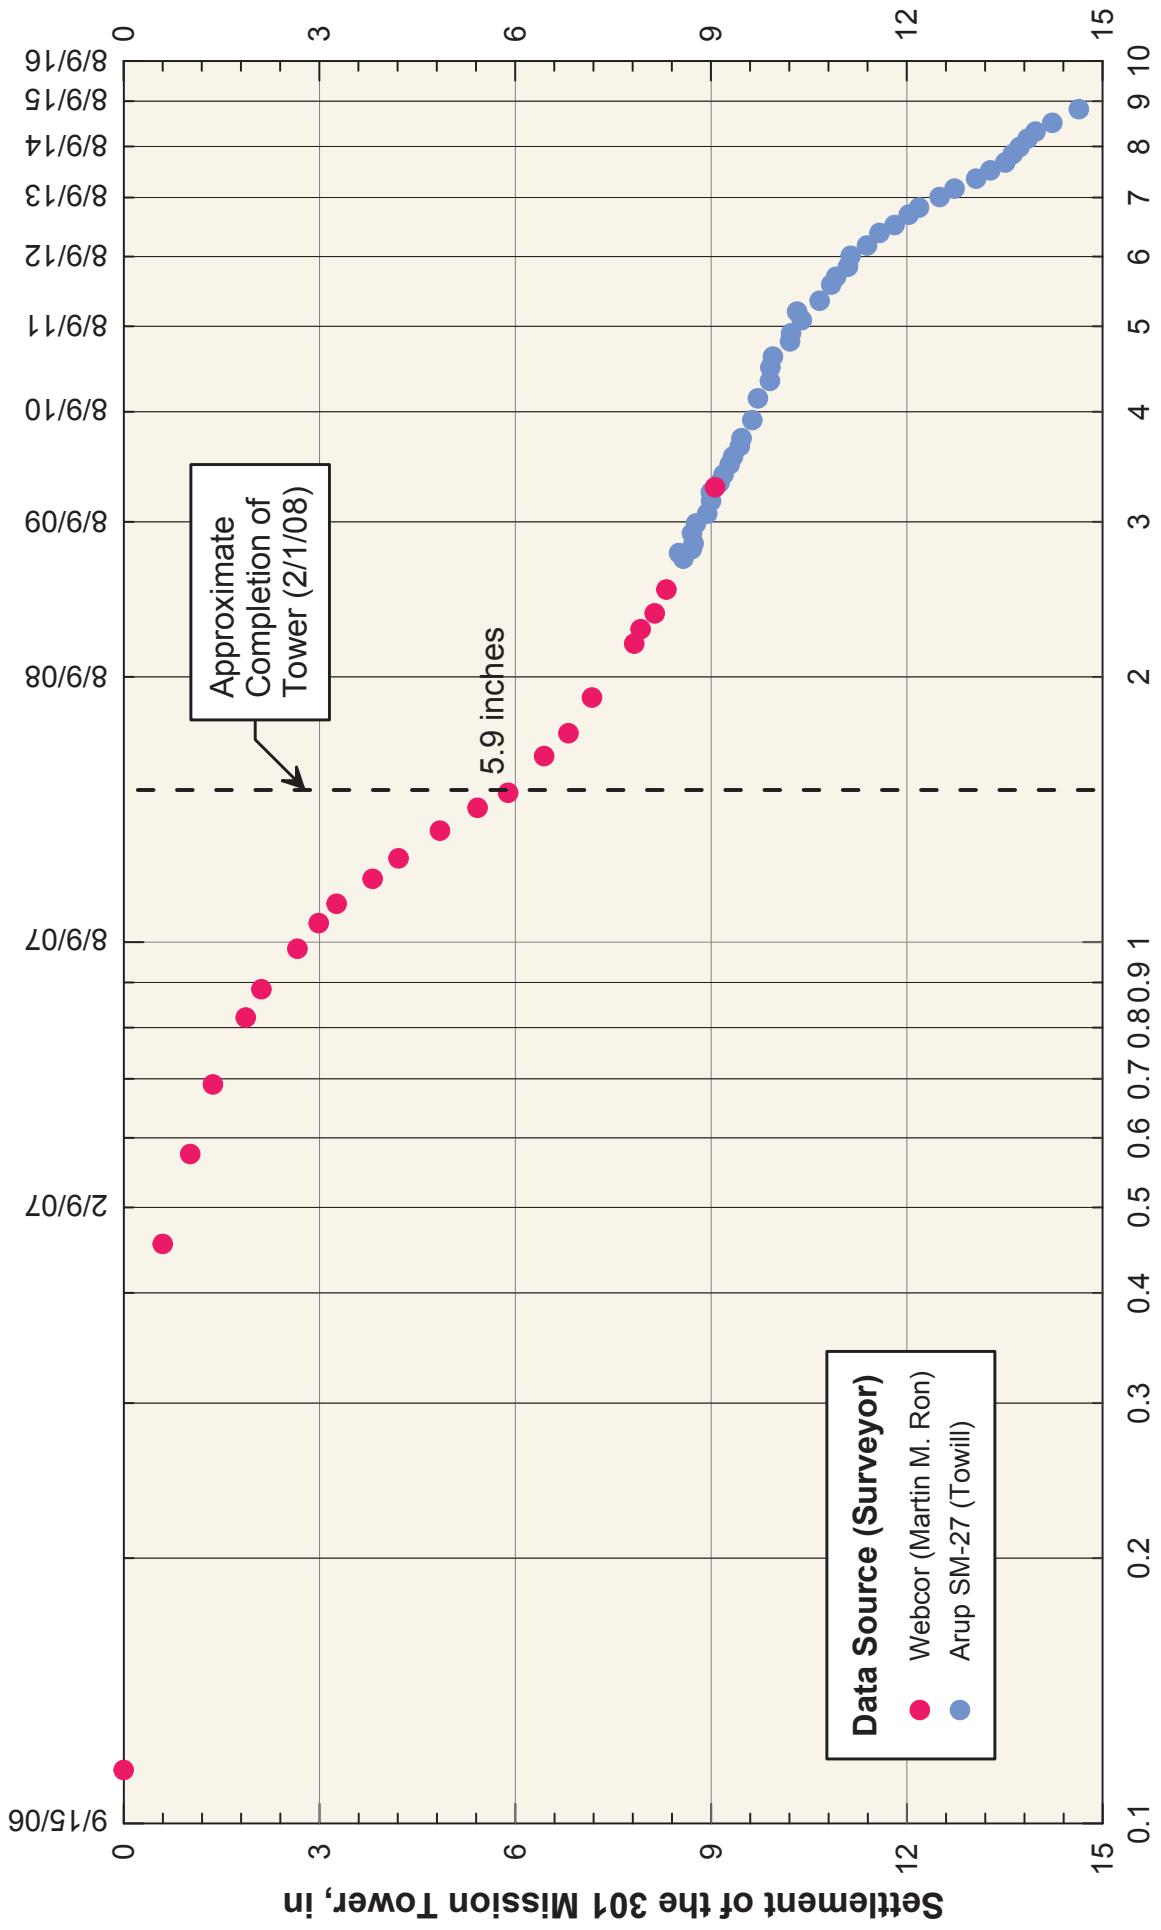

Beginning of Tower Construction: 8/9/06
End of Tower Construction: 2/1/08
Construction Duration: 542 days (1.5 years)

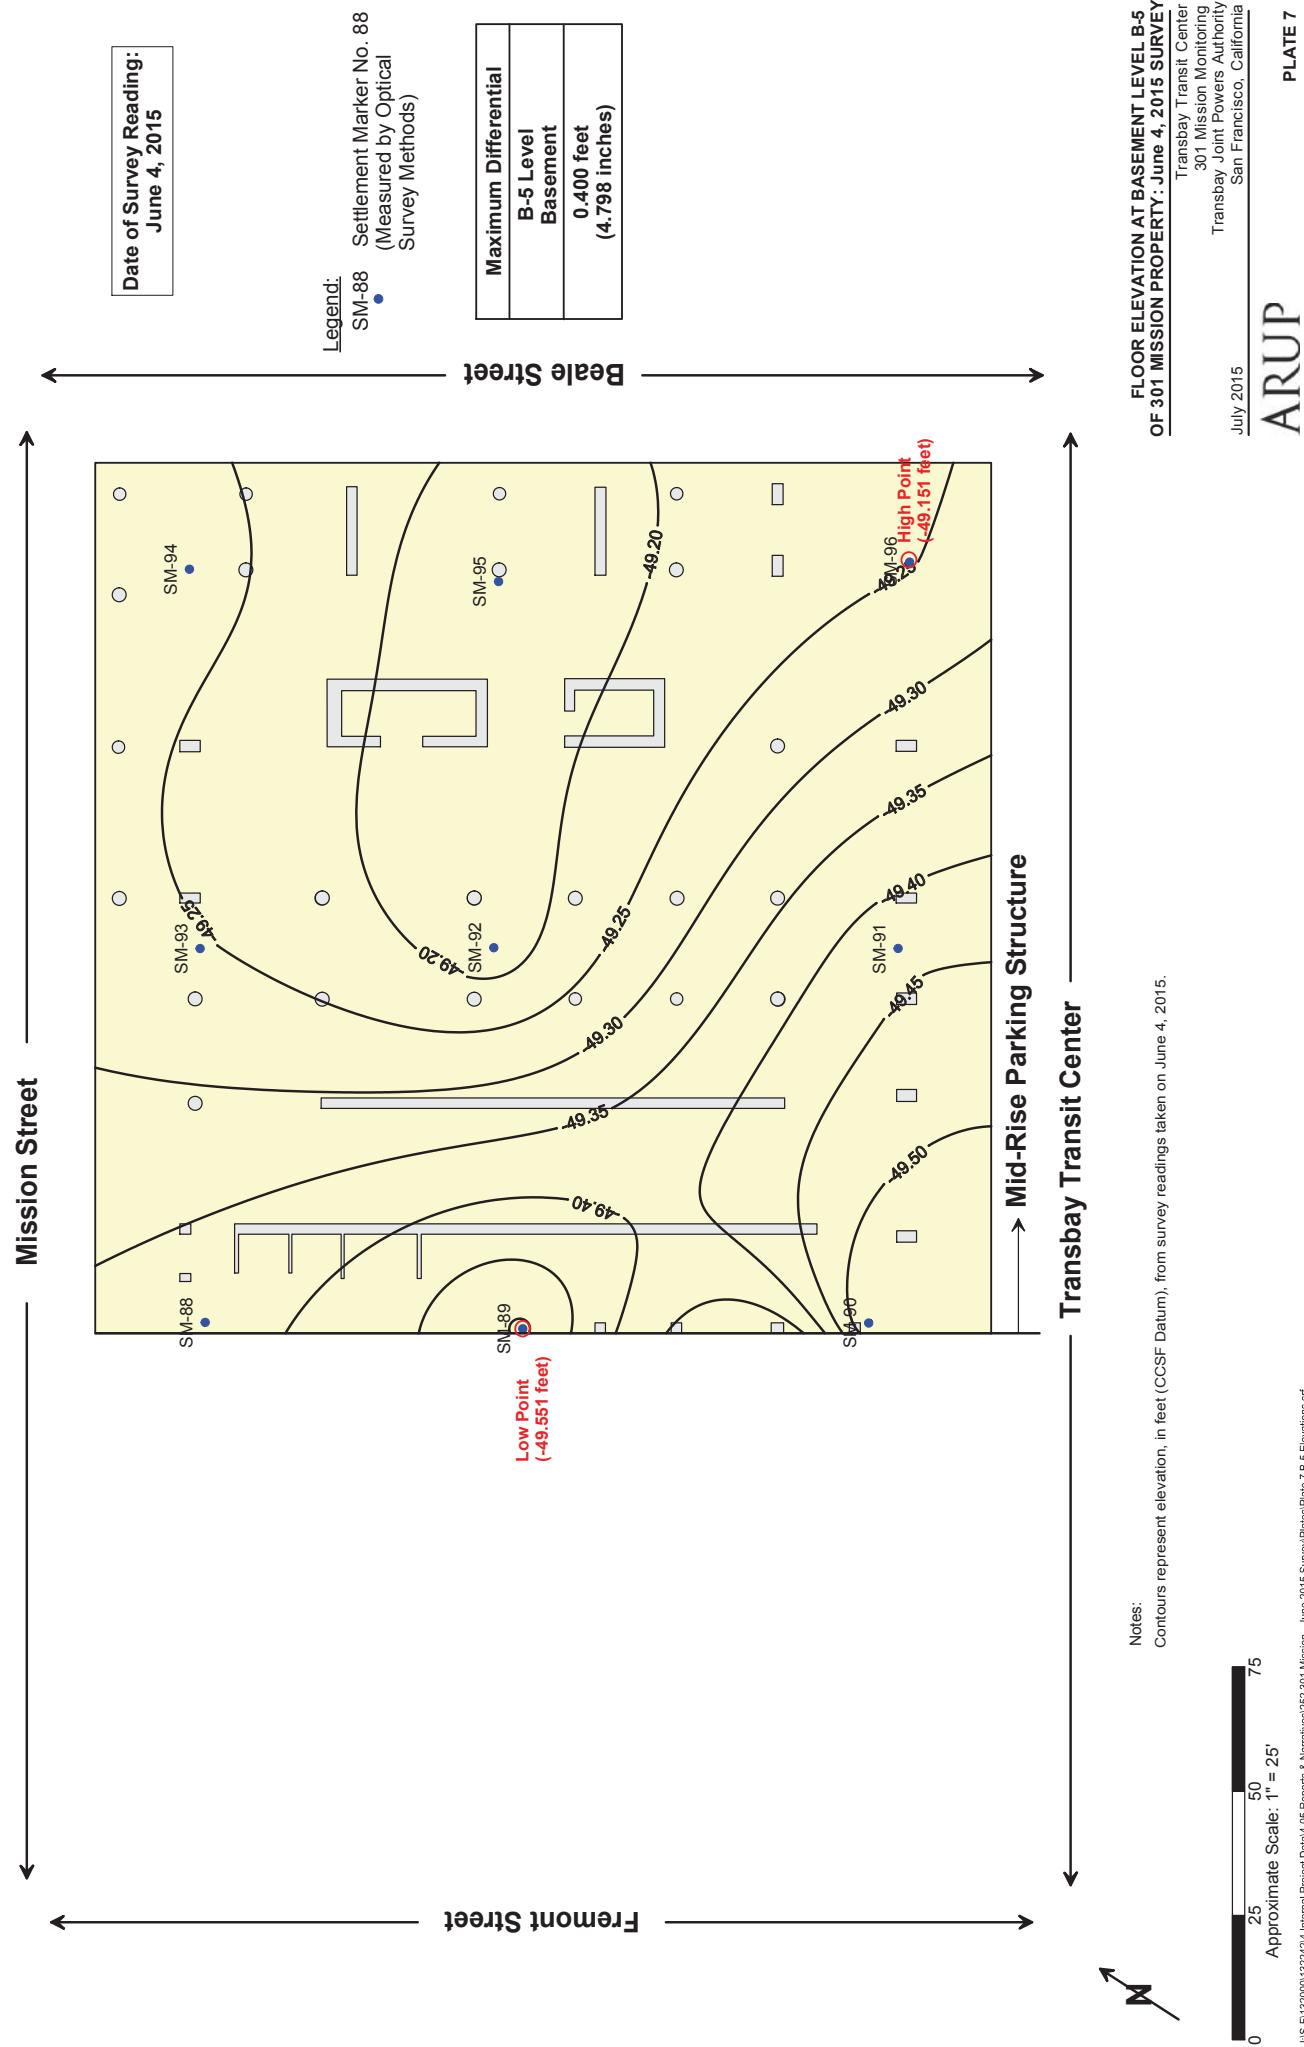

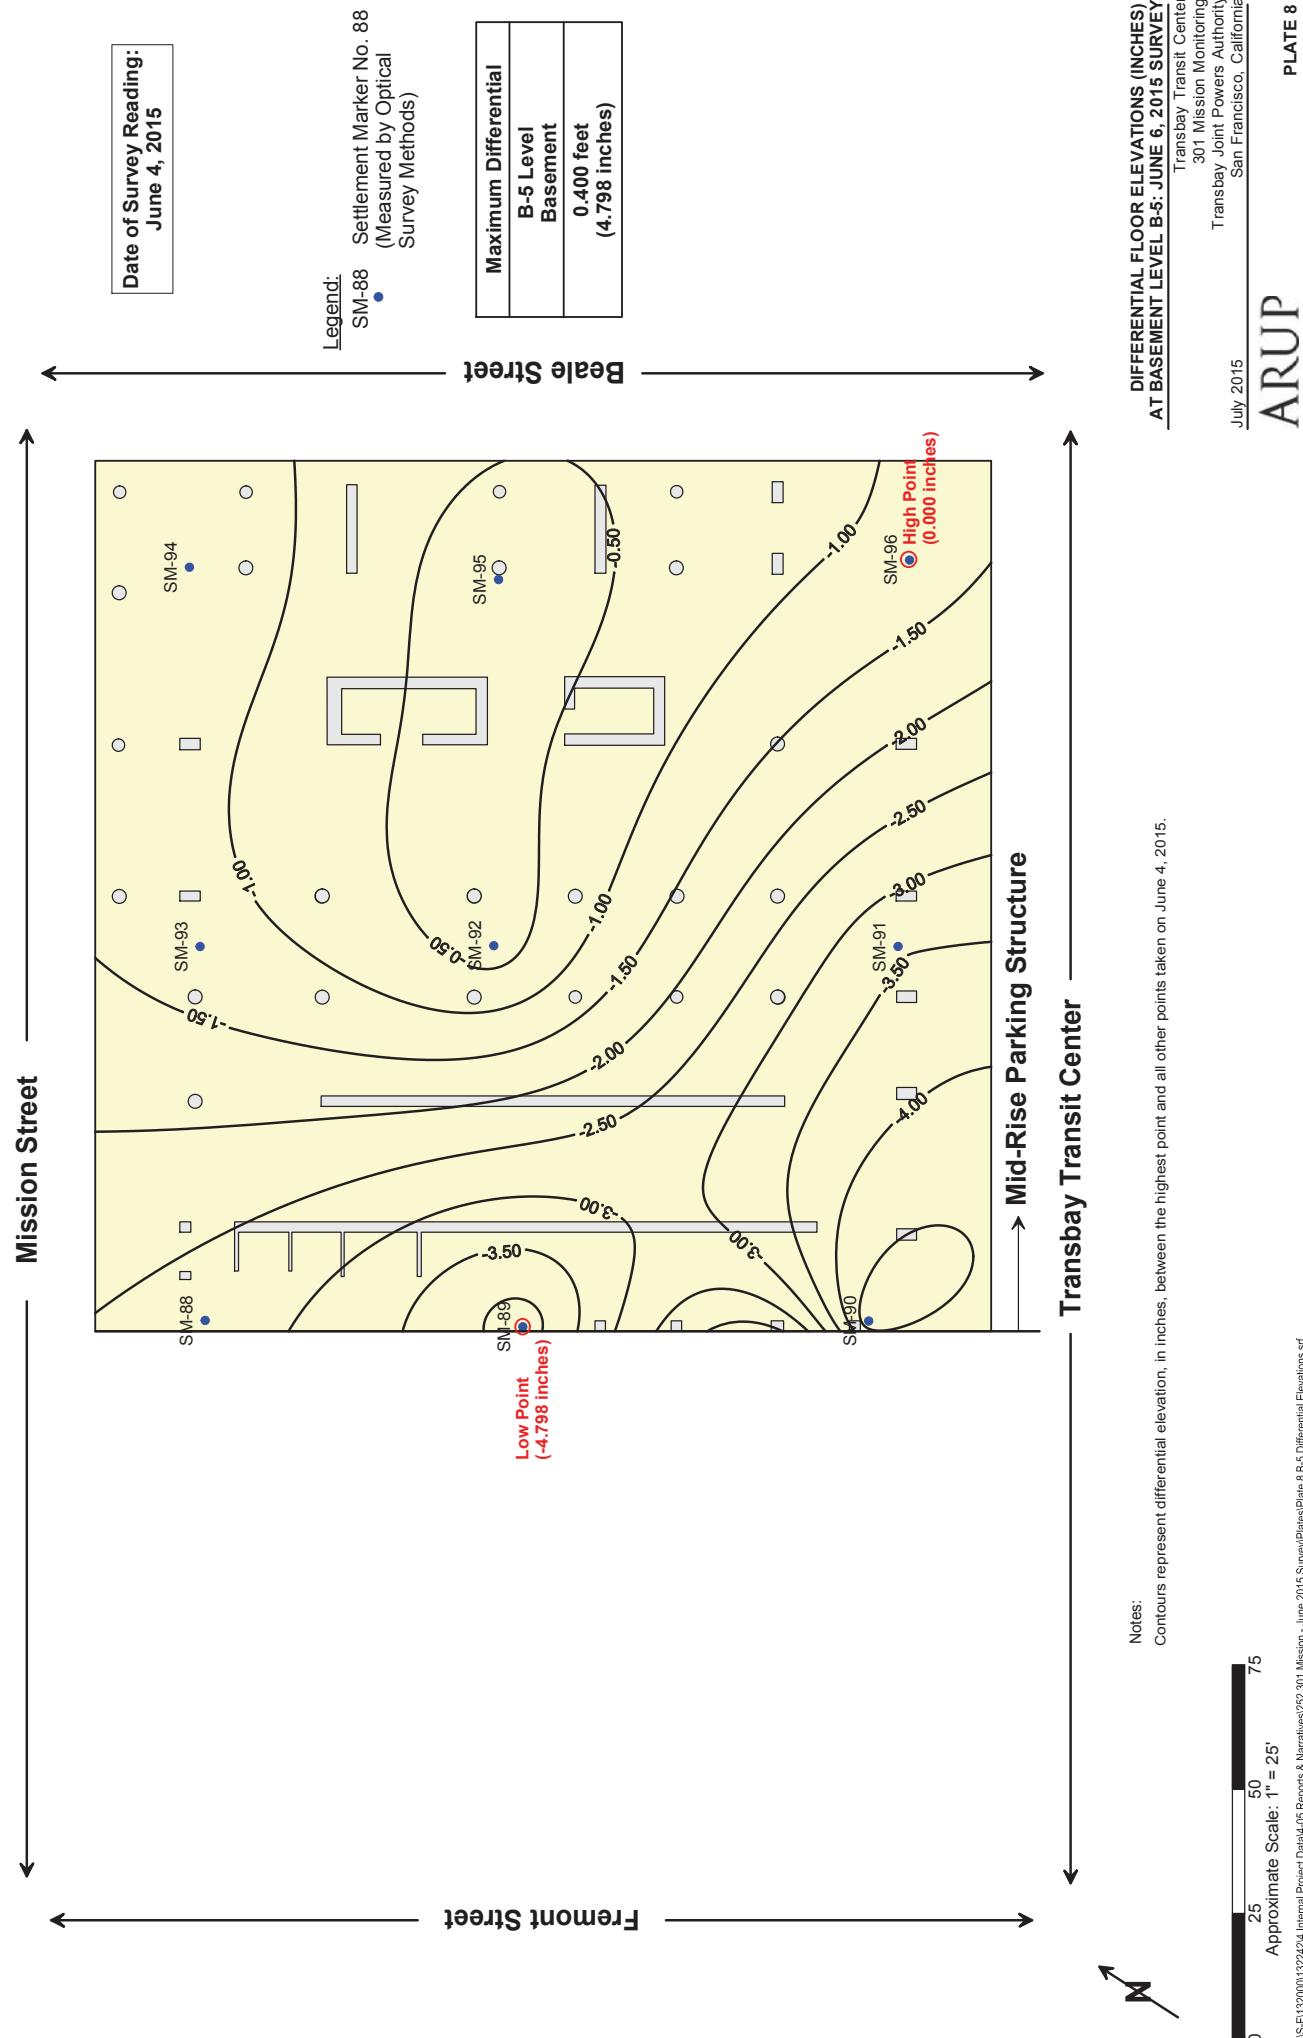

From: Brian Dykes
Sent: Wednesday, November 04, 2015 11:56 AM
To: 'shood@MillenniumPtrs.com'
Subject: FW: TTC - 301 Mission monitoring

Steven,
Here are the inclinometer and settlement survey readings taken in October.
I have requested the raw data for the settlement and will forward that to you shortly.
Brian.

From: Stephen McLandrich [<mailto:stephen.mclandrich@arup.com>]
Sent: Tuesday, November 03, 2015 5:23 PM
To: Brian Dykes
Cc: Jeff Dunn; Andrew Yeskoo
Subject: TTC - 301 Mission monitoring

Brian,

Please find the attached memoranda which present the October reads of the survey targets and the inclinometers around 301 Mission.

You will be receiving these memos from Andrew Yeskoo going forward. Our next read is planned for February 2016.

Regards,
Stephen

Stephen McLandrich PE GE
Senior Geotechnical Engineer

Arup
560 Mission Street Suite 700 San Francisco CA 94105 USA

t: +1 415 957 9445 d: +1 415 946 0245

m: +1 415 310 1095

www.arup.com

Explore innovation in the built environment on [*Doggerel*](#)

Check out our progress at <http://transbaycenter.org/construction-updates/construction-cameras>

NOTE: This e-mail communication and any attachments hereto are covered by the Electronic Communications Privacy Act, 18 U.S.C. Sections 2510-2521, and are legally privileged. The information contained herein is confidential, and is intended only for the use of the individual or entity to whom it is addressed. If you are not the intended recipient of this e-mail communication (or an employee or agent responsible for delivering this communication to its intended recipient(s)), you are hereby notified that any retention, copying or further distribution of this e-mail communication and any attachments is strictly prohibited. If you are not the intended recipient, please notify the sender by telephoning 415-597-4620, or by forwarding an e-mail reply message addressed to TransAdmin@TransbayCenter.org confirming that you have already destroyed (deleted) the original e-mail communication and any and all copies thereof. Thank you.

Memorandum

ARUP

To	Brian Dykes (TJPA)	Date
		October 30, 2015
Copies	Randy Volenec (PCPA) George Metzger (AAI)	Reference number 132242
From	Stephen McLandrich (Arup) Andrew Yeskoo (Arup)	File reference 4-05 255
Subject	Transbay Transit Center: Results of October 2015 Settlement Survey at 301 Mission Property	Page 1 of 1

Under Arup's Geotechnical Contract with the Transbay Joint Powers Authority through Pelli Clark Pelli Architects, Arup is required to monitor the settlements of the buildings adjacent to the Transbay Transit Center prior to and during construction. We began the monitoring program for the 301 Mission property in April of 2009. This memorandum and the attached plates present an update to our memorandum dated July 15, 2015 with measurements made through October 2015.


List of Plates


- Plate 1 Floor Elevations at Level B-1 of 301 Mission Property: Periodic Survey – October 5, 2015
- Plate 2 Differential Floor Elevation (Inches) October 5, 2015 Survey
- Plate 3 Contours of Settlements Measured at the 1st Level Basement of the 301 Mission St. Structure Between 04/30/2009 & 10/5/2014
- Plate 4 Settlement Over Time Floor Elevations at Level B-1 of 301 Mission Property – Tower: April 30, 2009 through October 5, 2015
- Plate 5 Settlement Over Time Floor Elevations at Level B-1 of 301 Mission Property – Mid-Rise: April 30, 2009 through October 5, 2015
- Plate 6 Settlements of the 301 Mission Tower Including Monitoring During Construction
- Plate 7 Floor Elevation at Basement Level B-5 of 301 Mission Property: October 5, 2015 Survey
- Plate 8 Differential Floor Elevations (Inches) at Basement Level B-5: October 5, 2015 Survey

FLOOR ELEVATIONS AT LEVEL B-1
OF 301 MISSION PROPERTY:
PERIODIC SURVEY - OCTOBER 5, 2015


Transbay Transit Center
301 Mission Monitoring
Transbay Joint Powers Authority
San Francisco, California

October 2015

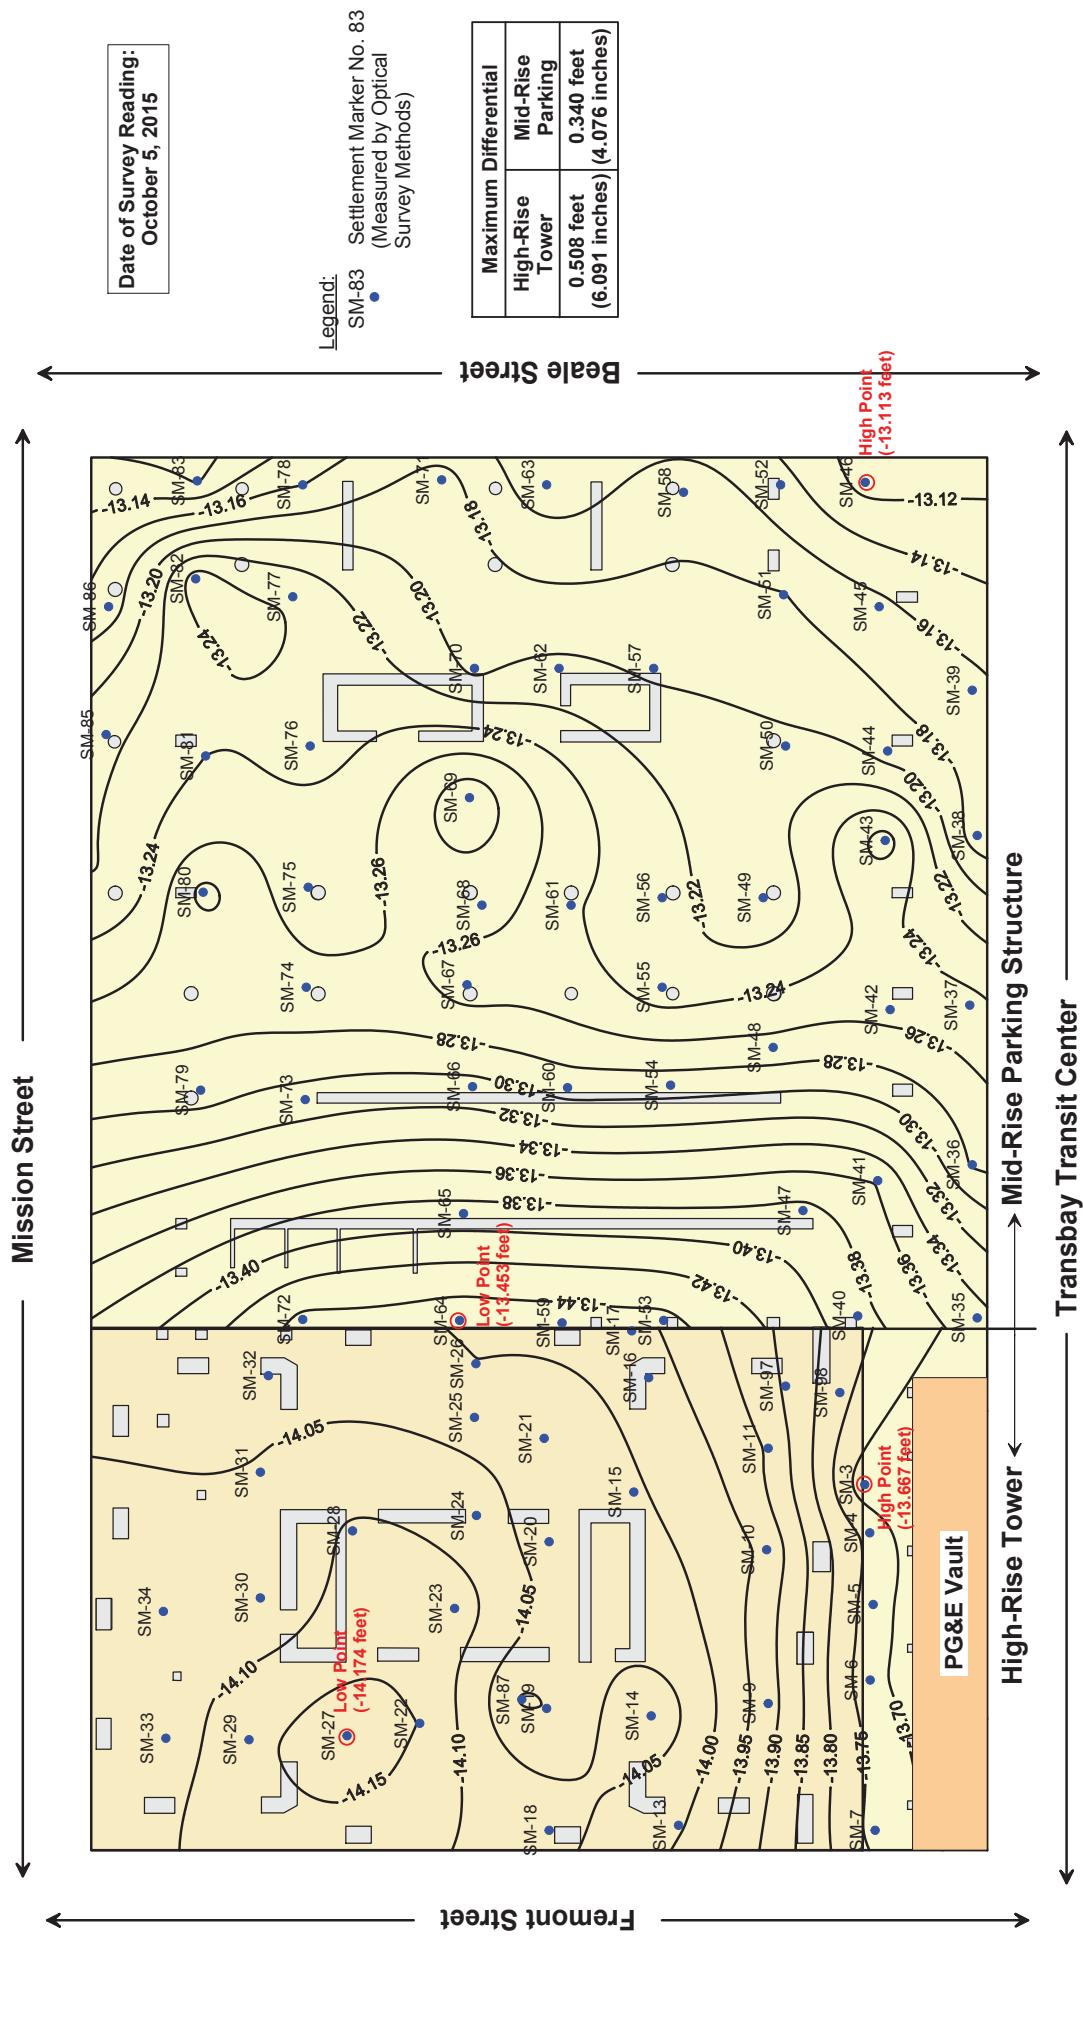

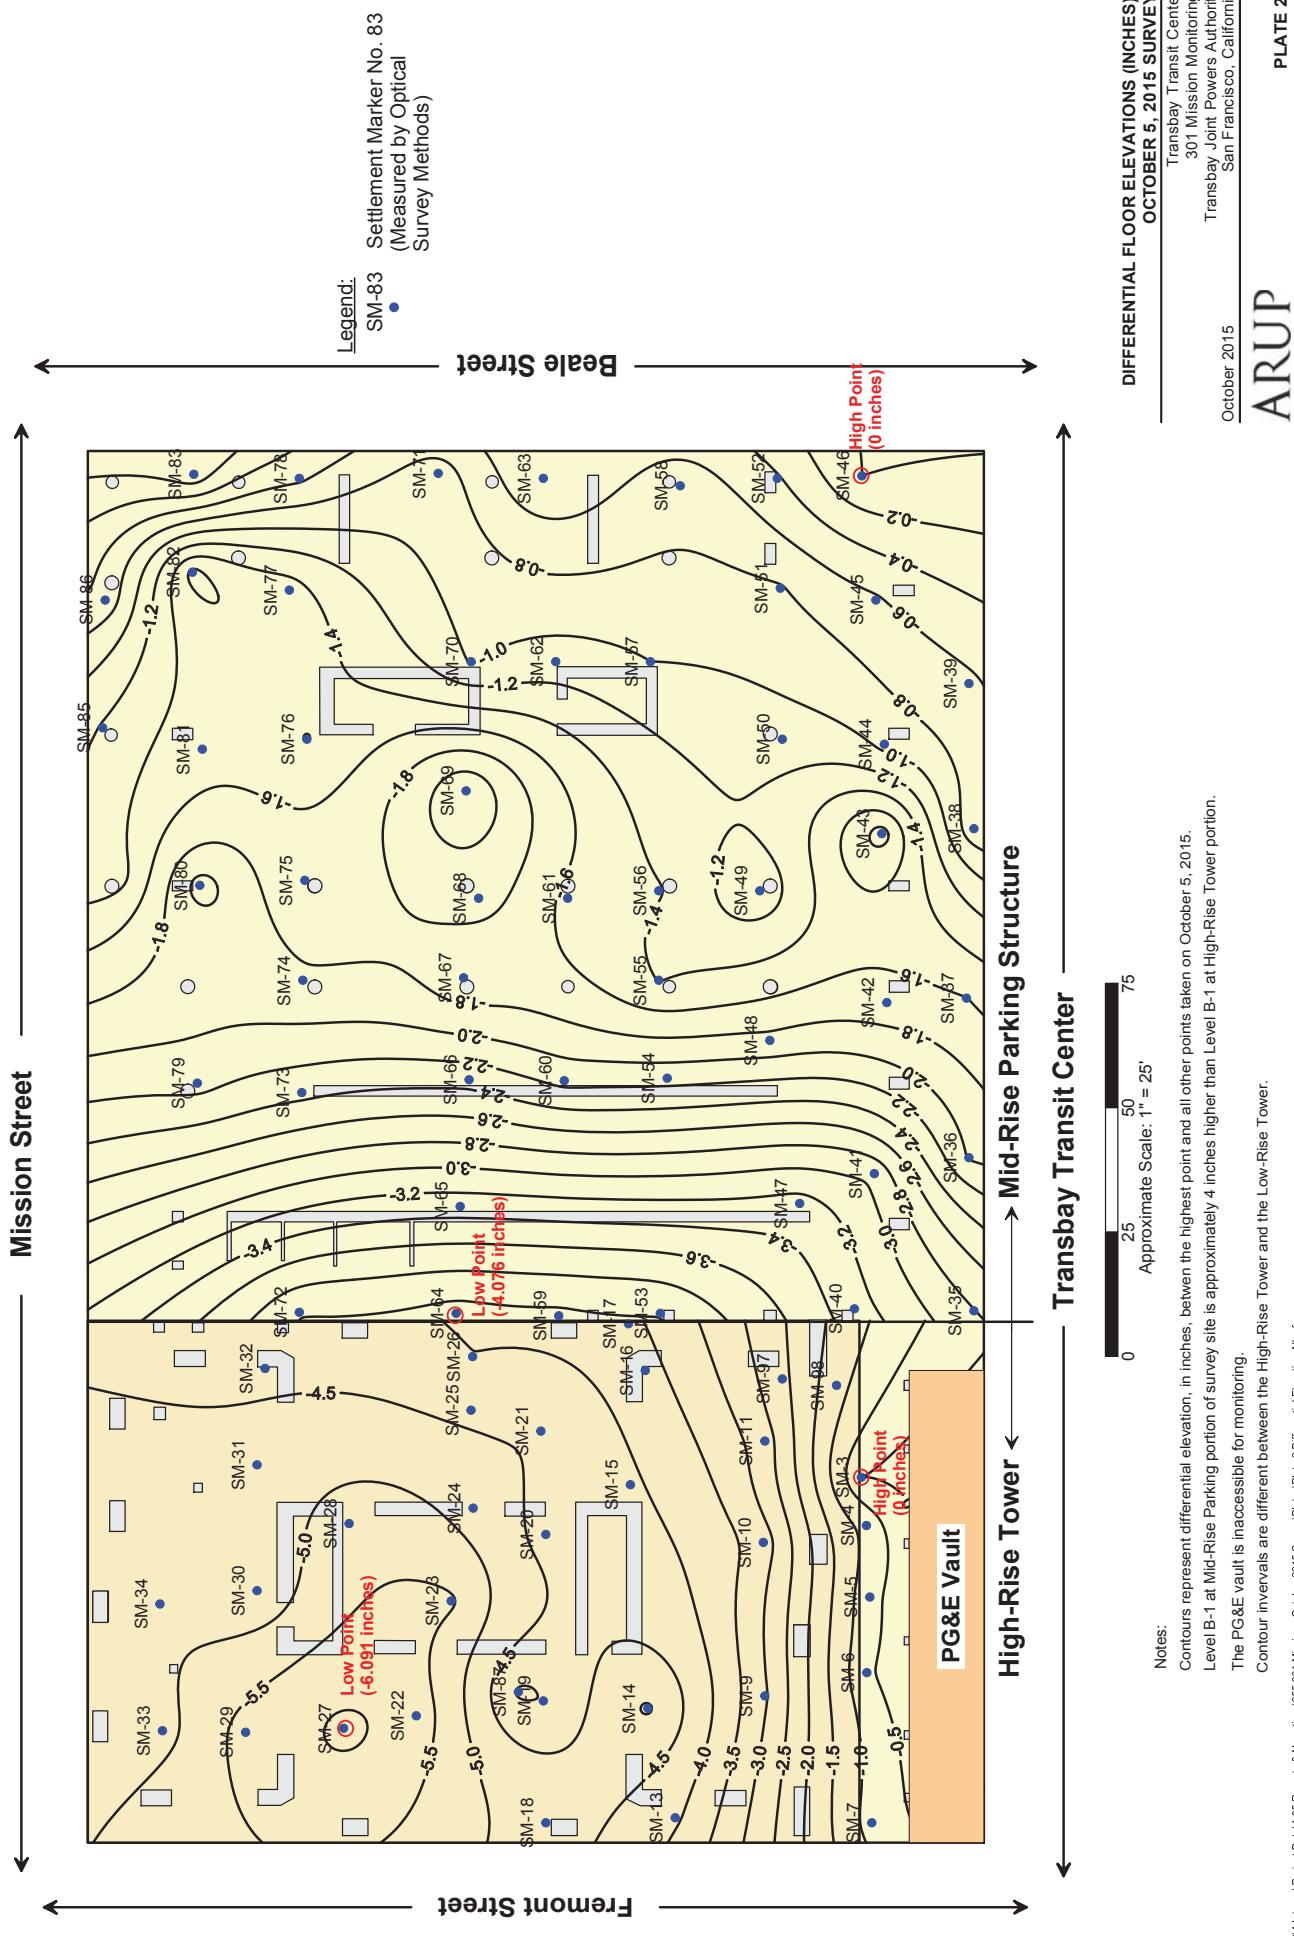

ARUP

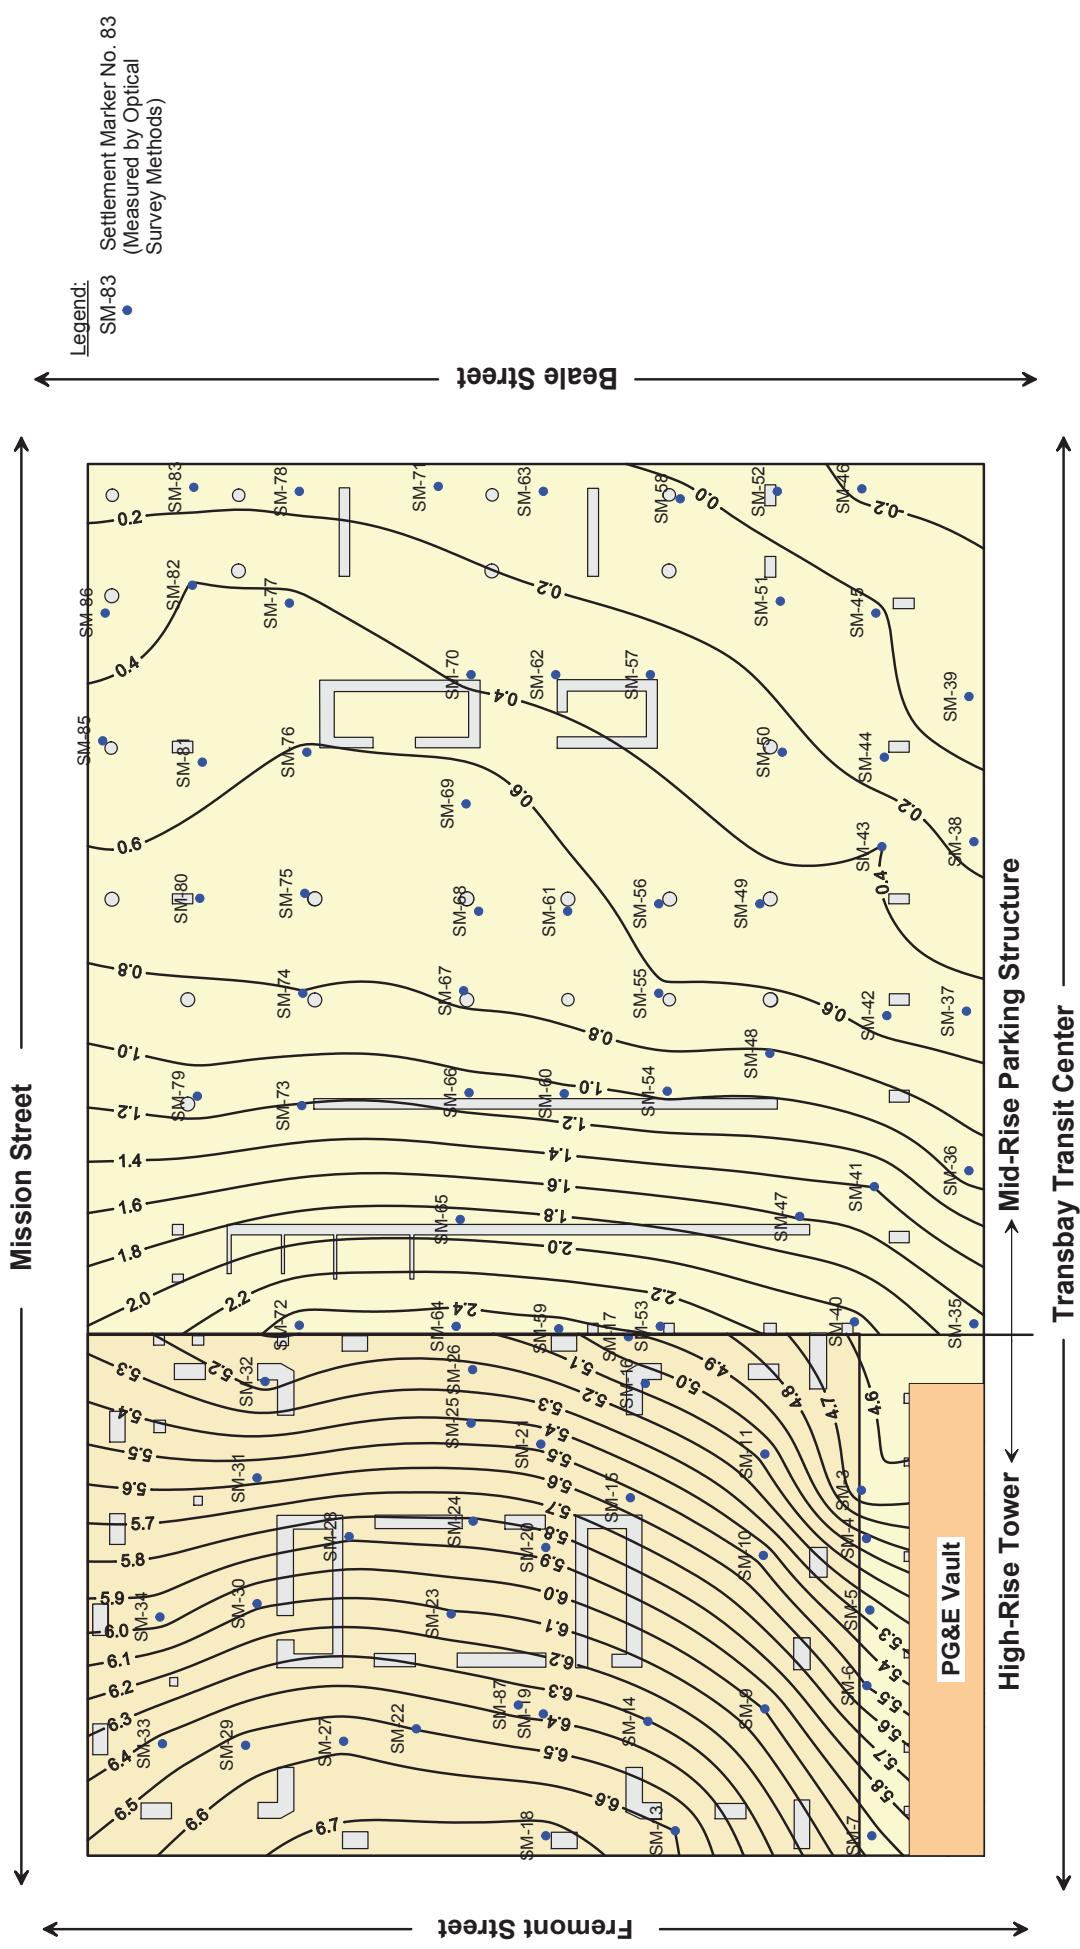

CONTOURS OF SETTLEMENTS MEASURED AT THE 1ST LEVEL BASEMENT OF THE 301 MISSION ST STRUCTURE BETWEEN 04/30/2009 & 10/5/2015

Transbay Transit Center
301 Mission Monitoring
Transbay Joint Powers Authority
San Francisco, California



October 2015

ARUP

Note:
Initial (Baseline) reading
taken on 04/30/09

SETTLEMENT OVER TIME
FLOOR ELEVATIONS AT LEVEL B-1
OF 301 MISSION PROPERTY - TOWER:
APRIL 30, 2009 THROUGH OCTOBER 5, 2015

Transbay Transit Center
301 Mission Monitoring
Transbay Joint Powers Authority
San Francisco, California

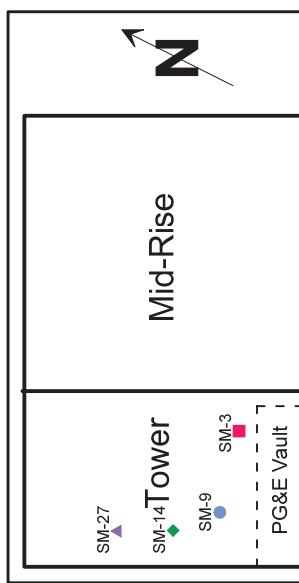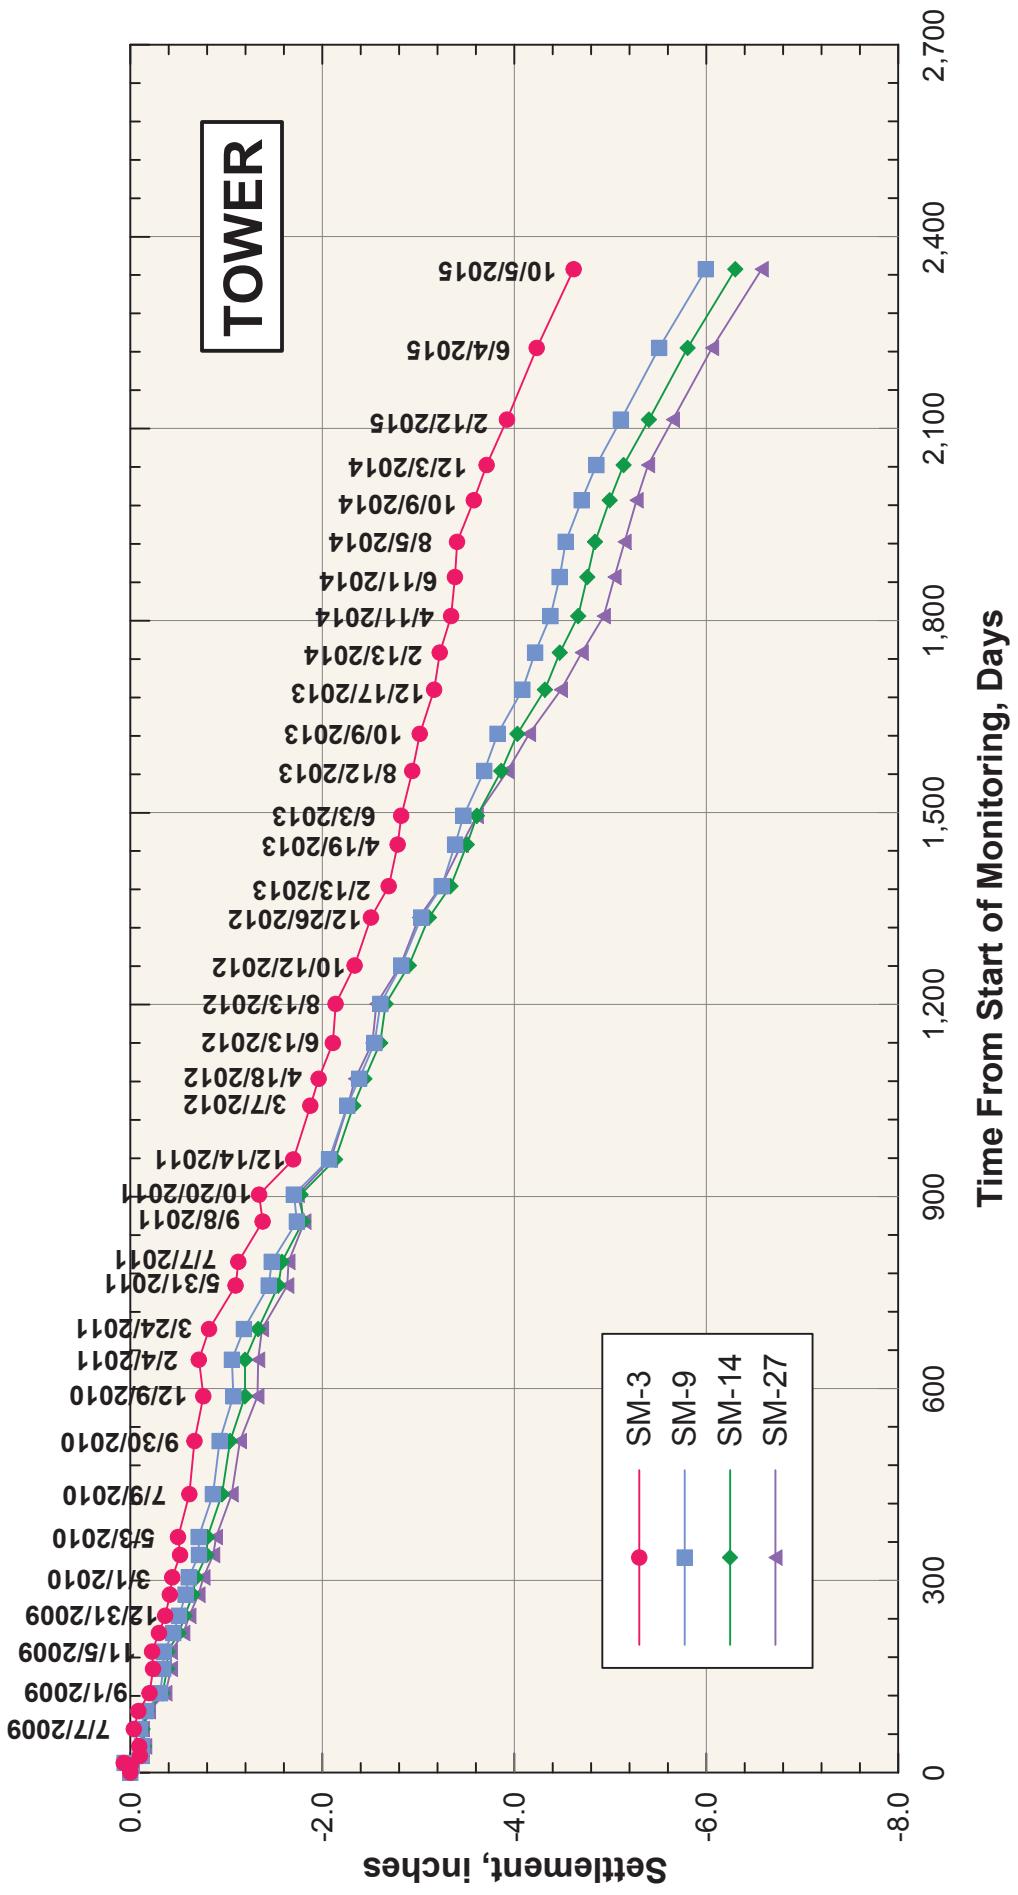



ARUP


Note:
Initial (Baseline) reading
taken on 04/30/09

J.S.F.132000.01322424 Internal Project Data\4.05 Reports & Narratives\255 301 Mission - October 2015 Survey\Plate 5 Settlement Over Time - Midrise.grf

**SETTLEMENT OVER TIME
FLOOR ELEVATIONS AT LEVEL B-1
OF 301 MISSION PROPERTY - MID-RISE:
APRIL 30, 2009 THROUGH OCTOBER 5, 2015**

Transbay Transit Center
301 Mission Monitoring
Transbay Joint Powers Authority
San Francisco, California

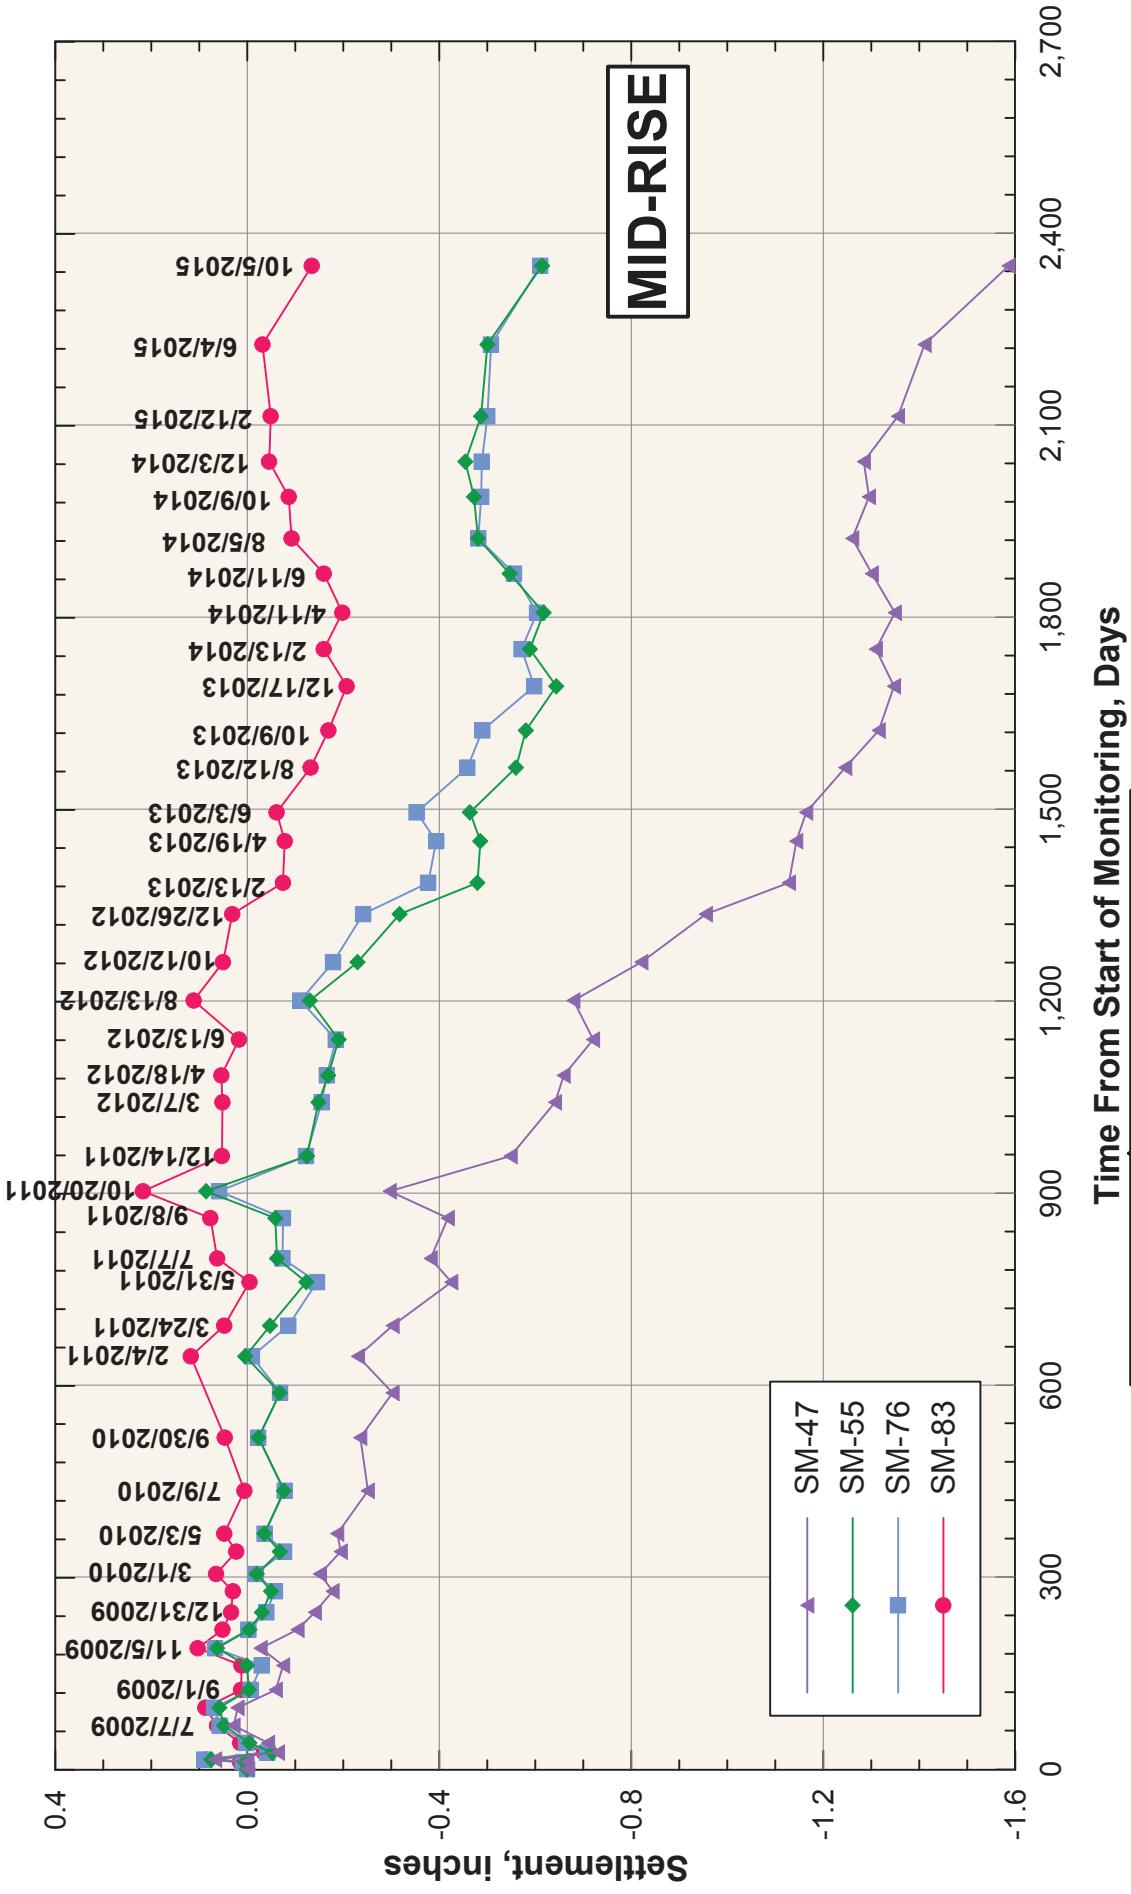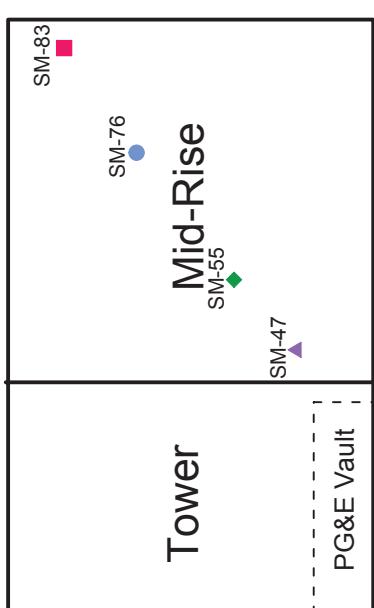

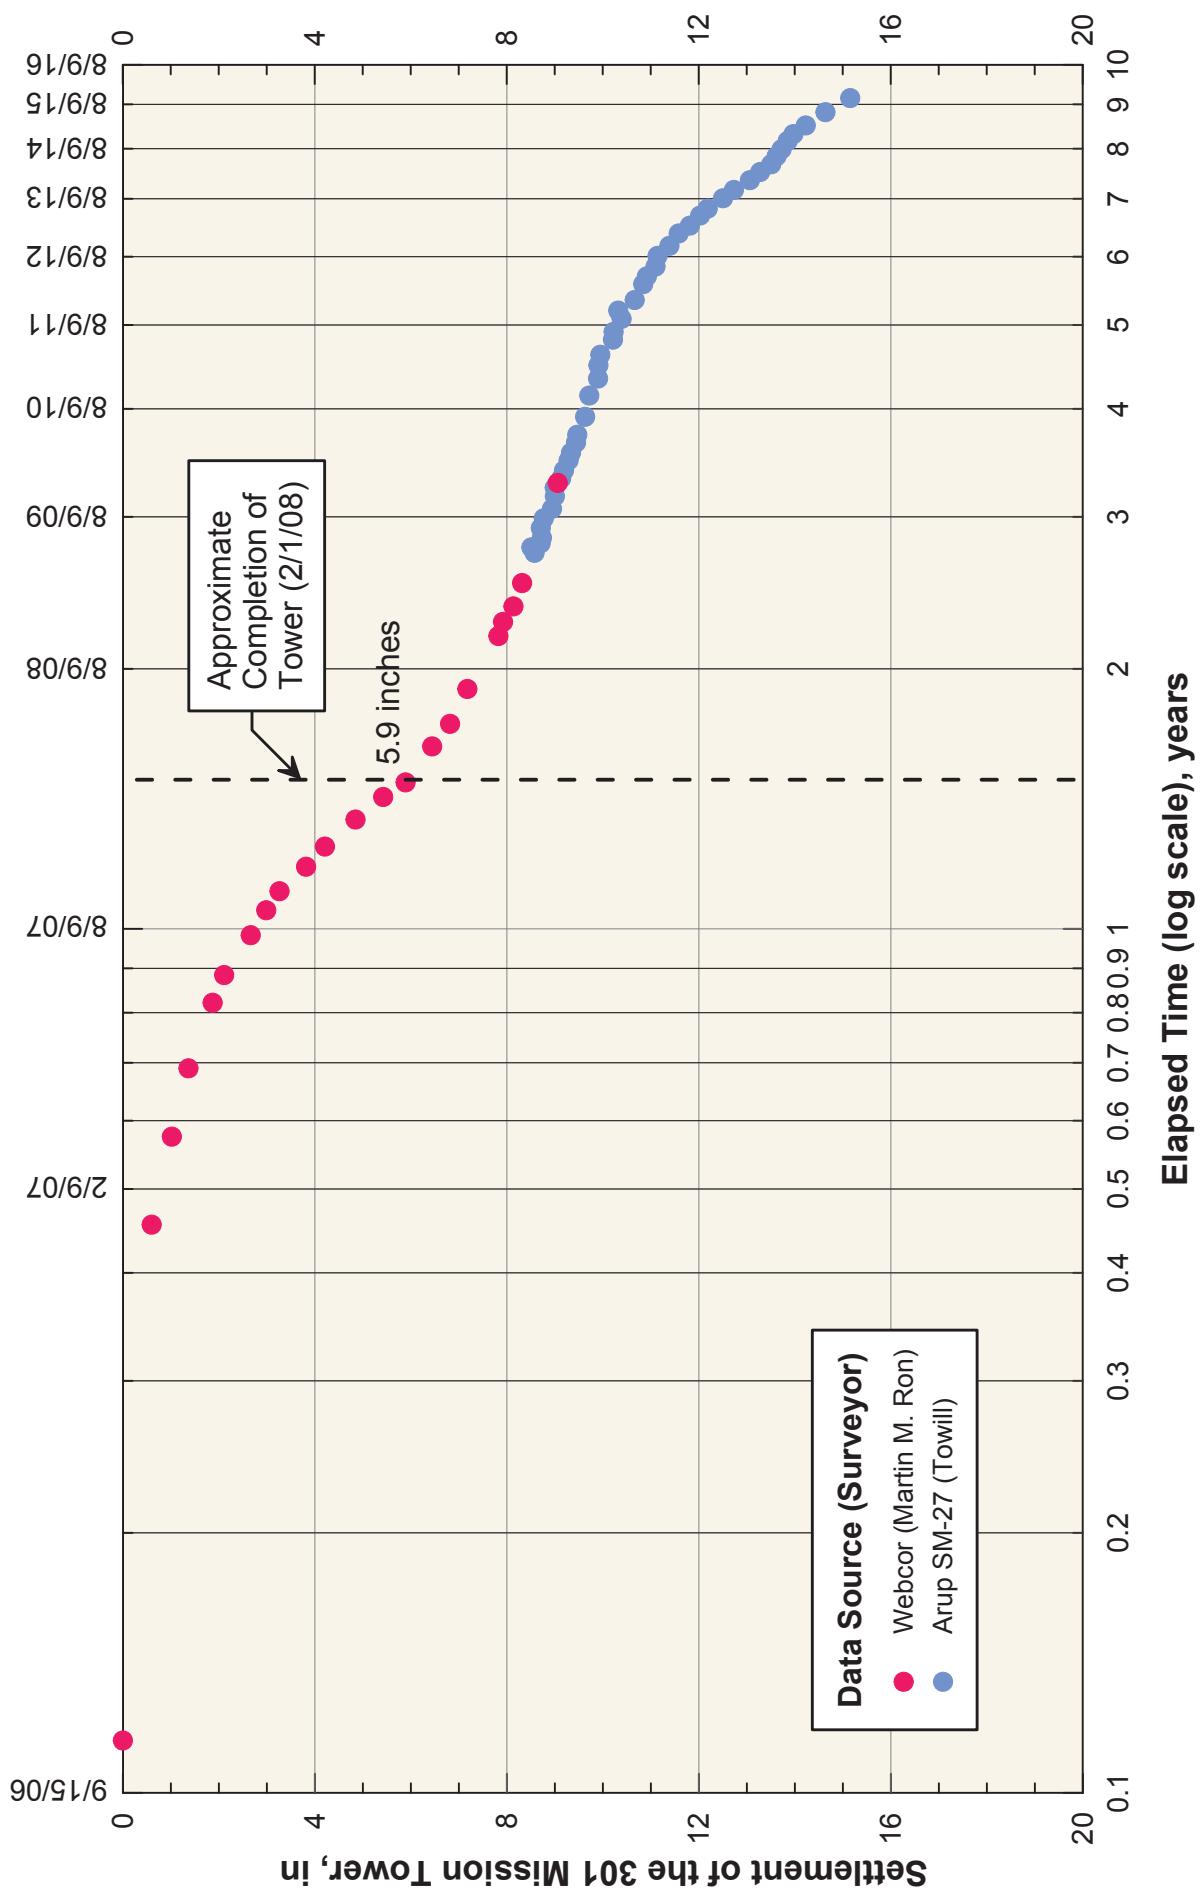


**SETTLEMENTS OF THE 301 MISSION TOWER
INCLUDING MONITORING DURING CONSTRUCTION**


Transbay Transit Center
301 Mission Monitoring
Transbay Joint Powers Authority
San Francisco, California

October 2015

Beginning of Tower Construction: 8/9/06
End of Tower Construction: 2/1/08
Construction Duration: 542 days (1.5 years)

ARUP

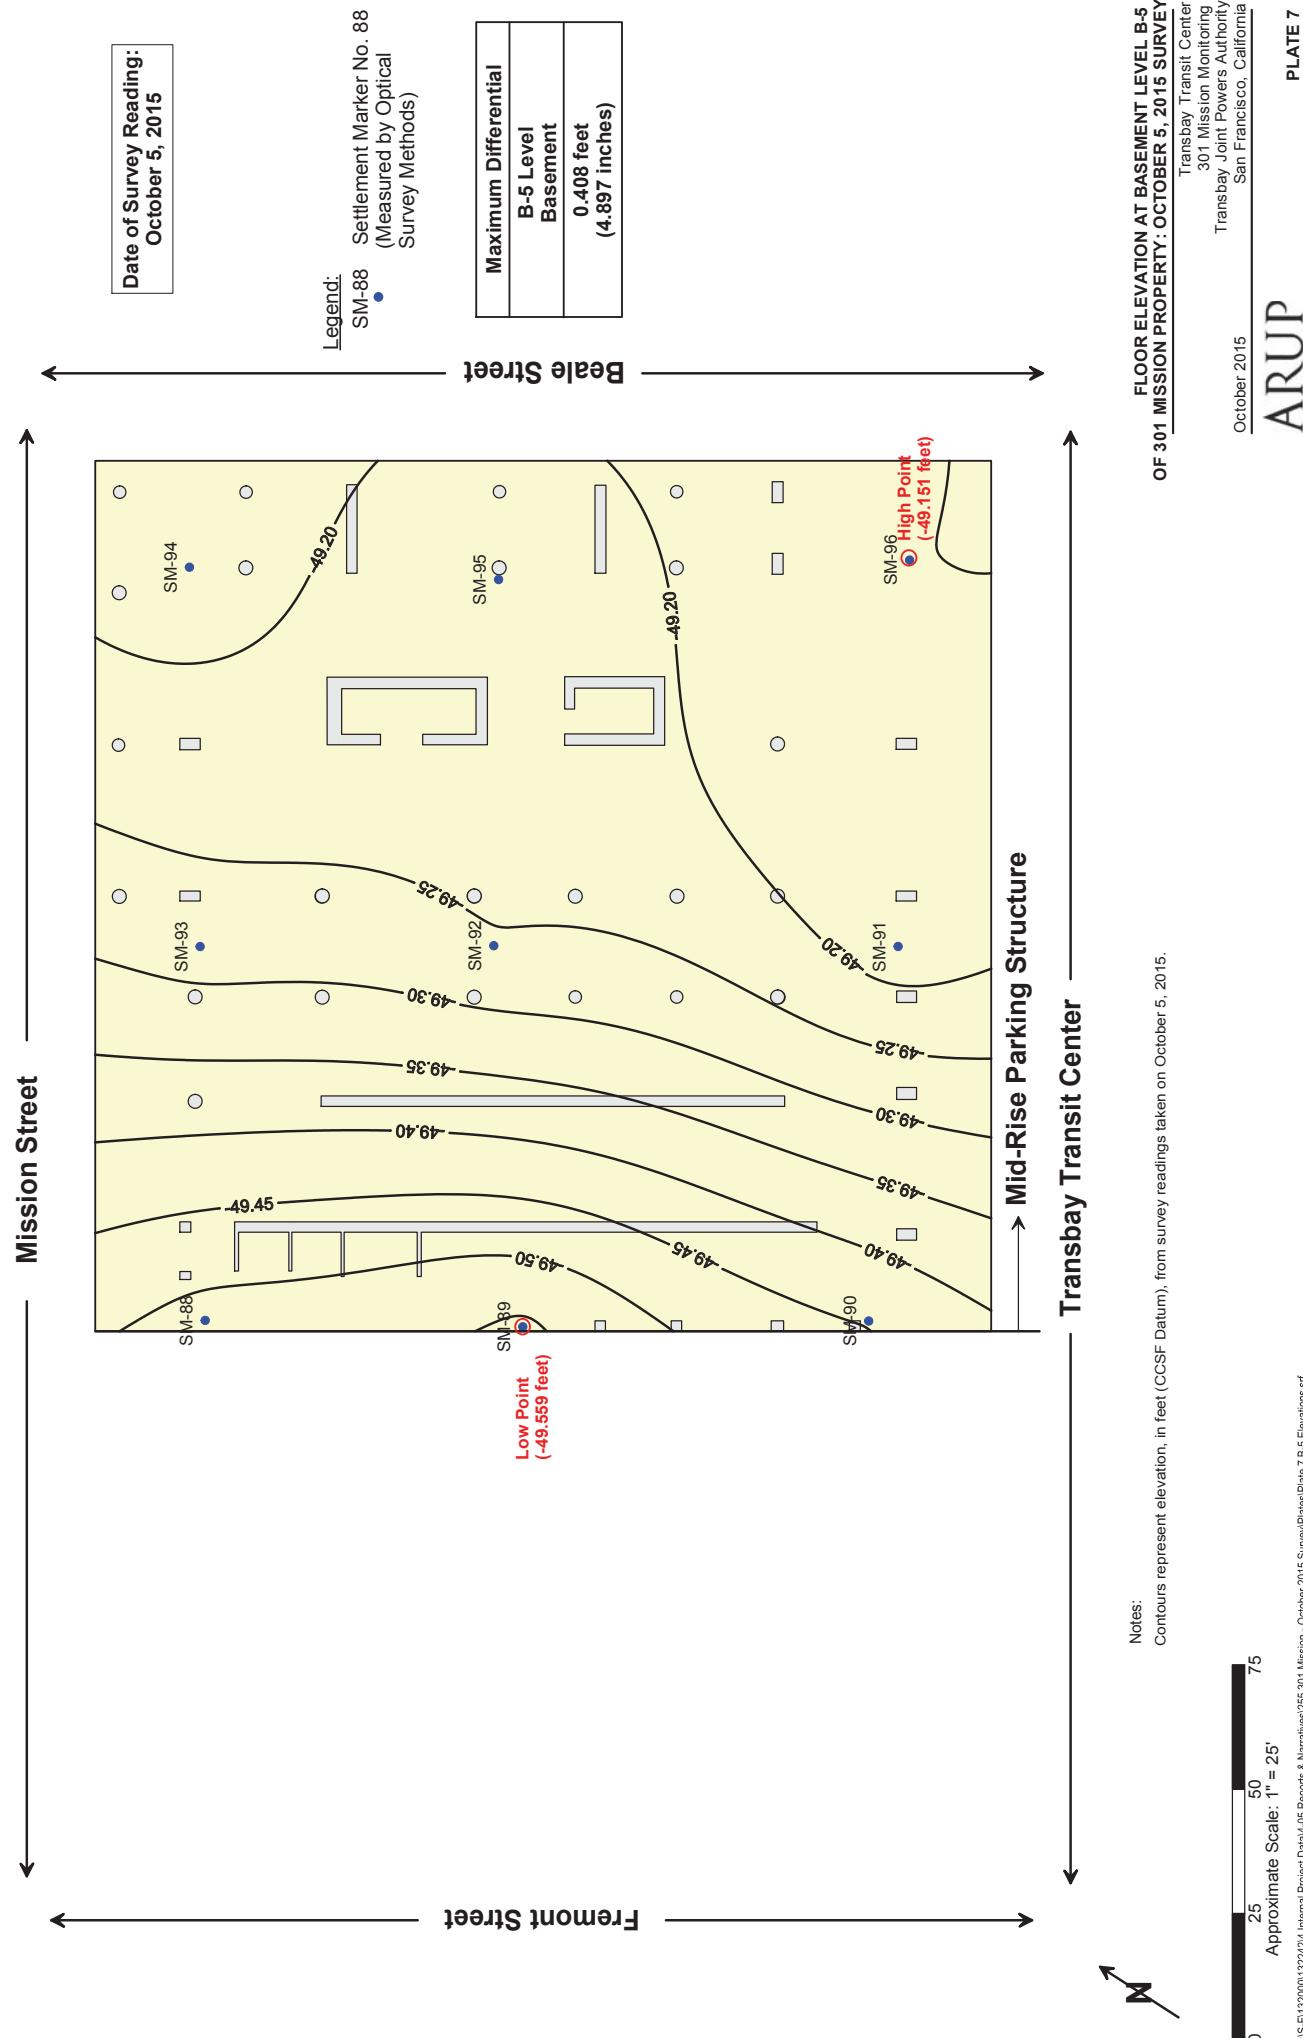

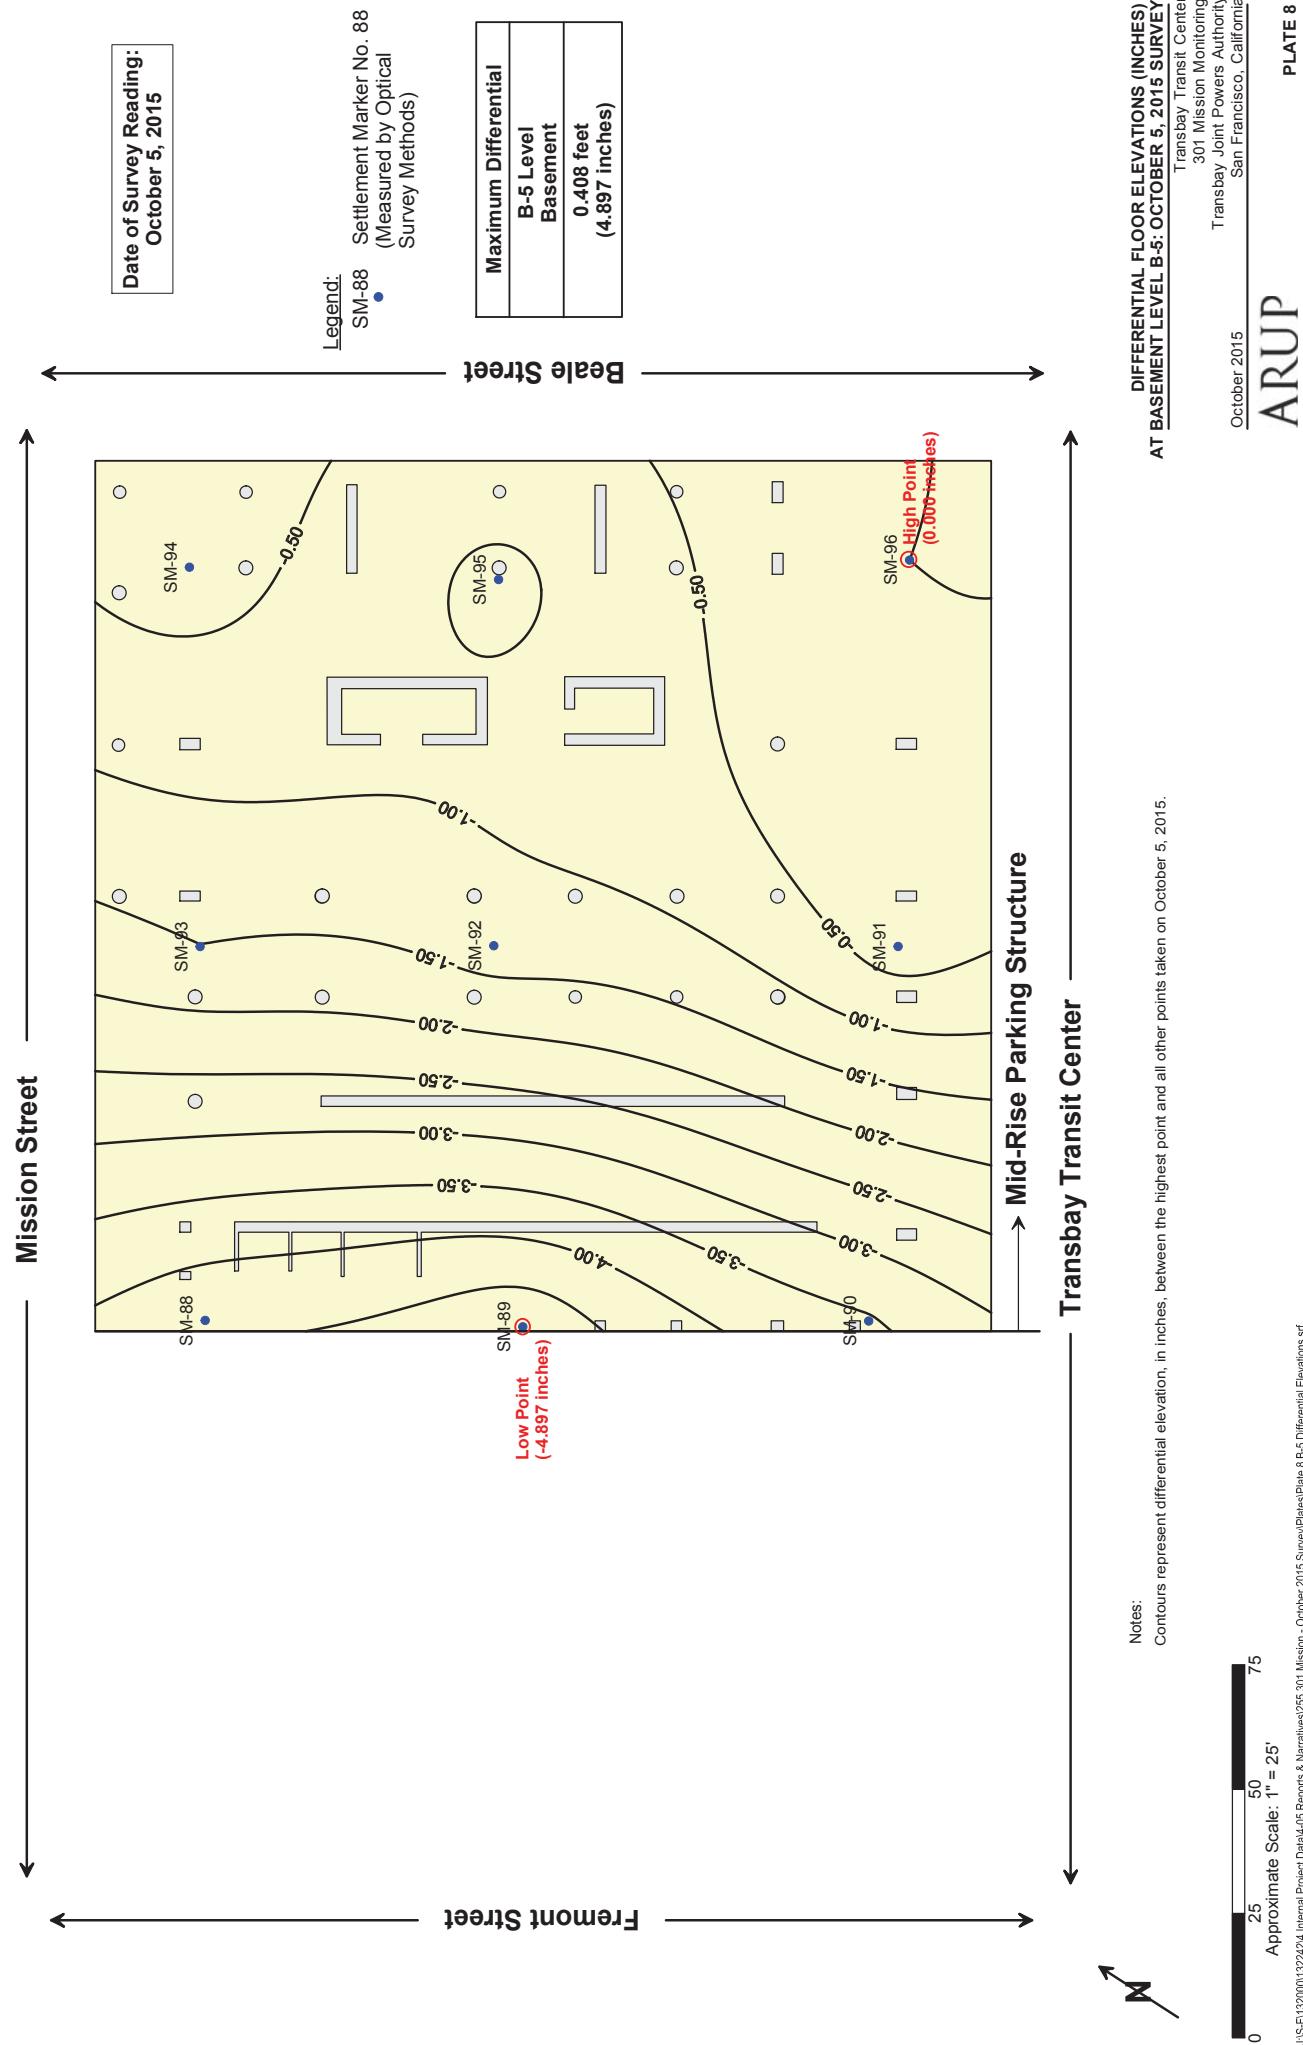

From: Brian Dykes
Sent: Tuesday, February 23, 2016 10:44 AM
To: 'Steven Hood'
Cc: 'Andrew Yeskoo'; Dennis Turchon; 'Edward T. Schexnayder'; Barbara Pemberton
Subject:

Steven,

Here is the Arup Memorandum for the February 2016 settlement monitoring inside the 301 Mission Street property. Also included is the raw data provided by Towill Company, their surveyor.

This week Arup is taking manual readings of the inclinometers and piezometers outside of your building and I expect to send you that information next week.

Note that the next quarterly readings inside your building are due to be taken at the beginning of June, 2016.

However, we are still awaiting the draft time extension to the entry agreement which you were going to provide in January.

The February readings were carried out based on a verbal agreement between the two of us.

Please let me know when we can expect the document for review.

Thanks, Brian.

Barbara,

Please print this message and the attachments in color for the correspondence file and also forward to the electronic file.
Thanks, Brian.

Brian Dykes
Principal Engineer
Transbay Joint Powers Authority
201 Mission Street, Suite 2100
San Francisco, CA 94105
415 597 4617 phone
415 597 4615 fax



 Please consider the environment before printing this message.

Check out our progress at <http://transbaycenter.org/construction-updates/construction-cameras>

NOTE: This e-mail communication and any attachments hereto are covered by the Electronic Communications Privacy Act, 18 U.S.C. Sections 2510-2521, and are legally privileged. The information contained herein is confidential, and is intended only for the use of the individual or entity to whom it is addressed. If you are not the intended recipient of this e-mail communication (or an employee or agent responsible for delivering this communication to its intended recipient(s)), you are hereby notified that any retention, copying or further distribution of this e-mail communication and any attachments is strictly prohibited. If you are not the intended

recipient, please notify the sender by telephoning 415-597-4620, or by forwarding an e-mail reply message addressed to TransAdmin@TransbayCenter.org confirming that you have already destroyed (deleted) the original e-mail communication and any and all copies thereof. Thank you.

Memorandum


ARUP

To	Brian Dykes (TJPA)	Date	February 19, 2015
Copies		Reference number	132242
From	Andrew Yeskoo (Arup)	File reference	"2016" 4-05 258
Subject	Transbay Transit Center: Results of February 2016 Settlement Survey at 301 Mission Property	Page 1 of 1	

Under Arup's Geotechnical Contract with the Transbay Joint Powers Authority through Pelli Clark Pelli Architects, Arup is required to monitor the settlements of the buildings adjacent to the Transbay Transit Center prior to and during construction. We began the monitoring program for the 301 Mission property in April of 2009. This memorandum and the attached plates present an update to our memorandum dated October 30, 2015 with measurements made through February 2016.

List of Plates


- Plate 1 Floor Elevations at Level B-1 of 301 Mission Property: Periodic Survey – February 5, 2016
- Plate 2 Differential Floor Elevation (Inches) February 5, 2016 Survey
- Plate 3 Contours of Settlements Measured at the 1st Level Basement of the 301 Mission St. Structure Between 4/30/2009 & 2/5/2016
- Plate 4 Settlement Over Time Floor Elevations at Level B-1 of 301 Mission Property – Tower: April 30, 2009 through February 5, 2016
- Plate 5 Settlement Over Time Floor Elevations at Level B-1 of 301 Mission Property – Mid-Rise: April 30, 2009 through February 5, 2016
- Plate 6 Settlements of the 301 Mission Tower Including Monitoring During Construction
- Plate 7 Floor Elevation at Basement Level B-5 of 301 Mission Property: February 5, 2016 Survey
- Plate 8 Differential Floor Elevations (Inches) at Basement Level B-5: February 5, 2016 Survey

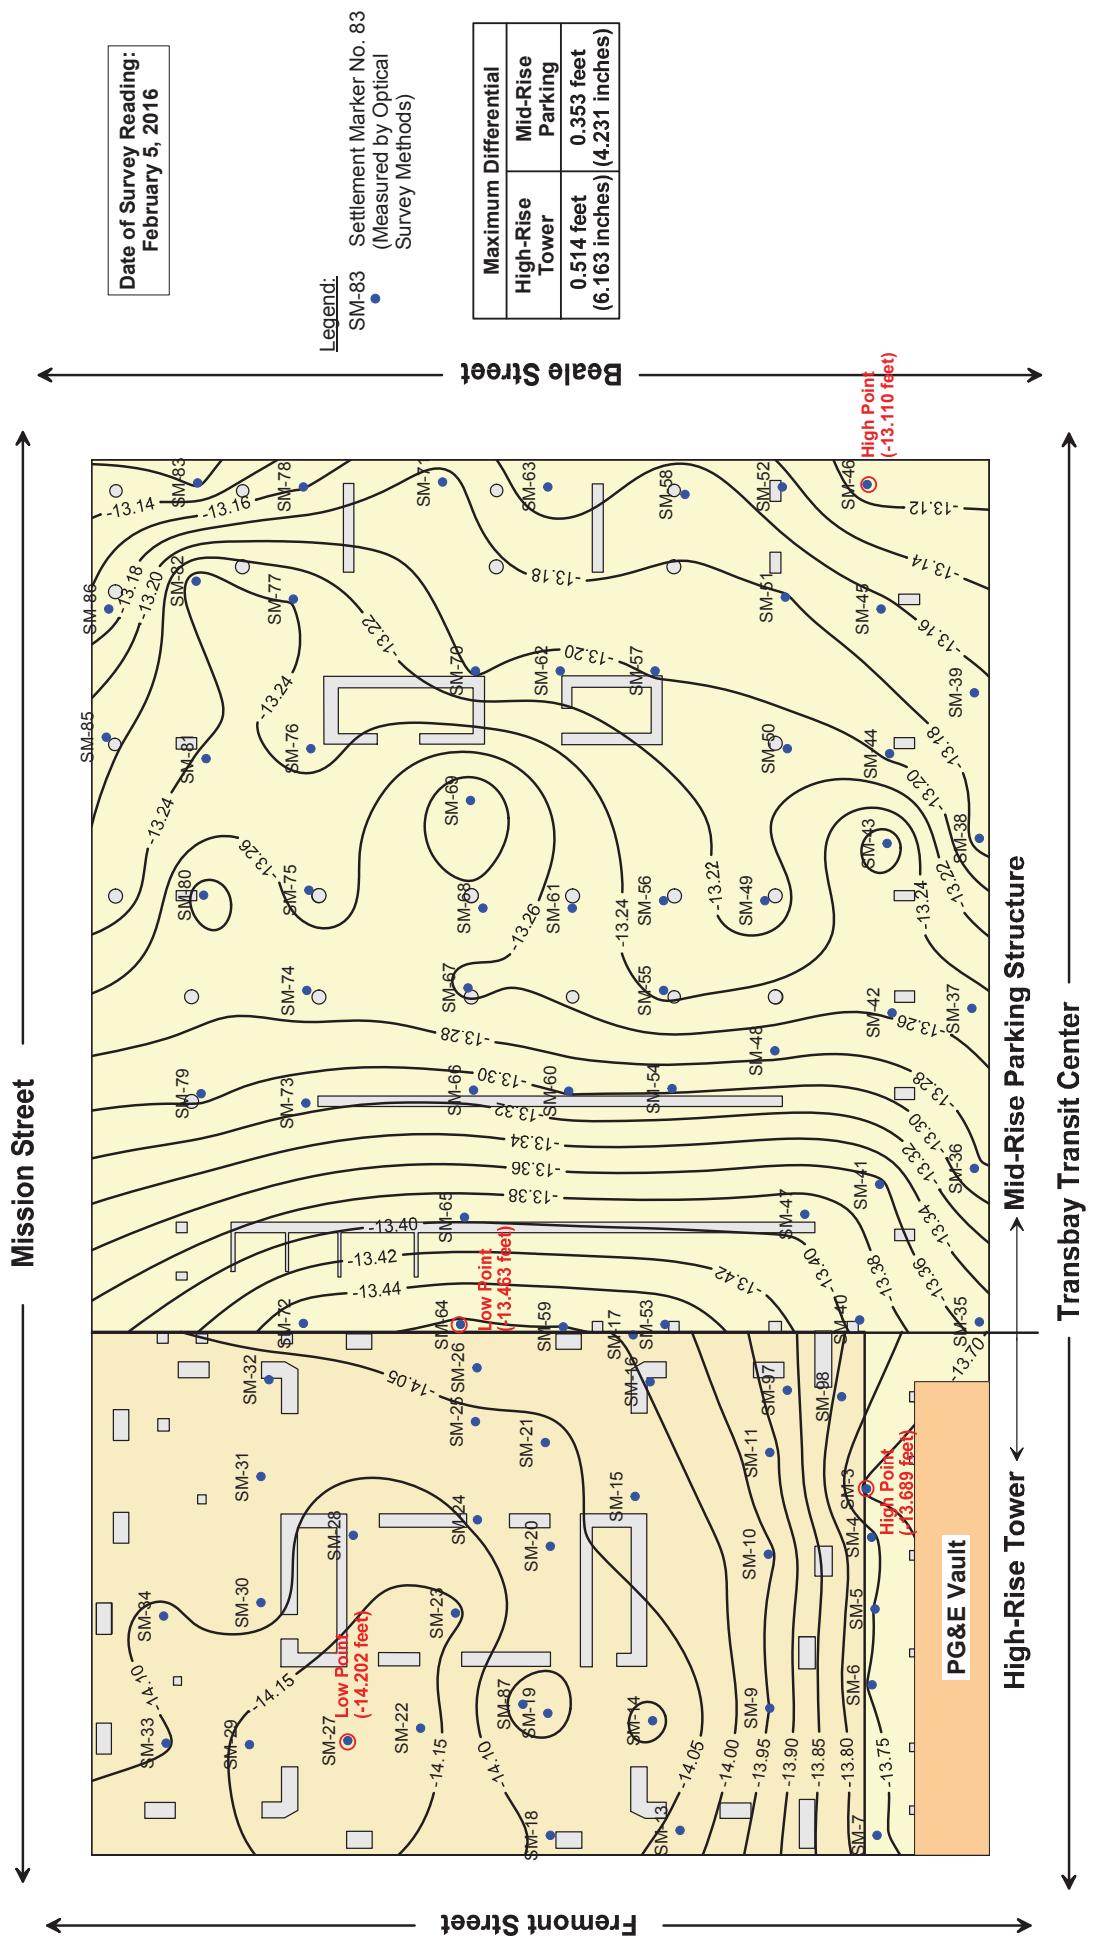


**FLOOR ELEVATIONS AT LEVEL B-1
 OF 301 MISSION PROPERTY:
 PERIODIC SURVEY - FEBRUARY 5, 2016**

Transbay Transit Center
 301 Mission Monitoring
 Transbay Joint Powers Authority
 San Francisco, California

February 2016

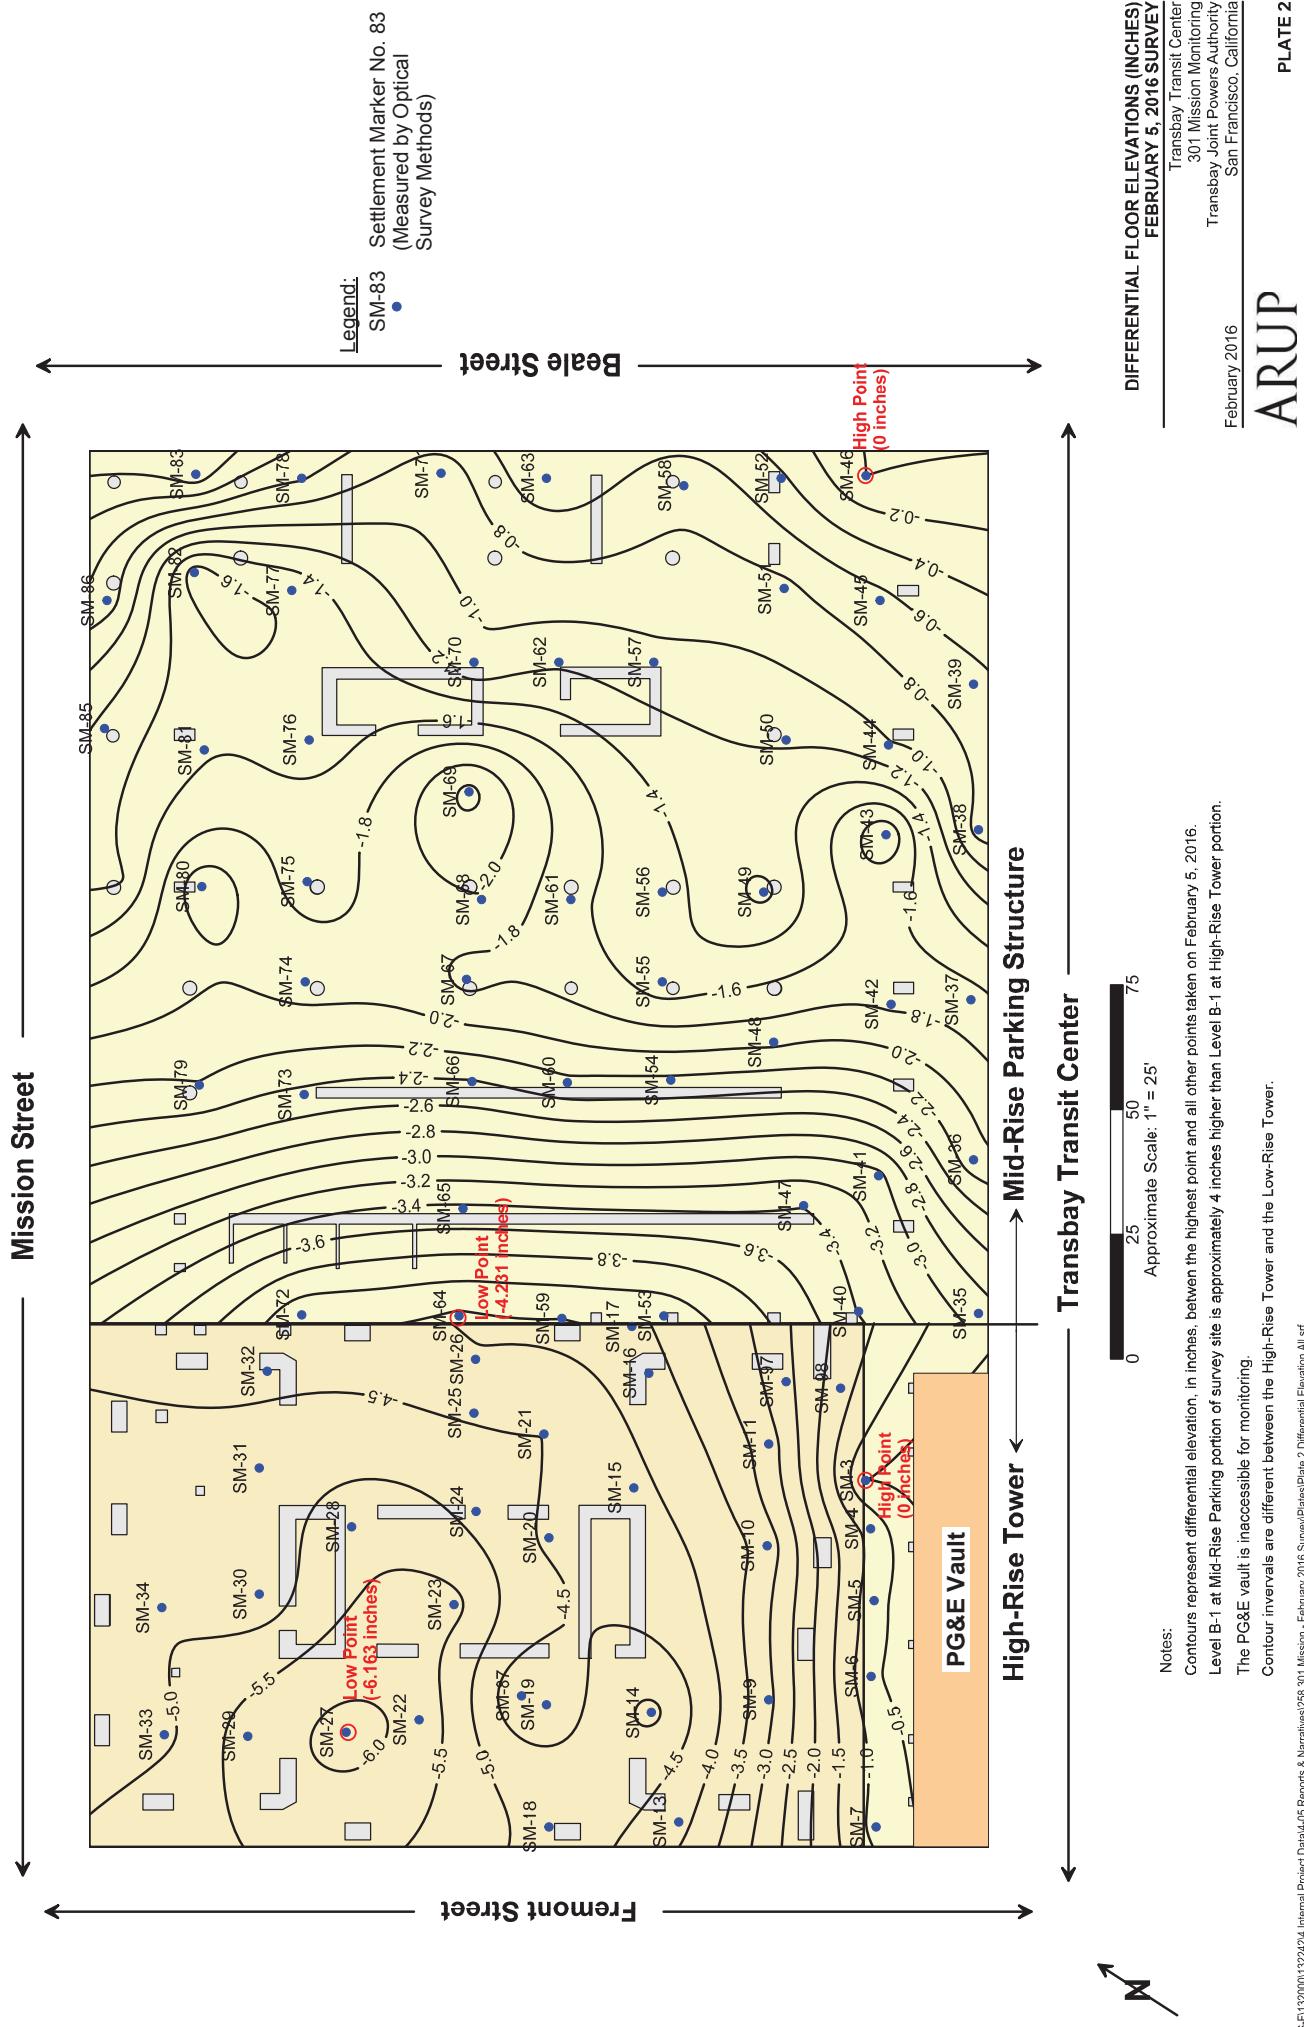

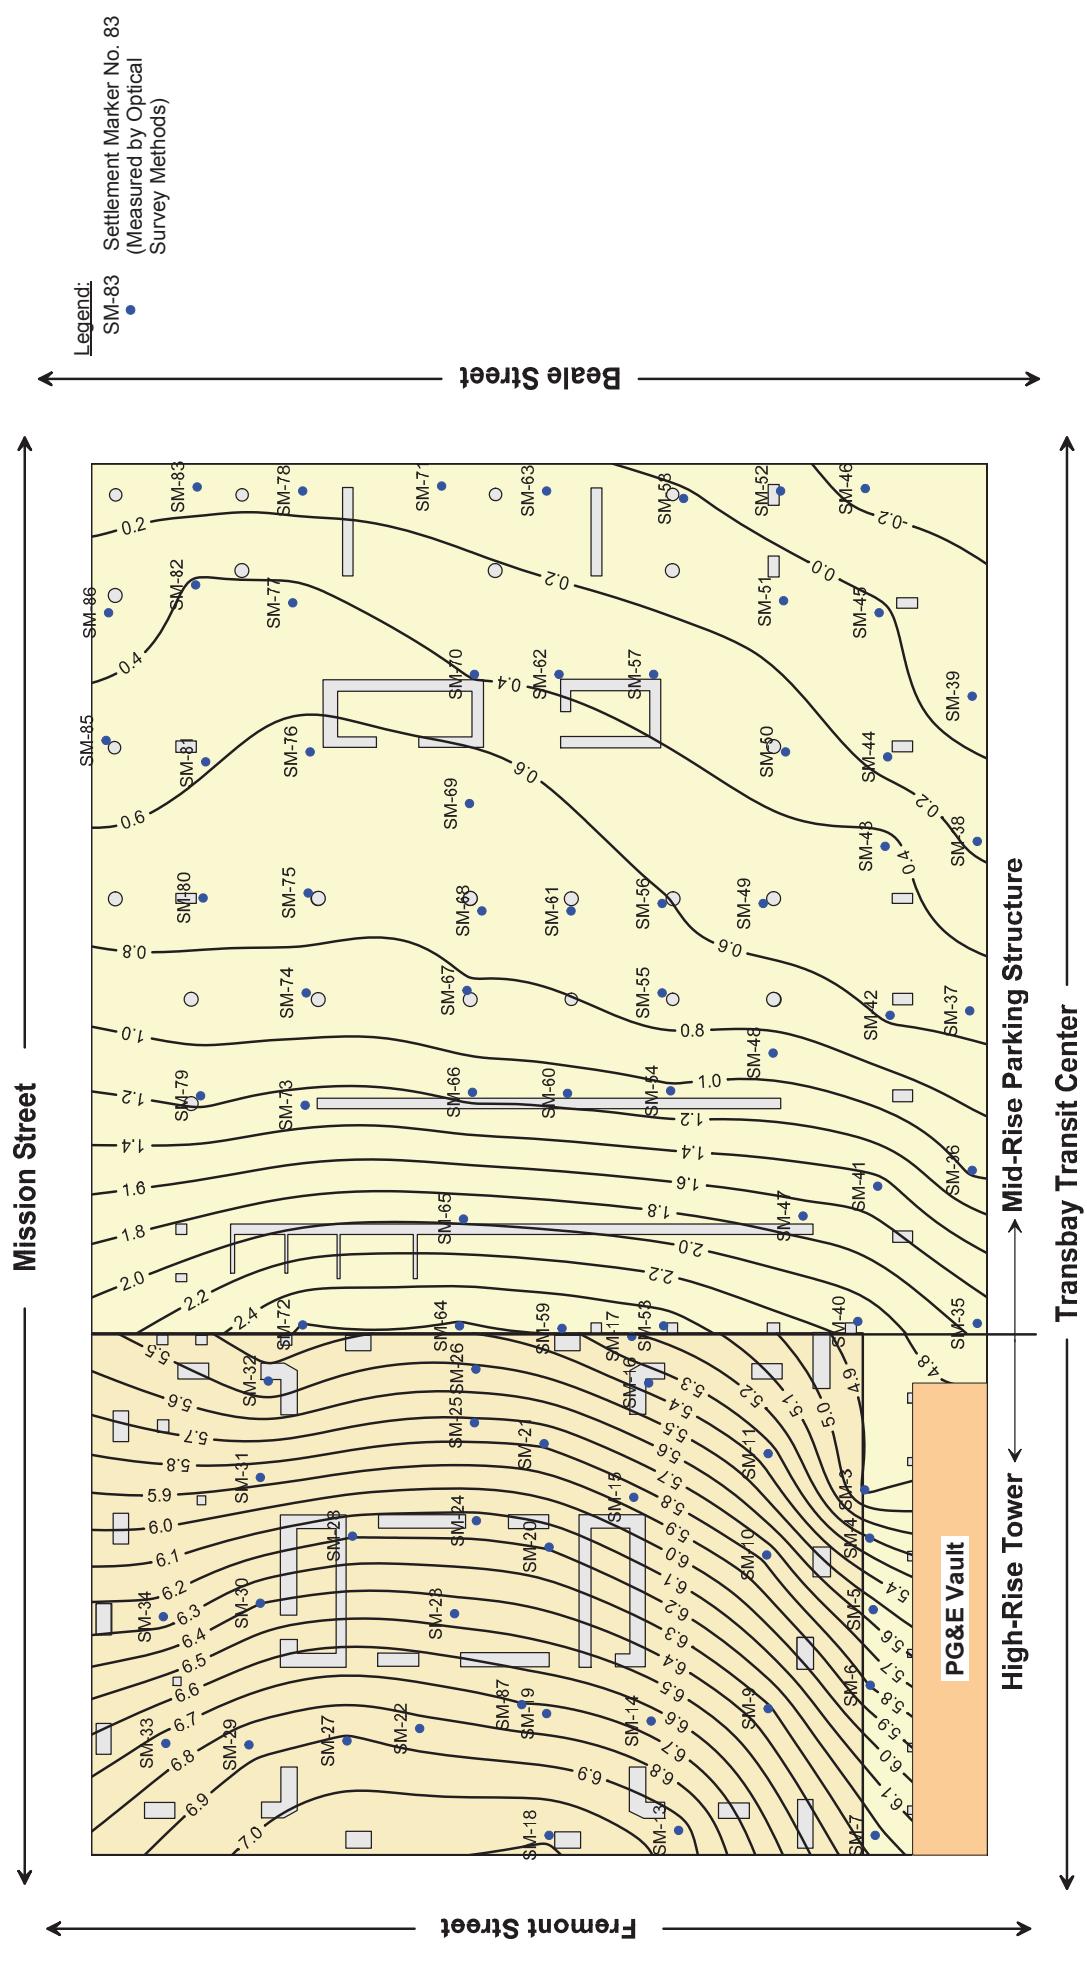

CONTOURS OF SETTLEMENTS MEASURED AT THE 1ST LEVEL BASEMENT OF THE 301 MISSION STREET STRUCTURE BETWEEN 4/30/2009 & 2/5/2016

Transbay Transit Center
301 Mission Monitoring
Transbay Joint Powers Authority
San Francisco, California
February 2016

JIS-F12000132424 Internal Project Data4-05 Reports & Narratives\258 301 Mission - February 2016 Survey\Pates\Plate 3 Elevation changes All.srf

PLATE 3

ARUP



ARUP

Note:
Initial (Baseline) reading
taken on 04/30/09

February 2016

SETTLEMENT OVER TIME
FLOOR ELEVATIONS AT LEVEL B-1
OF 301 MISSION PROPERTY- TOWER:
APRIL 30, 2009 THROUGH FEBRUARY 5, 2016

Transbay Transit Center
301 Mission Monitoring
Transbay Joint Powers Authority
San Francisco, California

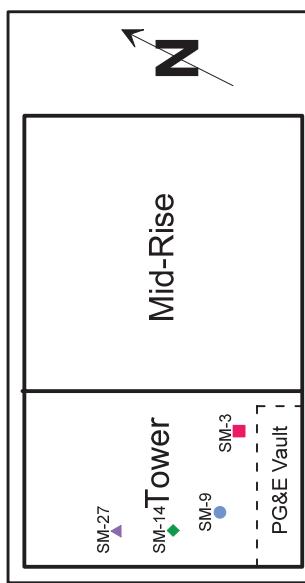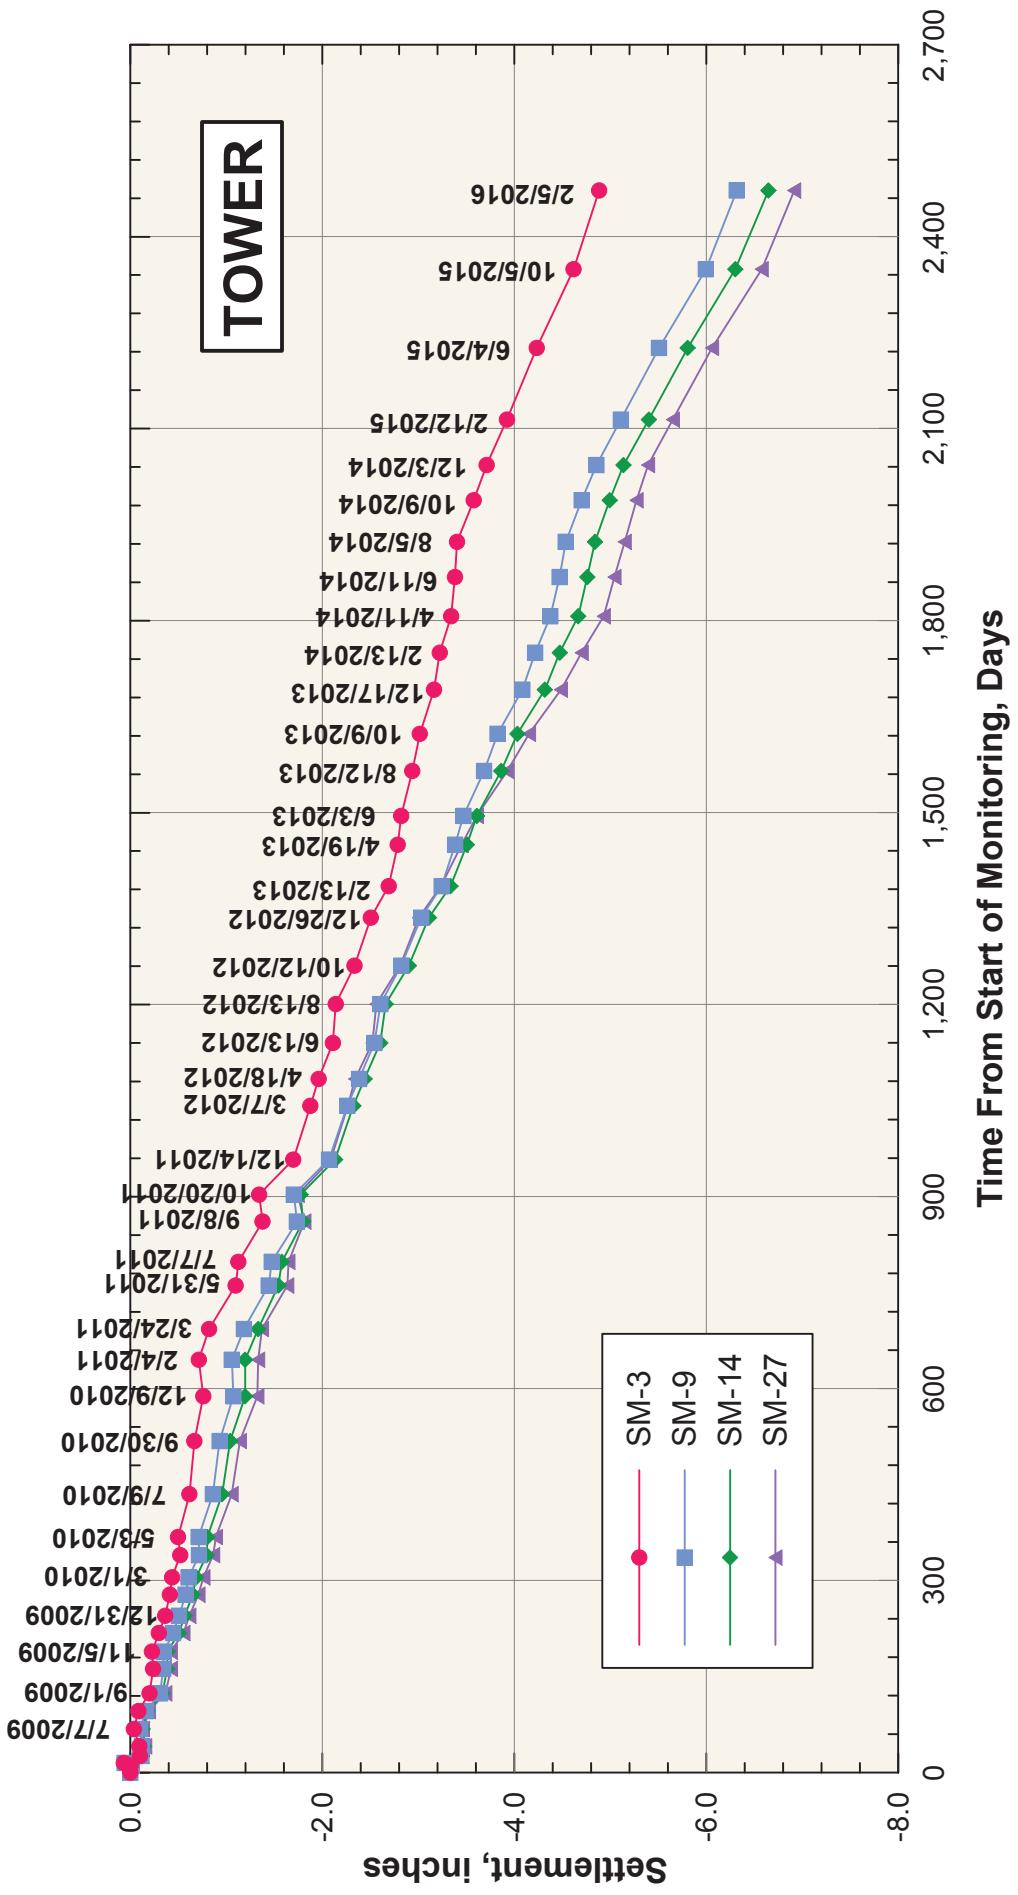

ARUP



Note:
Initial (Baseline) reading
taken on 04/30/09

J.S.F.13200001322424 Internal Project Data4-05 Reports & Narratives\258 301 Mission - February 2016 Survey\Plates\Plate 5 Settlement Over Time - Midrise.grf

MID-RISE

SETTLEMENT OVER TIME
FLOOR ELEVATIONS AT LEVEL B-1
OF 301 MISSION PROPERTY - MID-RISE:
APRIL 30, 2009 THROUGH FEBRUARY 5, 2016

Transbay Transit Center
301 Mission Monitoring
Transbay Joint Powers Authority
San Francisco, California

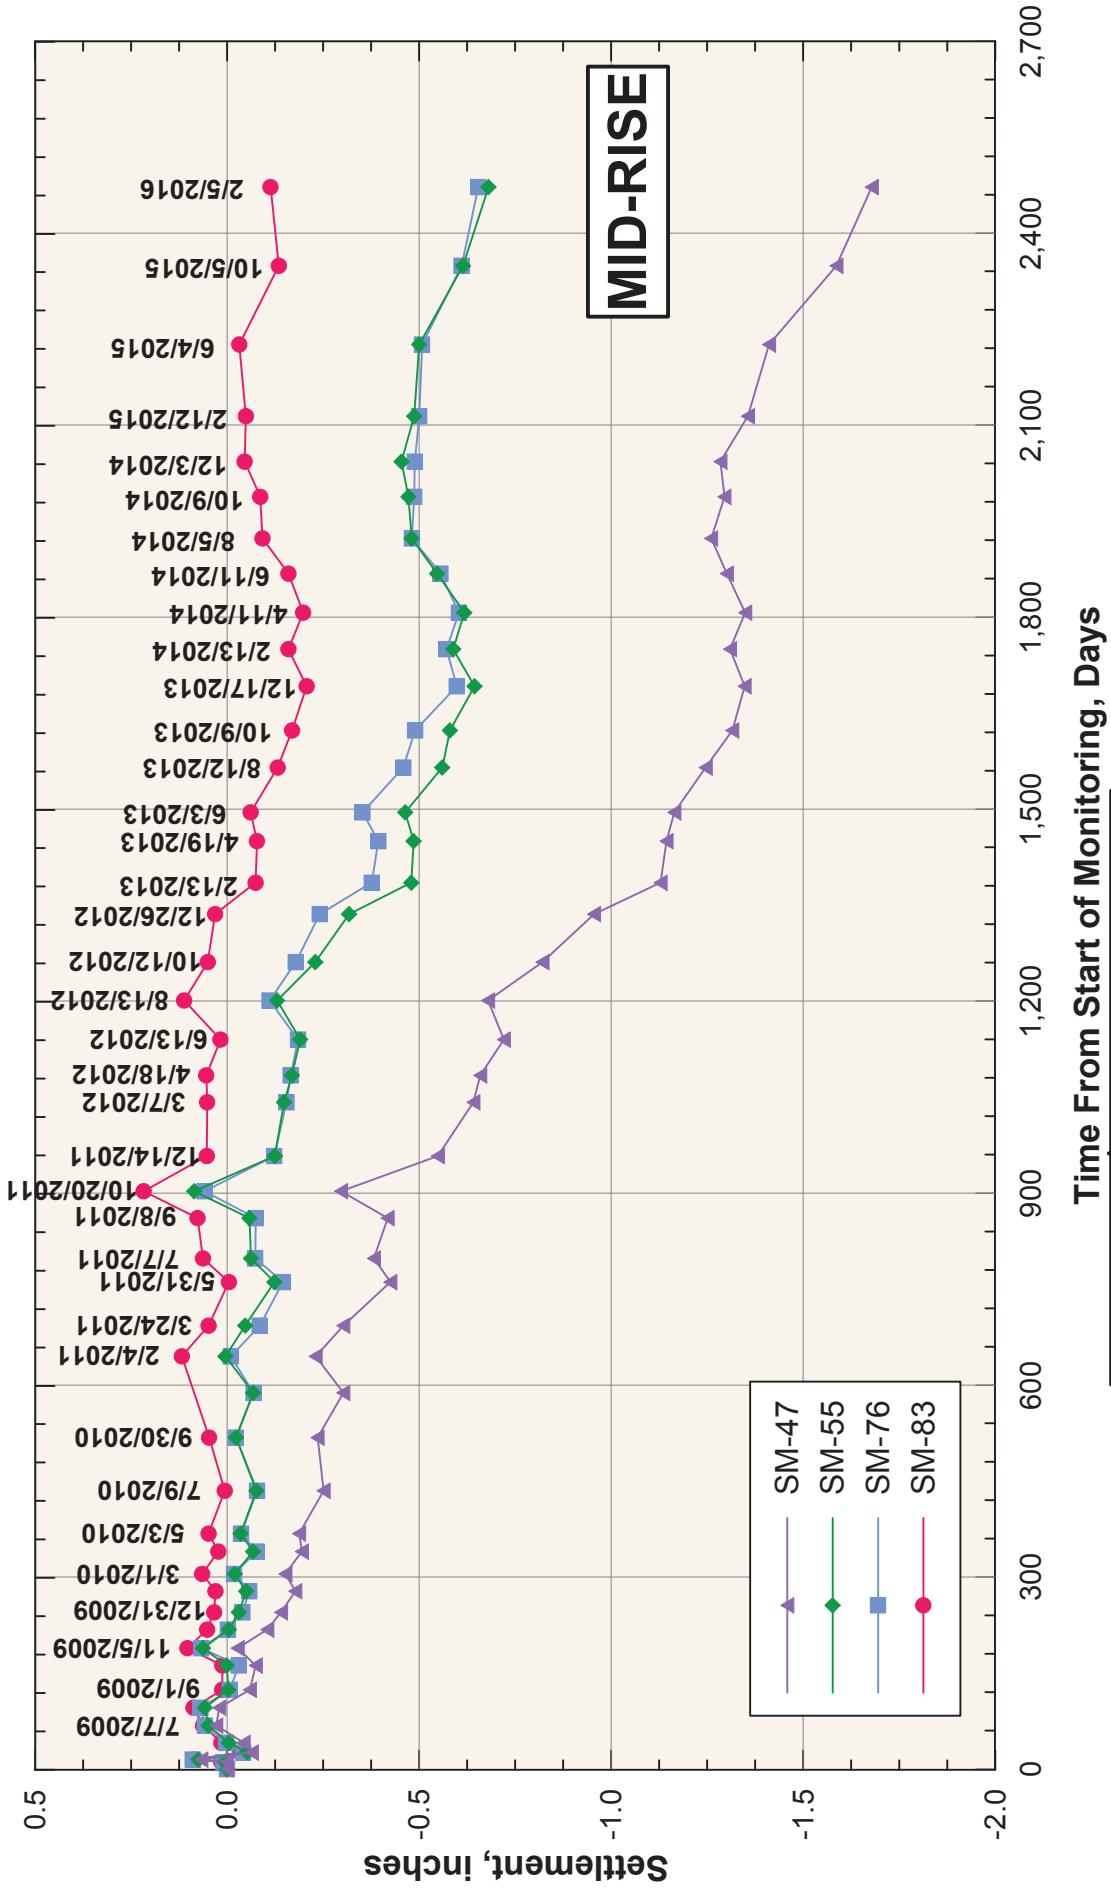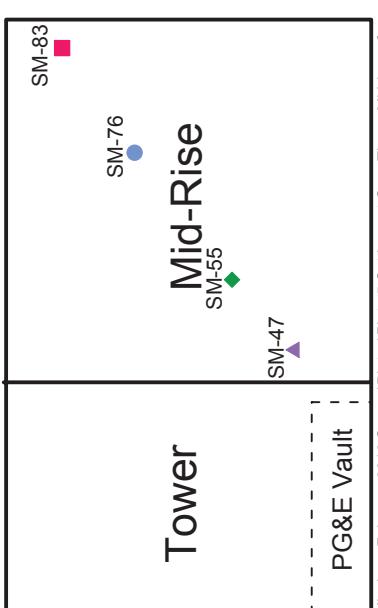


ARUP


**SETTLEMENTS OF THE 301 MISSION TOWER
INCLUDING MONITORING DURING CONSTRUCTION**


Transbay Transit Center
301 Mission Monitoring
Transbay Joint Powers Authority
San Francisco, California

February 2016

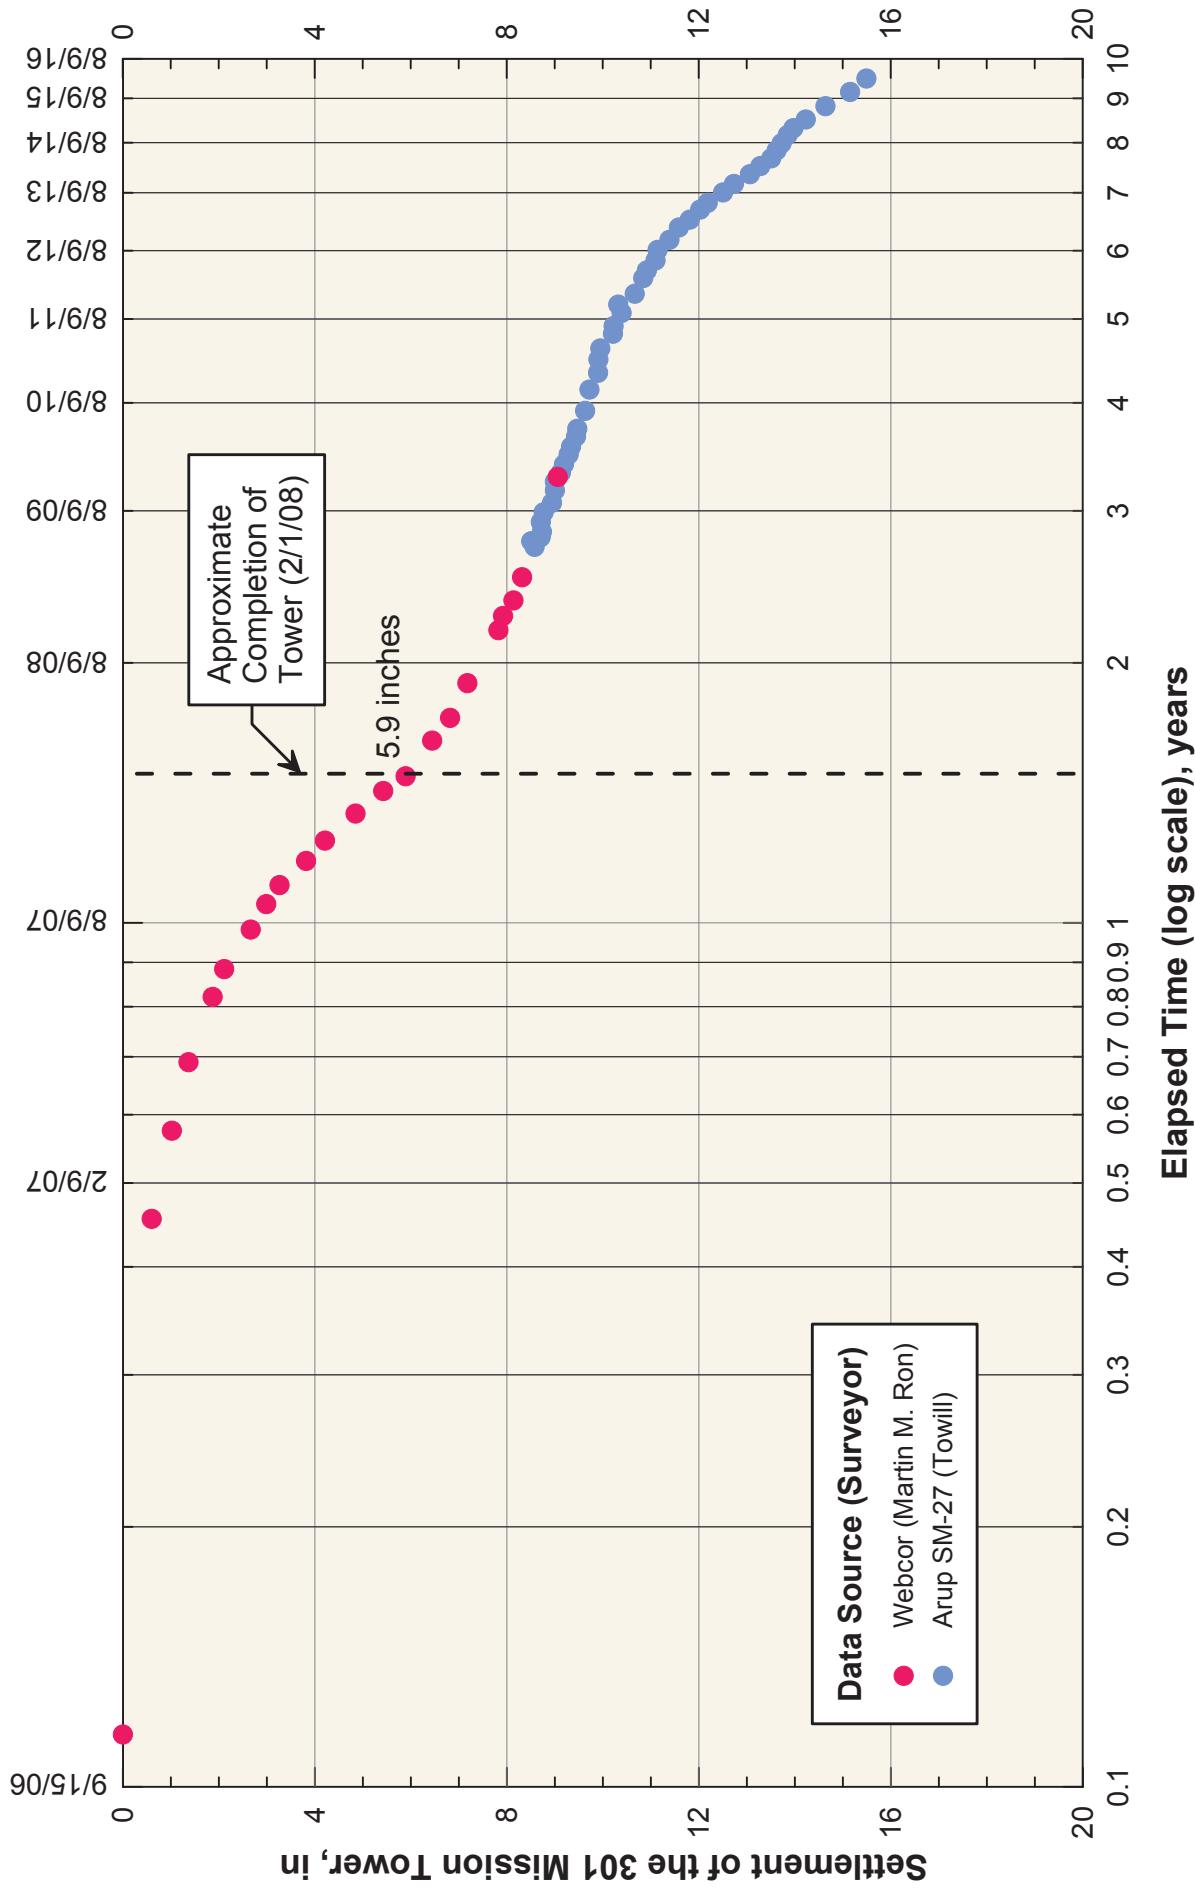

Beginning of Tower Construction: 8/9/06
End of Tower Construction: 2/1/08
Construction Duration: 542 days (1.5 years)

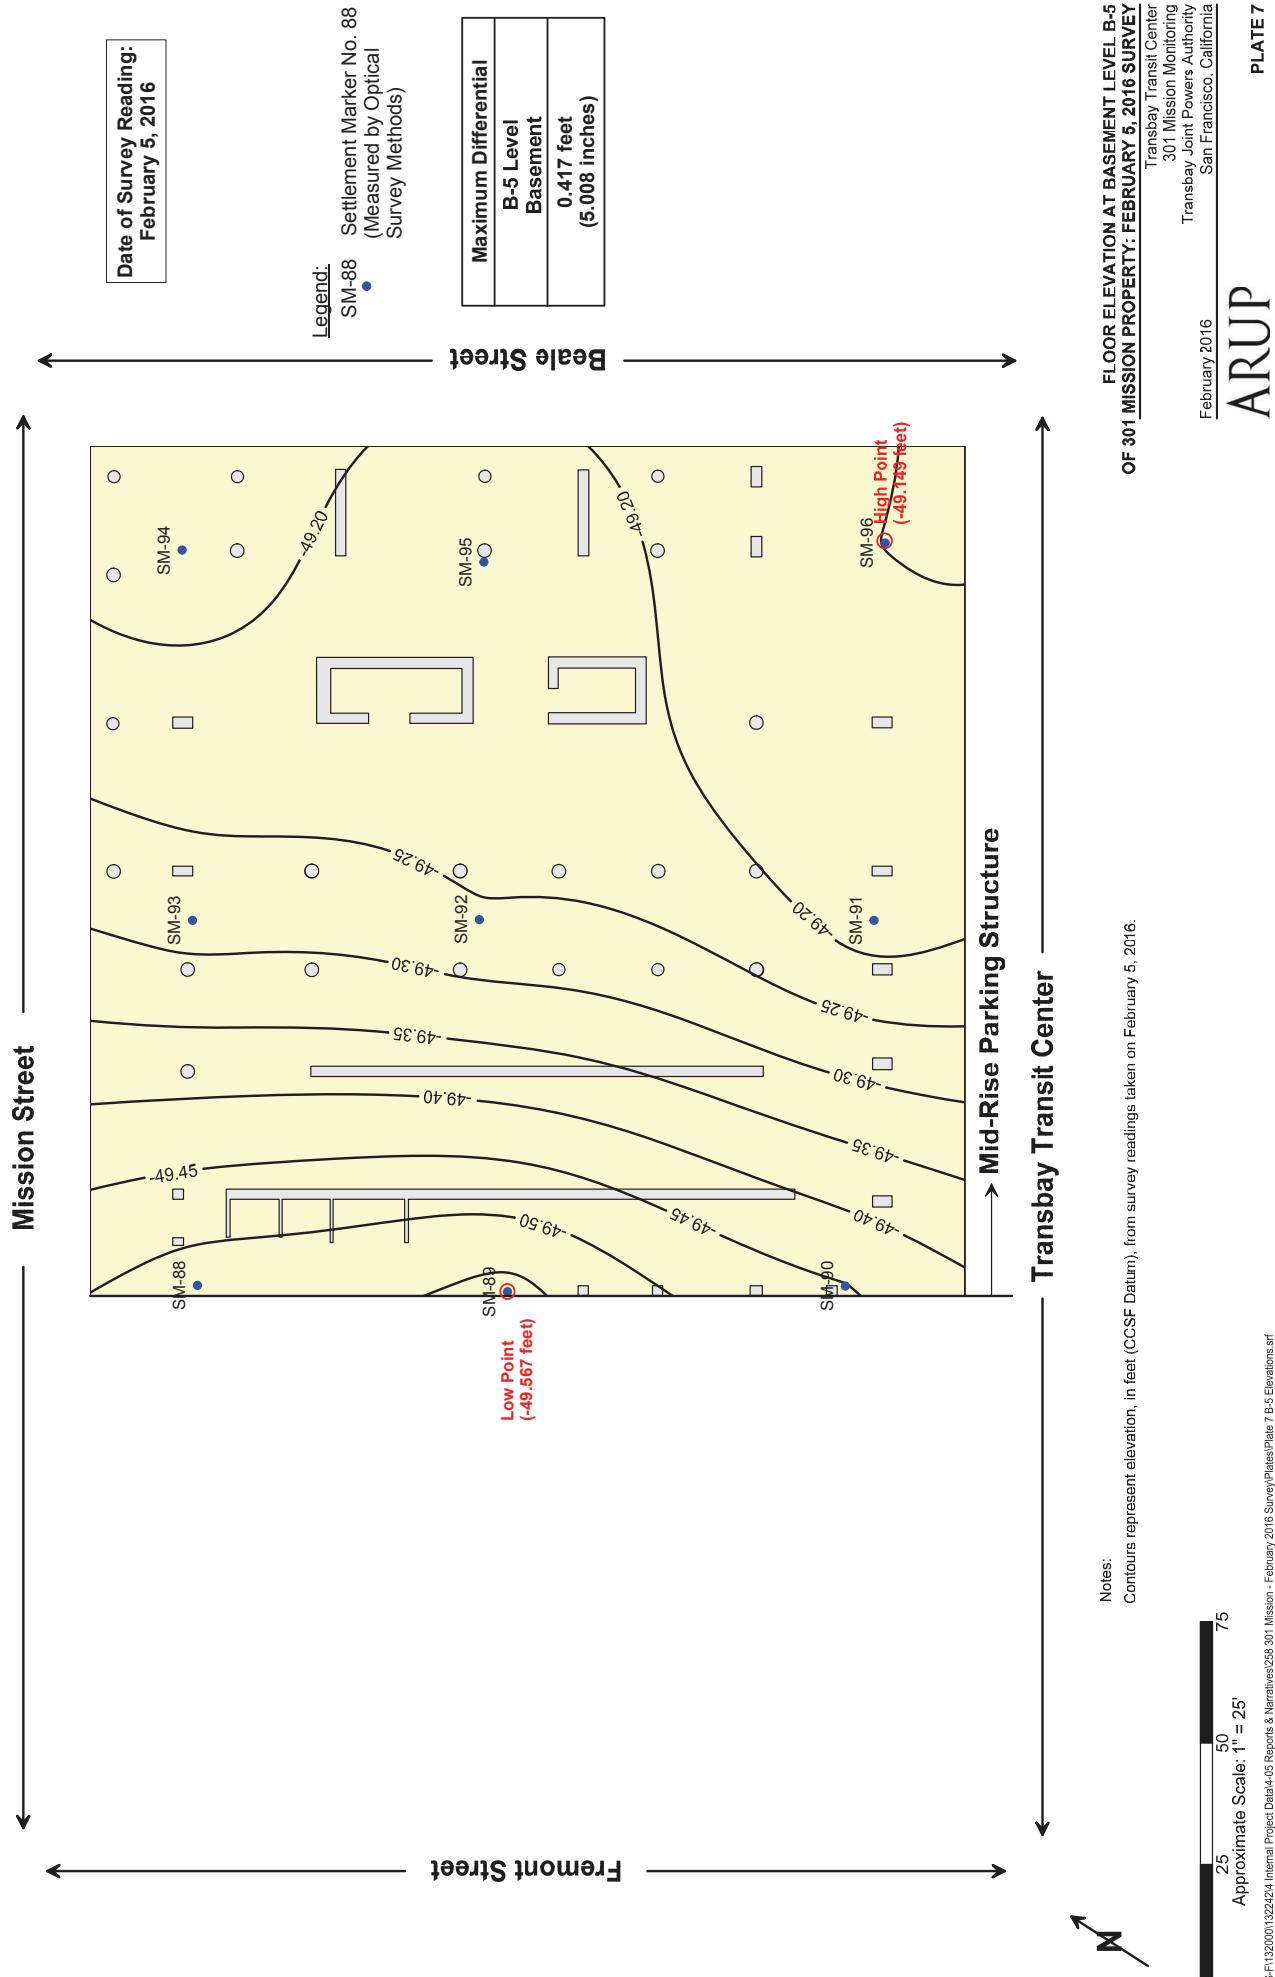

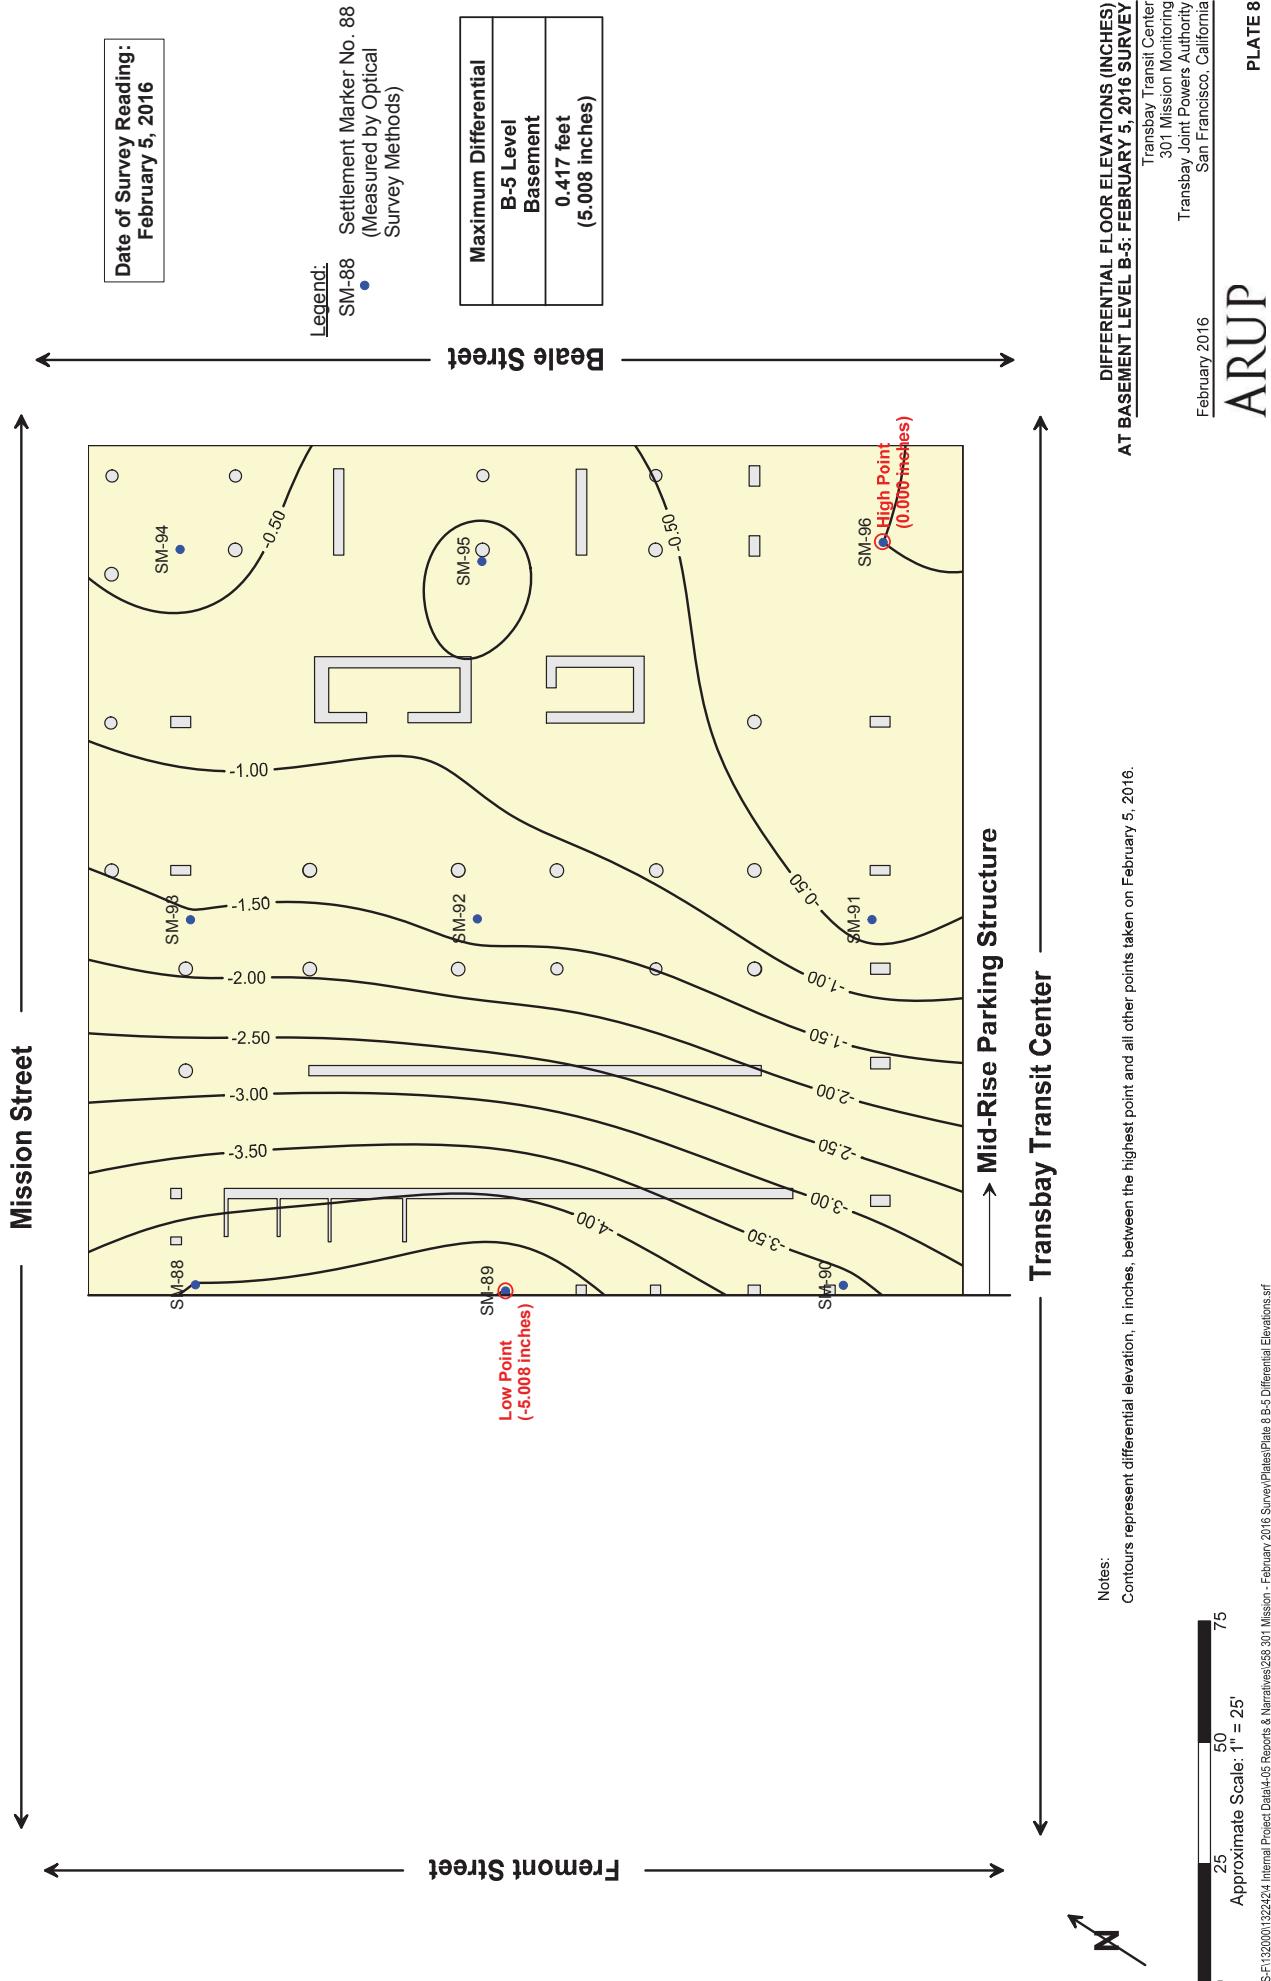

From: Brian Dykes
Sent: Wednesday, June 22, 2016 8:48 AM
To: 'Steven Hood'
Cc: Mark Zabaneh; Nila Gonzales
Subject: 301 Mission Street Settlement Readings

Steven,

Here is the June 16 settlement monitoring raw data from Towill and the memorandum report from Arup. Please ignore the incorrect label of February in the file name. The memo is dated June 16, 2016.

Brian.

Brian Dykes
Principal Engineer
Transbay Joint Powers Authority
201 Mission Street, Suite 2100
San Francisco, CA 94105
415 597 4617 phone
415 597 4615 fax



 Please consider the environment before printing this message.

Check out our progress at <http://transbaycenter.org/construction-updates/construction-cameras>

NOTE: This e-mail communication and any attachments hereto are covered by the Electronic Communications Privacy Act, 18 U.S.C. Sections 2510-2521, and are legally privileged. The information contained herein is confidential, and is intended only for the use of the individual or entity to whom it is addressed. If you are not the intended recipient of this e-mail communication (or an employee or agent responsible for delivering this communication to its intended recipient(s)), you are hereby notified that any retention, copying or further distribution of this e-mail communication and any attachments is strictly prohibited. If you are not the intended recipient, please notify the sender by telephoning 415-597-4620, or by forwarding an e-mail reply message addressed to TransAdmin@TransbayCenter.org confirming that you have already destroyed (deleted) the original e-mail communication and any and all copies thereof. Thank you.

Memorandum


ARUP

To	Brian Dykes (TJPA)	Date
		June 16, 2016
Copies		Reference number
		132242
From	Andrew Yeskoo (Arup)	File reference
		4-05 260
Subject	Transbay Transit Center: Results of June 2016 Settlement Survey at 301 Mission Property	Page 1 of 1

Under Arup's Geotechnical Contract with the Transbay Joint Powers Authority through Pelli Clark Pelli Architects, Arup is required to monitor the settlements of the buildings adjacent to the Transbay Transit Center prior to and during construction. We began the monitoring program for the 301 Mission property in April of 2009. This memorandum and the attached plates present an update to our memorandum dated February 19, 2016 with measurements made through June 2016.

List of Plates

- Plate 1 Floor Elevations at Level B-1 of 301 Mission Property: Periodic Survey – June 10, 2016
- Plate 2 Differential Floor Elevation (Inches) June 10, 2016 Survey
- Plate 3 Contours of Settlements Measured at the 1st Level Basement of the 301 Mission St. Structure Between 4/30/2009 & 6/10/2016
- Plate 4 Settlement Over Time Floor Elevations at Level B-1 of 301 Mission Property – Tower: April 30, 2009 through June 10, 2016
- Plate 5 Settlement Over Time Floor Elevations at Level B-1 of 301 Mission Property – Mid-Rise: April 30, 2009 through June 10, 2016
- Plate 6 Settlements of the 301 Mission Tower Including Monitoring During Construction
- Plate 7 Floor Elevation at Basement Level B-5 of 301 Mission Property: June 10, 2016 Survey
- Plate 8 Differential Floor Elevations (Inches) at Basement Level B-5: June 10, 2016 Survey

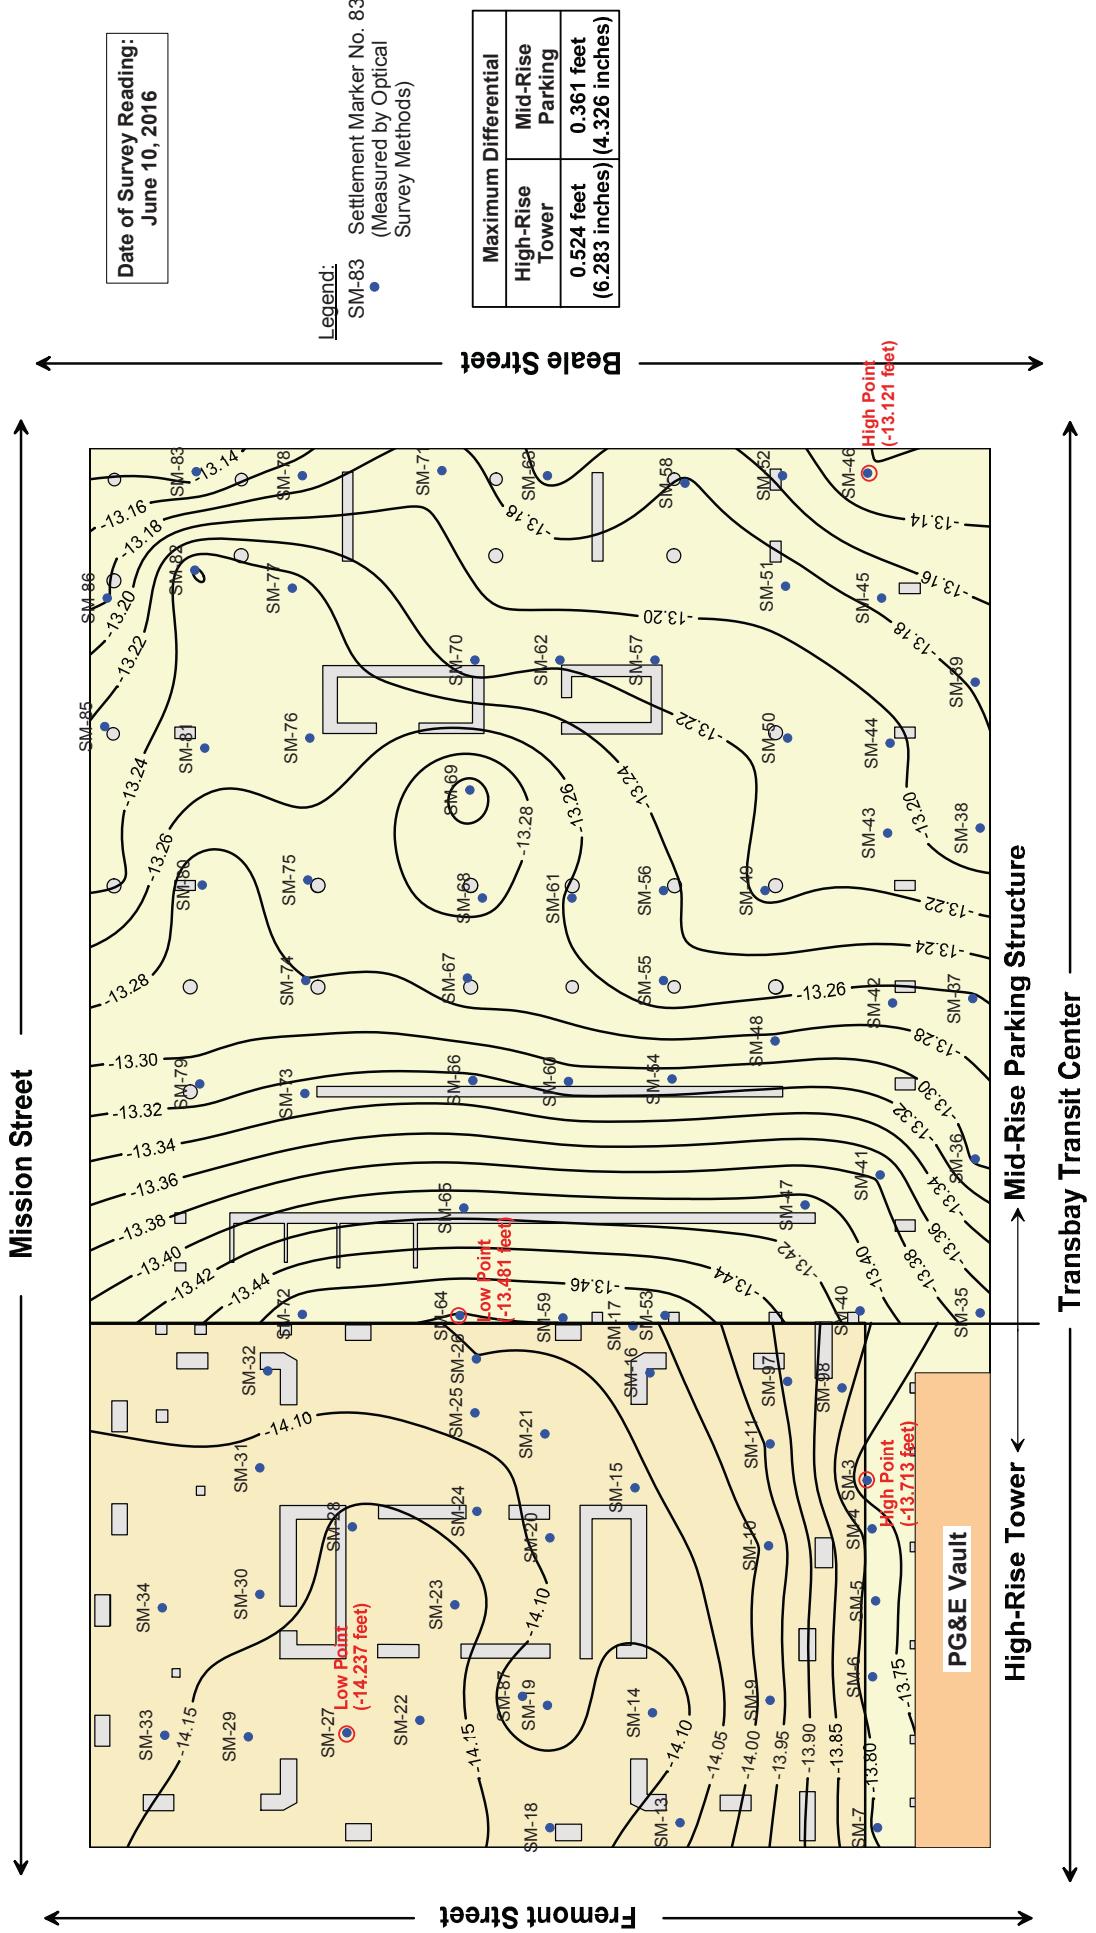


**FLOOR ELEVATIONS AT LEVEL B-1
OF 301 MISSION PROPERTY:
PERIODIC SURVEY - JUNE 10, 2016**

Transbay Transit Center
301 Mission Monitoring
Transbay Joint Powers Authority
San Francisco, California

June 2016


ARUP

PLATE 1

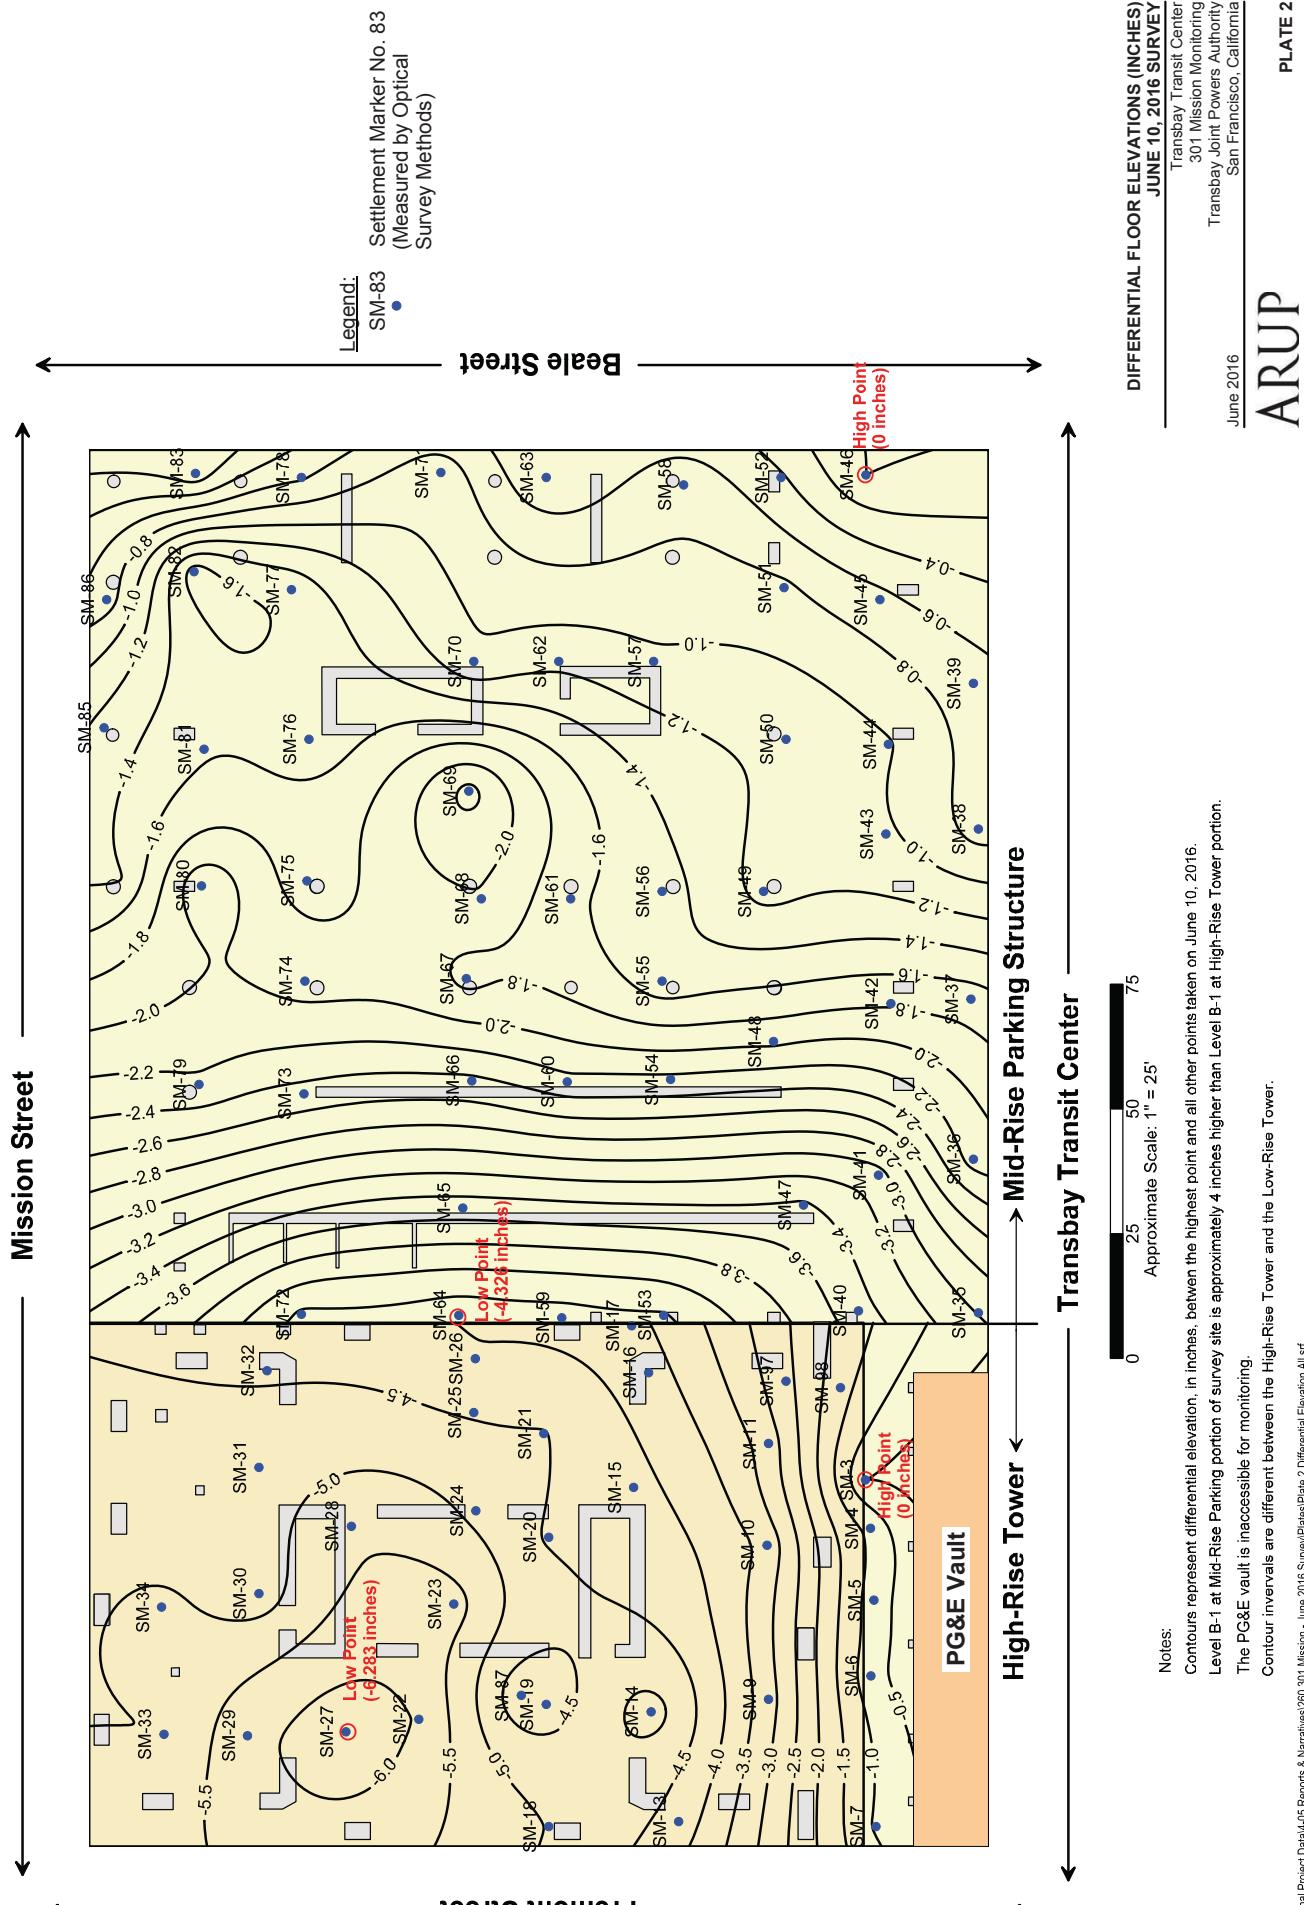

ARUP

PLATE 2

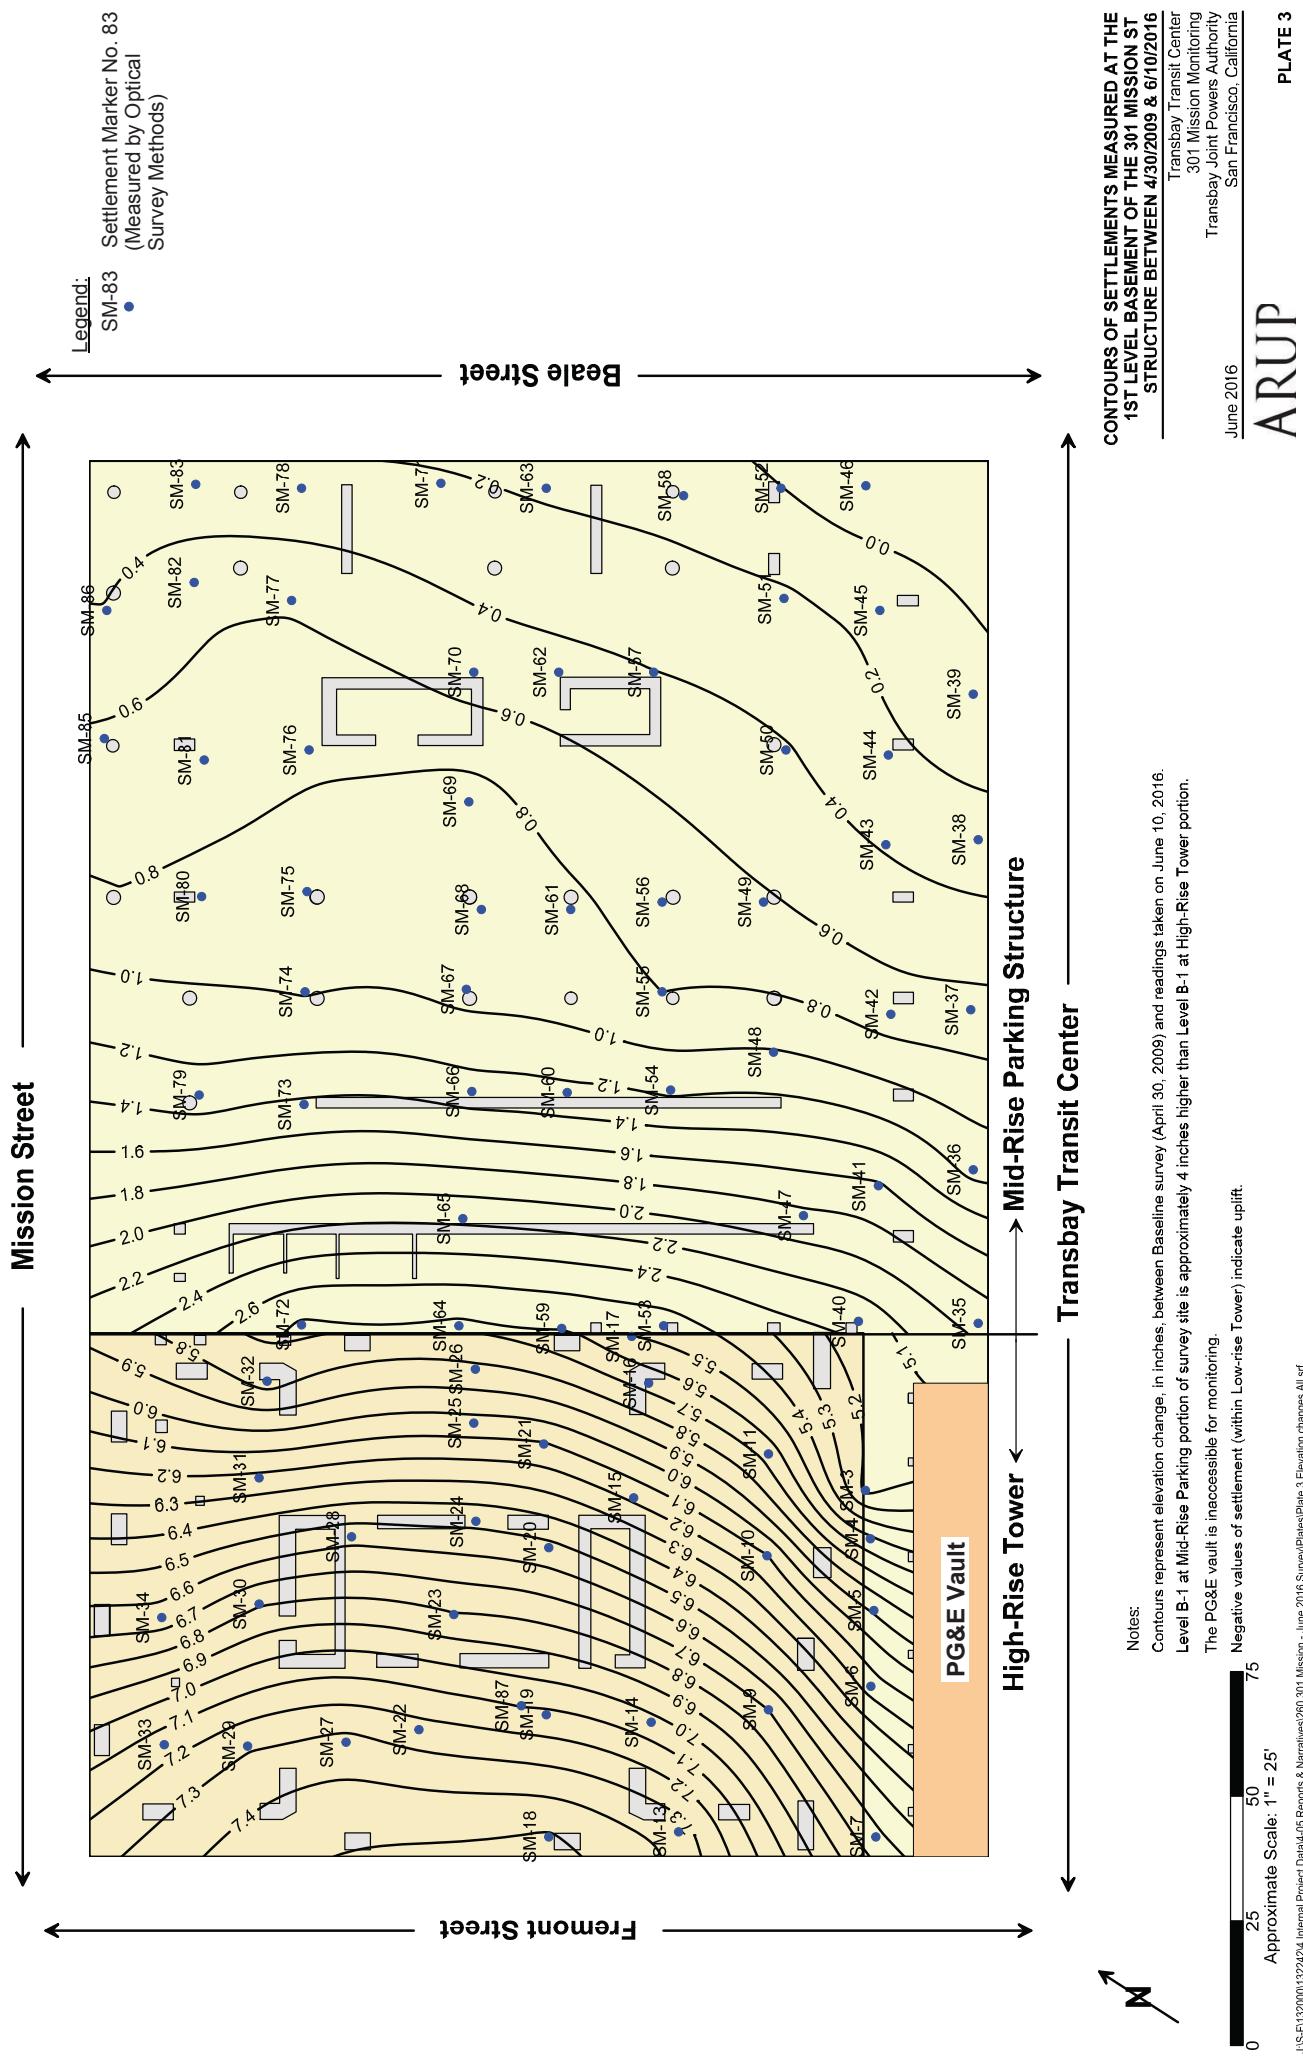


ARUP


June 2016 Survey Plates/Project Data/44-00 Mission - June 2016 Survey

**SETTLEMENT OVER TIME
FLOOR ELEVATIONS AT LEVEL B-1
OF 301 MISSION PROPERTY- TOWER:
APRIL 30, 2009 THROUGH JUNE 10, 2016**

Transbay Transit Center
301 Mission Monitoring
Transbay Joint Powers Authority
San Francisco, California

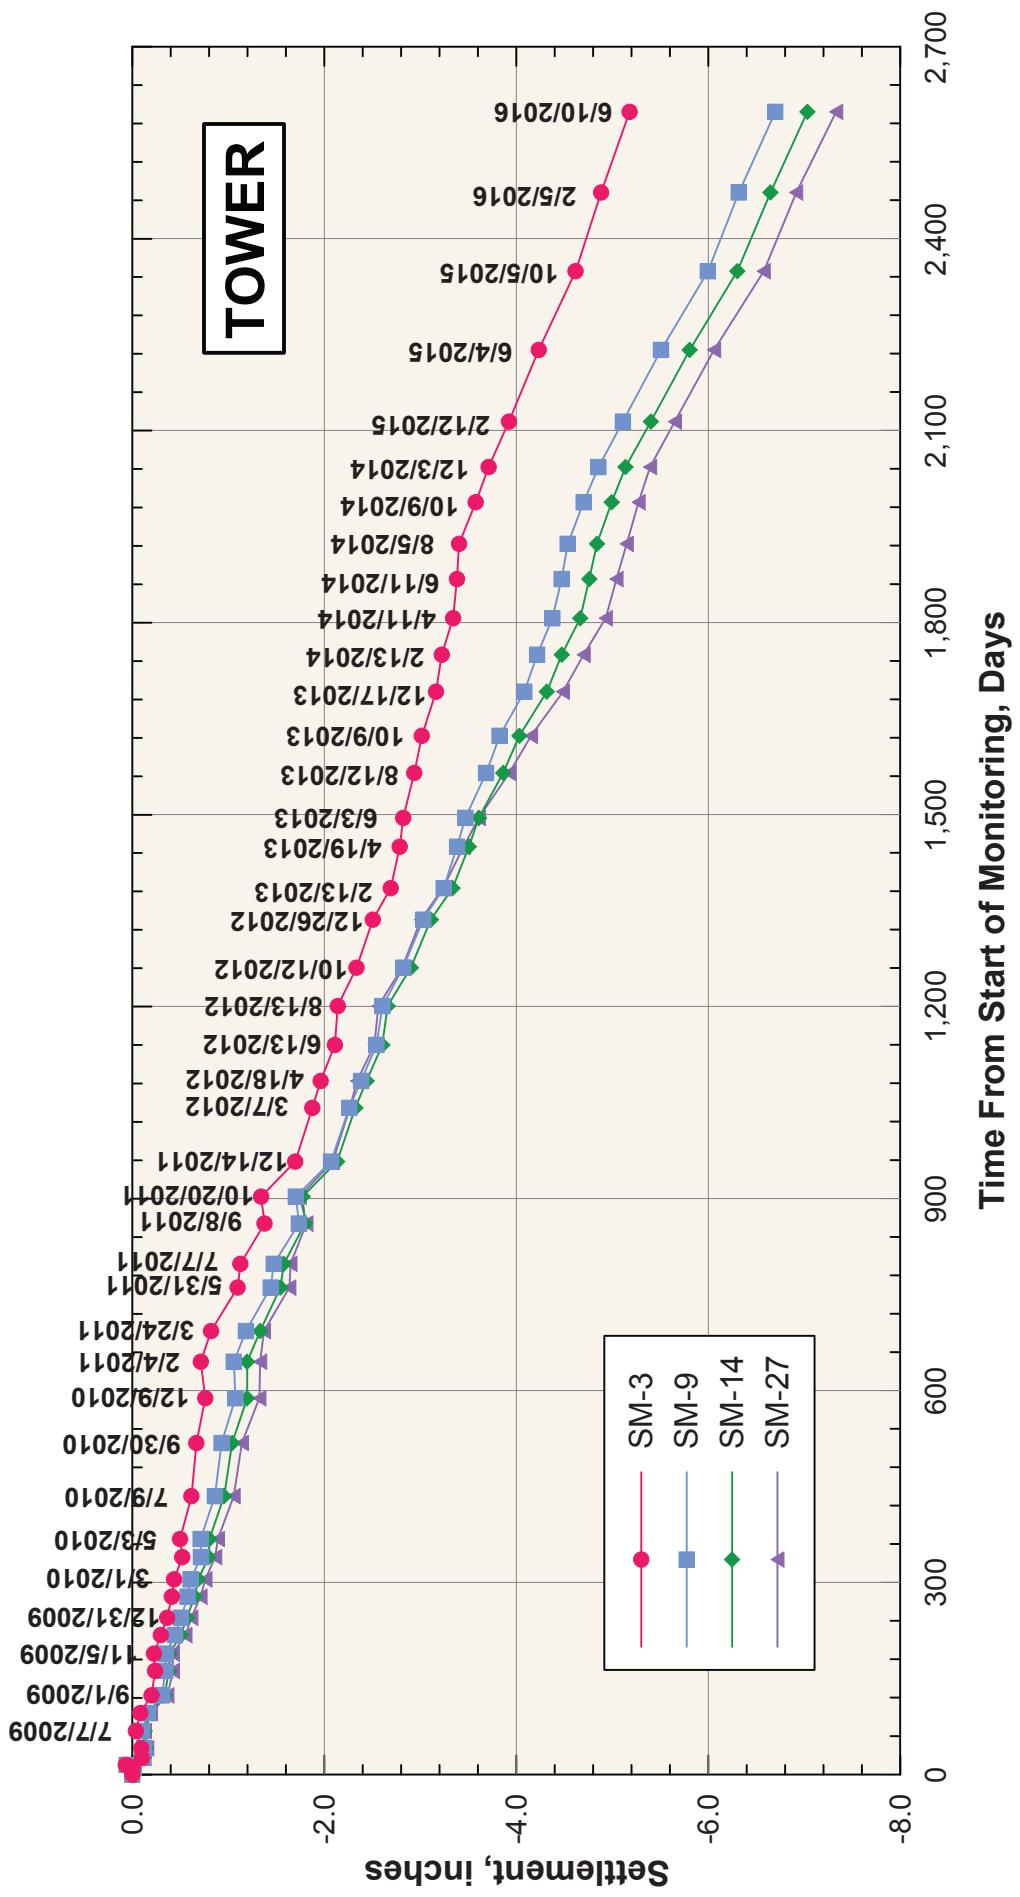

Note:
Initial (Baseline) reading
taken on 04/30/09

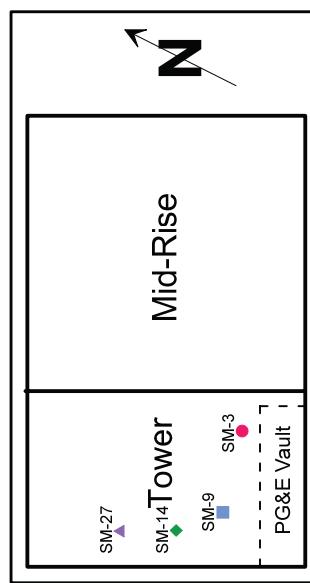



ARUP

Note:
Initial (Baseline) reading
taken on 04/30/09

J.S.F.13200001322424 Internal Project Data4-05 Reports & Narratives\260 301 Mission - June 2016 Survey\Plates\Plate 5 Settlement Over Time - Midrise.ghf

**SETTLEMENT OVER TIME
FLOOR ELEVATIONS AT LEVEL B-1
OF 301 MISSION PROPERTY - MID-RISE:
APRIL 30, 2009 THROUGH JUNE 10, 2016**

Transbay Transit Center
301 Mission Monitoring
Transbay Joint Powers Authority
San Francisco, California

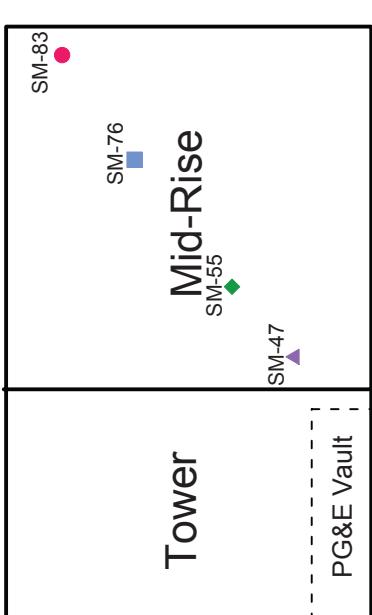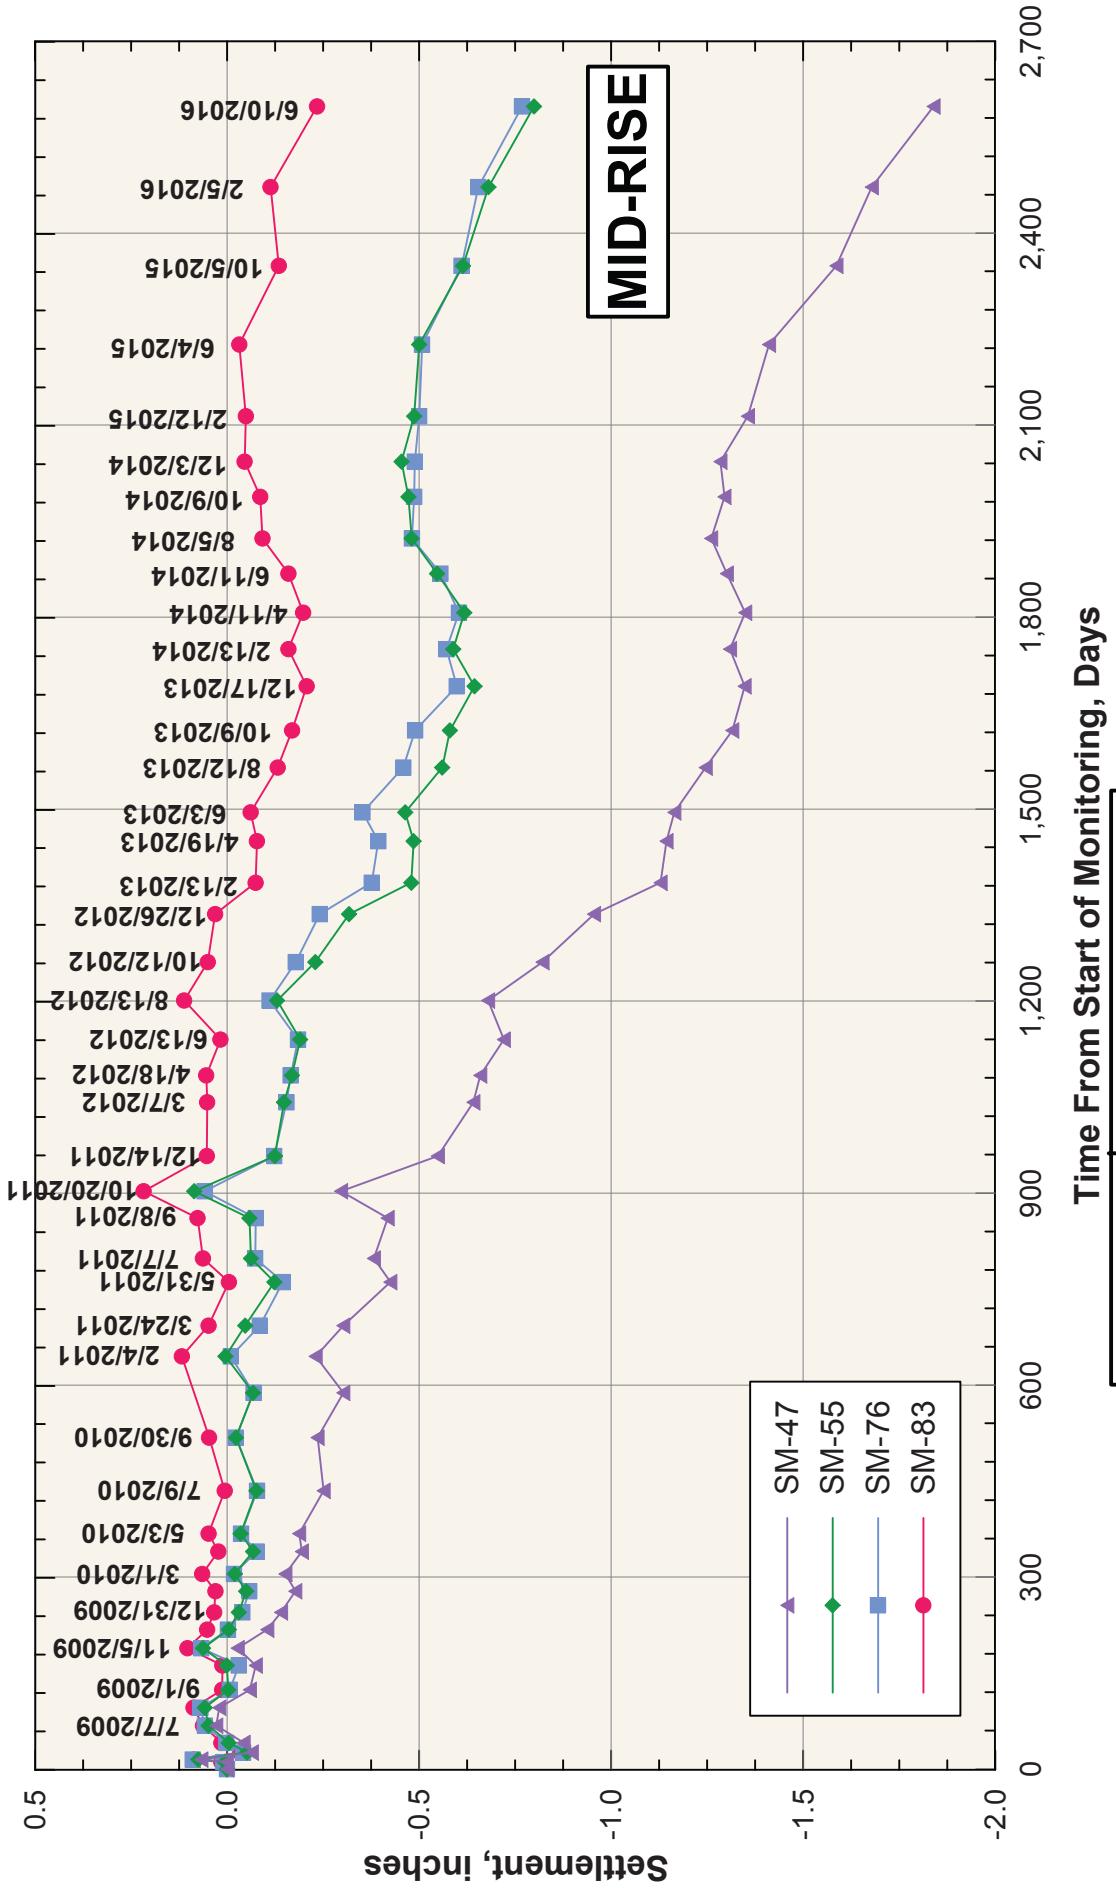

**SETTLEMENTS OF THE 301 MISSION TOWER
INCLUDING MONITORING DURING CONSTRUCTION**

Transbay Transit Center
301 Mission Monitoring
Transbay Joint Powers Authority
San Francisco, California

Beginning of Tower Construction: 8/9/06
End of Tower Construction: 2/1/08
Construction Duration: 542 days (1.5 years)

